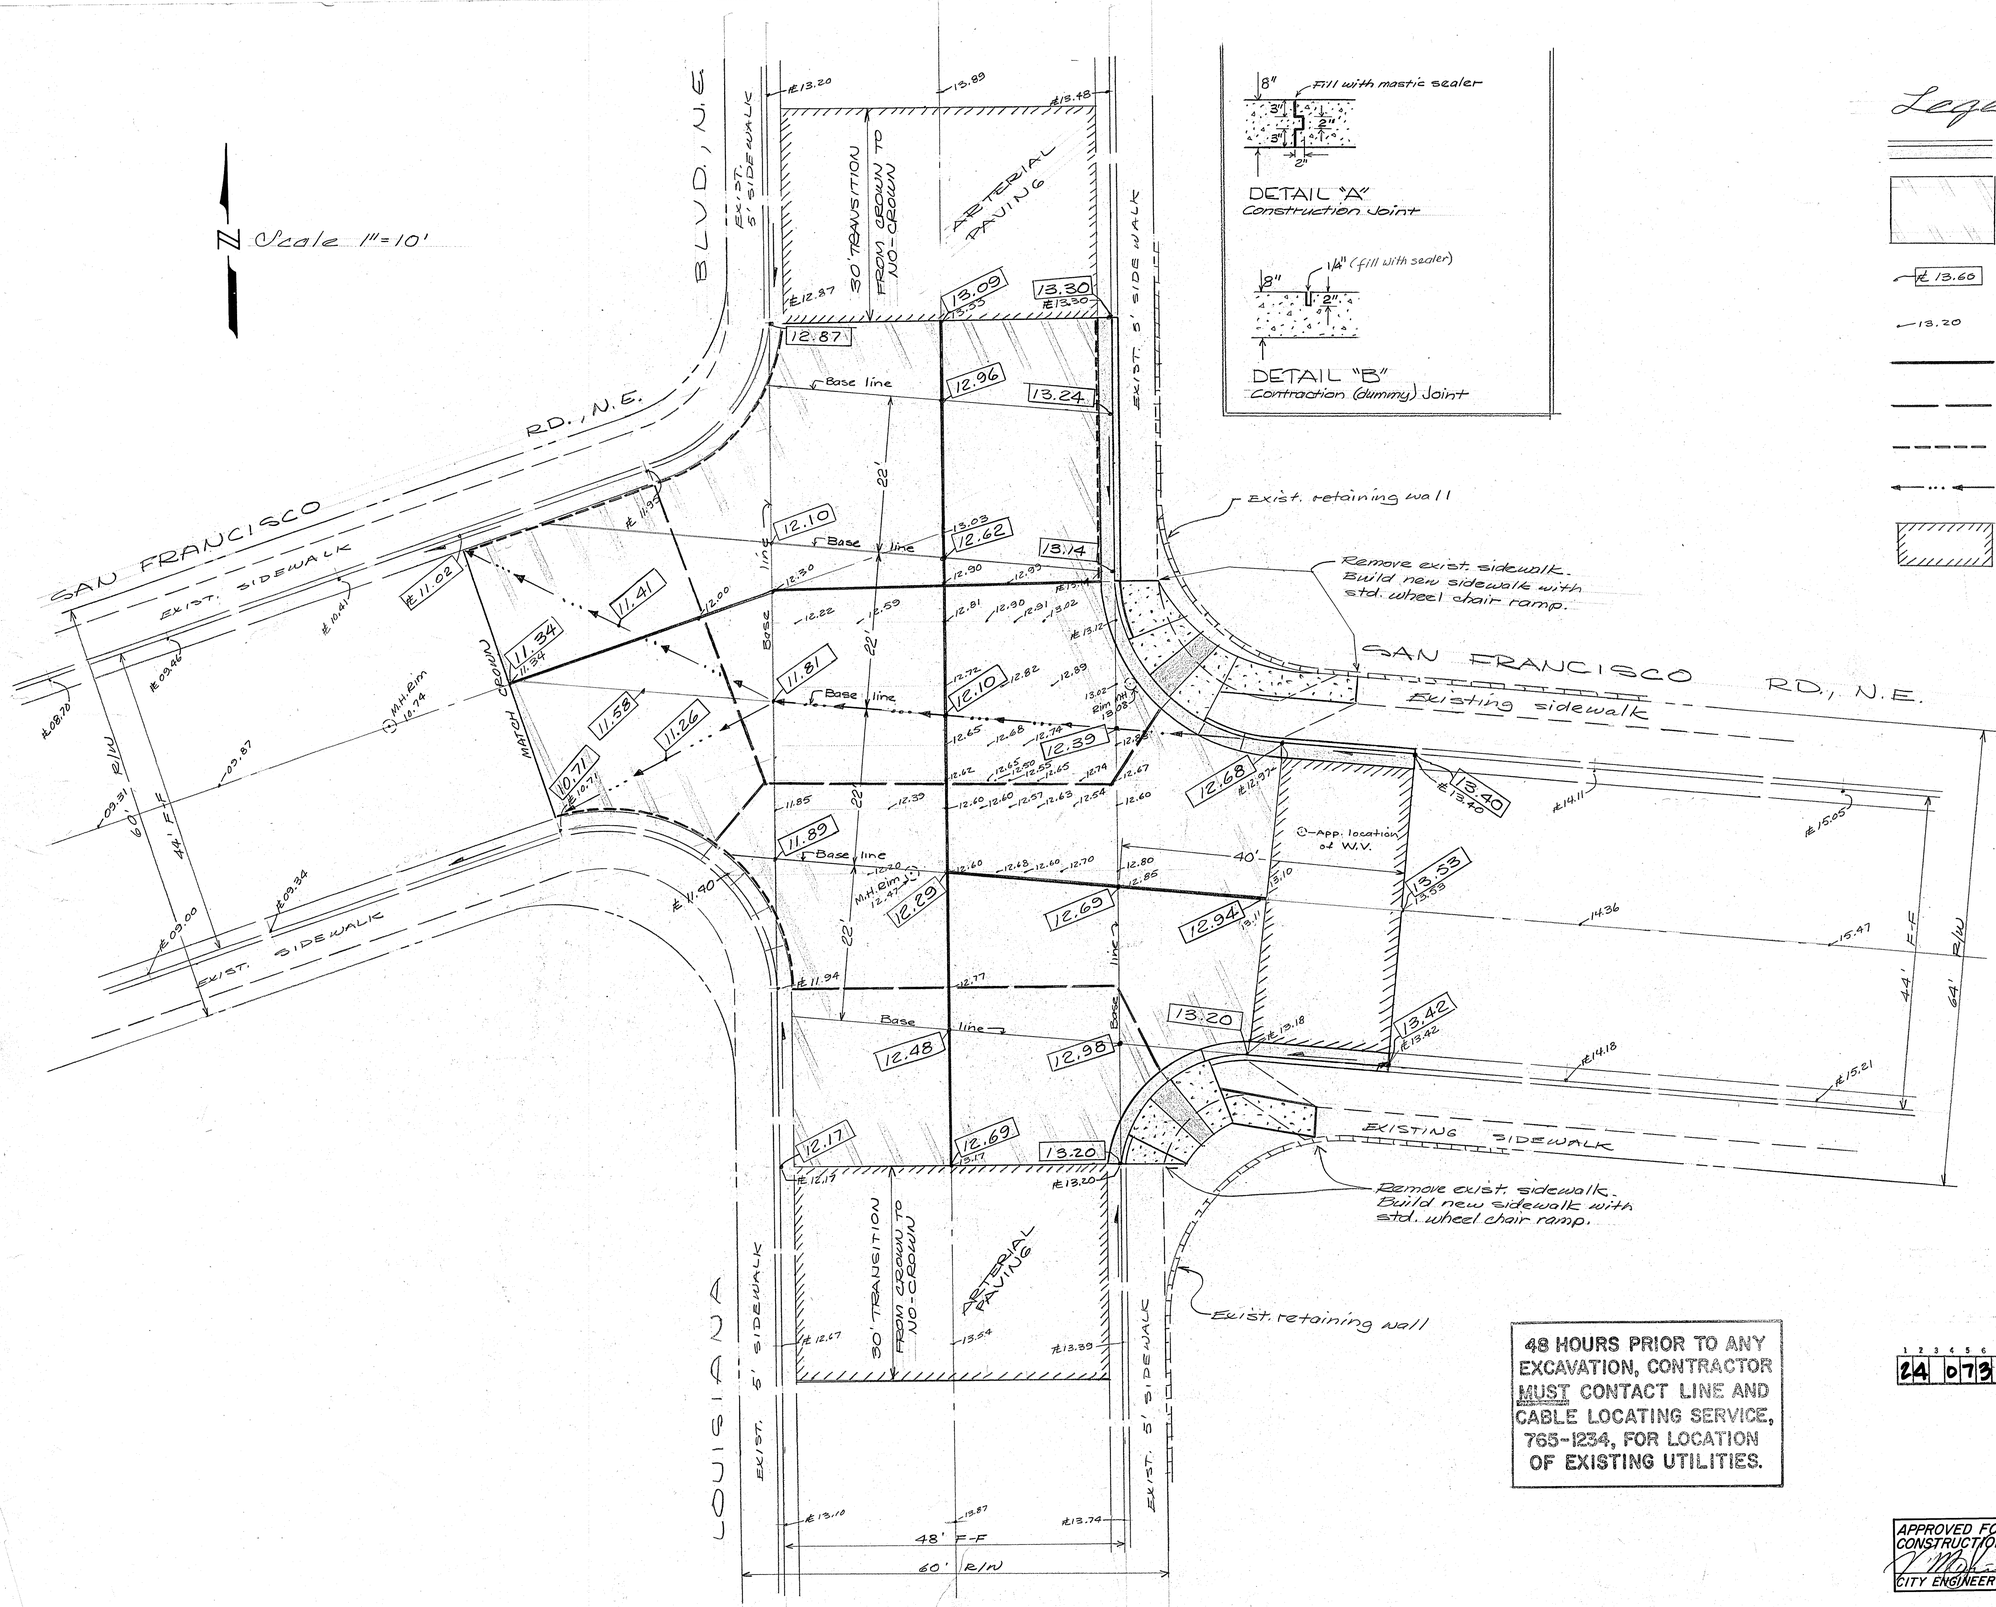

Legend

- Exist. curb and gutter to be removed. Build std. curb & gutter with depressed gutter section.
- Exist. asphalt pavement to be removed. Repave with 8" conc. paving to grades shown.
- ℄ 13.60 — Proposed grade
- 13.20 — Exist. elevation
- Construction joint (Detail "A")
- Contraction (dummy) joint (Detail "B")
- 1/2" Expansion Joint
- Valley
- Remove and replace existing asph. pavement to transition from crown to no-crown.

NOTE:
Existing utilities in:
LOUISIANA –
6" HP gas line 6' E. of W. ℄
16" Water line 10' W. of E. ℄
SAN FRANCISCO EAST –
2" HP 6' N. of S. ℄
6" Water line app. on ℄
SAN FRANCISCO WEST –
4" HP 6' N. of S. ℄
6" Water line 10' N. of ℄
Existing San. Sewer line in San Francisco across Louisiana.

48 HOURS PRIOR TO ANY EXCAVATION, CONTRACTOR MUST CONTACT LINE AND CABLE LOCATING SERVICE, 765-1234, FOR LOCATION OF EXISTING UTILITIES.

APPROVAL OF AS BUILT DRAWINGS
ASST. CITY ENGINEER - FIELD
DATE 11-27-78

1	2	3	4	5	6	7	8	9	10	11	12
24	0	7	3	0	1	7	7				

APPROVED FOR CONSTRUCTION
CITY ENGINEER — DATE 6-22-78

CITY OF ALBUQUERQUE
PUBLIC WORKS DEPARTMENT
ENGINEERING DIVISION

TITLE: INTERSECTION OF LOUISIANA AND SAN FRANCISCO ~ REPAVING

APPROVALS	ENGINEER	DATE	APPROVALS	ENGINEER	DATE
City Engineer		5-9-78	Liquid Waste		
A.C.E.-Design		5-9-78	Traffic		5/2/78
A.C.E.-Hydrology			Water		

DRAWING NO. P-73-77 — SHEET 1 OF 1

REFERENCES: MAP NO. D-18-19 AK; W.O. NO.; EST. NO. P-73-77

NO.	DATE	REMARKS	BY
		REVISIONS	

DESIGNED BY Calvin Tomlinson DATE 8-1-77
DRAWN BY B. EMMETT DATE 7-27-77
CHECKED BY DATE

SURVEY INFORMATION — FIELD NOTES

NO.	BY	DATE
	G. ARCHUNDE	7-15-77

BENCH MARKS: 2-D18 ELEV. 5318.75

AS-BUILT INFORMATION: CONTRACTOR; WORK ACCEPTED BY — DATE; DRAWING CORRECTED BY — DATE

MICRO-FILM INFORMATION: RECORDED BY — DATE; NO.