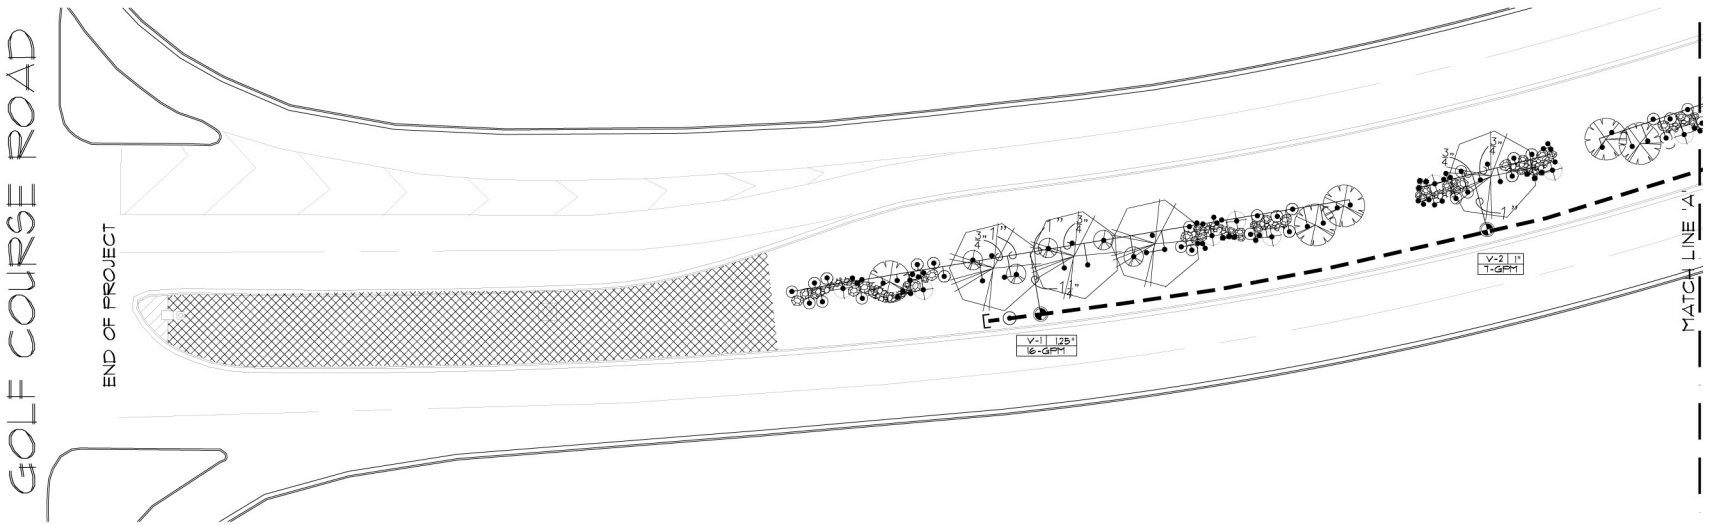

IRRIGATION LEGEND:

- M — 2" WATER METER
- 24-VOLT WIRE SLEEVES, SIZE 2".
- SLEEVE PIPING FOR IRRIGATION MAIN LINE, CLASS 200 SDR-21, SOLVENT WELD PVC.
- 2" IRRIGATION MAIN LINE, SCH 40 BELL END, SOLVENT WELD PVC
- LATERAL PIPING, SCH. 40, BELL END, SOLVENT WELD PVC
- 2" ISOLATION VALVE ASSEMBLY
- FEBCO 825YA 2" REDUCED PRESSURE PRINCIPLE BACKFLOW PREVENTER AND 2" MASTER VALVE ASSEMBLY WITH BALL VALVES
- DOUBLE CHECK VALVE
- REMOTE CONTROL VALVE ASSEMBLY, RAINBIRD PEB PLASTIC BODY 24-VOLT AUTOMATIC VALVE
- 2" AIR RELIEF VALVE.
- SOLVENT WELD CAP, SCH. 40 PVC
- PRESSURE COMPENSATING BUBBLER ASSEMBLIES, RAIN BIRD 1400 SERIES, AS FOLLOWS:

MODEL NO	GPM	PSI
1401	.25	30

- C — IRRINET 32 STATION CONTROLLER WITH INTERSPEC ENCLOSURE AND DOMED ANTENNA

AS-BUILT
1/3/2006
IRRIGATION PLAN

0 10' 20' 30' 50'
SCALE: 1" = 20'

NORTH

AS-BUILT INFORMATION
CONTRACTOR
WORK STAKED BY — DATE
INSPECTED BY — DATE
FIELD CHANGES — DATE
VERIFICATION BY — DATE
REMARKS — DATE 1.03.06
CORRECTED BY: JJG
MICRO-FILM INFORMATION
RECORDED BY — DATE
NO.

BENCH MARKS

SURVEY INFORMATION
FIELD NOTES
NO. | BY | DATE

ARCHITECTURAL SEAL

REVISIONS
NO. | DATE | REMARKS | BY

DESIGNED BY —
DRAWN BY JJG
CHECKED BY
DATE
DATE January 3, 2006
DATE

MORROW REARDON WILKINSON, LTD., LANDSCAPE ARCHITECTS
310 La Veta NE, Albuquerque, NM 87108
505.268.2266 FAX 505.265.9637
mrw@mrwnm.com

CITY OF ALBUQUERQUE
DEPARTMENT OF MUNICIPAL DEVELOPMENT
CAPITAL IMPLEMENTATION PROGRAM DIVISION

PROTOTYPE MEDIAN AND INTERSTATE LANDSCAPES FY04-A
PASEO DEL NORTE: EAGLE RANCH TO GOLF COURSE
IRRIGATION PLAN: WORK ORDER #4

Design Review Committee	City Engineer Approval	Last Design Update	Mo./Day/Yr.	Mo./Day/Yr.

City Project No.	Zone Map No.	Sheet
754503	C12	1 of 5

N:\$Year-2005\3205\3205-acad\3205-PROTO-DAA-754503\3205-WorkorderDrawings\Paseo-Eagle Ranch to Coors\As-BuiltfromLee-01-03-06\paseo_final_as_built3_2006.dwg, Irrig.1, 6/8/2011 4:07:07 PM, atreviso, ARCH3, 1:1.01053

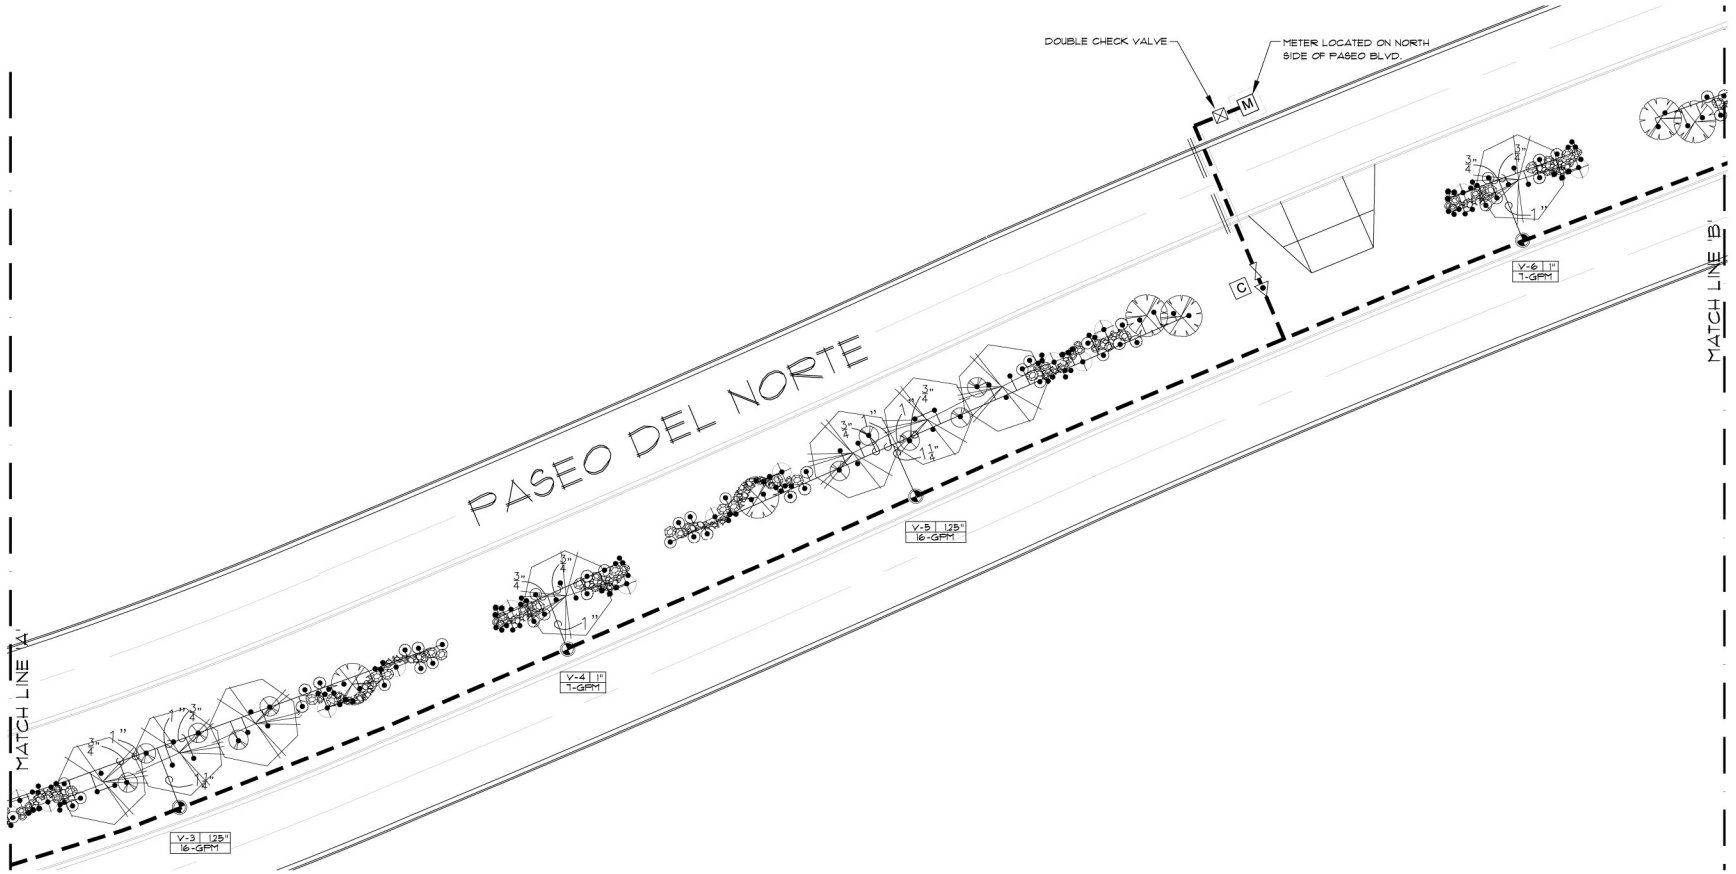

IRRIGATION LEGEND:

- M — 2" WATER METER
- 24-VOLT WIRE SLEEVES, SIZE 2".
- SLEEVE PIPING FOR IRRIGATION MAIN LINE, CLASS 200 SDR-21, SOLVENT WELD PVC.
- 2" IRRIGATION MAIN LINE, SCH 40 BELL END, SOLVENT WELD PVC
- LATERAL PIPING, SCH. 40, BELL END, SOLVENT WELD PVC
- 2" ISOLATION VALVE ASSEMBLY
- FEBCO 825YA 2" REDUCED PRESSURE PRINCIPLE BACKFLOW PREVENTER AND 2" MASTER VALVE ASSEMBLY WITH BALL VALVES
- DOUBLE CHECK VALVE
- REMOTE CONTROL VALVE ASSEMBLY, RAINBIRD PEB PLASTIC BODY 24-VOLT AUTOMATIC VALVE
- 2" AIR RELIEF VALVE.
- SOLVENT WELD CAP, SCH. 40 PVC
- PRESSURE COMPENSATING BUBBLER ASSEMBLIES, RAIN BIRD 1400 SERIES, AS FOLLOWS:

MODEL NO	GPM	PSI
1401	.25	30

- C — IRRINET 32 STATION CONTROLLER WITH INTERSPEC ENCLOSURE AND DOMED ANTENNA

AS-BUILT
1/3/2006
IRRIGATION PLAN

AS-BUILT INFORMATION
CONTRACTOR — DATE
WORK STAKED BY — DATE
INSPECTED BY — DATE
FIELD CHANGES — DATE 1.03.06
CORRECTED BY
MICRO-FILM INFORMATION
RECORDED BY — DATE
NO.

BENCH MARKS

SURVEY INFORMATION
FIELD NOTES
NO. | BY | DATE

ARCHITECTURAL SEAL

REVISIONS
NO. | DATE | REMARKS | BY

0 10' 20' 30' 50'
SCALE: 1" = 20'

NORTH

MORROW REARDON WILKINSON, LTD., LANDSCAPE ARCHITECTS
310 La Veta NE, Albuquerque, NM 87108
505.268.2266 FAX 505.265.9637
mrw@mrwnm.com

DESIGNED BY
DRAWN BY — JJG — DATE January 3, 2006
CHECKED BY — DATE

CITY OF ALBUQUERQUE
DEPARTMENT OF MUNICIPAL DEVELOPMENT
CAPITAL IMPLEMENTATION PROGRAM DIVISION

PROTOTYPE MEDIAN AND INTERSTATE LANDSCAPES FY04-A
PASEO DEL NORTE: EAGLE RANCH TO GOLF COURSE
IRRIGATION PLAN: WORK ORDER #4

Design Review Committee	City Engineer Approval	Last Design Update	Mo./Day/Yr.	Mo./Day/Yr.

City Project No.	Zone Map No.	Sheet
754503	C12	2 of 5

N:\$Year-2005\3205\3205-acad\3205-PROTO-04A-754503\3205-WorkorderDrawings\Paseo-Eagle Ranch to Coors\As-BuiltfromLee-01-03-06\paseo_final_as_built3_2006.dwg, lrig2, 6/8/2011 4:08:32 PM, ahewles, ARCH3, 1:1.01053

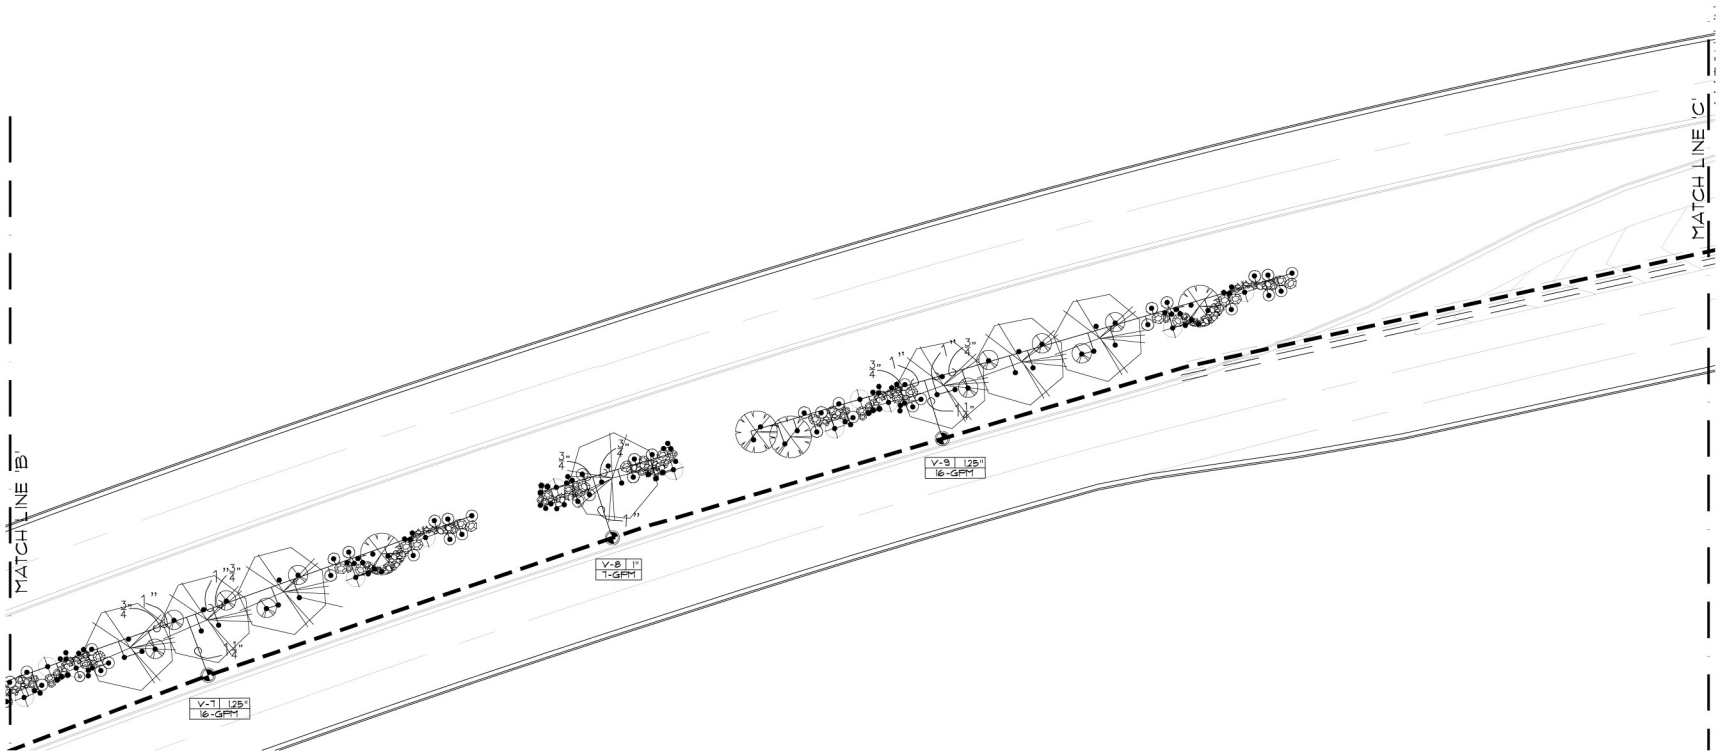

IRRIGATION LEGEND:

- [M] 2" WATER METER
- 24-VOLT WIRE SLEEVES, SIZE 2".
- SLEEVE PIPING FOR IRRIGATION MAIN LINE, CLASS 200 SDR-21, SOLVENT WELD PVC.
- 2" IRRIGATION MAIN LINE, SCH 40 BELL END, SOLVENT WELD PVC
- LATERAL PIPING, SCH. 40, BELL END, SOLVENT WELD PVC
- 2" ISOLATION VALVE ASSEMBLY
- FEBCO 825YA 2" REDUCED PRESSURE PRINCIPLE BACKFLOW PREVENTER AND 2" MASTER VALVE ASSEMBLY WITH BALL VALVES
- DOUBLE CHECK VALVE
- REMOTE CONTROL VALVE ASSEMBLY, RAINBIRD PEB PLASTIC BODY 24-VOLT AUTOMATIC VALVE
- 2" AIR RELIEF VALVE.
- SOLVENT WELD CAP, SCH. 40 PVC
- PRESSURE COMPENSATING BUBBLER ASSEMBLIES, RAIN BIRD 1400 SERIES, AS FOLLOWS:

MODEL NO	GPM	PSI
1401	.25	30

- [C] IRRINET 32 STATION CONTROLLER WITH INTERSPEC ENCLOSURE AND DOMED ANTENNA

AS-BUILT
1/3/2006
IRRIGATION PLAN

SCALE: 1" = 20'

NORTH

MORROW REARDON WILKINSON, LTD., LANDSCAPE ARCHITECTS
310 La Veta NE, Albuquerque, NM 87108
505.268.2266 FAX 505.265.9637
mrw@mrwnm.com

CITY OF ALBUQUERQUE
DEPARTMENT OF MUNICIPAL DEVELOPMENT
CAPITAL IMPLEMENTATION PROGRAM DIVISION

PROTOTYPE MEDIAN AND INTERSTATE LANDSCAPES FY04–A
PASEO DEL NORTE: EAGLE RANCH TO GOLF COURSE
IRRIGATION PLAN: WORK ORDER #4

Design Review Committee	City Engineer Approval	Last Design Update	Mo./Day/Yr.	Mo./Day/Yr.

City Project No.	Zone Map No.	Sheet
754503	C12	3 of 5

AS-BUILT INFORMATION
CONTRACTOR DATE
WORK STARTED BY DATE
RECORDS BY DATE
FIELD INSPECTION BY DATE
VERIFICATION BY DATE
CHANGES CORRECTED BY DATE 1.03.06
MICRO-FILM INFORMATION
RECORDED BY DATE
NO.

BENCH MARKS

SURVEY INFORMATION
FIELD NOTES BY DATE
NO.

ARCHITECTURAL SEAL

REVISIONS
NO. DATE REMARKS BY

DESIGNED BY DATE
DRAWN BY JJG DATE January 3, 2006
CHECKED BY DATE

N:\$Year-2005\3205\3205-acad\3205-PROTO-DAA-754503\3205-WorkorderDrawings\Paseo-Eagle Ranch to Coors\As-BuiltfromLee-01-03-06\paseo_final_as_built3_2006.dwg, irrig3, 6/8/2011 4:26:33 PM, ahewles, ARCH3, 1:1.01053

IRRIGATION LEGEND:

- M — 2" WATER METER
- 24-VOLT WIRE SLEEVES, SIZE 2".
- SLEEVE PIPING FOR IRRIGATION MAIN LINE, CLASS 200 SDR-21, SOLVENT WELD PVC.
- 2" IRRIGATION MAIN LINE, SCH 40 BELL END, SOLVENT WELD PVC
- LATERAL PIPING, SCH. 40, BELL END, SOLVENT WELD PVC
- 2" ISOLATION VALVE ASSEMBLY
- FEBCO 825YA 2" REDUCED PRESSURE PRINCIPLE BACKFLOW PREVENTER AND 2" MASTER VALVE ASSEMBLY WITH BALL VALVES
- DOUBLE CHECK VALVE
- REMOTE CONTROL VALVE ASSEMBLY, RAINBIRD PEB PLASTIC BODY 24-VOLT AUTOMATIC VALVE
- 2" AIR RELIEF VALVE.
- SOLVENT WELD CAP, SCH. 40 PVC
- PRESSURE COMPENSATING BUBBLER ASSEMBLIES, RAIN BIRD 1400 SERIES, AS FOLLOWS:

MODEL NO	GPM	PSI
1401	.25	30

- C — IRRINET 32 STATION CONTROLLER WITH INTERSPEC ENCLOSURE AND DOMED ANTENNA

AS-BUILT
1/3/2006
IRRIGATION PLAN

SCALE: 1" = 20'

NORTH

MORROW REARDON WILKINSON, LTD., LANDSCAPE ARCHITECTS
310 La Vota NE, Albuquerque, NM 87108
505.268.2266 FAX 505.265.3637
mrw@mrwnm.com

CITY OF ALBUQUERQUE
DEPARTMENT OF MUNICIPAL DEVELOPMENT
CAPITAL IMPLEMENTATION PROGRAM DIVISION

PROTOTYPE MEDIAN AND INTERSTATE LANDSCAPES FY04-A
PASEO DEL NORTE: EAGLE RANCH TO GOLF COURSE
IRRIGATION PLAN: WORK ORDER #4

Design Review Committee	City Engineer Approval	Last Design Update	Mo./Day/Yr.	Mo./Day/Yr.

City Project No.	Zone Map No.	Sheet
754503	C12	4 of 5

AS-BUILT INFORMATION
CONTRACTOR
WORK STARTED BY — DATE
WORK COMPLETED BY — DATE
FIELD INSPECTION BY — DATE
ACCEPTANCE BY — DATE
VERIFICATION BY
RECEIVED — DATE: 03.08
CORRECTED BY
MICRO-FILM INFORMATION
RECORDED BY — DATE
NO.

BENCH MARKS

SURVEY INFORMATION
FIELD NOTES BY — DATE
NO.

ARCHITECTURAL SEAL

REVISIONS

NO.	DATE	REMARKS	BY

DESIGNED BY — DATE
DRAWN BY — JJG — DATE January 3, 2006
CHECKED BY — DATE

N:\$Year-2005\3205\3205-acad\3205-PROTO-04A-754503\3205-WorkorderDrawings\Paseo-Eagle Ranch to Coors\As-BuiltfromLee-01-03-06\paseo_final_as_built3_2006.dwg, Irrig.4, 6/8/2011 4:27:19 PM, ahewles, ARCH3, 1:1.01053

IRRIGATION LEGEND:

- M — 2" WATER METER
- = ═══ — 24-VOLT WIRE SLEEVES, SIZE 2".
- ═══ — SLEEVE PIPING FOR IRRIGATION MAIN LINE, CLASS 200 SDR-21, SOLVENT WELD PVC.
- ▬ ▬ ▬ — 2" IRRIGATION MAIN LINE, SCH 40 BELL END, SOLVENT WELD PVC
- ——— — LATERAL PIPING, SCH. 40, BELL END, SOLVENT WELD PVC
- ⋈ — 2" ISOLATION VALVE ASSEMBLY
- FEBCO 825YA 2" REDUCED PRESSURE PRINCIPLE BACKFLOW PREVENTER AND 2" MASTER VALVE ASSEMBLY WITH BALL VALVES
- ☒ — DOUBLE CHECK VALVE
- REMOTE CONTROL VALVE ASSEMBLY, RAINBIRD PEB PLASTIC BODY 24-VOLT AUTOMATIC VALVE
- ⊙ — 2" AIR RELIEF VALVE.
- ⊓ — SOLVENT WELD CAP, SCH. 40 PVC
- • — PRESSURE COMPENSATING BUBBLER ASSEMBLIES, RAIN BIRD 1400 SERIES, AS FOLLOWS:

MODEL NO	GPM	PSI
1401	.25	30

- C — IRRINET 32 STATION CONTROLLER WITH INTERSPEC ENCLOSURE AND DOMED ANTENNA

AS-BUILT
1/3/2006
IRRIGATION PLAN

SCALE: 1" = 20'

NORTH

Lee Scapes

MORROW REARDON WILKINSON, LTD., LANDSCAPE ARCHITECTS
310 La Vota NE, Albuquerque, NM 87108
505.268.2266 FAX 505.265.9637
mrw@mrwnm.com

CITY OF ALBUQUERQUE
DEPARTMENT OF MUNICIPAL DEVELOPMENT
CAPITAL IMPLEMENTATION PROGRAM DIVISION

PROTOTYPE MEDIAN AND INTERSTATE LANDSCAPES FY04-A
PASEO DEL NORTE: EAGLE RANCH TO GOLF COURSE
IRRIGATION PLAN: WORK ORDER #4

Design Review Committee	City Engineer Approval	Last Design Update	Mo./Day/Yr.	Mo./Day/Yr.

City Project No.	Zone Map No.	Sheet
754503	C12	5 of 5

AS-BUILT INFORMATION
CONTRACTOR — DATE
WORK STARTED BY — DATE
ACCEPTANCE BY — DATE
VERIFICATION BY — DATE
REMARKS: — DATE 01.03.06
CORRECTED BY
MICRO-FILM INFORMATION
RECORDED BY — DATE
NO.

BENCH MARKS

SURVEY INFORMATION
FIELD NOTES BY — DATE
NO.

ARCHITECTURAL SEAL

REVISIONS
NO. | DATE | REMARKS | BY

DESIGNED BY — DATE
DRAWN BY JJG DATE January 3, 2006
CHECKED BY — DATE

N:\$Year-2005\3205\3205-acad\3205-PROTO-04A-754503\3205-WorkorderDrawings\Paseo-Eagle Ranch to Coors\As-BuiltfromLee-01-03-06\paseo_final_as_built3_2006.dwg, trig.5, 6/8/2011 4:28:52 PM, ahewles, ARCH1, 1:1.0153