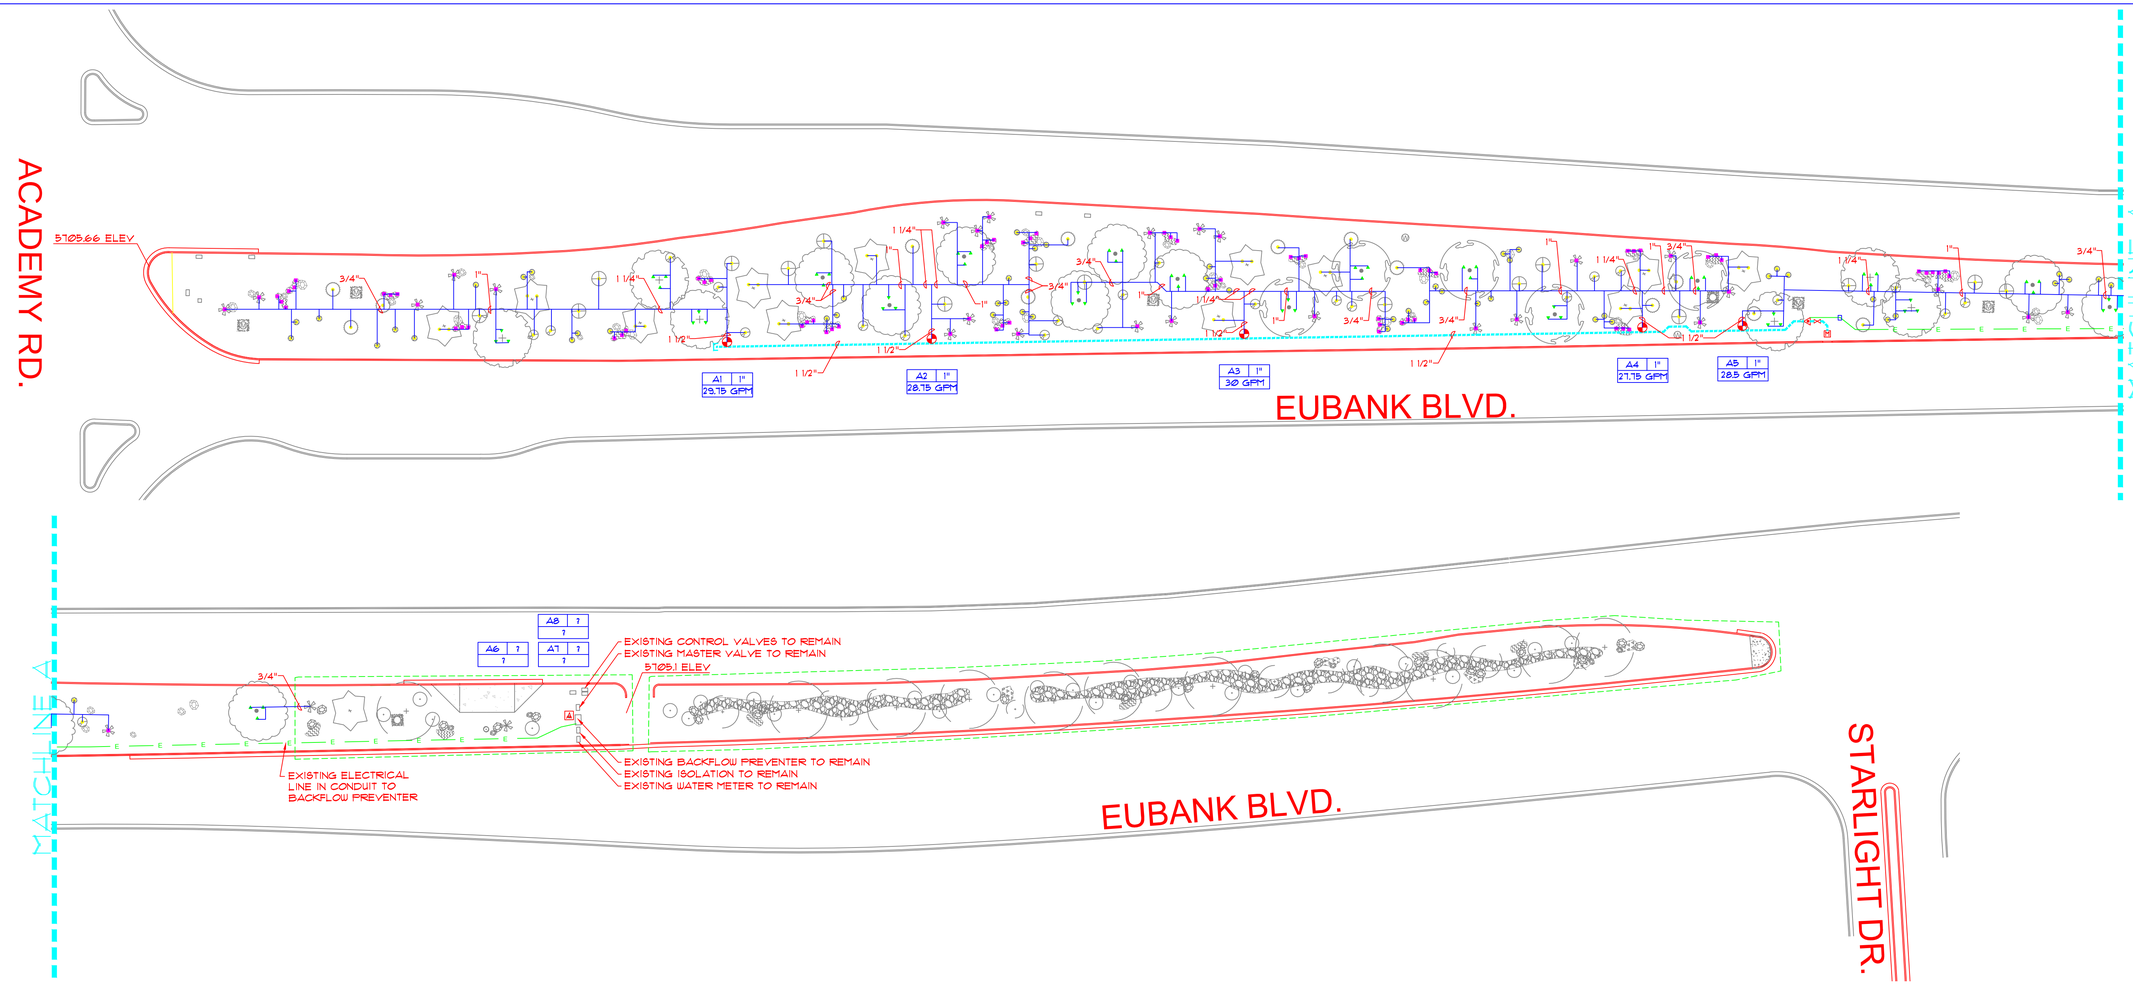

IRRIGATION LEGEND POC #1

- EXISTING 1.5" WATER METER TO REMAIN.
- IRRIGATION MAIN LINE, 1.5", SCH 40 BELL END, SOLVENT WELD PVC. 28" DEPTH OF BURY AT CONSTANT PRESSURE MAINLINE. 18" DEPTH OF BURY AT NON-CONSTANT PRESSURE MAINLINE.
- LATERAL PIPING, SCH. 40, BELL END, SOLVENT WELD PVC. DEPTH OF BURY, 18". SIZE PER PLAN.
- ISOLATION VALVE
- FEBCO 860-U 1.5" REDUCED PRESSURE FRINCIPLE BACKFLOW PREVENTER AND MASTER VALVE ASSEMBLY WITH BALL VALVES, INSTALLED IN HEATED AND INSULATED ENCLOSURE AND FLOW METER INSTALLED IN VALVE BOX PER DETAIL C/4. SIZE OF RP, MASTER VALVE, AND FLOW METER SHALL BE SAME AS LINE SIZE. ENCLOSURE SHALL BE SIZED TO ACCOMMODATE SIZE OF RP AND MASTER VALVE ASSEMBLY.
- REMOTE CONTROL VALVE ASSEMBLY, RAINBIRD PEB PLASTIC BODY. 24-VOLT AUTOMATIC VALVE, SIZE PER PLAN. INSTALL PER C.O.A. DRAWING NO. 2703.

PRESSURE COMPENSATING BUBBLER ASSEMBLIES, RAIN BIRD 1400 SERIES, AS FOLLOWS: INSTALL PER C.O.A. DRAWING NUMBERS 2710, 2711, 2711-A AND 2712.

MODEL NO.	GPM	PSI
1401	.25	30
1402	.50	30
1404	1.0	30

- IRRINET M AC 12 STATION CONTROLLER

0 15' 30' 60' 90'

SCALE: 1" = 30'

AS-BUILT
8/18/2014

Lee Landscapes
5604 Wilshire Ave NE
Albuquerque, NM 87113
(505)822-8722

AS-BUILT INFORMATION

CONTRACTOR	LEE LANDSCAPES,INC.	
WORK STAKED BY		DATE
MAINLINES INSPECTED BY		DATE
ACCEPTANCE BY		DATE
FIELD INFORMATION BY	ML	DATE 8/18/14
DRAWINGS CORRECTED BY		DATE
MICRO-FILM INFORMATION		
RECORDED BY		DATE
NO.		

BENCH MARKS

SURVEY INFORMATION

FIELD NOTES

NO.	BY	DATE

ARCHITECTURAL SEAL

REVISIONS

NO.	DATE	REMARKS	BY

		DATE
DESIGNED BY	ML	5/10/14
DRAWN BY	ML	5/10/14
CHECKED BY	LS	5/10/14

CITY OF ALBUQUERQUE
CAPITAL IMPLEMENTATION PROGRAM
DEPARTMENT OF MUNICIPAL DEVELOPMENT

PROTOTYPE MEDIAN AND INTERSTATE LANDSCAPES FY-14A
EUBANK BLVD: ACADEMY TO ARROYO.
IRRIGATION PLAN: WORK ORDER #1

Design Review Committee	City Engineer Approval	Last Design Update	Mo./Day/Yr.	Mo./Day/Yr.

City Project No.	Zone Map No.	Sheet
785802	E21	1 OF 1