



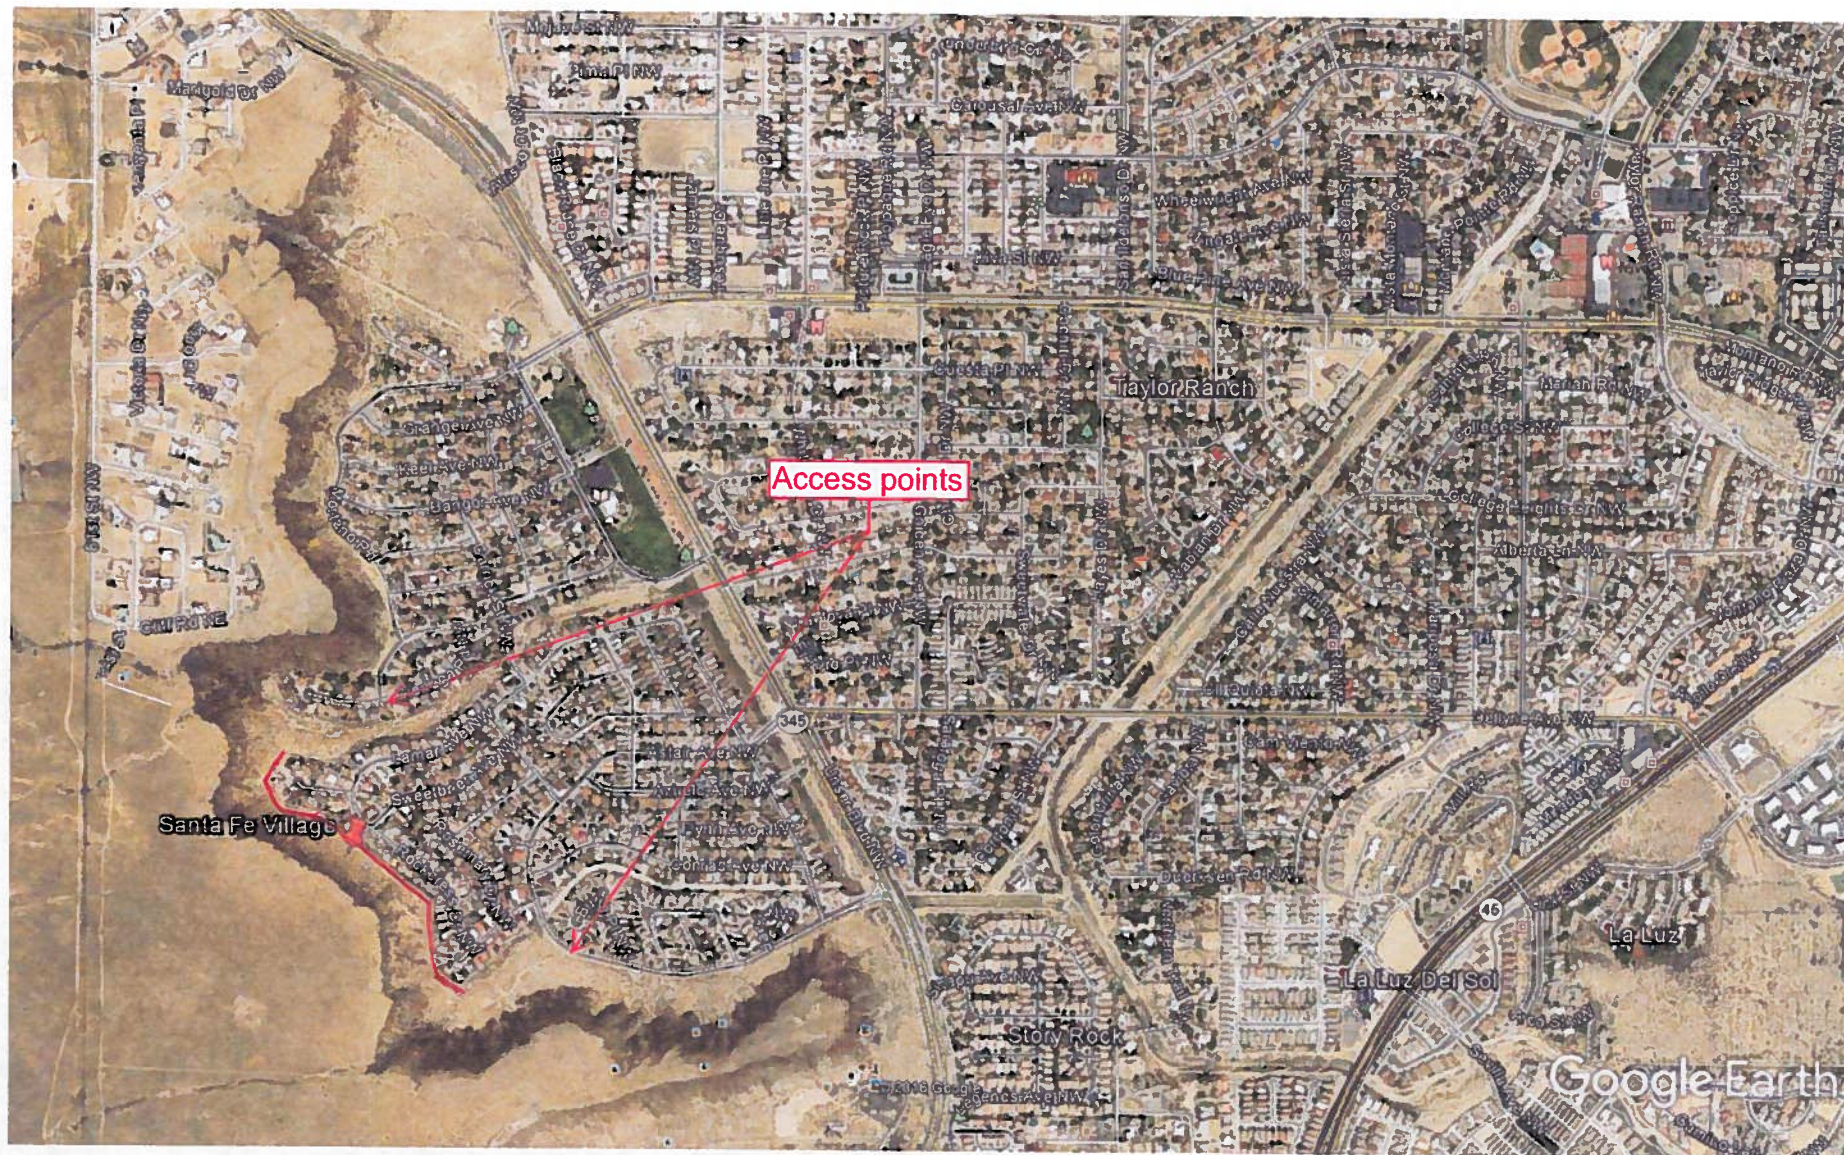

Google Earth

miles
km

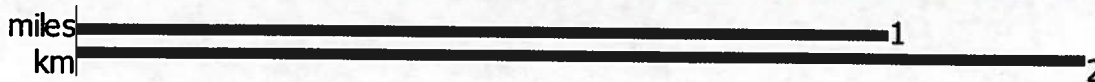



Google Earth



18" FROM EXISTING GROUND

INSTALL NEW SILT FENCE ALONG UPSTREAM SIDE OF HAY BALES.

