




Google Earth

feet
meters

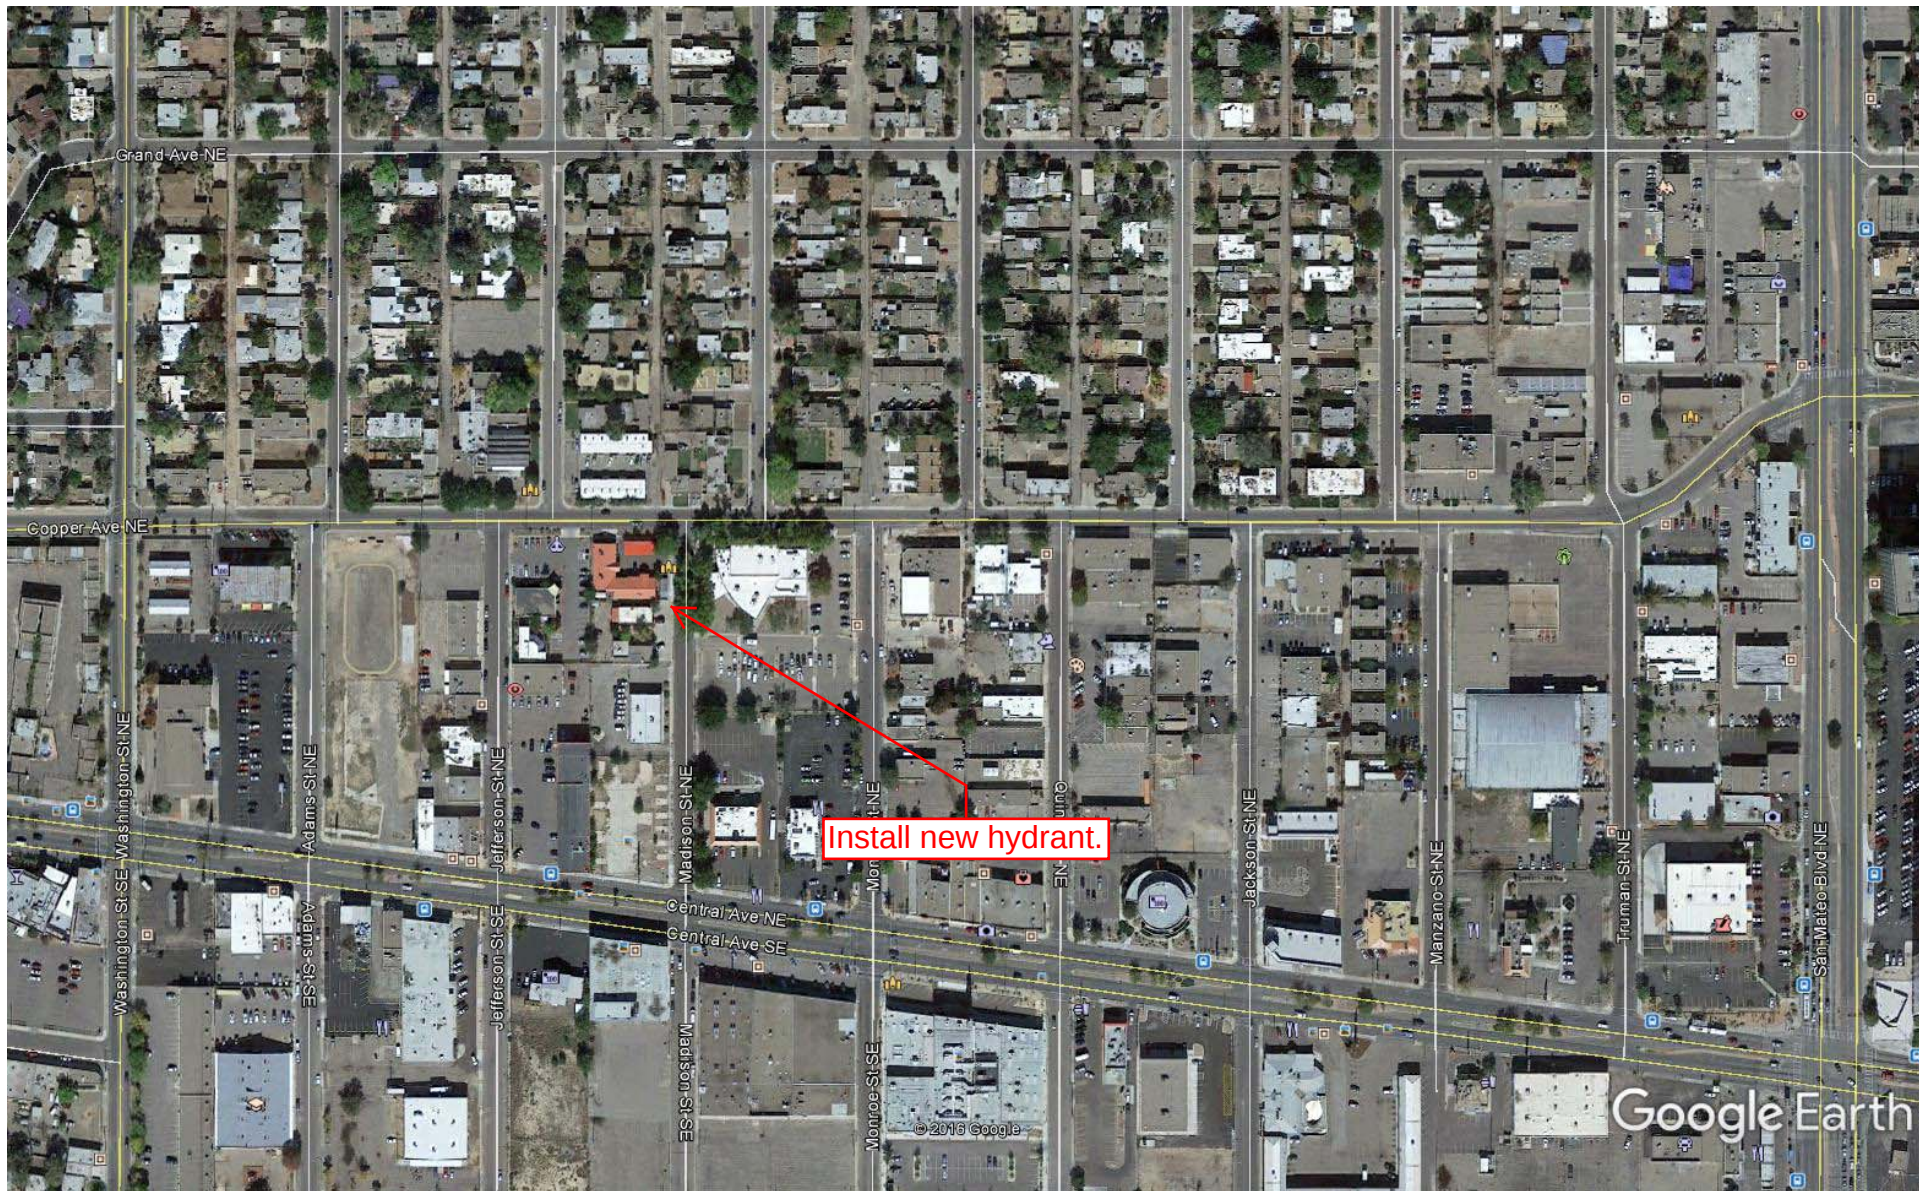



© 2016 Google
© 2016 INEGI
© 2017 Google

Google Earth

feet
meters



Copper

Install New Fire
Hydrant.

