

GENERAL NOTES:

1. CONSTRUCT CONCRETE WALL BARRIER WITHOUT EXTERIOR PATTERN. MATCH EXISTING COLOR. SEE DETAIL ON SHEET 3-3. LAYOUT NORTHING AND EASTING ARE TO THE BASE OF THE WALL.
2. CONSTRUCT CURB AND GUTTER PER COA STANDARD DRAWING 2415.
3. CUT AND CAP EXISTING IRRIGATION LINES. WORK SHALL BE CONSIDERED INCIDENTAL TO CONSTRUCTION.

LEGEND:

- | | |
|--|------------------------------|
| | EXISTING R.O.W |
| | EXISTING RAILROAD R.O.W |
| | EXISTING PROPERTY LINE |
| | EXISTING METAL FENCE |
| | EXISTING STORM DRAIN PIPE |
| | EXISTING UNDER GRND ELECTRIC |
| | EXISTING SANITARY SEWER LINE |
| | EXISTING WATER LINE |
| | EXISTING FIBER OPTIC LINE |
| | EXISTING NATURAL GAS LINE |

EXISTING LIGHT

E

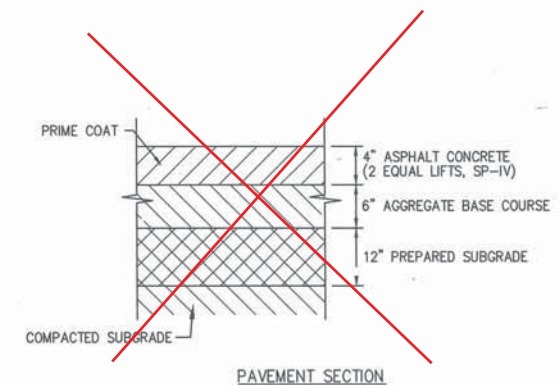
EXISTING GRADE

10

FINISH GRADE

☐

NEW PAVEMENT AREA

[illegible]

GRAPHIC SCALE

(IN FEET)
1 inch = 10 ft.