




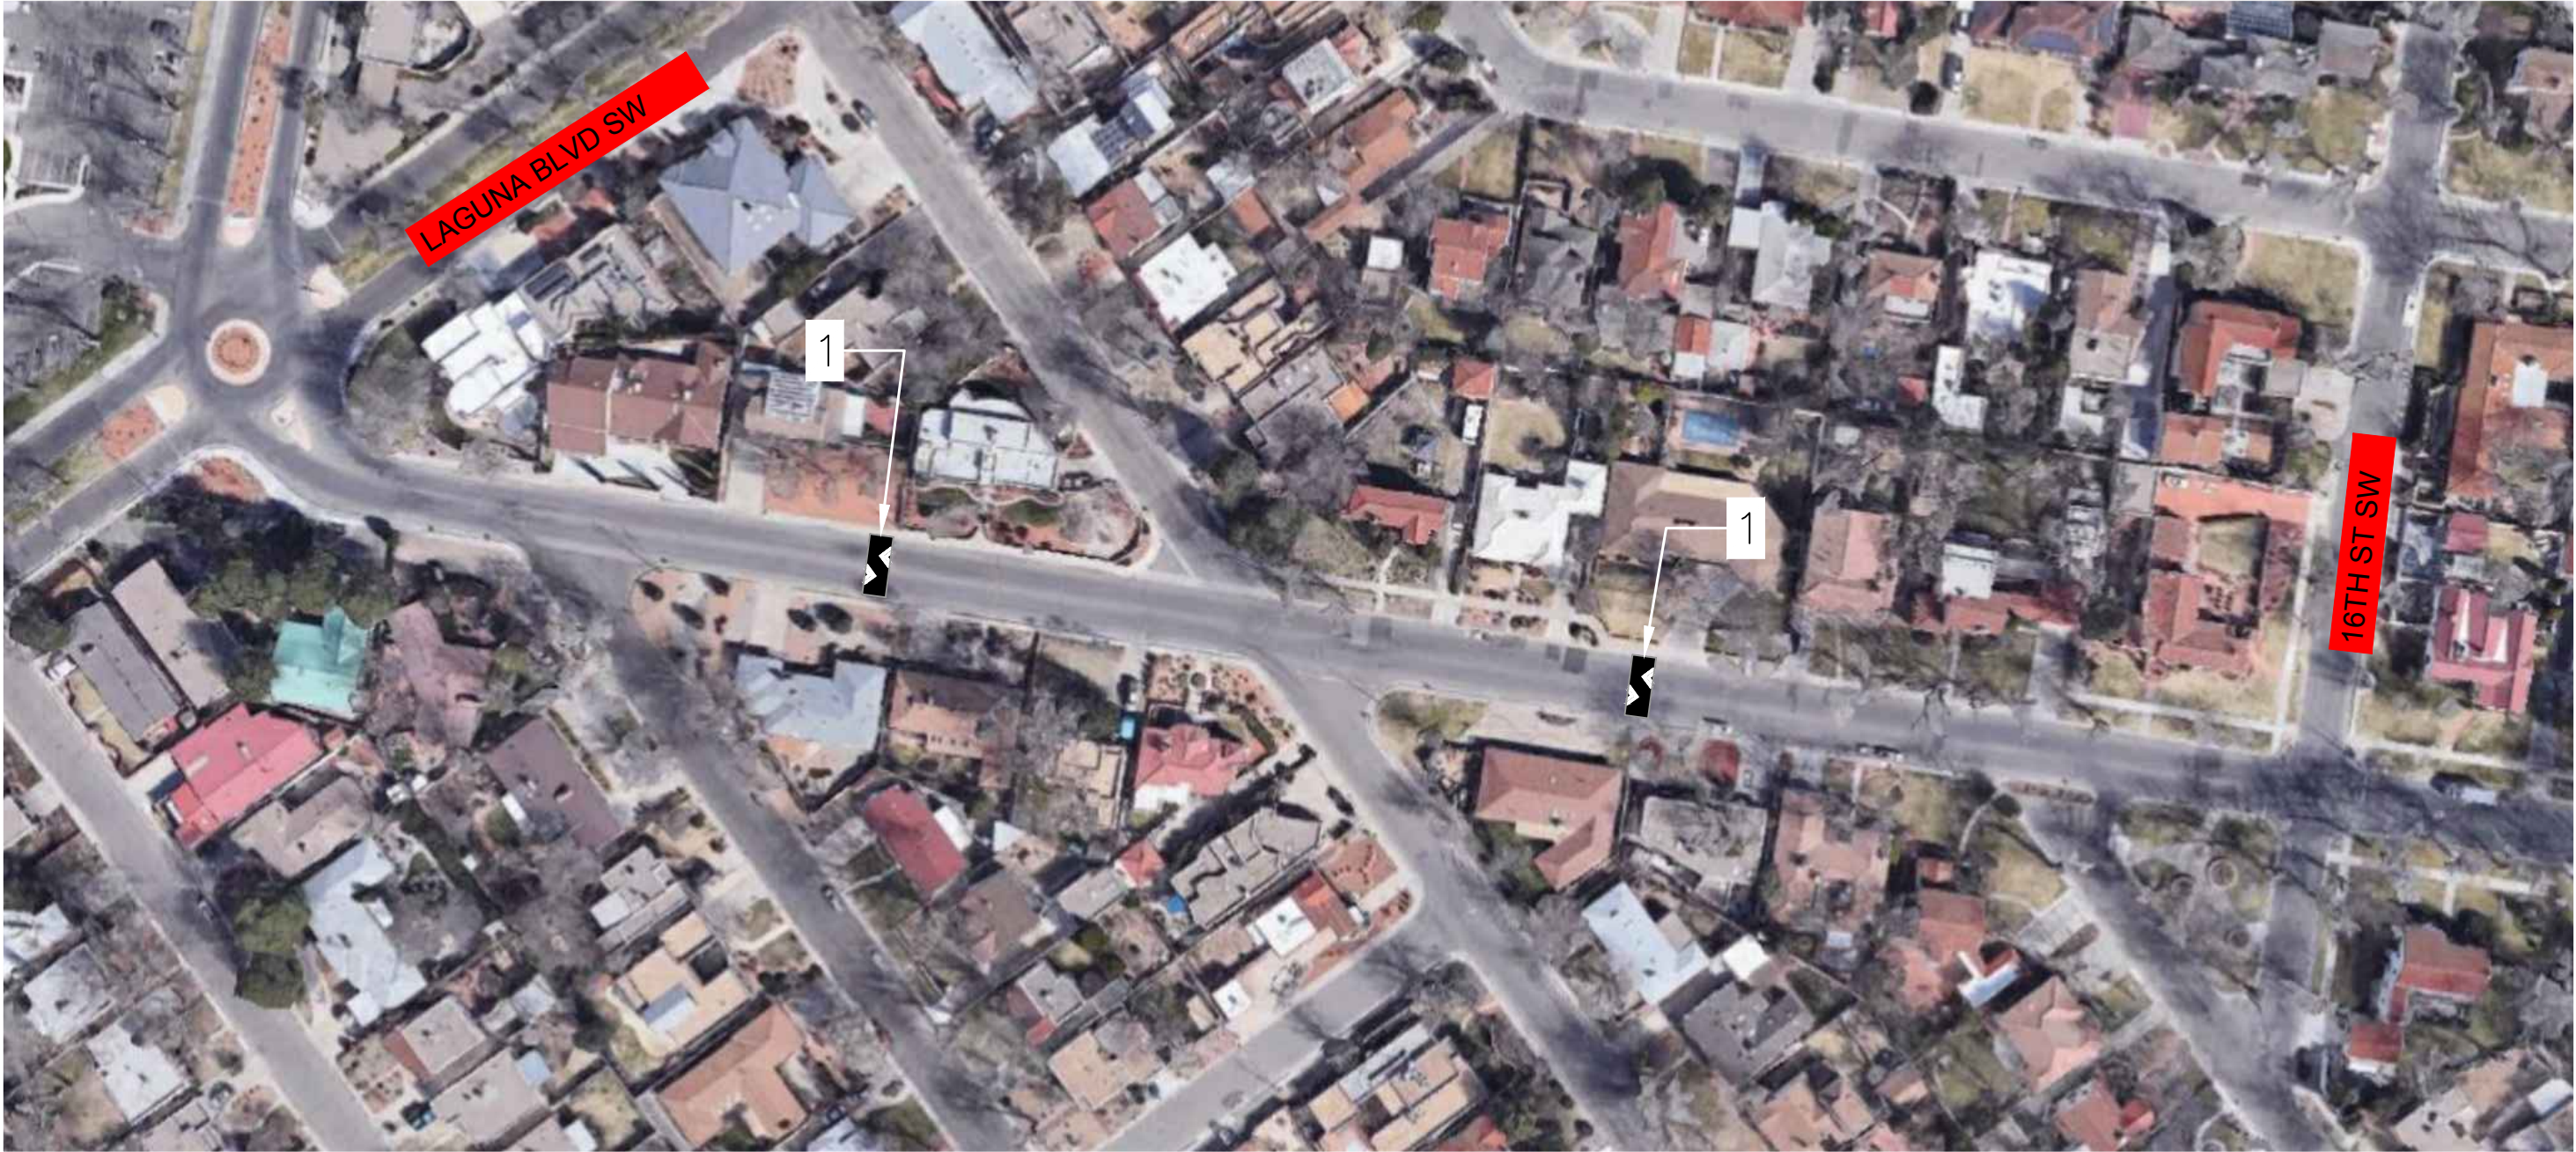
SCALE: 1'=100'

KEYED NOTES:

- 1. REMOVE EXISTING SPEED HUMP



CITY OF ALBUQUERQUE DEPARTMENT OF MUNICIPAL DEVELOPMENT ENGINEERING DIVISION			
TITLE: PARK AVENUE SPEED HUMPS REMOVALS			
NOT FOR CONSTRUCTION	DESIGNED BY: D. DAVIDSON		LAST DESIGN UPDATE
	REVIEWED BY:		
City Project No. 569694	Zone Map No. K13	Sheet 1	Of 3




SCALE: 1'=100'

KEYED NOTES:

- 1. REMOVE EXISTING SPEED HUMP




CITY OF ALBUQUERQUE DEPARTMENT OF MUNICIPAL DEVELOPMENT ENGINEERING DIVISION				
TITLE: PARK AVENUE SPEED HUMPS REMOVALS				
NOT FOR CONSTRUCTION	DESIGNED BY: D. DAVIDSON		LAST DESIGN UPDATE	Mo./Day/Yr. 6/12/19
	REVIEWED BY:			
City Project No.	Zone Map No. K13	Sheet 1	Of 3	





SCALE: 1"=100'

KEYED NOTES:

- 1. INSTALL TYPE A SPEED HUMPS PER DETAIL ON SHEET 3/3
- 2. INSTALL W17-1 SPEED HUMPS SIGN SEE DETAIL ON SHEET 3/3

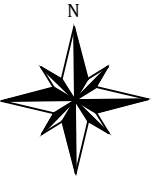

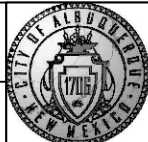CITY OF ALBUQUERQUE DEPARTMENT OF MUNICIPAL DEVELOPMENT ENGINEERING DIVISION			
TITLE: PARK AVENUE SPEED HUMPS IMPROVEMENTS			
NOT FOR CONSTRUCTION	DESIGNED BY: D. DAVIDSON		LAST DESIGN UPDATE
	REVIEWED BY:		
City Project No.	Zone Map No. K13	Sheet 2	Of 3

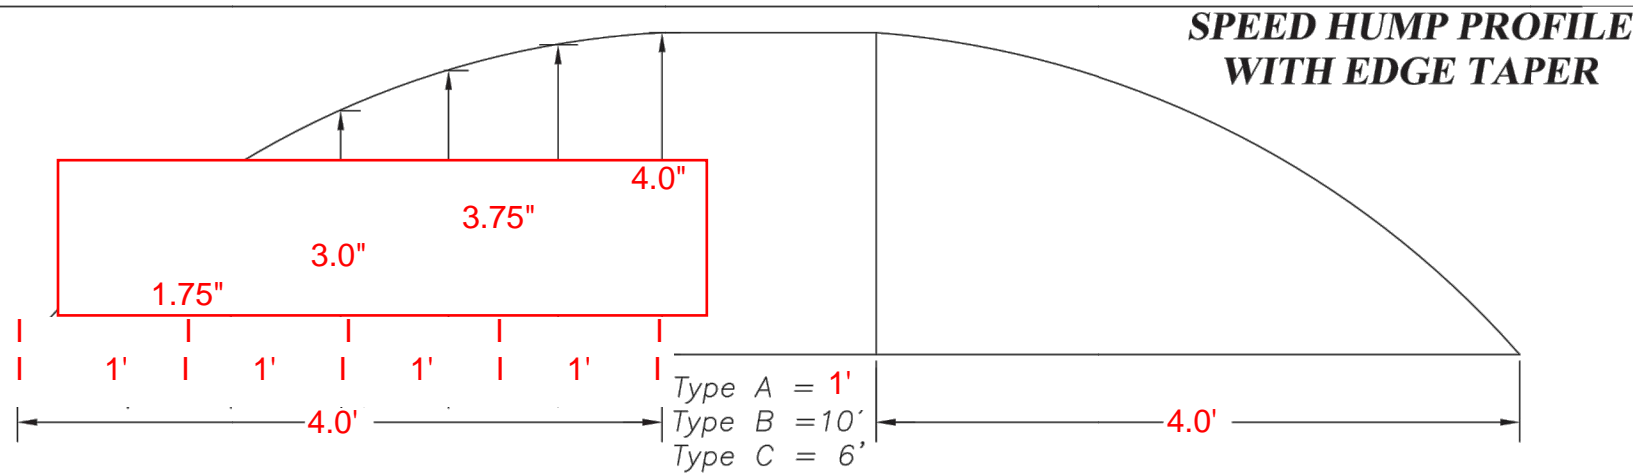


Construction Note: Typical residential street speed hump is Type A. If demolishing and rehabilitating, match existing.

Exaggerated Vertical


Actual



W17-1
24X24

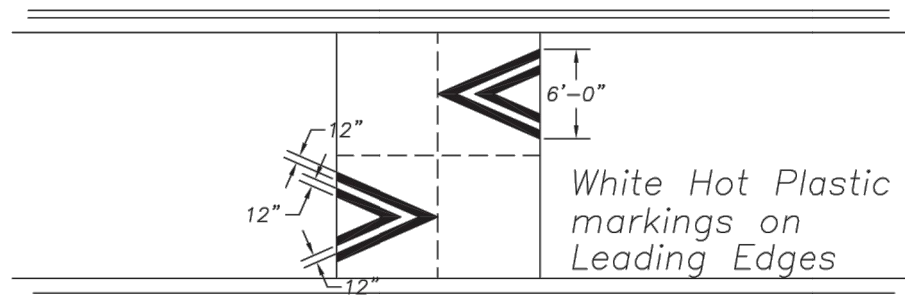

Marking Plan— Not To Scale

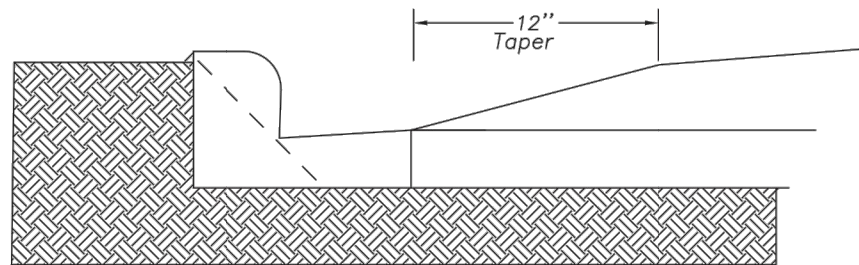


Curb Treatment Not To Scale

City of Albuquerque Public Works Department, Traffic Engineering Operations			
Title: Speed Hump Profile, w/ Edge Taper			
Location:			
Date: August 2003		By: Leonard Brown	
Scale: none	Sheet: 1 of 1	Zone:	Quadrant:




CITY OF ALBUQUERQUE DEPARTMENT OF MUNICIPAL DEVELOPMENT ENGINEERING DIVISION		
TITLE: PARK AVENUE SPEED HUMPS DETAILS		
NOT FOR CONSTRUCTION	DESIGNED BY: D. DAVIDSON	Mo./Day/Yr. 6/12/19
	REVIEWED BY:	
City Project No.	Zone Map No. K13	Sheet 3
		Of 3

A photograph of a residential street intersection. The foreground shows a newly paved asphalt area with white directional arrows painted on it, pointing towards the intersection. The street continues into the background where a white semi-truck and a dark car are visible. The area is lined with trees and houses under a clear blue sky.

Work was
constructed per
details provided on
previous pages.

FOR
INFORMATION
ONLY

09/30/2019 11:25

A photograph of a residential street lined with mature trees. A white car is parked on the right side of the road. The road surface is asphalt, and there are blue painted markings on it. The scene is captured on a clear day with bright sunlight.

Work was
constructed per
details provided on
previous pages.

FOR
INFORMATION
ONLY


09/30/2019 11:18




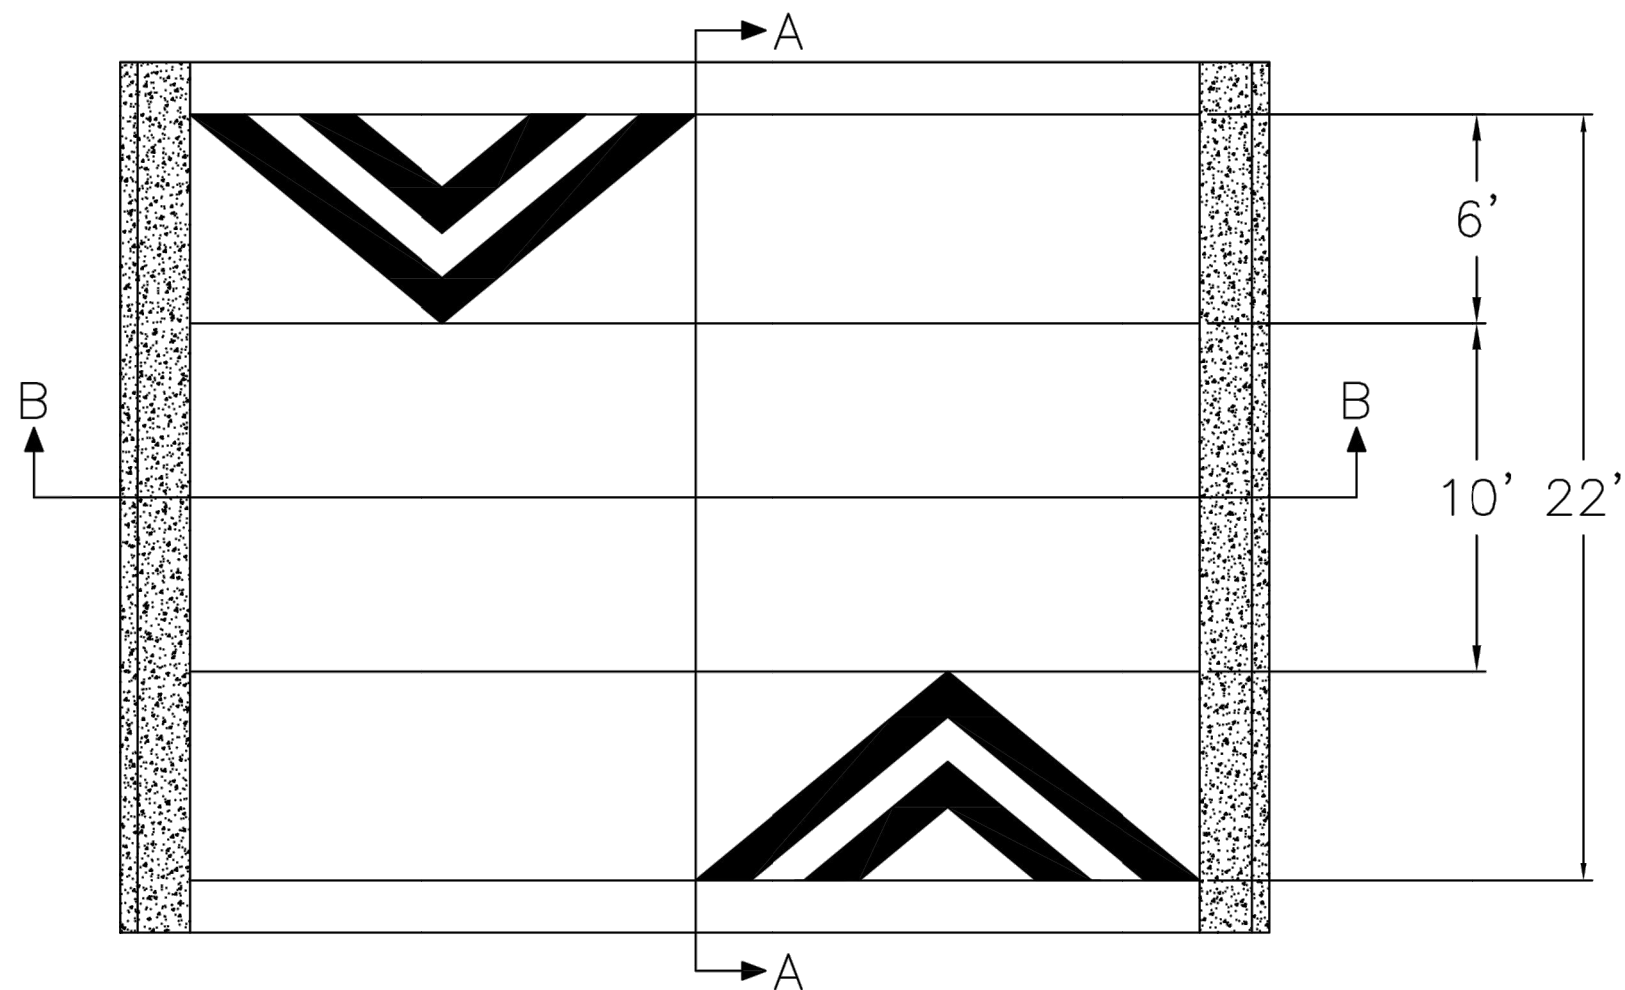
SCALE: 1"=100'

KEYED NOTES:


- 1. INSTALL SPEED TABLE PER DETAIL ON SHEET 3/3
- 2. INSTALL W17-1 SPEED HUMP SIGN SEE DETAIL ON SHEET 3/3

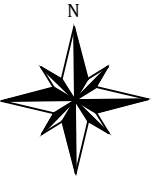


CITY OF ALBUQUERQUE DEPARTMENT OF MUNICIPAL DEVELOPMENT ENGINEERING DIVISION			
TITLE: PARK AVENUE SPEED HUMPS IMPROVEMENTS			
NOT FOR CONSTRUCTION	DESIGNED BY: D. DAVIDSON		LAST DESIGN UPDATE
	REVIEWED BY:		
City Project No. 569694	Zone Map No. K13	Sheet 2	Of 3



Section B-B

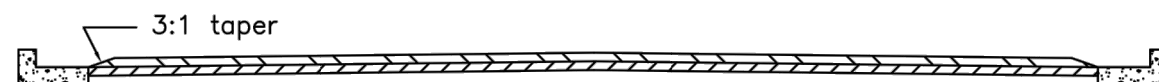


Section A-A

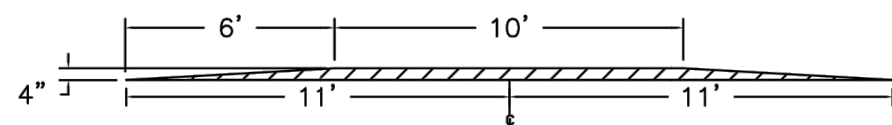


CITY OF ALBUQUERQUE		
DEPARTMENT OF MUNICIPAL DEVELOPMENT		
TRAFFIC ENGINEERING DIVISION		
INFRASTRUCTURE	DESIGNED BY:	T.J.B.
	DRAWN BY:	T.J.B.
	CHECKED BY:	
	APPROVED BY:	
22' SPEED HUMP PROFILE AND CROSS SECTION	DATE:	7/12/13
	ENGINEER'S PROJECT NO.:	SHEET NO.: 1 of 1
SCALE: NTS		



W17-1
24X24

CITY OF ALBUQUERQUE DEPARTMENT OF MUNICIPAL DEVELOPMENT ENGINEERING DIVISION					
TITLE: PARK AVENUE SPEED HUMPS DETAILS					
NOT FOR CONSTRUCTION		DESIGNED BY: D. DAVIDSON			LAST DESIGN UPDATE Mo./Day/Yr. 8/2/19
		REVIEWED BY:			
City Project No. 569694		Zone Map No. K13		Sheet 3 Of 3	

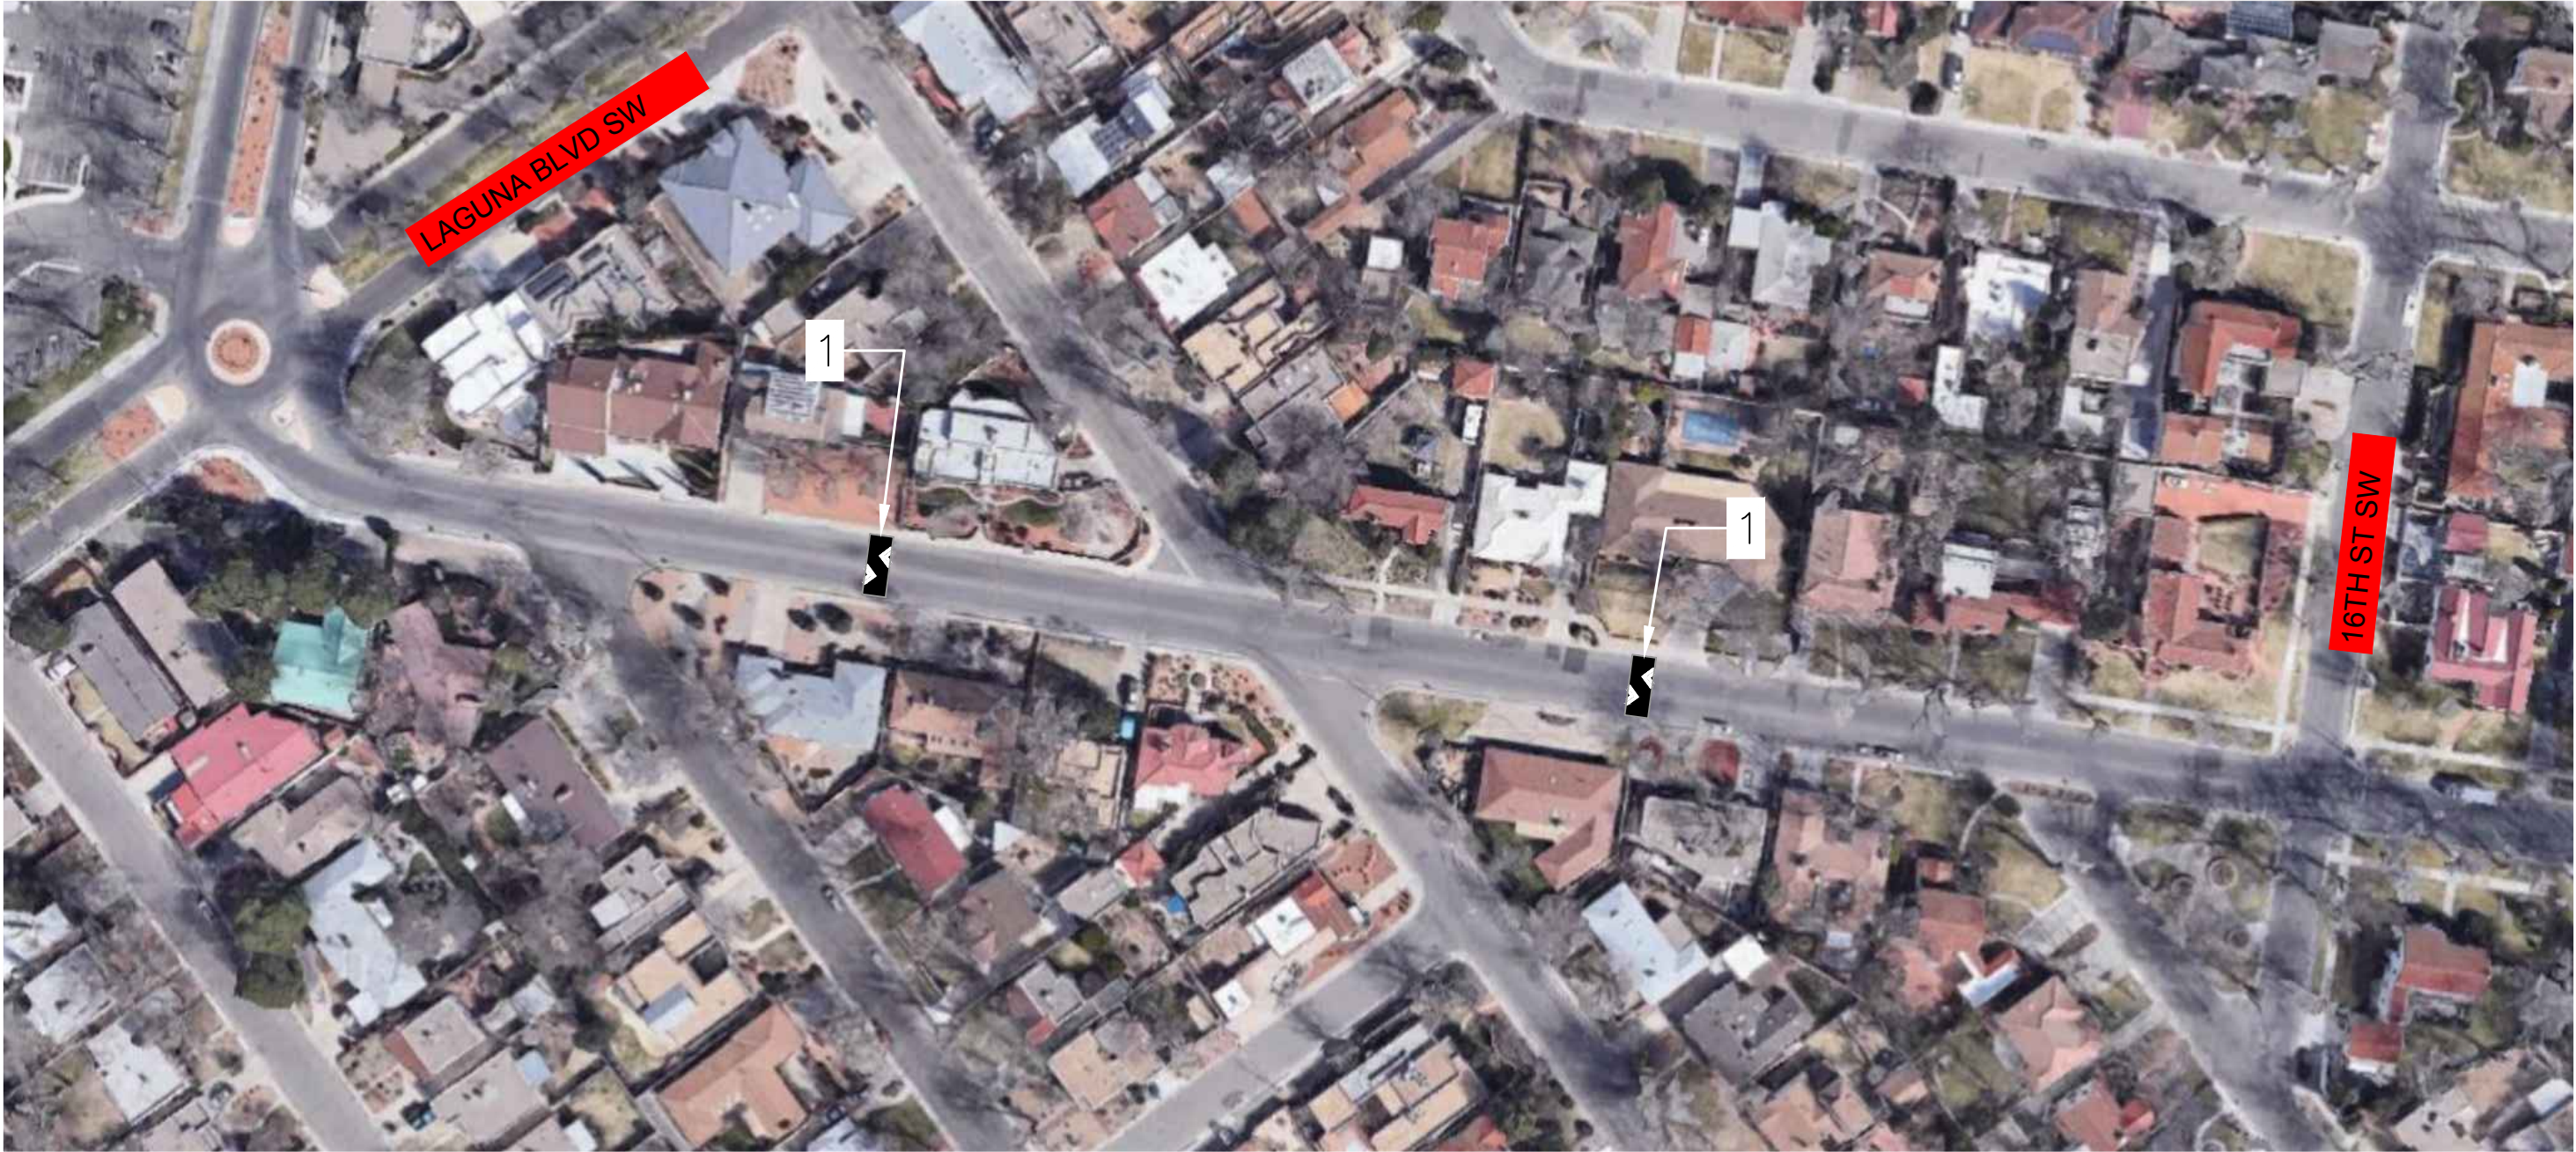


SCALE: 1"=100'

KEYED NOTES:

- 1. REMOVE EXISTING SPEED HUMP




CITY OF ALBUQUERQUE DEPARTMENT OF MUNICIPAL DEVELOPMENT ENGINEERING DIVISION			
TITLE: PARK AVENUE SPEED HUMPS REMOVALS			
NOT FOR CONSTRUCTION	DESIGNED BY: D. DAVIDSON		LAST DESIGN UPDATE
	REVIEWED BY:		
City Project No.	Zone Map No. K13	Sheet 1	Of 3





SCALE: 1"=100'

KEYED NOTES:

1. INSTALL TYPE A SPEED HUMPS PER DETAIL ON SHEET 3/3
2. INSTALL W17-1 SPEED HUMPS SIGN SEE DETAIL ON SHEET 3/3

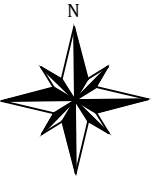

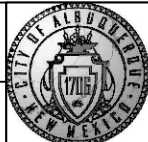
CITY OF ALBUQUERQUE DEPARTMENT OF MUNICIPAL DEVELOPMENT ENGINEERING DIVISION			
TITLE: PARK AVENUE SPEED HUMPS IMPROVEMENTS			
NOT FOR CONSTRUCTION	DESIGNED BY: D. DAVIDSON		LAST DESIGN UPDATE
	REVIEWED BY:		
City Project No.	Zone Map No. K13	Sheet 2	Of 3

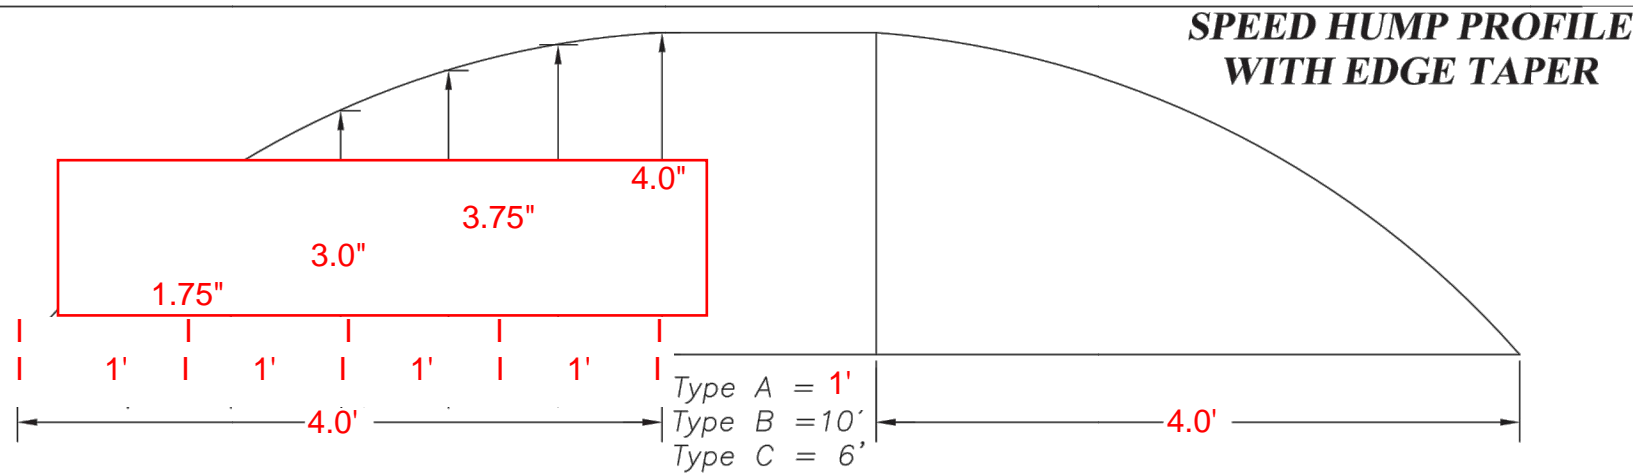


Construction Note: Typical residential street speed hump is Type A. If demolishing and rehabilitating, match existing.



W17-1
24X24

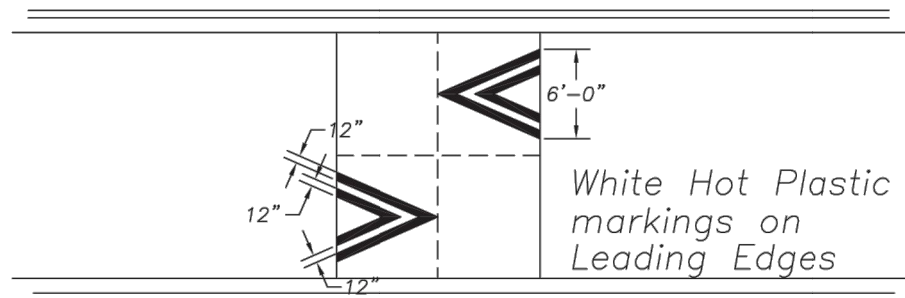


Marking Plan— Not To Scale

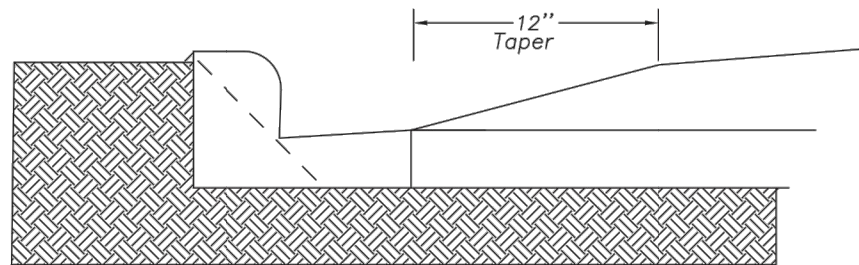

Curb Treatment Not To Scale

City of Albuquerque Public Works Department, Traffic Engineering Operations			
Title: Speed Hump Profile, w/ Edge Taper			
Location:			
Date: August 2003	By: Leonard Brown		
Scale: none	Sheet: 1 of 1	Zone:	Quadrant:




CITY OF ALBUQUERQUE DEPARTMENT OF MUNICIPAL DEVELOPMENT ENGINEERING DIVISION		
TITLE: PARK AVENUE SPEED HUMPS DETAILS		
NOT FOR CONSTRUCTION	DESIGNED BY: D. DAVIDSON	LAST DESIGN UPDATE Mo./Day/Yr. 6/12/19
	REVIEWED BY:	
City Project No.	Zone Map No. K13	Sheet 3 Of 3

Work was
constructed per
details provided on
previous pages.

FOR
INFORMATION
ONLY

09/30/2019 11:25



Work was
constructed per
details provided on
previous pages.

FOR
INFORMATION
ONLY

09/30/2019 11:18