

Elena Dr

Install (2) 30" W17-1
SPEED HUMP signs
per MUTCD

270'

500'

640'

Balloon Fiesta Pkwy

640'

175'

Construct eight (8) new 4"H x 9' L speed humps,
four (4) in each direction, per attached detail.
Dimensions shown are distances between speed
humps and/or ends of medians. Adjust locations as
required to avoid existing drive pads, turn lanes
and/or drainage features.

San Mateo Blvd NE


Pasadena Ave

Pan American Frontage Rd S


Google Earth

© 2020 Google

Go

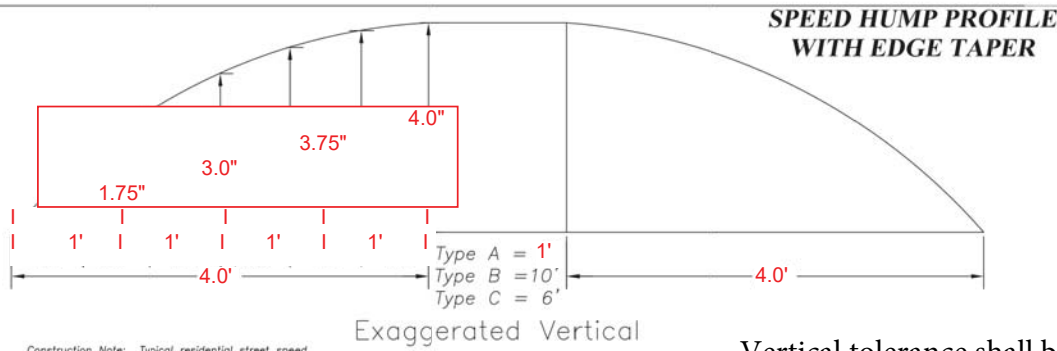


Construction Note: Typical residential street speed hump is Type A. If demolishing and rehabilitating, match existing.

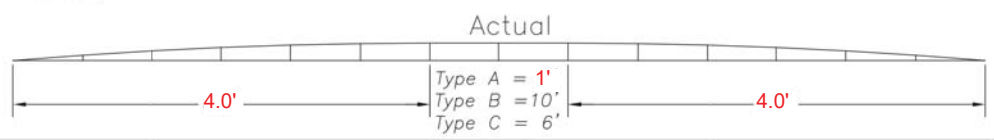


W17-1
24X24

Sign dimension to be 30" x 30" for collector streets.

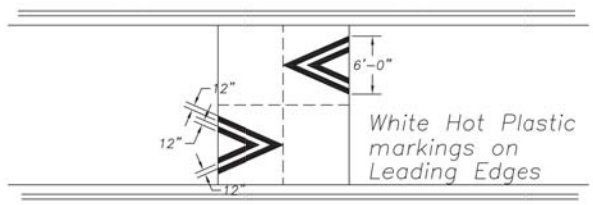


Marking Plan— Not To Scale

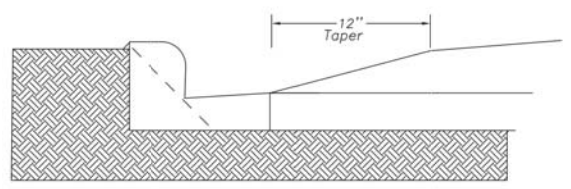

Curb Treatment Not To Scale

City of Albuquerque			
Public Works Department, Traffic Engineering Operations			
Title: Speed Hump Profile, w/ Edge Taper			
Location:			
Date: August 2003	By: Leonard Brown		
Scale: none	Sheet: 1 of 1	Zone:	Quadrant:



CITY OF ALBUQUERQUE DEPARTMENT OF MUNICIPAL DEVELOPMENT ENGINEERING DIVISION				
TITLE: PARK AVENUE SPEED HUMPS DETAILS				
NOT FOR CONSTRUCTION	DESIGNED BY: D. DAVIDSON		LAST DESIGN UPDATE	Mo./Day/Yr.
	REVIEWED BY:			6/12/19
City Project No.	Zone Map No. K13	Sheet 3	Of 3	