
UNSER BOULEVARD AT GWIN ROAD CUT-THROUGH REDUCTION: SCHEMATIC OPTIONS

OPTION 1

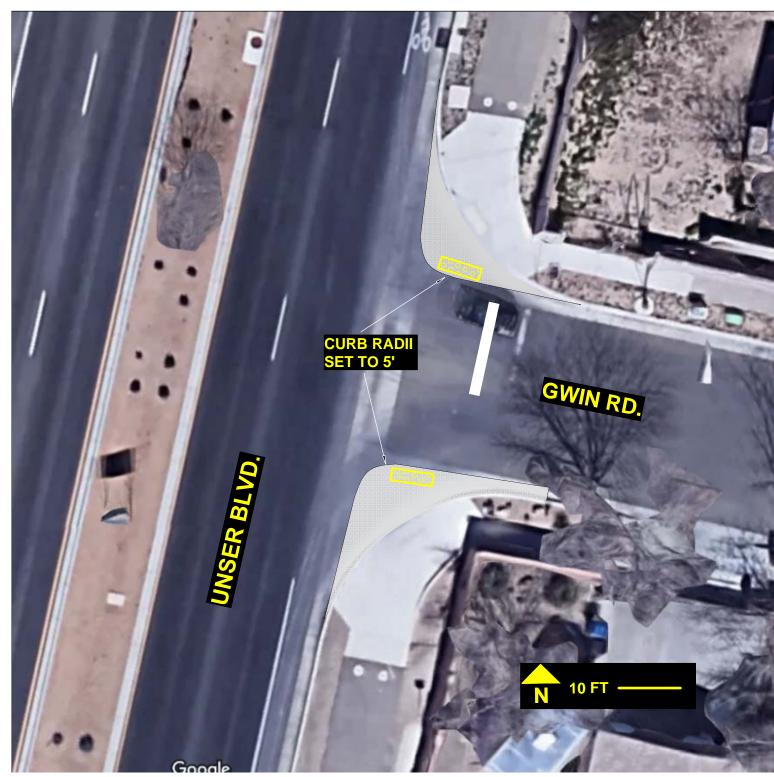

OPTION 2



NOTES

- 1. Option 1 tightens existing curb radii to 5' and relocates detectable warning surfaces to slow down drivers entering Gwin Road.
- 2. Option 2 prohibits motorists from entering Gwin Road from Unser Boulevard, allowing only right-turn exits.