


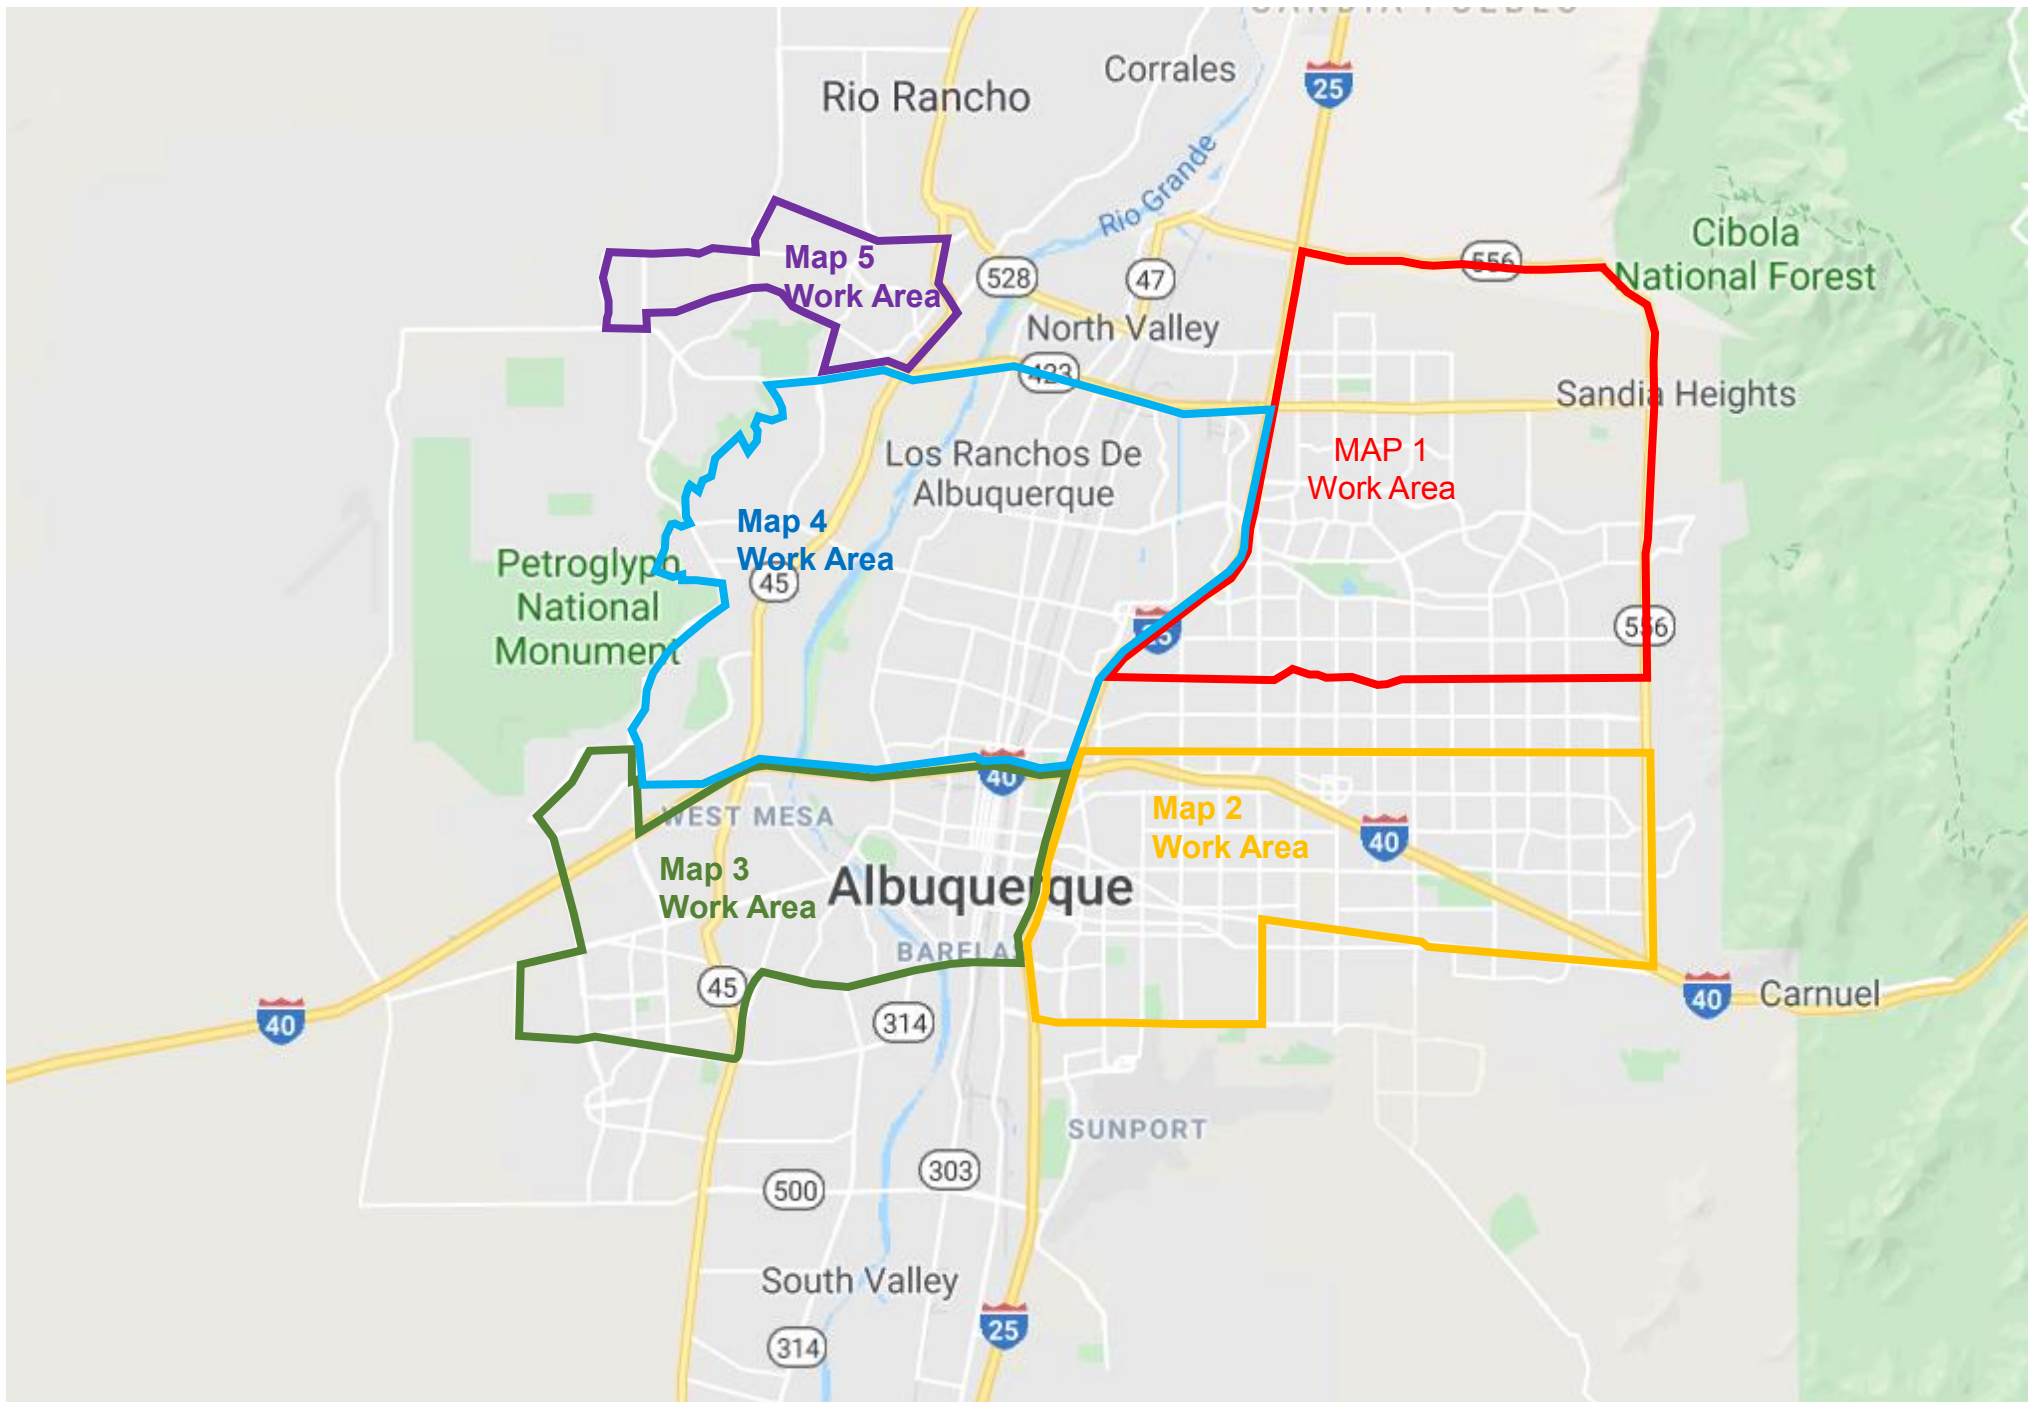

Work Order 805204
Sidewalk Repair - Various Reasons
Alphabetical Listing

3	43	1	601	1st Street	NW
4	108	4	413	2nd Street	SW
4	109	4	525	2nd Street	SW
3	44	1	1222	4th Street	NW
3	45	3	1224	4th Street	NW
4	110	4	1701	4th Street	SW
3	46	1	1916	4th Street	NW
3	47	3	1407	7th Street	NW
4	111	1	706	11th Street	SW
3	48	2	511	12th Street	NW
3	49	3	514	12th Street	NW
3	50	2	515	12th Street	NW
3	51	2	516	12th Street	NW
3	52	2	524	12th Street	NW
3	53	1	806-816	13th Street	NW
2	1	3	403	Adams St	NE
2	2	1	217	Amherst Dr	NE
2	3	1	316	Amherst Dr	NE
4	54	3	2229	Ana Ct	NW
3	55	1	9101	Anacapa Ave	NW
4	112	3	10624	Andalusian Ave	SW
3	92	1	119	Arno St	SE
3	93	1	121	Arno St	SE
2	94	2	1837	Ash Ct	SE
3	56	2	1223	Atrisco Dr	NW
3	57	1	1525	Atrisco Blvd	NW
3	4	1	1620	Broadway Blvd	NE
2	5	1	2917	Campus Blvd	NE
2	6	1	3201	Campus Blvd	NE
2	7	4	3205	Campus Blvd	NE
2	8	1	3209	Campus Blvd	NE
2	9	1	3619	Campus Blvd	NE
1	10	1	5900	Canyon Creek Dr	NE
1	11	1	12016	Caribou Ave	NE
5	58	1	5744	Carmen Dr	NW
3	59	1	1423	Casa Florida	NW
3	60	2	8620	Casa Verde	NW
3	12	4	725	Central Ave	NE
5	61	2	7401	Cerros Pl	NW
1	13	3	6201	Christy Ave	NE
1	14	1	6205	Christy Ave	NE
2	95	2	2100	Coal Ave	SE
1	15	1	7612	Copperfield Dr	NE
2	96	1	3434	Crest	SE
5	62	4	4816	Cumberland Rd	NW
1	16	2	7335	Dancing Eagle Ave	NE
4	113	2	1400	Del Rey Pl	SW
4	63	1	806	Delamar Ave	NW
4	114	1	1724	Desert Breeze Dr	SW
5	64	2	10609	Desert Dreamer St	NW
1	17	3	7324	Don Diego ST	NE

Work Order 805204


Sidewalk Repair - Various Reasons

Alphabetical Listing


5	65	4	-	Eagle Ranch (Irving to Parag	NW
3	66	1	350	Estancia	NW
3	67	2	365	Estancia Dr	NW
2	97	1	500	Eubank Blvd	SE
1	18	1	9012	Freedom Way	NE
3	68	1	923	Fruit	NW
3	69	3	1119	Fruit Ave	NW
3	70	2	1201	Fruit Ave	NW
2	98	1	5001	Gibson Blvd	SE
3	99	4	-	GOLD ALLEY (Between Arno	SW
3	100	4	-	GOLD ALLEY (Between Arno	SW
1	19	1	7900	Harwood Dr	NE
1	20	3	6700	Hensch Ave	NE
5	71	1	8600	Hillshire Pl	NW
4	72	2	7008	Huerta Ave	NW
2	21	1	9824	Indian School Rd	NE
4	115	1	1020	Iron Ave	SW
4	116	3	6801	Ivy Pl	SW
2	22	2	1777	Juan Tabo Blvd	NE
2	23	1	3601	Juan Tabo Blvd	NE
4	117	4	227	Kathryn Ave	SW
5	73	2	5408	La Terra Bella	NW
3	74	4	-	Ladera Blvd - Gunnison	NW
3	75	4	-	Ladera Blvd - Unser	NW
4	76	1	5908	Las Humanas	NW
2	24	1	1719	Lomas Blvd	NE
5	77	2	6019	Maddux Pl	NW
2	25	1	833	Marcella St	NE
2	26	3	4603	Marquette Ave	NE
2	27	1	635	Marquis Dr	NE
1	28	1	7124	Marseille Pl	NE
4	78	1	7909	Mauna Loa	NW
5	79	1	9016	Mesa Pl	NW
4	80	1	212	Mildred Ave	NW
4	81	2	7001	Montano Rd	NW
2	29	2	2913	Morningside Dr	NE
2	30	1	13200	Mountain Rd	NE
2	31	1	13201	Mountain Rd	NE
4	82	2	2525	Oro Vista Rd	NW
2	101	1	1301	Ortiz DR	SE
4	83	3	5016	Pastura Pl	NW
1	32	3	6409	Prairie Rd	NE
4	84	2	1	Quaker Heights Pl	NW
4	118	1	10427	Red Robin Rd	SW
4	121	1	10501	Red Robin Rd	SW
4	85	2	6031	Redlands Rd	NW
4	119	3	8909	Rhonda Ave	SW
2	102	1	600	Ridgecrest Dr	SE

Work Order 805204
Sidewalk Repair - Various Reasons
Alphabetical Listing

2	103	1	2501	Ridgecrest Dr	SE
2	33	4	5201	Roma Ave	NE
4	86	1	3409	Ronda De Lechusas	NW
4	87	3	2712	San Isidro St	NW
2	104	2	2928	San Joaquin Ave	SE
4	88	4	7700	Santo Tomas Pl	NW
4	120	3	2401	Scarlet Bloom	SW
2	105	3	12602	Singing Arrow Ave	SE
2	106	1	12606	Singing Arrow AVE	SE
4	89	1	4908	Sooner Trail	NW
4	90	1	4920	Story Rock St	NW
1	34	3	12301	Tamarac Tr	NE
1	35	3	5729	Teakwood Trl	NE
1	36	3	5733	Teakwood Trl	NE
2	37	2	1802	Valencia Dr	NE
2	38	2	428	Virginia St	NE
4	91	4	-	Vista Del Norte - Calle Co	NW
2	107	2	425	Washington St	SE
2	39	3	817	Wellesley Dr	NE
1	40	1	8412	Wilson Hurley Pl	NE
1	41	4	4516	Wyoming Blvd	NE
1	42	1	4920	Wyoming	NE

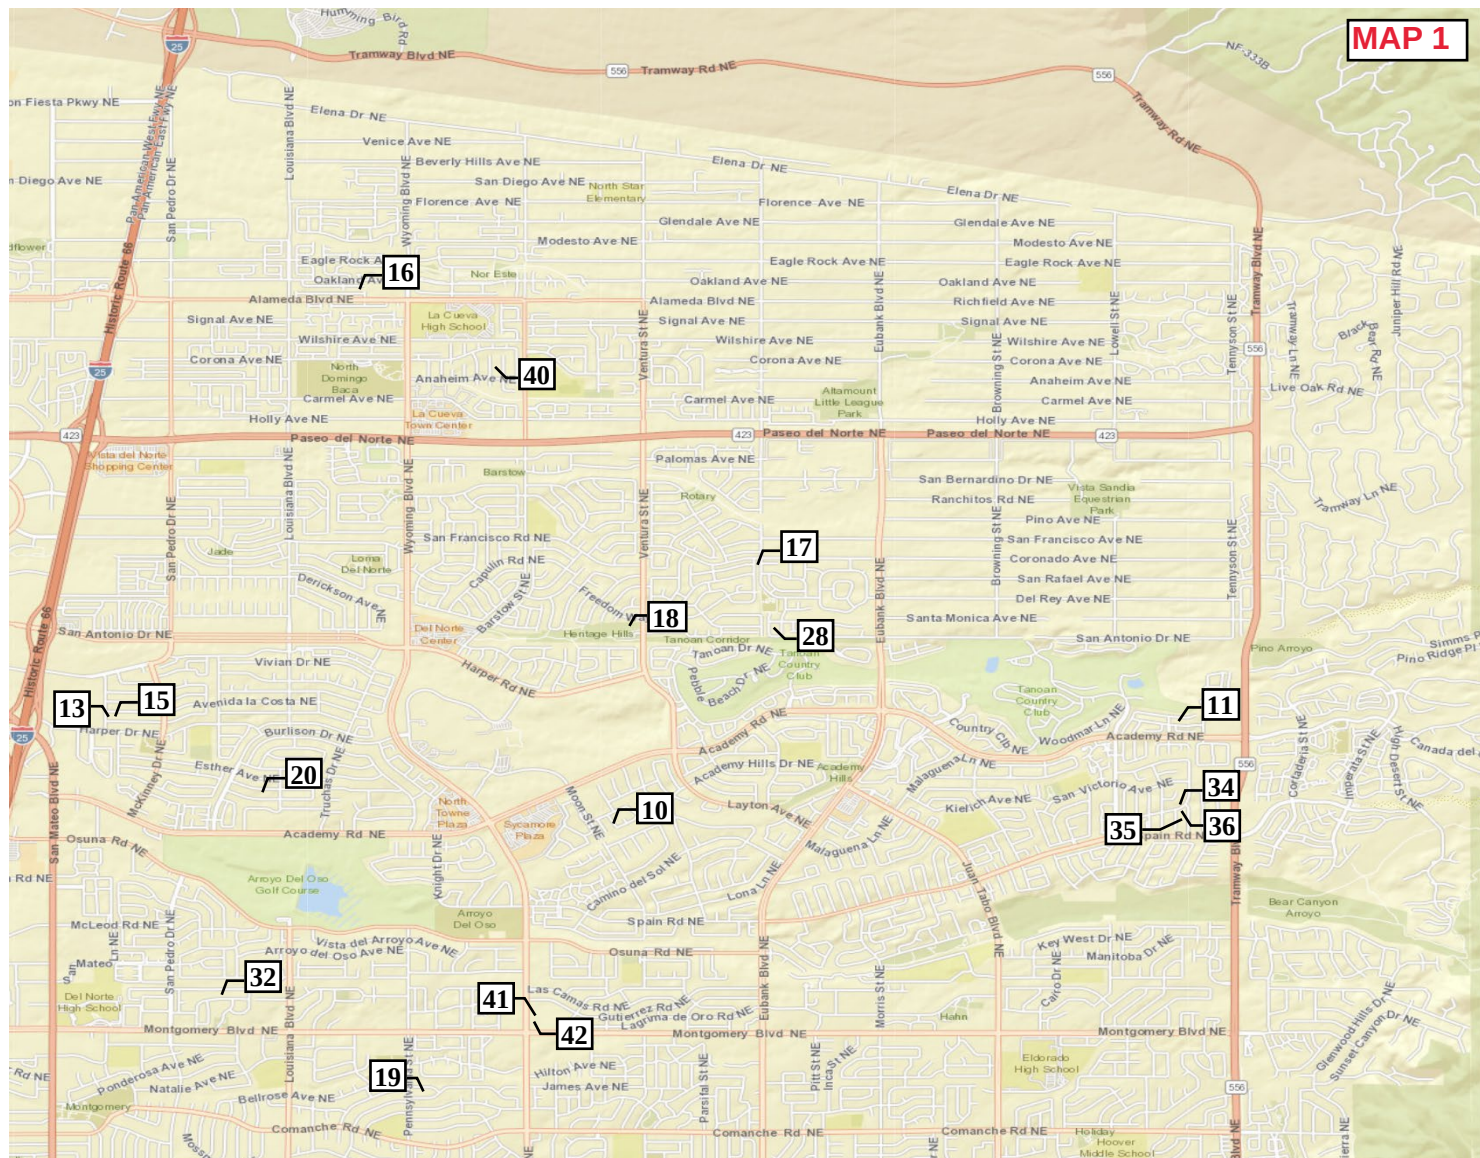


COUNT	ASSET NO.	INTERSECTION	QUADRANT
10	PO	5900 Canyon Creek Dr NE	NE
11	PO	12016 Caribou Ave NE	NE
13	SR	6201 Christy Ave NE	NE
14	PO	6205 Christy Ave NE	NE
15	PO	7612 Copperfield Dr NE	NE
16	NR	7335 Dancing Eagle Ave NE	NE
17	SR	7324 Don Diego St NE	NE
18	PO	9012 Freedom Way NE	NE
19	PO	7900 Harwood Ave NE	NE
20	SR	6700 Hensch Ave NE	NE
28	PO	7124 Marseille Pl NE	NE
32	SR	6409 Prairie Ave NE	NE
34	SR	12301 Tamarac Trl NE	NE
35	SR	5729 Teakwood Trl NE	NE
36	SR	5733 Teakwood Trl NE	NE
40	PO	8412 Wilson Hurley Pl NE	NE
41	CITY	4516 Wyoming Blvd NE	NE
42	PO	4920 Wyoming Blvd NE	NE

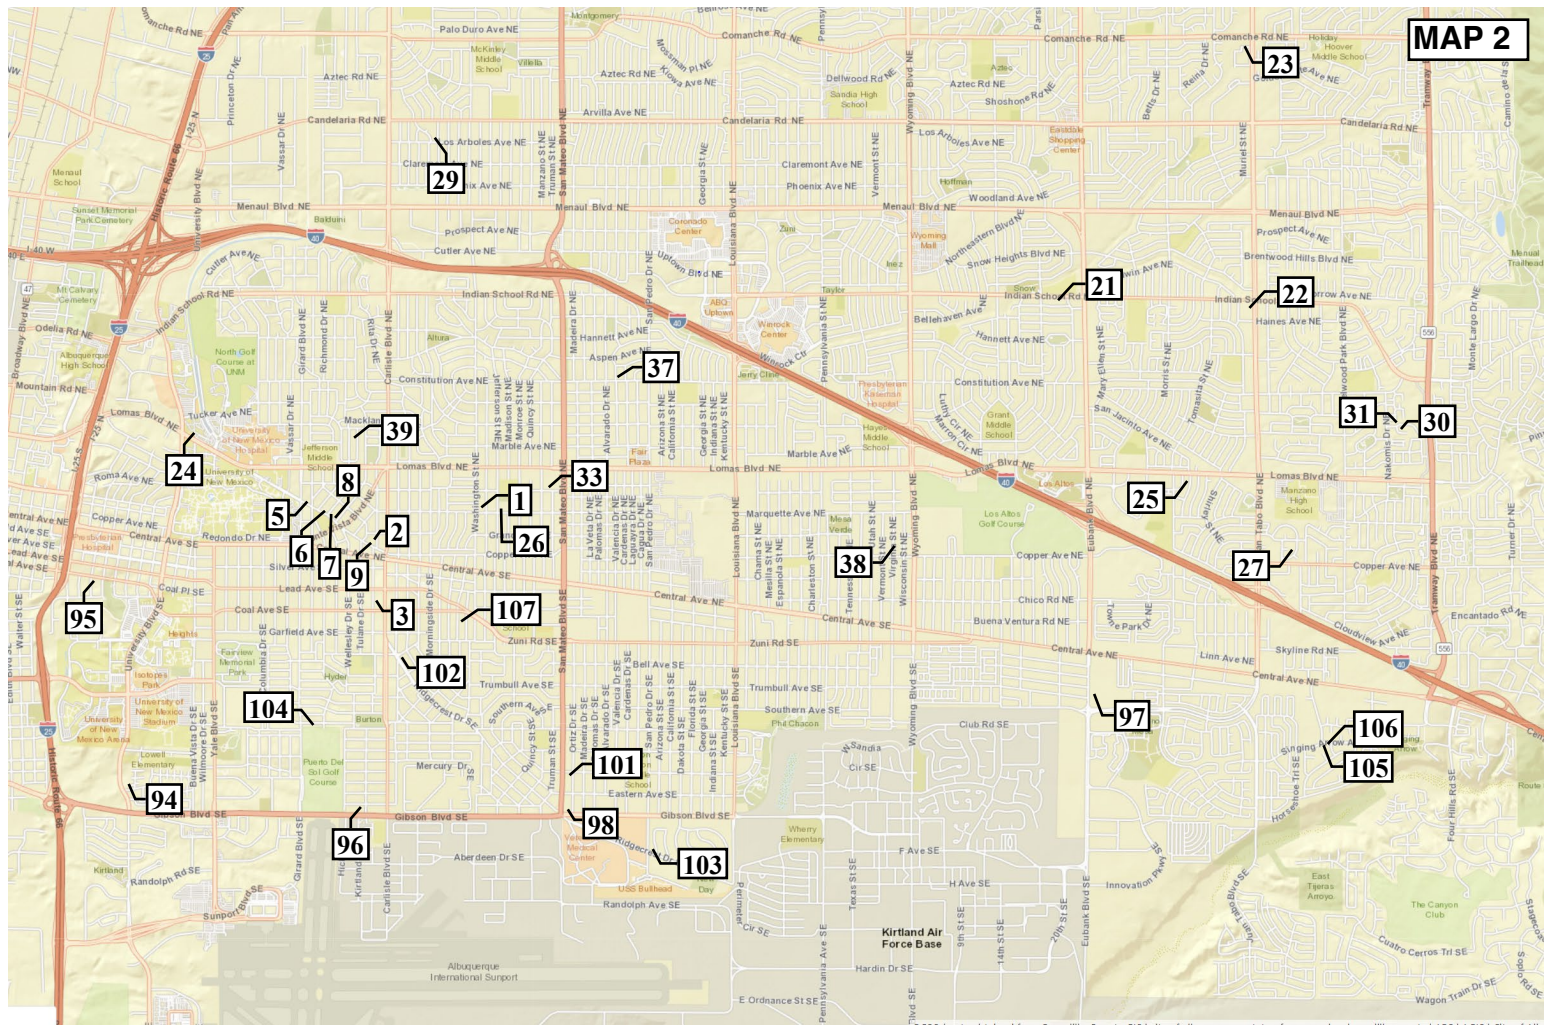


COUNT	ASSET NO.	INTERSECTION	QUAD
1	SR	403 Adams St NE	SE
2	PO	217 Amherst Dr NE	SE
3	PO	316 Amherst Dr NE	SE
5	PO	2917 Campus Blvd NE	SE
6	PO	3201 Campus Blvd NE	SE
7	CITY	3205 Campus Blvd NE	SE
8	PO	3209 Campus Blvd NE	SE
9	PO	3619 Campus Blvd NE	SE
21	PO	9824 Indian School Rd NE	SE
22	NR	1777 Juan Tabo Blvd NE	SE
23	PO	3601 Juan Tabo Blvd NE	SE
24	PO	1719 Lomas Blvd NE	SE
25	PO	833 Marcella St NE	SE
26	SR	4603 Marquette Ave NE	SE
27	PO	635 Marquis Dr NE	SE
29	NR	2913 Morningside Dr NE	SE
30	PO	13200 Mountain Rd NE	SE
31	PO	13201 Mountain Rd NE	SE
33	CITY	5201 Roma Ave NE	SE
37	NR	1802 Valencia Dr NE	SE
38	NR	428 Virginia St NE	SE
39	SR	817 Wellesley Dr NE	SE
94	NR	1837 Ash Ct SE	SE
95	NR	1200 Coal Ave SE	SE
96	PO	3434 Crest Ave SE	SE
97	PO	500 Eubank Blvd SE	SE
98	PO	5001 Gibson Blvd SE	SE
101	PO	1301 Ortiz Dr SE	SE
102	PO	600 Ridgcrest Dr SE	SE

COUNT	ASSET NO.	INTERSECTION	QUAD
103	PO	2501 Ridgcrest Dr SE	SE
104	NR	2928 San Joaquin Ave SE	SE
105	SR	12602 Singing Arrow Ave SE	SE
106	PO	12606 Singing Arrow Ave SE	SE
107	NR	425 Washington St SE	SE

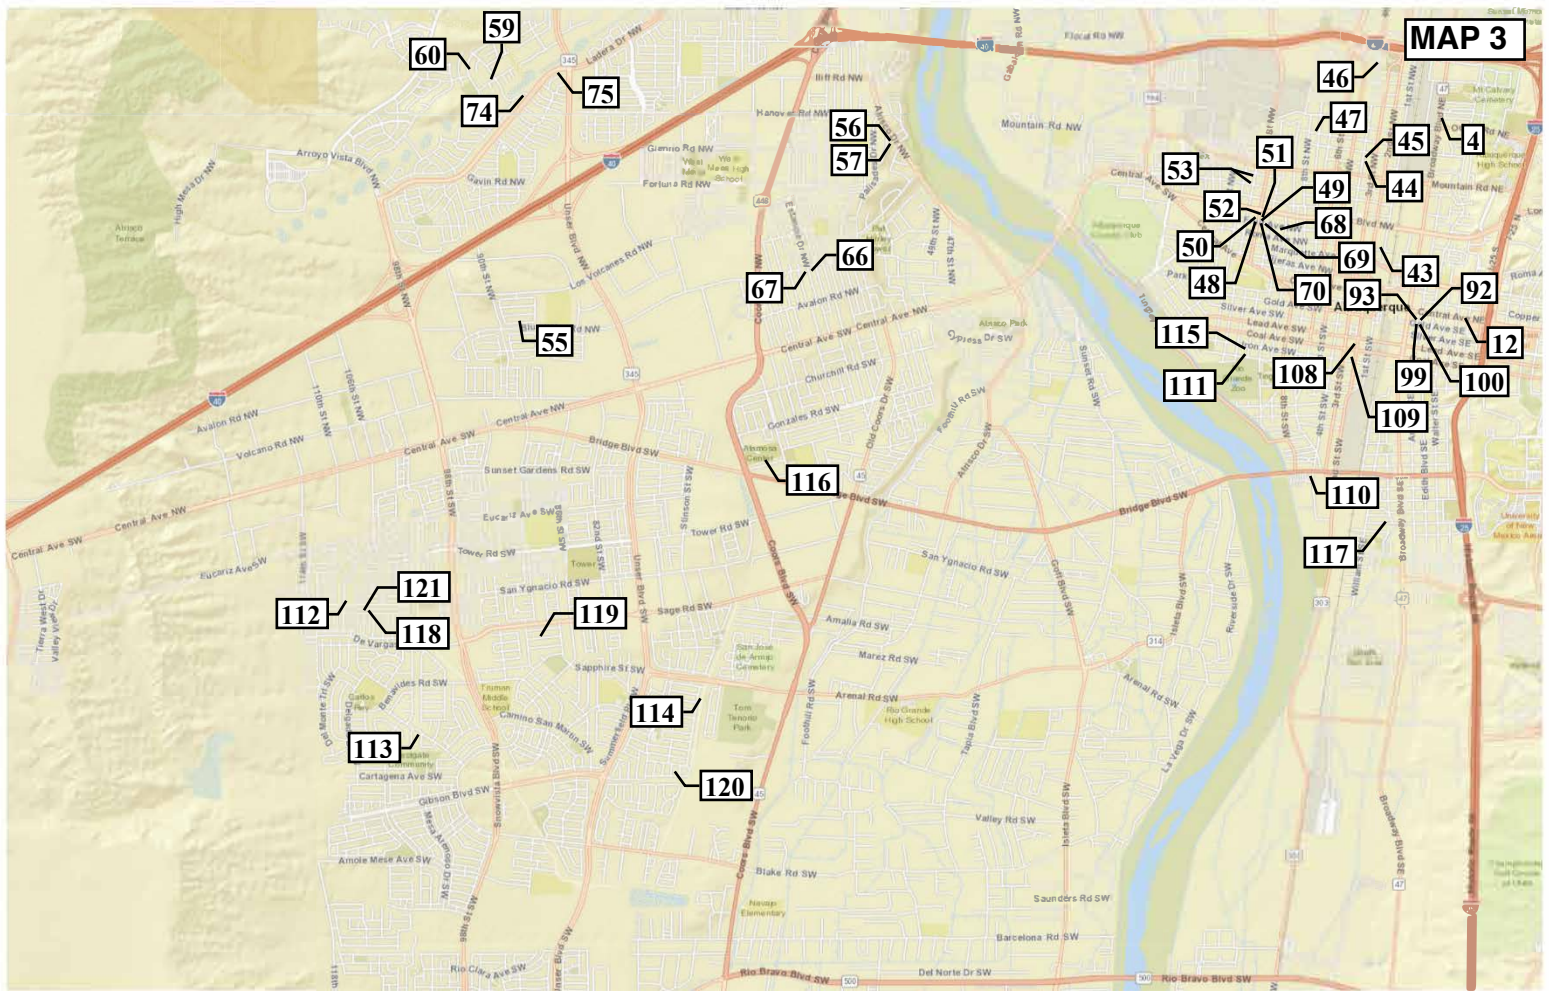


COUNT	ASSET NO.	INTERSECTION	QUAD
4	PO	1620 Broadway Blvd NE	SW
12	CITY	725 Central Ave NE	SW
43	PO	601 1 st St NW	SW
44	PO	1222 4th St NW	SW
45	SR	1224 4th St NW	SW
46	PO	1916 4th St NW	SW
47	SR	1407 7th St NW	SW
48	NR	511 12th St NW	SW
49	SR	514 12th St NW	SW
50	NR	515 12th St NW	SW
51	NR	516 12th St NW	SW
52	NR	524 12th St NW	SW
53	PO	806 – 816 13 th St NW	SW
55	PO	9101 Anacapa Ave NW	SW
56	NR	1223 Atrisco Dr NW	SW
57	PO	1525 Atrisco Blvd NW	SW
59	PO	1423 Casa Florida Pl NW	SW
60	NR	8620 Casa Verde Ave NW	SW
66	PO	350 Estancia Dr NW	SW
67	NR	365 Estancia Dr NW	SW
68	PO	923 Fruit Ave NW	SW
69	SR	1119 Fruit Ave NW	SW
70	NR	1201 Fruit Ave NW	SW
74	CITY	Ladera Dr and Gunnison Pl NW	SW
75	CITY	Ladera Dr and Unser Blvd NW	SW
92	PO	119 Arno St SE	SW
93	PO	121 Arno St SE	SW
99	CITY	GOLD ALLEY (Btwn Arno & Broadway - north)	SW
100	CITY	GOLD ALLEY (Btwn Arno & Broadway - south)	SW
108	CITY	413 2nd St SW	SW

COUNT	ASSET NO.	INTERSECTION	QUAD
109	CITY	525 2 nd St SW	SW
110	CITY	1701 4th St SW	SW
111	PO	706 11 th St SW	SW
112	SR	10624 Andalusian Ave SW	SW
113	NR	1400 Del Rey Pl SW	SW
114	PO	1724 Desert Breeze Dr SW	SW
115	PO	1020 Iron Ave SW	SW
116	SR	6801 Ivy Pl SW	SW
117	CITY	227 Kathryn Ave SE	SW
118	PO	10427 Red Robin Rd SW	SW
121	PO	10501 Red Robin Rd SW	SW
119	SR	8909 Rhonda Ave SW	SW
120	SR	2401 Scarlet Bloom Dr SW	SW

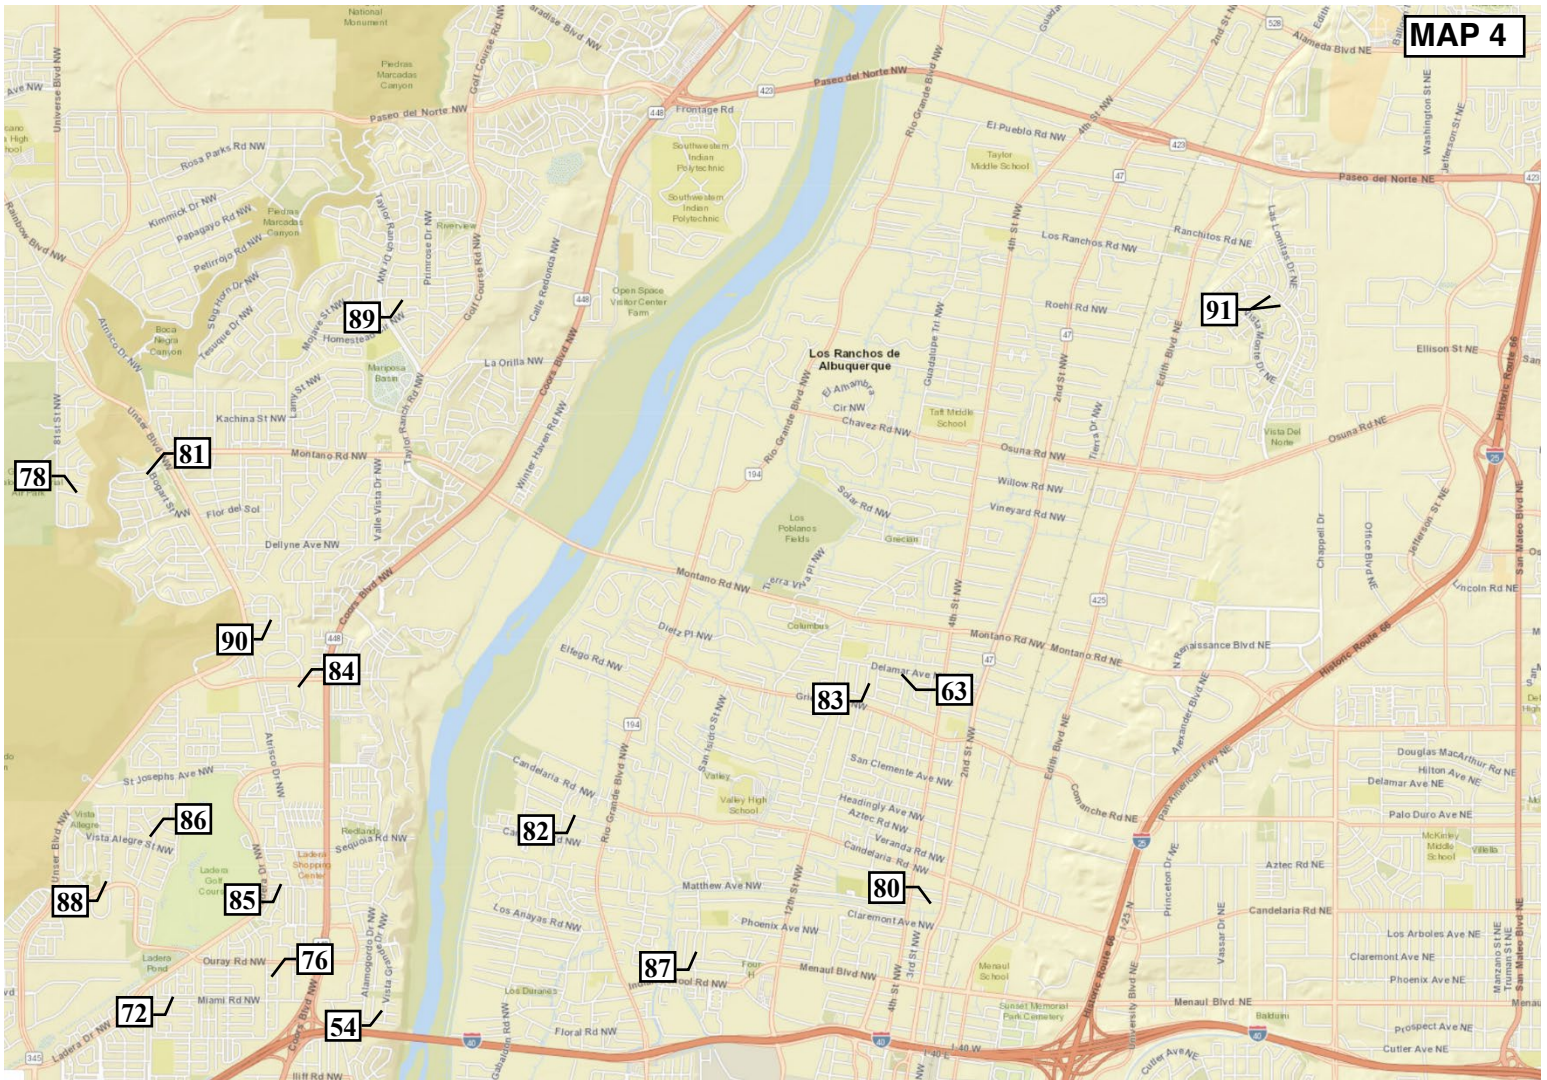

COUNT	ASSET NO.	INTERSECTION	QUADRANT
54	SR	2229 Ana Ct NW	NW
63	PO	806 Delamar Ave NW	NW
72	NR	7008 Huerto Ave NW	NW
76	PO	5908 Las Humanas Rd NW	NW
78	PO	7909 Mauna Loa Dr NW	NW
80	PO	212 Mildred Ave NW	NW
81	NR	7001 Montano Rd NW	NW
82	NR	2525 Oro Vista Rd NW	NW
83	SR	5016 Pastura Pl NW	NW
84	NR	Quaker Heights Pl (west side) @ Western Trail NW	NW
85	NR	6031 Redlands Rd NW	NW
86	PO	3409 Ronda De Lechusas NW	NW
87	SR	2712 San Isidro St NW	NW
88	CITY	7700 Santo Tomas Ct NW	NW
89	PO	4908 Sooner Trail NW	NW
90	PO	4920 Story Rock St NW	NW
91	CITY	Vista Del Norte - Calle Comodo to Las Lomitas Dr NW	NW

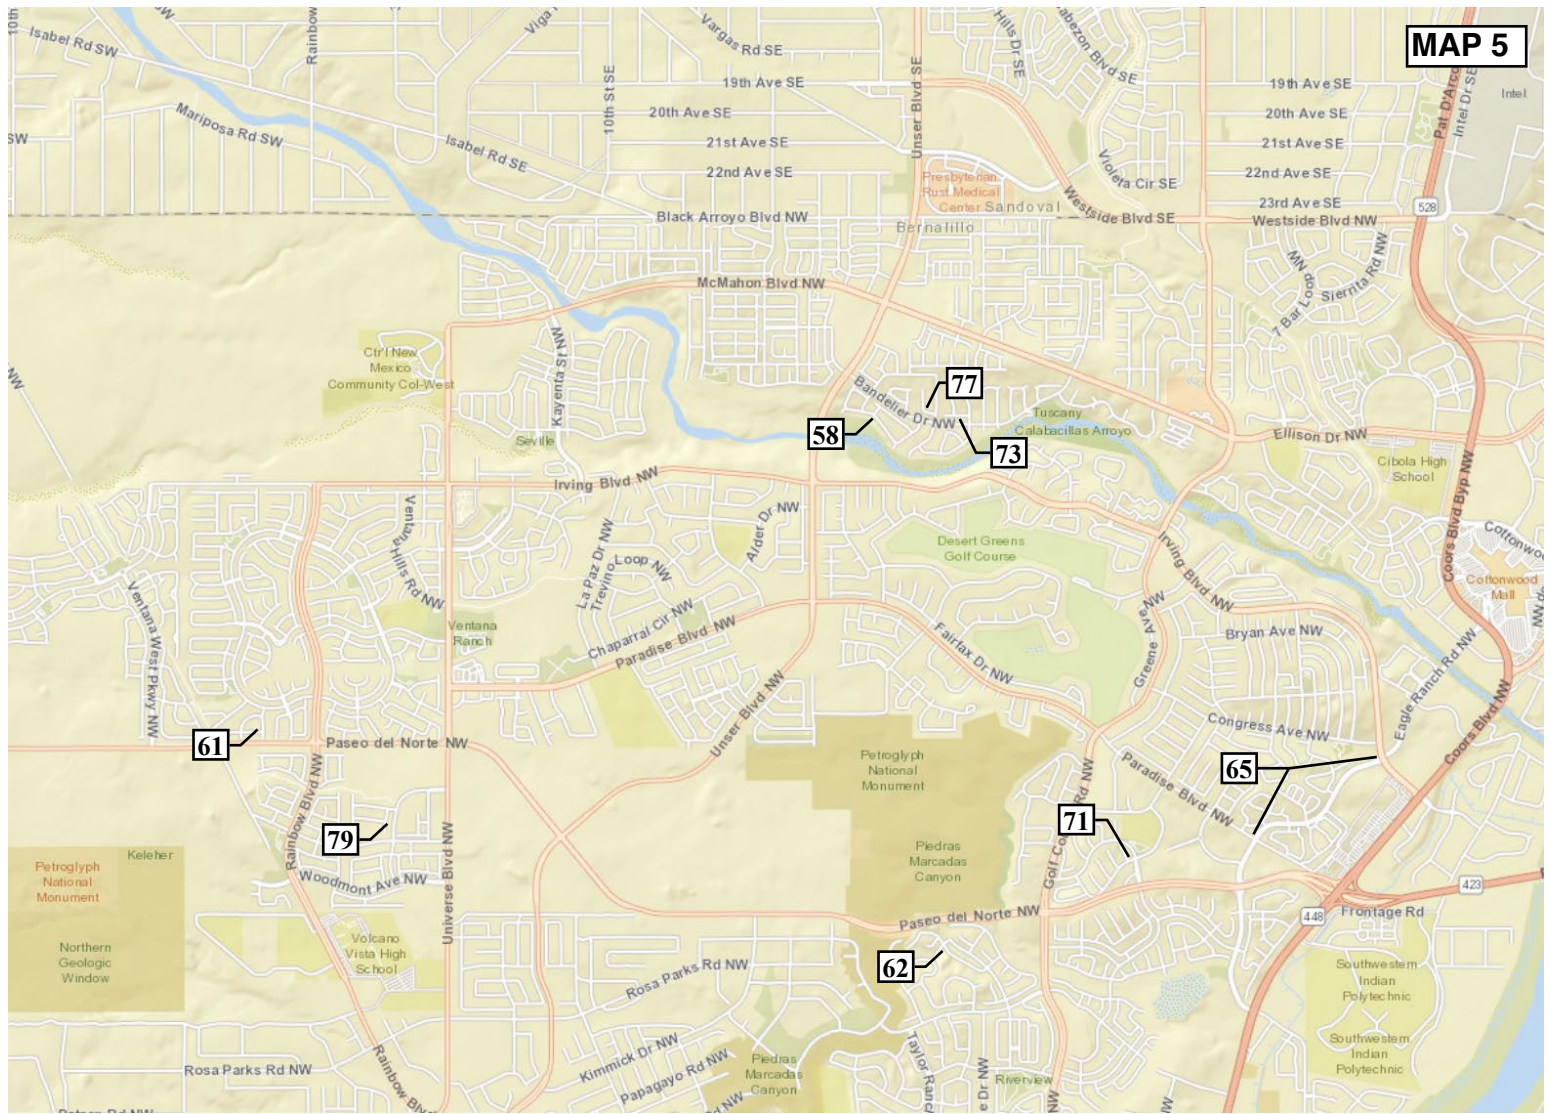

COUNT	ASSET NO.	INTERSECTION	QUADRANT
58	PO	5744 Carmen Dr NW	NW
61	NR	7401 Cerros Pl NW	NW
62	CITY	4816 Cumberland Rd NW	NW
65	CITY	Eagle Ranch (Irving to Paradise)	NW
71	PO	8600 Hillshire Pl NW	NW
73	NR	5408 La Terra Bella Rd NW	NW
77	NR	6019 Maddux Pl NW	NW
79	PO	9016 Mesa Pl NW	NW