

Dotted Line - East Bound

OUTLET Elev 5188.91

CANDELARIA RD NE

QUINCY ST. NE

LIP

LIP

Sidewalk

Sidewalk

Back of Curb

Back of Curb

Flow Line


Flow Line

SURVEY NOTES

1. THIS IS NOT A BOUNDARY SURVEY. APPARENT PROPERTY LINES AND FOUND CORNERS AS MAY BE SHOWN HEREIN ARE FOR ORIENTATION PURPOSE ONLY.
2. FIELD WORK WAS COMPLETED IN OCTOBER 2020 USING GPS VIA THE LIECA SMARTNET REAL TIME GEODETIC NETWORK.
3. TOPOGRAPHIC MAP IS BASED ON MODIFIED NEW MEXICO STATE PLANE COORDINATE SYSTEM, CENTRAL ZONE (3002) US SURVEY FEET.
4. THE HORIZONTAL DATUM IS BASED ON NAD83 AND THE VERTICAL DATUM IS BASED ON NAVD88.
5. THE PROJECT BENCHMARK IS AGRS CONTROL MONUMENT STAMPED NM\_367\_6 ELEV. 5209.956
6. THIS MAPPING DATA SET WAS COLLECTED TO SUPPORT A HORIZONTAL SCALE OF 1"=10' AND A VERTICAL CONTOUR OF 0.25 US FT.
7. THE CENTER OF THE PROJECT CAN BE LOCATED BY GEOGRAPHIC COORDINATES 35° 06' 59" N, 106° 35' 22.5" W.

LIP 91.60  
FL 91.55  
BOC 92.16

FL 91.57  
LIP 91.55  
BOC 92.12

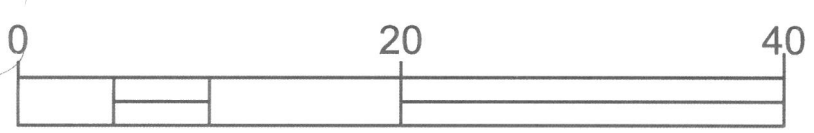

Feet

1"=10'



DEPARTMENT OF MUNICIPAL DEVELOPMENT  
CONSTRUCTION SERVICES / SURVEY SECTION

Candelaria and Quincy Topo

DRAWN BY: DB  
APPROVED BY: LR

DWG NO. 1 OF 1

REV

FIELD WORK PERFORMED 10/9/2020 | SHEET 1



Dotted Line - East Bound

OUTLET Elev 5188.91

End of return @  
each side

CANDELARIA RD NE

Removal limits, curb  
and gutter and  
asphalt cut only

Remove existing  
pavement and  
replace with two 2"  
lifts of SP-C

LIP

Sidewalk

Sidewalk

LIP 91.41  
BOC 91.97

South removal limit  
determined by this  
elevation point.

LIP 91.69  
FL 91.58  
BOC 92.16

Back of Curb

Back of Curb

Flow Line

Flow Line

QUINCY ST. NE

SURVEY NOTES

1. THIS IS NOT A BOUNDARY SURVEY. APPARENT PROPERTY LINES AND FOUND CORNERS AS MAY BE SHOWN HEREIN ARE FOR ORIENTATION PURPOSE ONLY.
2. FIELD WORK WAS COMPLETED IN OCTOBER 2020 USING GPS VIA THE LIECA SMARTNET REAL TIME GEODETIC NETWORK.
3. TOPOGRAPHIC MAP IS BASED ON MODIFIED NEW MEXICO STATE PLANE COORDINATE SYSTEM, CENTRAL ZONE (3002) US SURVEY FEET.
4. THE HORIZONTAL DATUM IS BASED ON NAD83 AND THE VERTICAL DATUM IS BASED ON NAVD88.
5. THE PROJECT BENCHMARK IS AGRS CONTROL MONUMENT STAMPED NM\_367\_6 ELEV. 5209.956
6. THIS MAPPING DATA SET WAS COLLECTED TO SUPPORT A HORIZONTAL SCALE OF 1"=10' AND A VERTICAL CONTOUR OF 0.25 US FT.
7. THE CENTER OF THE PROJECT CAN BE LOCATED BY GEOGRAPHIC COORDINATES 35° 06' 59" N, 106° 35' 22.5" W.

LIP 91.60  
FL 91.55  
BOC 92.16

FL 91.57  
LIP 91.55  
BOC 92.12



DEPARTMENT OF MUNICIPAL DEVELOPMENT  
CONSTRUCTION SERVICES / SURVEY SECTION

Candelaria and Quincy Topo

DRAWN BY: DB  
APPROVED BY: LR

DWG NO. 1 OF 1

REV

FIELD WORK PERFORMED 10/9/2020 | SHEET 1