

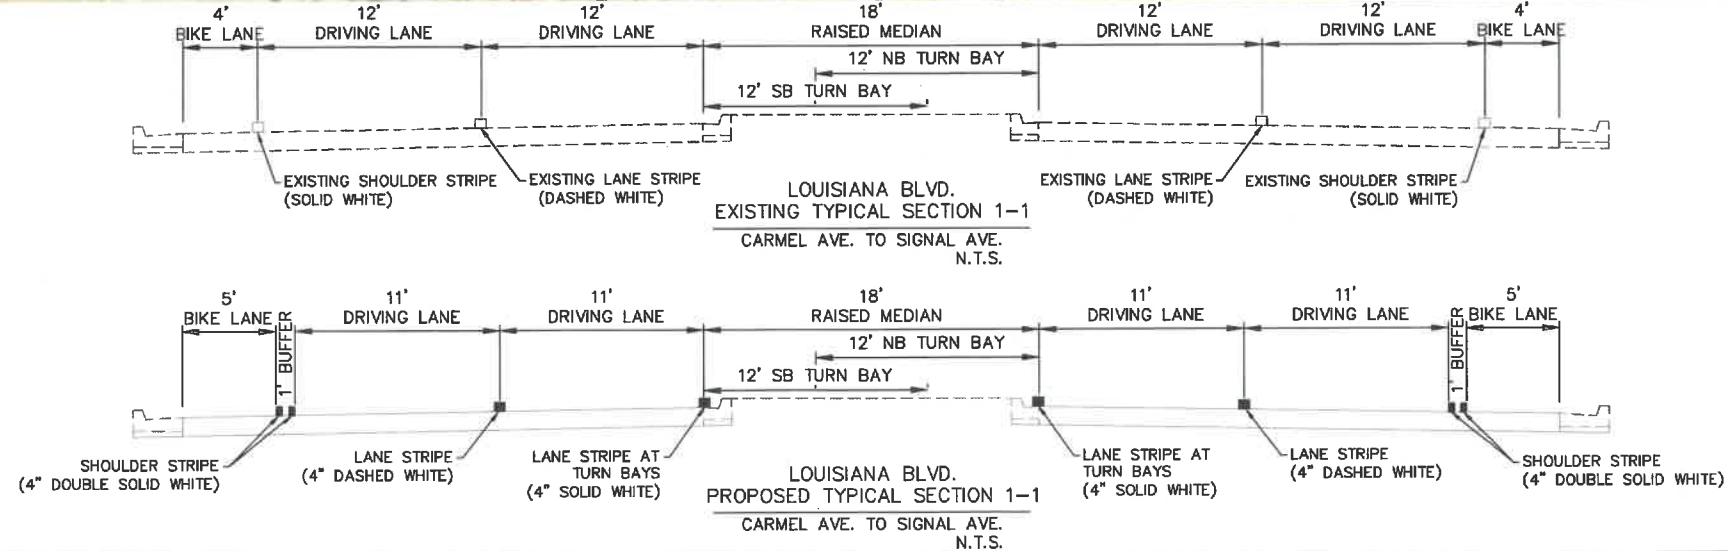
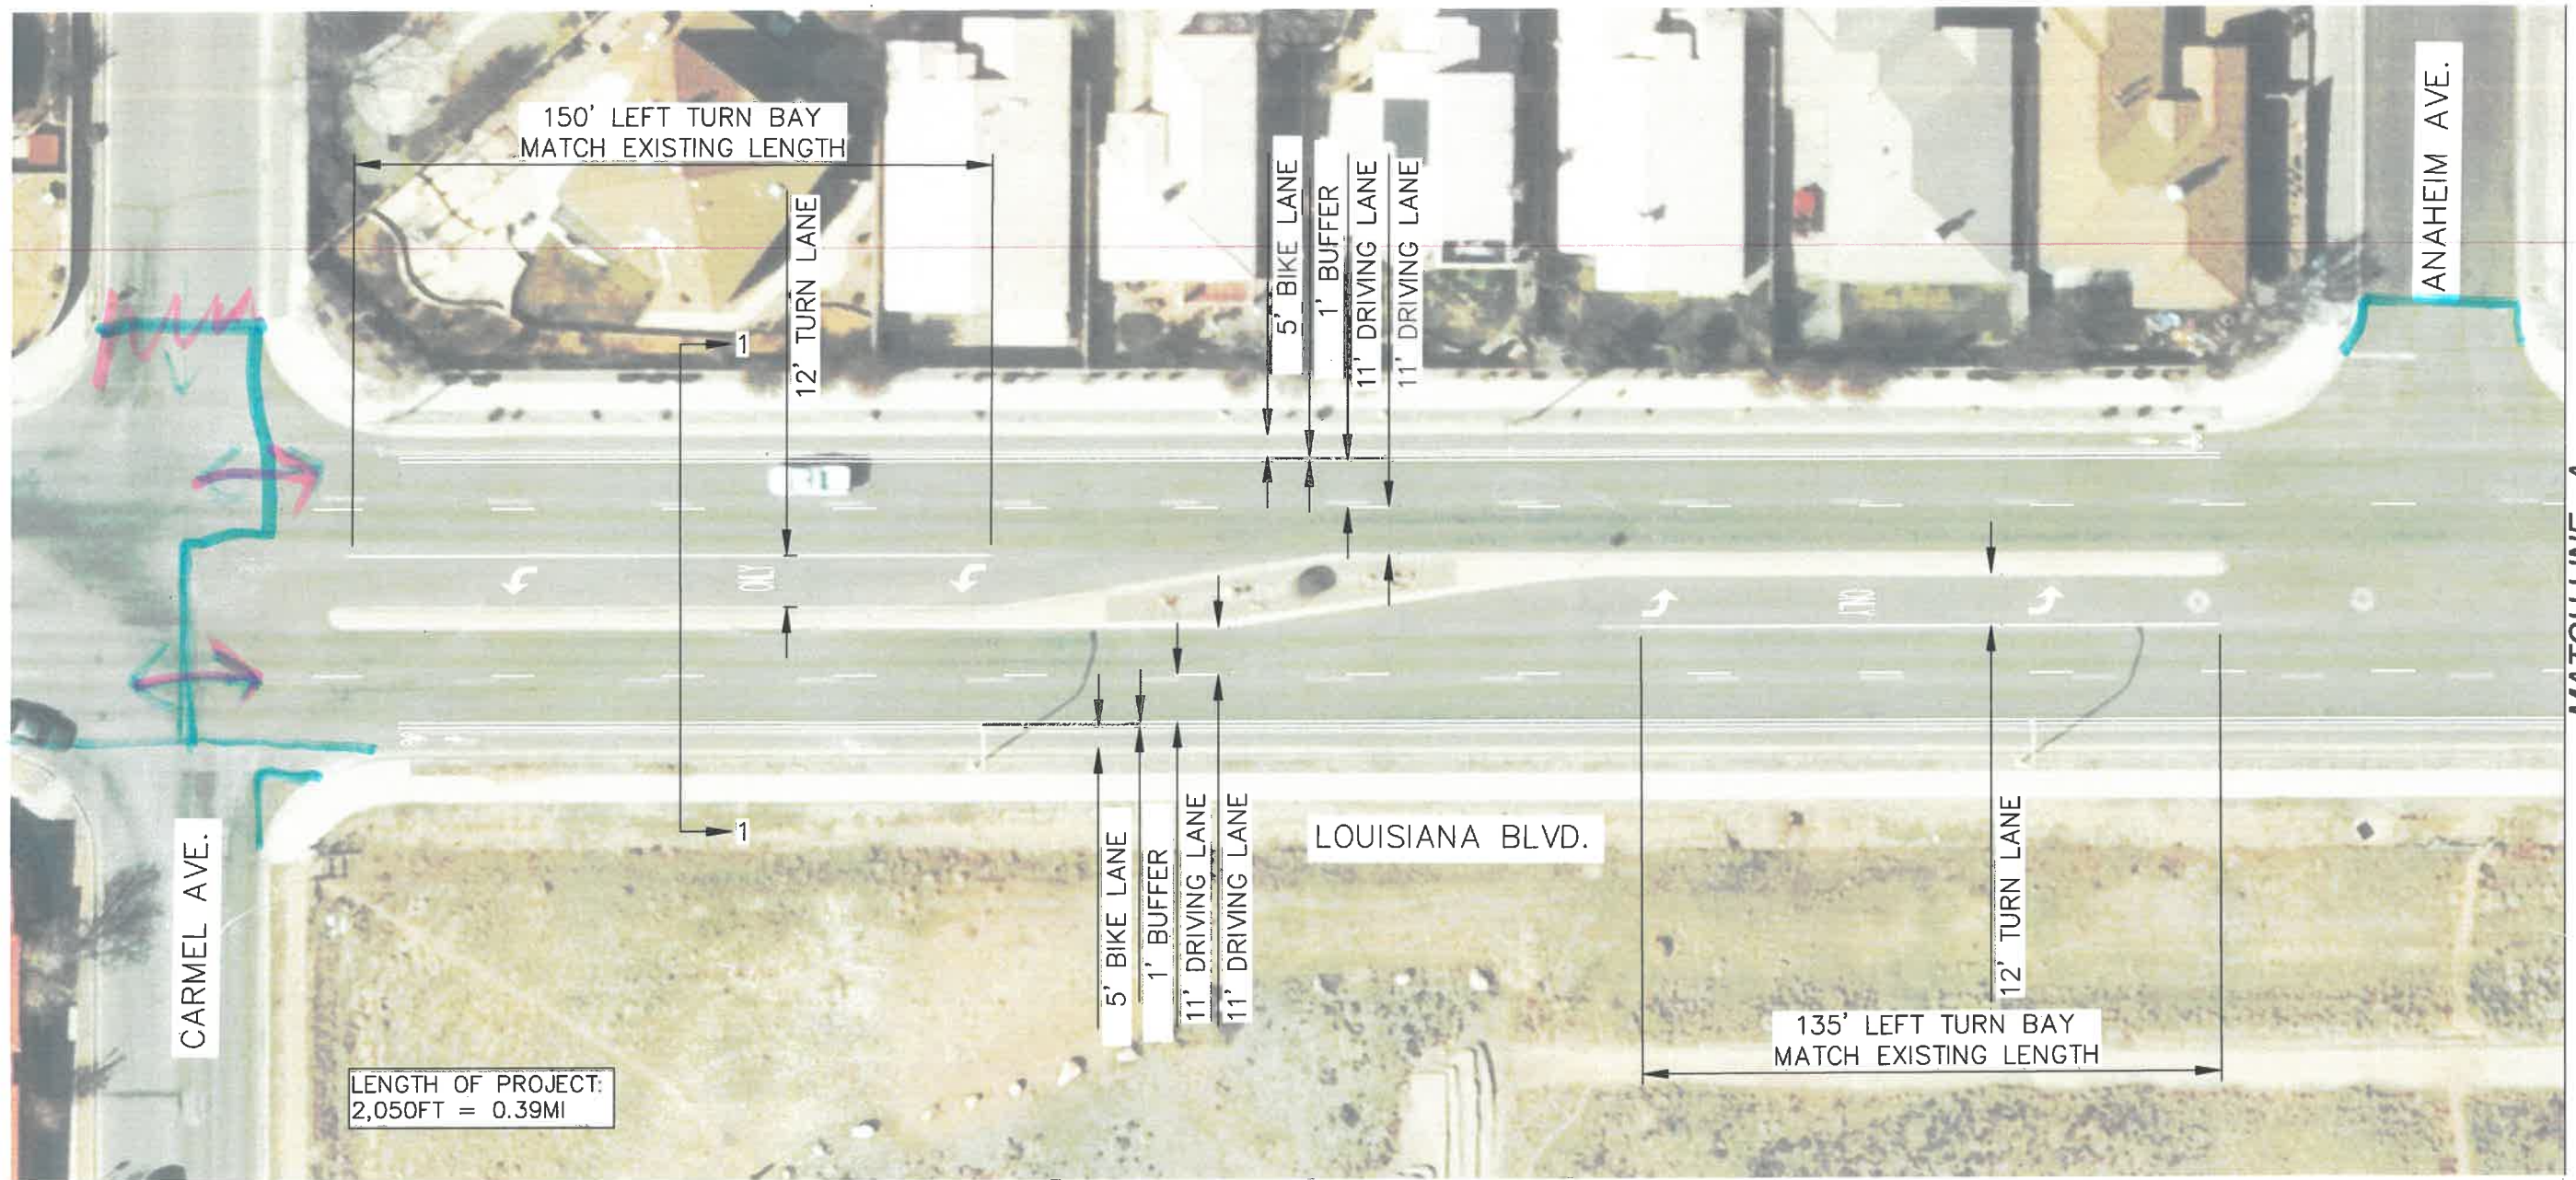
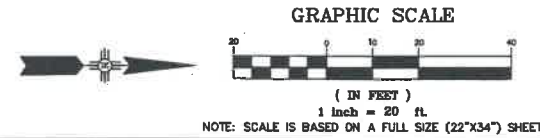


|   |                        |                 |             |
|---|------------------------|-----------------|-------------|
| <p>WSP USA Inc.<br/>2540 LOUISIANA BLVD. NE<br/>SUITE 400<br/>ALBUQUERQUE, NM 87110<br/>TEL: +1 505.261.2357</p>                                                                                      |                        |                 |             |
| <p>CITY OF ALBUQUERQUE<br/>DEPARTMENT OF MUNICIPAL DEVELOPMENT<br/>ENGINEERING DIVISION<br/>COMPLETE STREETS STRIPING<br/>IMPLEMENTATION CONCEPT<br/>LOUISIANA BLVD. - CARMEL AVE. TO SIGNAL AVE.</p> |                        |                 |             |
| DESIGN REVIEW COMMITTEE   | CITY ENGINEER APPROVAL | MO./DAY/YR.     | MO./DAY/YR. |
|   |                        |                 |             |
|   |                        |                 |             |
|   |                        |                 |             |
| City Project No.   | Zone Map No.           | Sheet<br>1 OF 4 |             |

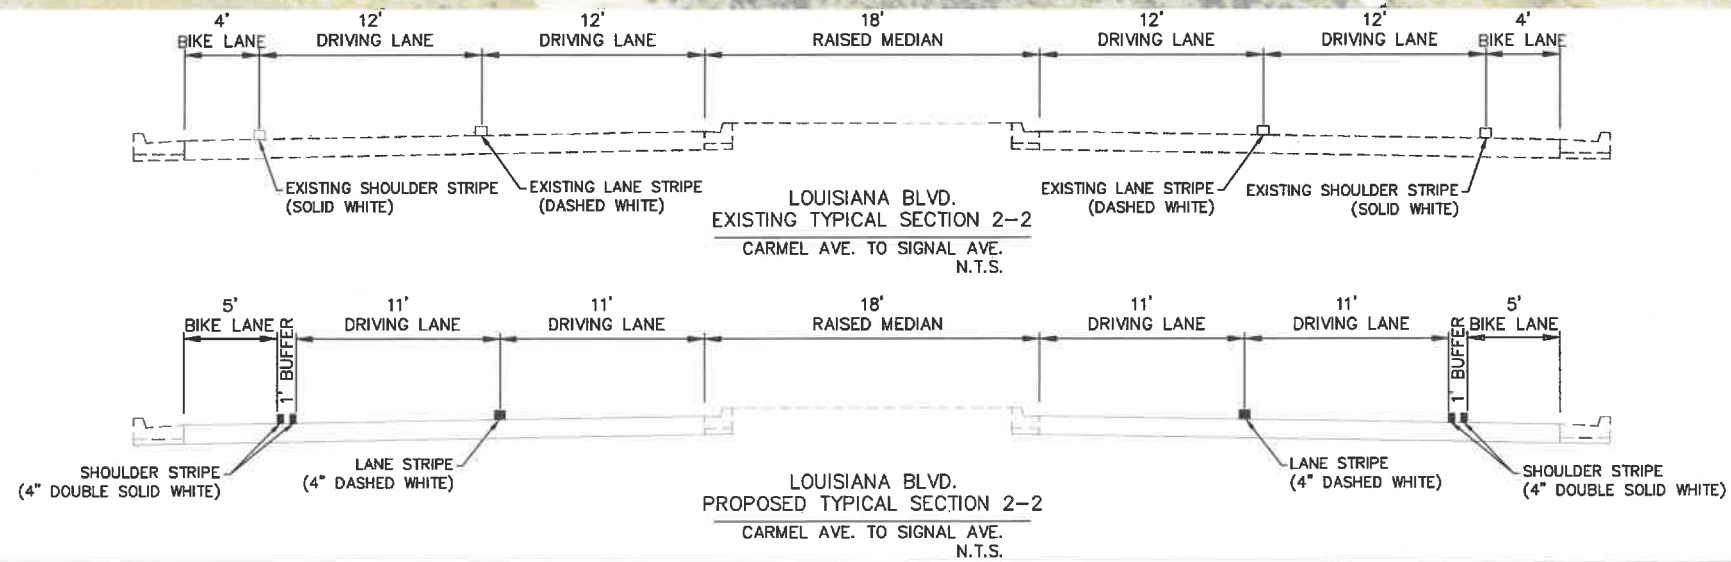

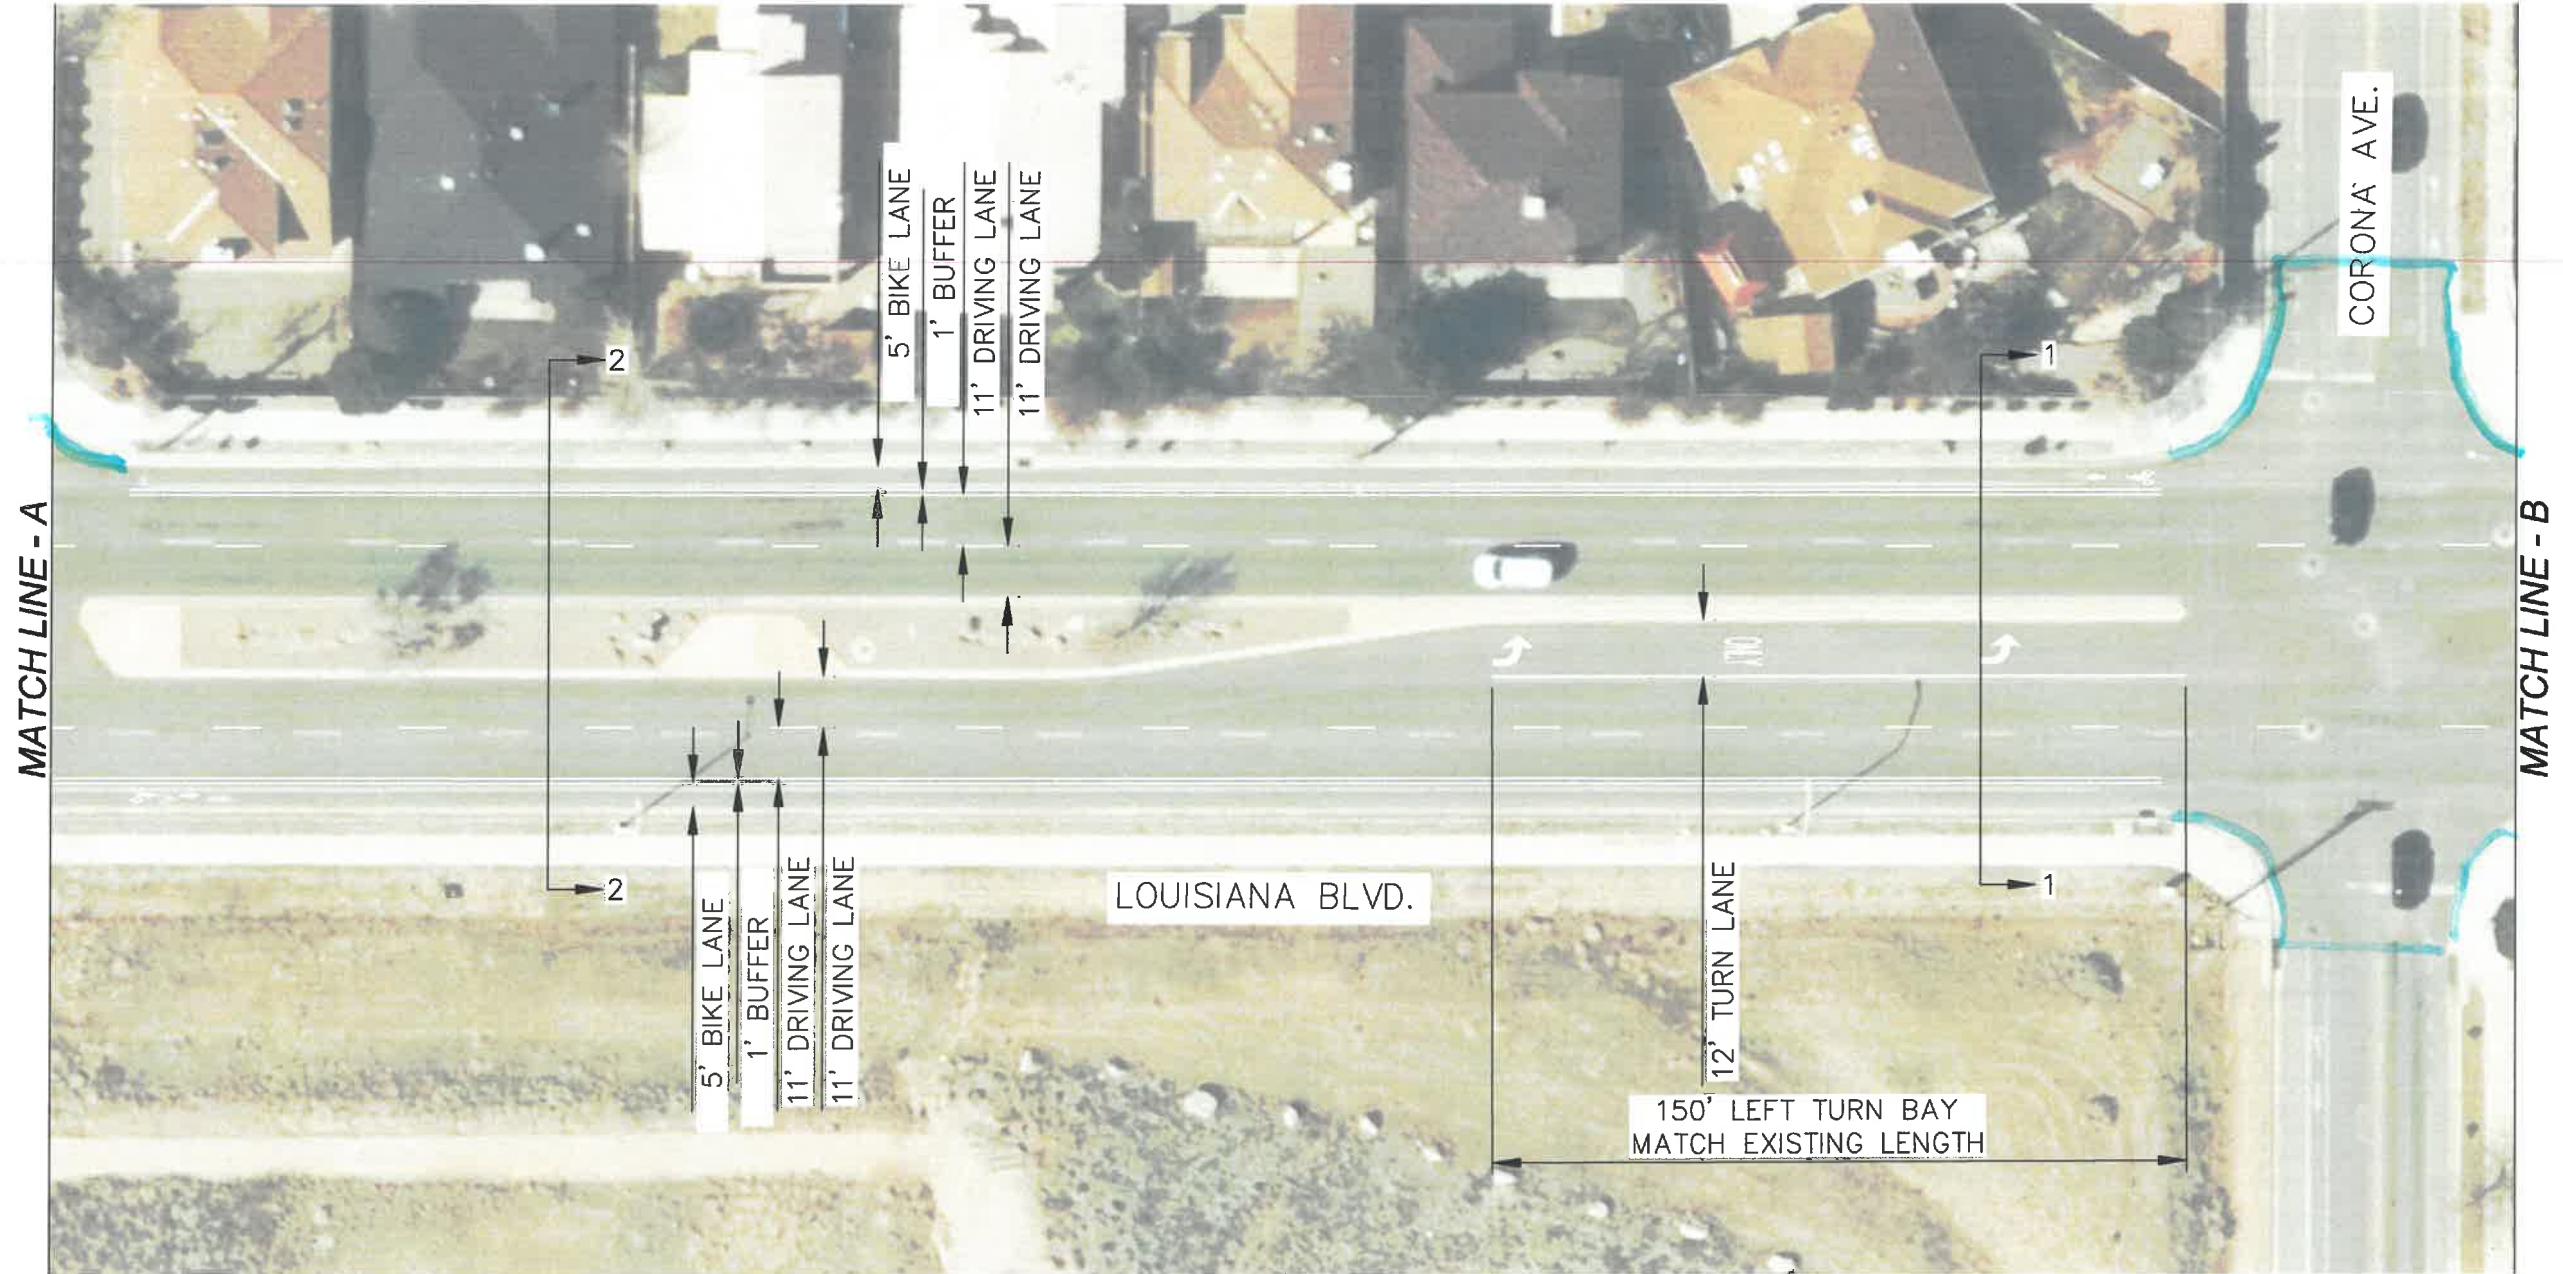




NOTE: SCALE IS BASED ON A FULL SIZE (22"x34") SHEET.

|   |                        |                 |             |
|---|------------------------|-----------------|-------------|
| WSP USA Inc.<br>2840 LOUISIANA BLVD. NE<br>SUITE 400<br>ALBUQUERQUE, NM 87110<br>TEL: +1 505.861.5357                                                                                     |                        |                 |             |
| CITY OF ALBUQUERQUE<br>DEPARTMENT OF MUNICIPAL DEVELOPMENT<br>ENGINEERING DIVISION<br>COMPLETE STREETS STRIPING<br>IMPLEMENTATION CONCEPT<br>LOUISIANA BLVD. — CARMEL AVE. TO SIGNAL AVE. |                        |                 |             |
| DESIGN REVIEW COMMITTEE   | CITY ENGINEER APPROVAL | MO./DAY/YR.     | MO./DAY/YR. |
|   |                        |                 |             |
|   |                        |                 |             |
|   |                        |                 |             |
| City Project No.   | Zone Map No.           | Sheet<br>2 OF 4 |             |





MATCH LINE - B

MATCH LINE - C

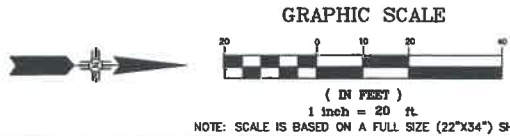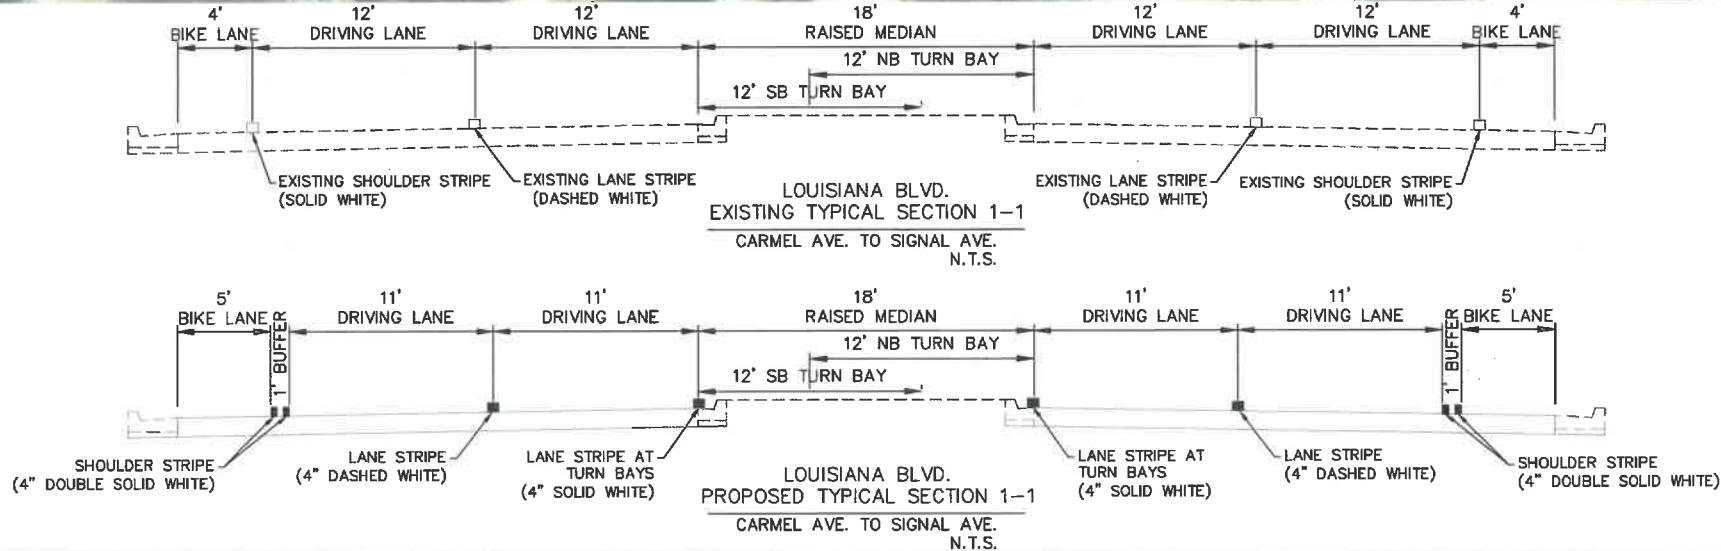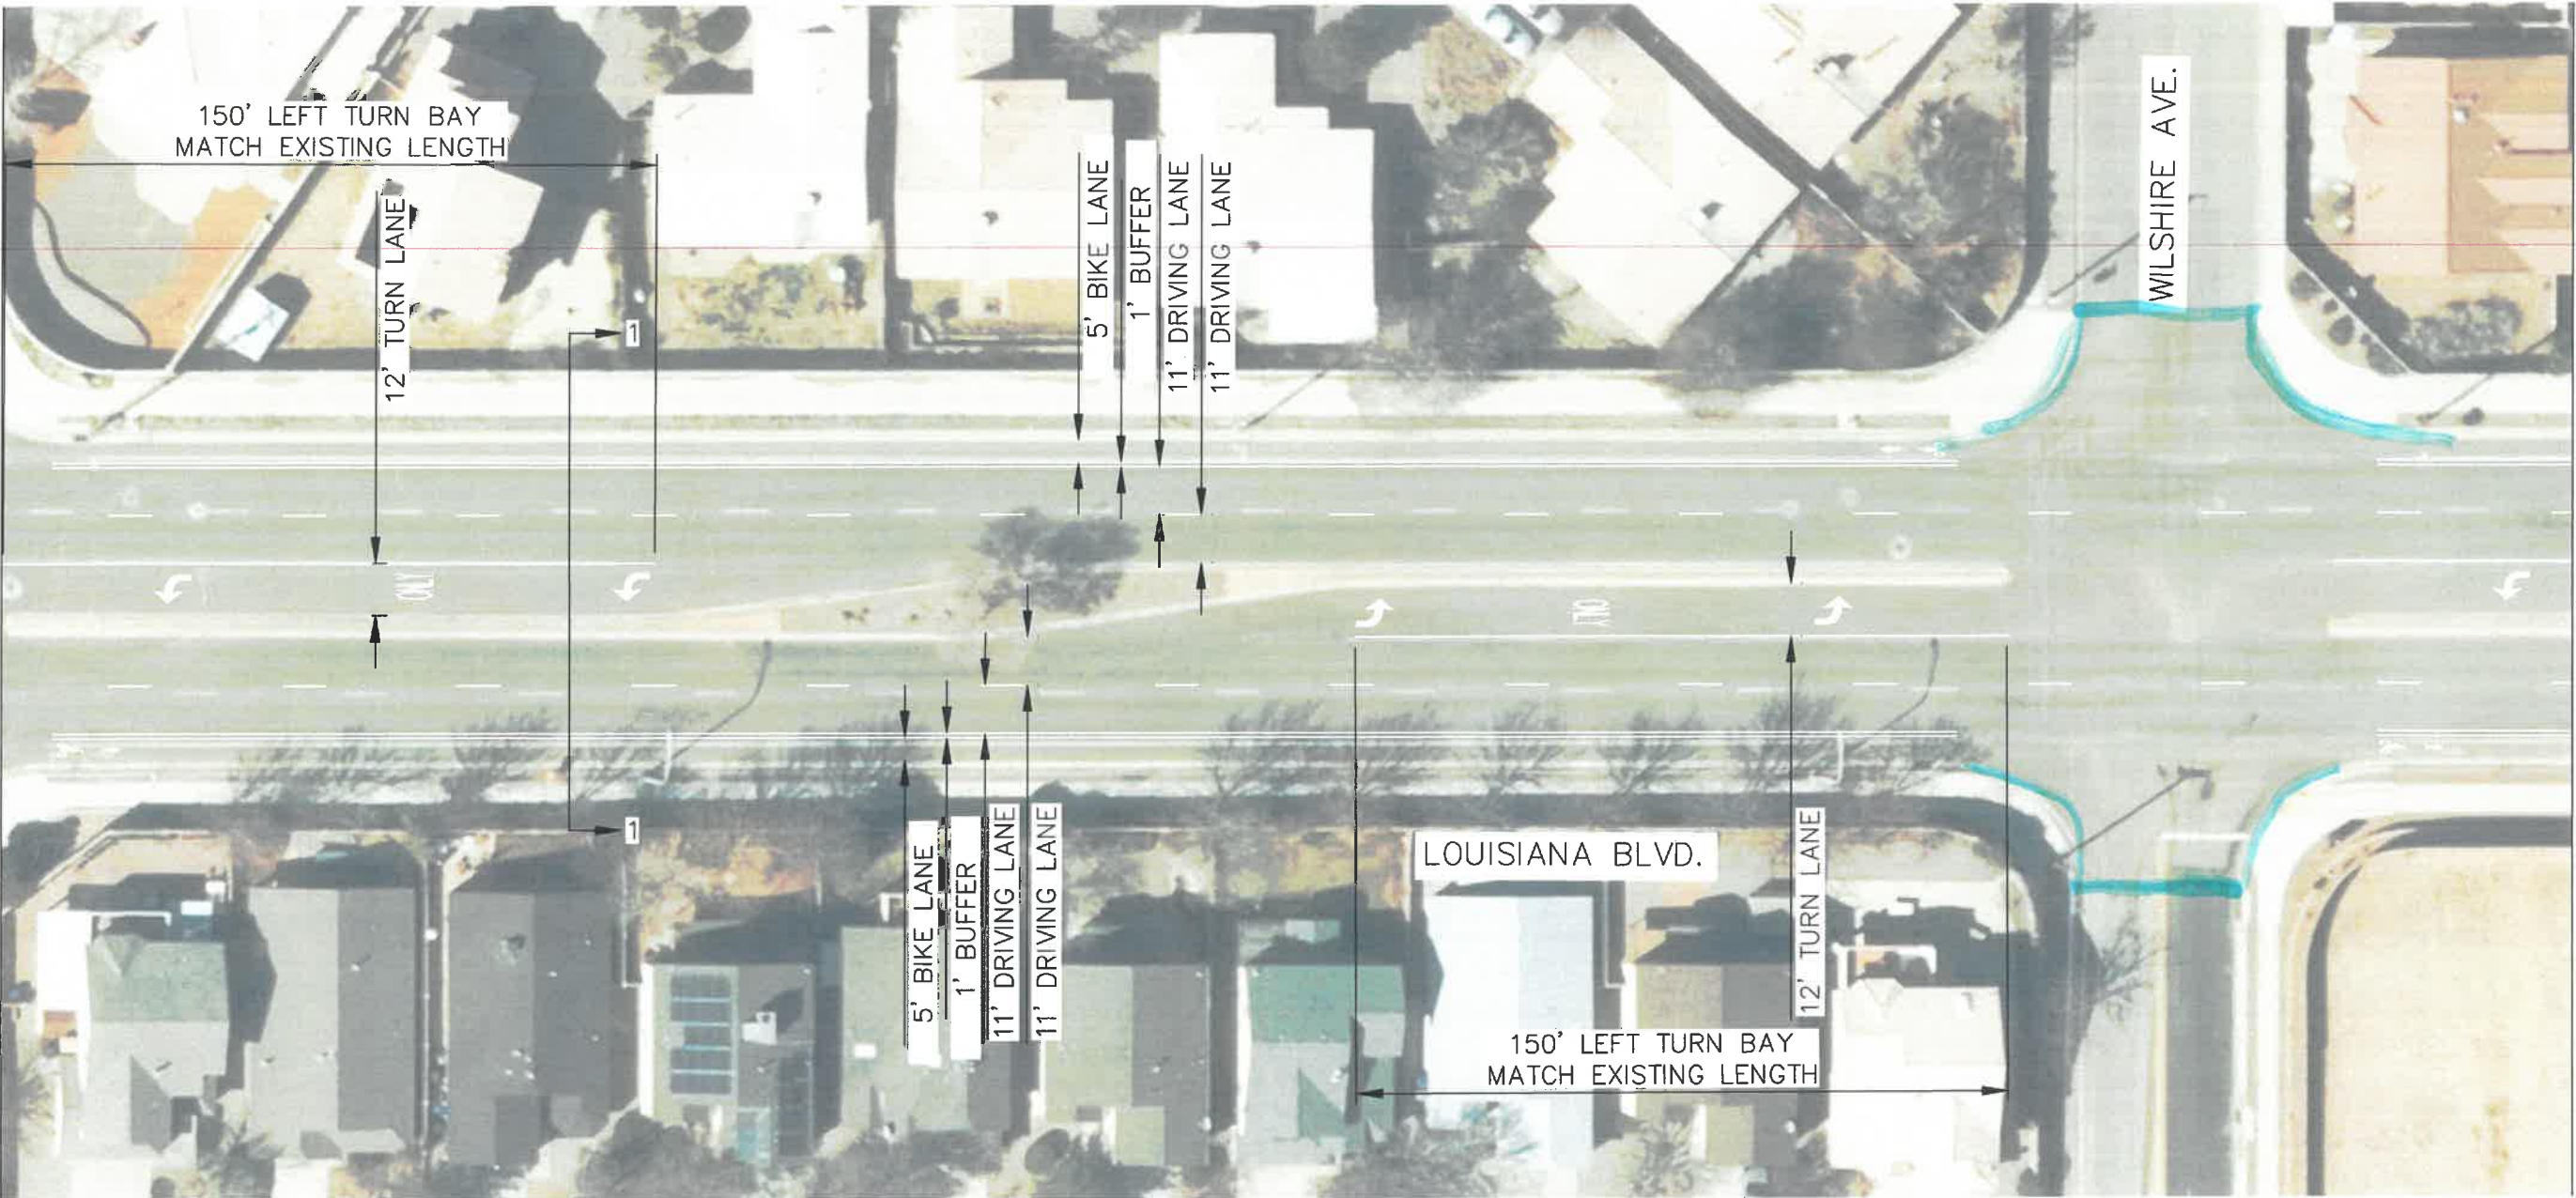


|   |                        |                 |             |
|---|------------------------|-----------------|-------------|
| <b>wsp</b><br>WSP USA, INC.<br>3040 LOUISIANA BLVD. NW<br>SUITE 400<br>ALBUQUERQUE, NM 87110<br>TEL: +1 505.861.5357                                                                      |                        |                 |             |
| CITY OF ALBUQUERQUE<br>DEPARTMENT OF MUNICIPAL DEVELOPMENT<br>ENGINEERING DIVISION<br>COMPLETE STREETS STRIPING<br>IMPLEMENTATION CONCEPT<br>LOUISIANA BLVD. - CARMEL AVE. TO SIGNAL AVE. |                        |                 |             |
| DESIGN REVIEW COMMITTEE   | CITY ENGINEER APPROVAL | MO./DAY/YR.     | MO./DAY/YR. |
|   |                        |                 |             |
|   |                        |                 |             |
|   |                        |                 |             |
|   |                        |                 |             |
| City Project No.   | Zone Map No.           | Sheet<br>3 OF 4 |             |



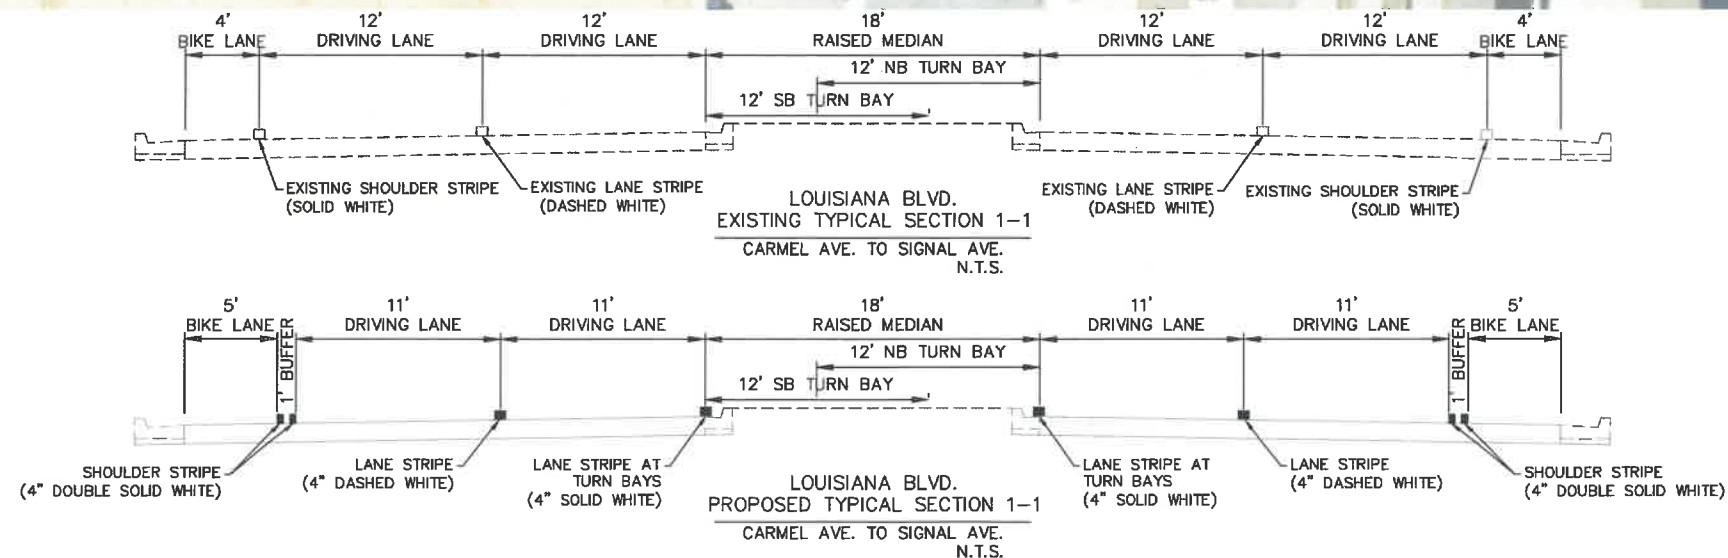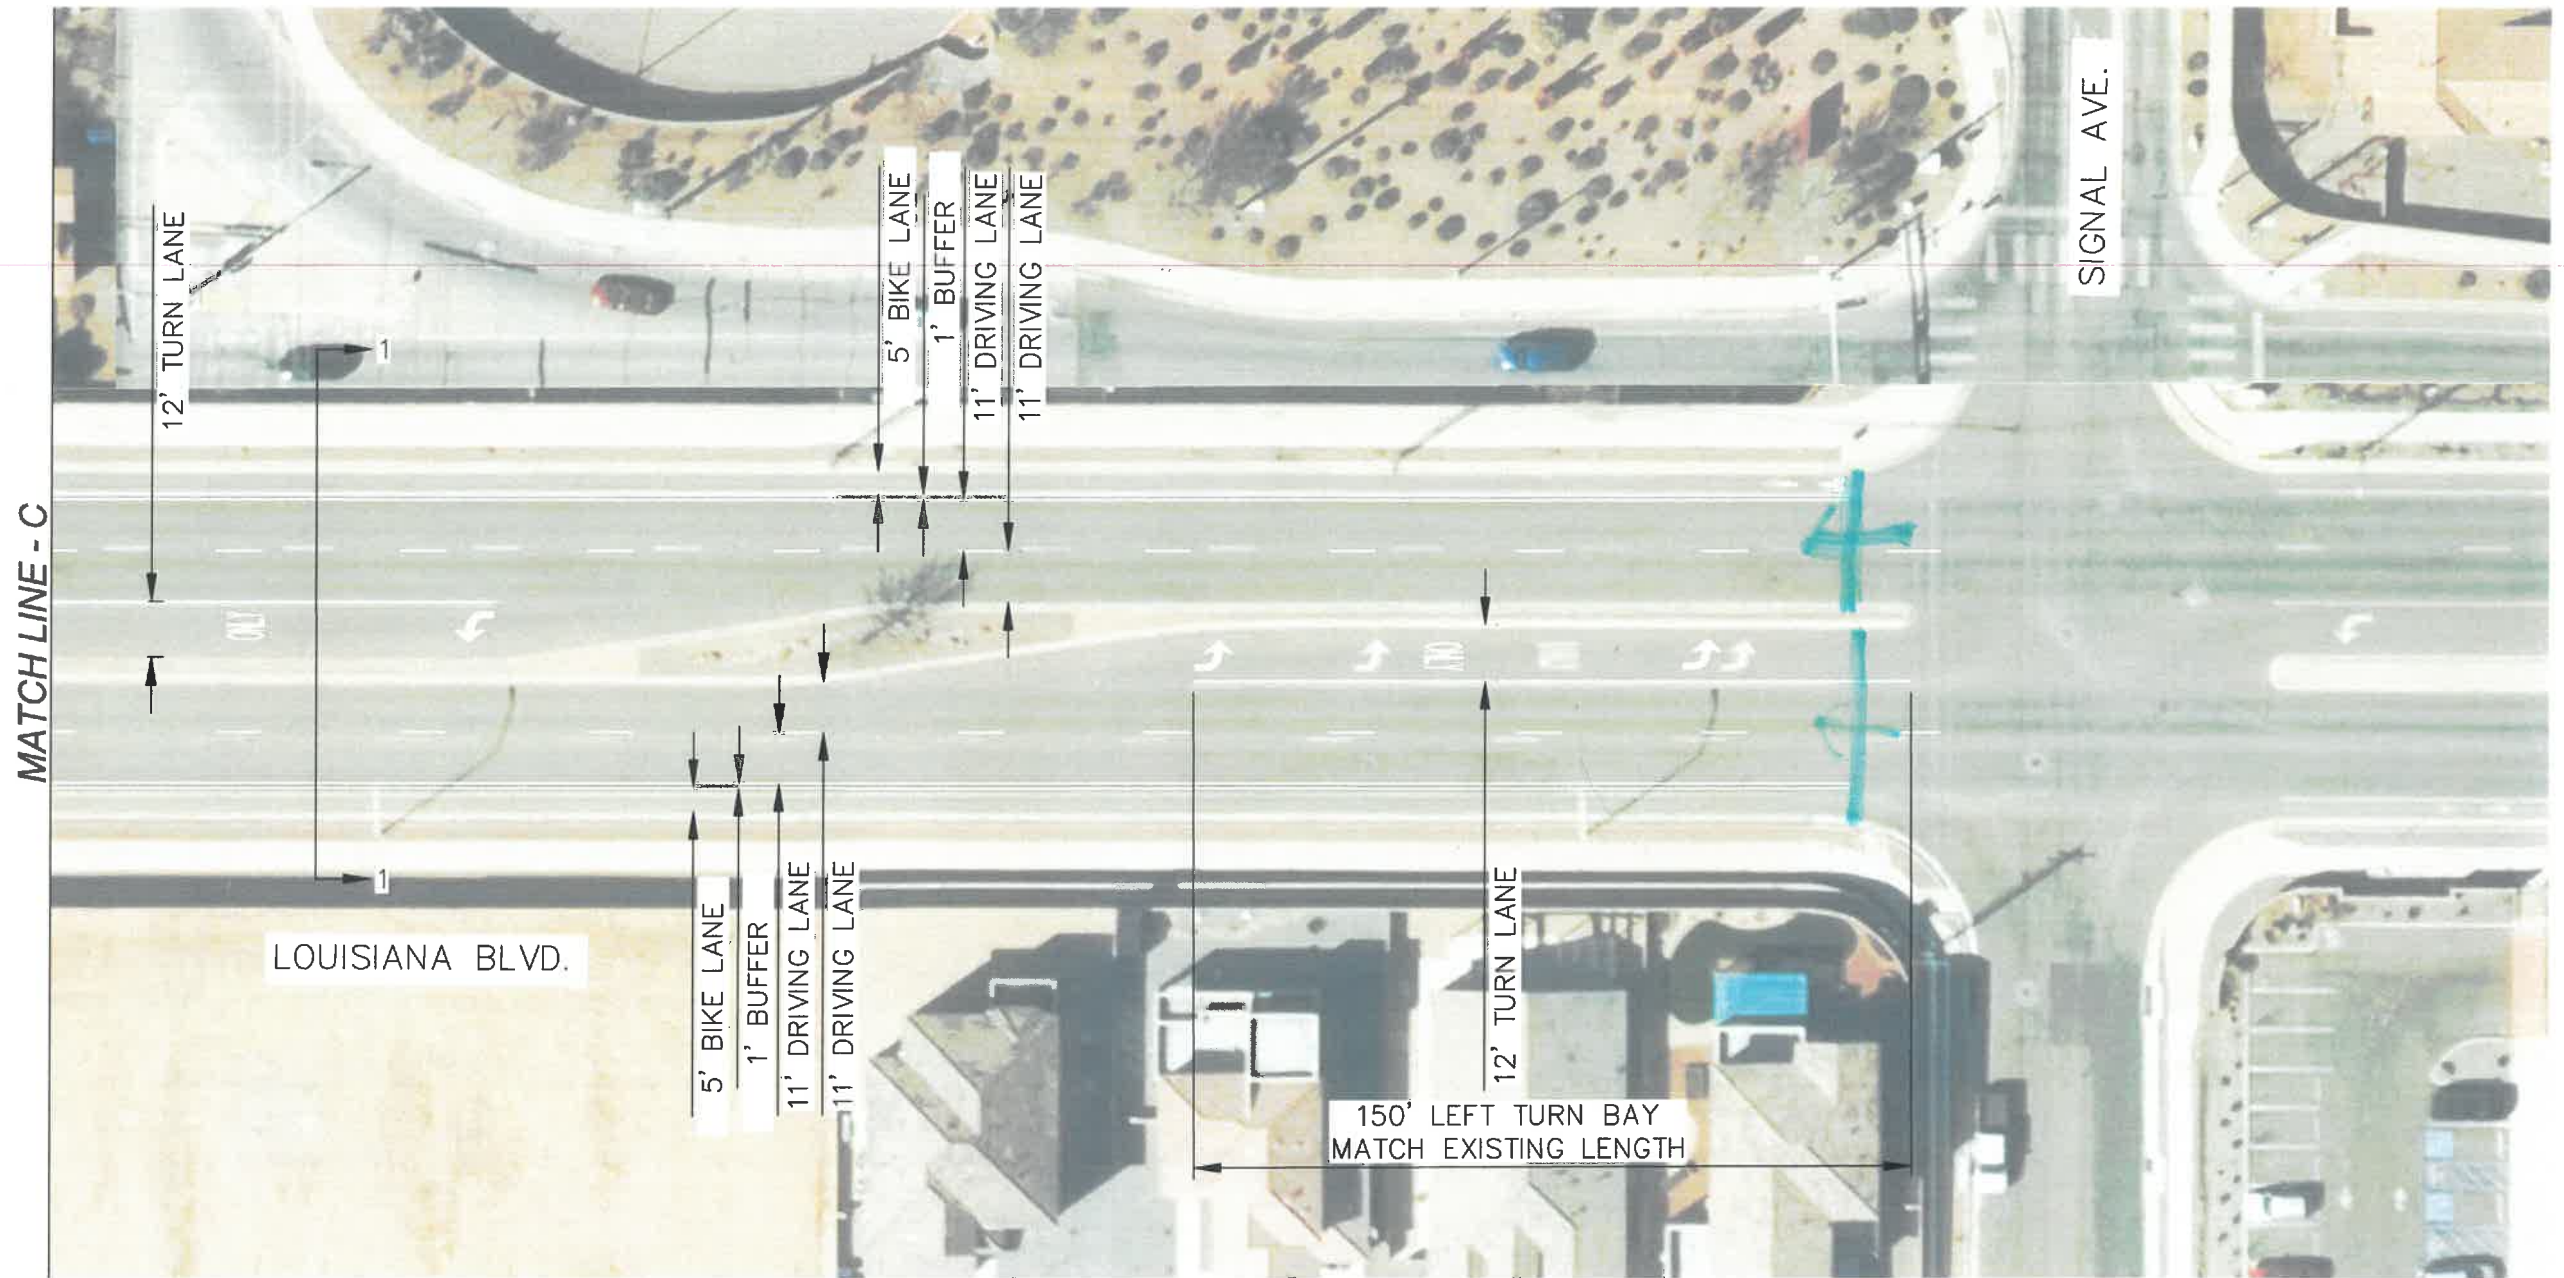

NOTE: SCALE IS BASED ON A FULL SIZE (22"x34") SHEET.

|   |                        |                 |             |
|---|------------------------|-----------------|-------------|
| <b>wsp</b><br><small>WSP USA INC.<br/>2440 LOUISIANA BLVD. SE<br/>SUITE 400<br/>ALBUQUERQUE, NM 87110<br/>TEL: 415.861.5357</small>                                                              |                        |                 |             |
| <b>CITY OF ALBUQUERQUE</b><br>DEPARTMENT OF MUNICIPAL DEVELOPMENT<br>ENGINEERING DIVISION<br>COMPLETE STREETS STRIPING<br>IMPLEMENTATION CONCEPT<br>LOUISIANA BLVD. - CARMEL AVE. TO SIGNAL AVE. |                        |                 |             |
| DESIGN REVIEW COMMITTEE   | CITY ENGINEER APPROVAL | MO./DAY/YR.     | MO./DAY/YR. |
|   |                        |                 |             |
|   |                        |                 |             |
| City Project No.   | Zone Map No.           | Sheet<br>4 OF 4 |             |

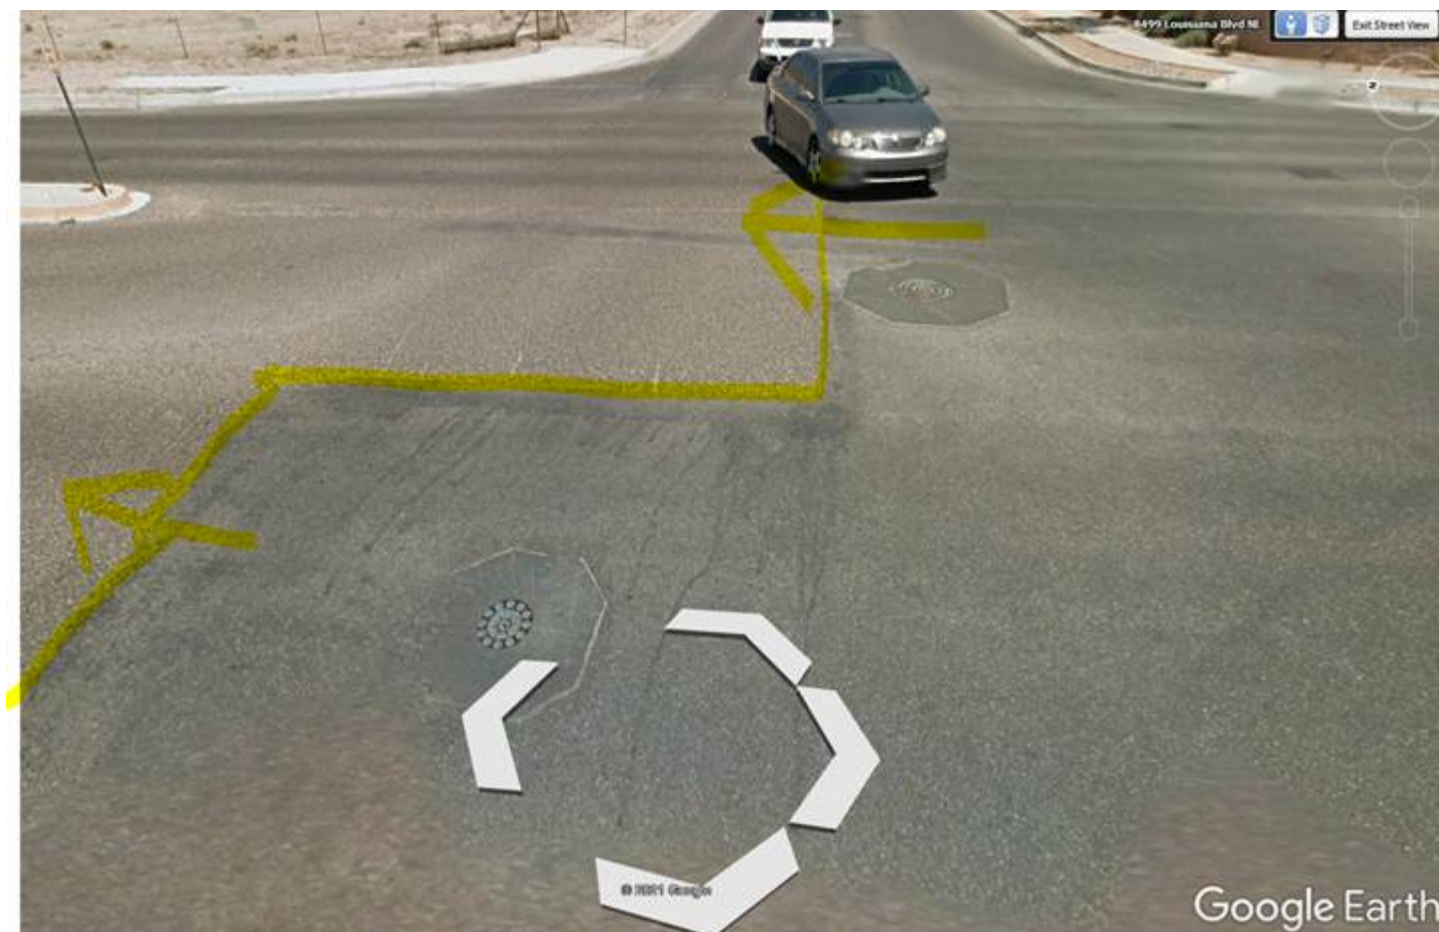

**From:** [noreply@cabq.gov](mailto:noreply@cabq.gov) <[noreply@cabq.gov](mailto:noreply@cabq.gov)>  
**Sent:** Tuesday, November 9, 2021 12:38 PM  
**To:** Woodall, Stephen P. <[swoodall@cabq.gov](mailto:swoodall@cabq.gov)>  
**Subject:** Message from KM\_C458