



South side



South side

Excavate and fill
two holes with lean
or flowable fill

Grade area and place
dumped rip rap




North side



North side

Reconnect pipe
segment with
reinforced collar
and backfill

Grade area and
place dumped rip rap

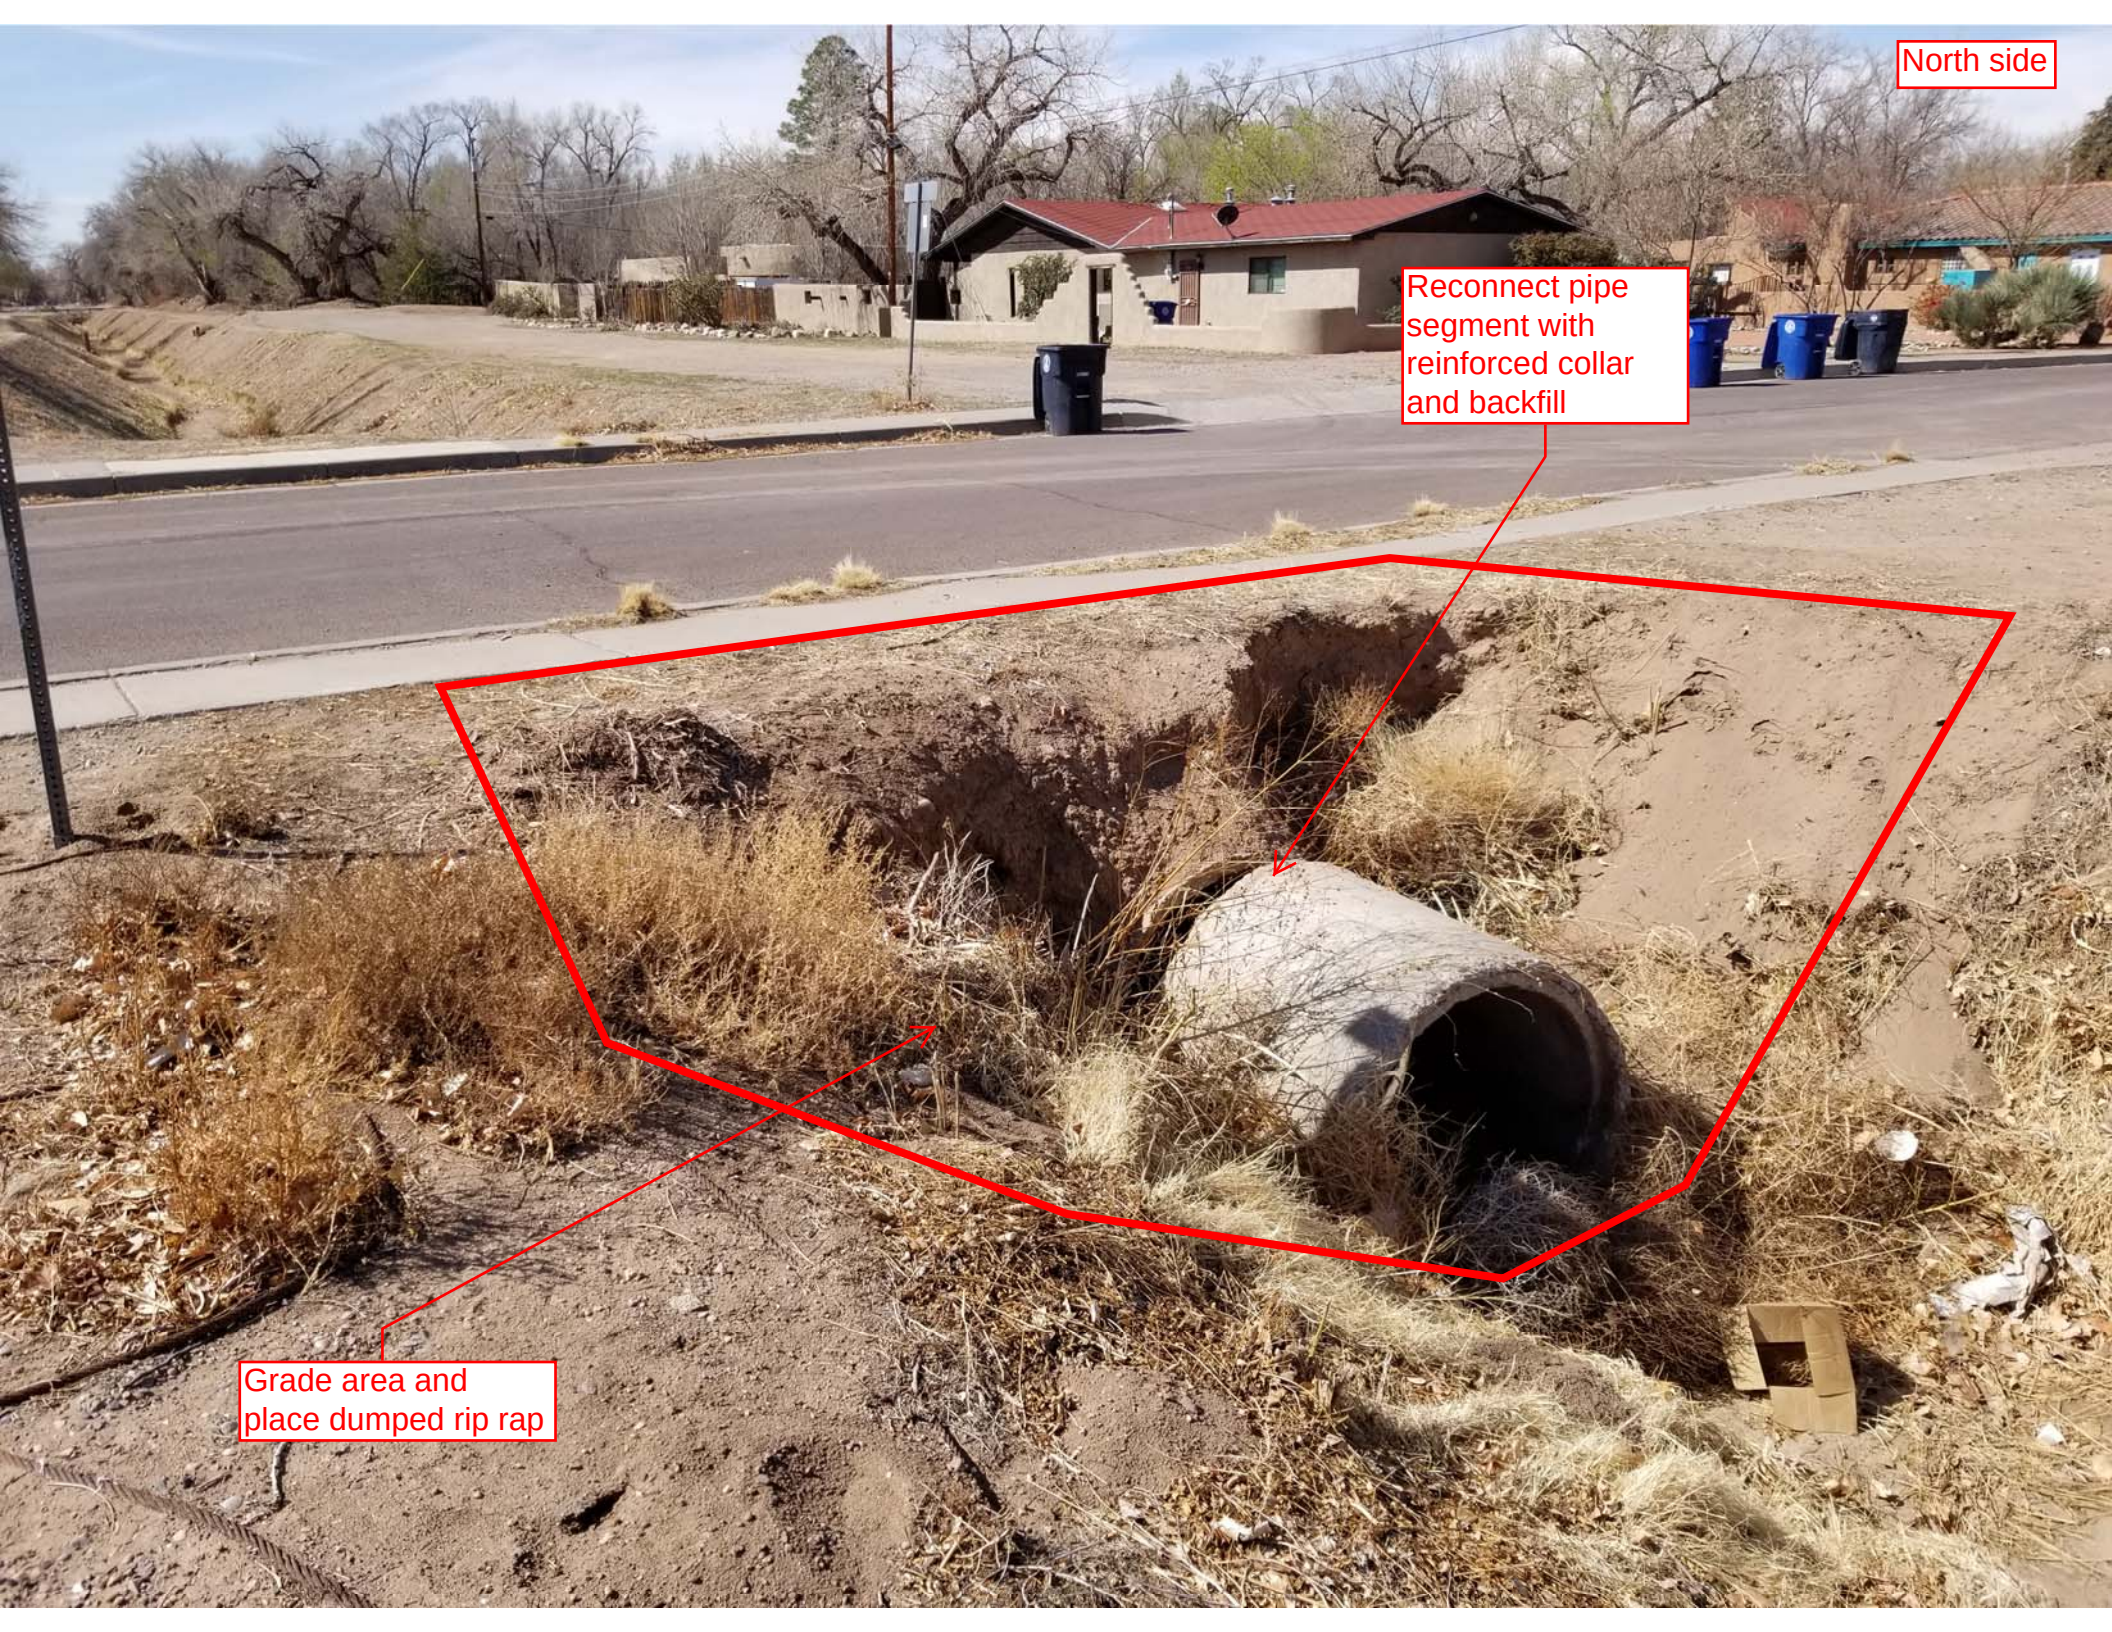



Excavate approx.
2'x2' area around
pothole, fill with
lean or flowable fill
and re-pave.

