






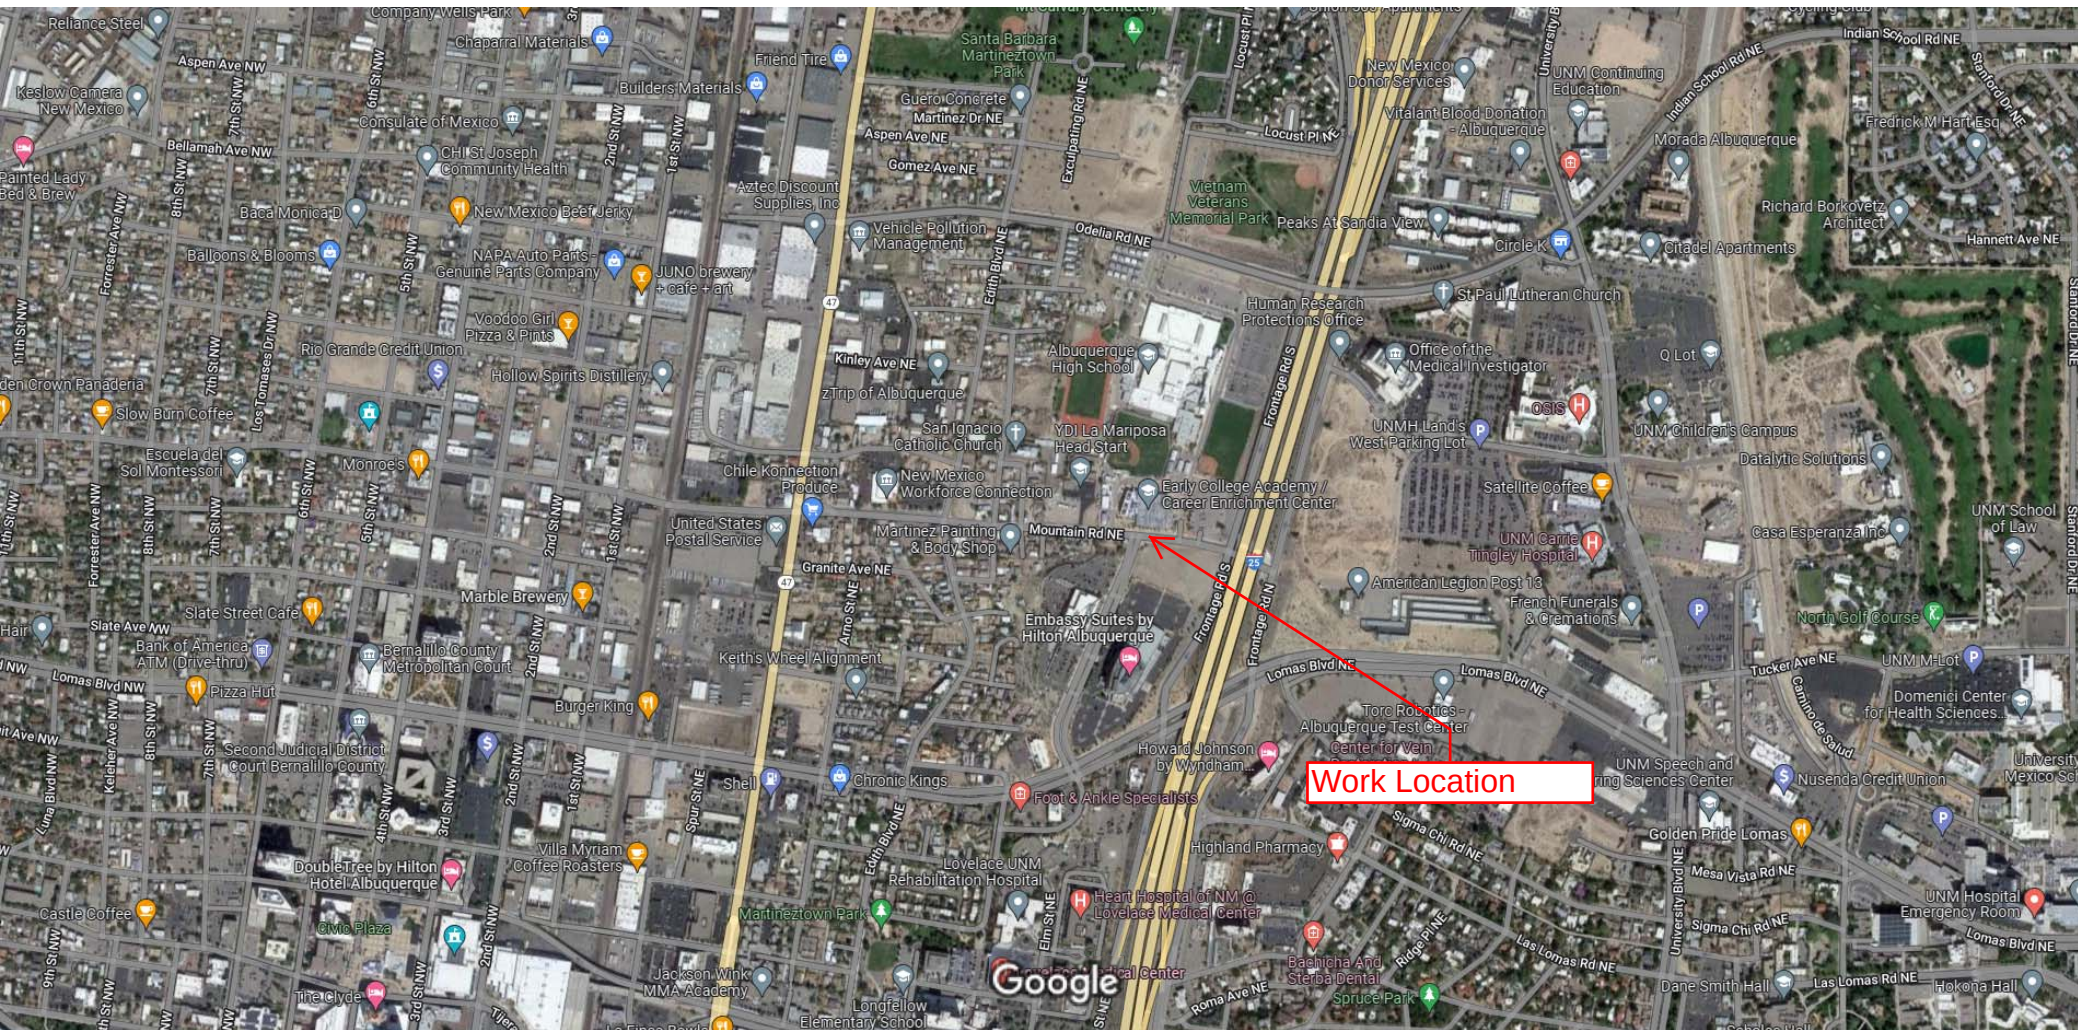

ADA Curb Ramp Documentation


Type: Mid-Block Parallel



NORTH

Where the turning space is constrained at the back-of-sidewalk, the turning space shall be 4' min by 5' min. The 5' dimension shall be provided in the direction of the ramp run. If the turning space is constrained on two or more sides the turning space shall be 5' long.

Running Slope — shall be 8.3% maximum but shall not require the ramp length to exceed 15'. To avoid chasing grade indefinitely when connecting to steep grades, the running slope shall be extended as flat as maximum extent practicable.

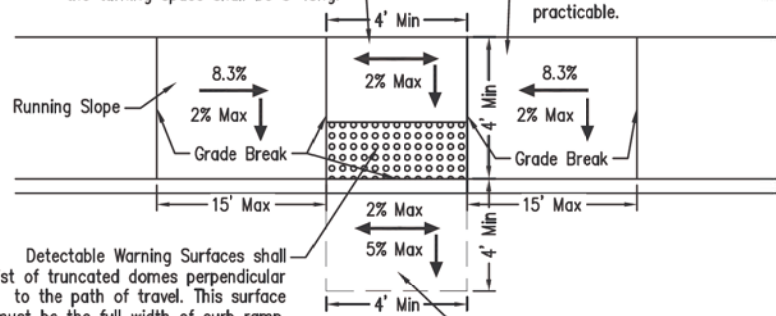


Detectable Warning Surfaces shall consist of truncated domes perpendicular to the path of travel. This surface must be the full width of curb ramp, 5' or less from the back of curb, and 2' deep.

Clear Space/Gutter Counter Slope — If the crossing is mid-block or a crossing without yield or stop control, the cross slope may match the grade of the road.

Vertical Surface Discontinuities

SCALE : N.T.S.

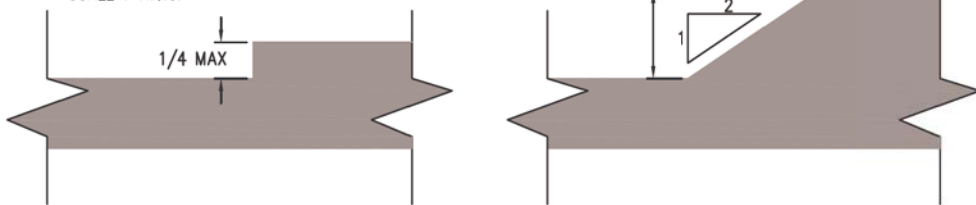

Vertical surface discontinuities shall be 0.5" maximum. Vertical discontinuities between 0.25" and 0.5" shall be beveled with a slope not steeper than 50%. The bevel shall be applied across the entire vertical surface discontinuity.




ADA Curb Ramp Documentation

Type: Mid-Block Parallel

COMMENTS:

**Figure 1 – Tubular Markers Supplementing
Centerline Markings**

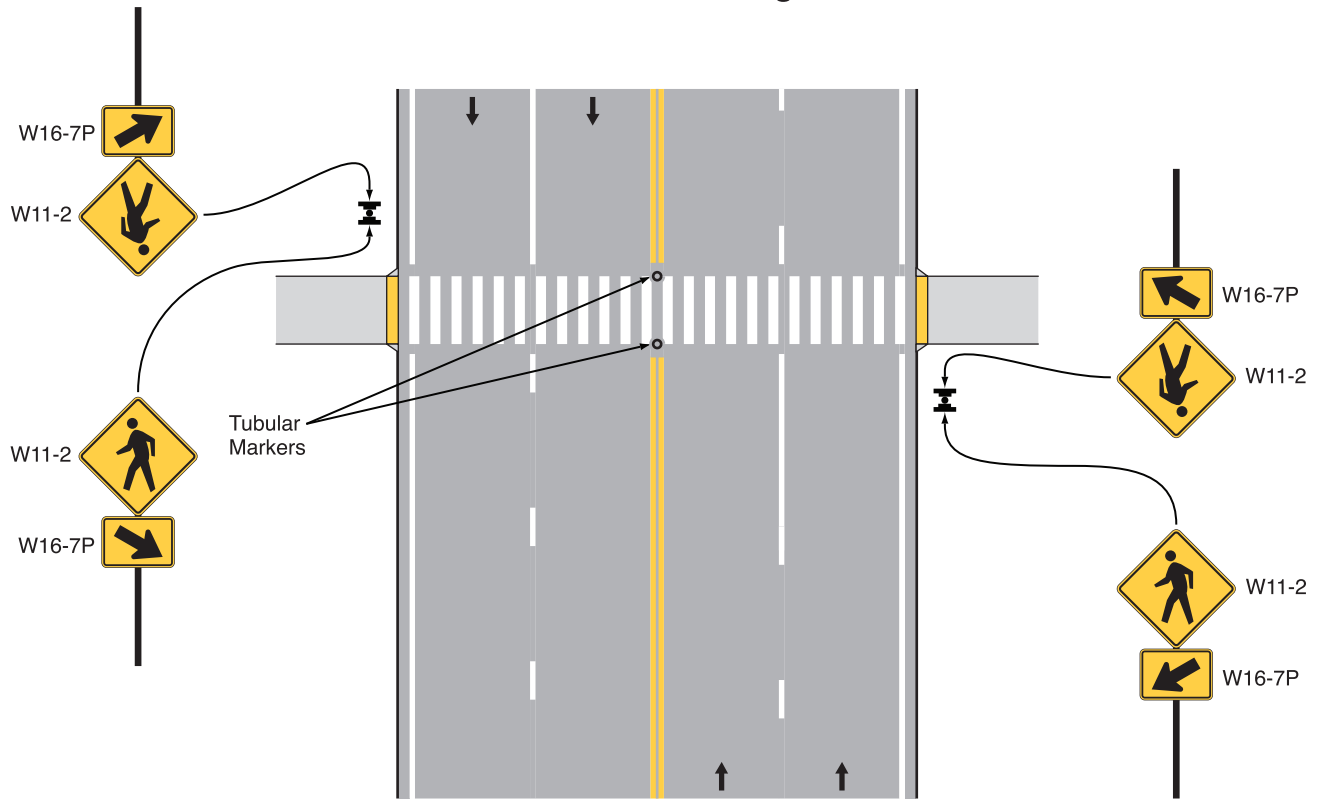

Signs shall be chartreuse in color, W11-2 dimension is 30"x30".
Do not install crosswalk striping or tubular markers.