


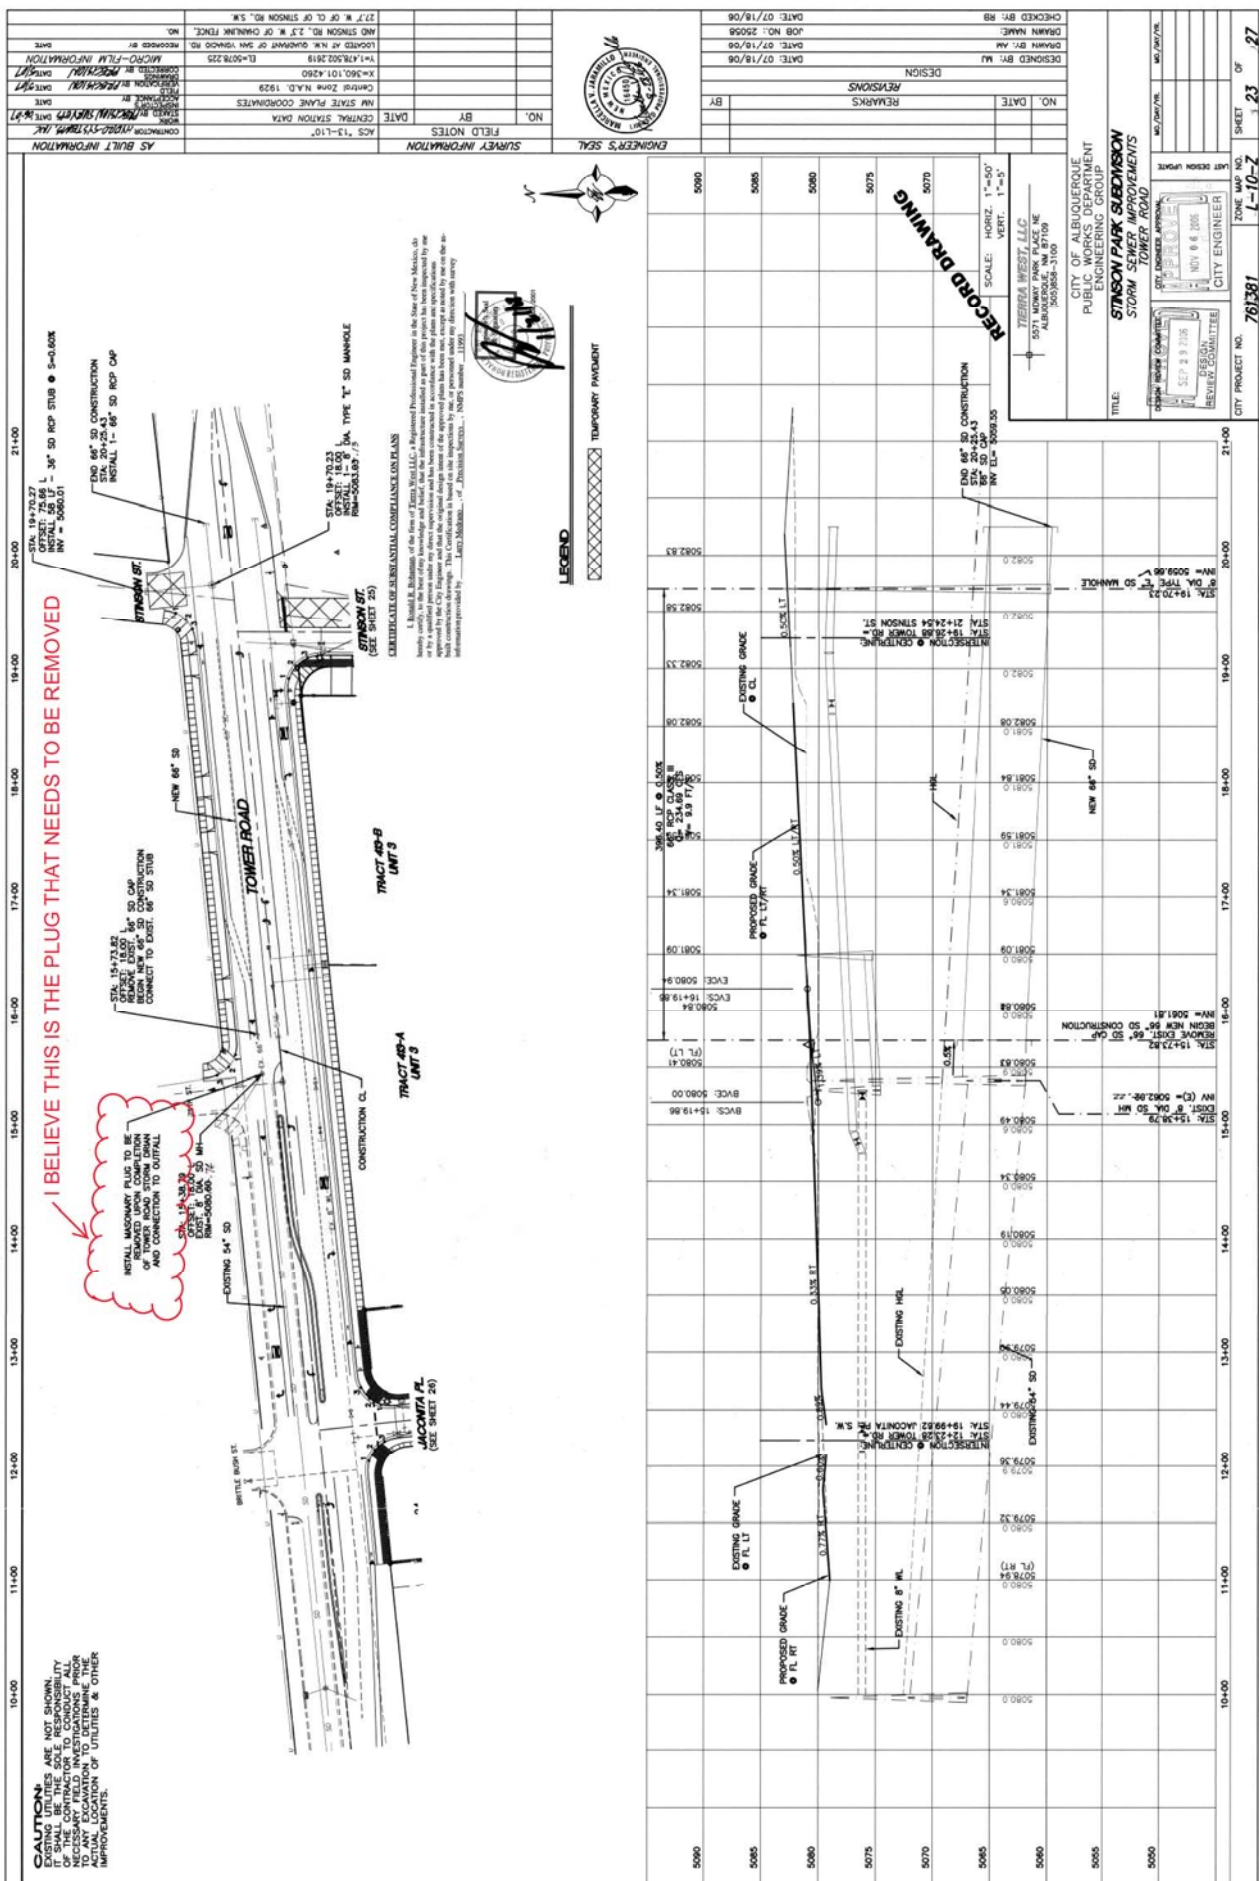

CAUTION:

I BELIEVE THIS IS THE PLUG THAT NEEDS TO BE REMOVED


