



☰ Gonzales Road Southwest, Albu 🔍 ✕

← **400 Sunset Rd SW**
Albuquerque, New Mexico

 Google Street View

Mar 2022 [See more dates](#)











Remove existing pavement, guardrail, and approximately 40 LF of culvert pipe. Replace with sufficient length of ~~36" RC pipe~~ and end sections to provide a minimum 10' lateral buffer from edge of road to top of slope. Construct concrete slope paving per attached details. Apron length to be approximately 5.5 LF, not 11.0 LF as indicated in drawing.


48" HERCP pipe

Slope paving
example at
Campbell Rd./
Griegos Drain




2018/02/26

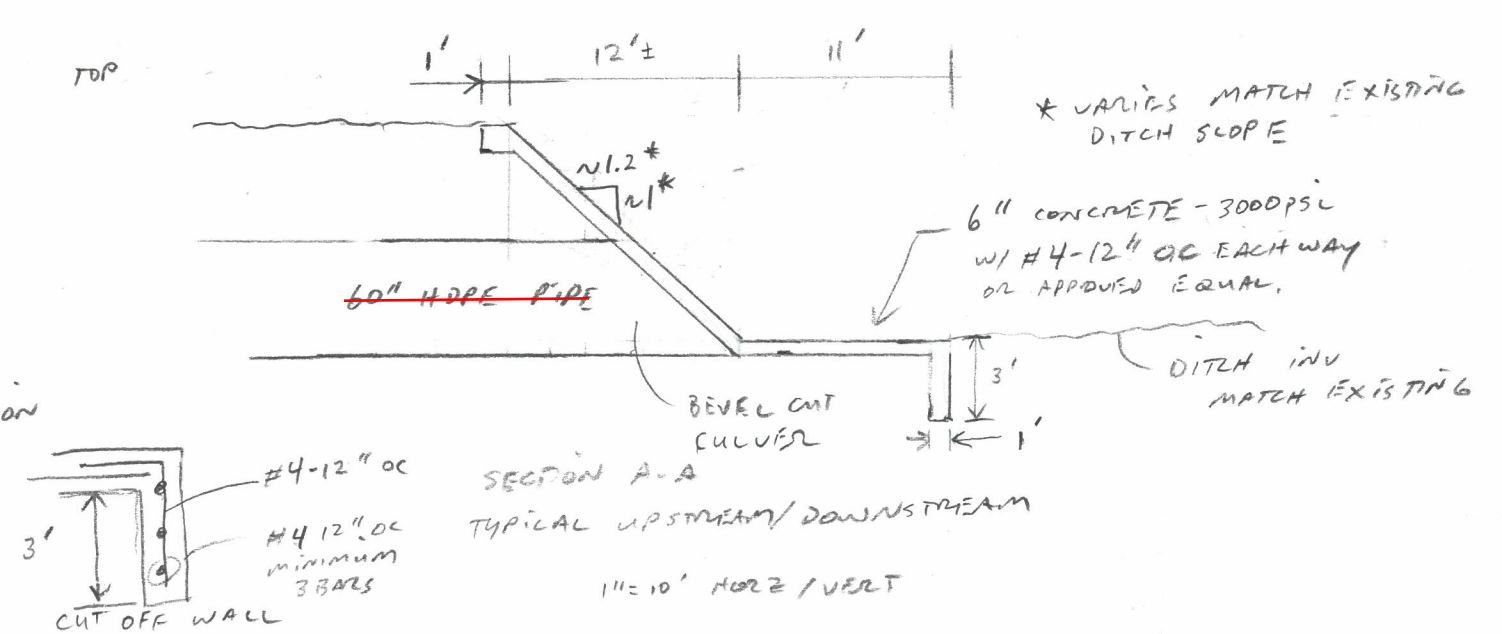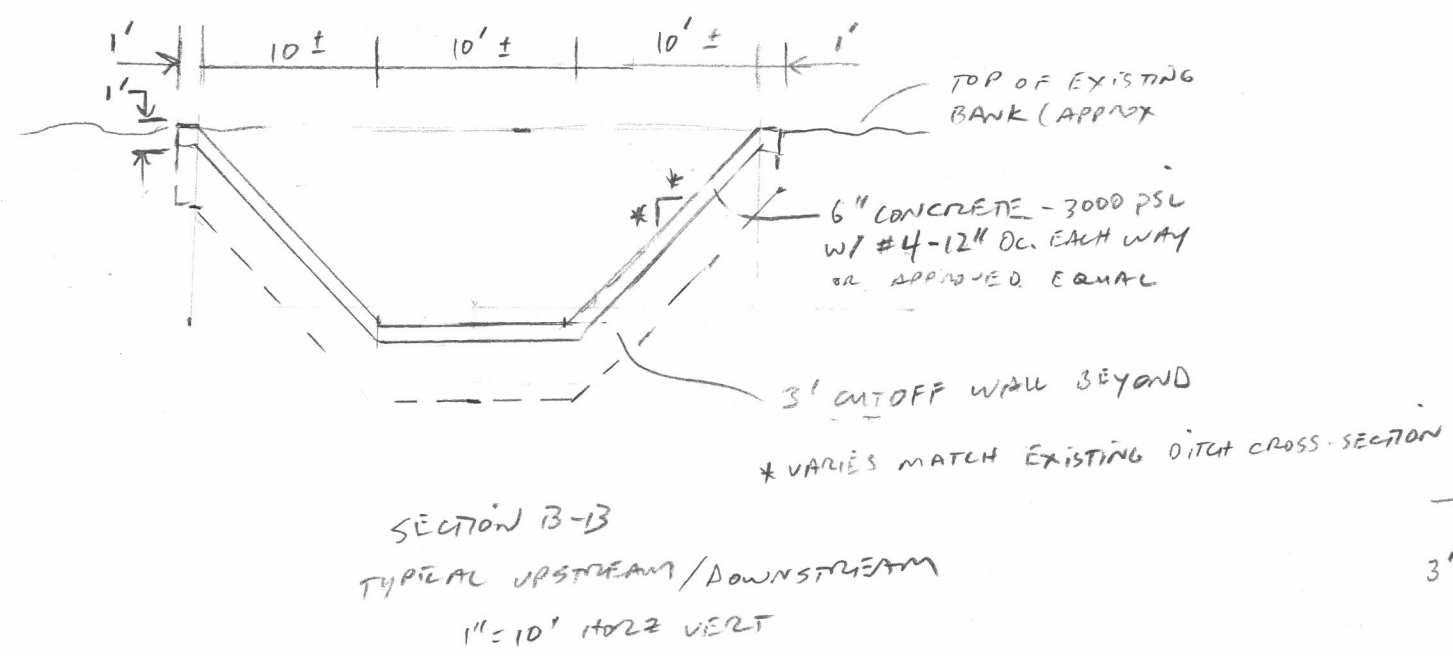


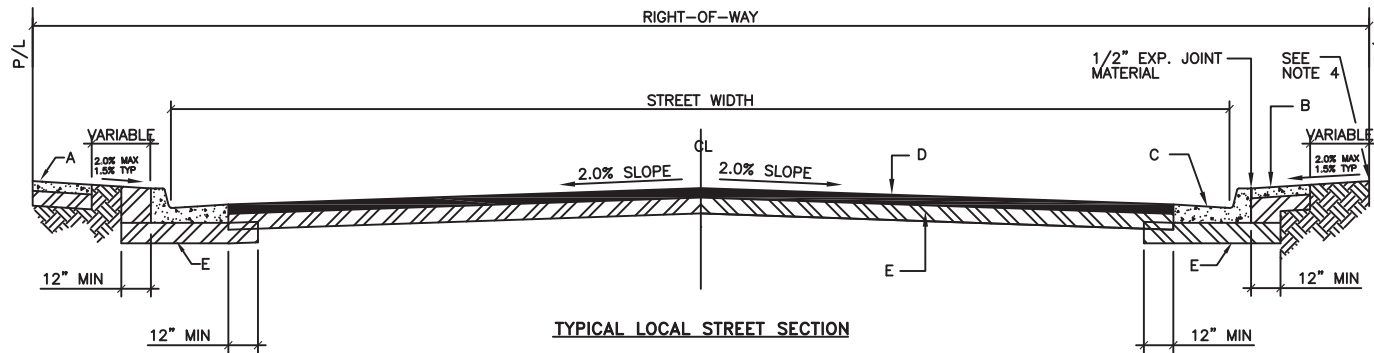

TYPICAL LOCAL STREET SECTION

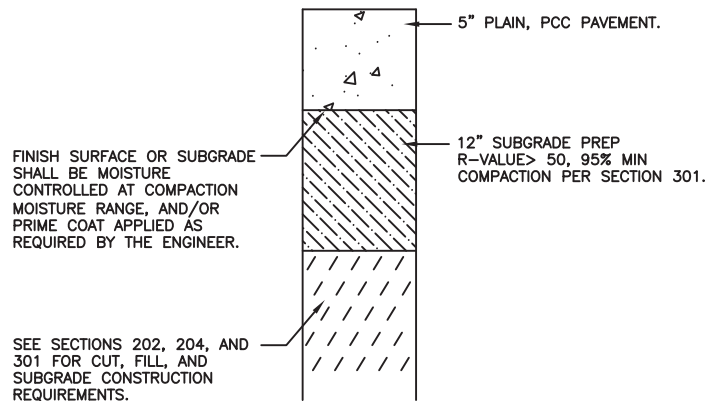

RIGID PAVEMENT SECTION

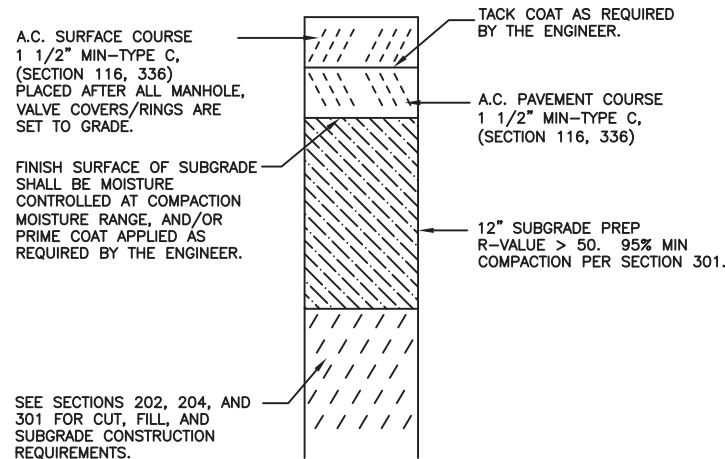

FLEXIBLE PAVEMENT SECTION

GENERAL NOTES:

1. CROWN ON STREET SHALL BE AS FOLLOWS:
 - a. 32' STREET = 4"
 - b. 40' STREET = 5"
 - c. LESS THAN 32' STREET, PAVEMENT SLOPE = 2%
2. ALL SUBGRADE COMPACTION FOR C & G SHALL EXTEND 12" MIN ON EITHER SIDE OF C & G OR CURB SECTION.
3. SUBGRADE PREPARATION UNDER SIDEWALK AND DRIVE PADS SHALL BE INCIDENTAL TO ITEM.
4. FINISH GRADE AT PROPERTY LINE SHALL BE BASED ON A MIN 2% SLOPE FROM TOP OF CURB.
5. ALL ASPHALT CONCRETE (AC) PAVEMENT SHALL COMPLY WITH SECTION 116.
6. ALL PORTLAND CEMENT CONCRETE (PCC) PAVEMENT SHALL COMPLY WITH SECTION 101.
7. IN ACCORDANCE WITH COA DPM THE FOLLOWING APPLIES UNLESS AUTHORIZED OTHERWISE BY THE CITY ENGINEER:
 - * RESIDENTIAL STREETS SERVING 50 LOTS OR LESS SHALL BE DESIGNED AS LOCAL RESIDENTIAL STREETS.
 - * RESIDENTIAL STREETS SERVING MORE THAN 50 LOTS WITH AN ANTICIPATED AWDT < 3000 SHALL BE DESIGNED AS MAJOR LOCAL STREETS.
8. FOR SUBGRADE R-VALUE < 50, PAVEMENT SECTION SHALL BE DESIGNED IN ACCORDANCE WITH DPM CH. 07
9. SUBGRADE PREPARATION SHALL BE PERFORMED AFTER ALL SUBSURFACE UTILITIES ARE CONSTRUCTED.

CONSTRUCTION NOTES:

- A. SIDEWALK AT STANDARD SETBACK.
- B. SIDEWALK ADJACENT TO CURB. (NON-STANDARD, VARIANCE REQUIRED).
- C. CURB AND GUTTER HEIGHT TO BE SPECIFIED ON PLANS.
- D. ASPHALT CONCRETE (AC) OR PORTLAND CEMENT (PCC) PAVEMENT.
- E. 12" COMPACTED SUBGRADE PREP, 95% COMPACTION.

REVISIONS	CITY OF ALBUQUERQUE
06/2019	PAVING LOCAL - RESIDENTIAL STREET SECTION DWG. 2405A JUNE 2019