


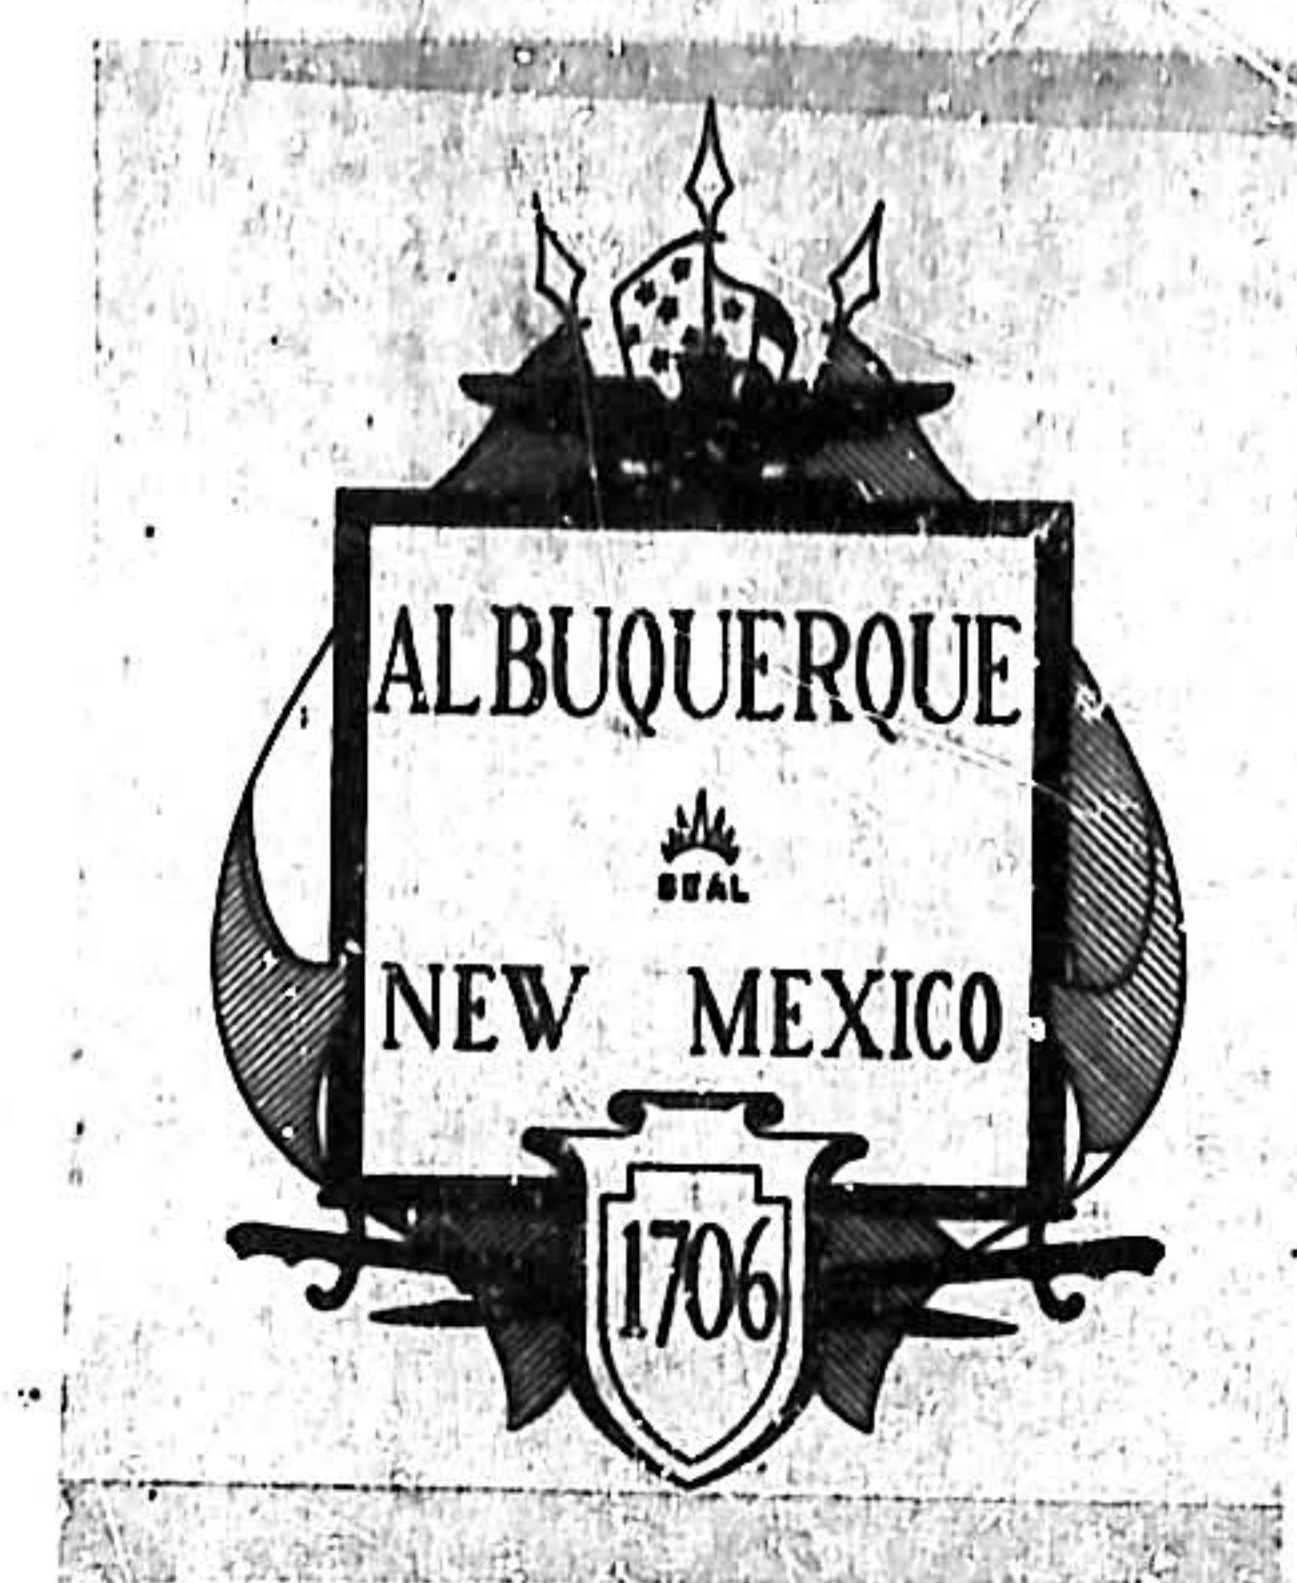

CITY OF ALBUQUERQUE
DEPARTMENT OF PUBLIC WORKS

SPECIAL ASSESSMENT DISTRICT No 173
(PAVING) (WATER) (SANITARY SEWER) (STORM SEWER)

INDEX		INDEX		INDEX	
Sheet No	Description	Sheet No	Description	Sheet No	Description
1.	TITLE SHEET & INDEX TO DRAWINGS	29.	VICINITY MAP (WATER SYSTEM IMPROVEMENTS)	52.	VICINITY MAP (STORM SEWER IMPROVEMENTS)
2.	VICINITY MAP - (PAVING)	30.	LOCATION PLAT (WATER SYSTEM IMPROVEMENTS)	53.	LOCATION PLAT (STORM SEWER IMPROVEMENTS)
3.	LOCATION PLAT - (PAVING)	31.	LOCATION PLAT (WATER SYSTEM IMPROVEMENTS)	54-57.	PLAN & PROFILE SHEETS (STORM SEWER IMPROVEMENTS)
4.	LOCATION PLAT - (PAVING)	32-40.	PLAN & PROFILE SHEETS (WATER SYSTEM IMPROVEMENTS)	54.	BELL AVE. - ALTEZ ST.
5.	LOCATION PLAT - (PAVING)	32.	ACOMA ROAD - GENERAL PATCH	55.	COCHITI RD. - ACOMA RD.
6.	LOCATION PLAT - (PAVING)	33.	ERBBE ST. - ALTEZ ST.	56.	MOON ST. - GENERAL ARNOLD - COLUMBIA DR.
7-29.	PLAN & PROFILE SHEETS (PAVING)	34.	COCHITI RD. - COCHITI RD. - MADISON ST.	57.	ALAMO AVENUE
7.	GENERAL ARNOLD - ALTEZ ST. - PARKVIEW PL.	35.	BELL AVE. - ALTEZ ST.	57-a.	RHODE ISLAND
8.	GENERAL STILLWELL - GENERAL PATCH - GENERAL SOMERVELL	36.	ALTEZ ST - GENERAL SOMERVELL - GENERAL STILLWELL	58-71.	STANDARD DETAIL SHEETS
9.	ERBBE ST. - ALTEZ ST.	37.	RHODE ISLAND ST. - ESPANOLA ST. - FLORIDA ST. - VAIL AVE	58.	TYPICAL ROADWAY SECTIONS & MISC. DETAILS
10.	LINN AVE. - CHELWOOD PARK BLVD.	38.	GENERAL CHENAULT ST. - ALAMO AVE. - TRUMBULL AVE.	59.	STANDARD WATER DETAILS
11.	VAIL AVE. - DAKOTA ST.	39.	ALAMO AVE. - COLUMBIA DR.	60.	STANDARD WATER DETAILS
12.	COCHITI RD.			61.	METER BOX DETAILS
13.	DOROTHY ST. - ELIZABETH ST. - SHIRLEY ST.	40.	VICINITY MAP (SANITARY SEWER IMPROVEMENTS)	62.	VALVE BOX DETAILS
14.	COCHITI RD.	41.	LOCATION PLAT (SANITARY SEWER IMPROVEMENTS)	63.	SERVICE CONNECTIONS & TRENCH CUT DETAILS
15.	ACOMA RD. - RHODE ISLAND ST.	42-51.	PLAN & PROFILE SHEETS (SANITARY SEWER IMPROVEMENTS)	64.	STORM SEWER MISCELLANEOUS DETAILS
16.	BELL AVENUE	42.	COCHITI RD.	65.	STANDARD MANHOLE DETAILS
17.	TRUMBULL AVE. - COLUMBIA DR.	43.	ERBBE ST. - ALTEZ ST.	66.	STANDARD MANHOLE DETAILS
18.	SUSAN AVENUE	44.	GENERAL STILLWELL ST. - GENERAL PATCH ST. - GENERAL SOMERVEL ST.	67.	STANDARD DETAILS
19.	MOON STREET	45.	BELL AVENUE	68.	STANDARD DROP INLET DETAILS
20.	BELL AVE. - ALTEZ ST.	46.	GENERAL PATCH	69.	LAYOUT SHEET & MISC. DETAILS STORM SEWERS (YALE & ALAMO)
21.	SKYVIEW AVE. - GROVE PL. - ESPANOLA ST. - TENNESSEE ST.	47.	MADISON ST. - GROVE PL. - MOON ST. - GENERAL CHENAULT ST.	70.	STANDARD TRAFFIC CONTROL SIGNS
22.	SAN PEDRO DR. - RHODE ISLAND ST. -	48.	SUSAN AVENUE		
23.	ALLEY - ALLEY - ALLEY - CHICO RD. - GRAND AVE.	49.	ACOMA ROAD		
24.	MADISON ST - ZUNI RD.	50.	TRUMBULL AVE. - ALAMO AVE.		
25.	GENERAL PATCH ST - LINN AVE. - FLORIDA ST.	51.	ALAMO AVENUE - COLUMBIA DRIVE		
26.	DOMINGO RD. - GENERAL CHENAULT ST. - BUENA VISTA DR. - COLUMBIA DR. - ALLEY				
27.	ALAMO AVENUE				
28.	ALAMO AVENUE				

1	2	3	4	5	6	7	8	9	10	11	12	13	14	15	16	17	18	19	20	21	22	23	24	25	26	27	28	29
10	173	01	70	20	20	20	20	20																				
07																												
08																												
09																												

AS BUILT DRAWING



RECOMMENDED D. F. MOLZEN & ASSOC.

CHAIRMAN OF THE COMMISSION.....*Richard H. Wilson*.....
CITY MANAGER.....*Richard H. Wilson*.....
CITY ENGINEER.....*William J. Heron*.....
DIRECTOR OF PUBLIC WORKS.....*D. F. Molzen*.....
CITY ATTORNEY.....*D. F. Molzen*.....

TITLE SHEET

D. F. MOLZEN & ASSOCIATES
Consulting Engineers
ALBUQUERQUE NEW MEXICO

Drawn	Checked	Sheet
File	Date	1 of

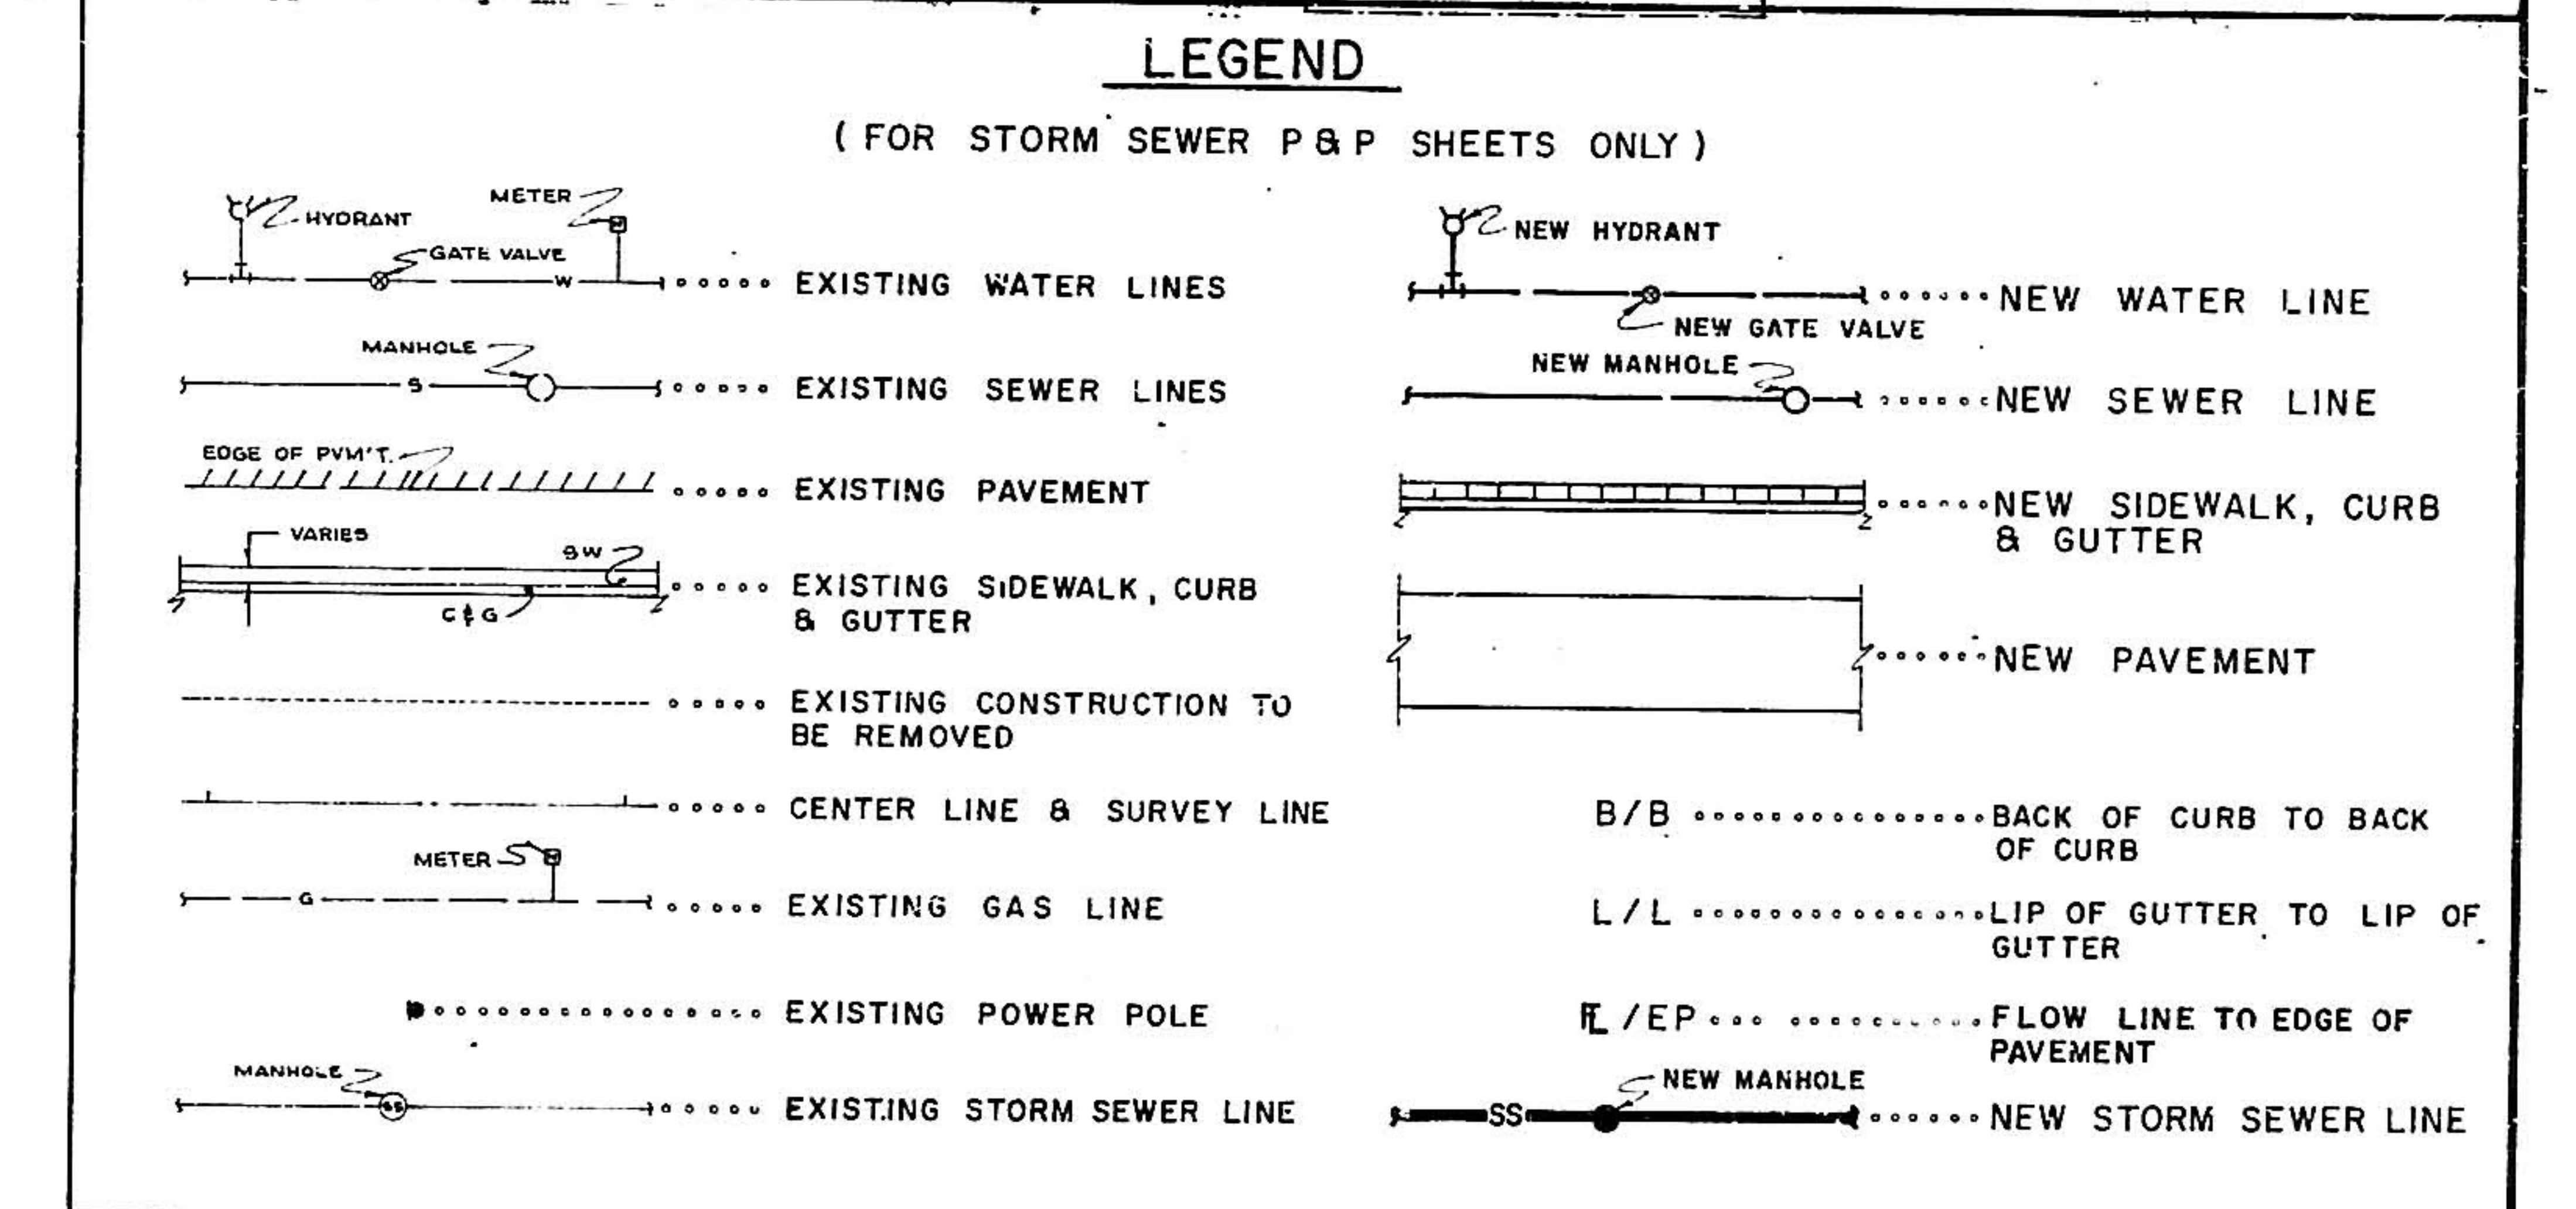 






08 173 5270 21

ALBUQUERQUE, NEW MEXICO
SPECIAL ASSESSMENT DISTRICT NO.173

**STORM SEWER
VICINITY MAP**

D. F. MOLZEN & ASSOCIATES
Consulting Engineers
ALBUQUERQUE NEW MEXICO

Drawn	Checked	Sheet
File	Date	52 of

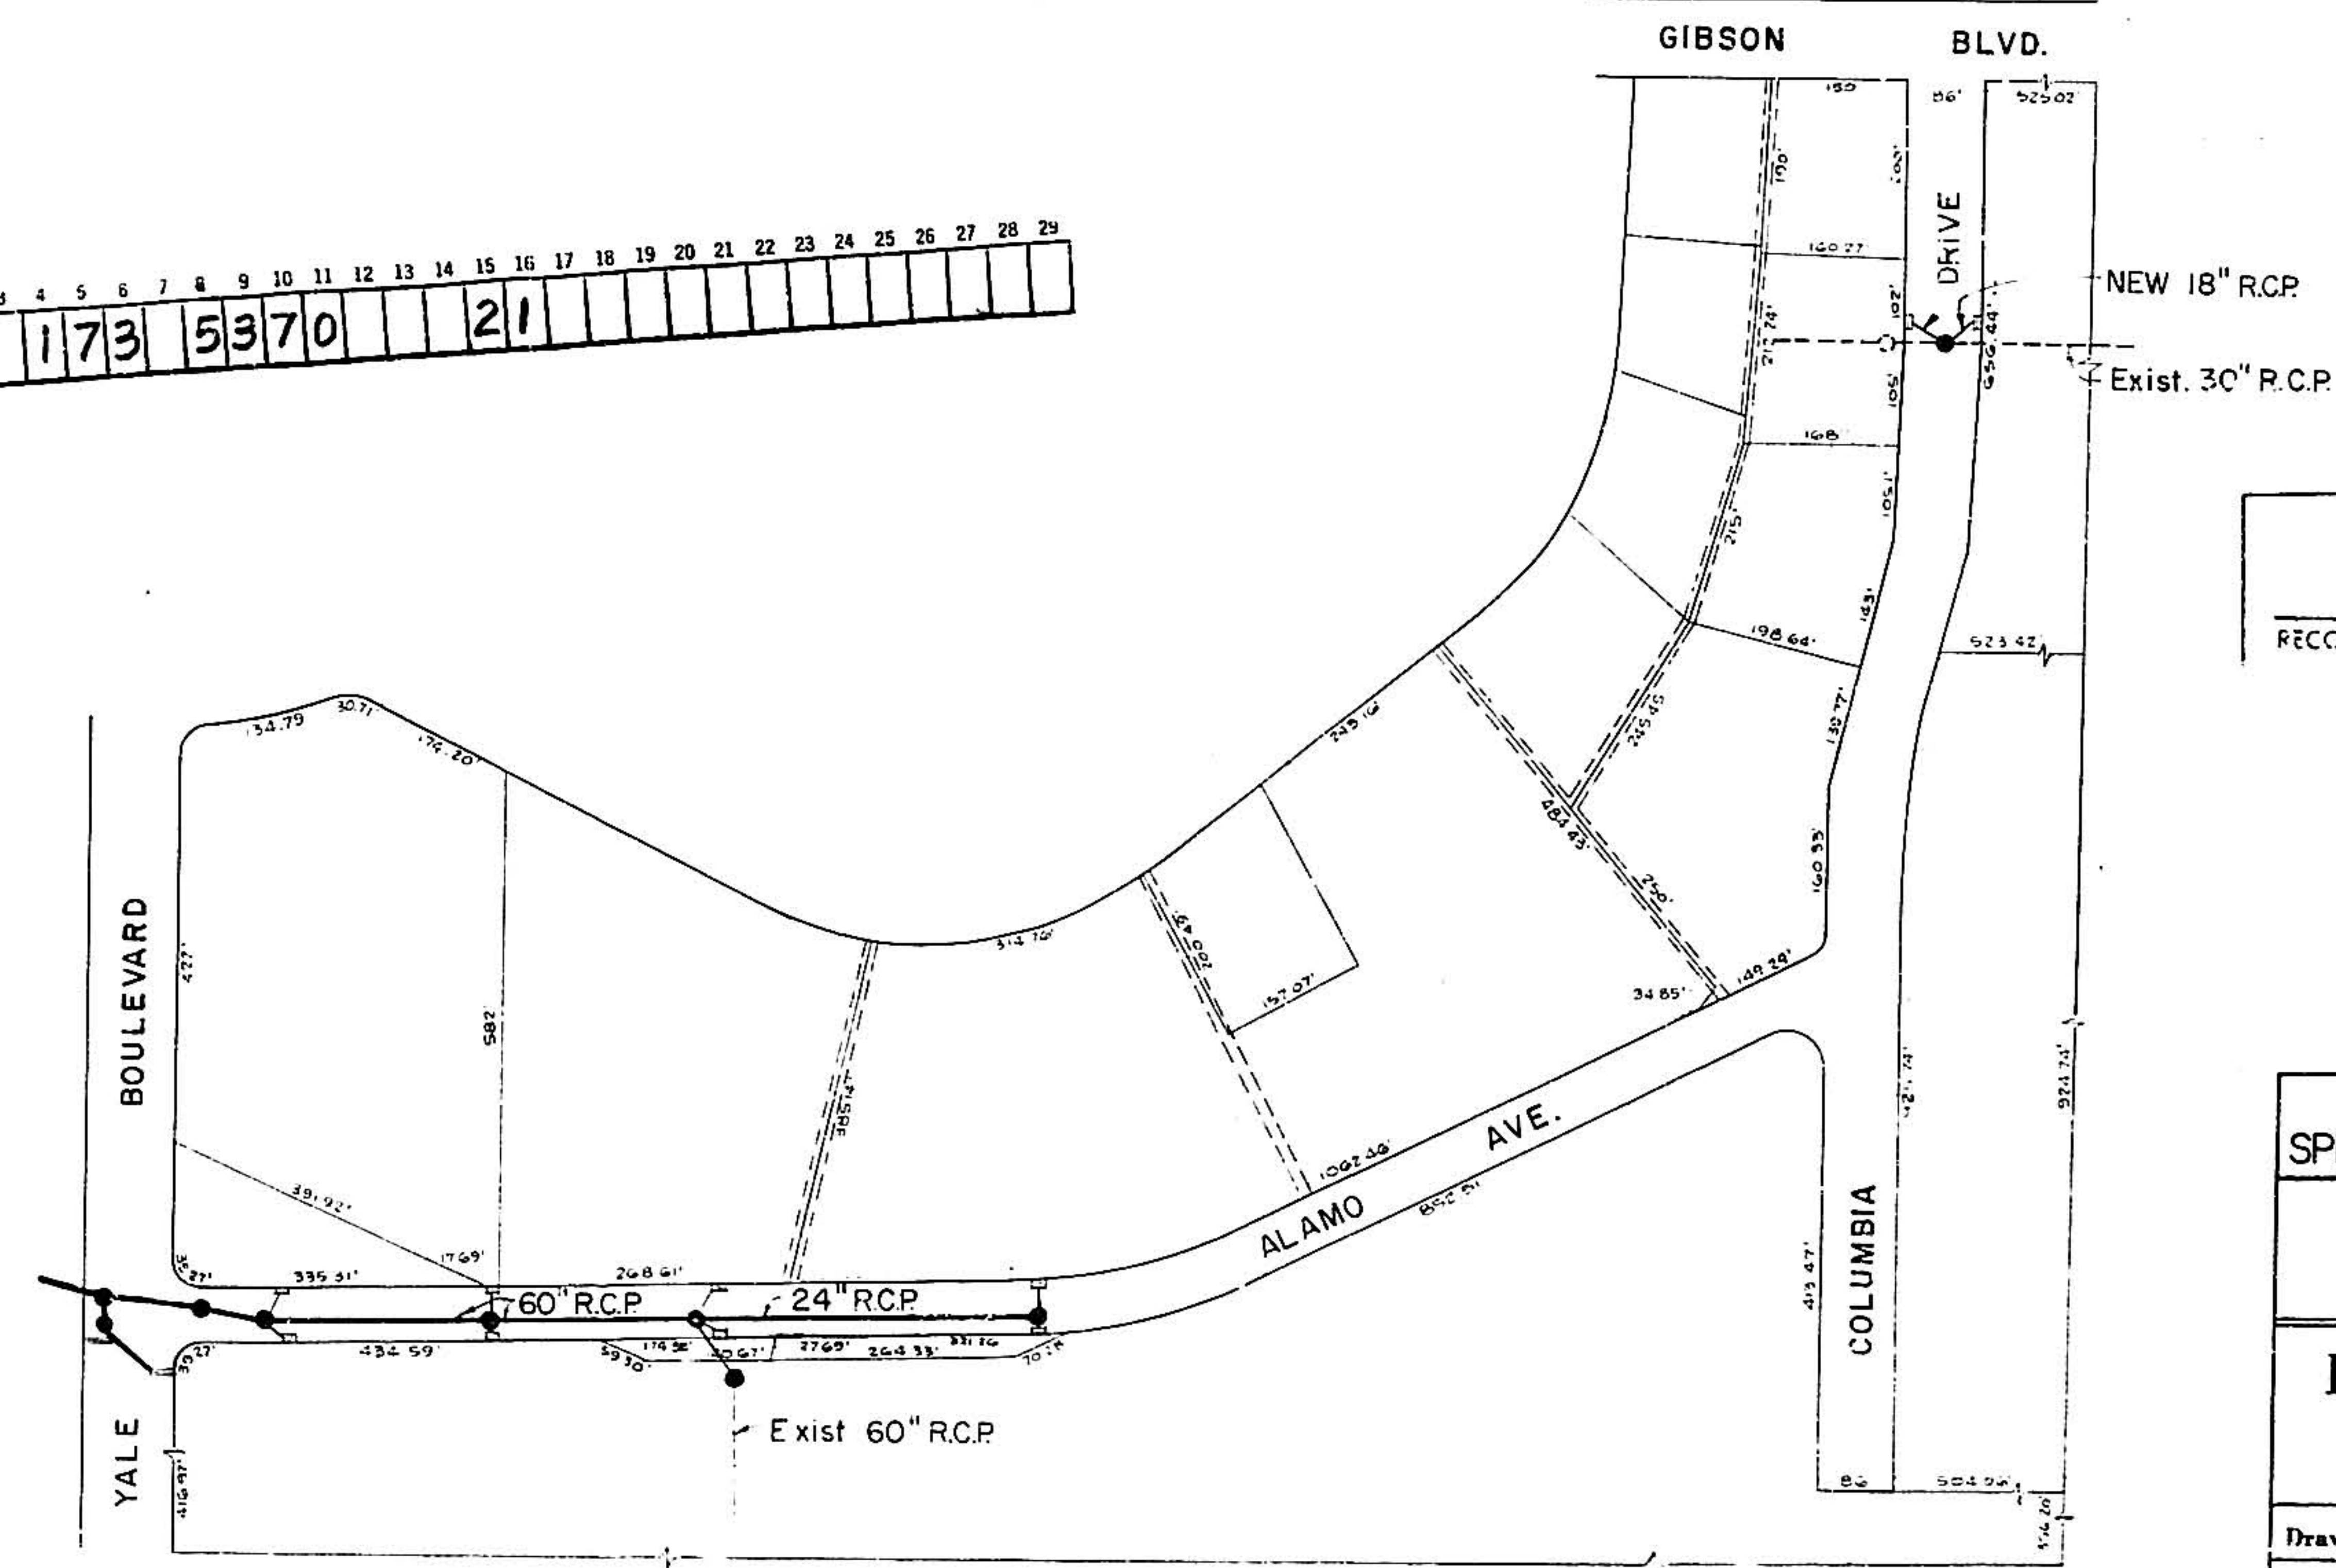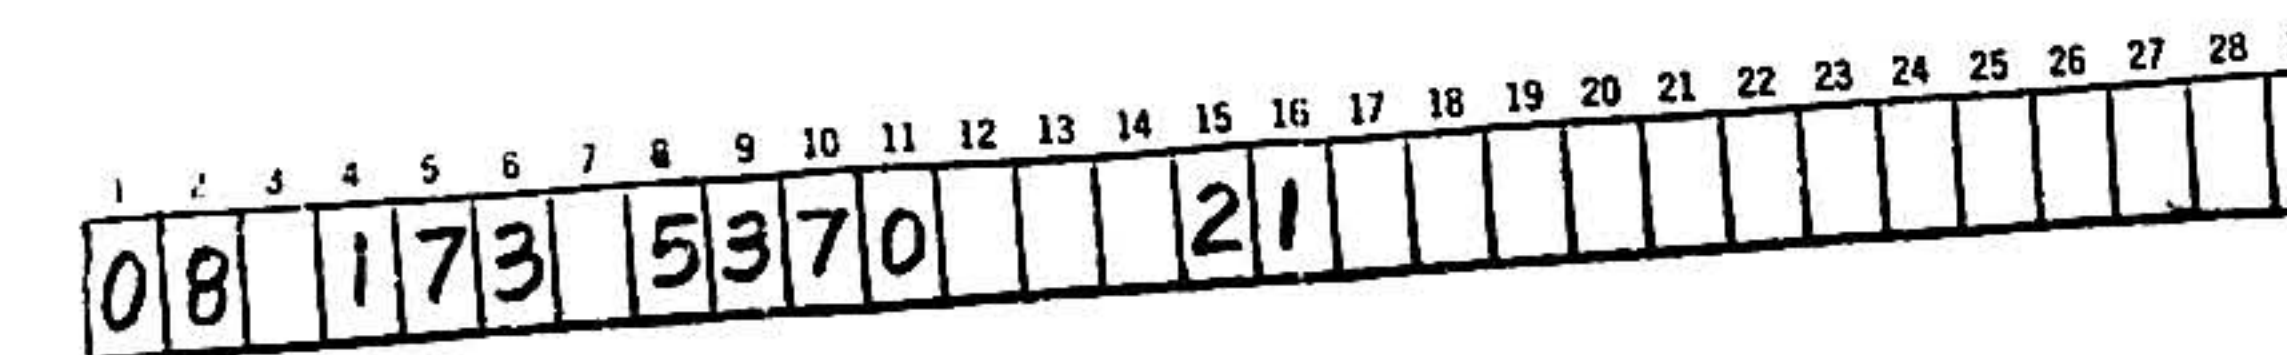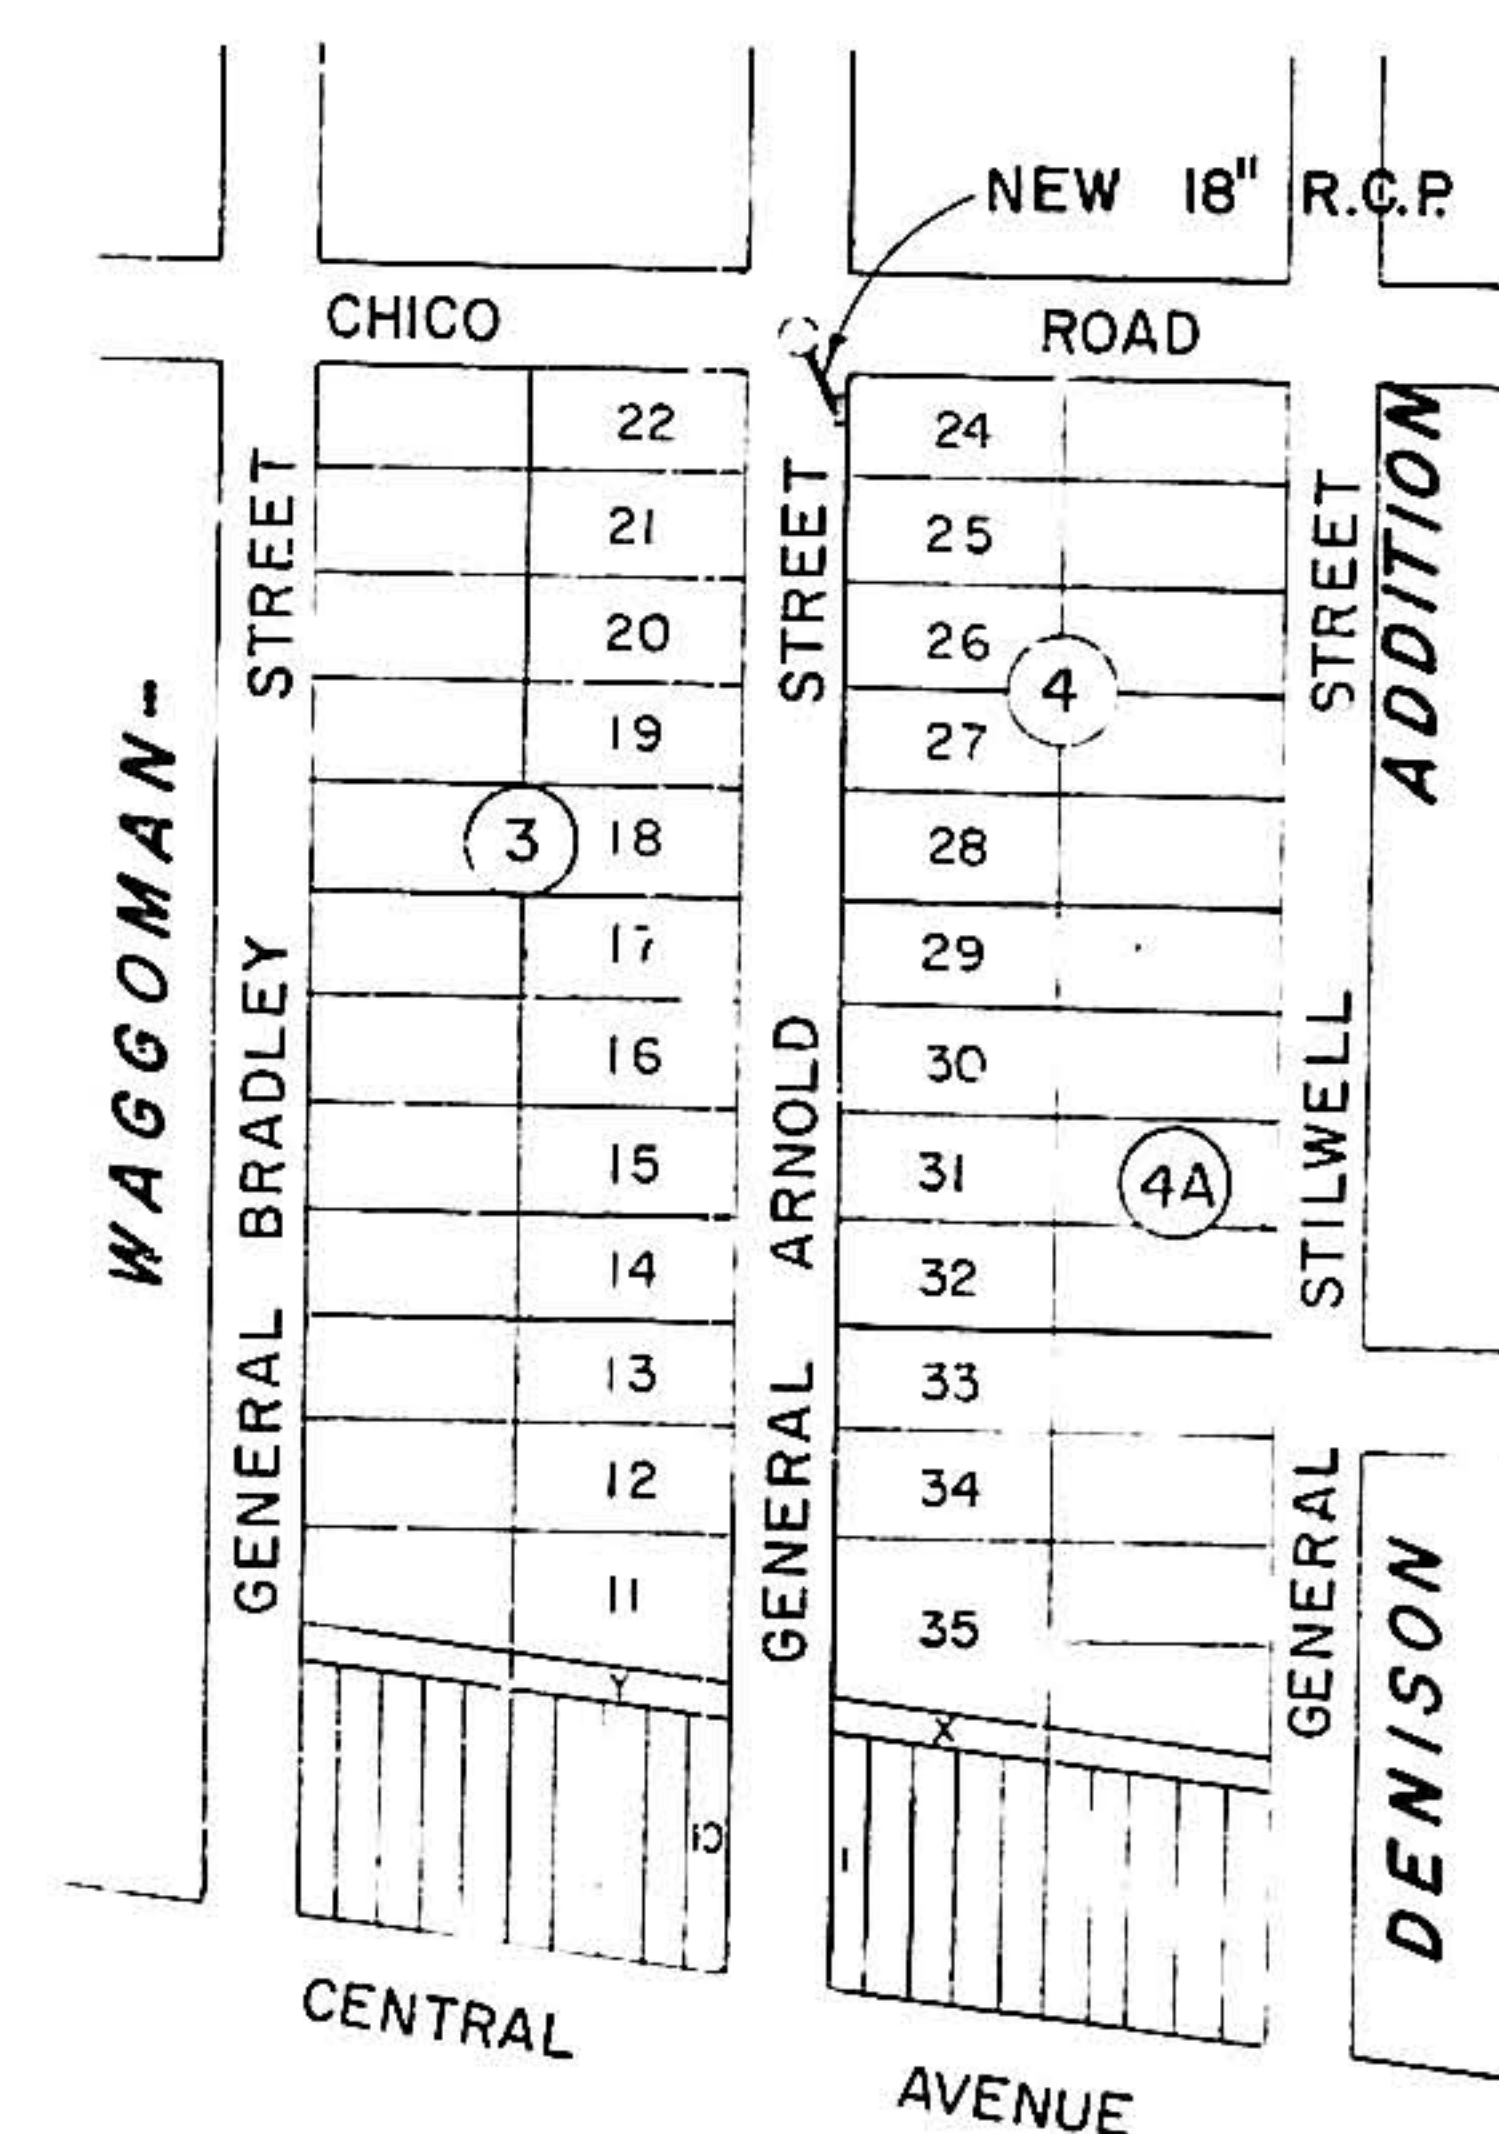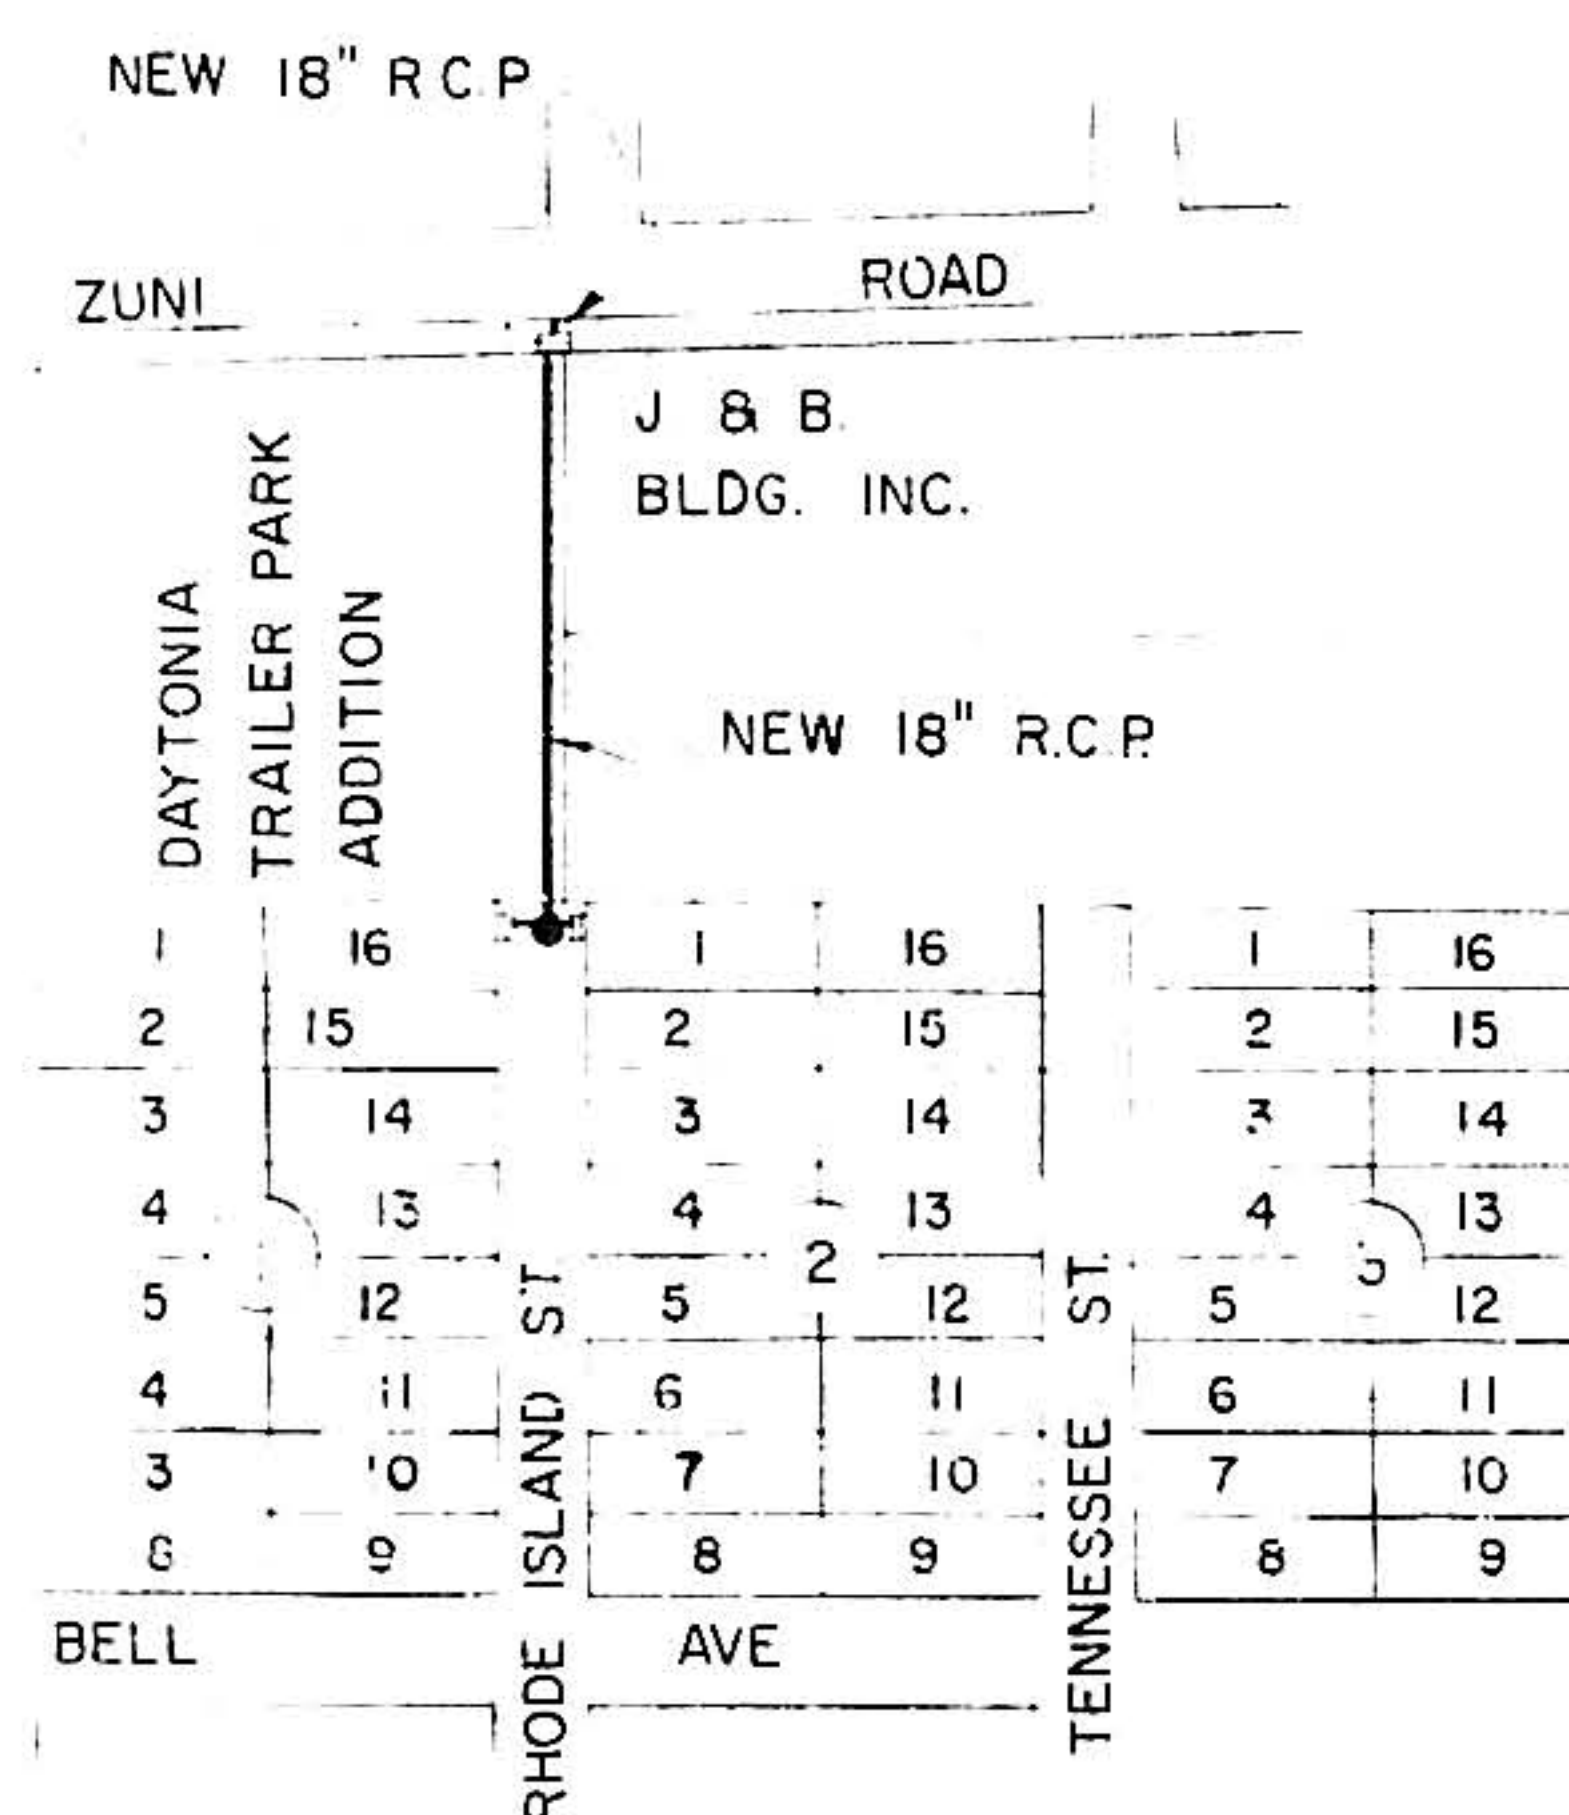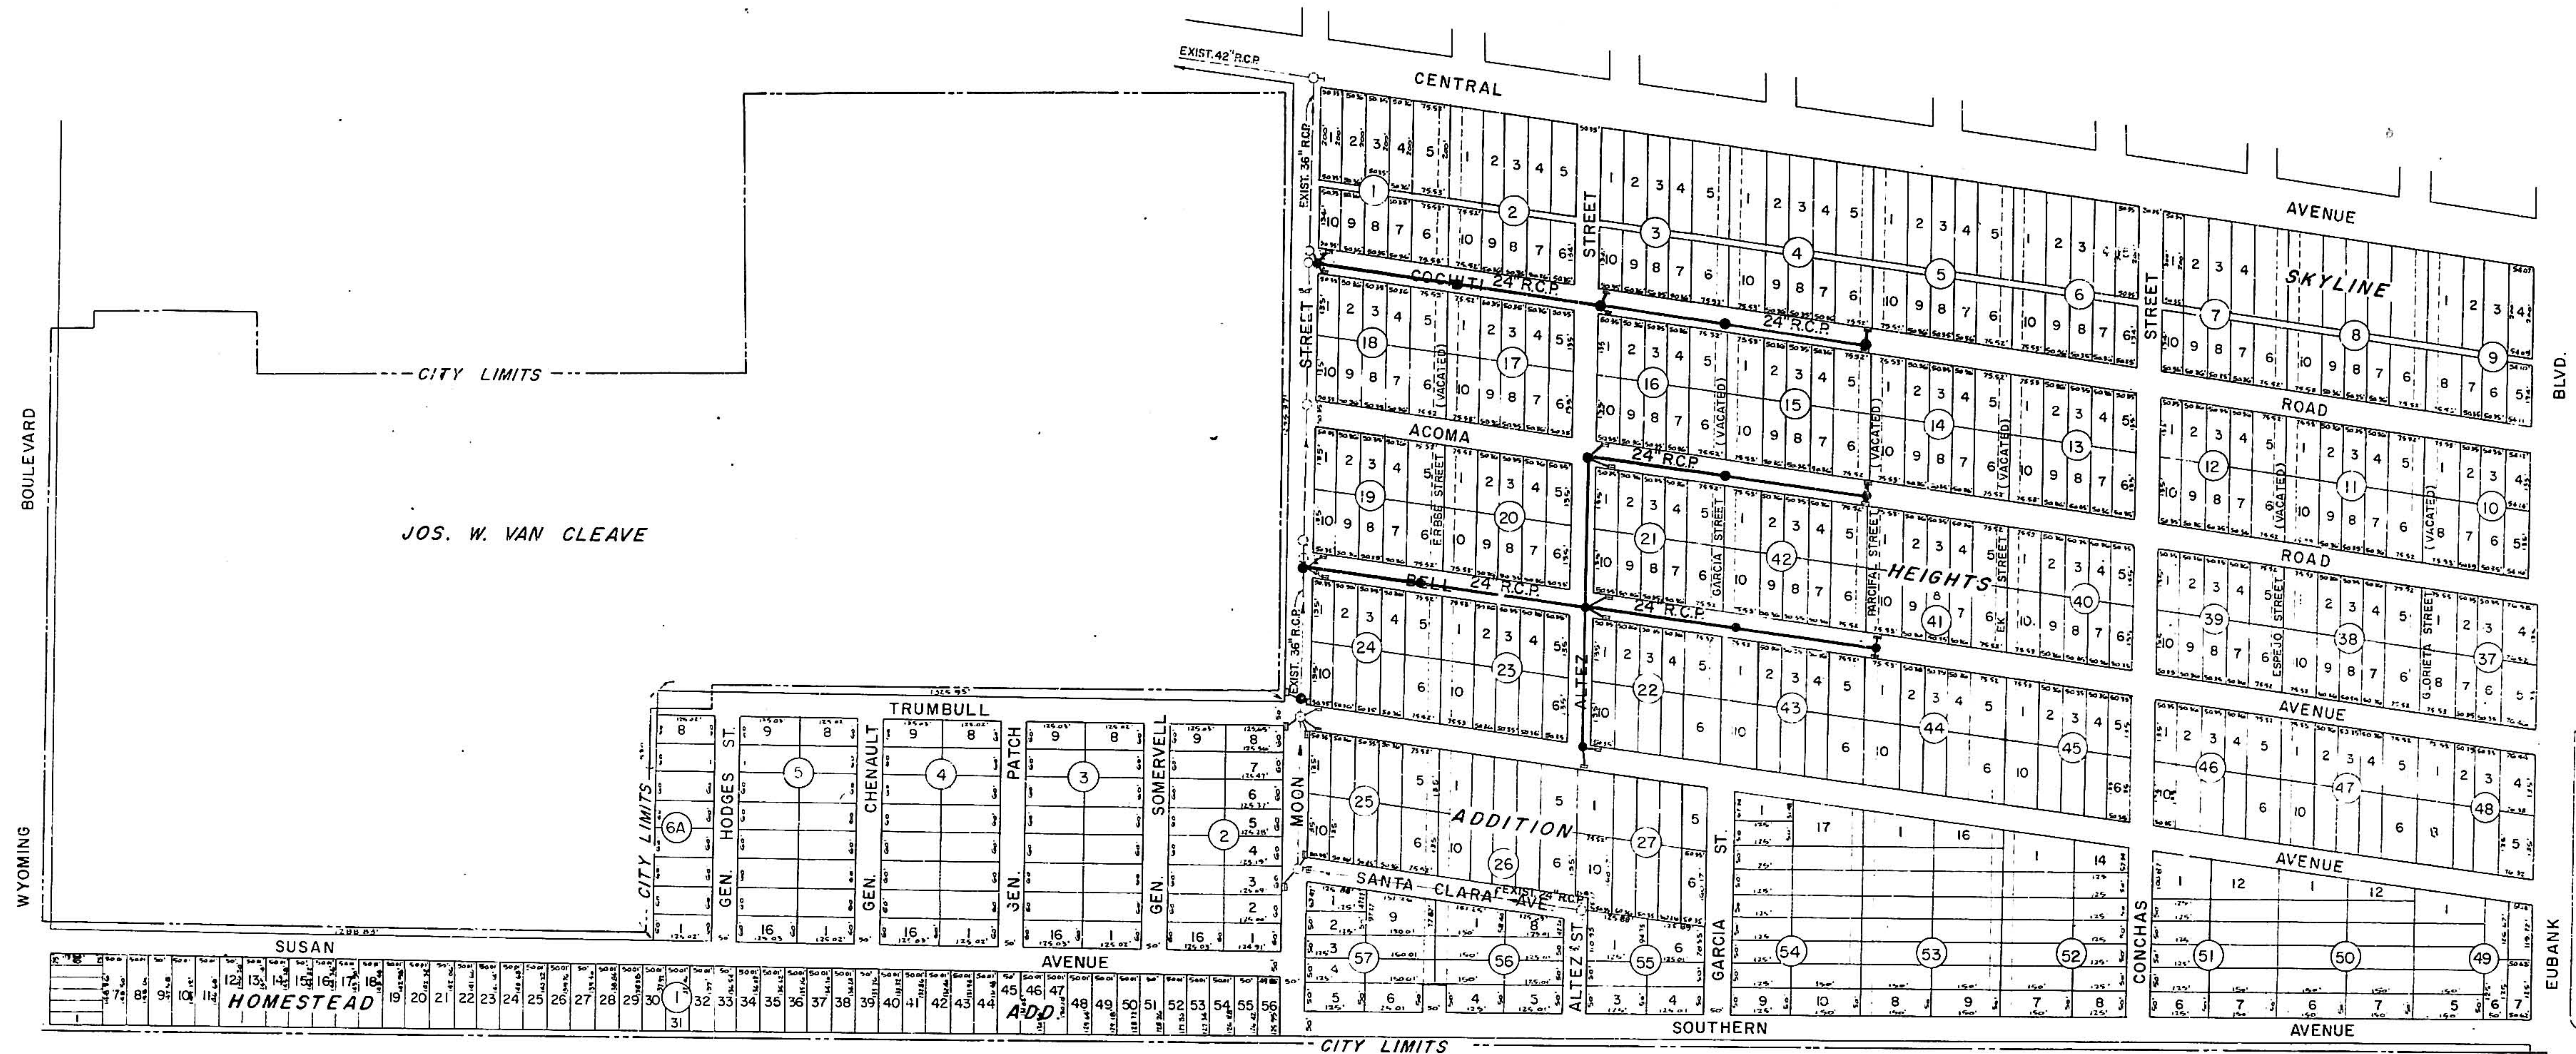

AS BUILT DRAWING
RECOMMENDED
D. F. MOLZEN & ASSOC.

ALBUQUERQUE, NEW MEXICO
SPECIAL ASSESSMENT DISTRICT NO.173
STORM SEWER
LOCATION PLAT
D. F. MOLZEN & ASSOCIATES
Consulting Engineers
ALBUQUERQUE NEW MEXICO
Drawn: _____ Checked: _____ Sheet: 53 of
File: _____ Date: _____

PLAN

PROFILE

 


PLATE 2-PLAN-PROFILE

AS BUILT DRAWING

SPECIAL ASSESSMENT DISTRICT NO. 173

CITY OF ALBUQUERQUE
STORM SEWER PLAN & PROFILE
BELL AVE
(Moon To Conchas)
ALTEZ ST. (Trumbull To Acoma)

SHEET
54
OF

PLAN
NOTES:
1. ALL NEW CONCRETE
2. ALL NEW 24" R.C.P.

PLAN
NOTE: SEE SHEET 56 FOR CONT.

PROFILE
NOTE: SEE SHEET 56 FOR CONT.

 


PLATE 2-PLAN-PI PROFILE

AS BUILT DRAWING


REVISION N° 1, APR 13, 1970
REVISION N° 2, JUNE 23, 1970



SPECIAL ASSESSMENT DISTRICT NO. 173
CITY OF ALBUQUERQUE
STORM SEWER PLAN & PROFILE
MOON ST (Southern To Bell)
GEN. ARNOLD ST (Chico - South)
COLUMBIA DR (South Of Gibson)
MADISON ST (Lomas - South)

SHEET 56 OF



 

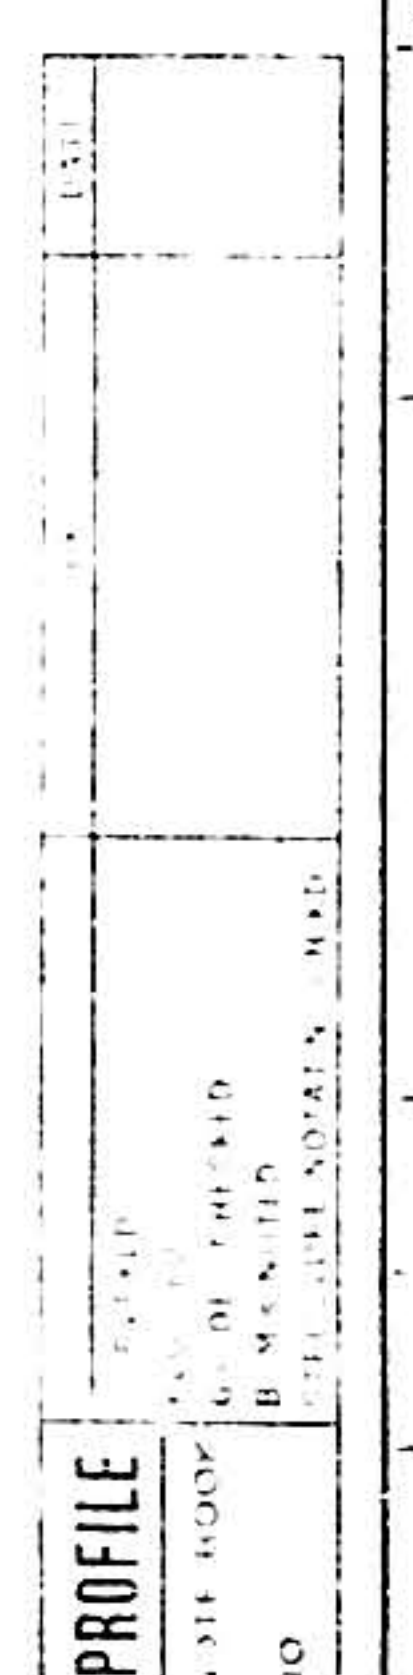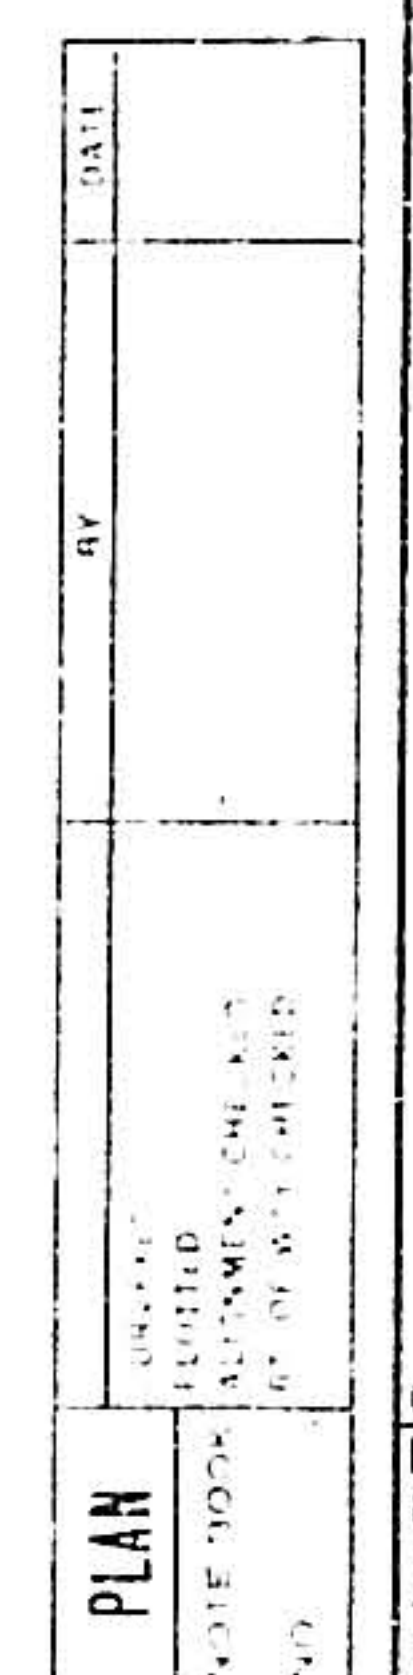

SPECIAL ASSESSMENT DISTRICT NO. 173	
CITY OF ALBUQUERQUE STORM SEWER PLAN & PROFILE	SHEET
ALAMO AVE. (Yale East)	57 OF

PLAN	SUBMITTED	DATE
	NOTE NO. 1	BY
PROFILE	NOTE NO. 2	DATE
	NOTE NO. 3	BY

PROFILE	SUBMITTED	DATE
	NOTE NO. 1	BY
PLAN	NOTE NO. 2	DATE
	NOTE NO. 3	BY

 









PLATE 1 - PLAN - PROFILE
MADE AND PRINTED IN U.S.A.
CHARLES BRIDING COMPANY

AS BUILT DRAWING

SEPT. 10, 1970

SPECIAL ASSESSMENT DISTRICT NO. 173
CITY OF ALBUQUERQUE
STORM SEWER PLAN & PROFILE
FROM RHODE ISLAND STREET TO
ZUNI ROAD

SHEET
57-0
OF

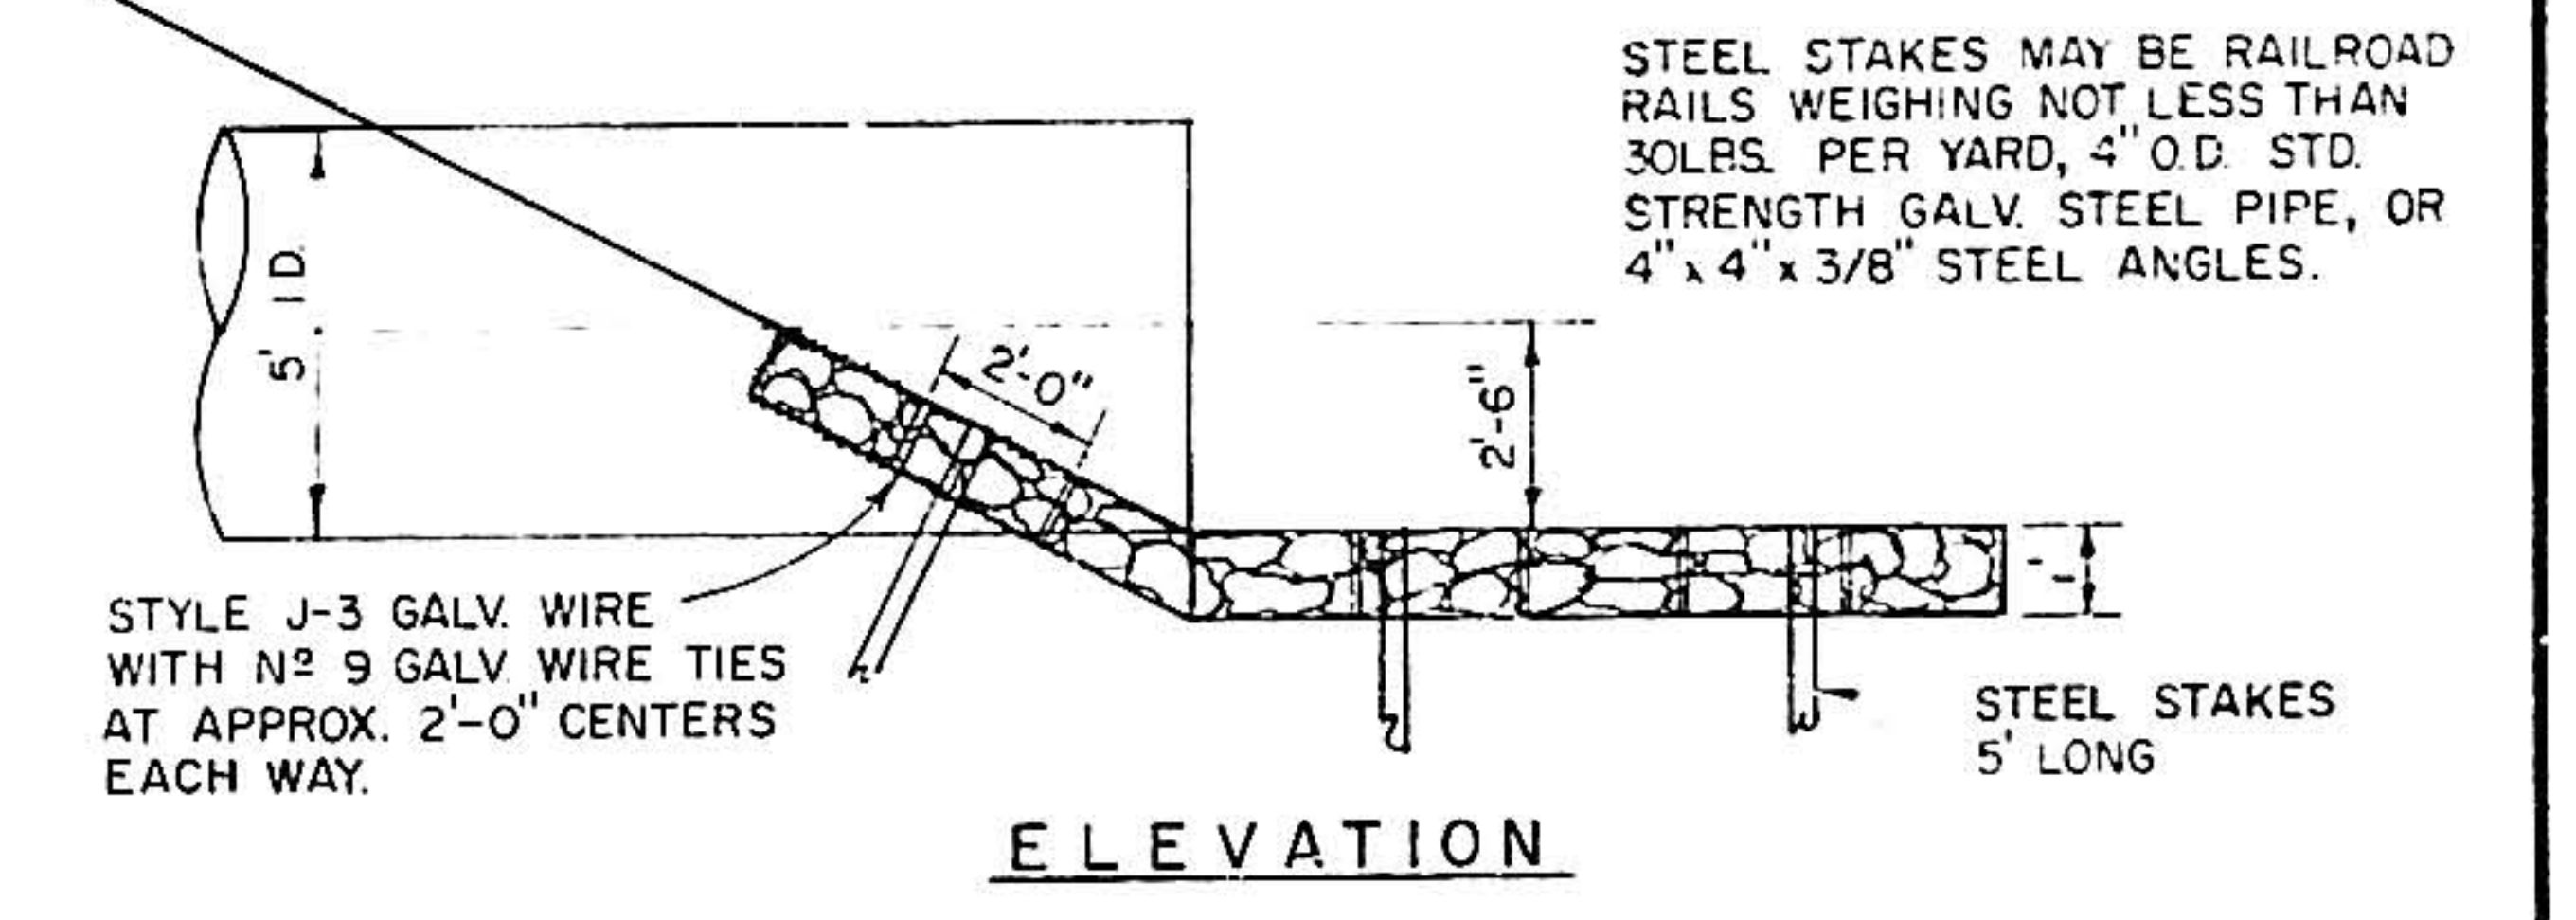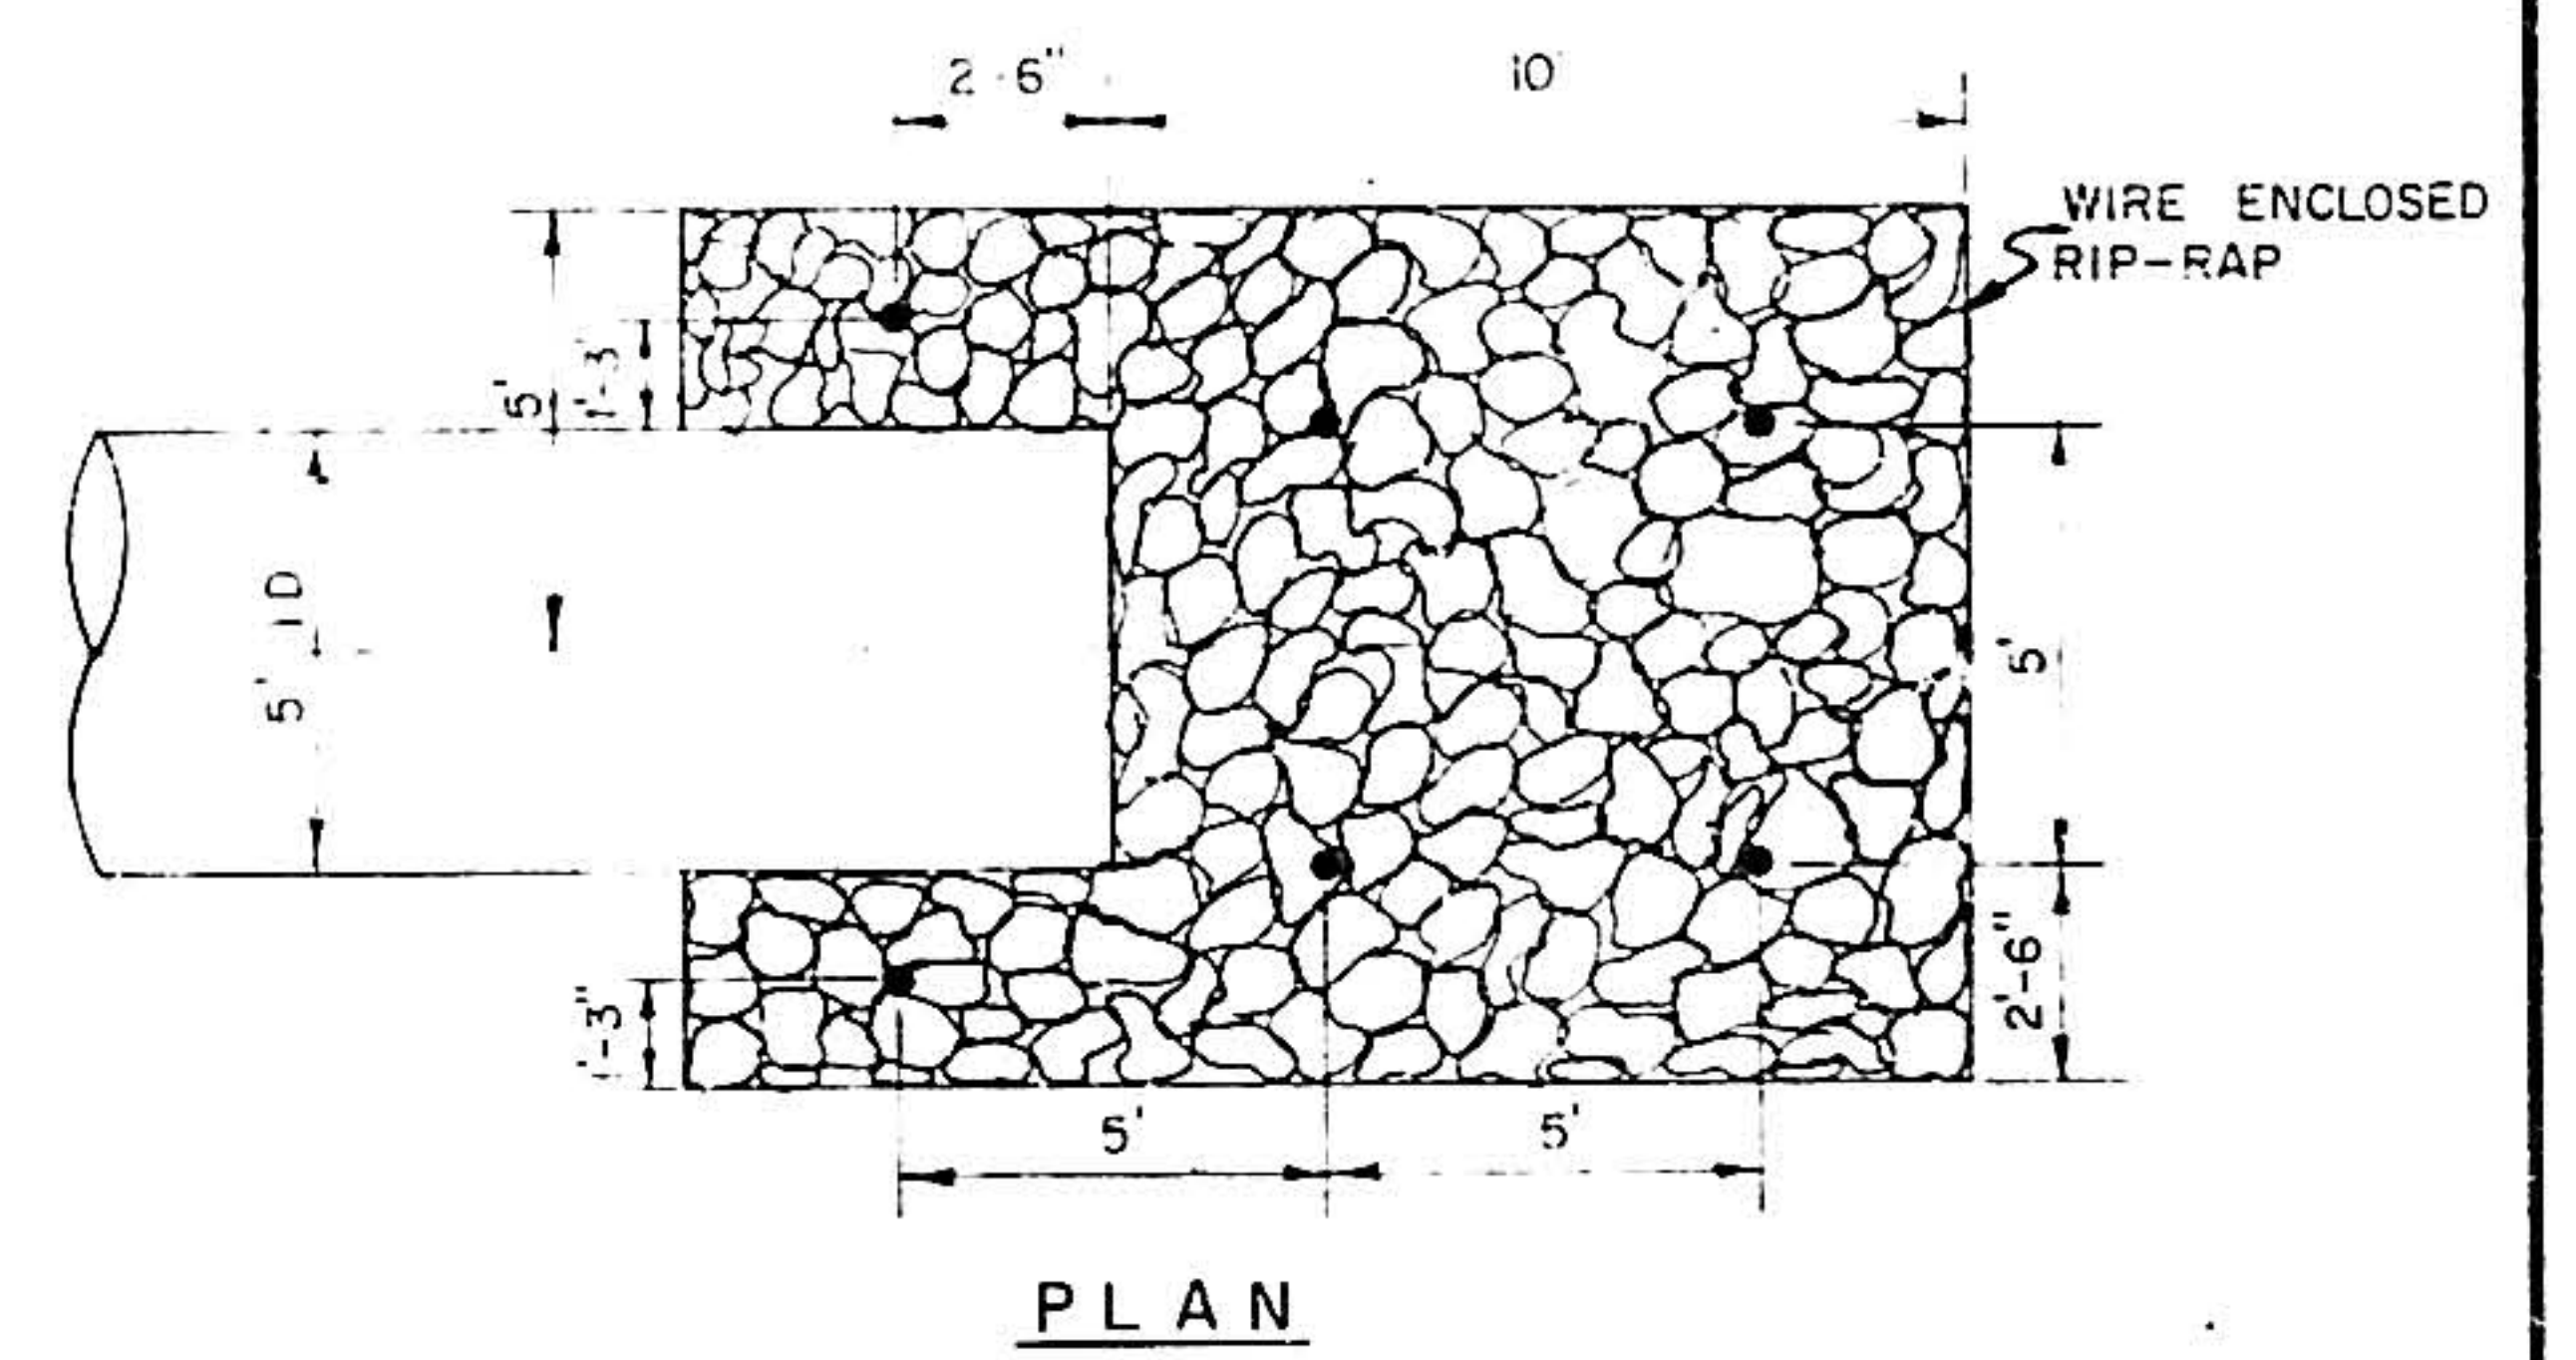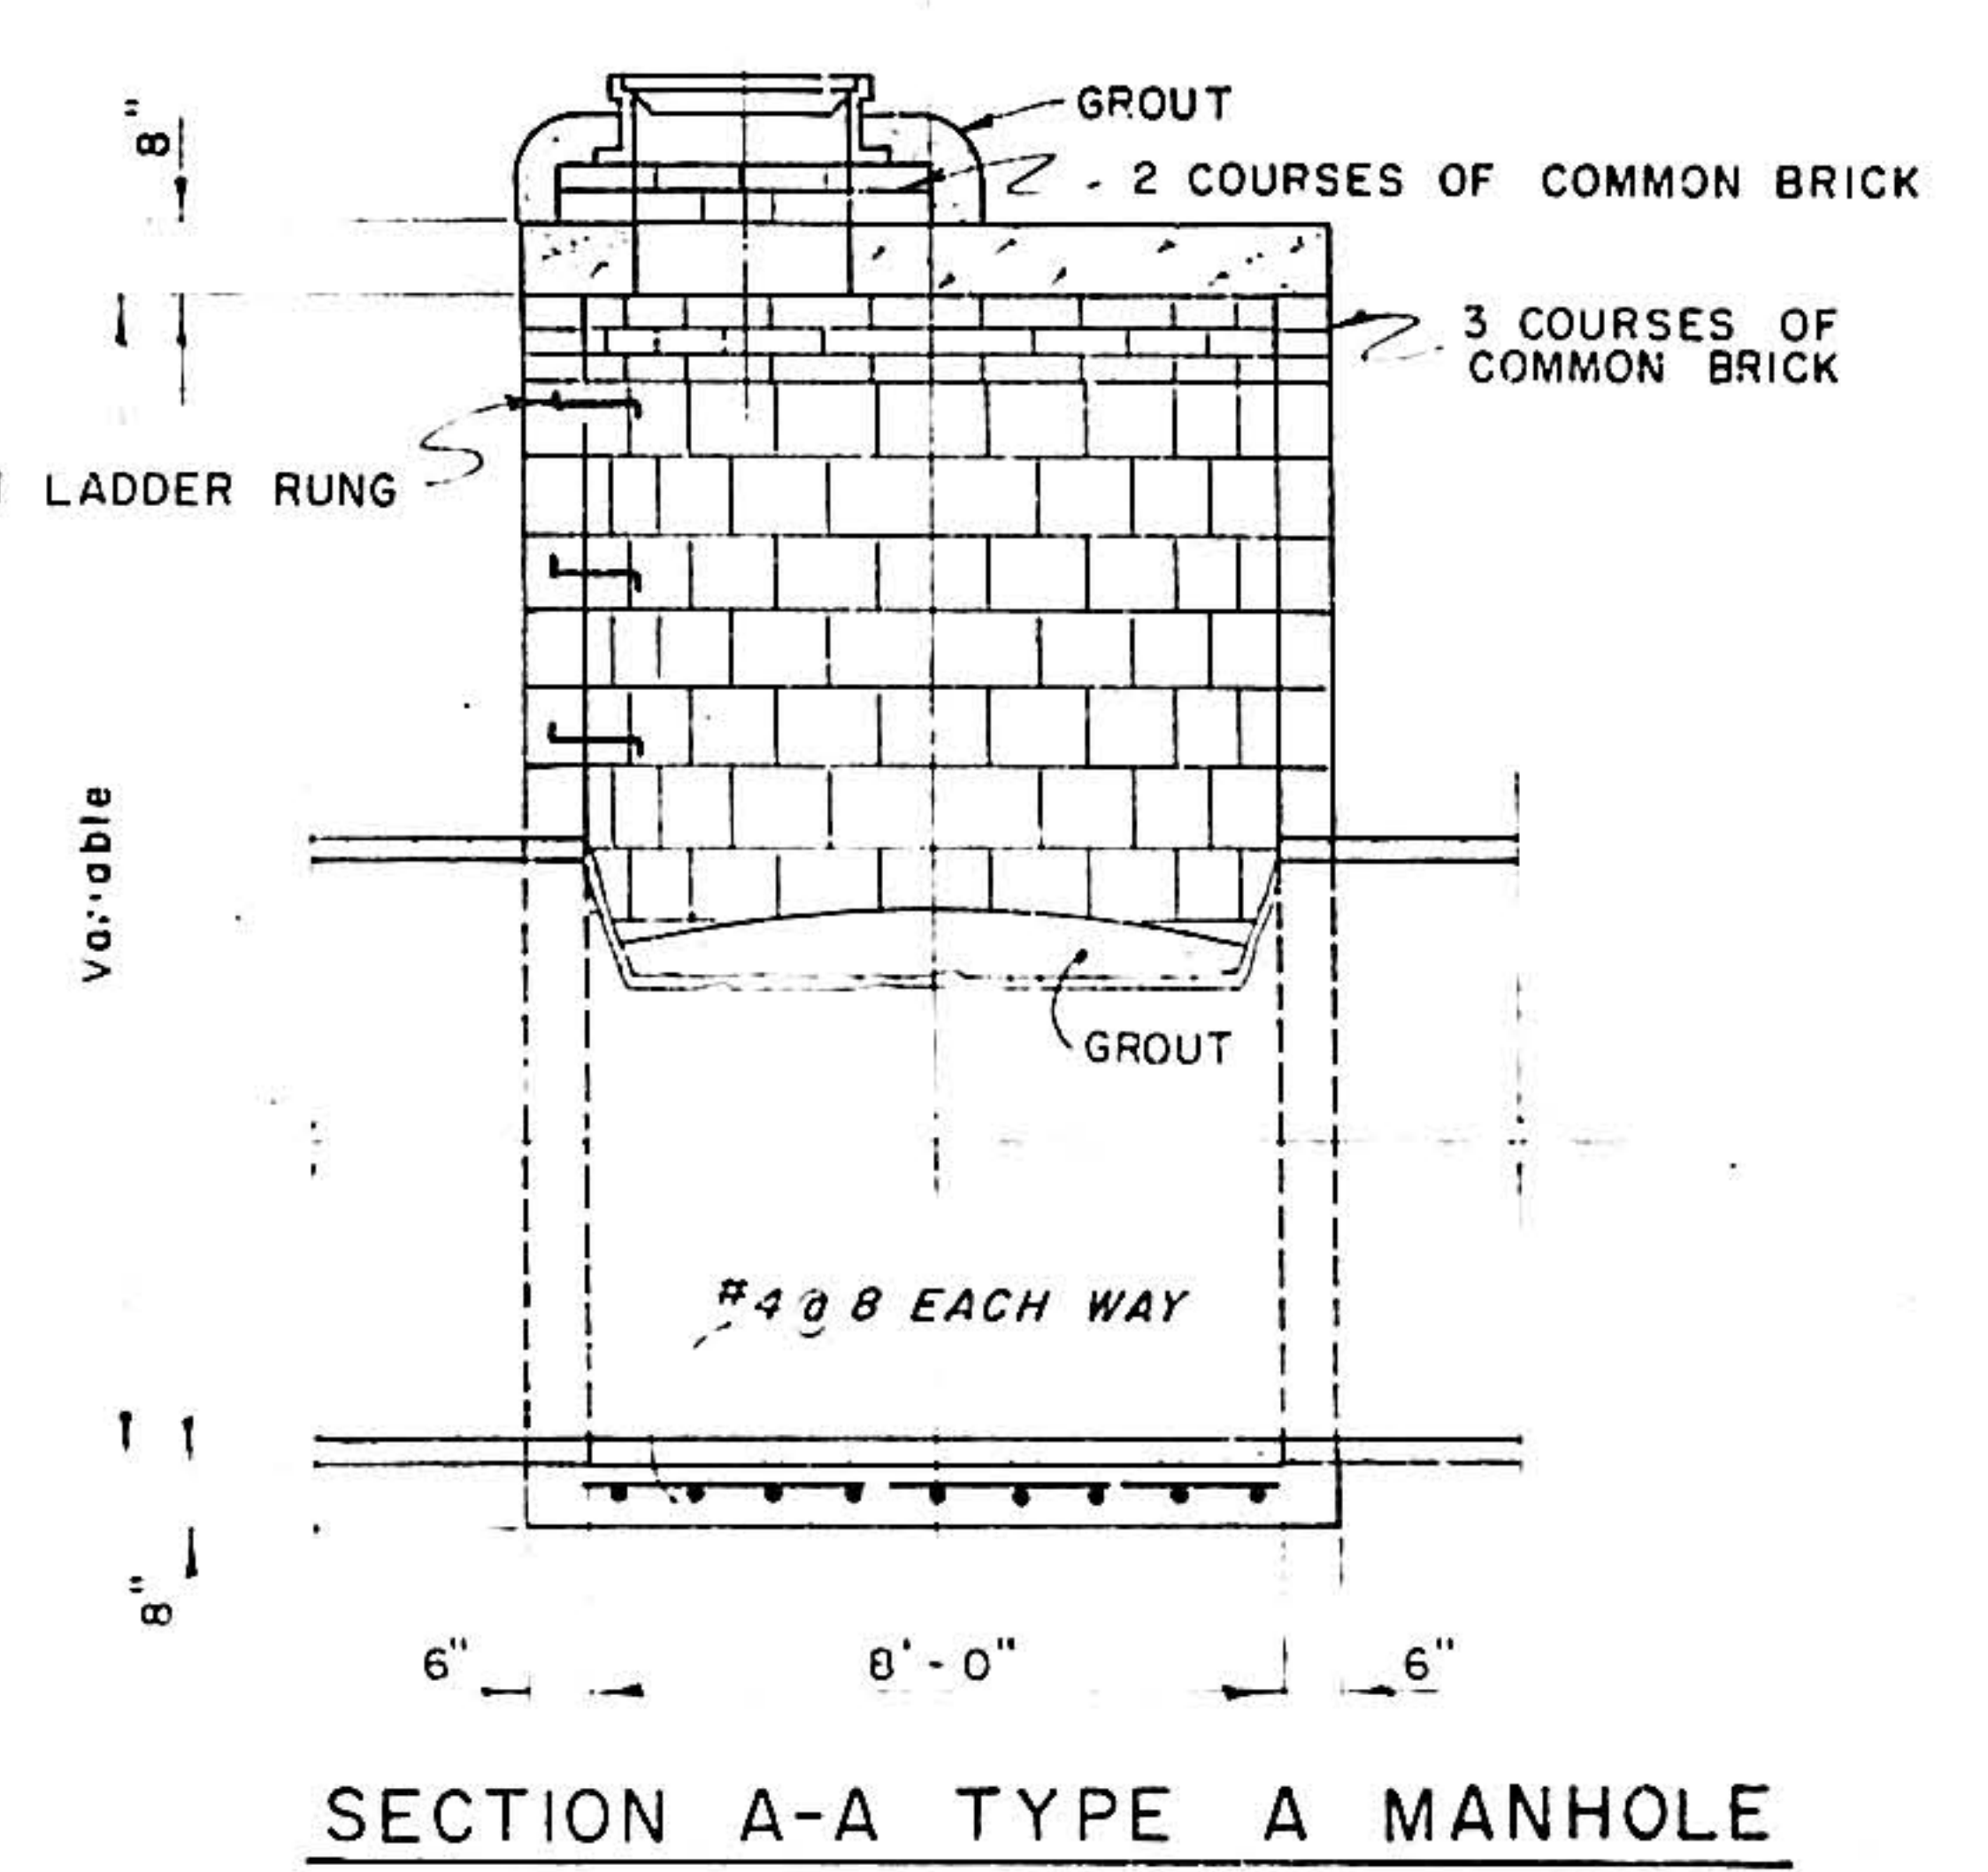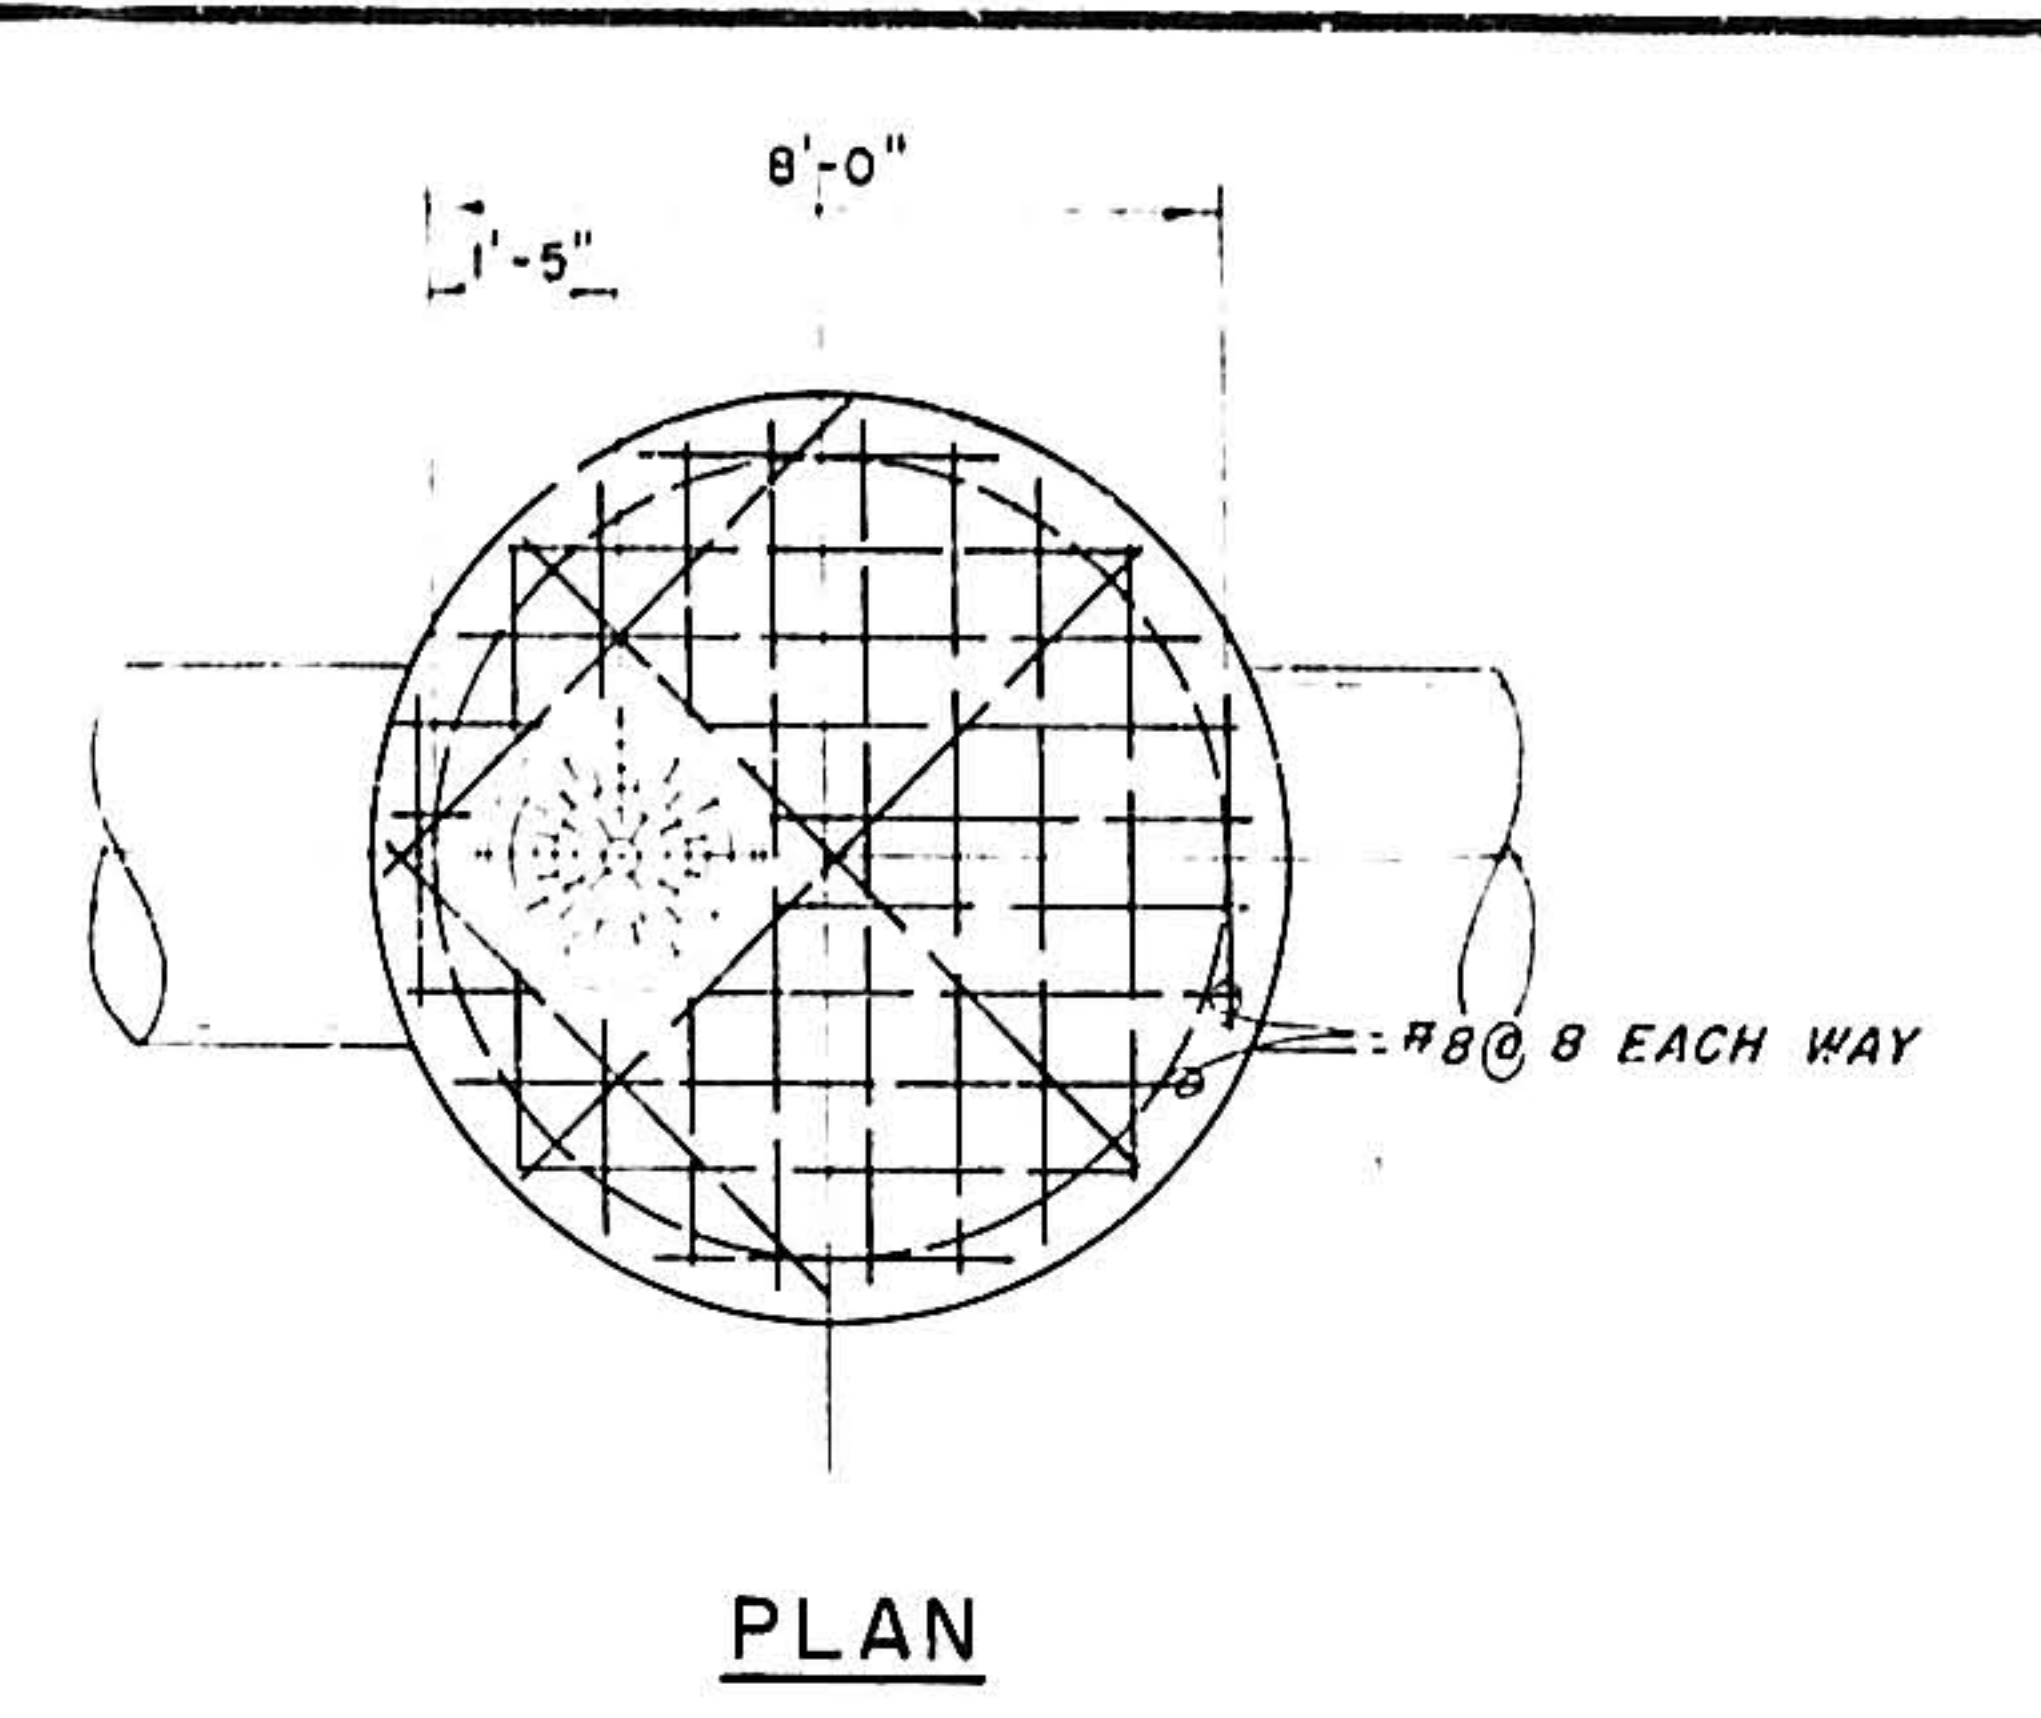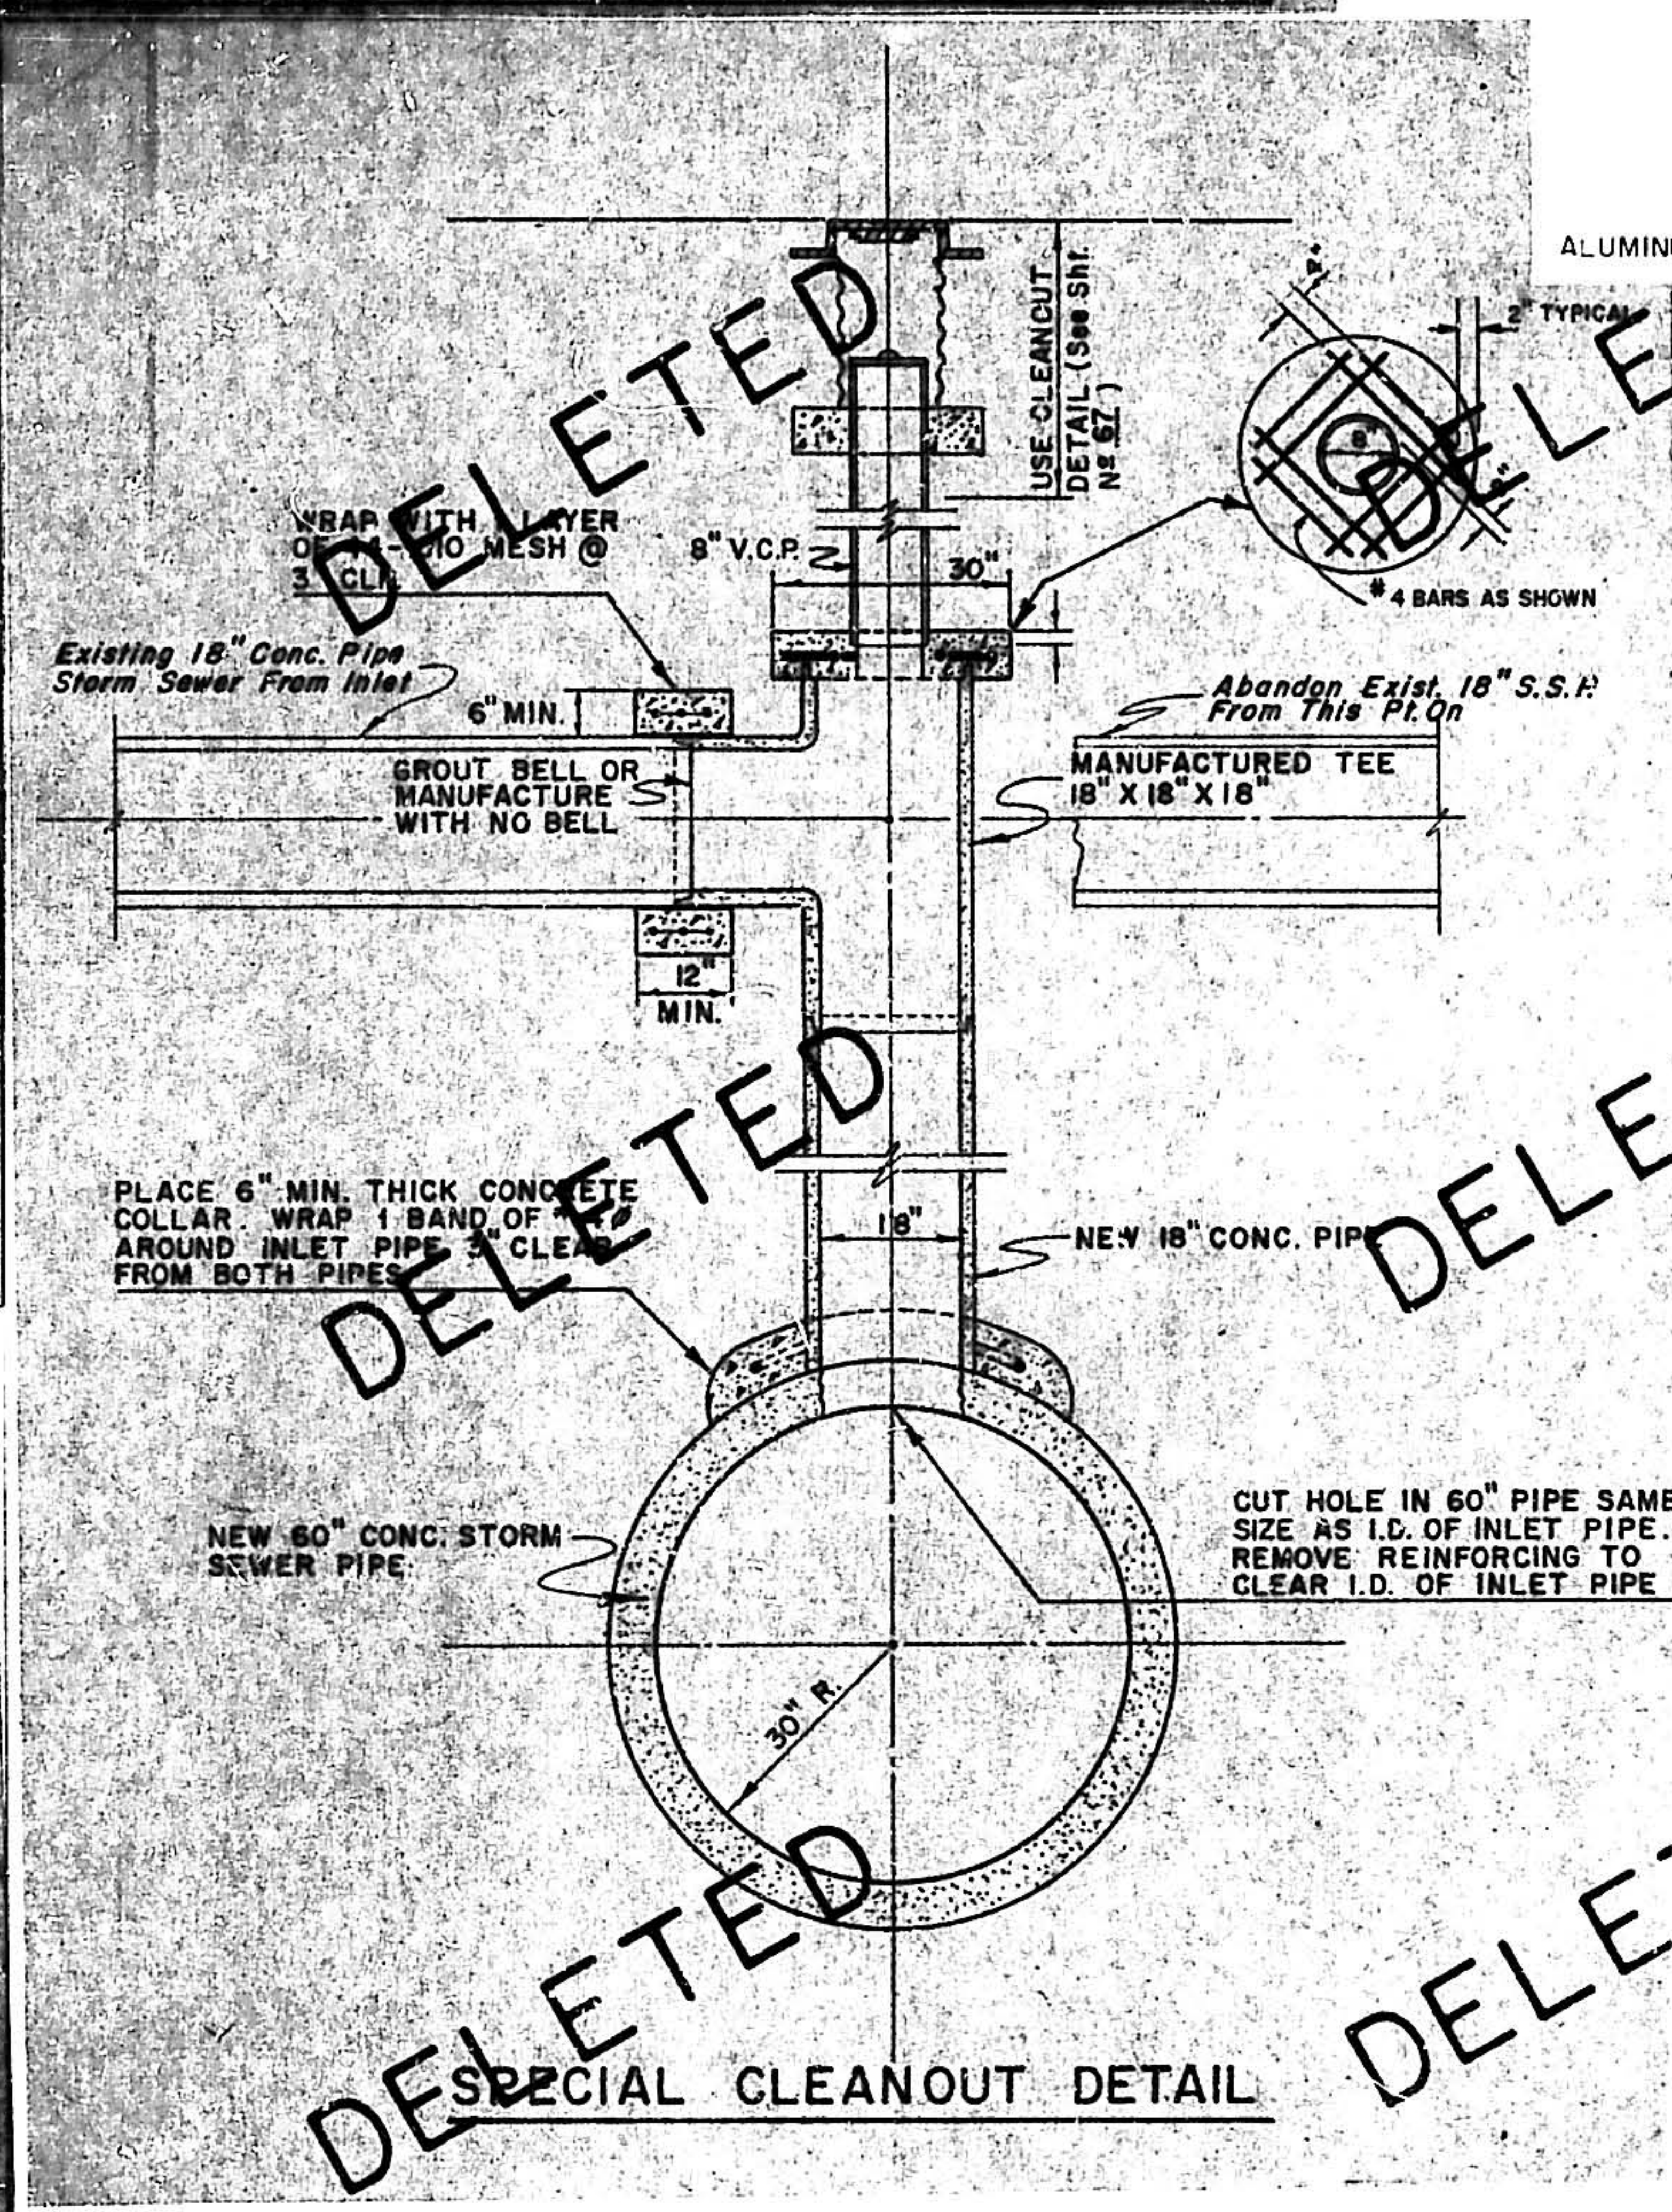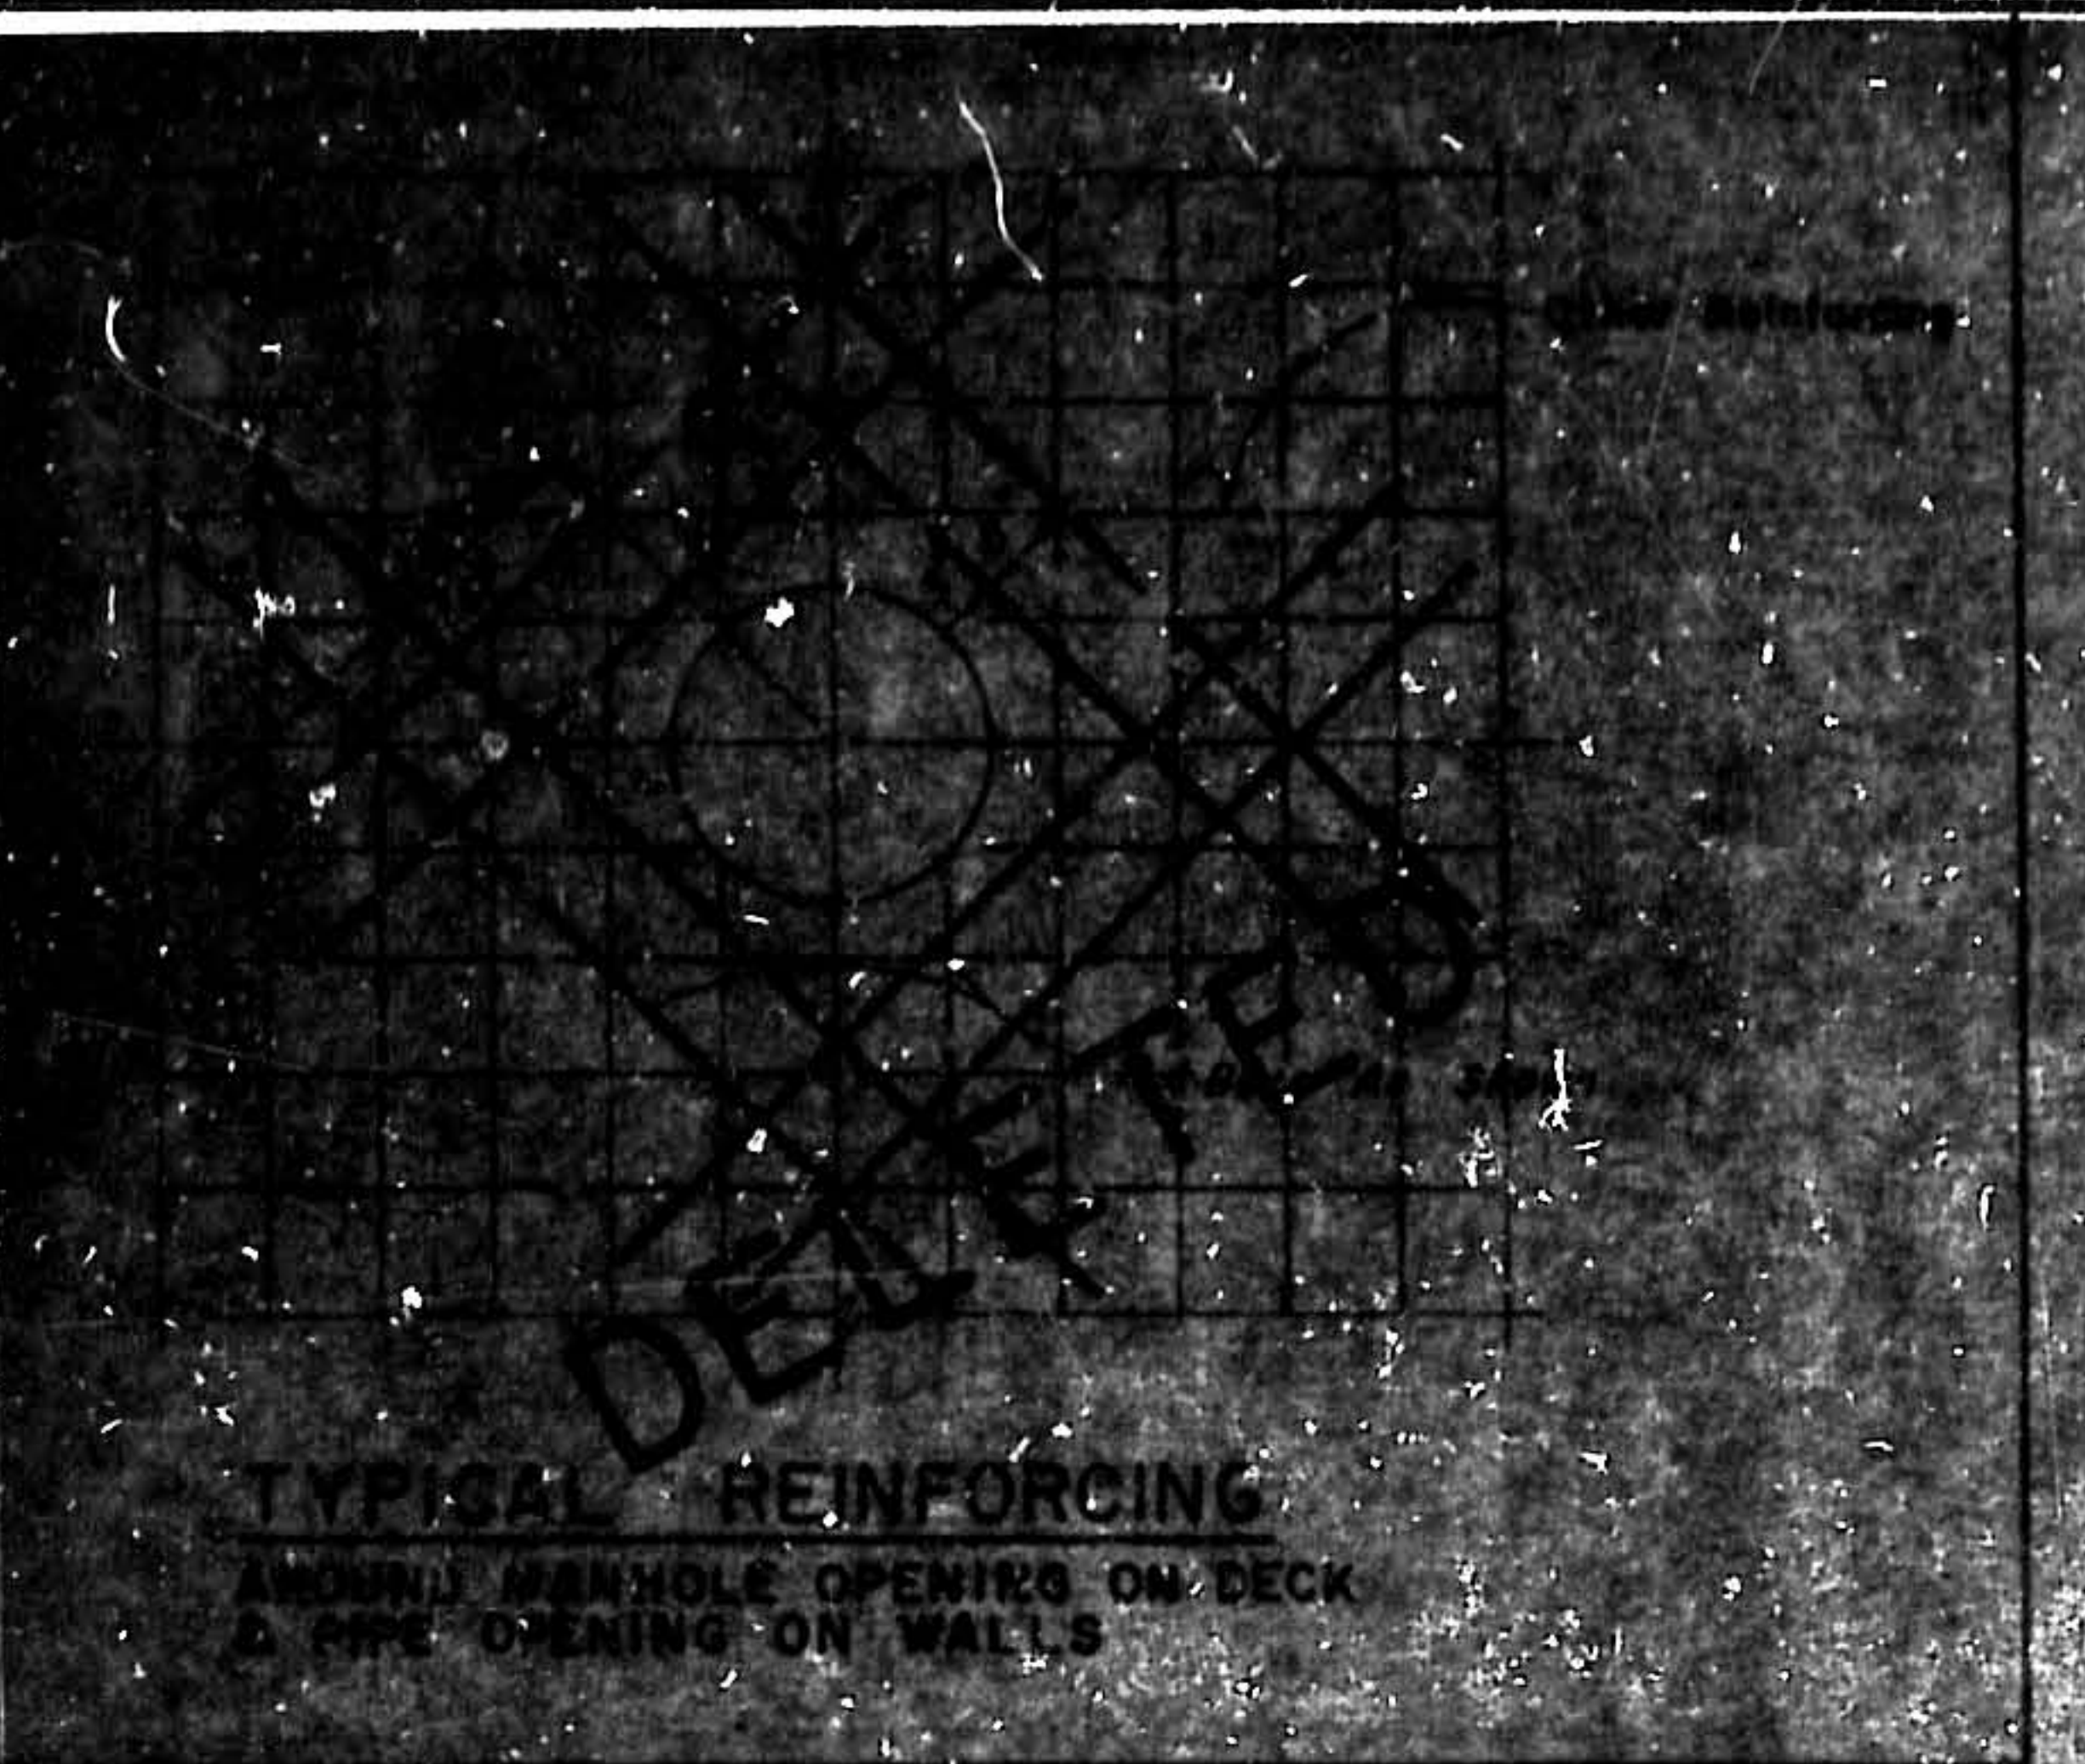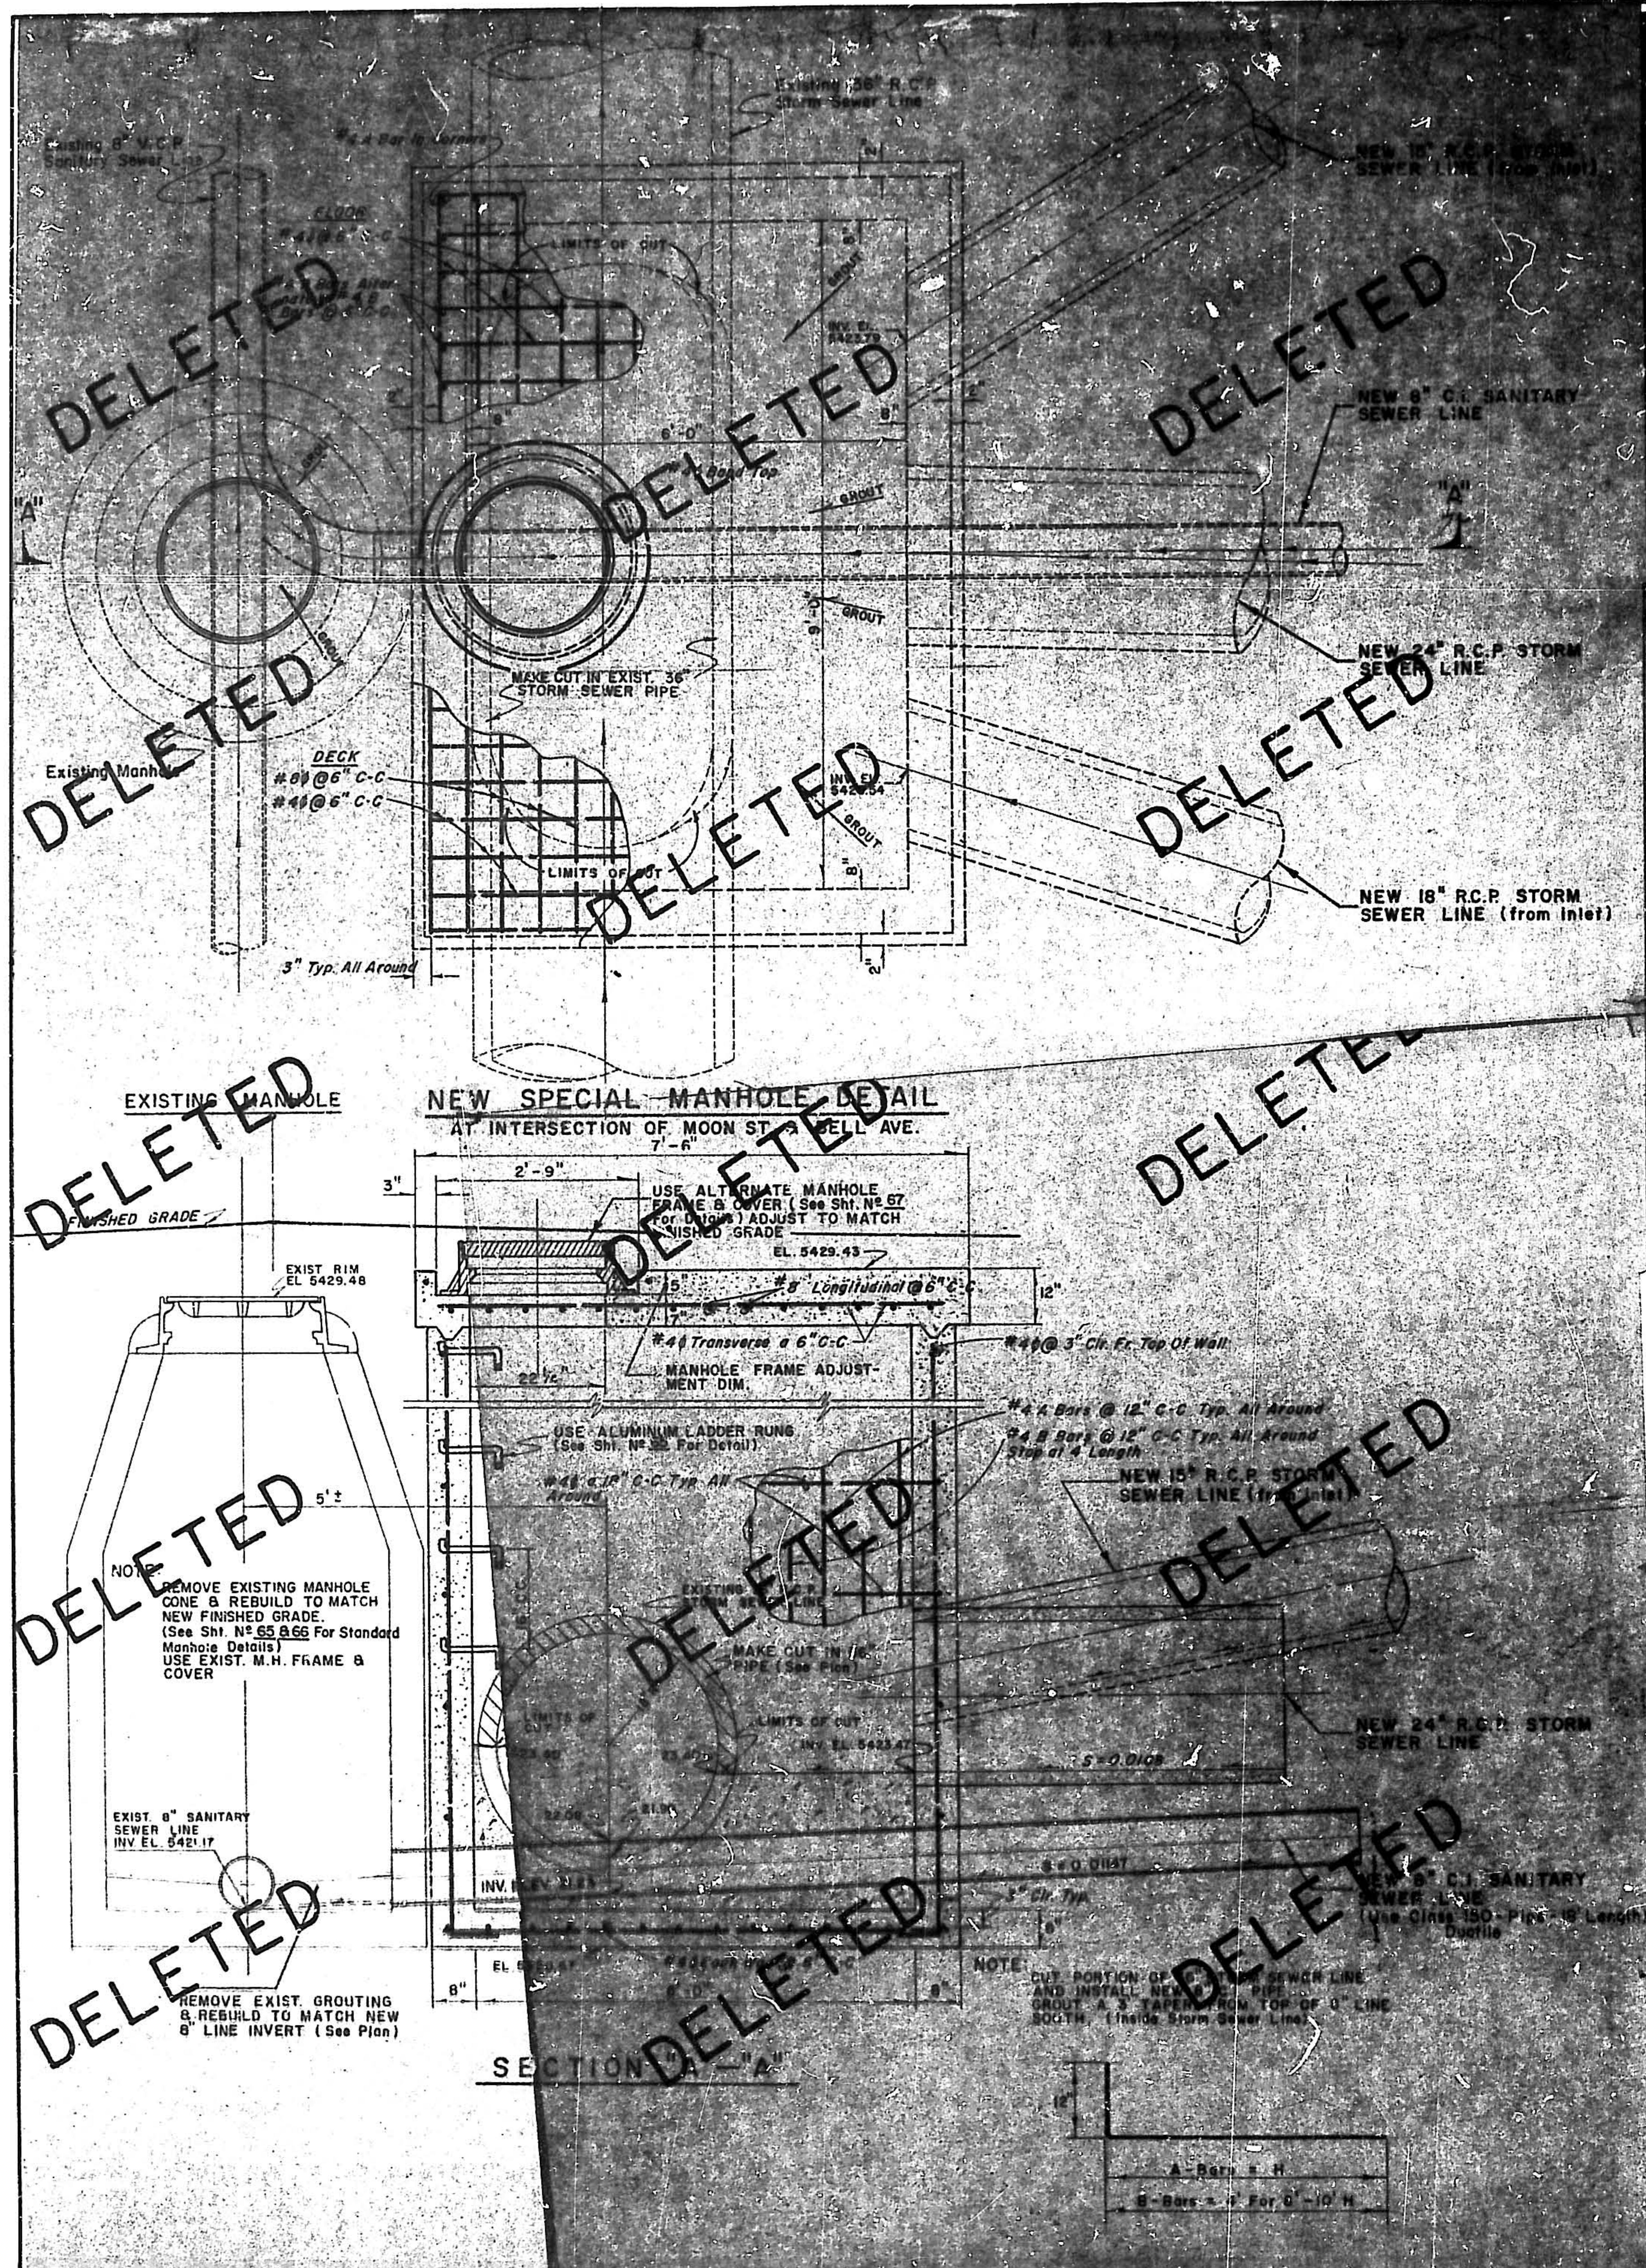

RIP RAP PROTECTION


1	2	3	4	5	6	7	8	9	10	11	12	13	14	15	16	17	18	19	20	21	22	23	24	25	26	27	28	29
08	17	3	6	4	7	0																						

ALBUQUERQUE, NEW MEXICO
SPECIAL ASSESSMENT DISTRICT NO. 173


**STORM SEWER
MISCELLANEOUS DETAILS**

D. F. MOLZEN & ASSOCIATES
Consulting Engineers
ALBUQUERQUE NEW MEXICO


Drawn	Checked	Sheet
File	Date	64 of

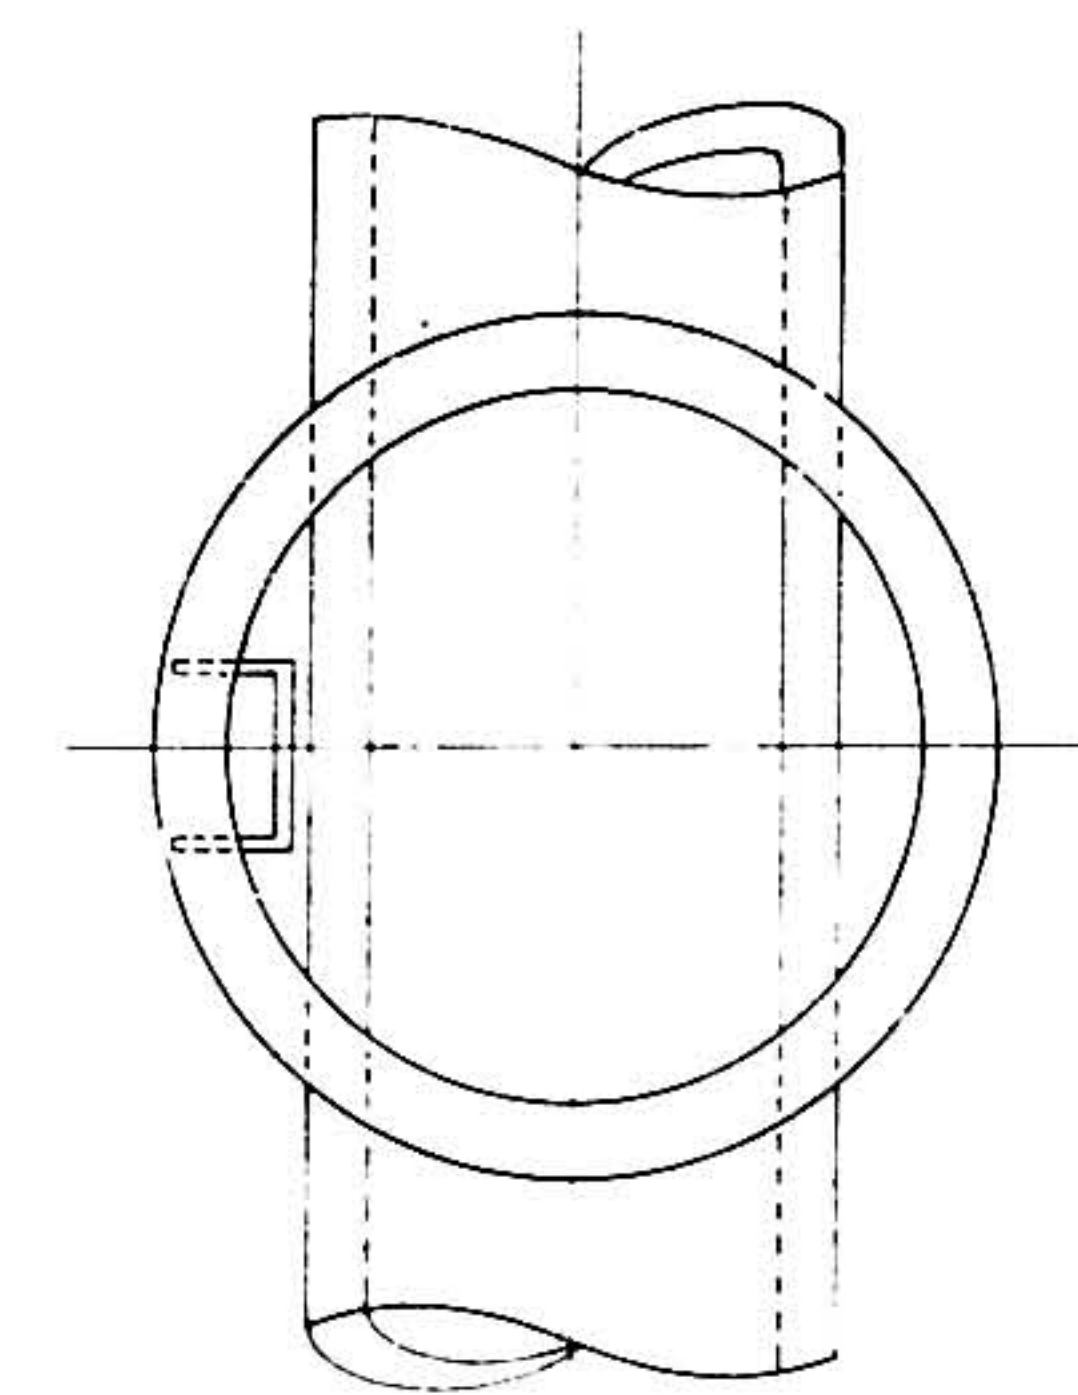


SECTION TOP VIEW

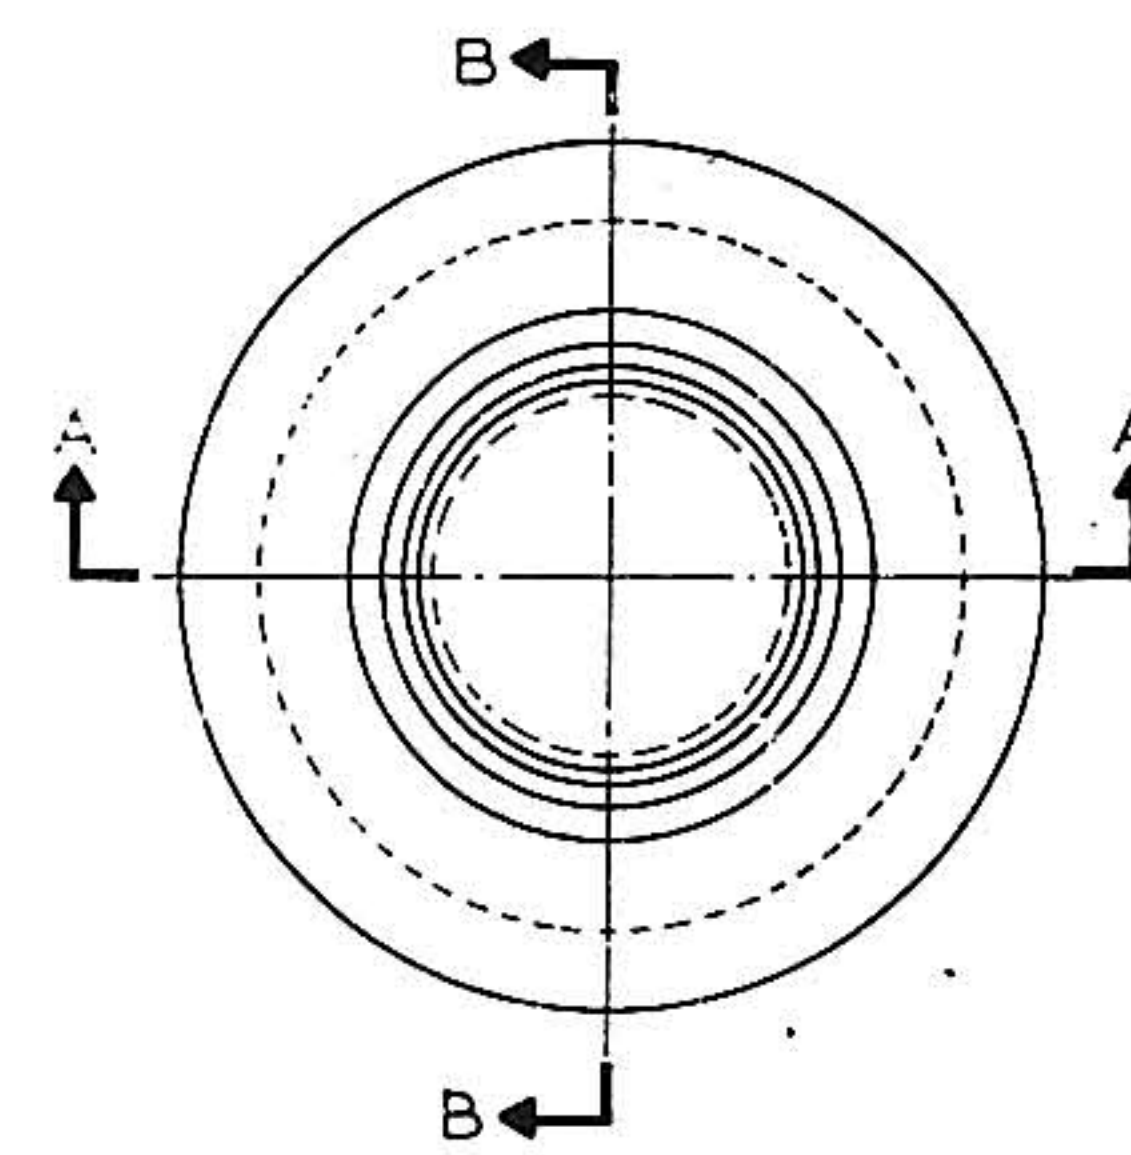

TOP VIEW

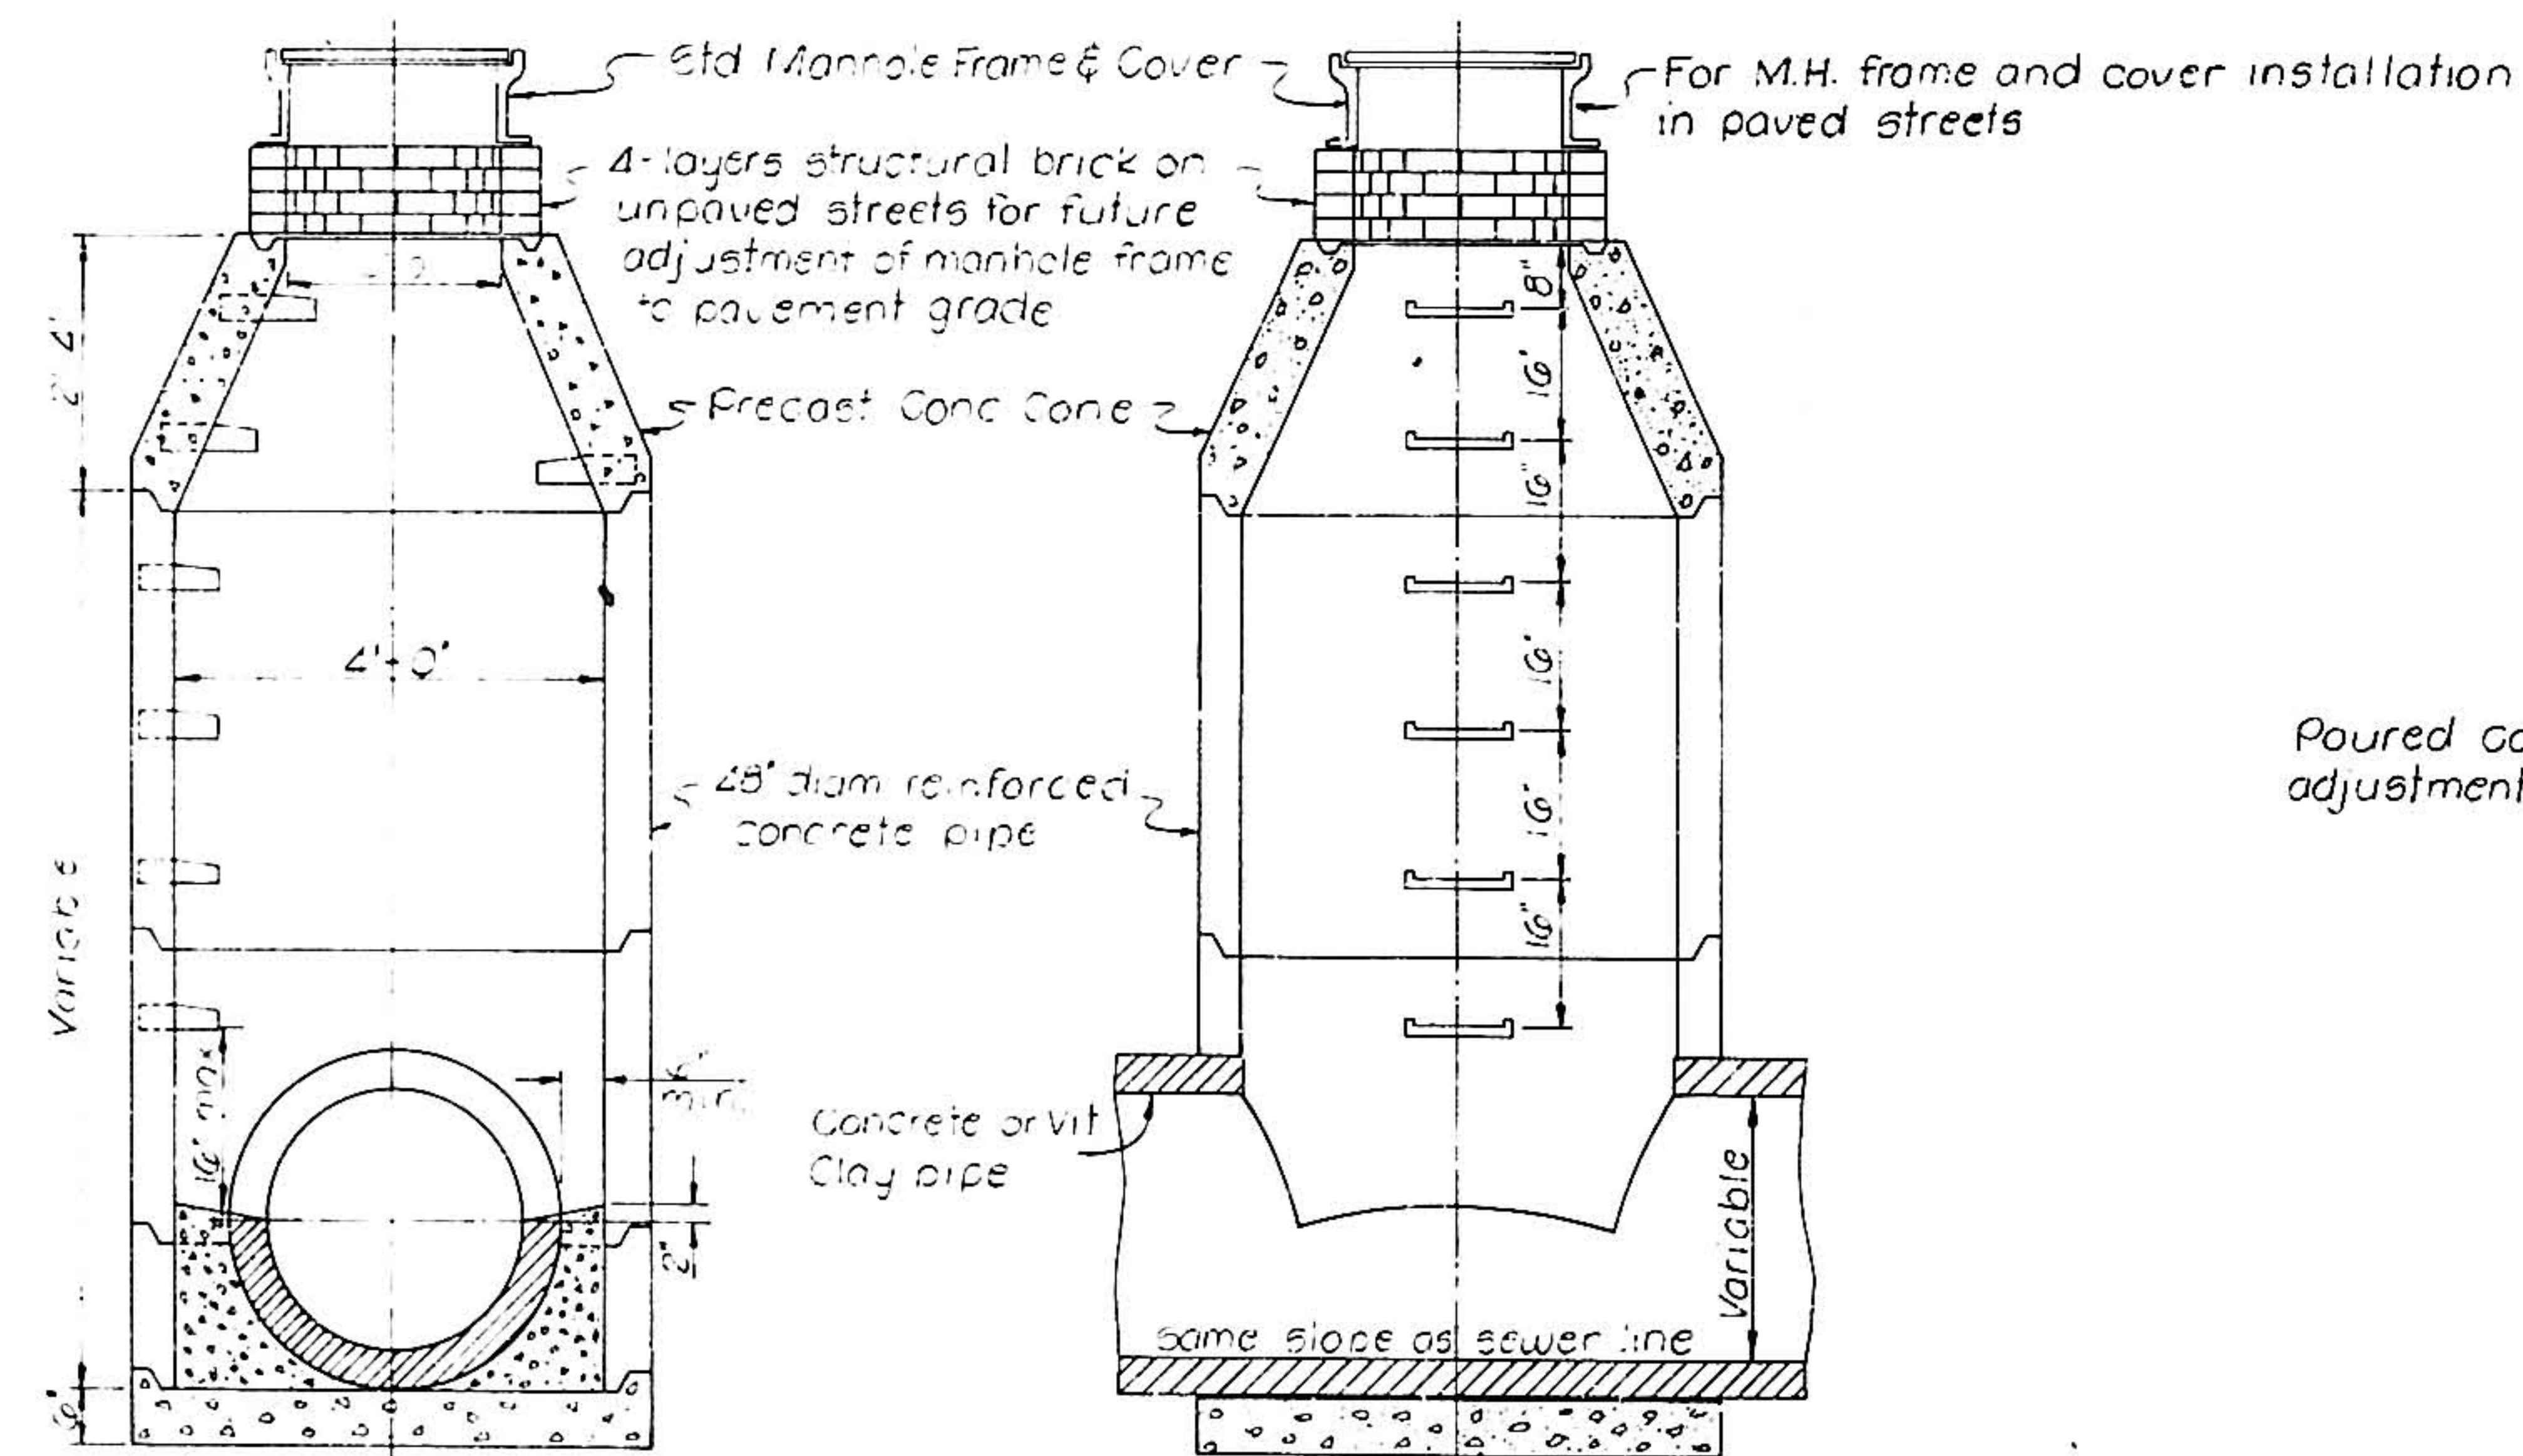


SECTION B-B

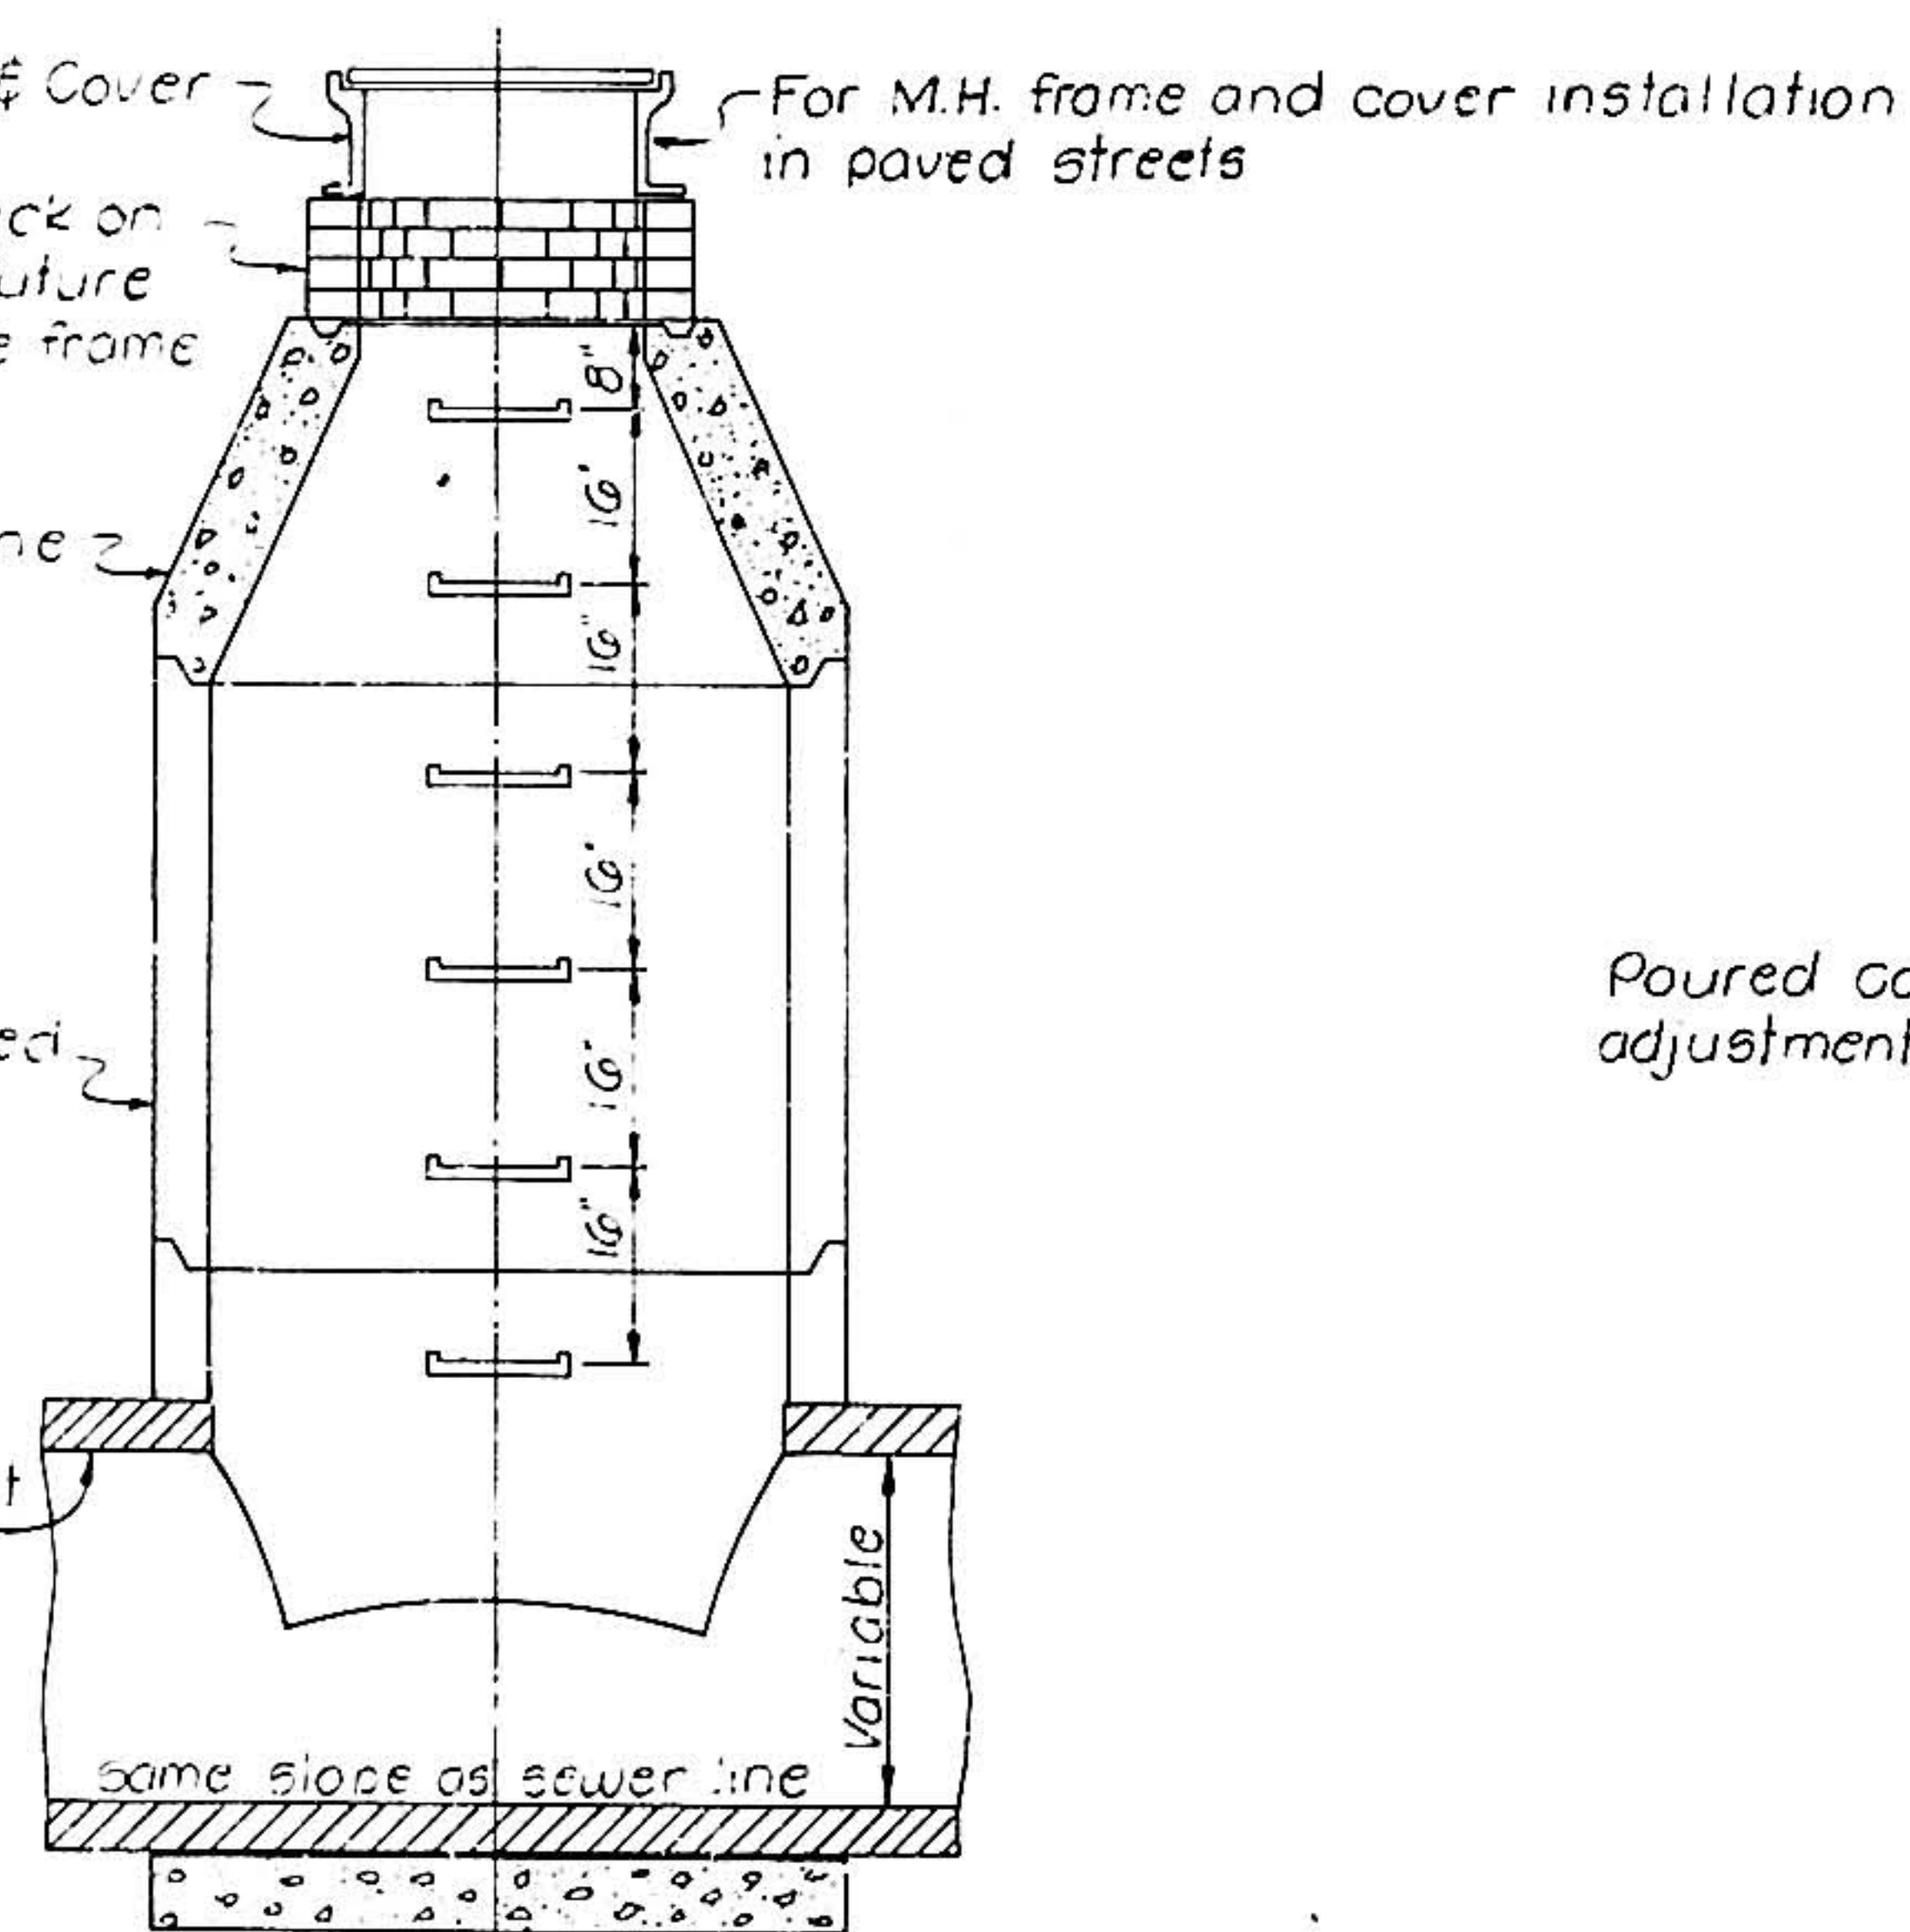

SECTION A-A


STANDARD SANITARY SEWER MANHOLE TYPE "B-1"

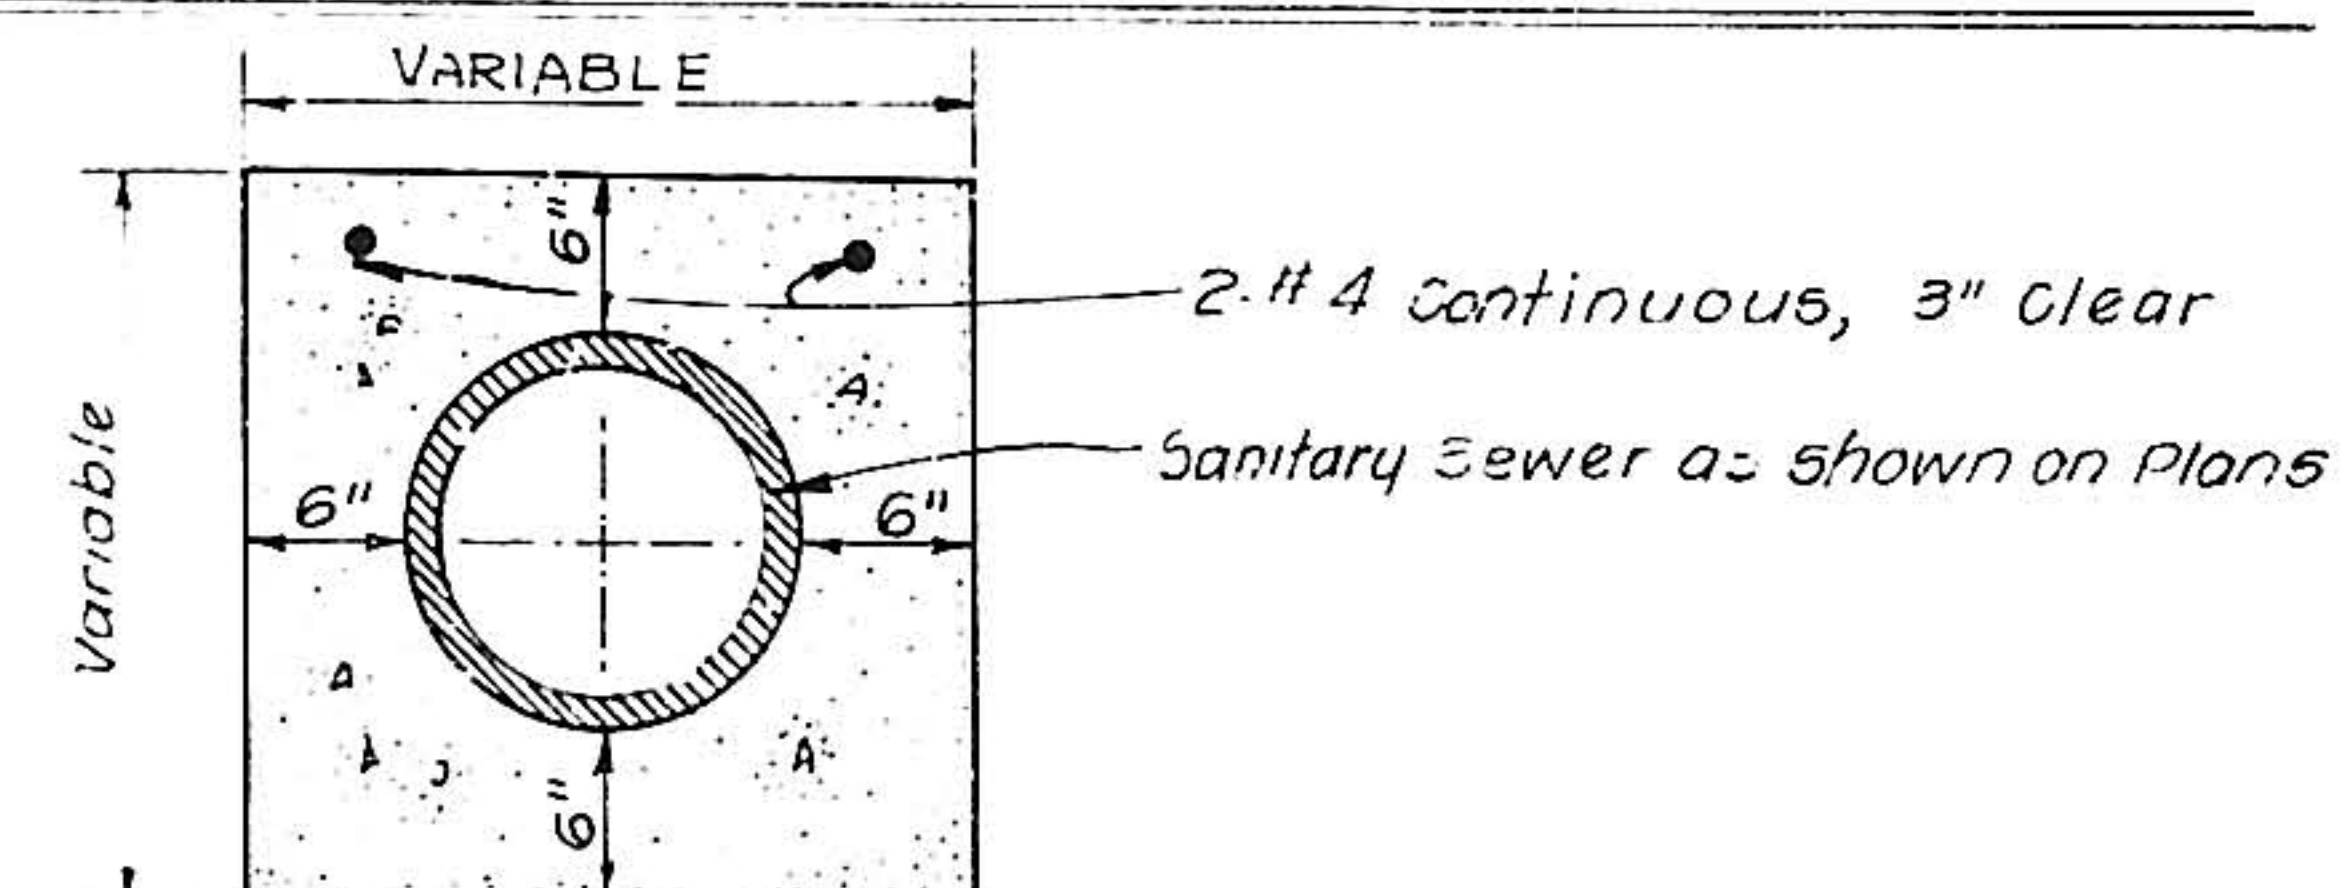


CONCRETE ENCASEMENT DETAIL

NOTE: Where a water line passes beneath an existing sewer line, the sewer line shall be encased in Concrete 6" inches thick for at least 10' feet on each side of the water line, or the sewer line shall be replaced with cast Iron pipe with leaded joints for 10' feet each side of water line.

REINFORCEMENT
2 layers #4 @ 6" C-C each way
1 1/2" cover over reinf.

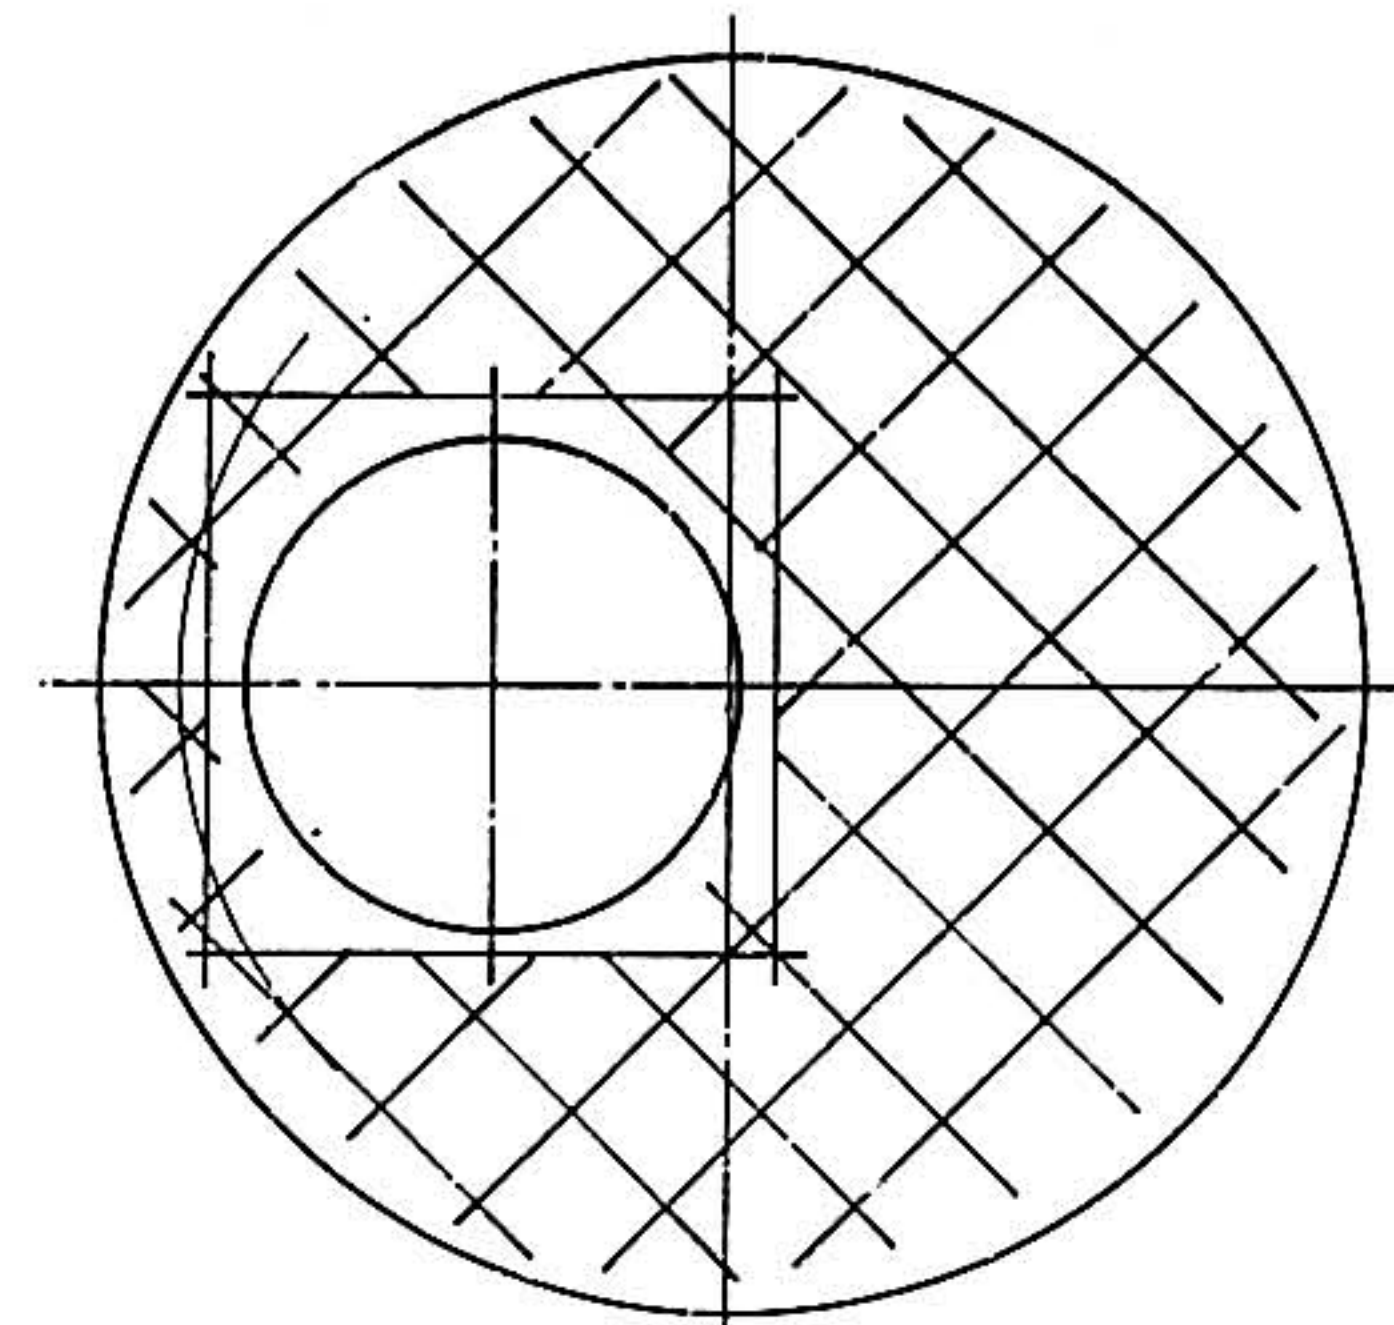


BOTTOM MAT

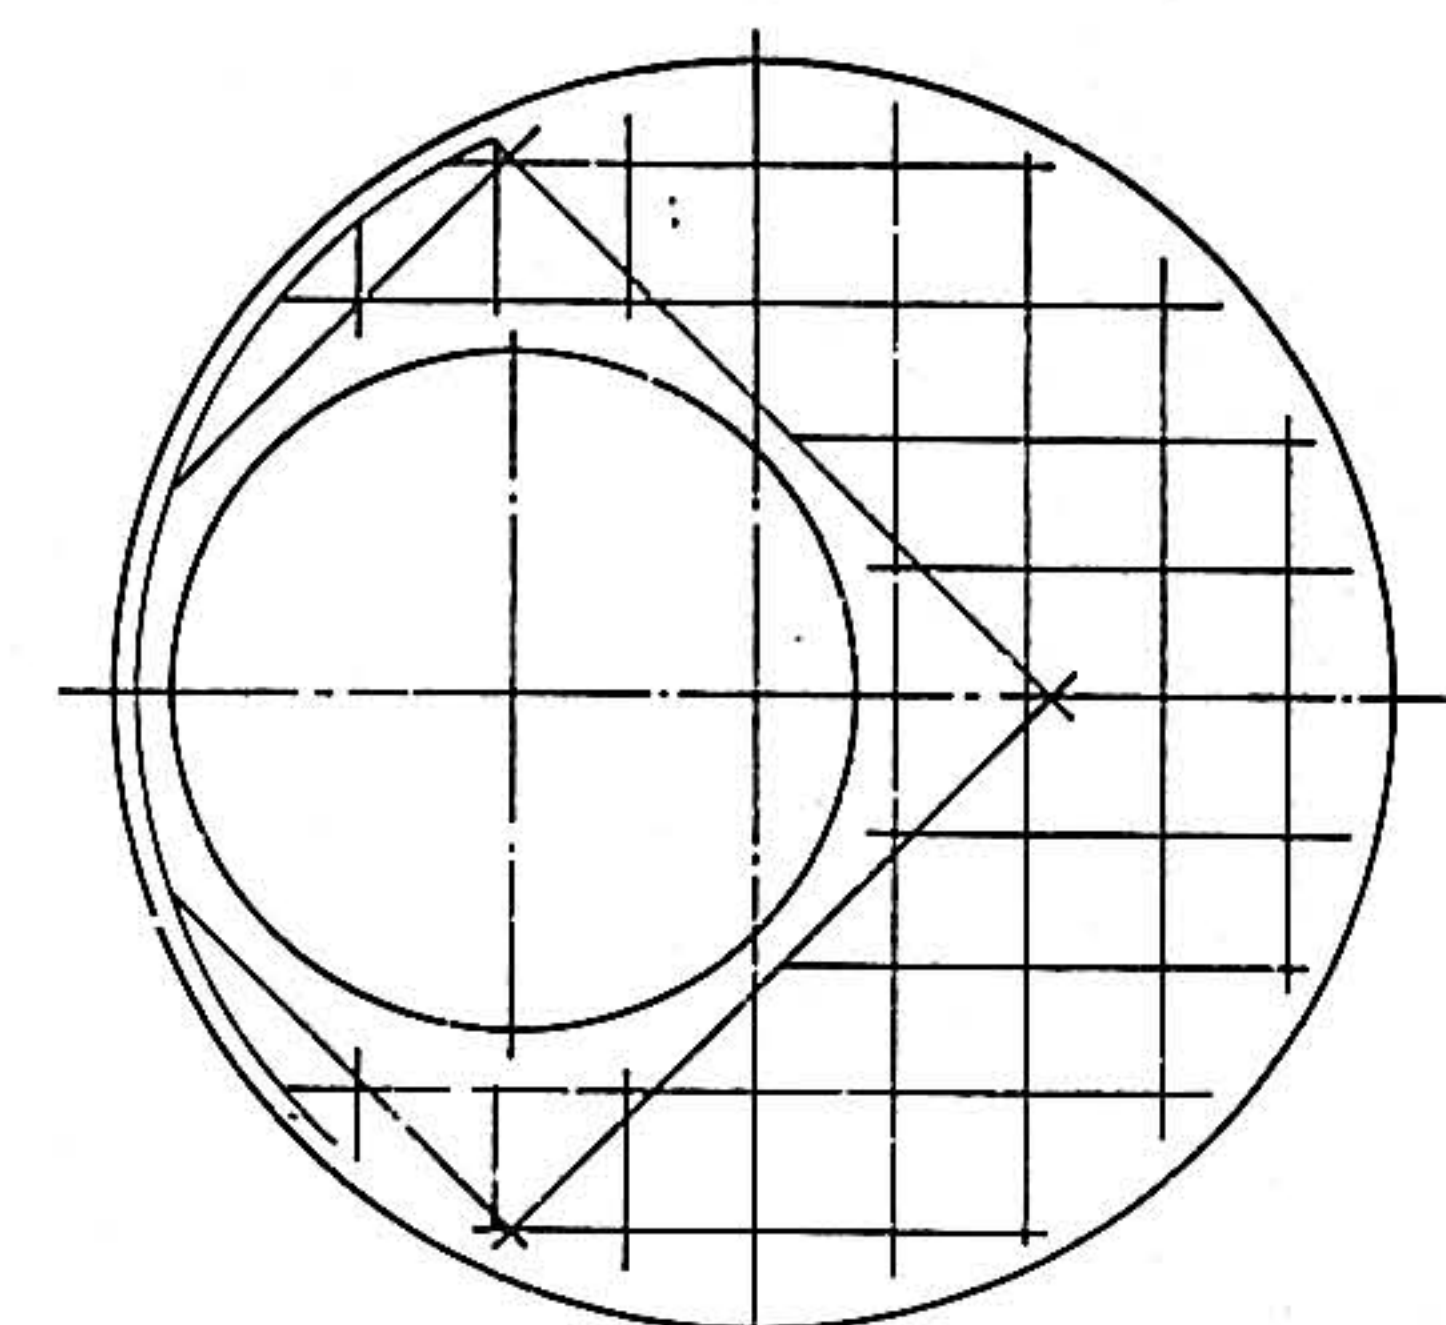


TOP MAT



REINFORCING FOR PRECAST CONC. COVER

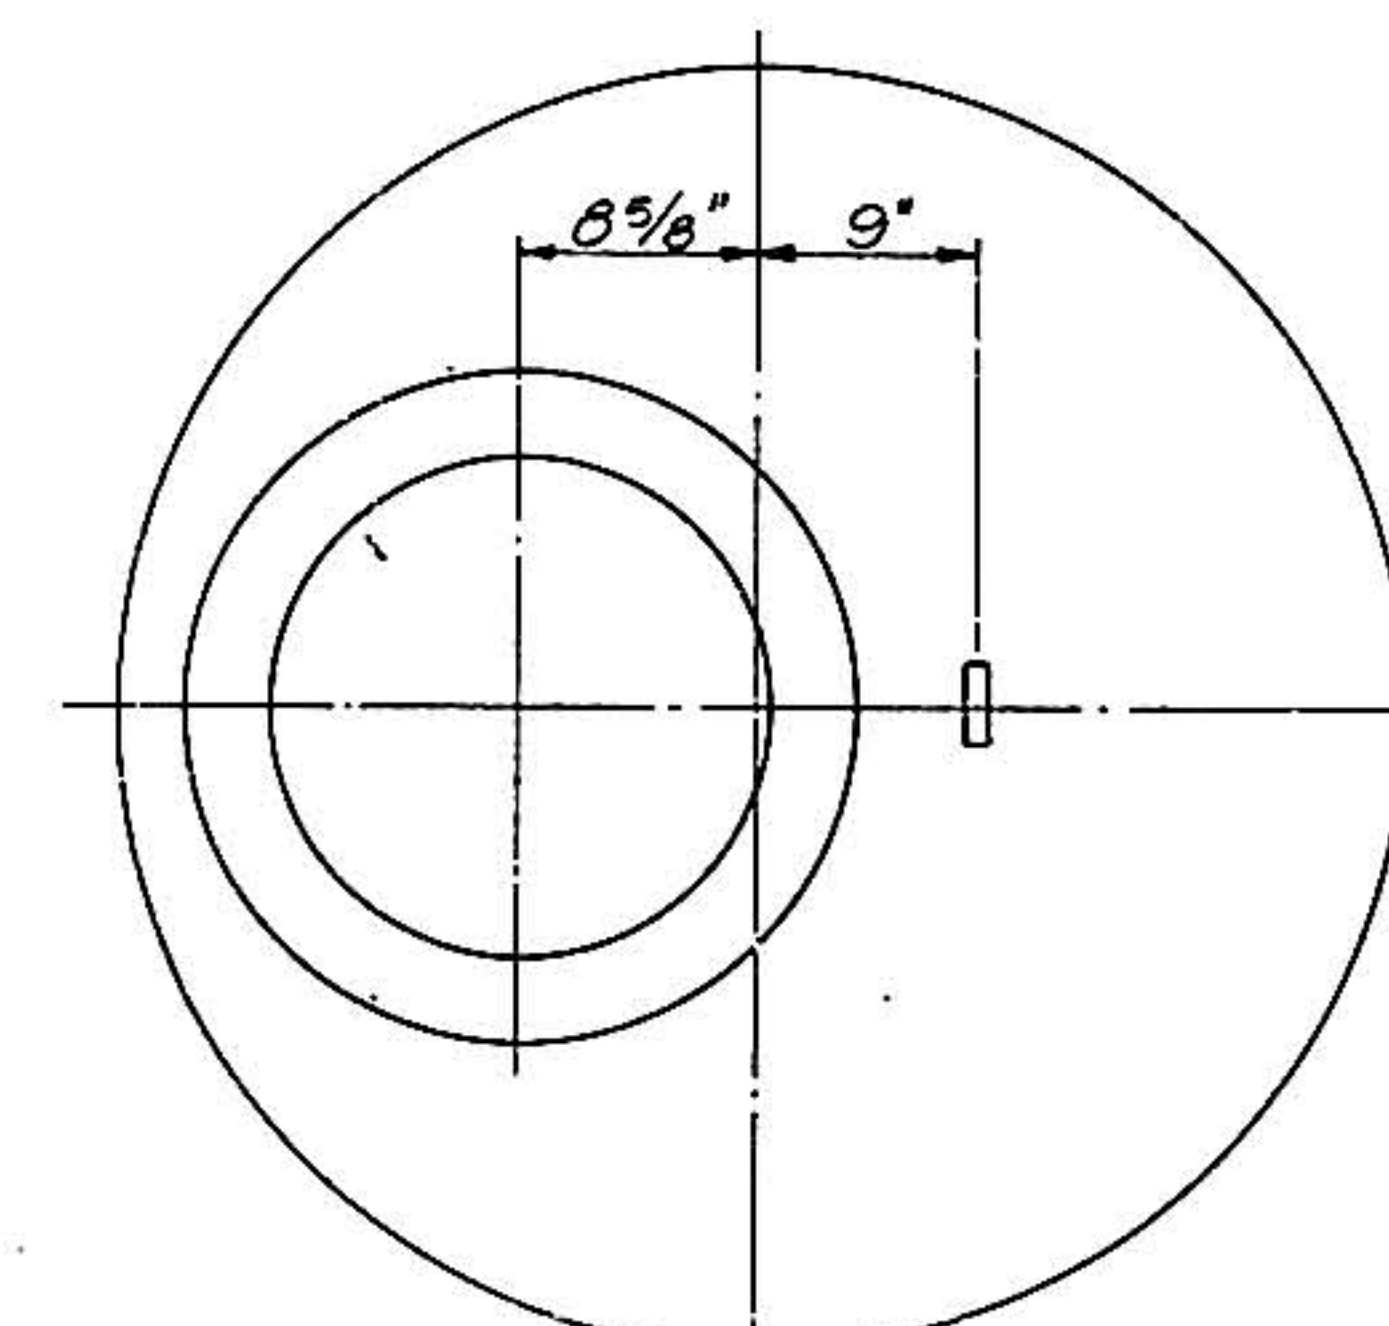


TOP VIEW

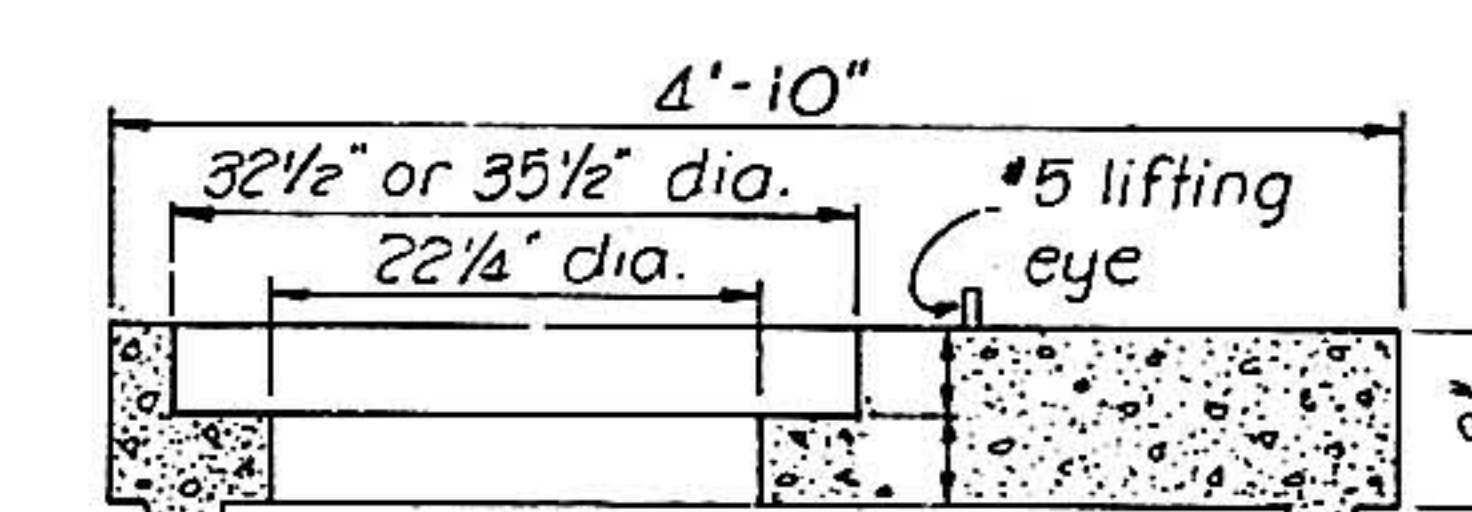

PRECAST CONCRETE COVER

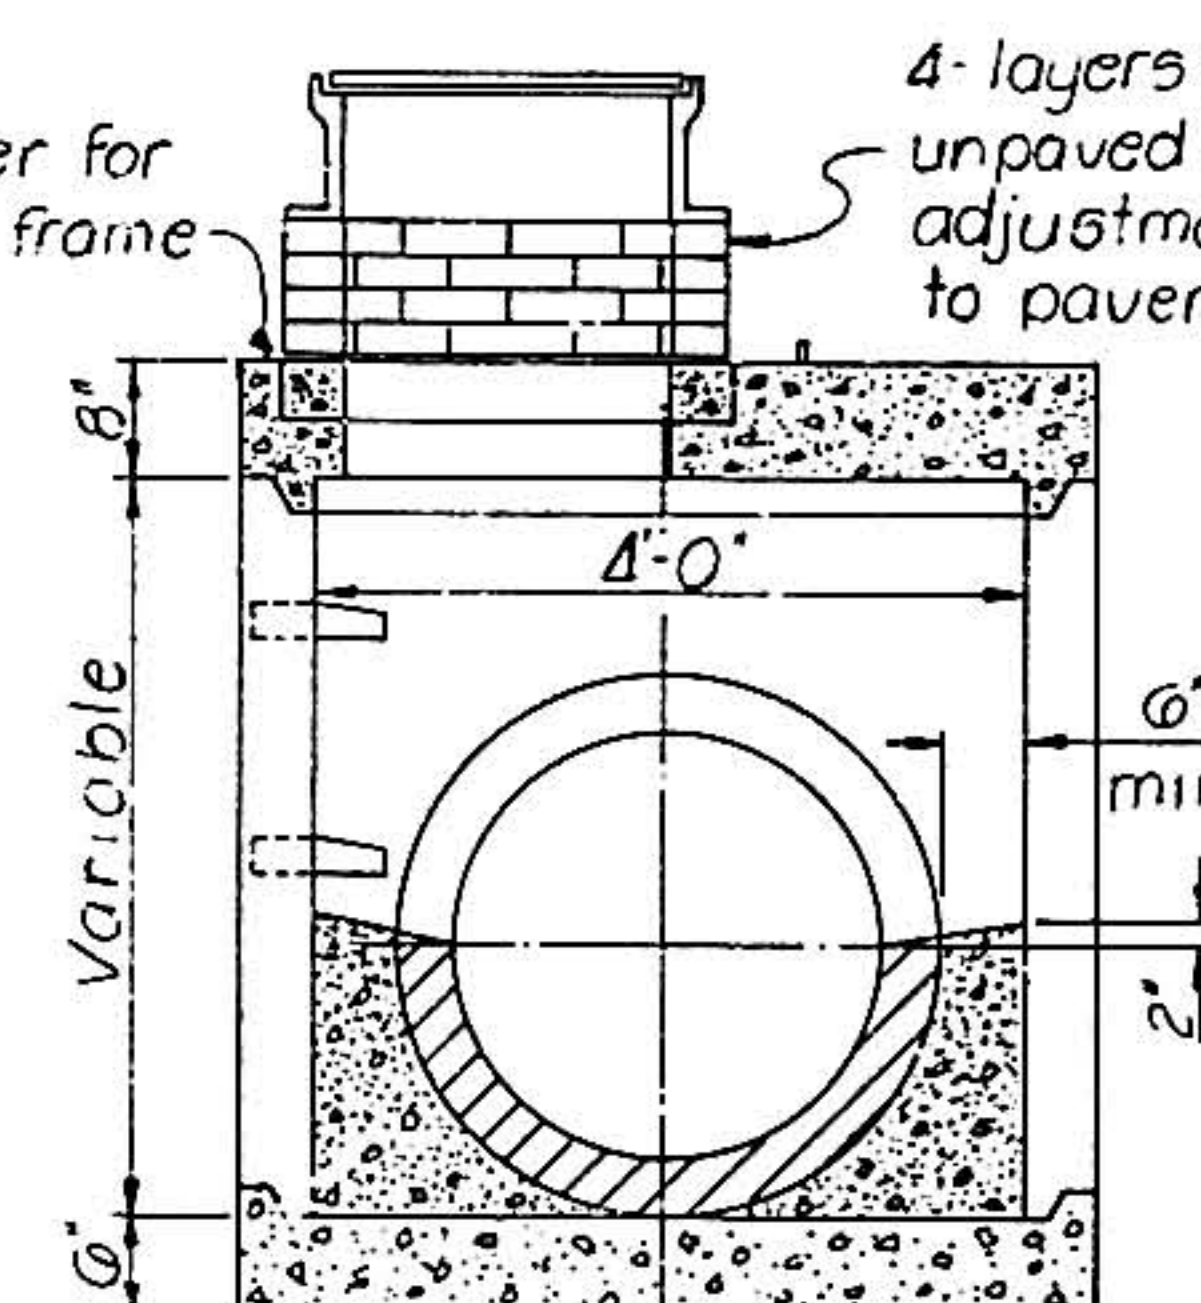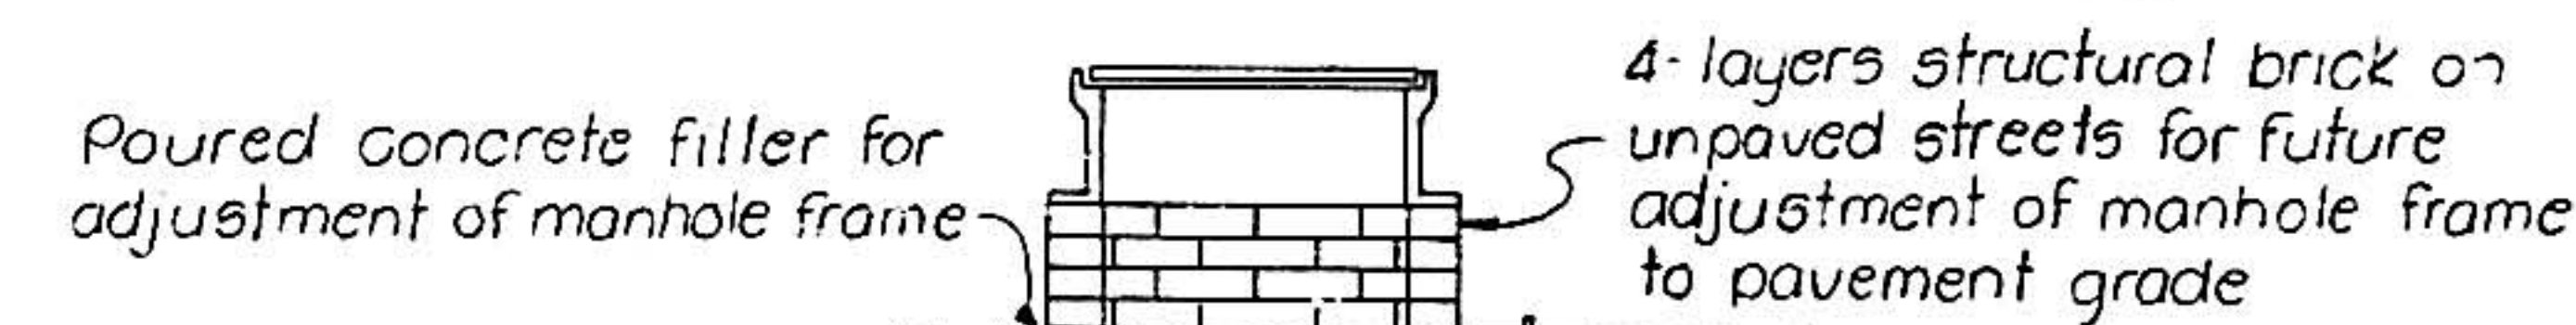


SECTION B-B

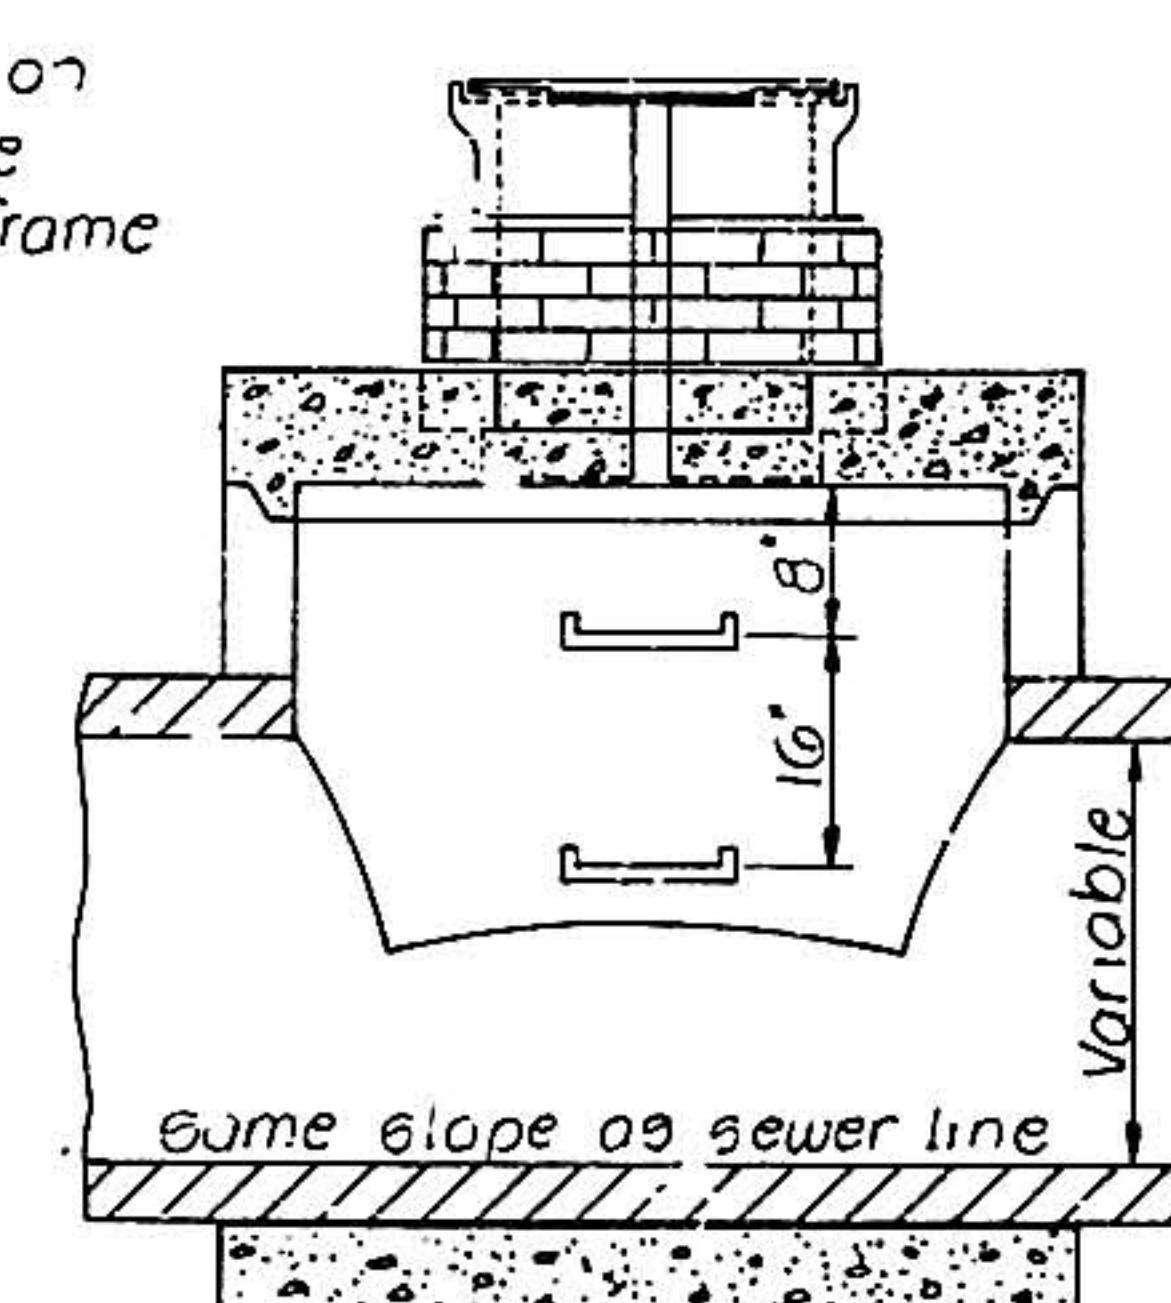


SECTION A-A

SPECIAL SANITARY SEWER MANHOLE TYPE "C-1"

ALTERNATE MANHOLE DESIGN

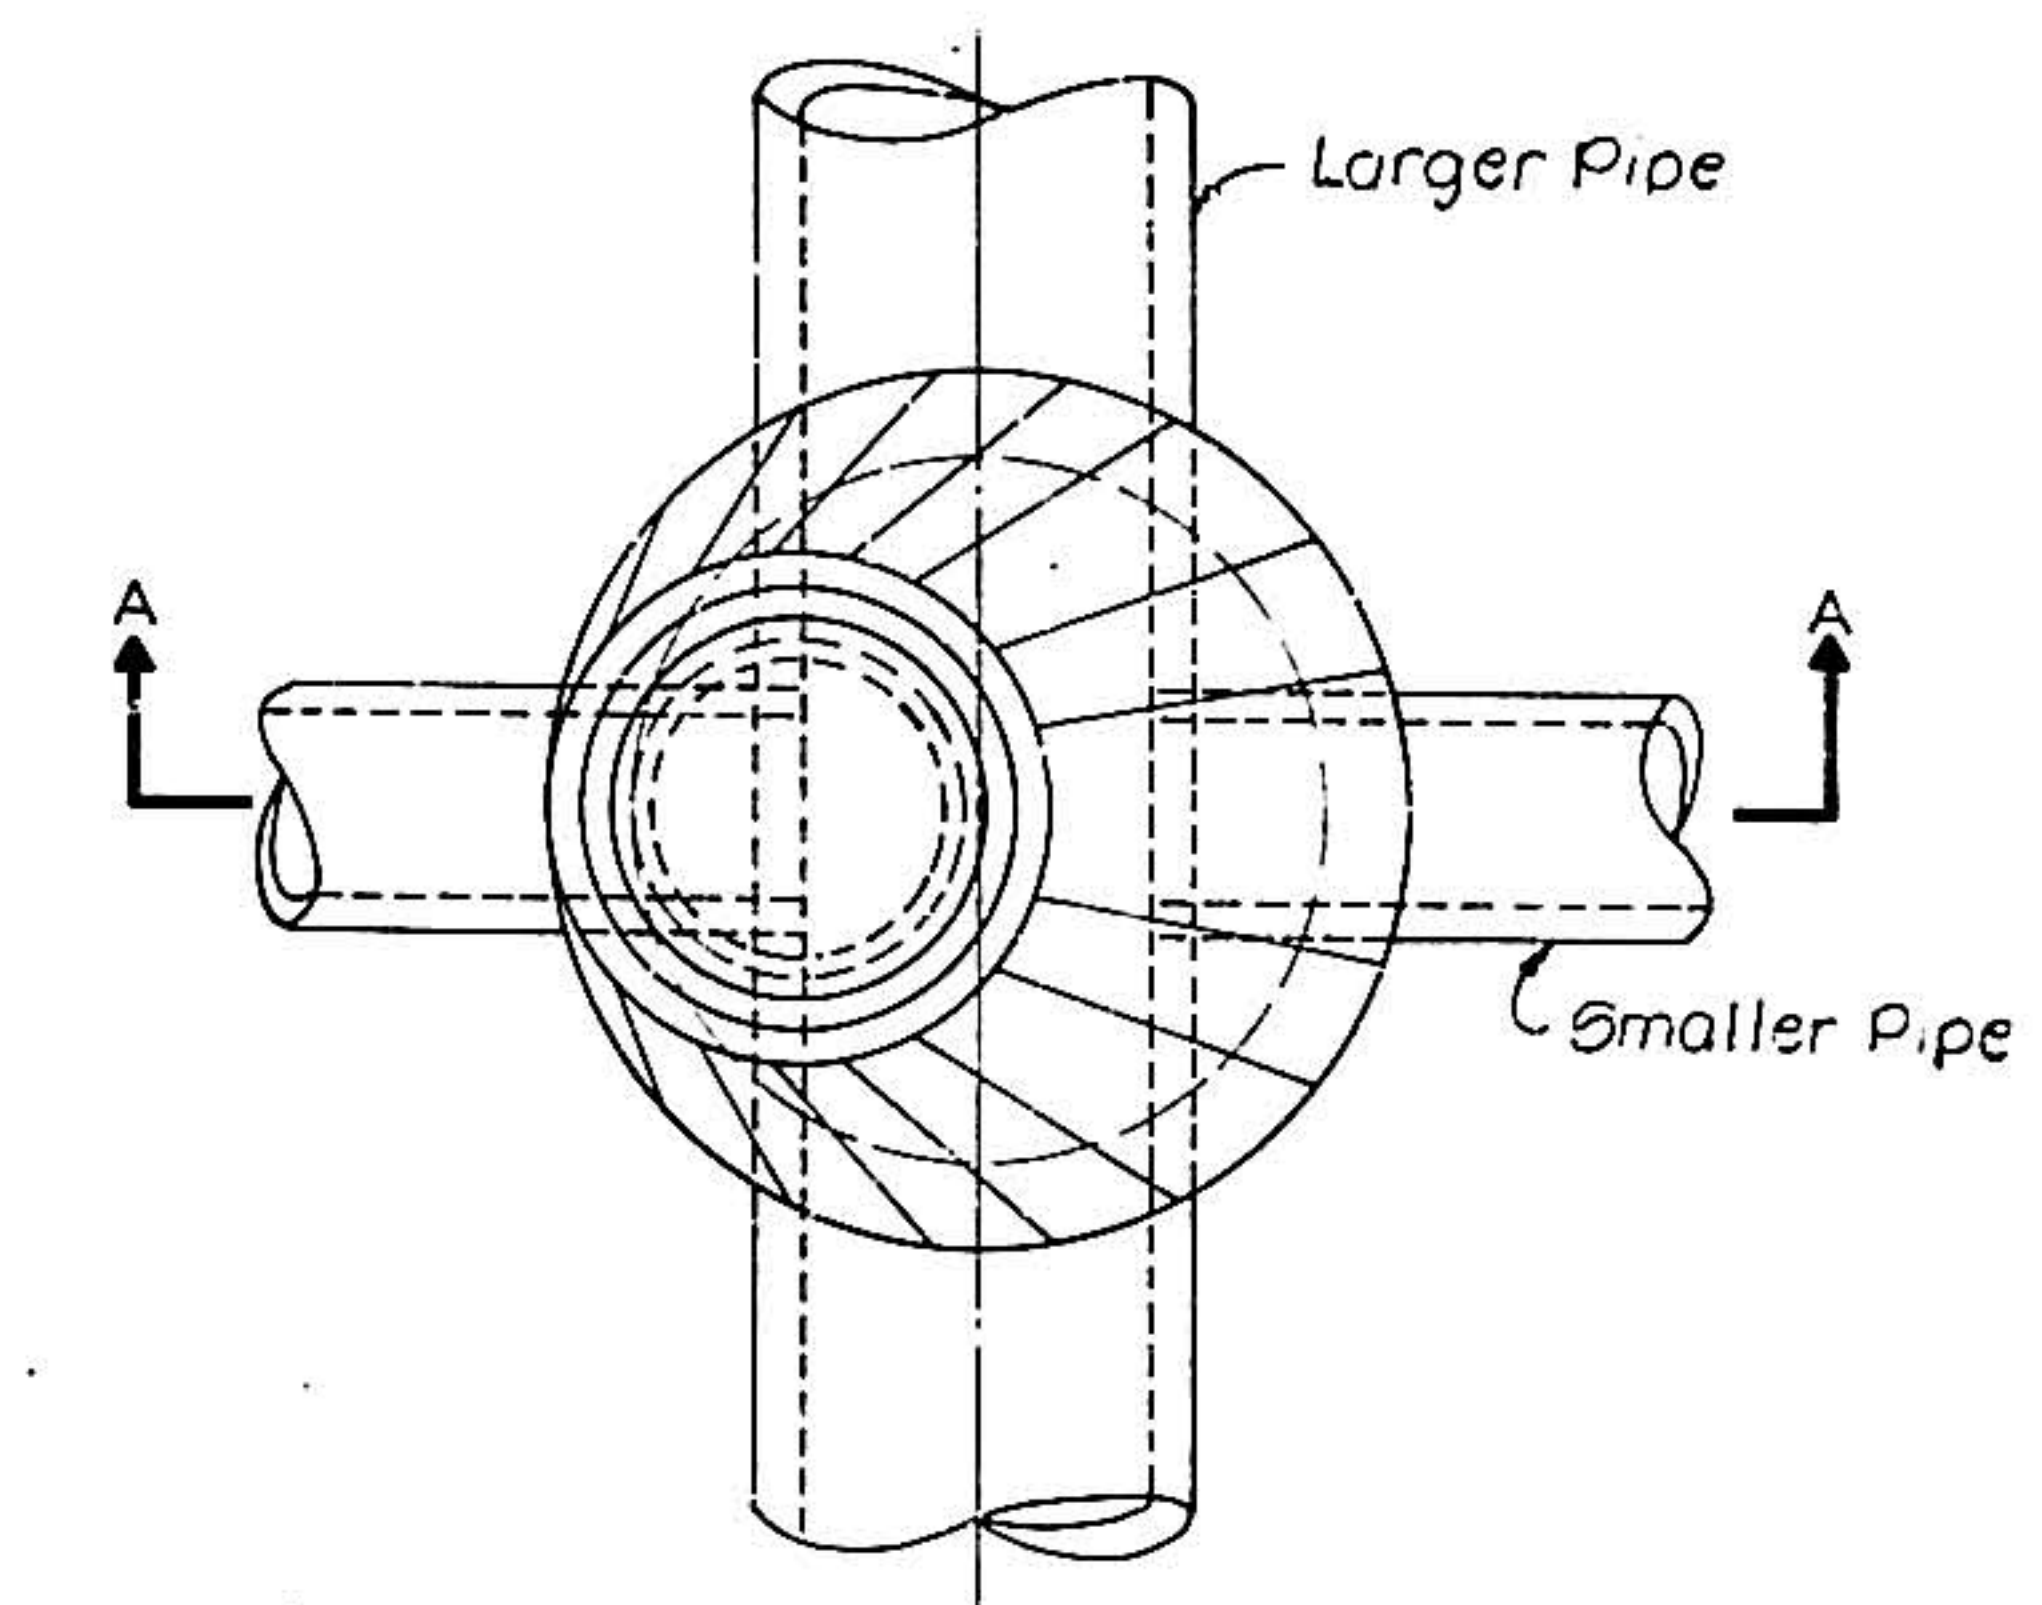

TOP VIEW

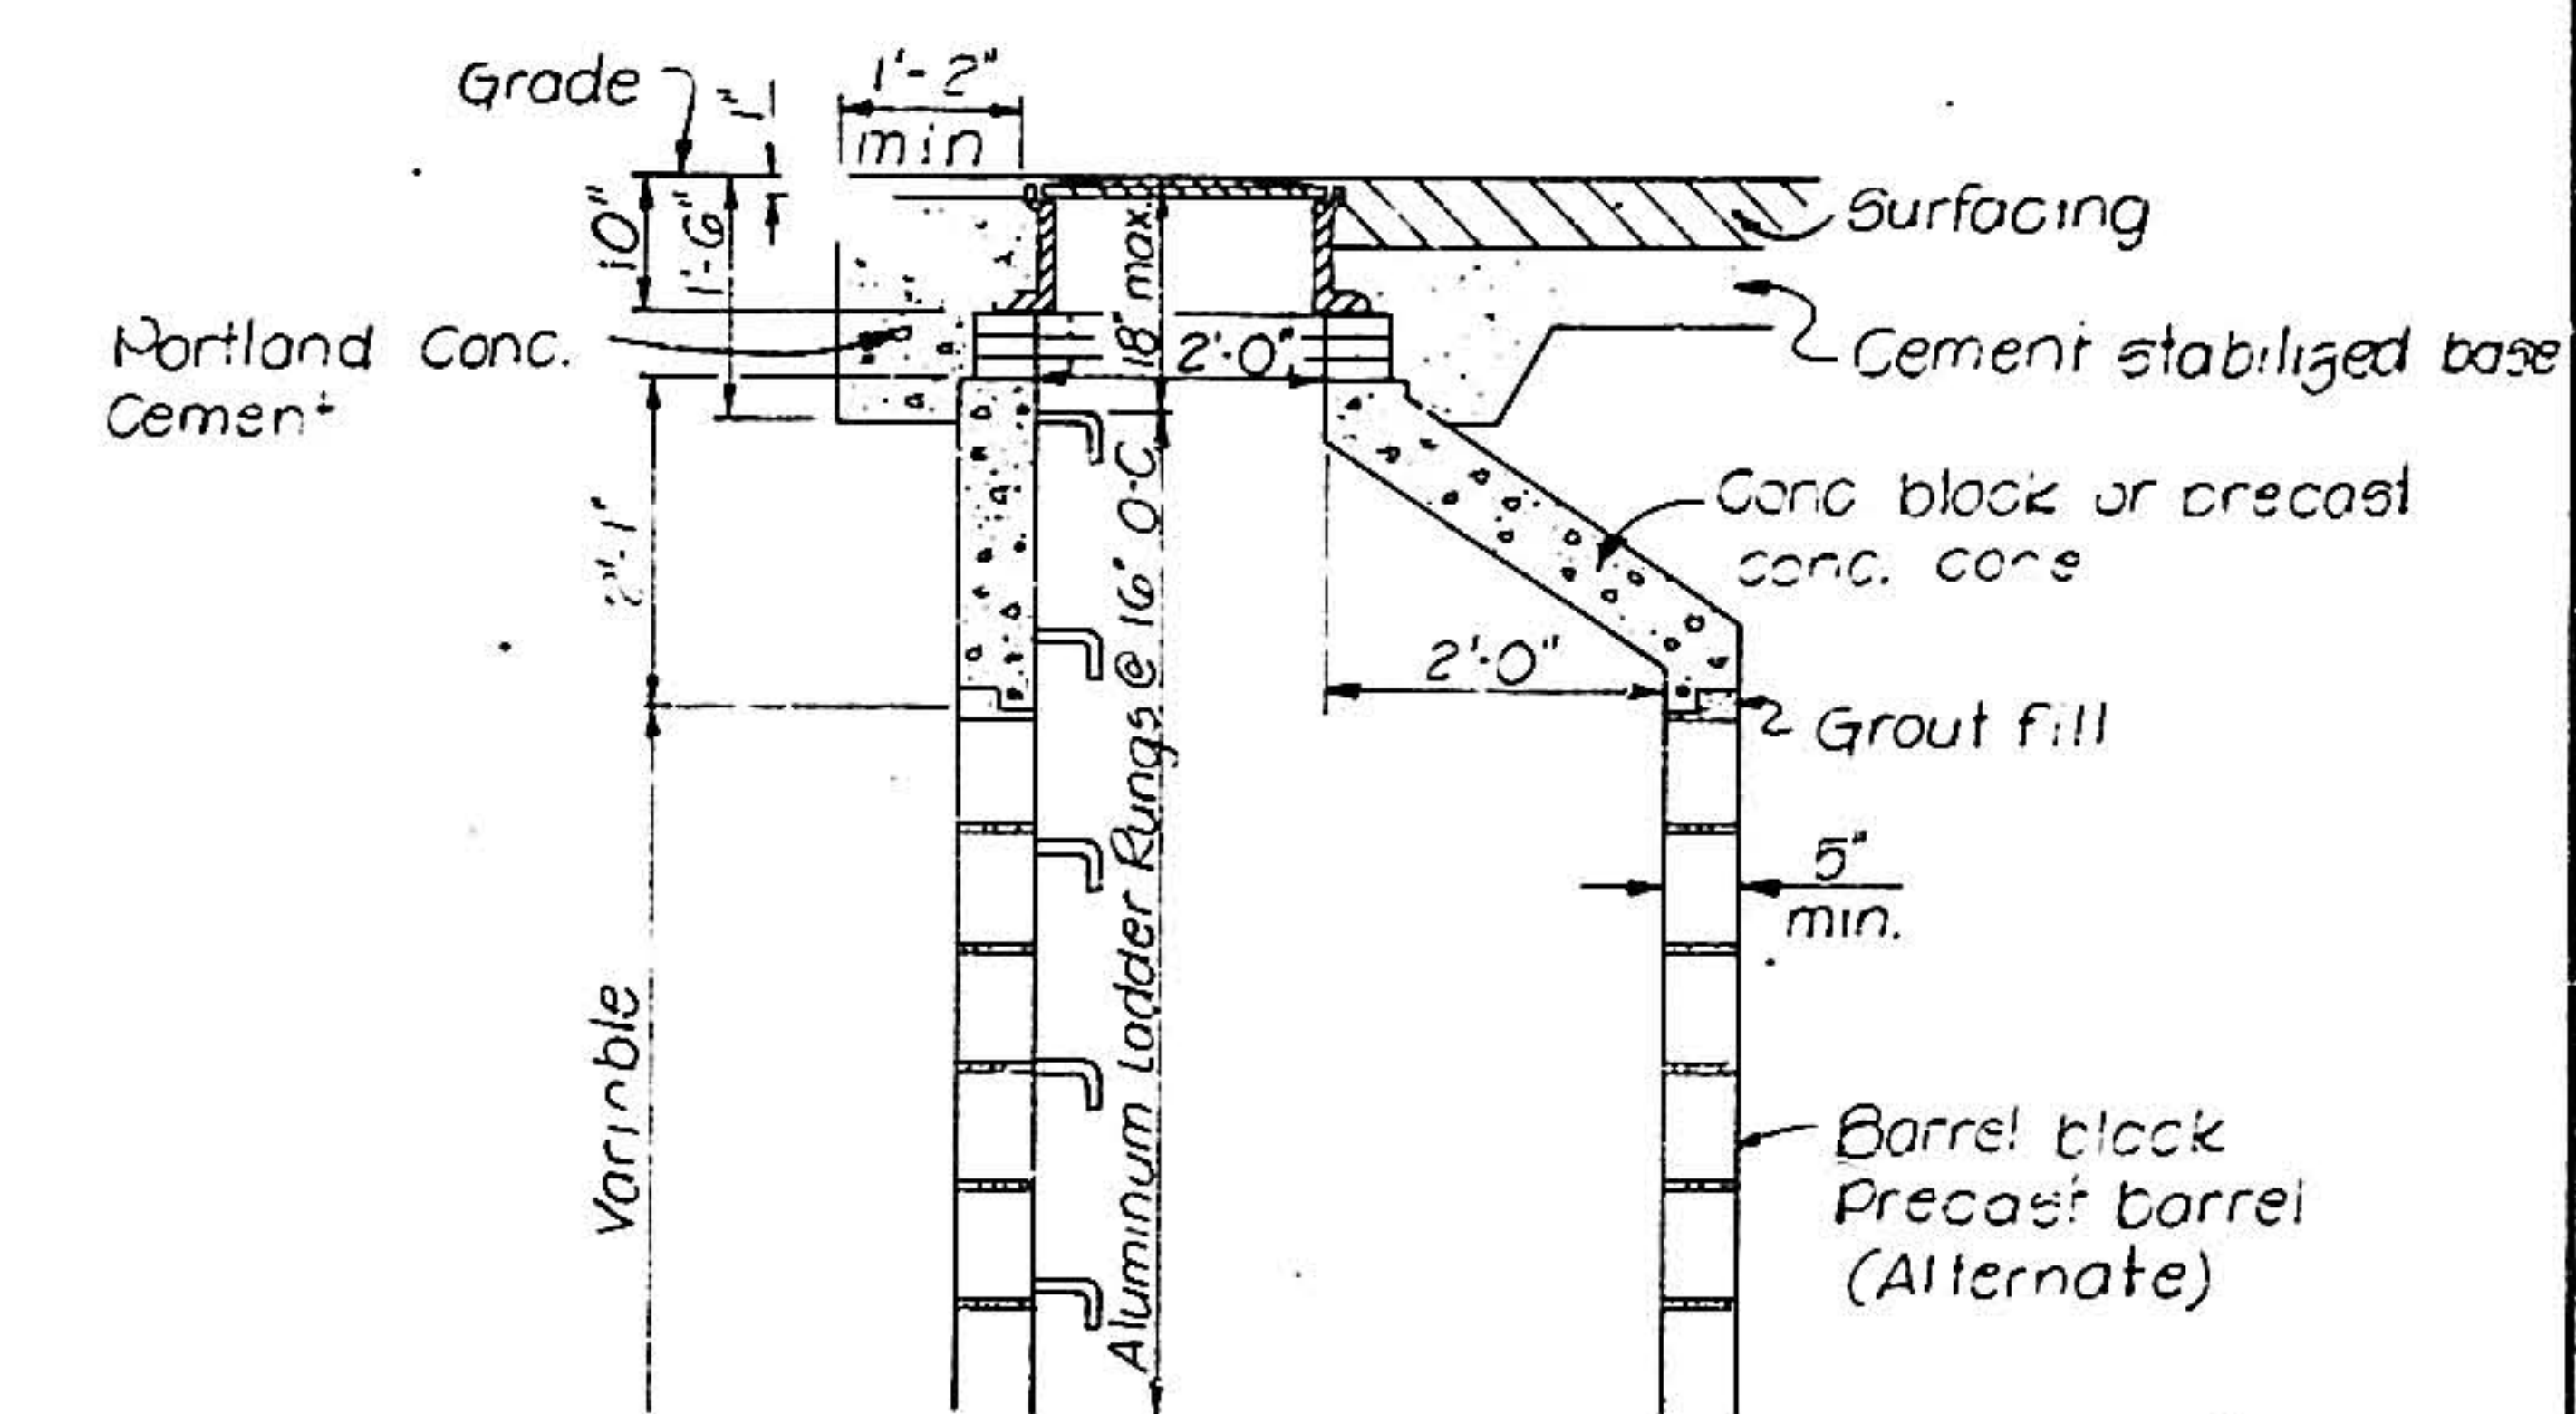

SECTION A-A

TYPE E MANHOLE

NOTES:

1. Eccentric Cones shall be Used for Manholes On All pipes 24" diameter and larger, regardless of depth.
2. Eccentric Cones shall be used for all manholes 10' or greater in depth.
3. Eccentric Cones for 6' diameter manholes may consist of standard 4' diameter eccentric cone and approved 4' to 6' precast transition section.
4. Manhole cover and rim to be placed above axis of small pipe

ALBUQUERQUE, NEW MEXICO
SPECIAL ASSESSMENT DISTRICT NO.173

STANDARD MANHOLE DETAILS


D. F. MOLZEN & ASSOCIATES
Consulting Engineers
ALBUQUERQUE NEW MEXICO

Drawn	Checked	Sheet 66 of
File	Date	



ADDENDUM No 1

JANUARY 13, 1970


1	2	3	4	5	6	7	8	9	10	11	12	13	14	15	16	17	18	19	20	21	22	23	24	25	26	27	28
0	7		1	7	3		6	6	7	0		1	0	1	0												
08																											

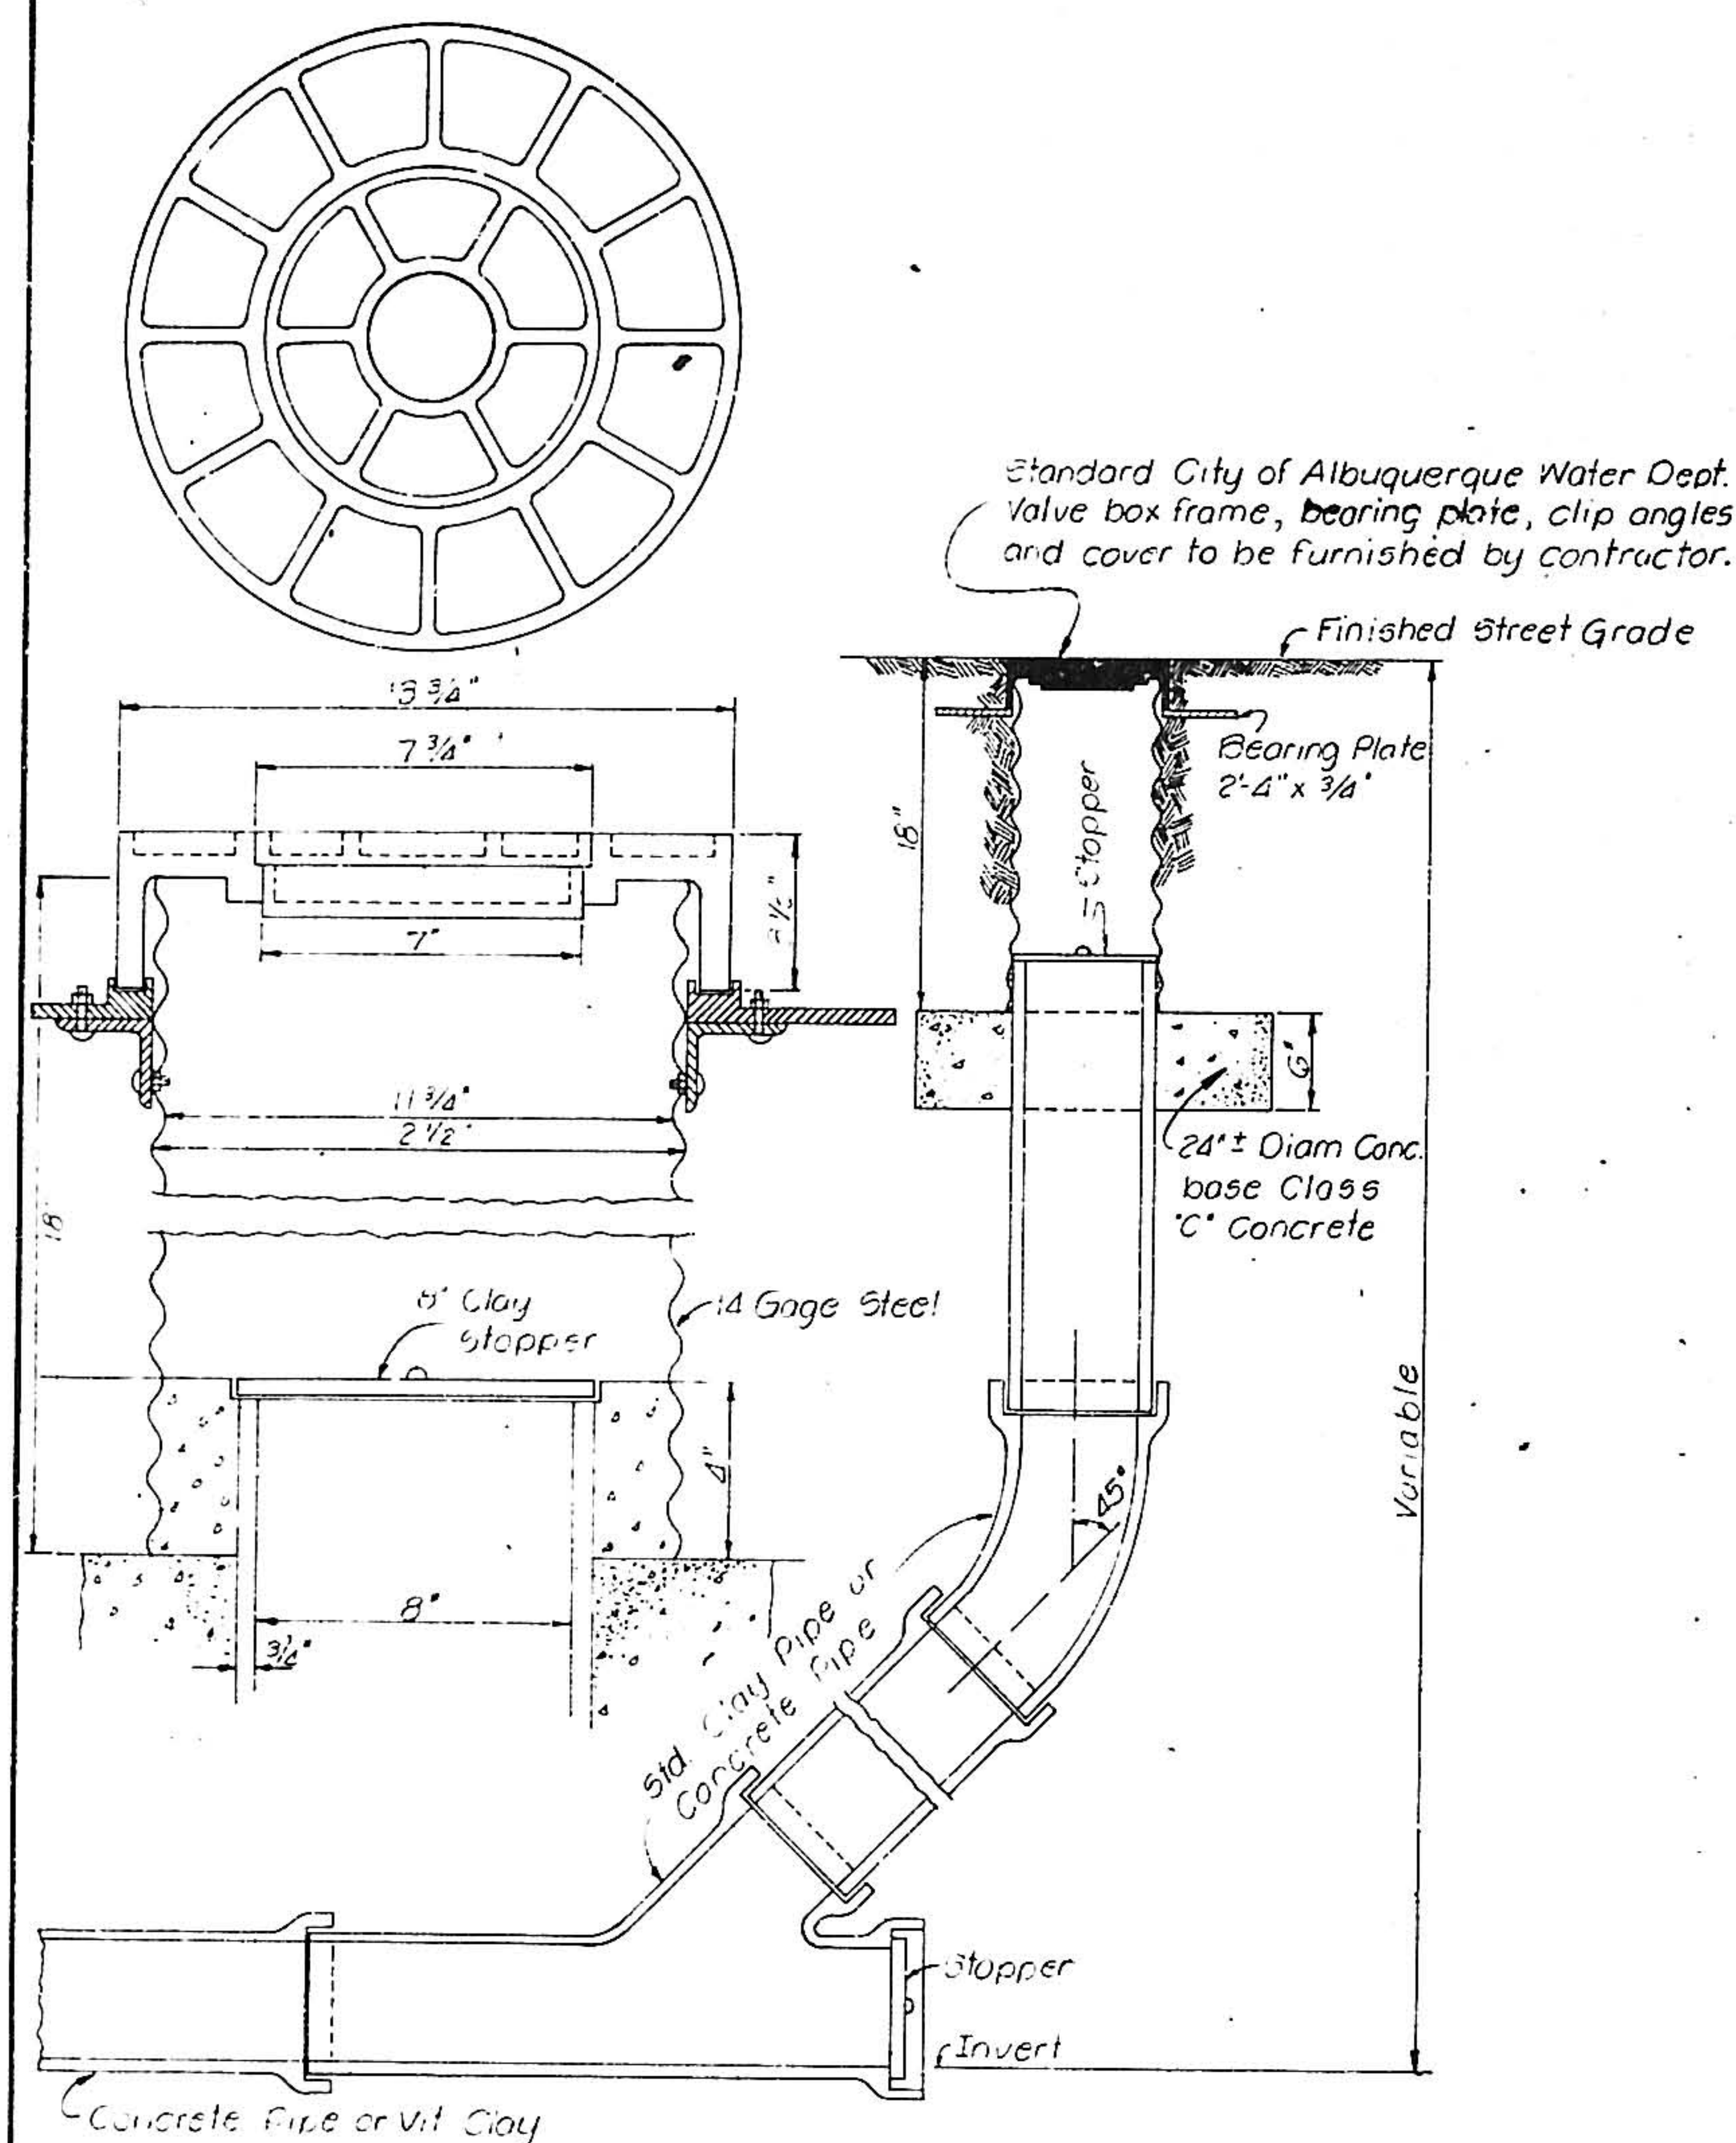


LAMPHOLE OR CLEANOUT, AND COVER

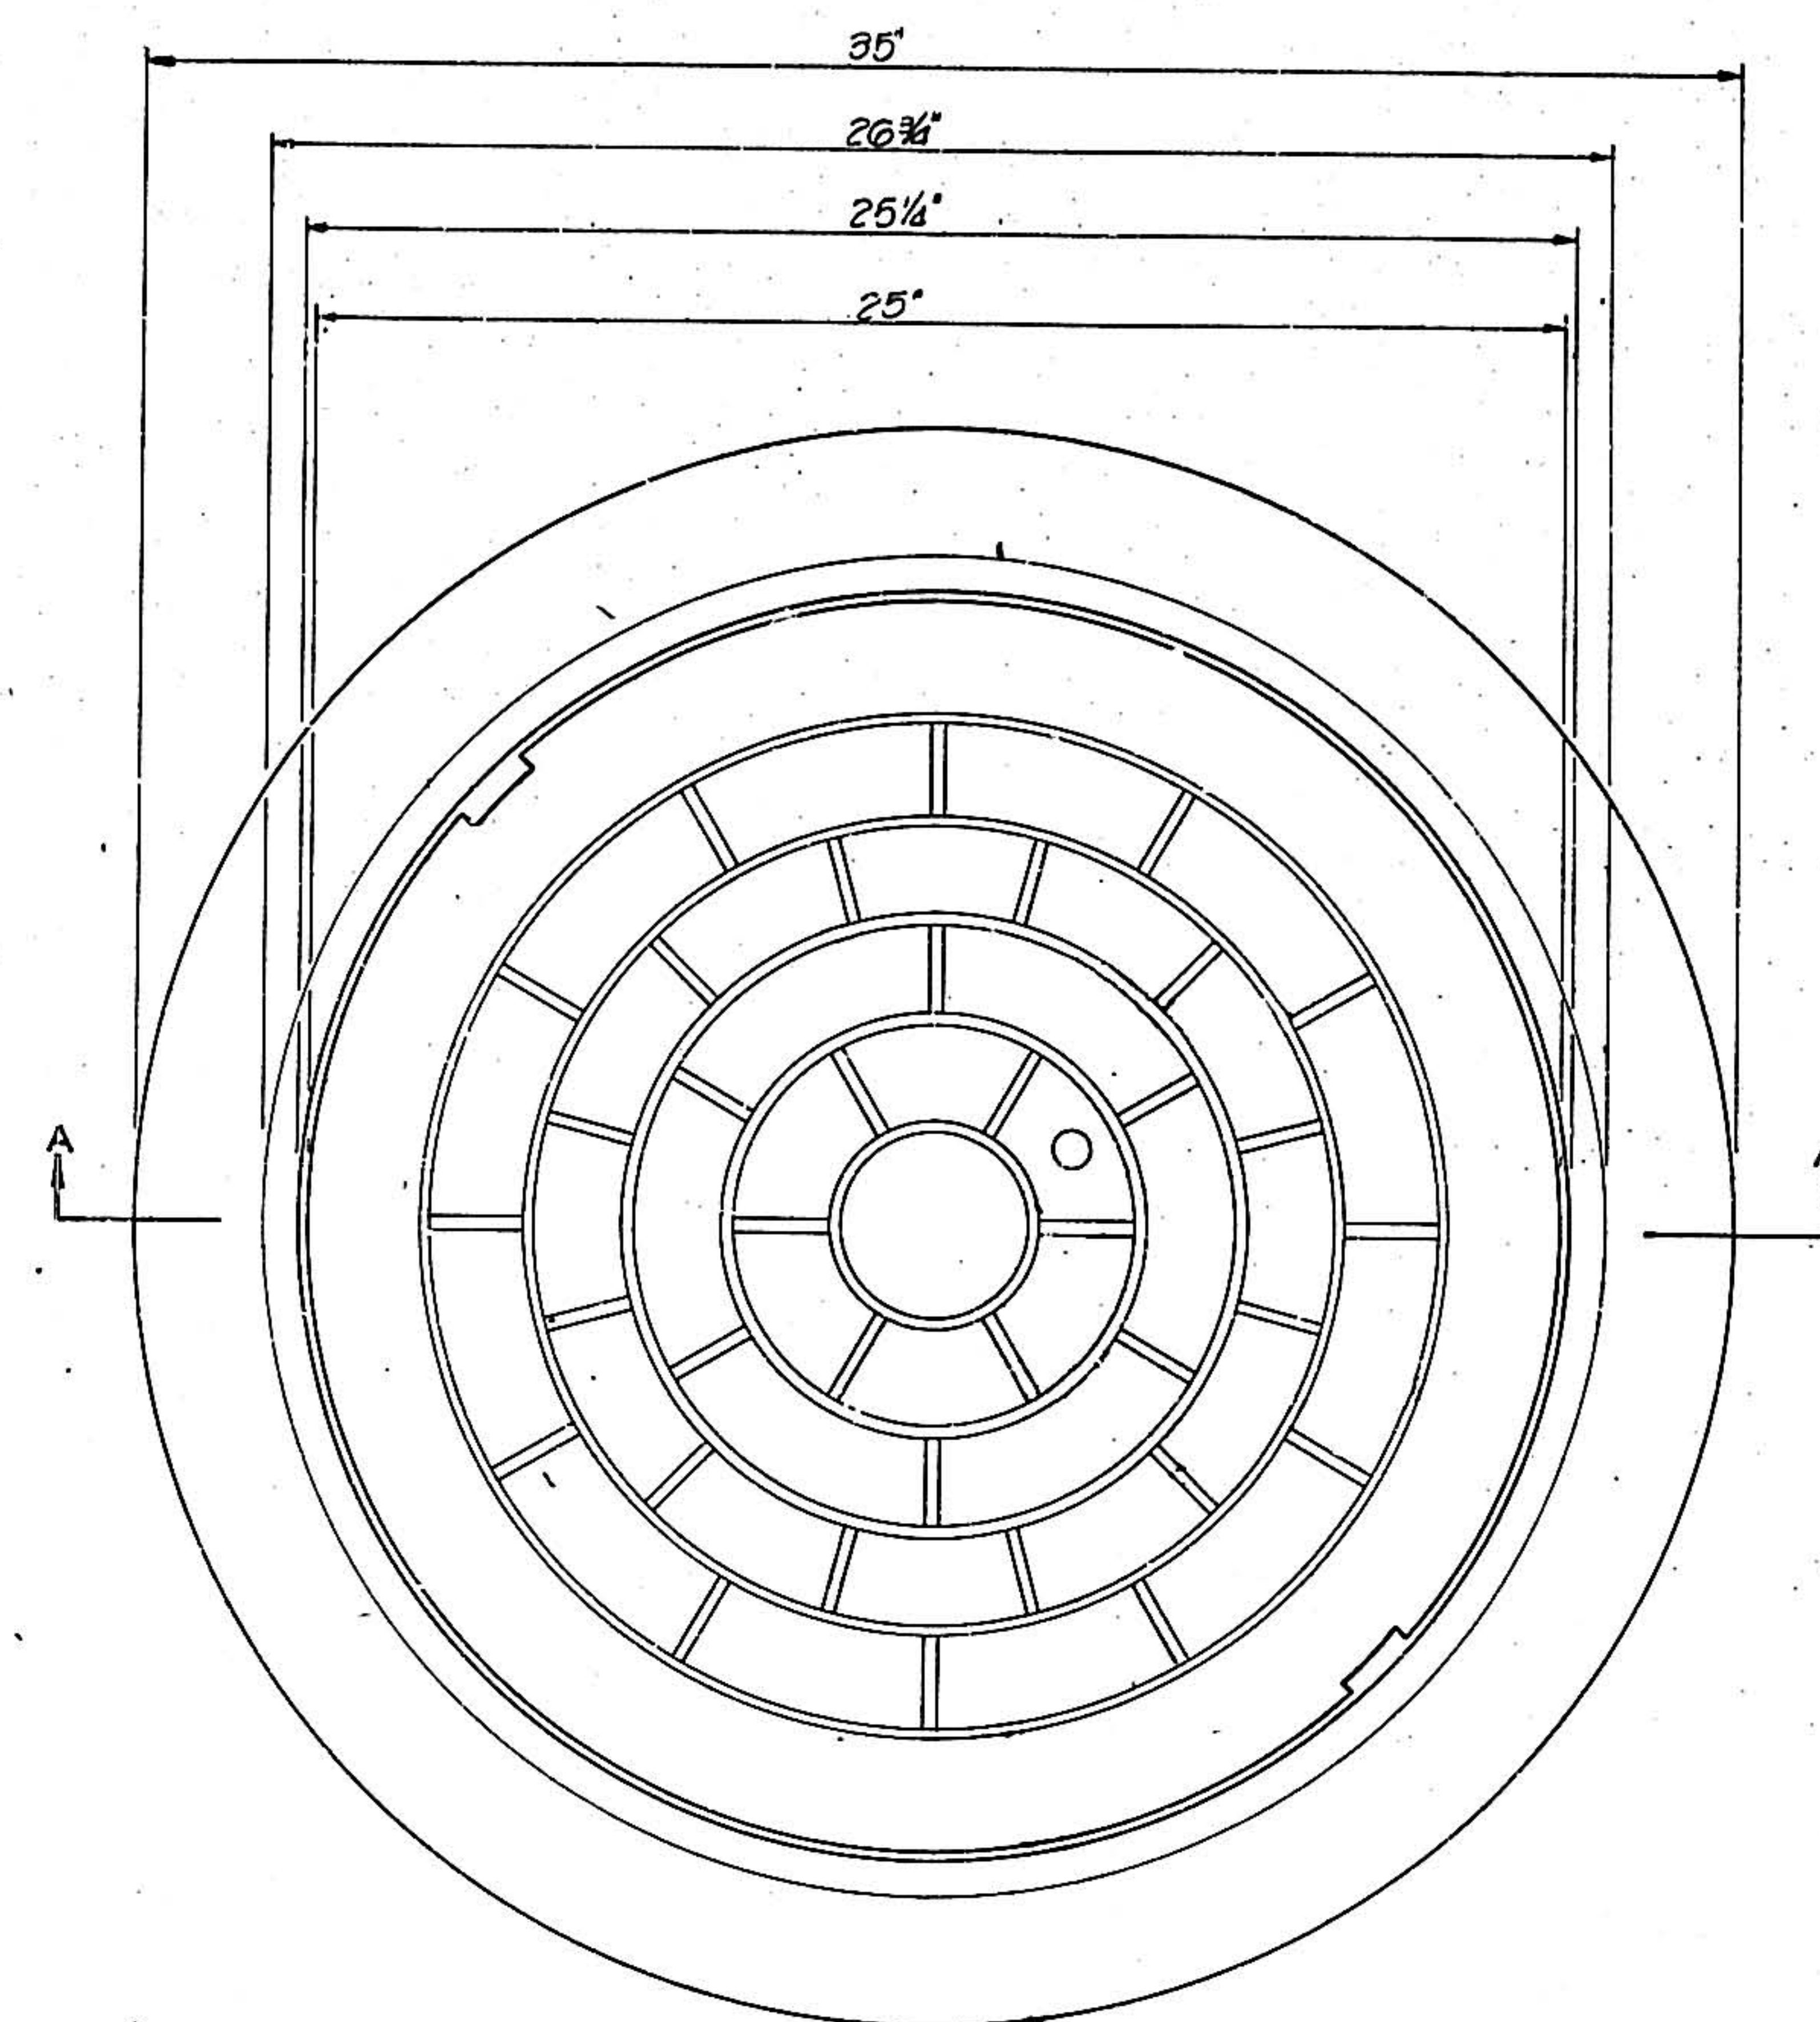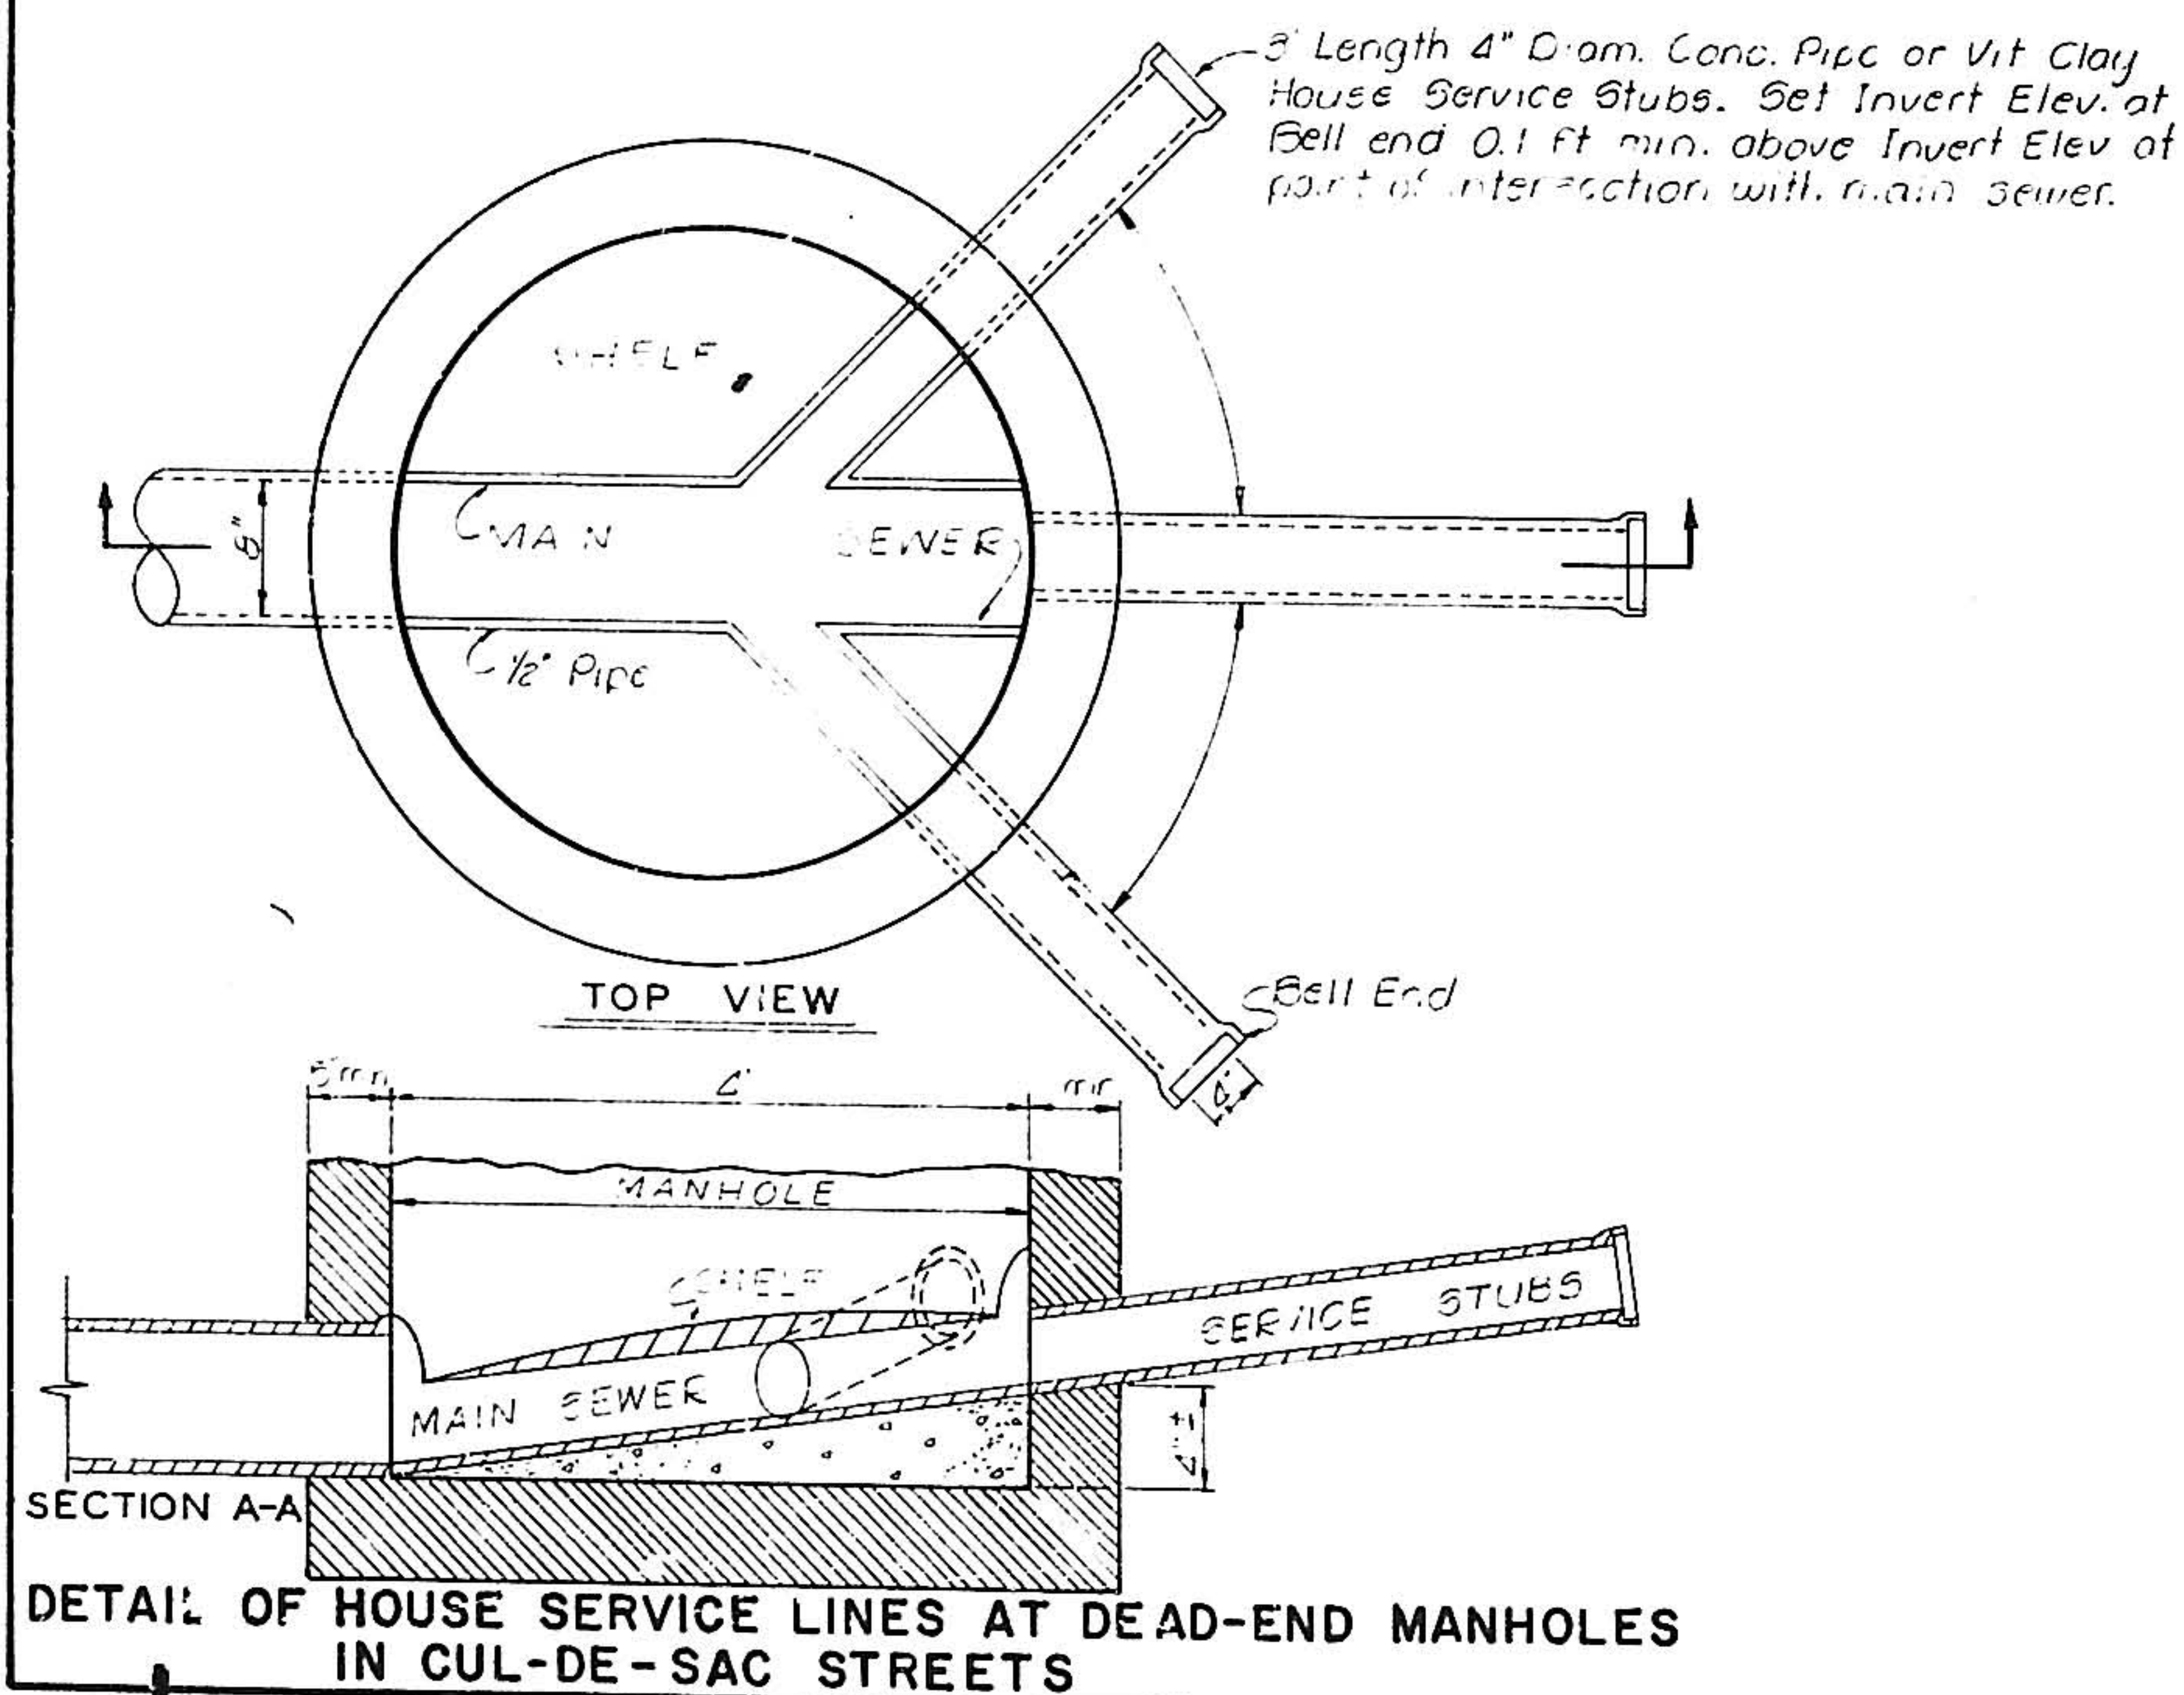


STANDARD MANHOLE FRAME AND COVER

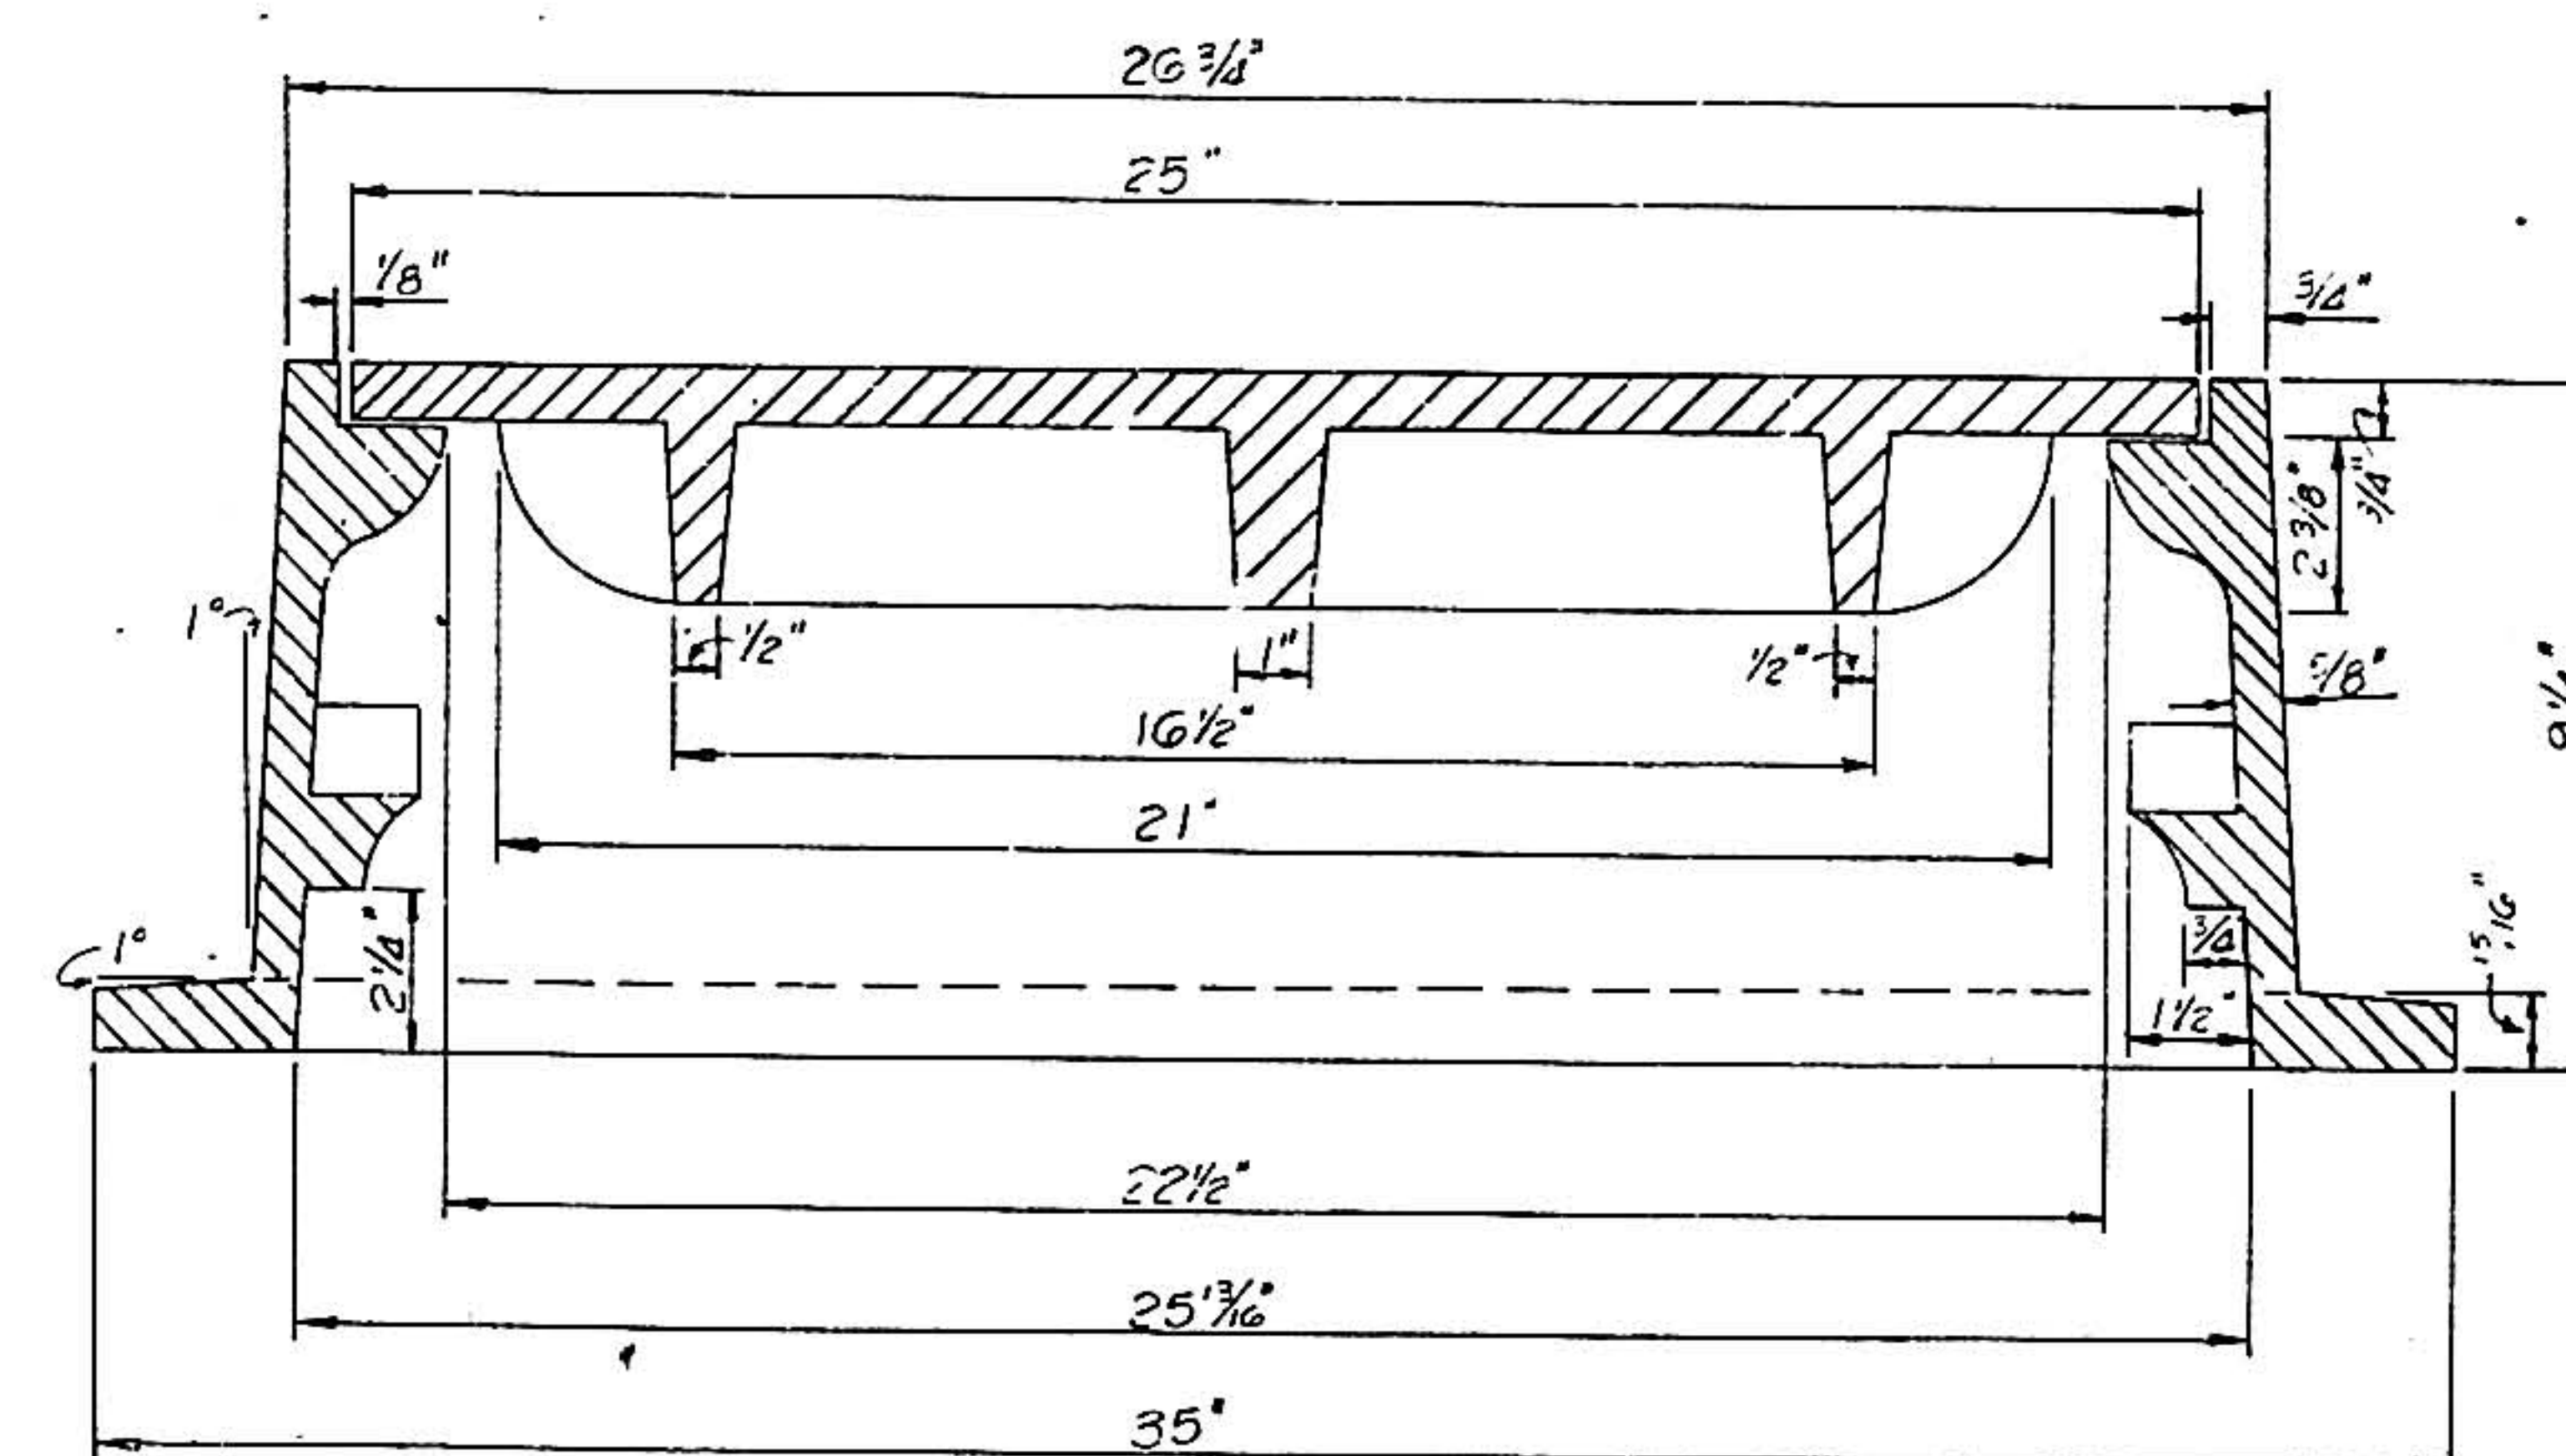

SECTION A-A

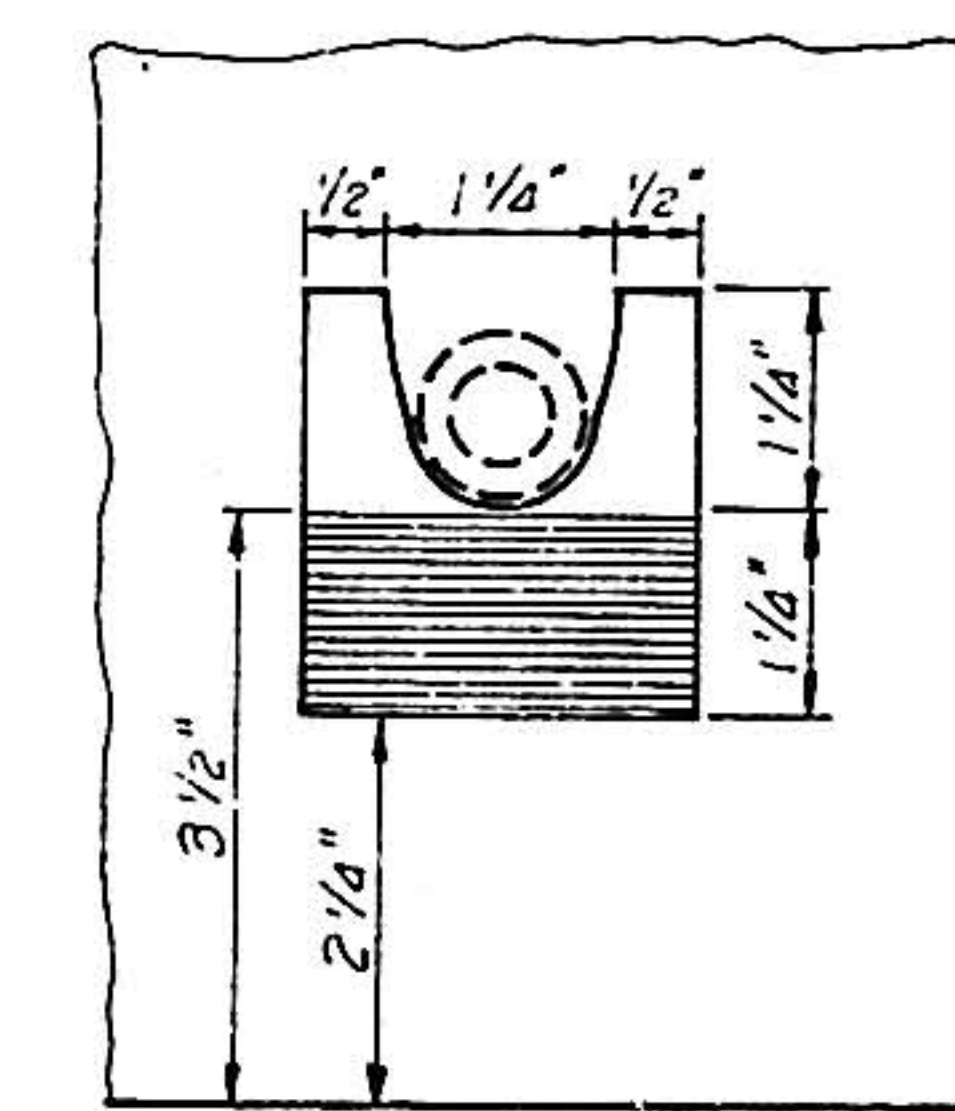

SECTION C-C


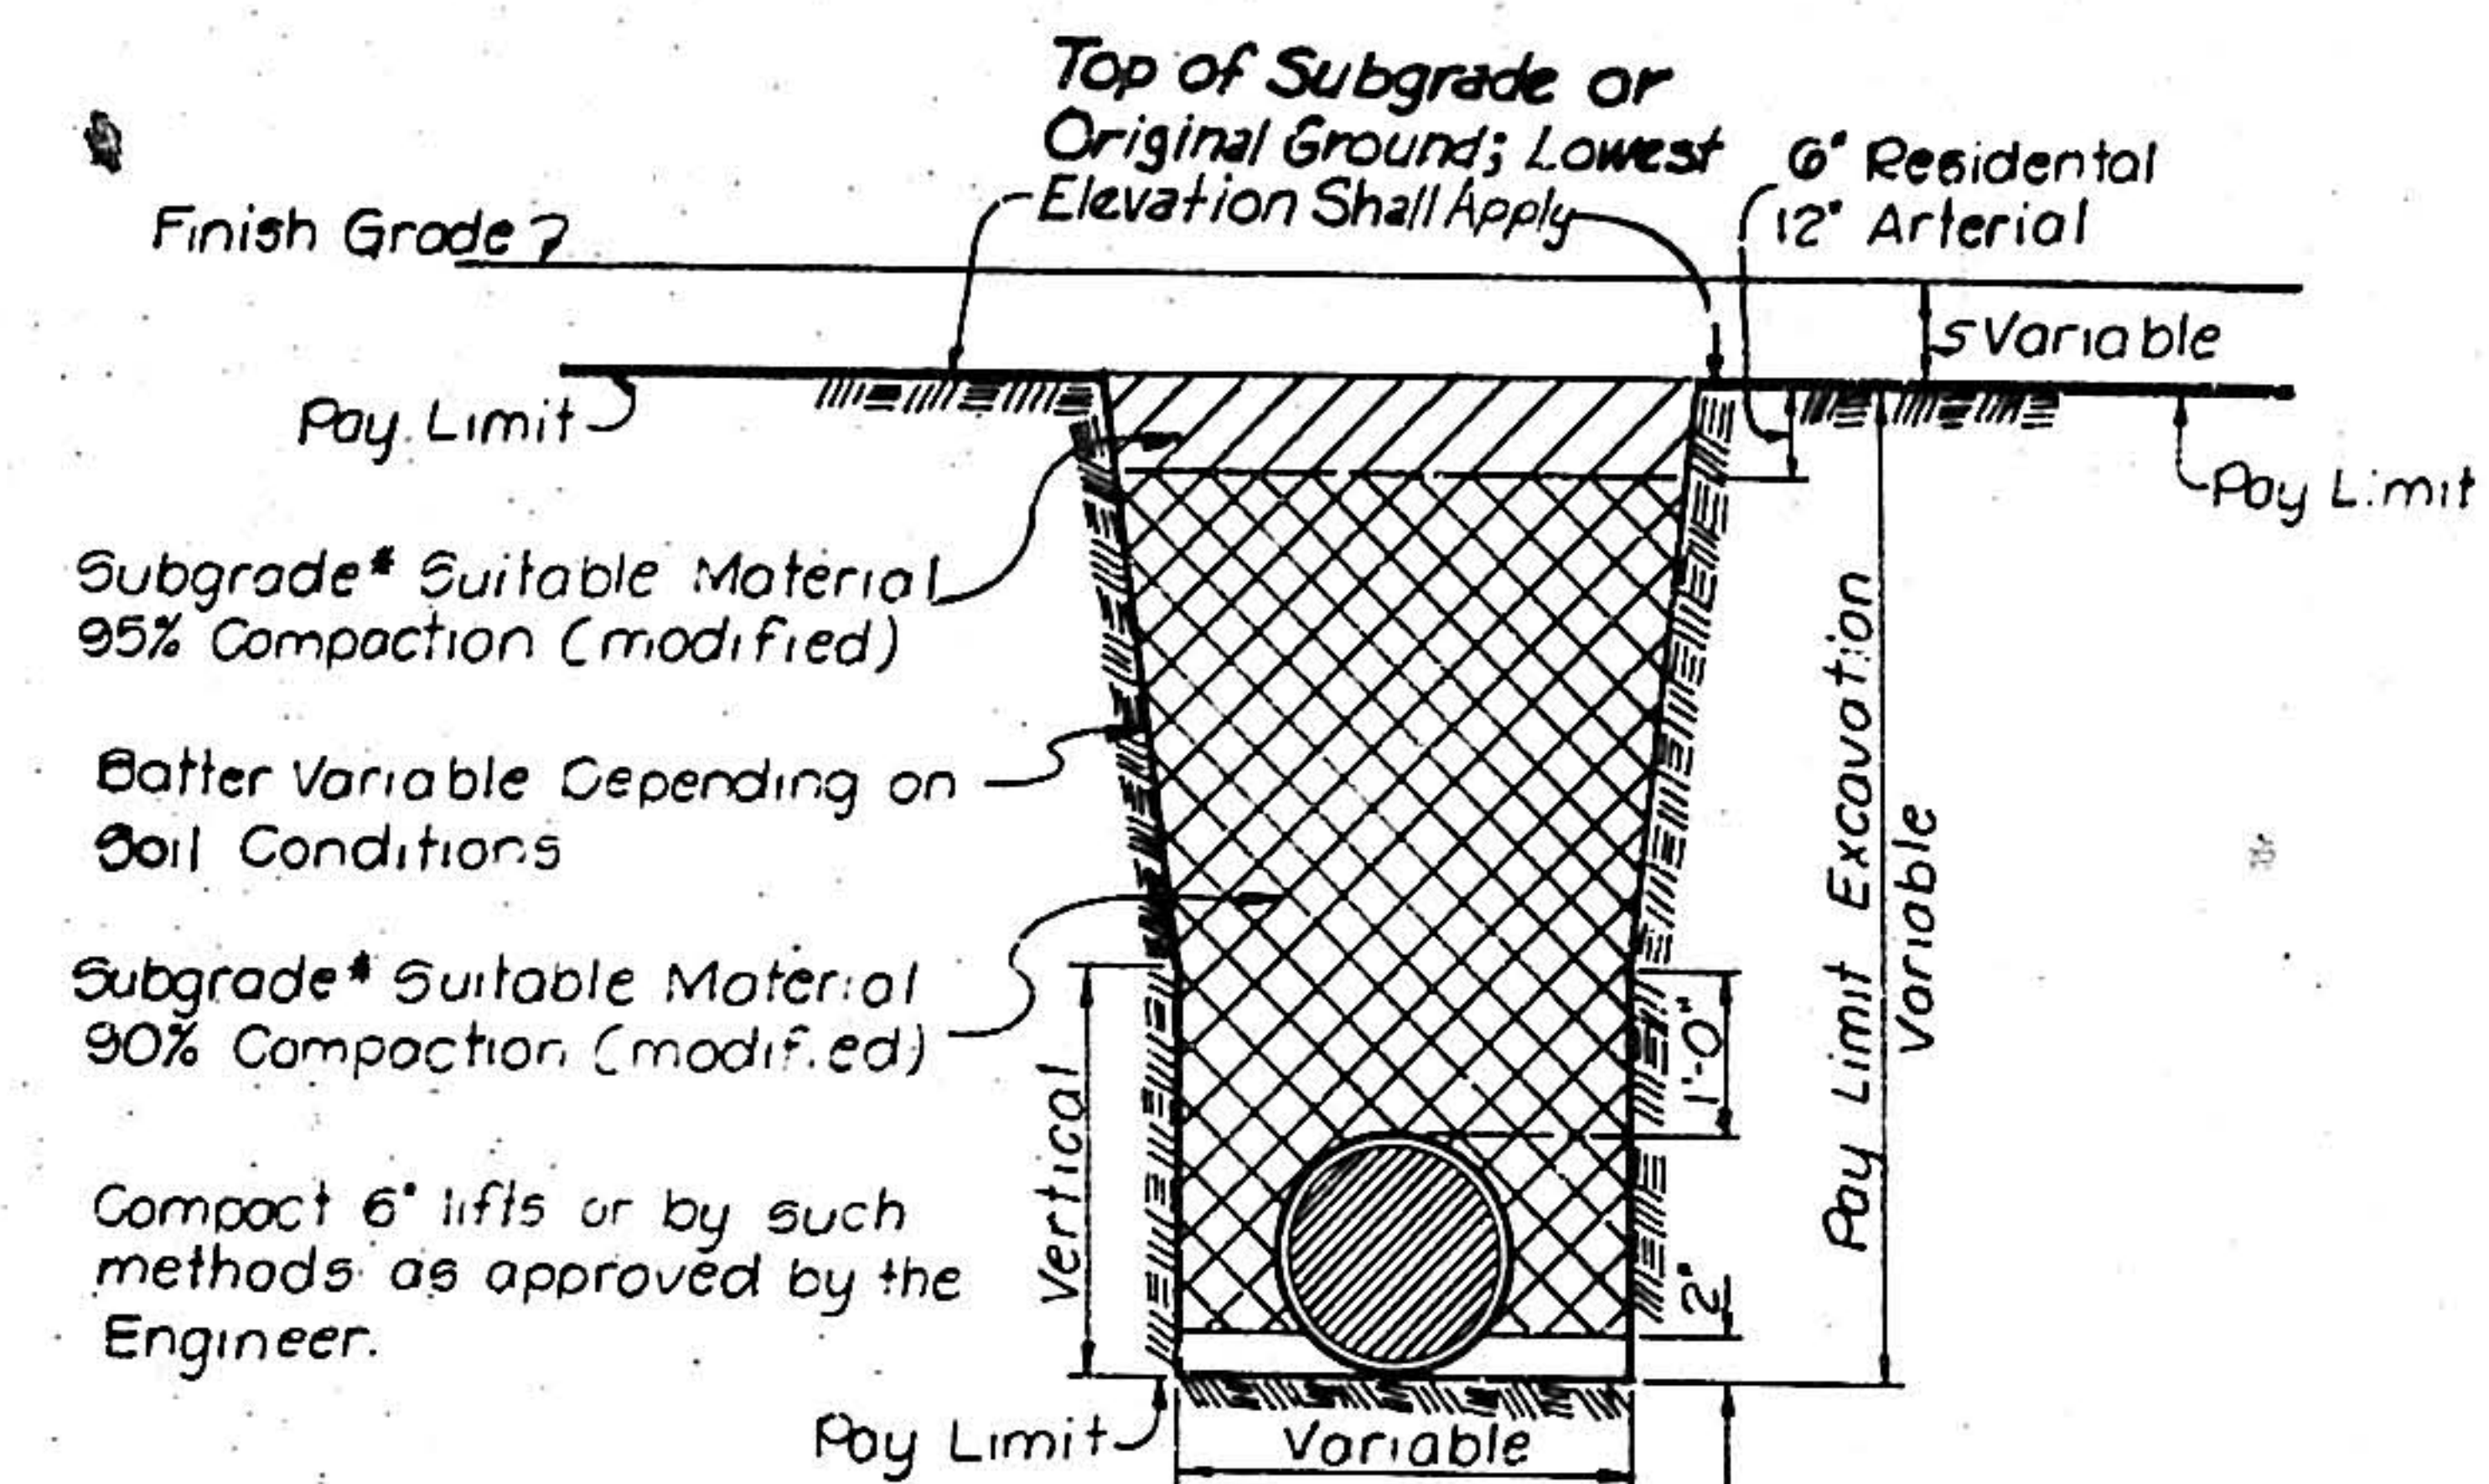


DETAIL OF TRENCH CUT AND BACKFILL WITHOUT ROCK

* NOTE: as determined by.

A.A.S.H.O. Deg. T-180-Proctor
A.A.S.H.O. Deg. T-147-Field Test

Moisture content of all compacted subgrade material in place shall be no greater than optimum nor any less than optimum minus 5%.

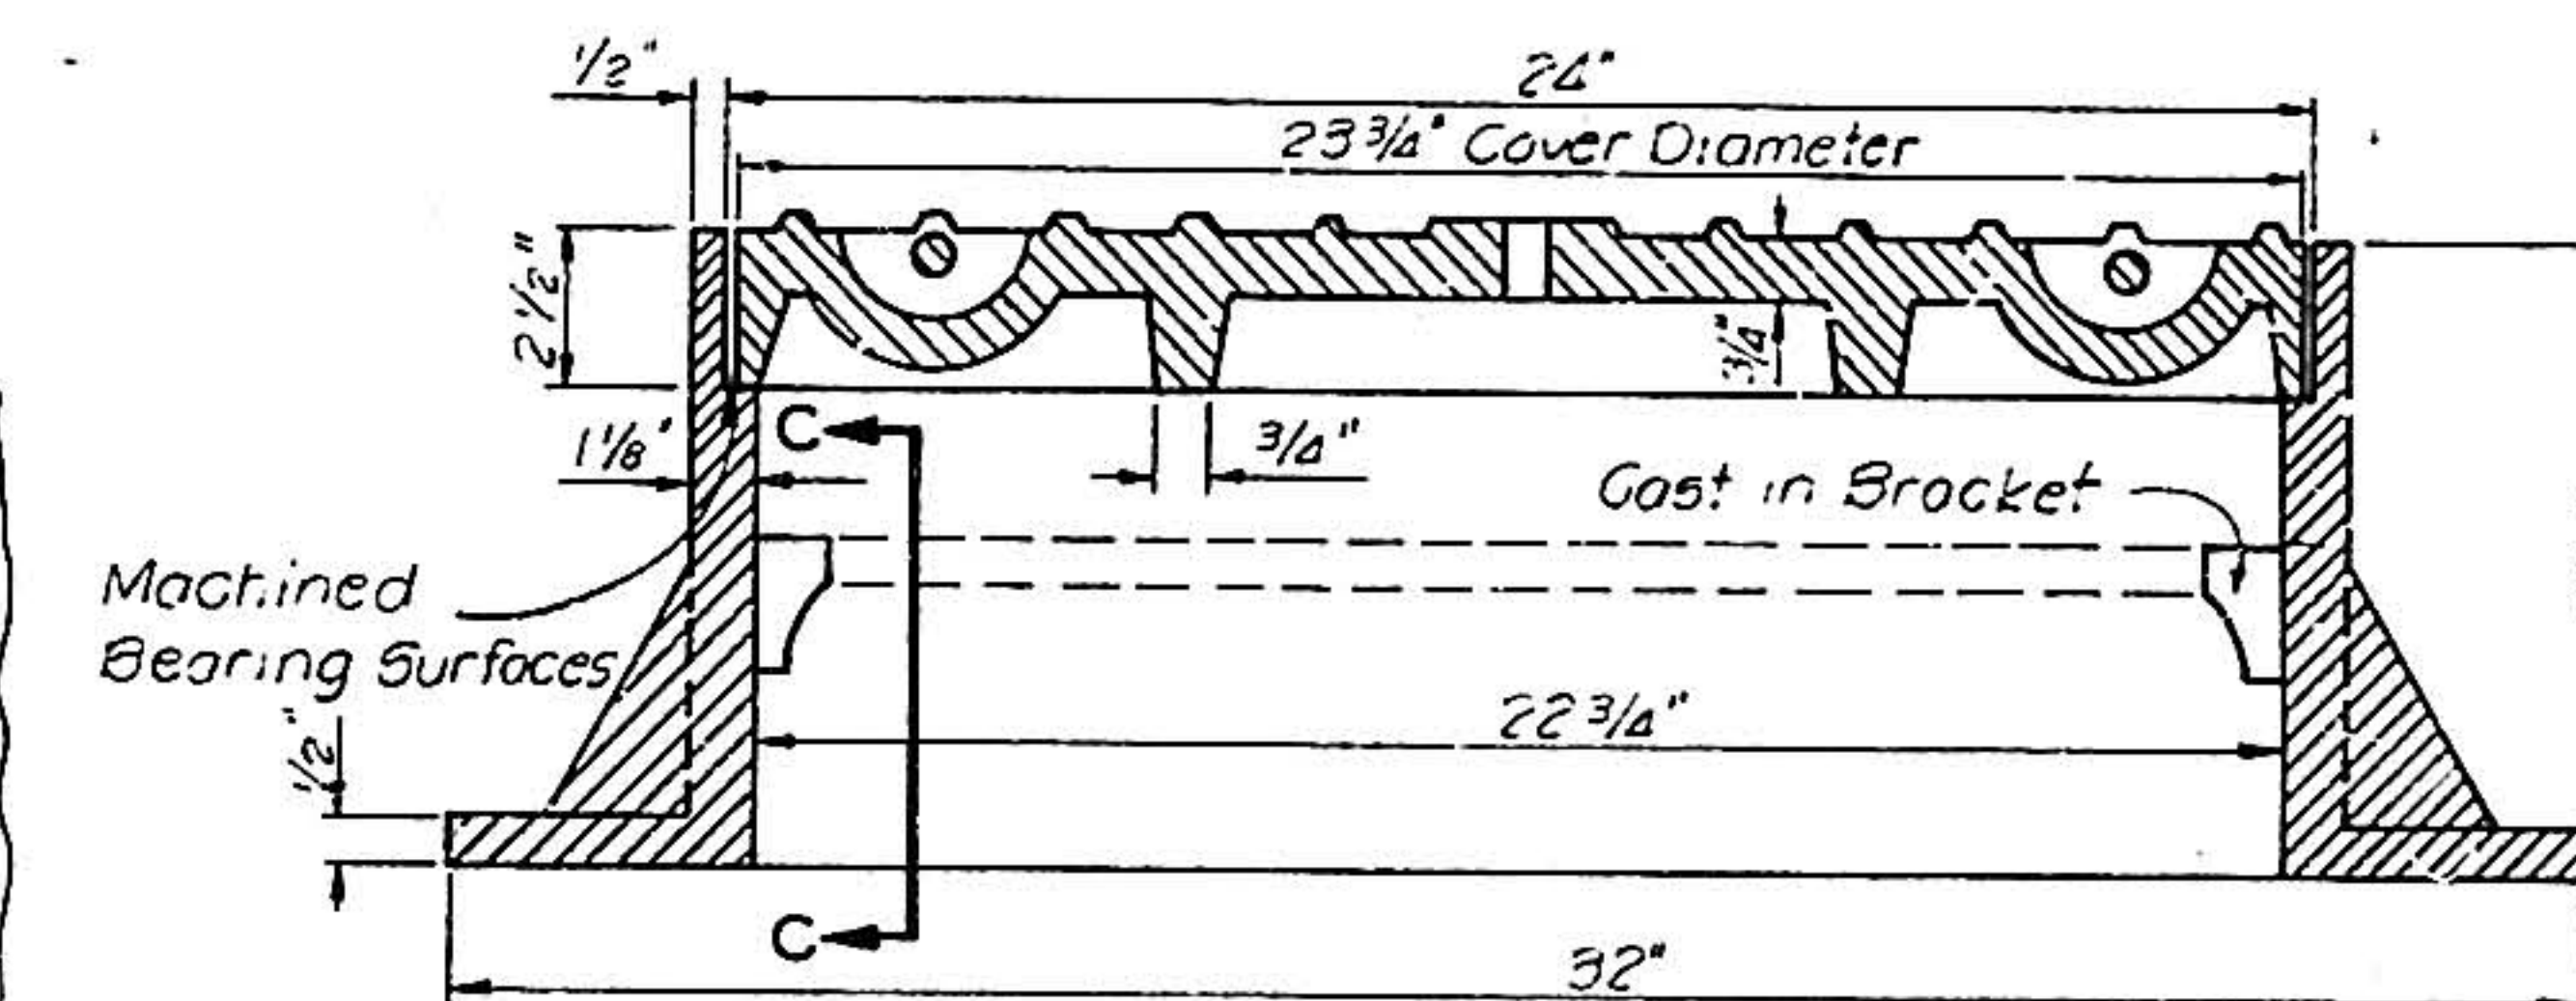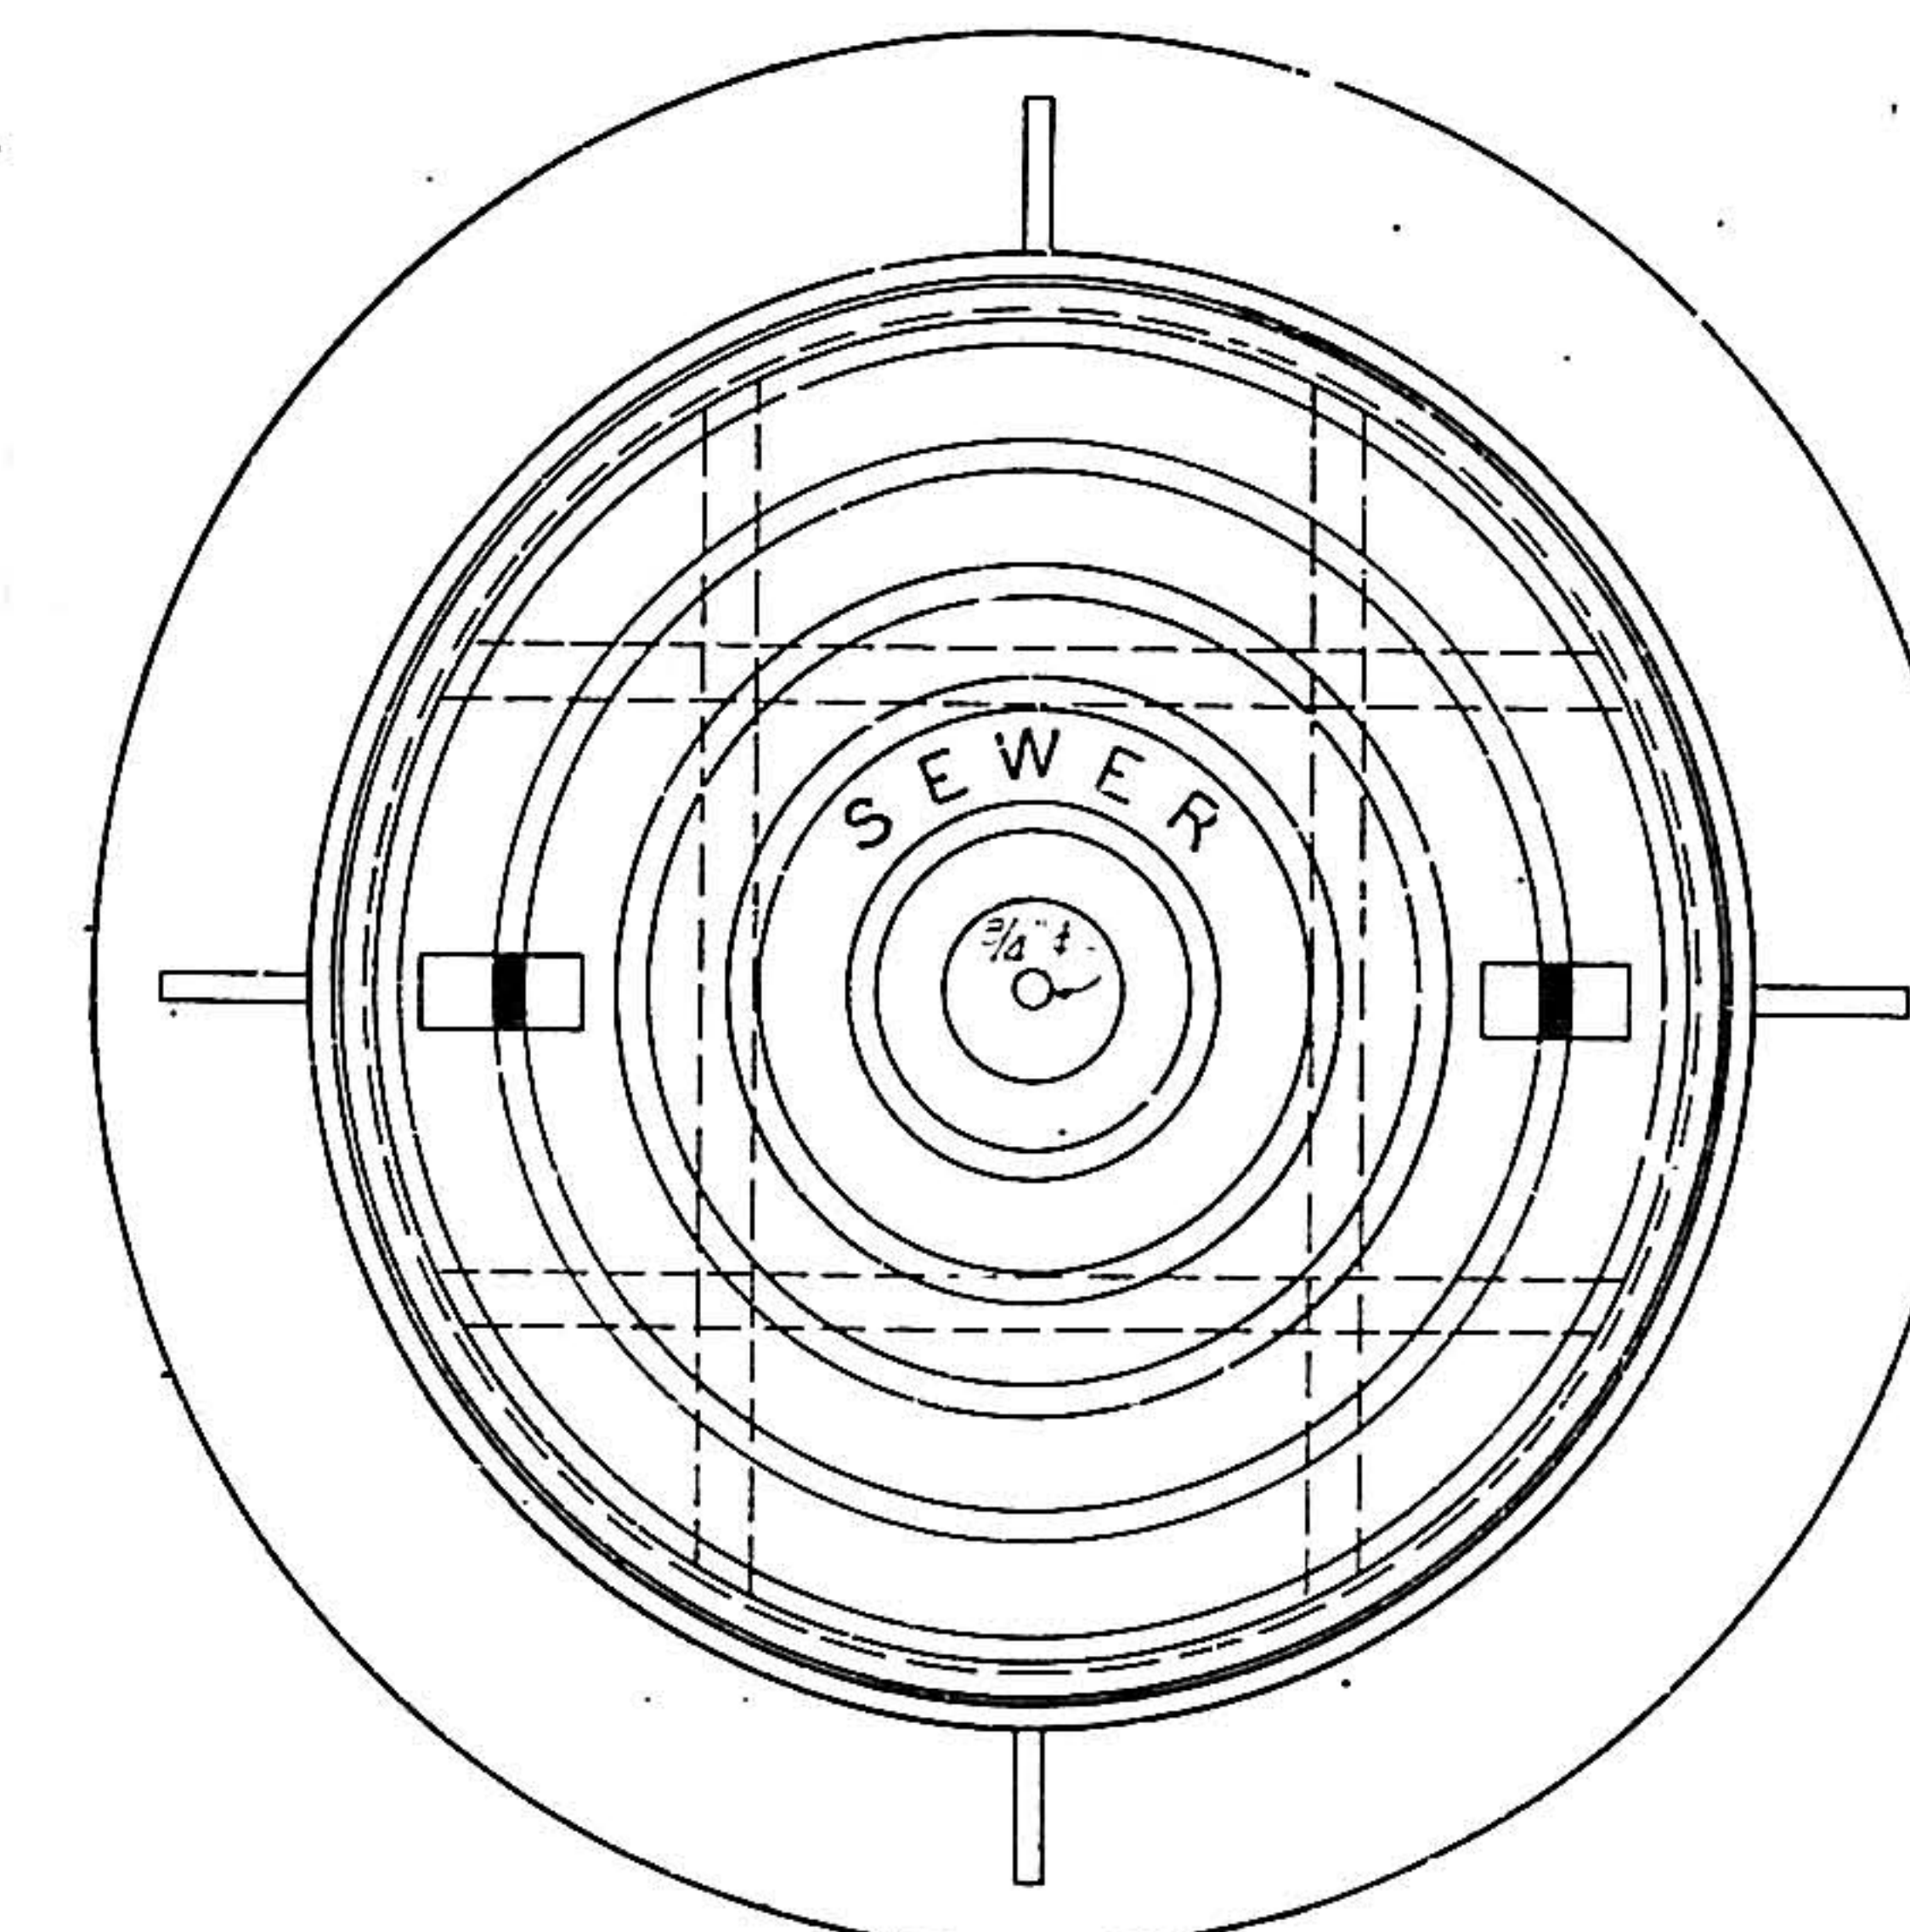

ALTERNATE FRAME AND COVER

ALBUQUERQUE, NEW MEXICO
SPECIAL ASSESMENT DISTRICT NO.173

STANDARD DETAILS













D. F. MOLZEN & ASSOCIATES
Consulting Engineers

ALBUQUERQUE NEW MEXICO

Drawn _____ Checked _____ Sheet _____
File _____ Date _____ 67 of _____

1 2 3 4 5 6 7 8 9 10 11 12 13 14 15 16 17 18 19 20 21 22 23 24 25 26 27 28 29

07 173 6770 1010

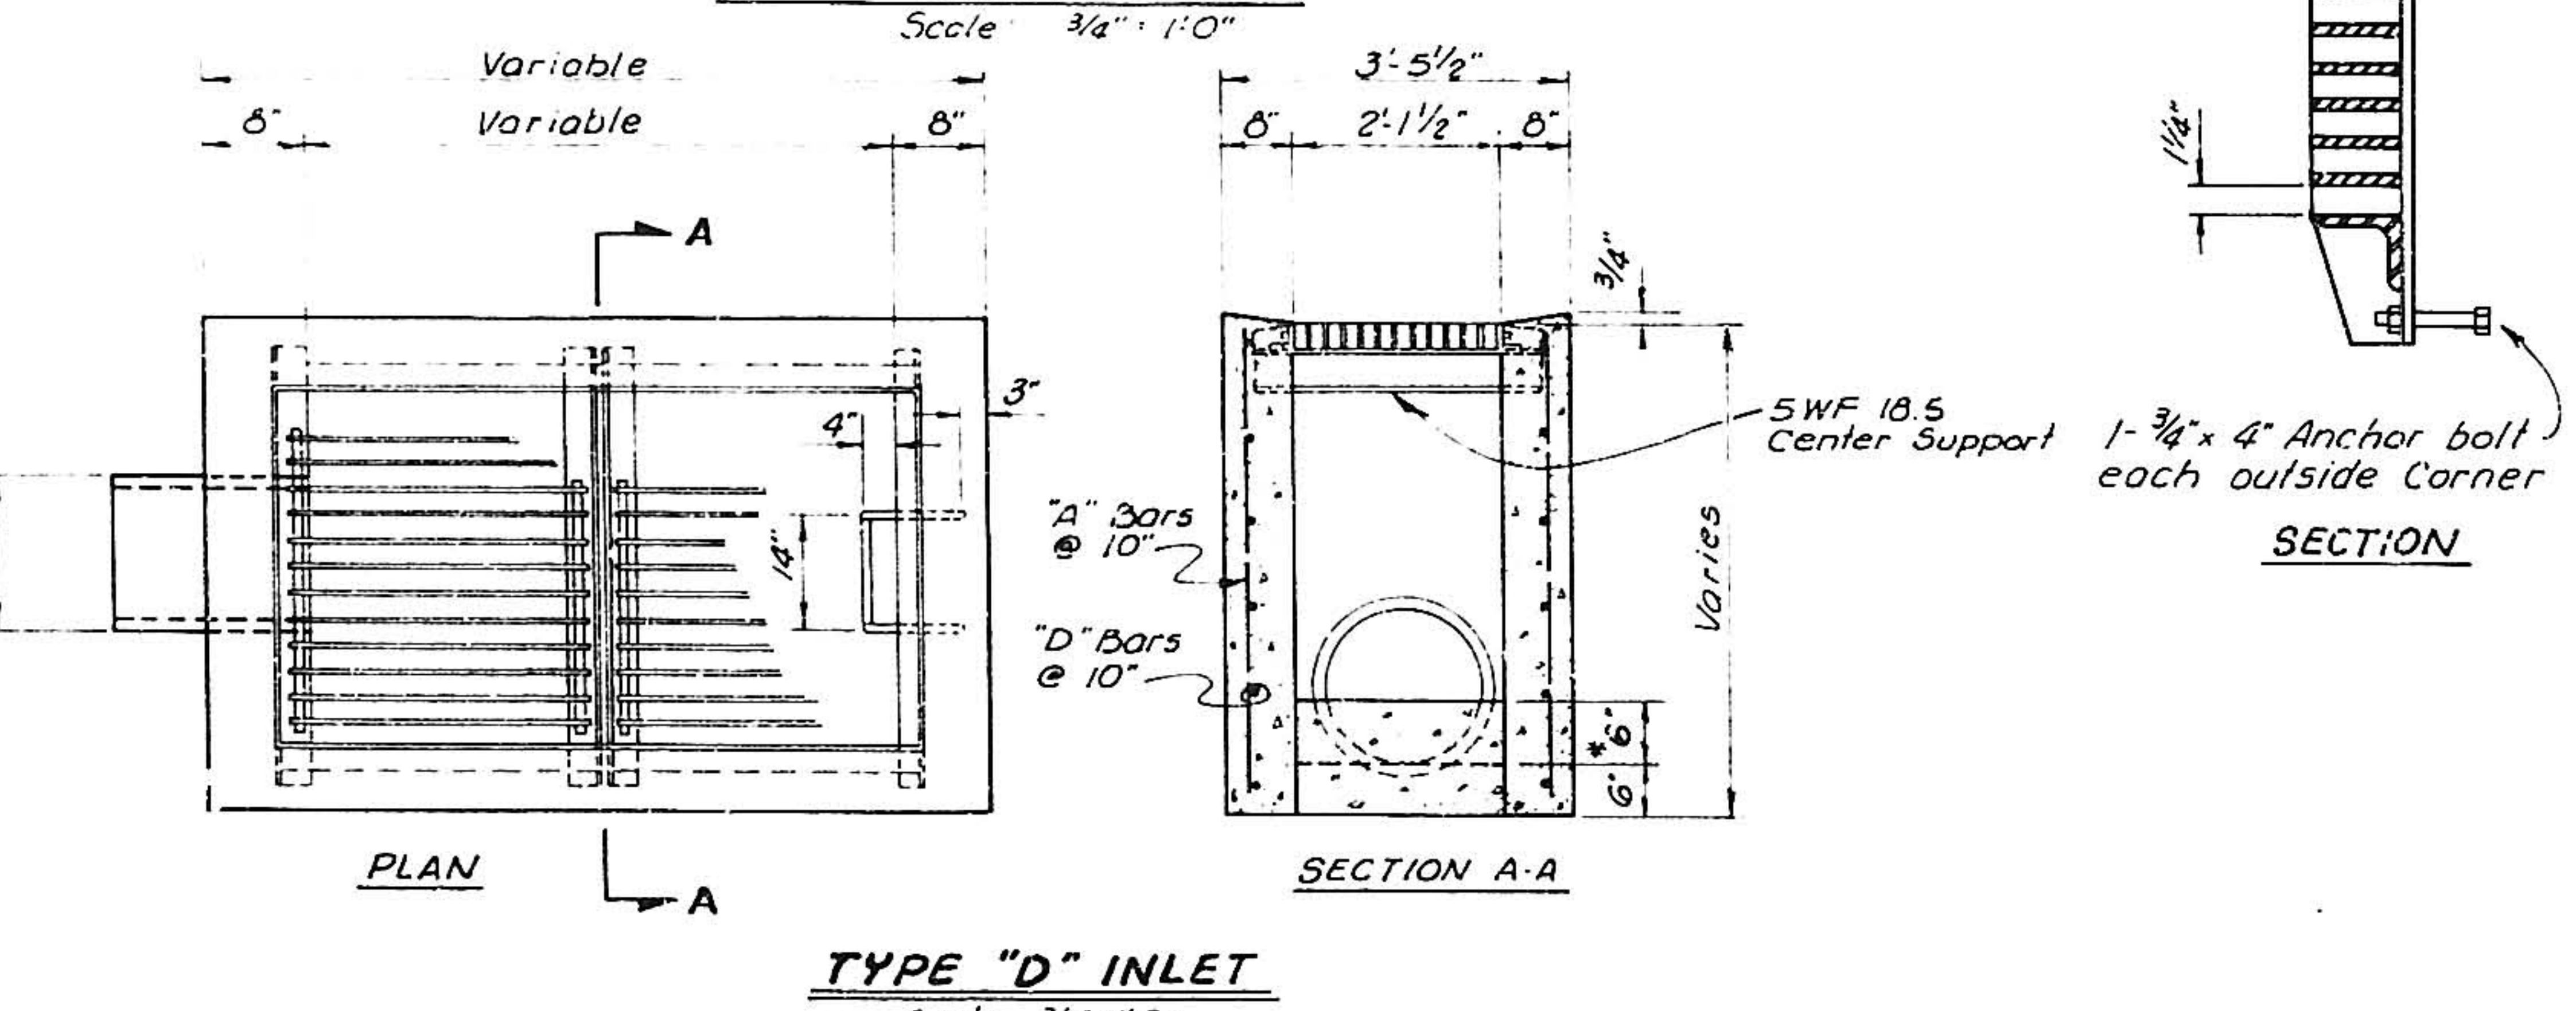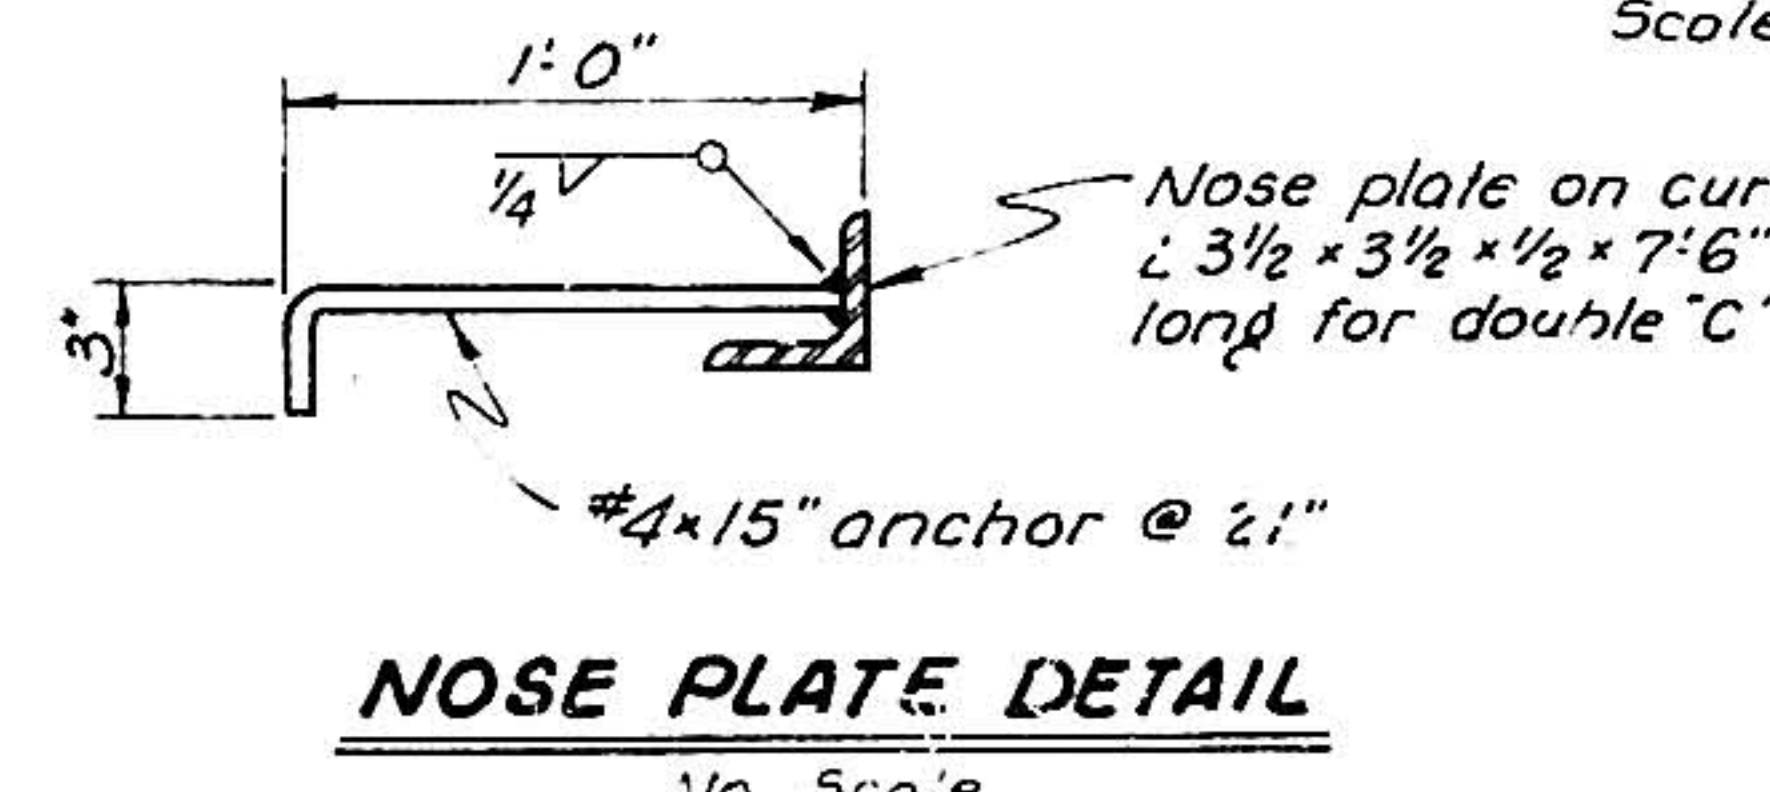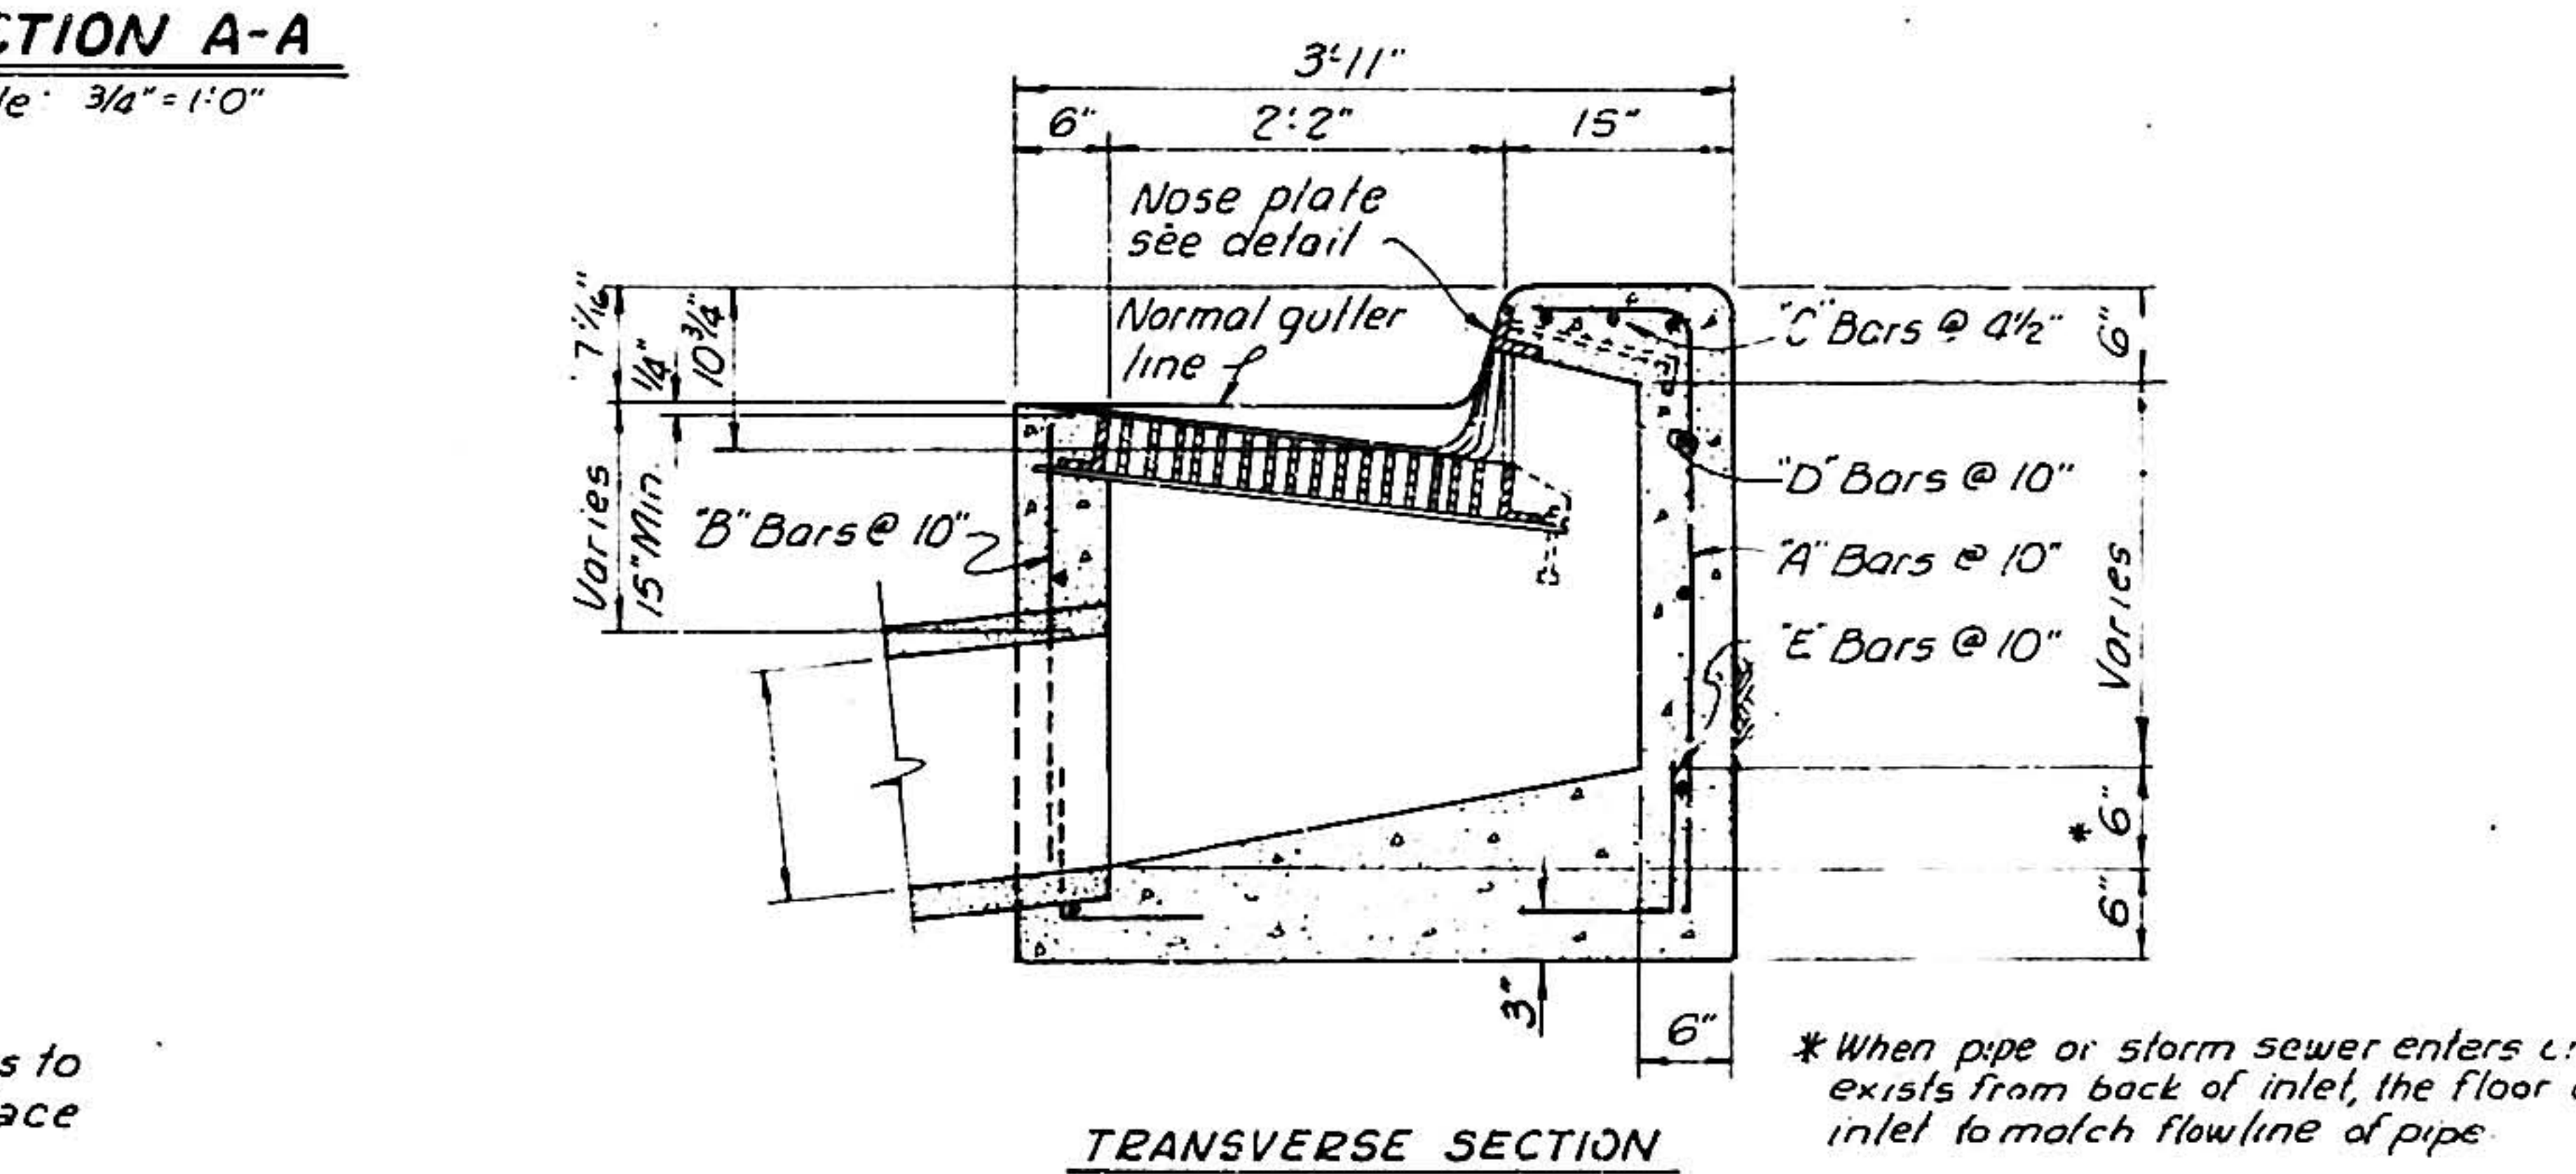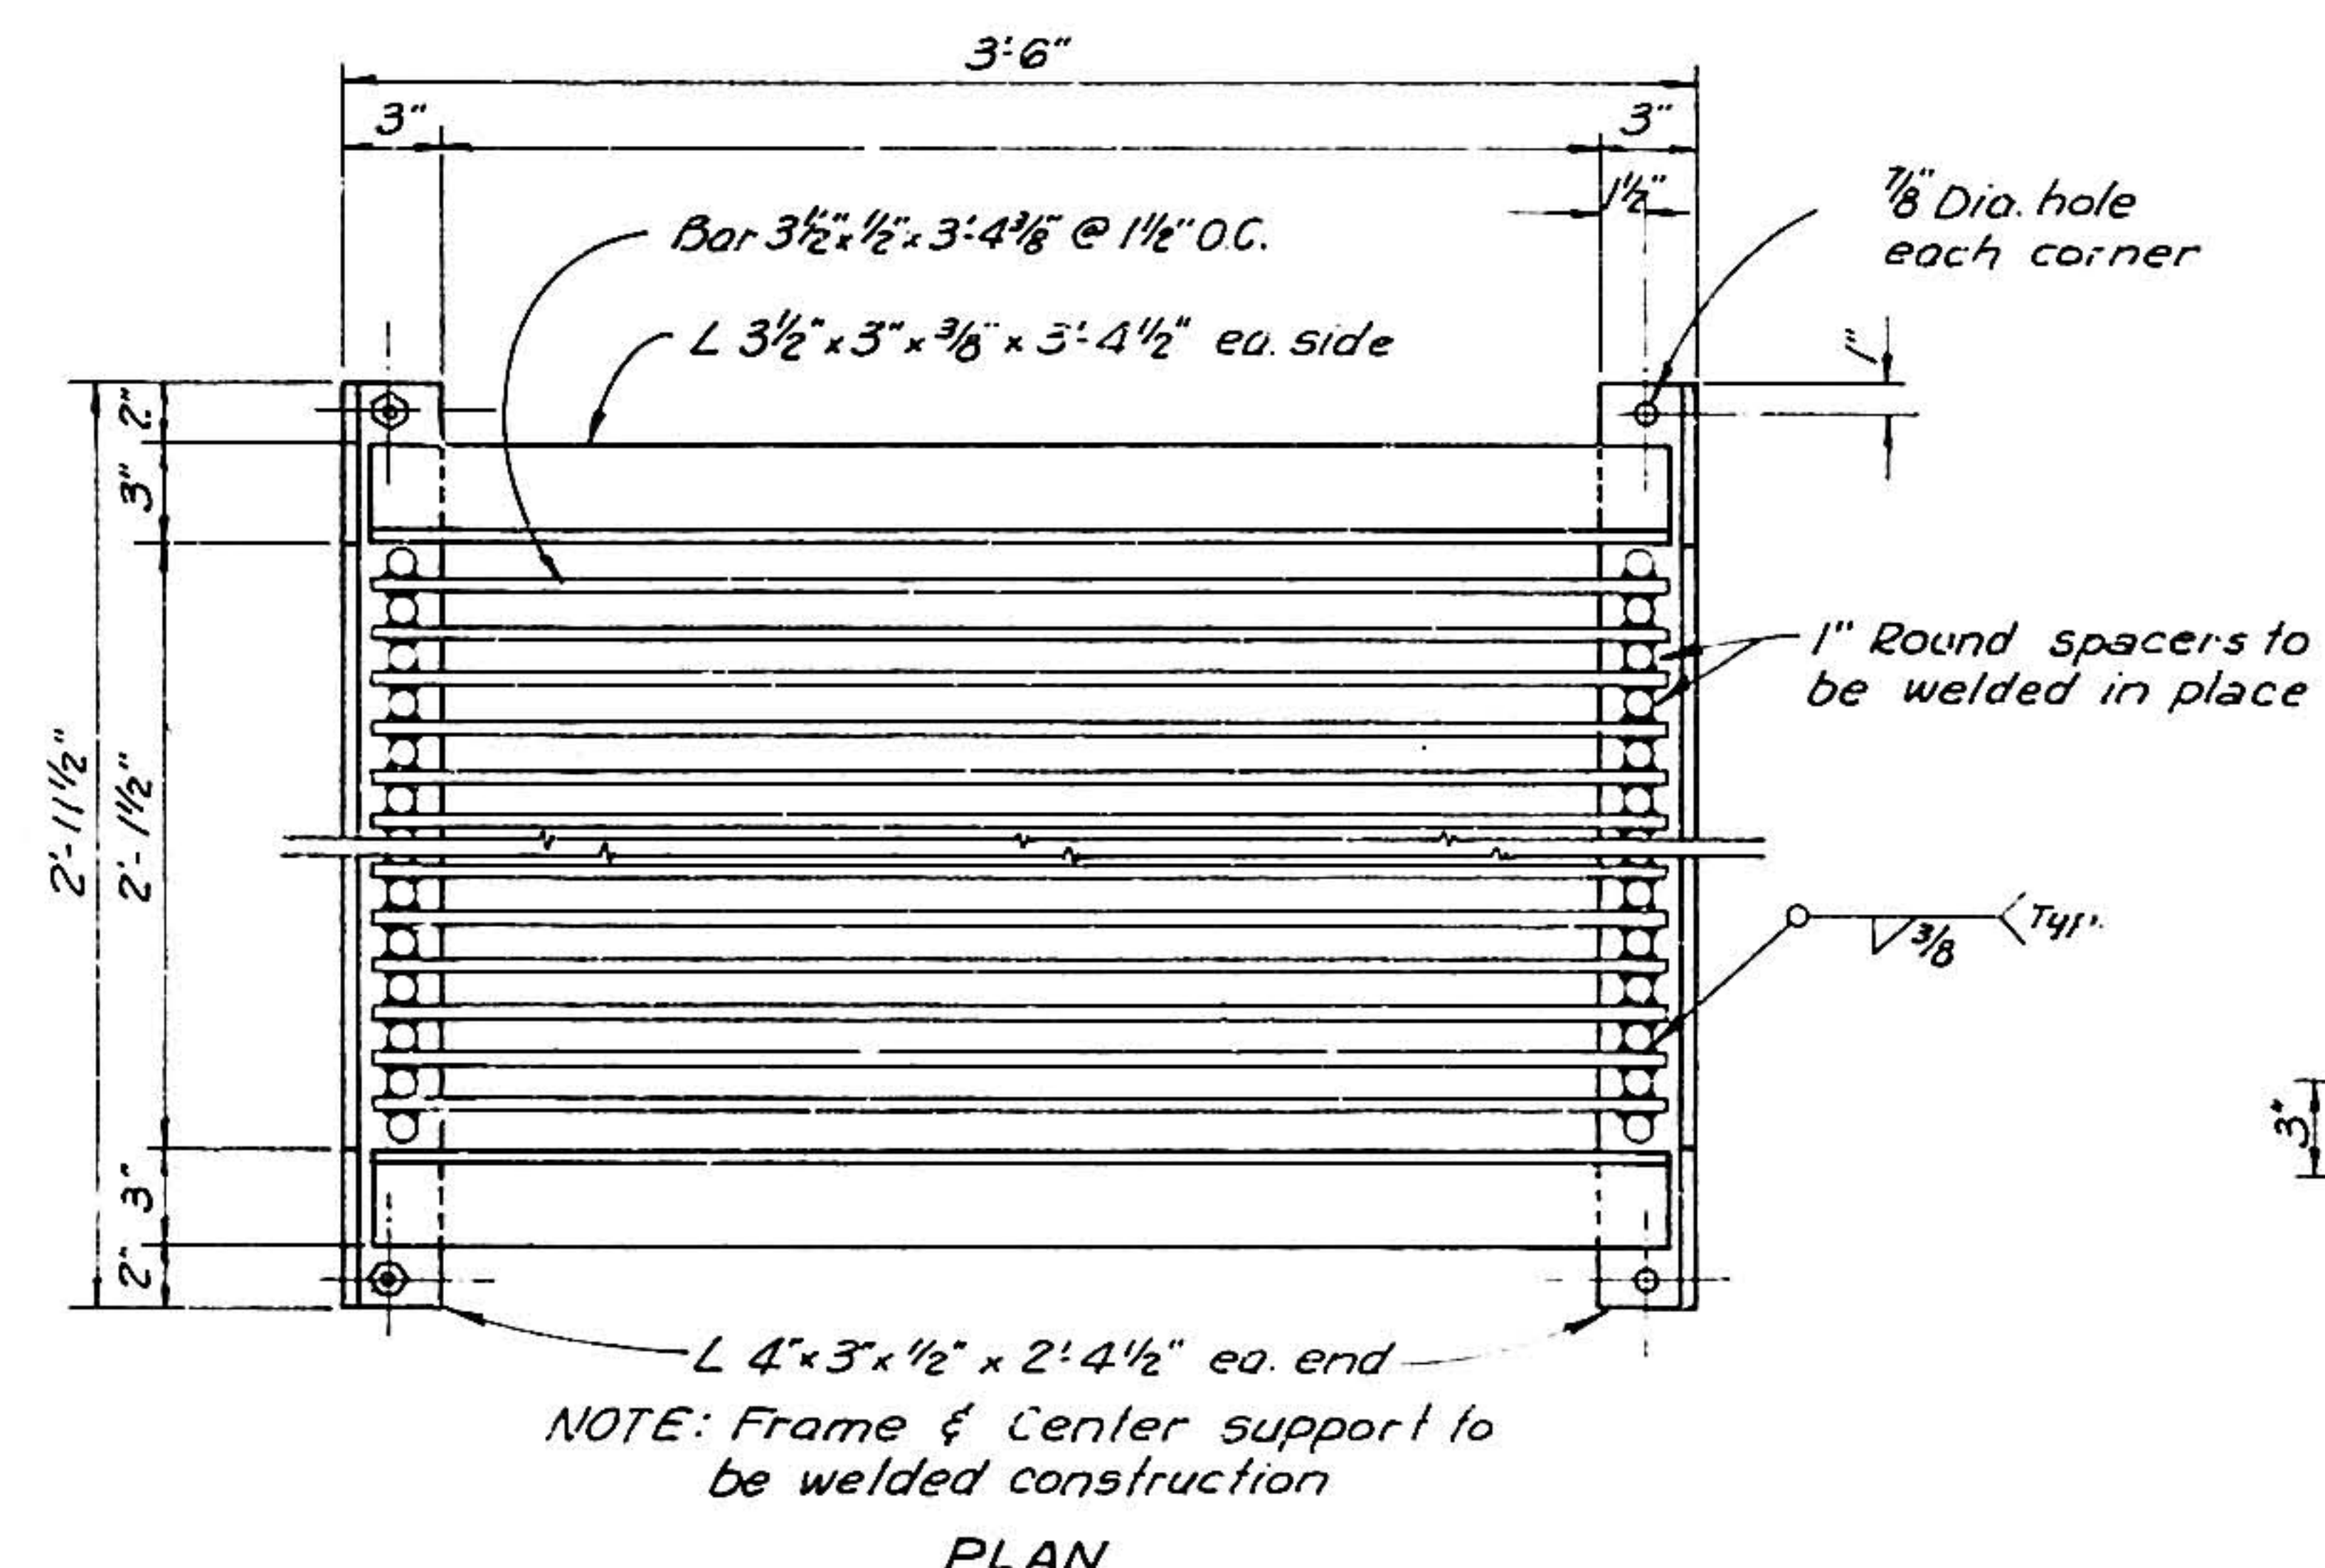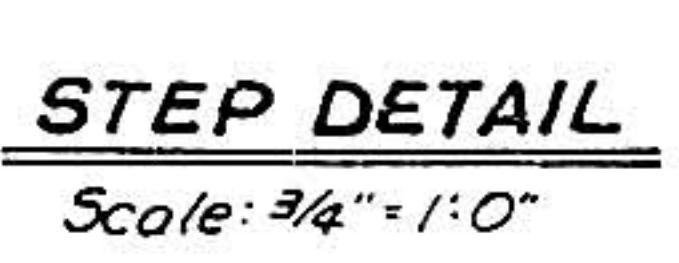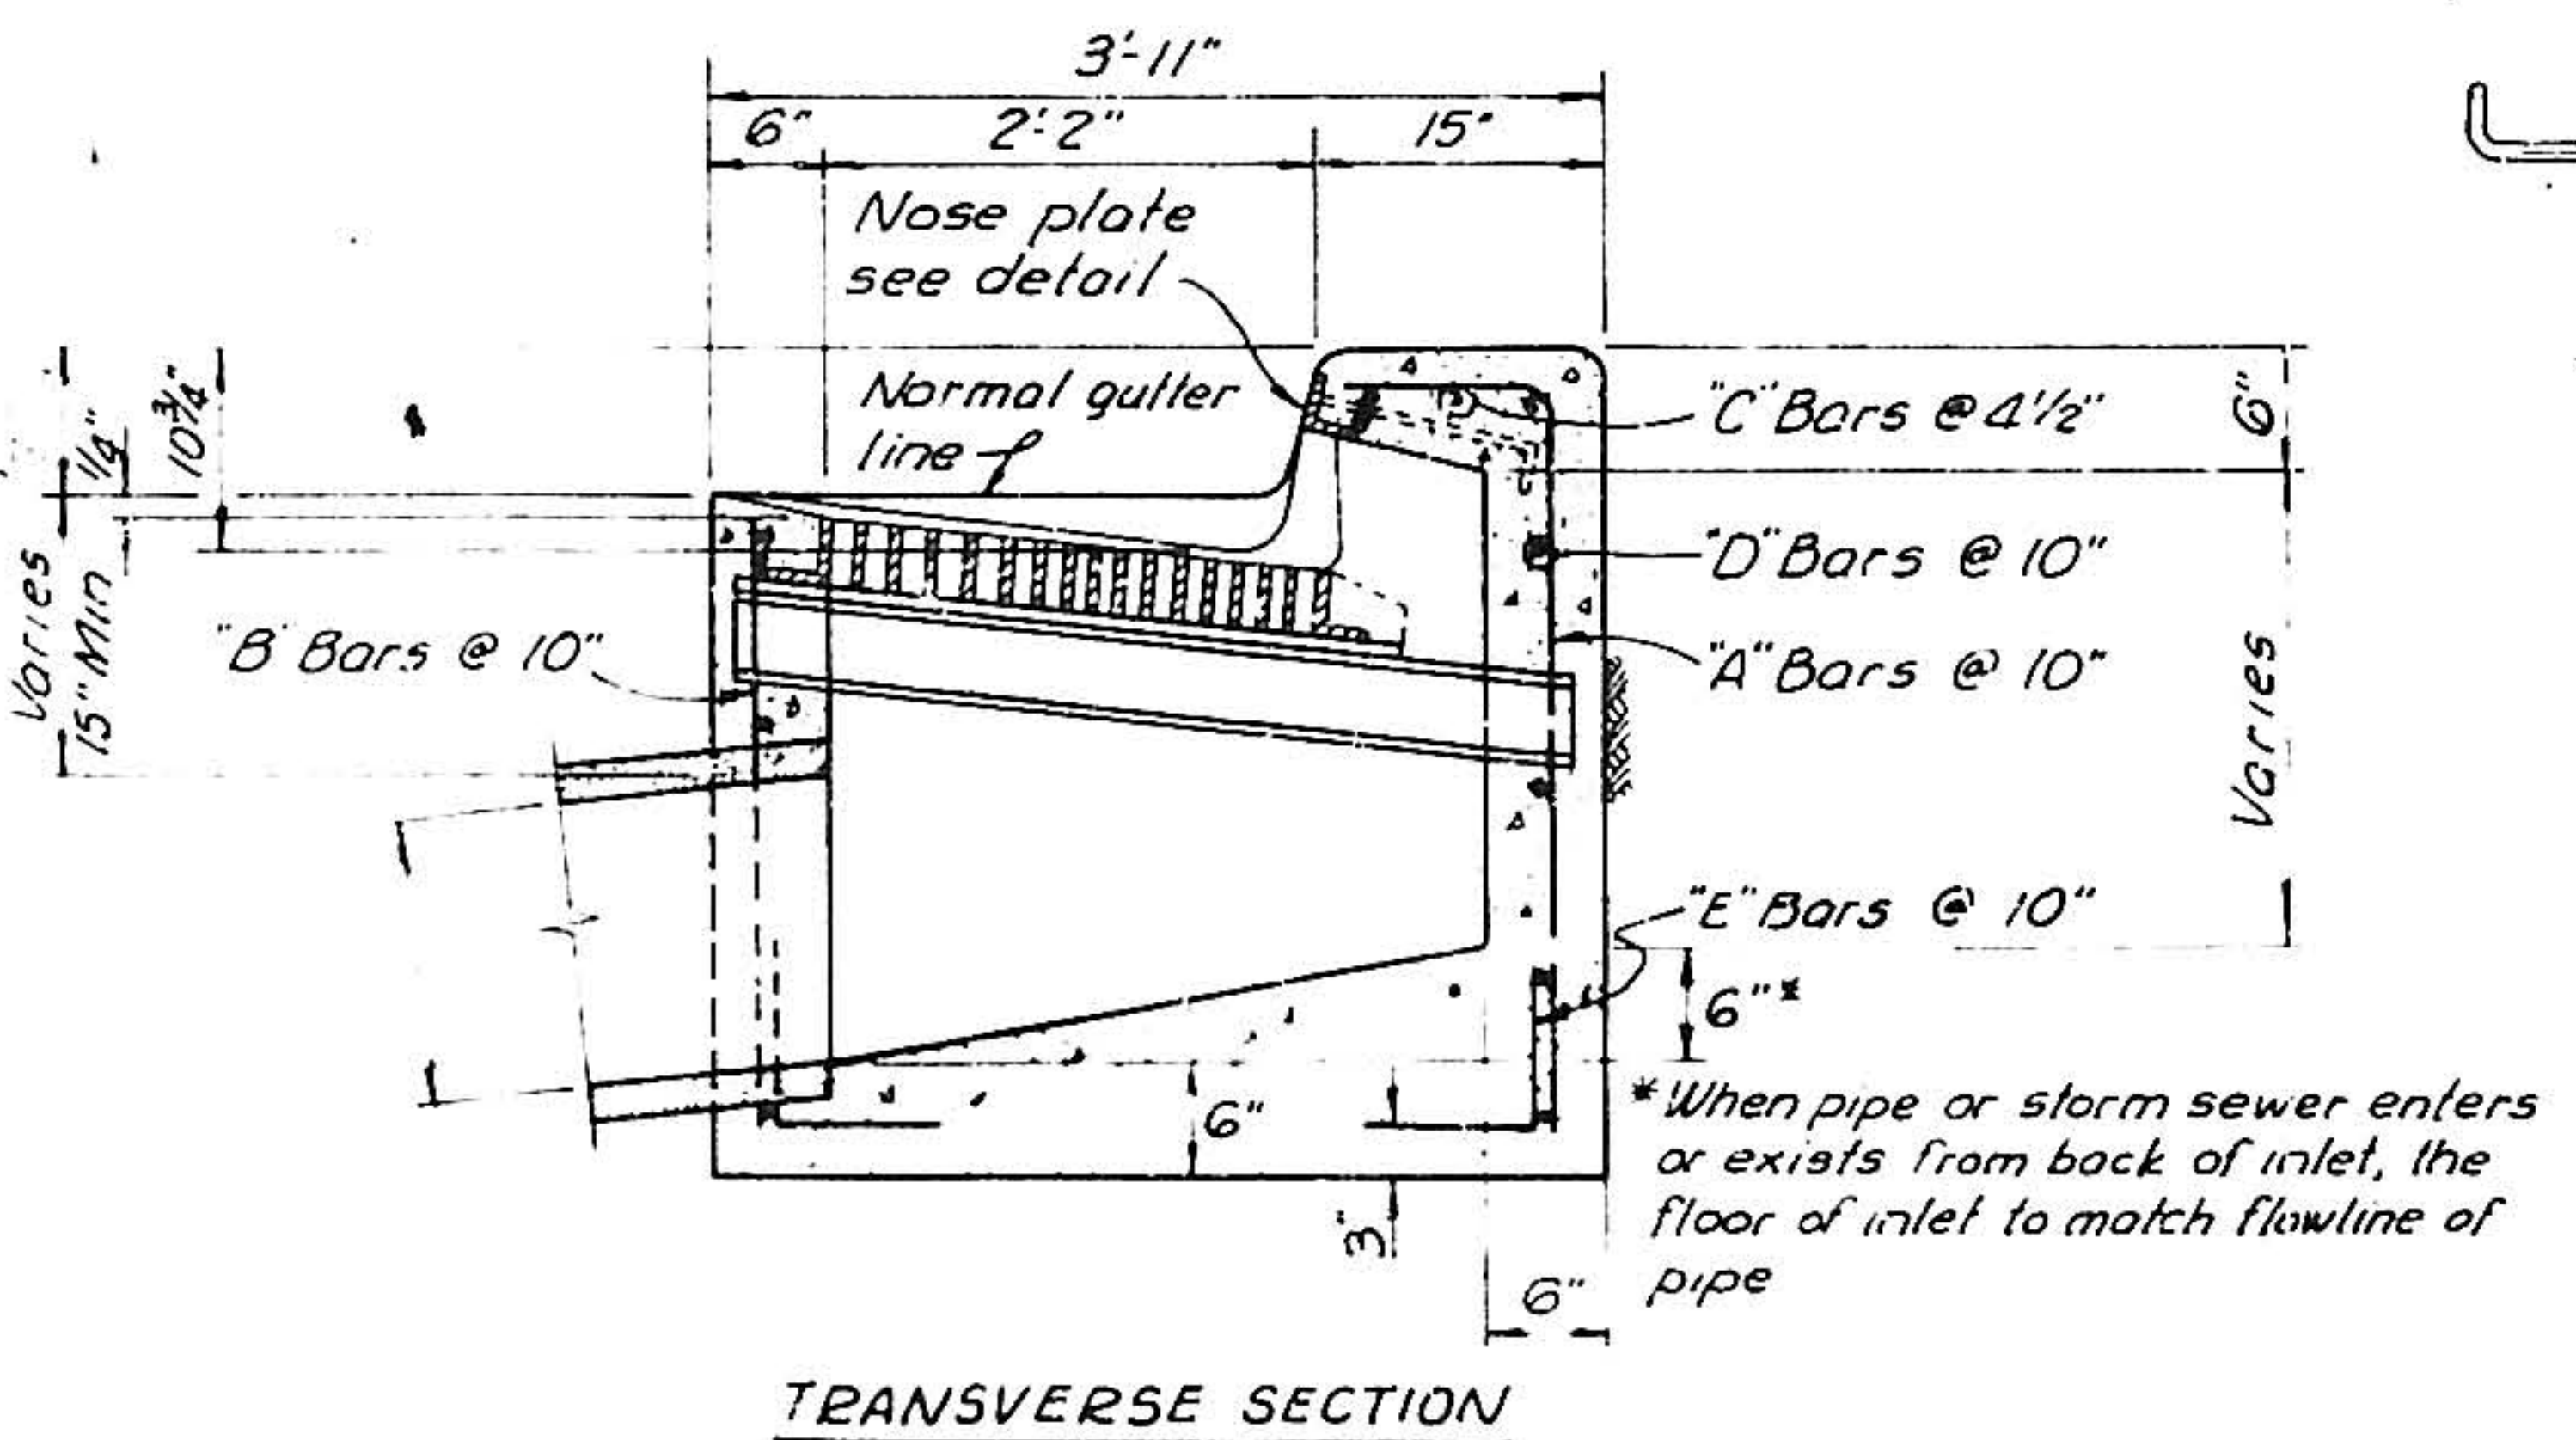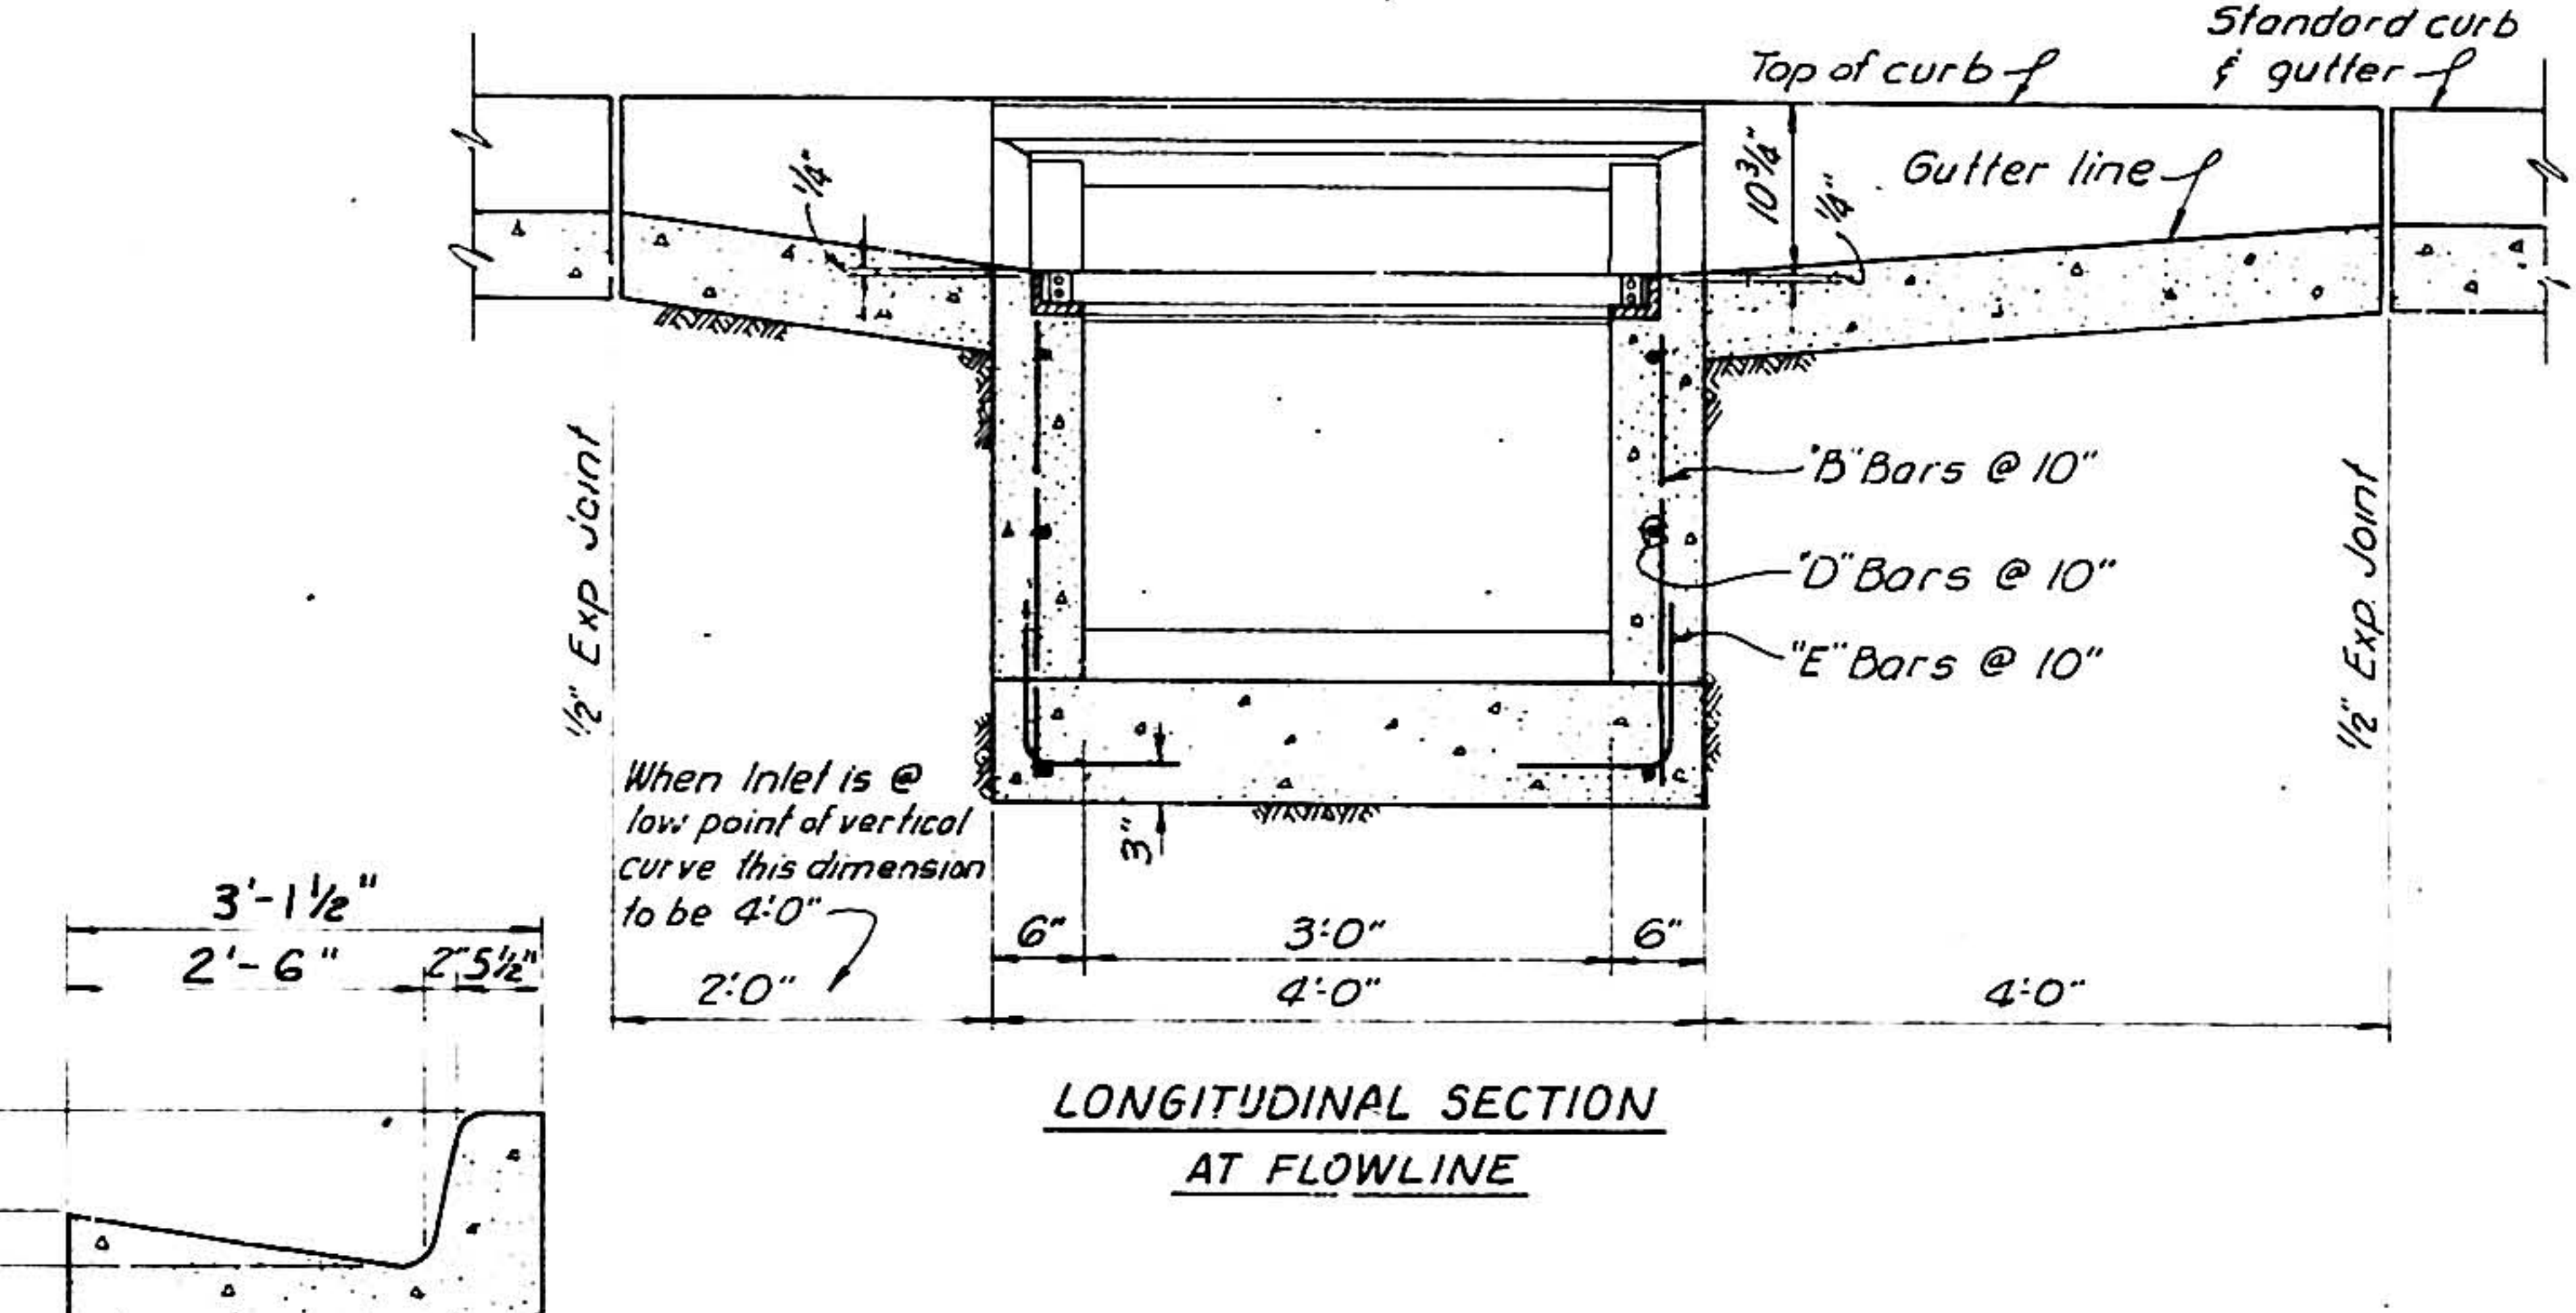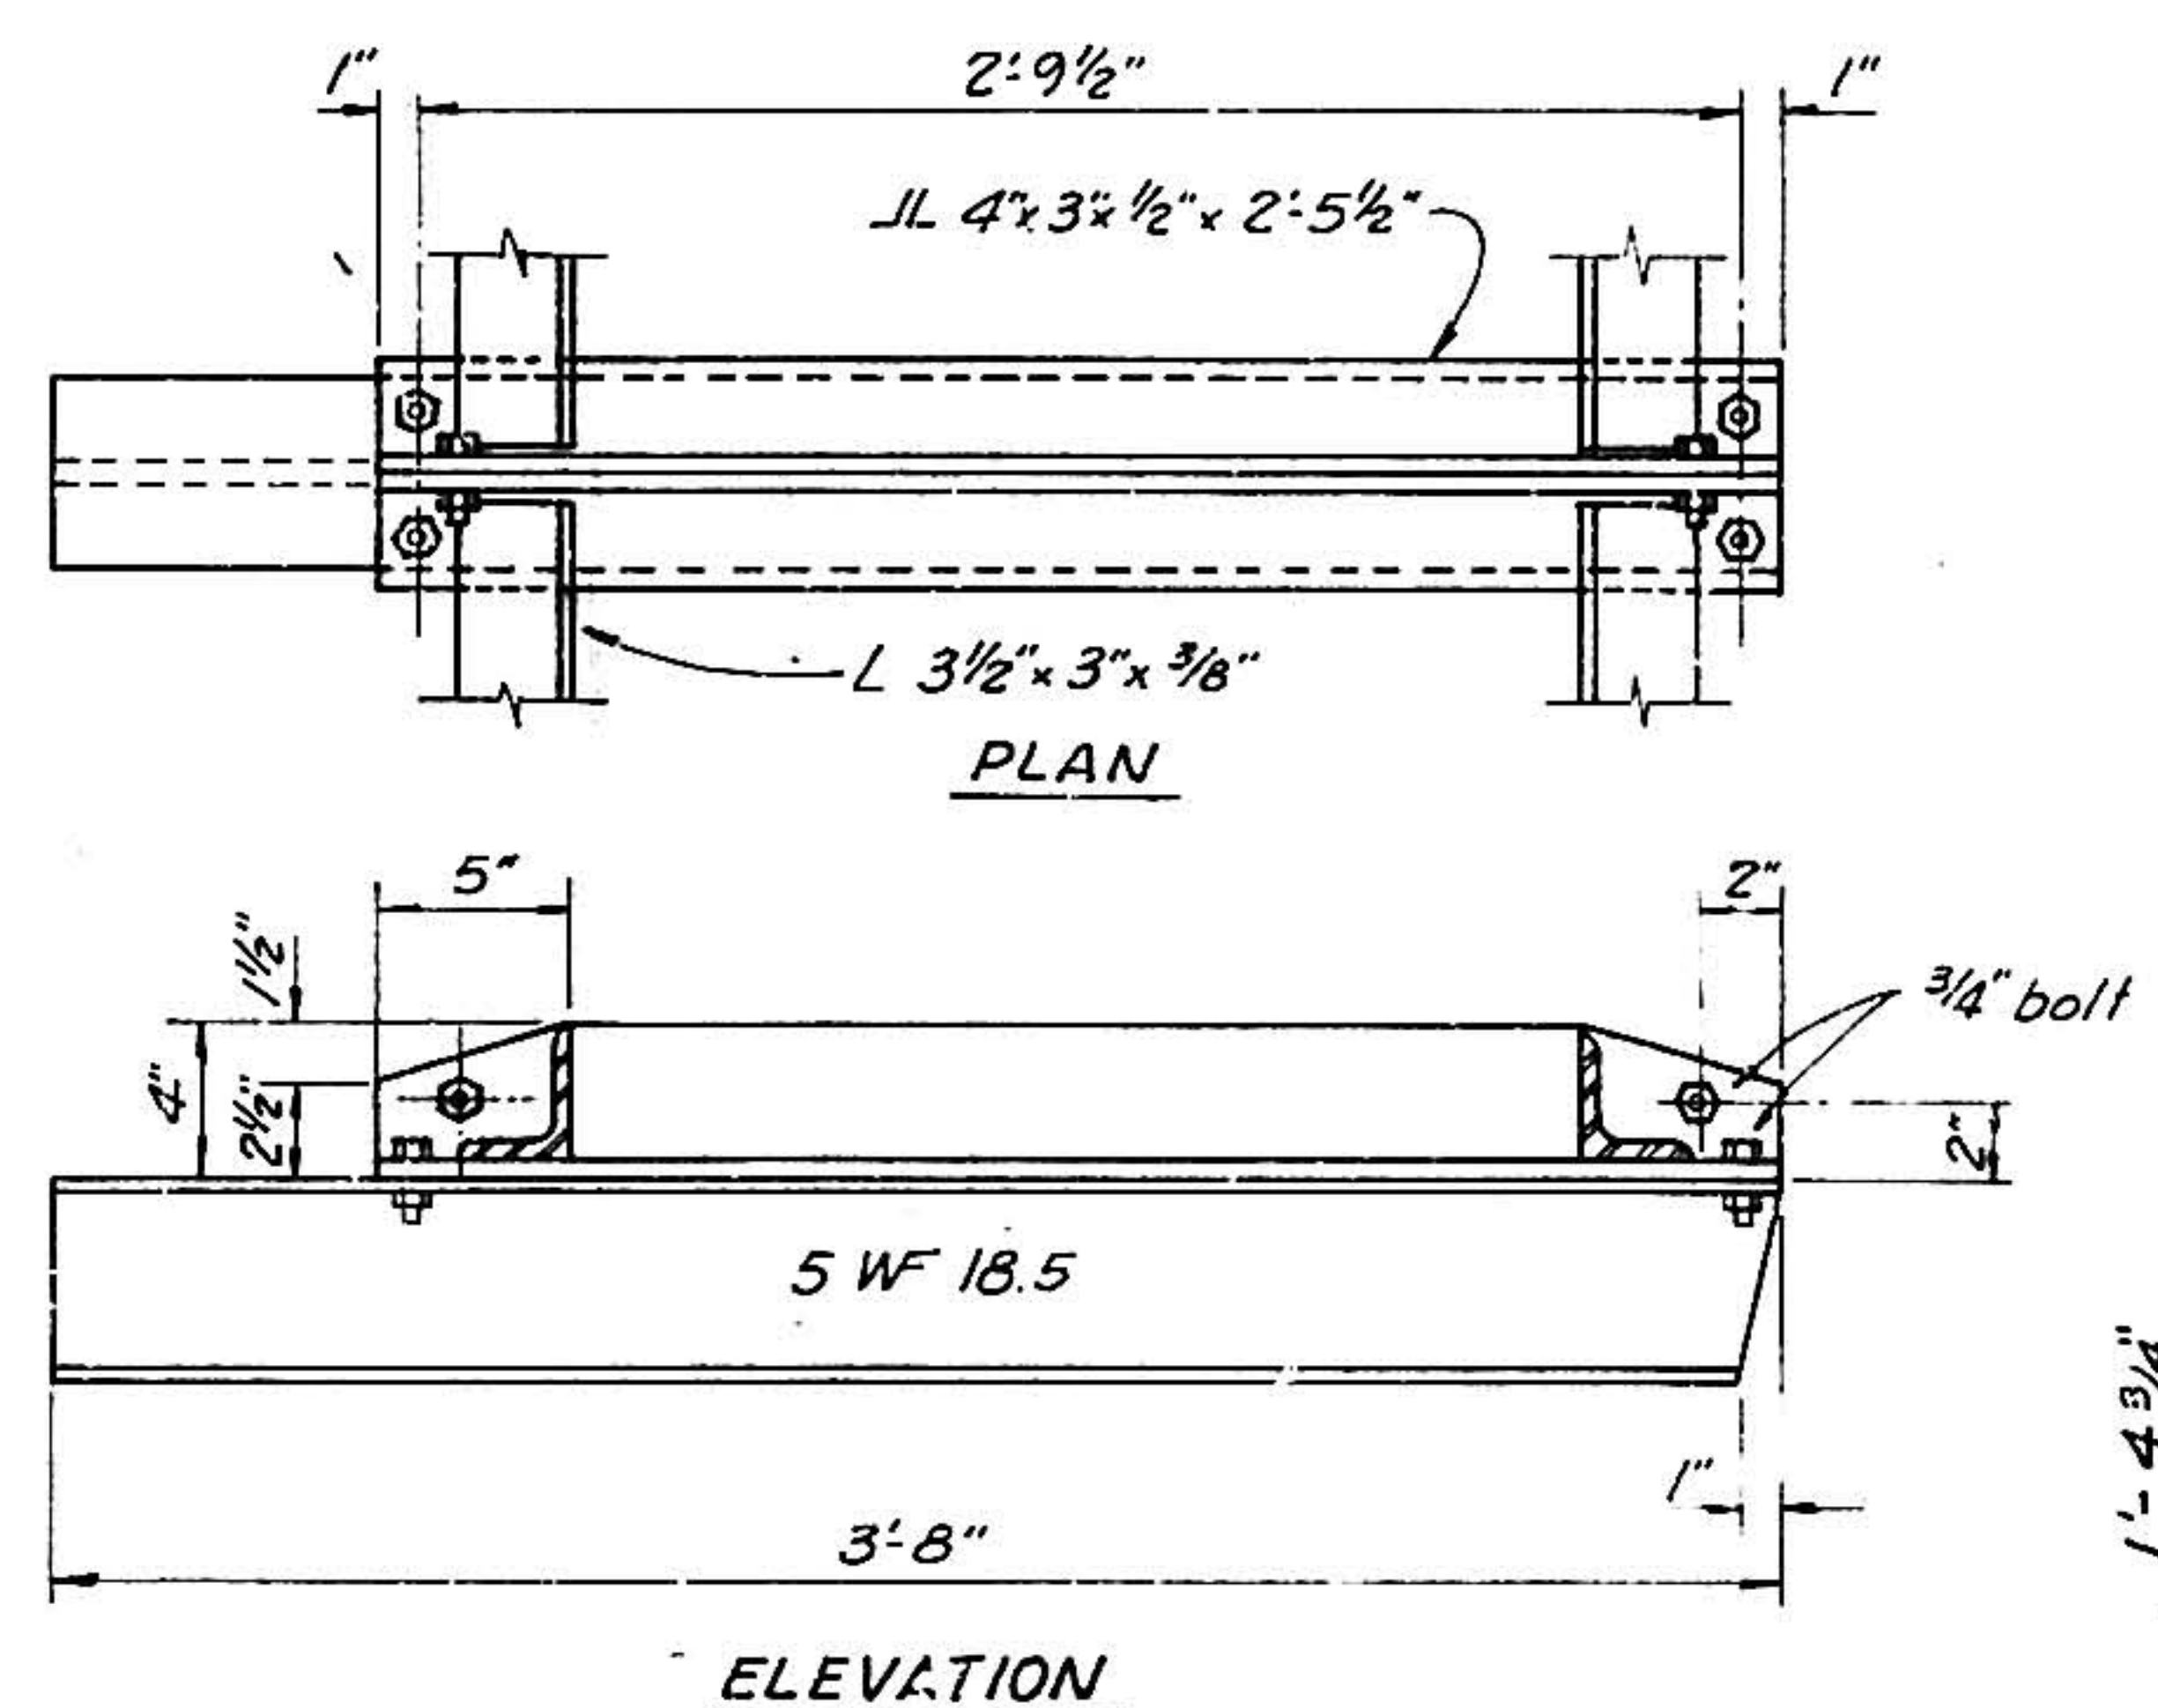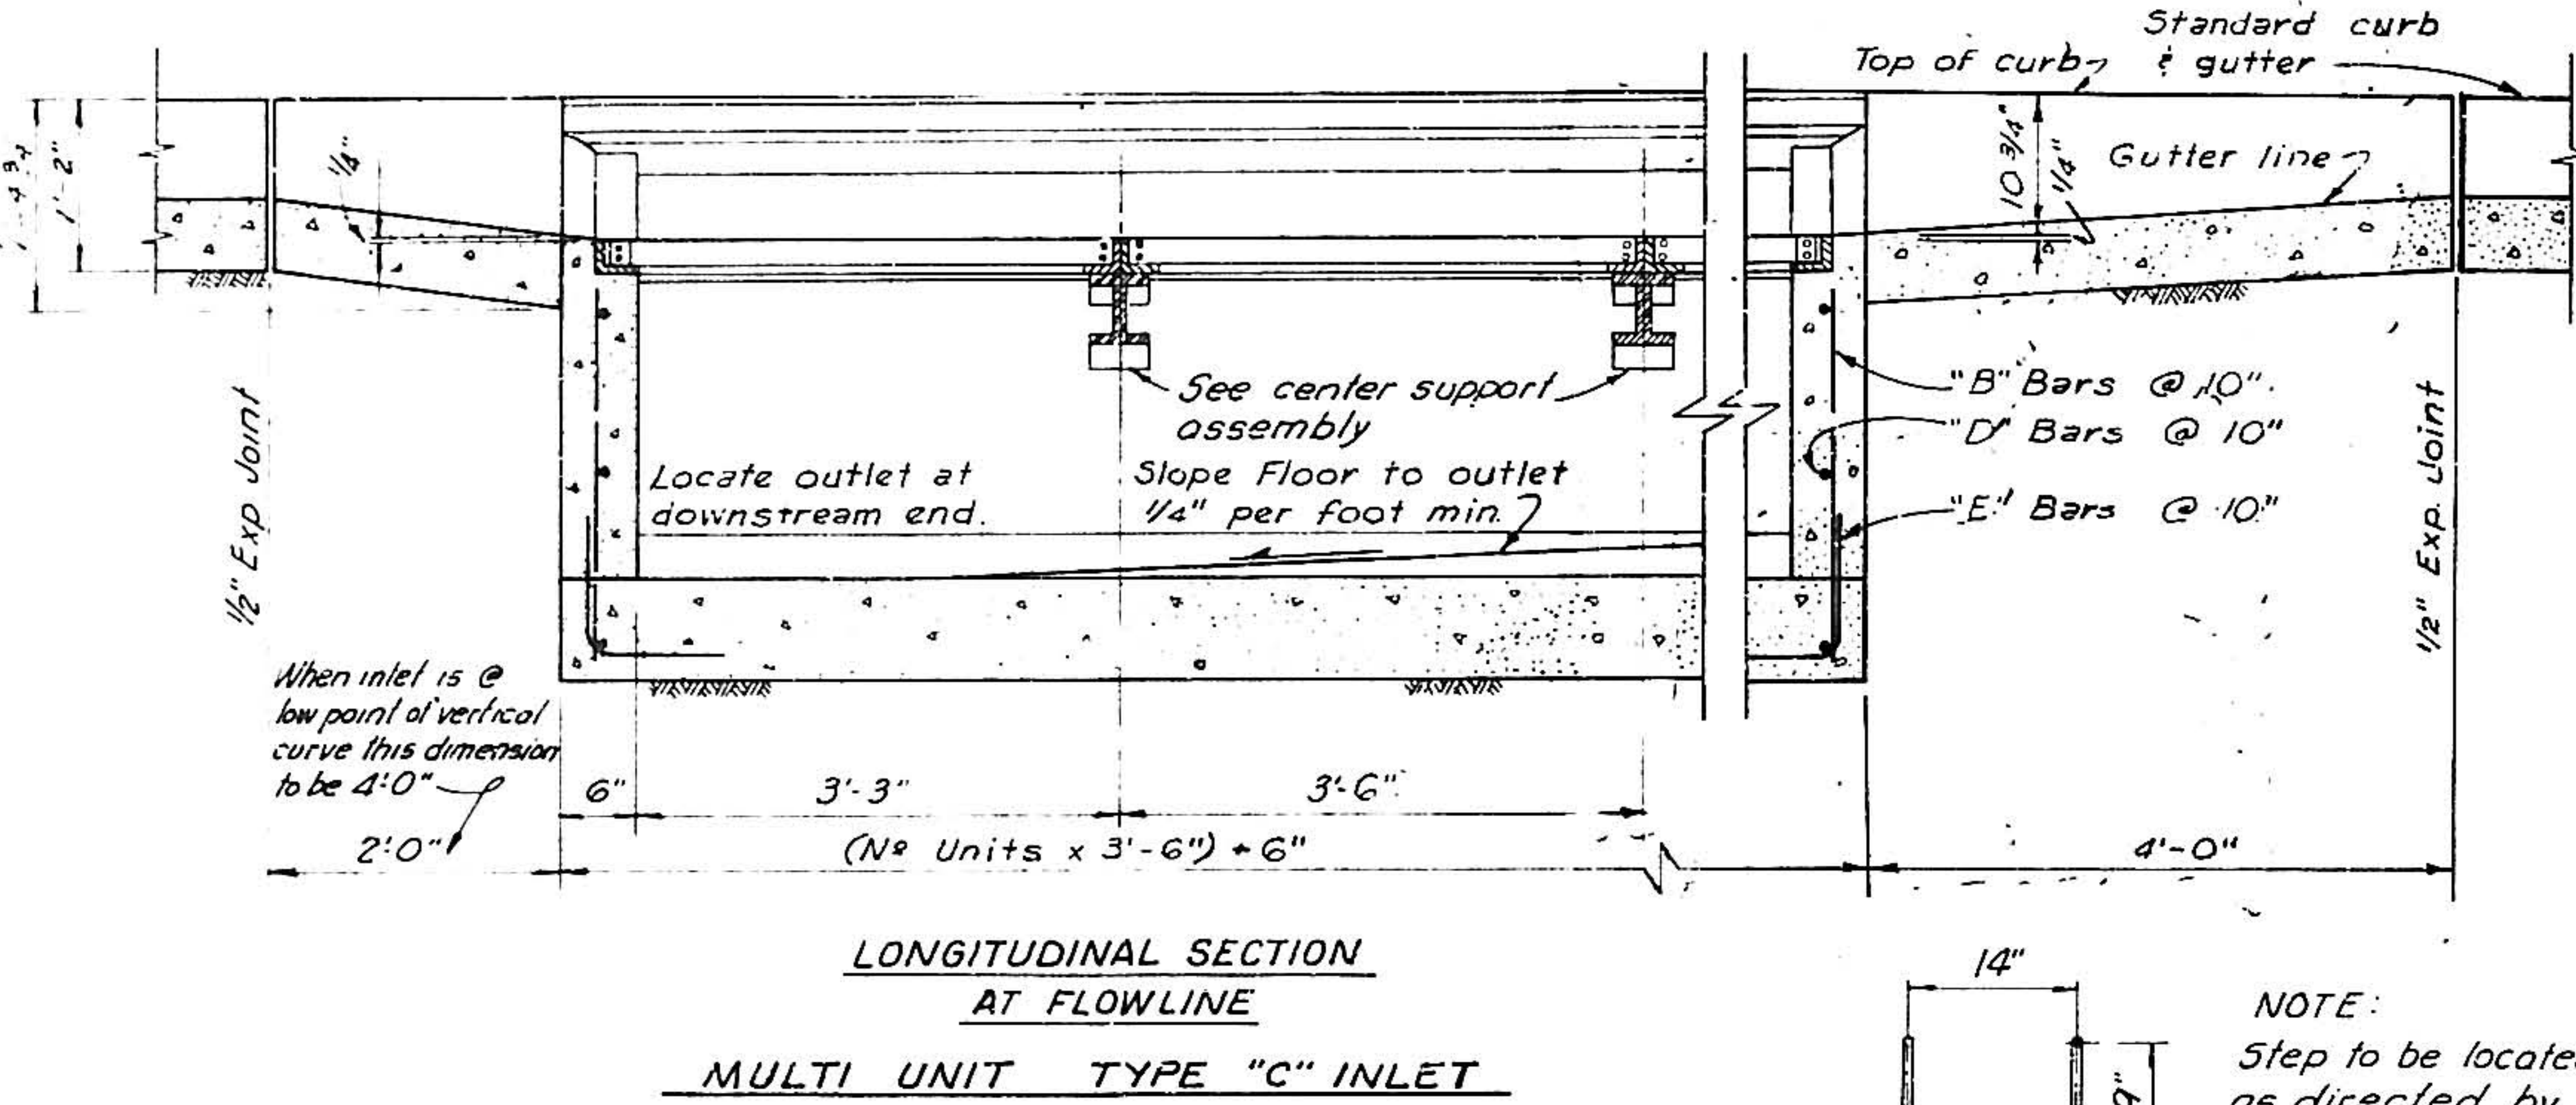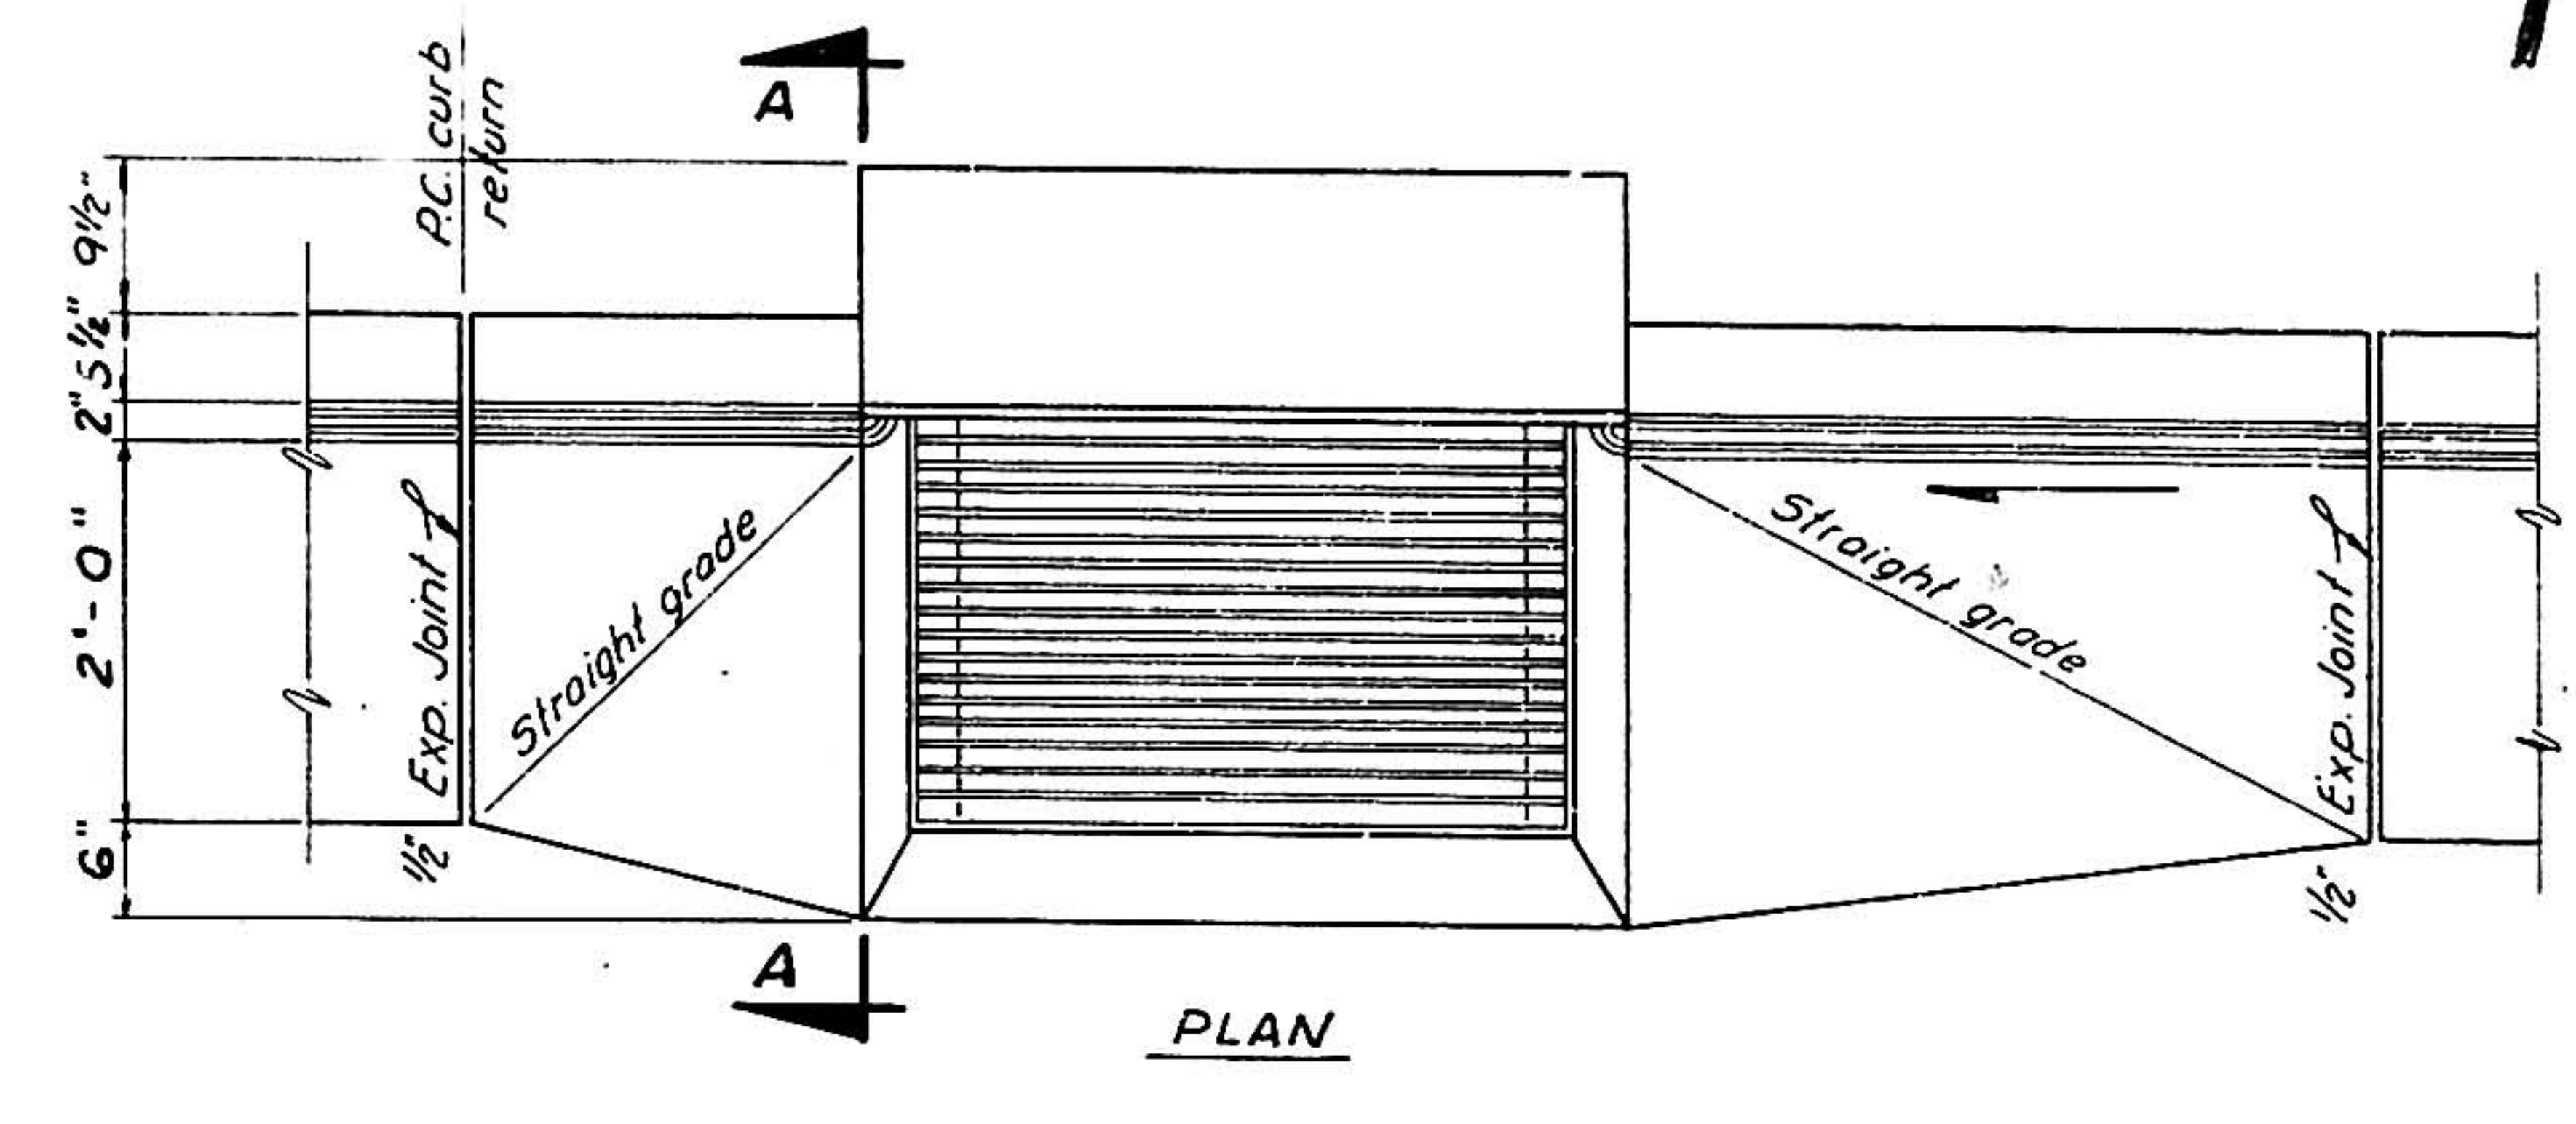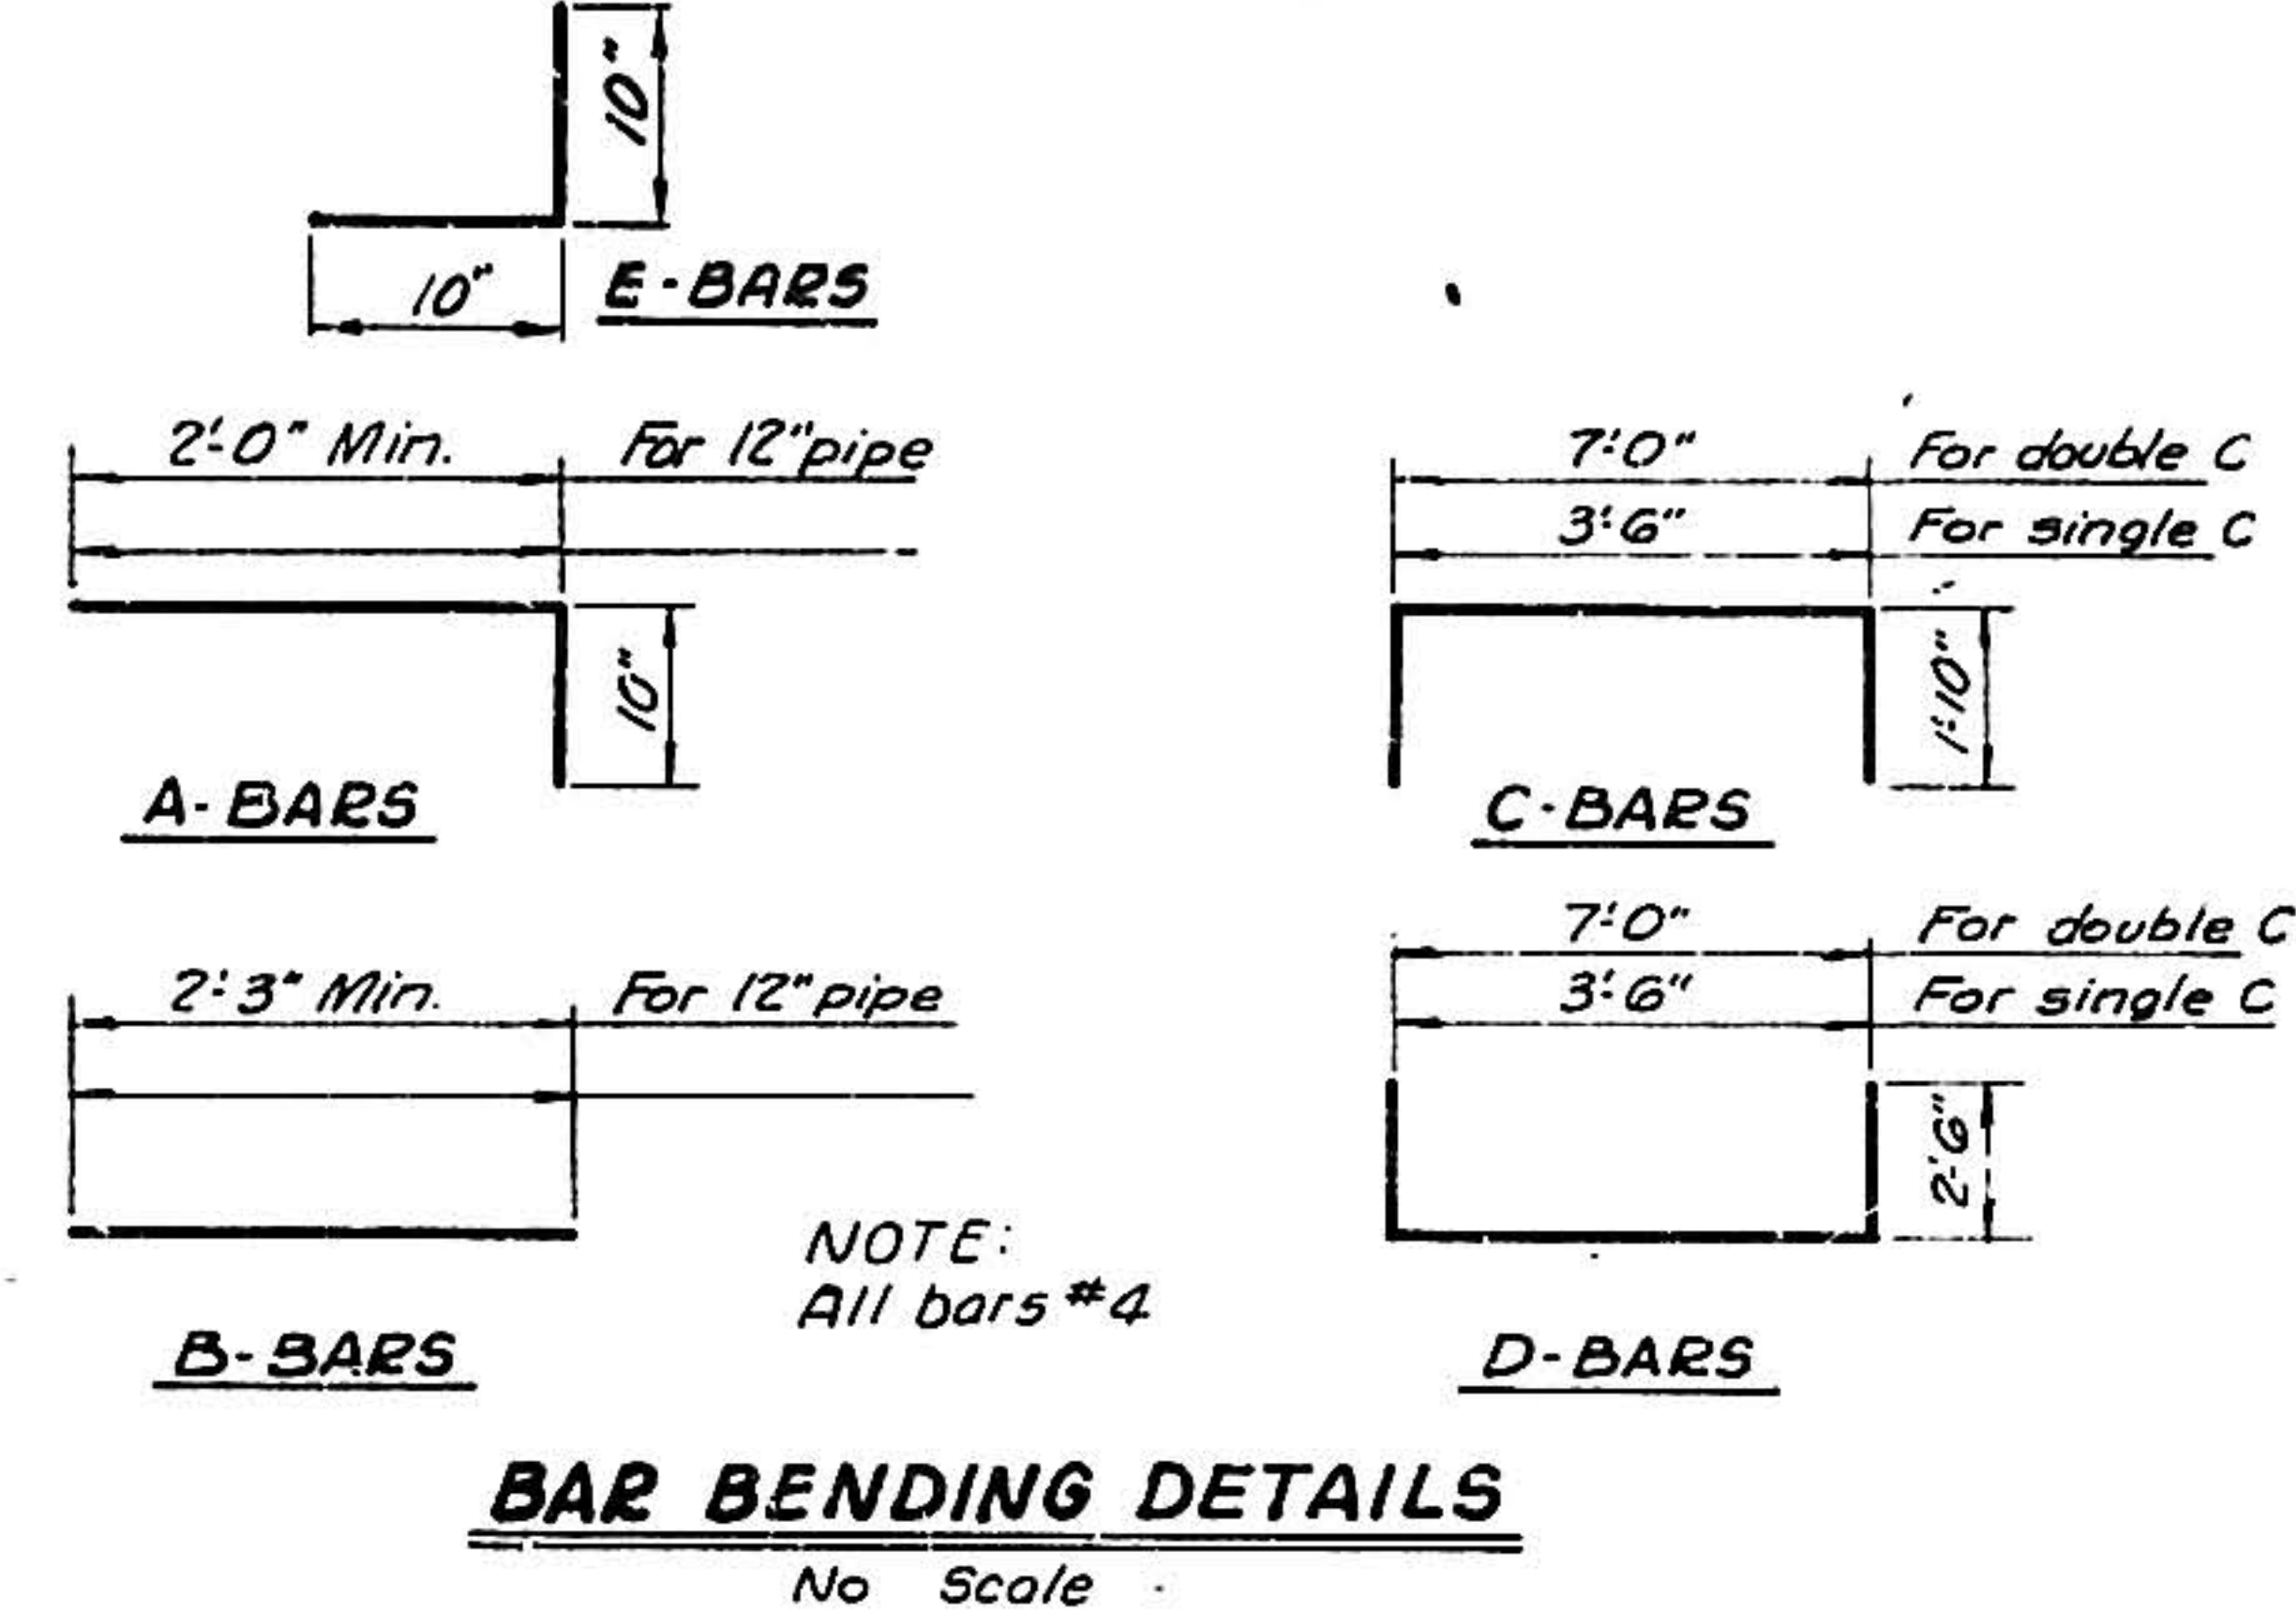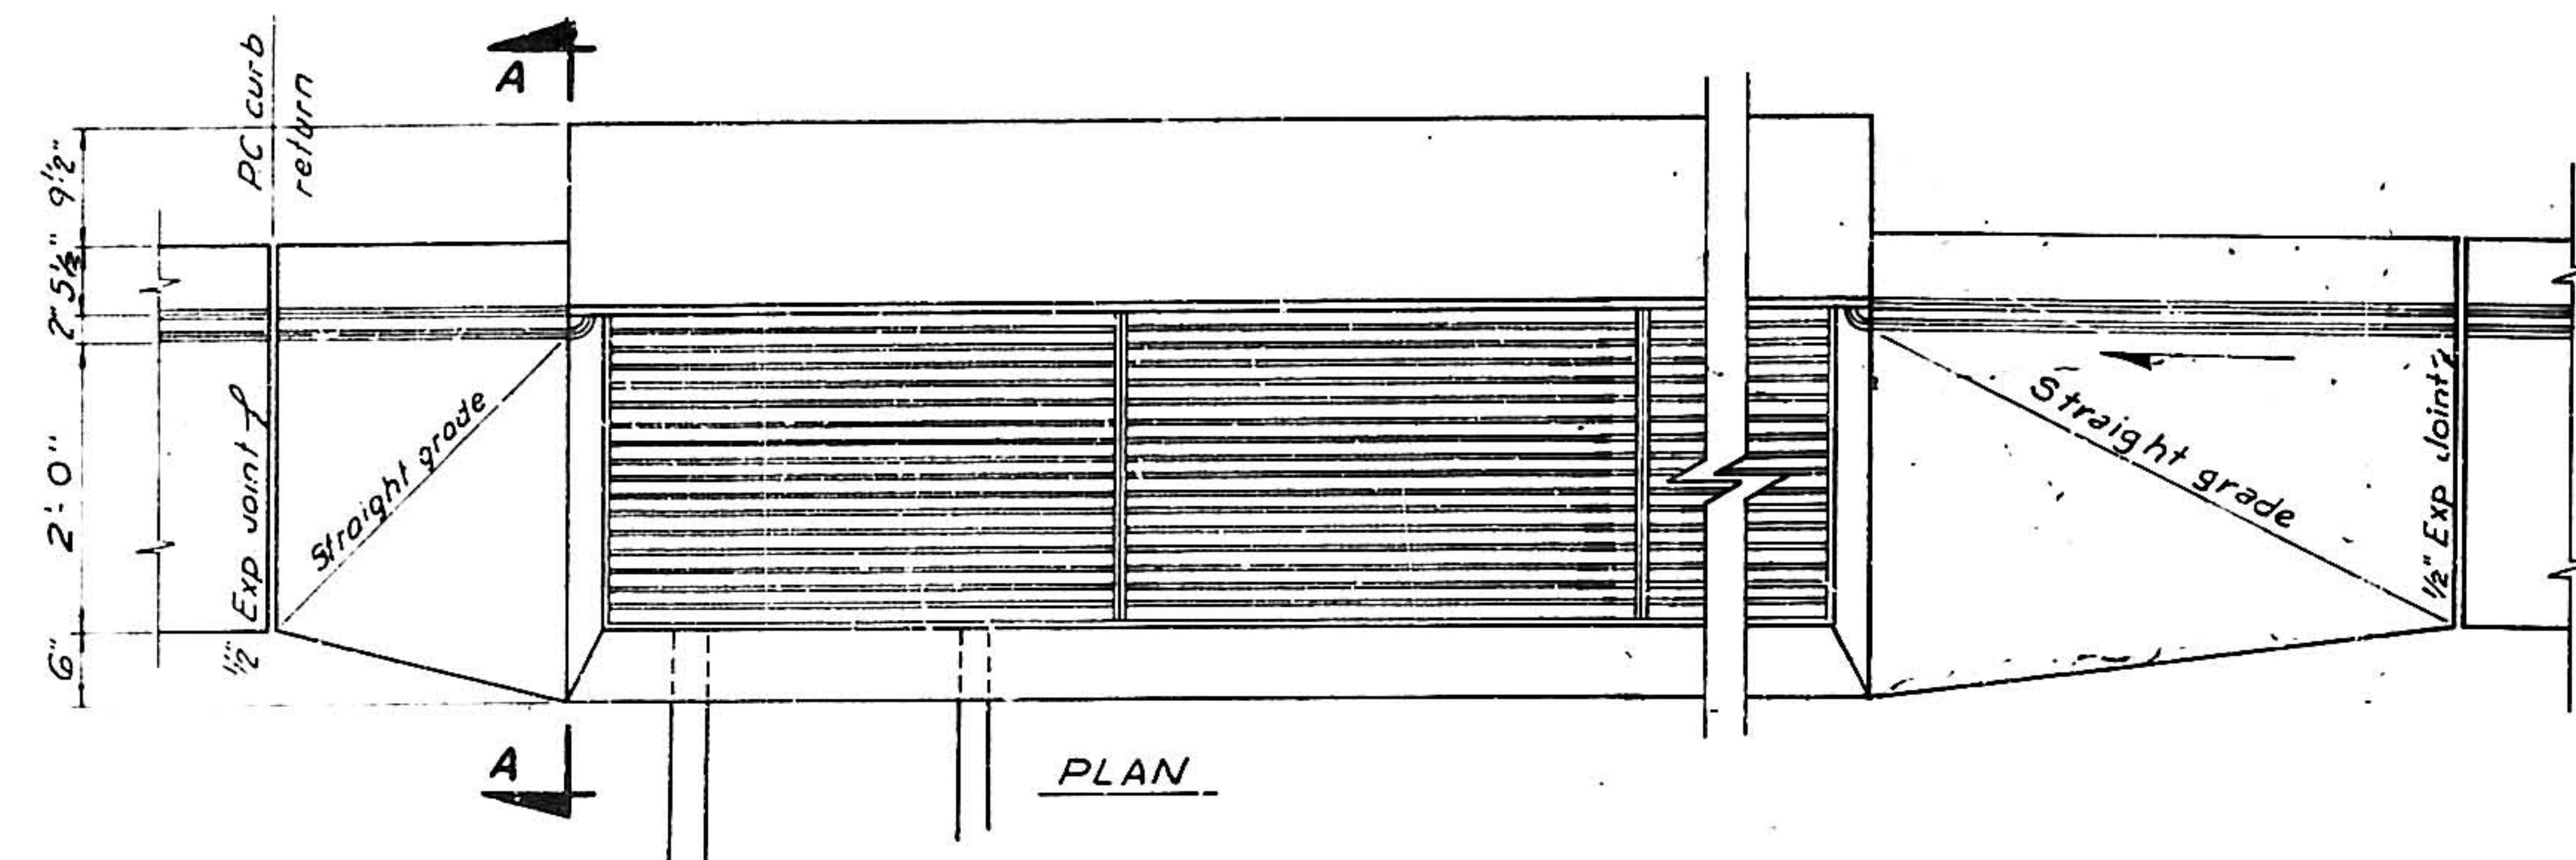

1	2	3	4	5	6	7	8	9	10	11	12	13	14	15	16	17	18	19	20	21	22	23	24	25	26	27	28	29
08	173	6870																										




ALBUQUERQUE, NEW MEXICO
SPECIAL ASSESSMENT DISTRICT NO. 173

DROP INLET DETAILS

D. F. MOLZEN & ASSOCIATES
Consulting Engineers
ALBUQUERQUE NEW MEXICO

Drawn: Spinello Checked: D.F.M. Sheet: 68 of

Date: _____

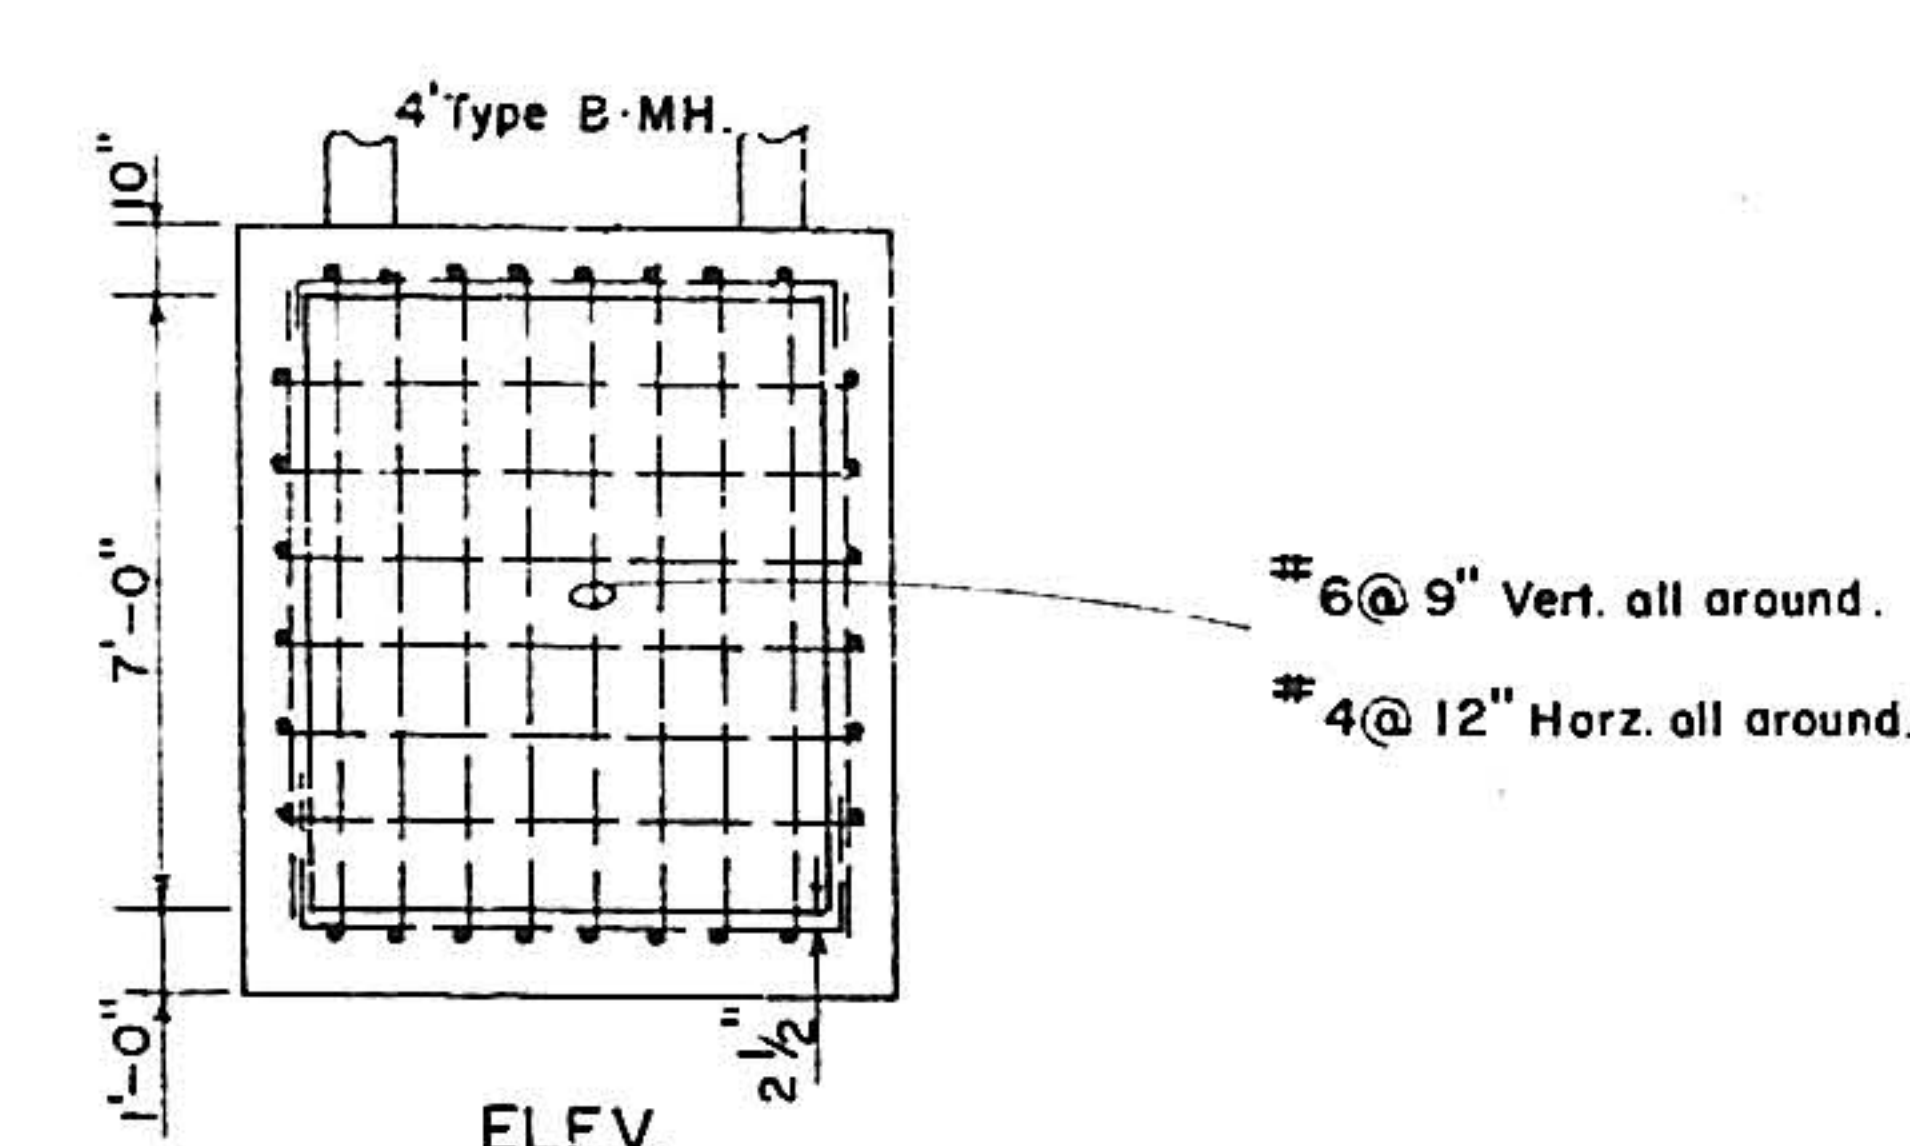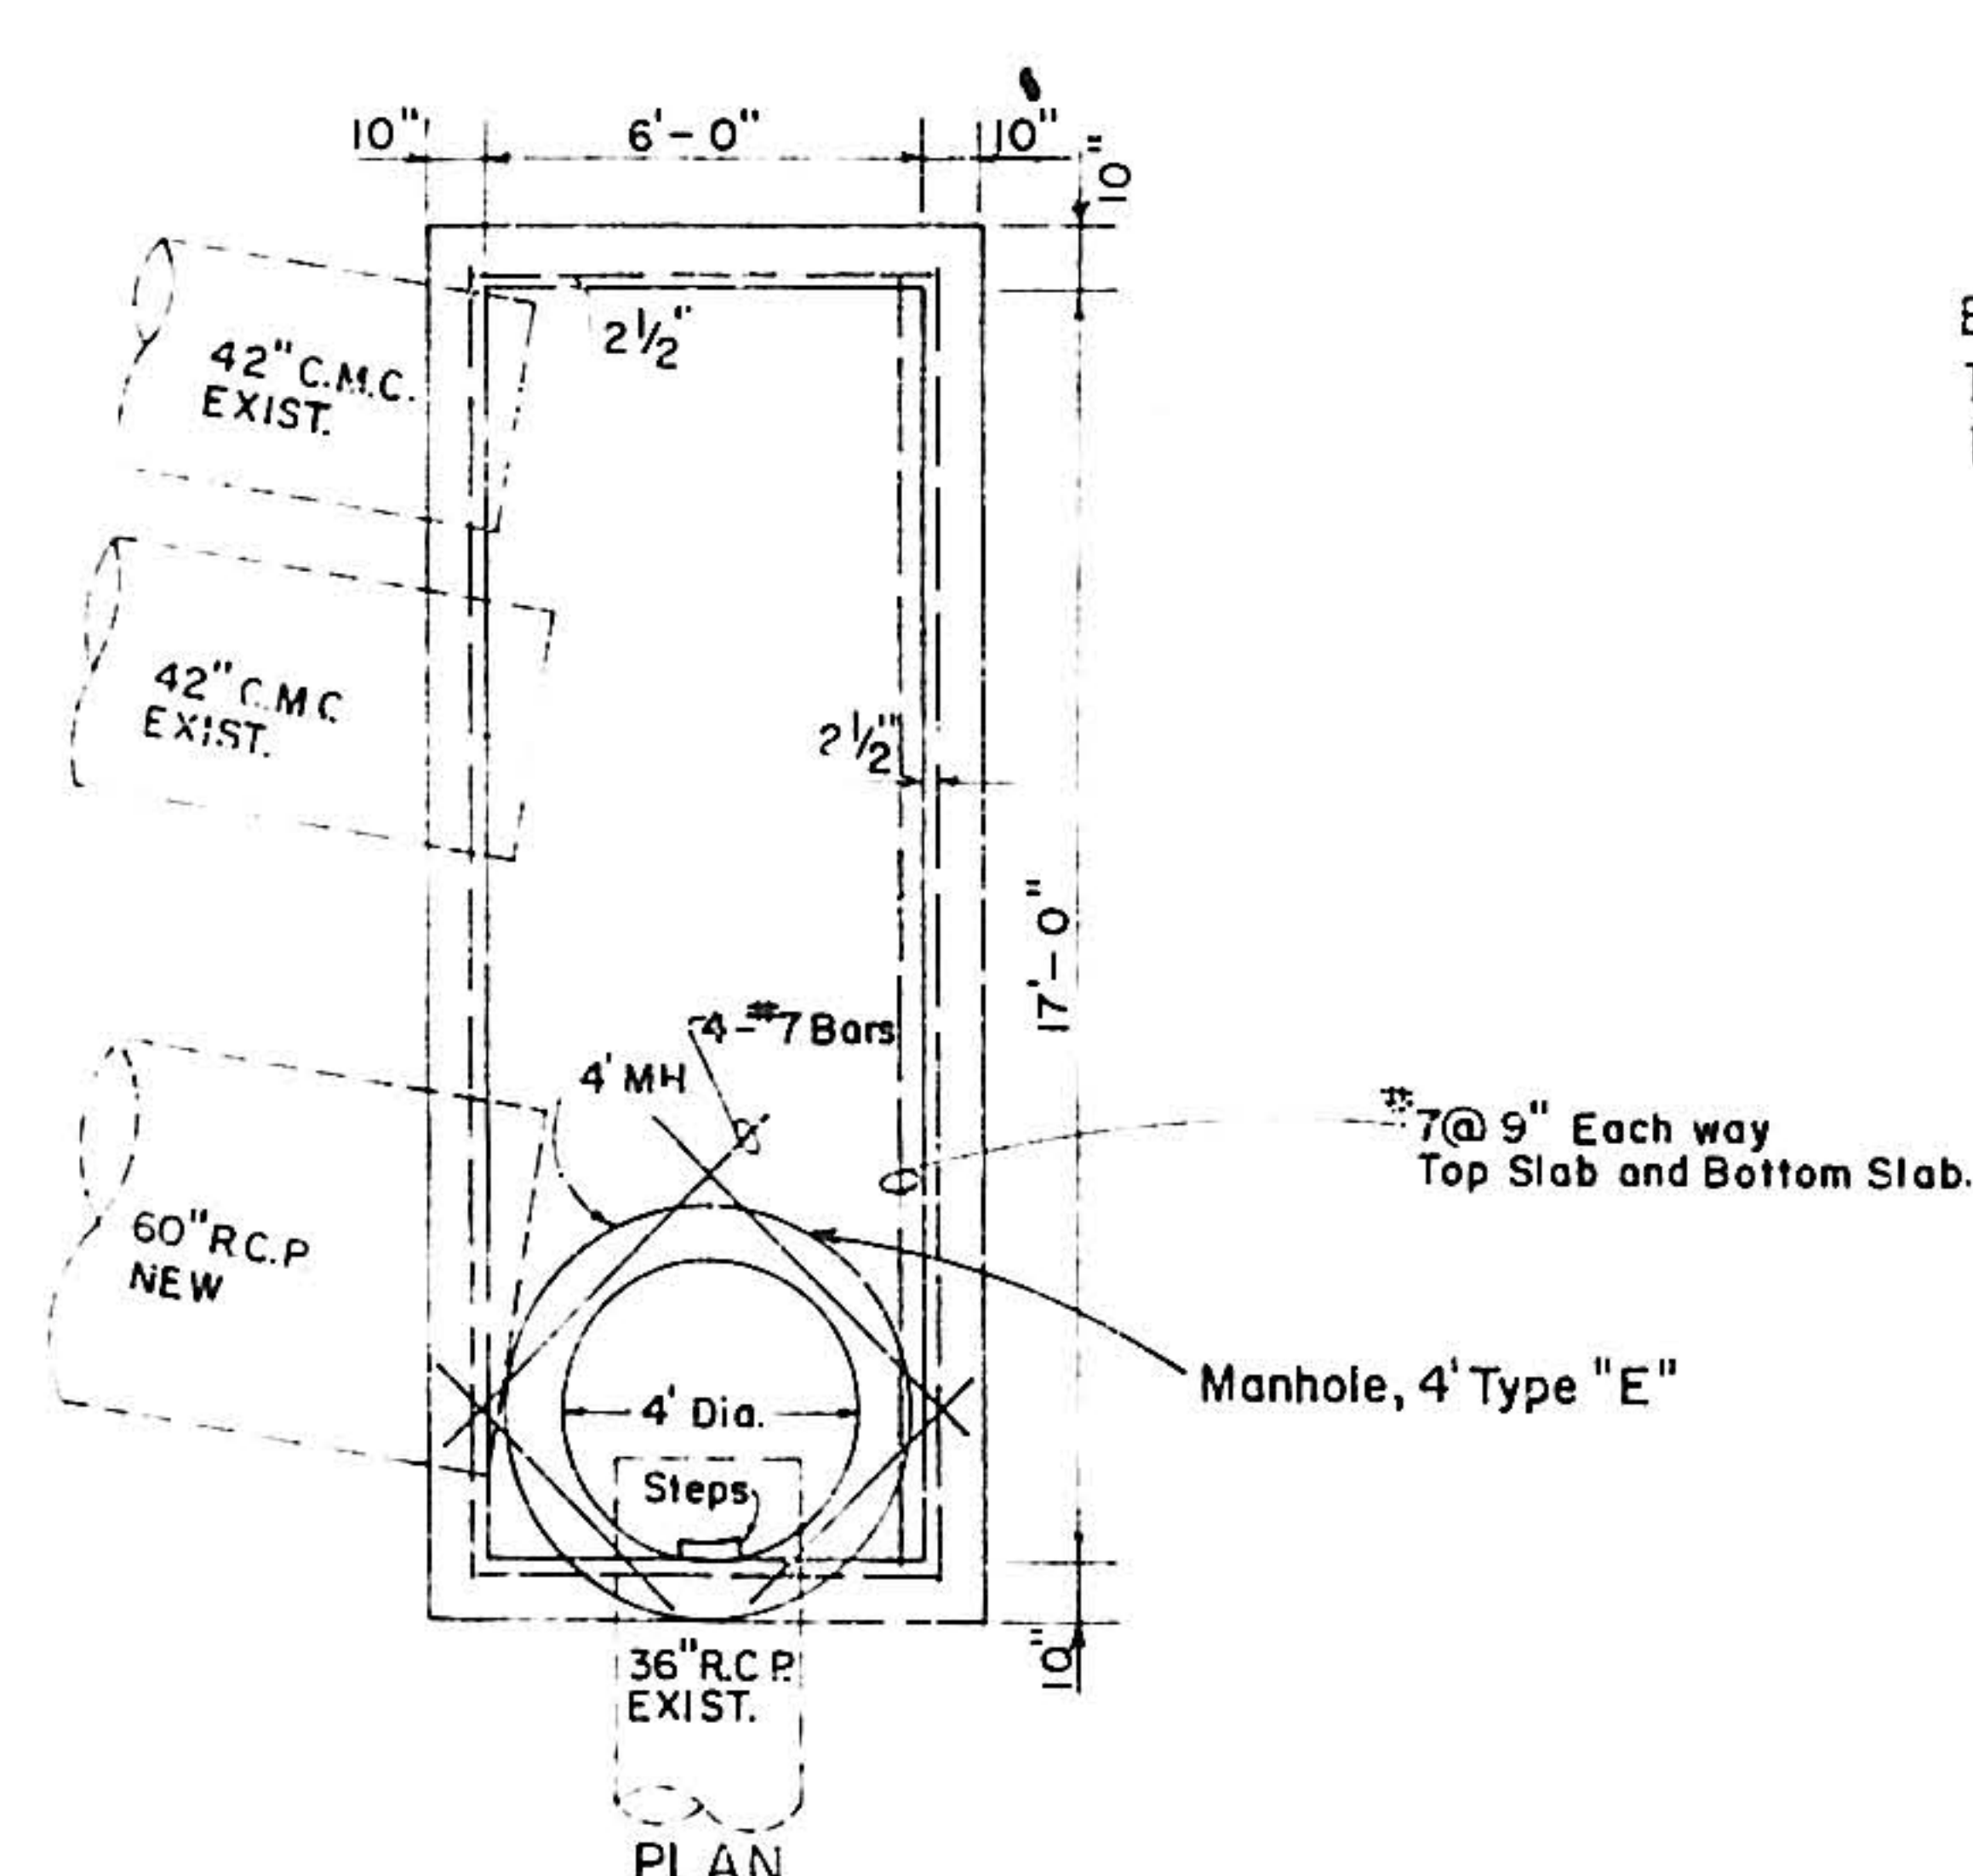 

NOTE: SEE SHEET NO. 27 FOR PAVING PLAN & PROFILE
SEE SHEET NO. 38 FOR WATER IMPROVEMENTS
SEE SHEET NO. 50 FOR SANITARY SEWER IMPROVEMENTS
SEE SHEET NO. 57 FOR STORM SEWER

1	2	3	4	5	6	7	8	9	10	11	12	13	14	15	16	17	18	19	20	21	22	23	24	25	26	27	28	29
08	17	3	6	9	7	0																						

Revision No. 1 20 May 1970

ALBUQUERQUE, NEW MEXICO
SPECIAL ASSESSMENT DISTRICT NO. 173

LAYOUT SHEET
NEW STORM SEWER ALAMO AVE.

D. F. MOLZEN & ASSOCIATES
Consulting Engineers
ALBUQUERQUE NEW MEXICO

Drawn	Checked	Sheet
File	Date	69 of