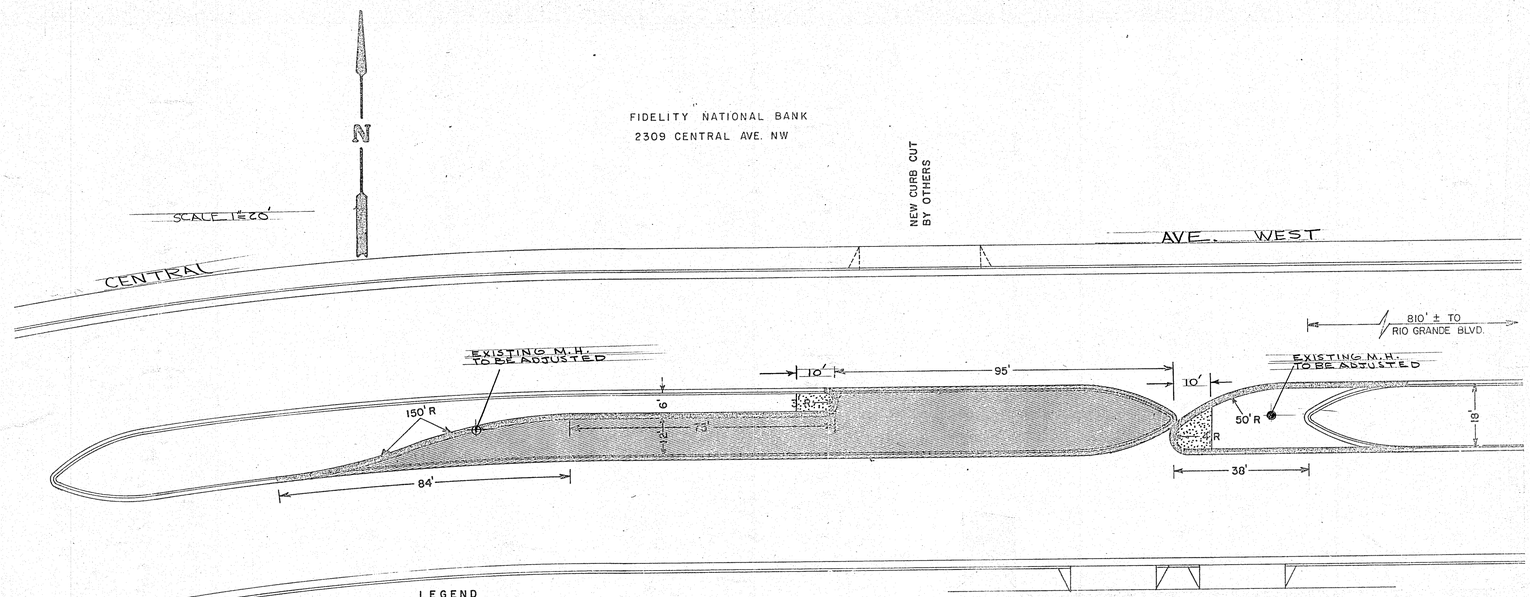


**LEGEND**

- - - - - - - - AREA TO BE REMOVED & PAVED.

- - - - - - - - MEDIAN TYPE CONCRETE CURB & GUTTER TO BE BUILT.

NOTE: ℄ CURVE RADIUS = 881.47' (PD. 90-B)

APPROVAL OF AS BUILT DRAWINGS
ASST. CITY ENGINEER - FIELD
DATE 12-6-82

| 1 | 2 | 3 | 4 | 5 | 6 | 7 | 8 | 9 | 10 | 11 | 12 |
|---|---|---|---|---|---|---|---|---|---|---|---|
| 24 | | 087 | | 01 | 76 | | | | | | |

AS-BUILT INFORMATION
CONTRACTOR
WORK ACCEPTED BY — DATE
DRAWING CORRECTED BY — DATE

MICRO-FILM INFORMATION
RECORDED BY — DATE
NO.

BENCH MARKS

SURVEY INFORMATION
FIELD NOTES
NO. — BY — DATE

REFERENCES
MAP NO. J-12
EST. NO. P-87-76
W.O. NO.

| NO. | DATE | REMARKS | BY |
|---|---|---|---|
| | | REVISIONS | |

DESIGN — DATE

DESIGNED BY
DRAWN BY M.S. TRAFFIC ENGINEERS DATE
CHECKED BY Lalo Pino DATE 9/29/76

CITY OF ALBUQUERQUE
PUBLIC WORKS DEPARTMENT
ENGINEERING DIVISION

TITLE: PROPOSED MEDIAN REVISION ON CENTRAL AVE, WEST, 810'± WEST OF RIO GRANDE BLVD. N.W.

| APPROVALS | ENGINEER | DATE | APPROVALS | ENGINEER | DATE |
|---|---|---|---|---|---|
| City Engineer | | 10-4-76 | Liquid Waste | | |
| A.C.E.-Design | | 30 Sep 76 | Traffic | R.A. Tomaglio | 10/4/76 |
| A.C.E.-Hydrology | | | Water | | |

APPROVED FOR CONSTRUCTION
CITY ENGINEER — DATE 12-2-76

DRAWING NO. P-87-76 — SHEET 1 OF 1