


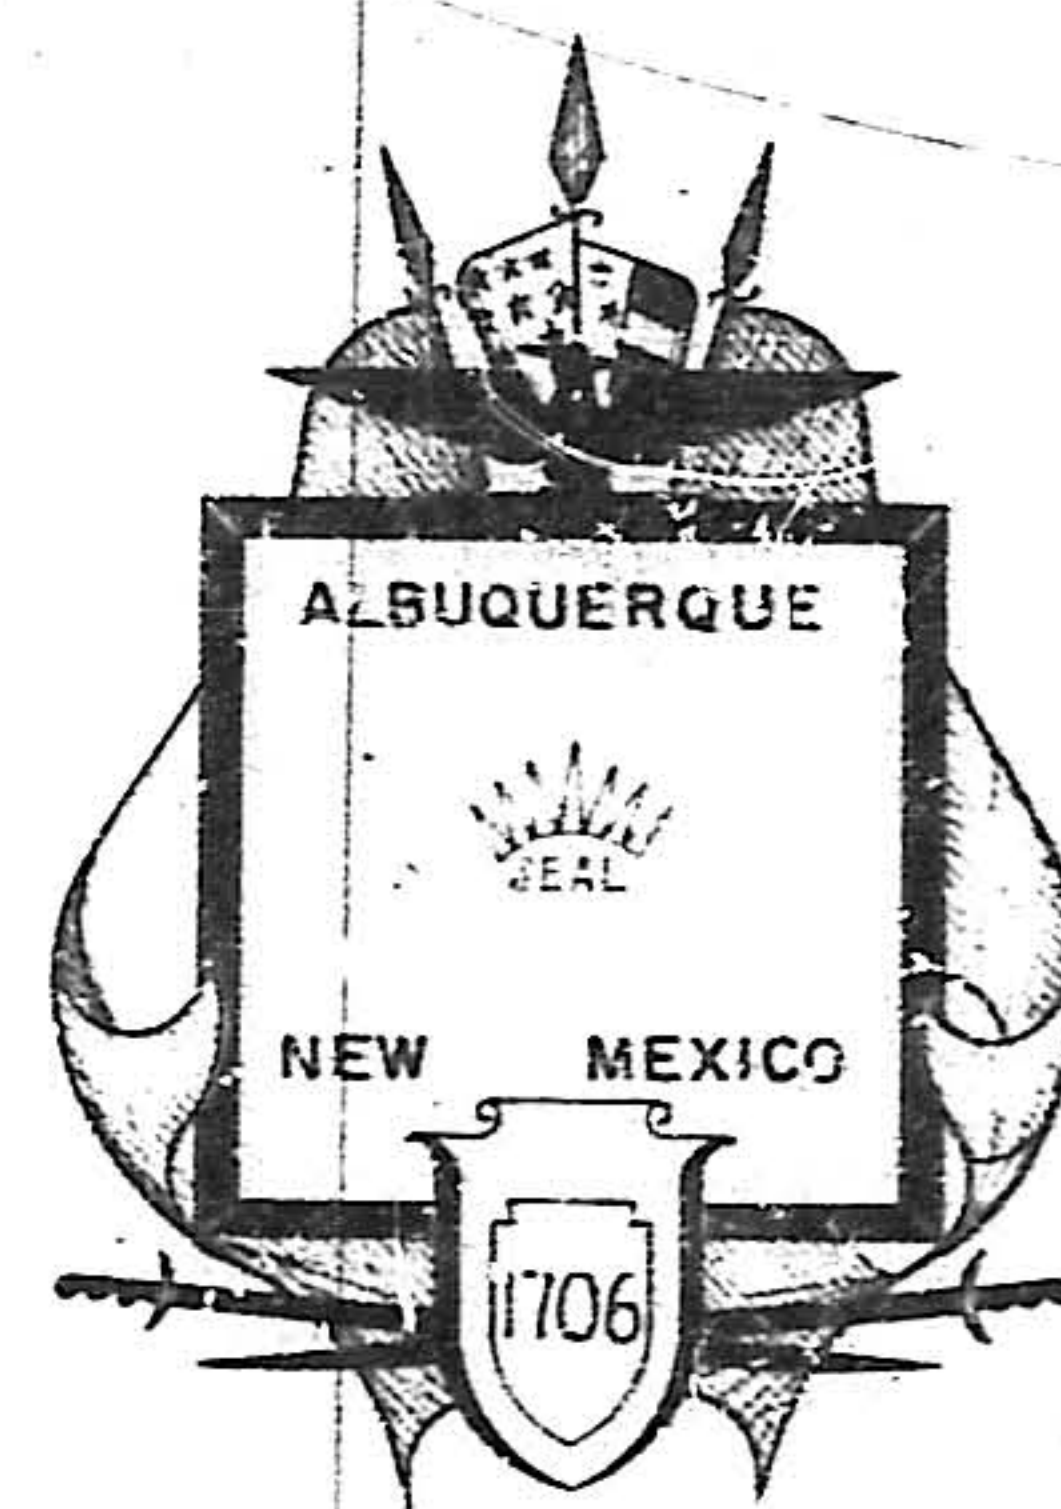

CITY OF ALBUQUERQUE
DEPARTMENT OF PUBLIC WORKS

PLANS
FOR CONSTRUCTION
OF
1972 WELL WASH LINES


CHAIRMAN OF THE CITY COMMISSION & EX-OFFICIO MAYOR *Harry E. Kinney*
CITY MANAGER *Walter A. Smith*
CITY ATTORNEY *Franklin*

DIRECTOR OF PUBLIC WORKS *E. J. Hensch*
CITY ENGINEER *V. M. Smith*



GORDON HERKENHOFF AND ASSOCIATES
ENGINEERS · PLANNERS

1	2	3	4	5	6	7	8	9	10	11	12	13	14	15	16	17	18	19	20	21	22	23	24	25	26	27	28	29
09	00	01	01	74																								

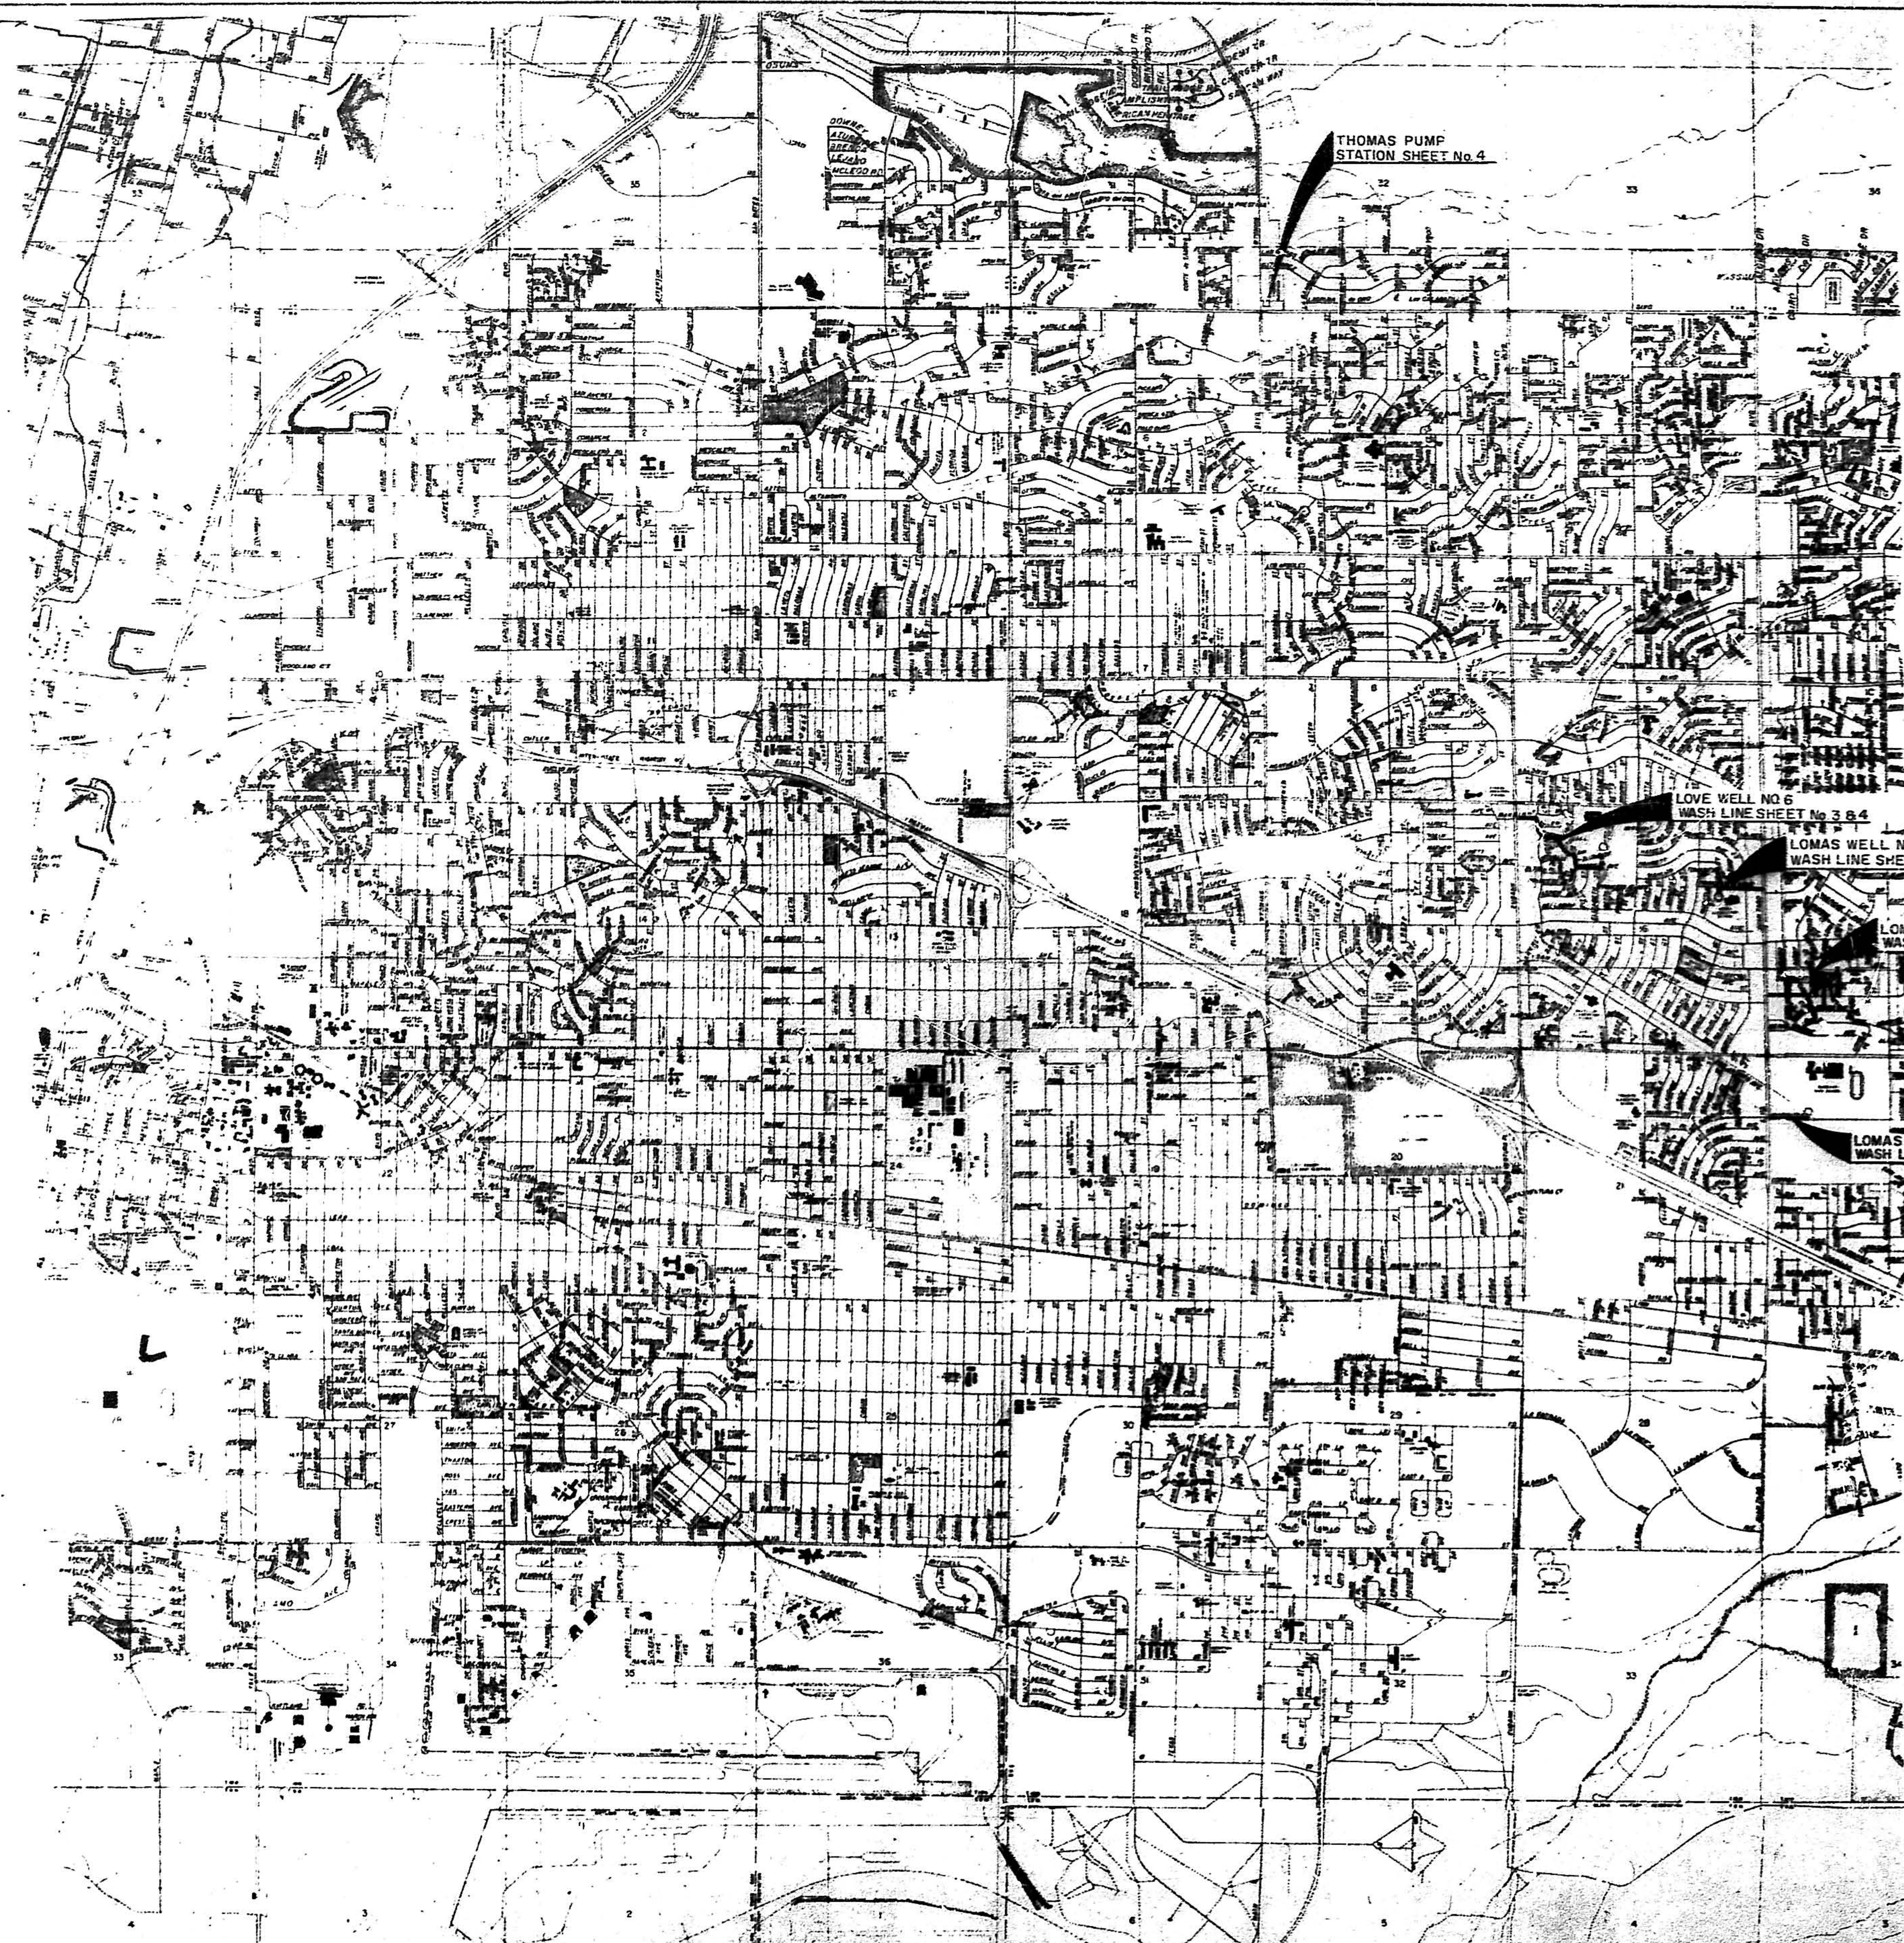



1	2	3	4	5	6	7	8	9	10	11	12	13	14	15	16	17	18	19	20	21	22	23	24	25	26	27	28	29
09	00	1	0	2	7	4																						



ALBUQUERQUE, NEW MEXICO	
1972 WELL WASH LINES	
LOCATION MAP	
GORDON HERKENHOFF & ASSOCIATES, INC. CONSULTING ENGINEERS	
ALBUQUERQUE, NEW MEXICO	
SCALE 1" = 2000'	DATE NOV. 1972
DRAWN: L.A.B.	CHECKED: S.A.J.
SHEET 2	OF 6

AS CONSTRUCTED

PLAN	DATE
BY	
REVISION	
NOTES	
DATE	

PROFILE	DATE
BY	
REVISION	
NOTES	
DATE	

  

 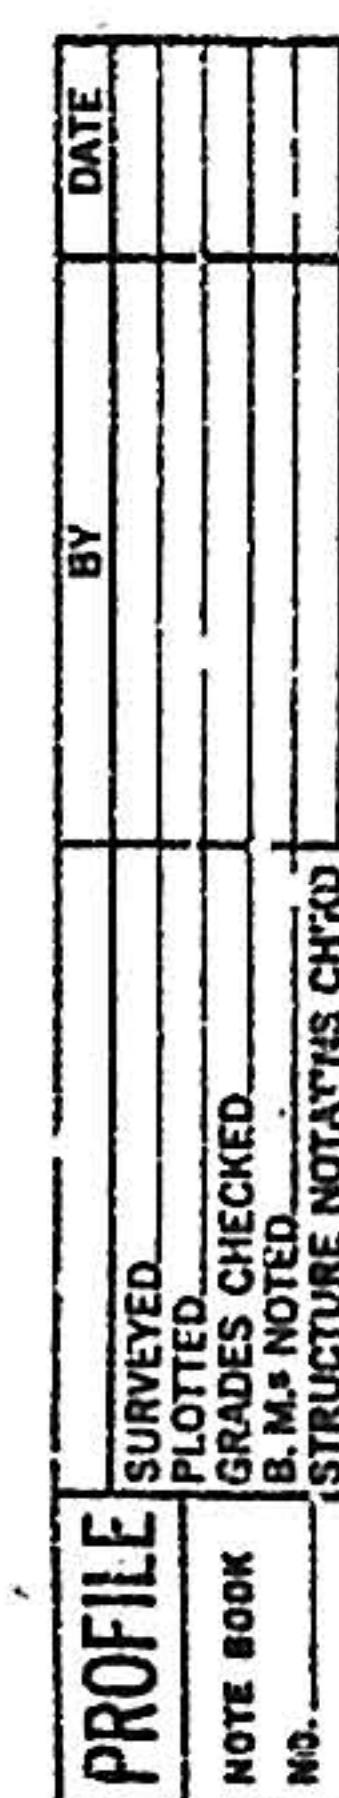

PLAN	DATE
BY	
CHECKED	
NO.	

PROFILE	DATE
BY	
CHECKED	
NO.	

 


PLATE 2 - PROFILE PLAN - PROFILE - NOTED


AS CONSTRUCTED

1972 WELL WASH LINES

SHEET 5 OF 6

PLAN	DATE	BY
DESIGNED		
PLOTTED		
GRADES CHECKED		
NOTES		
NO.		

PROFILE	DATE	BY
DESIGNED		
PLOTTED		
GRADES CHECKED		
NOTES		
NO.		

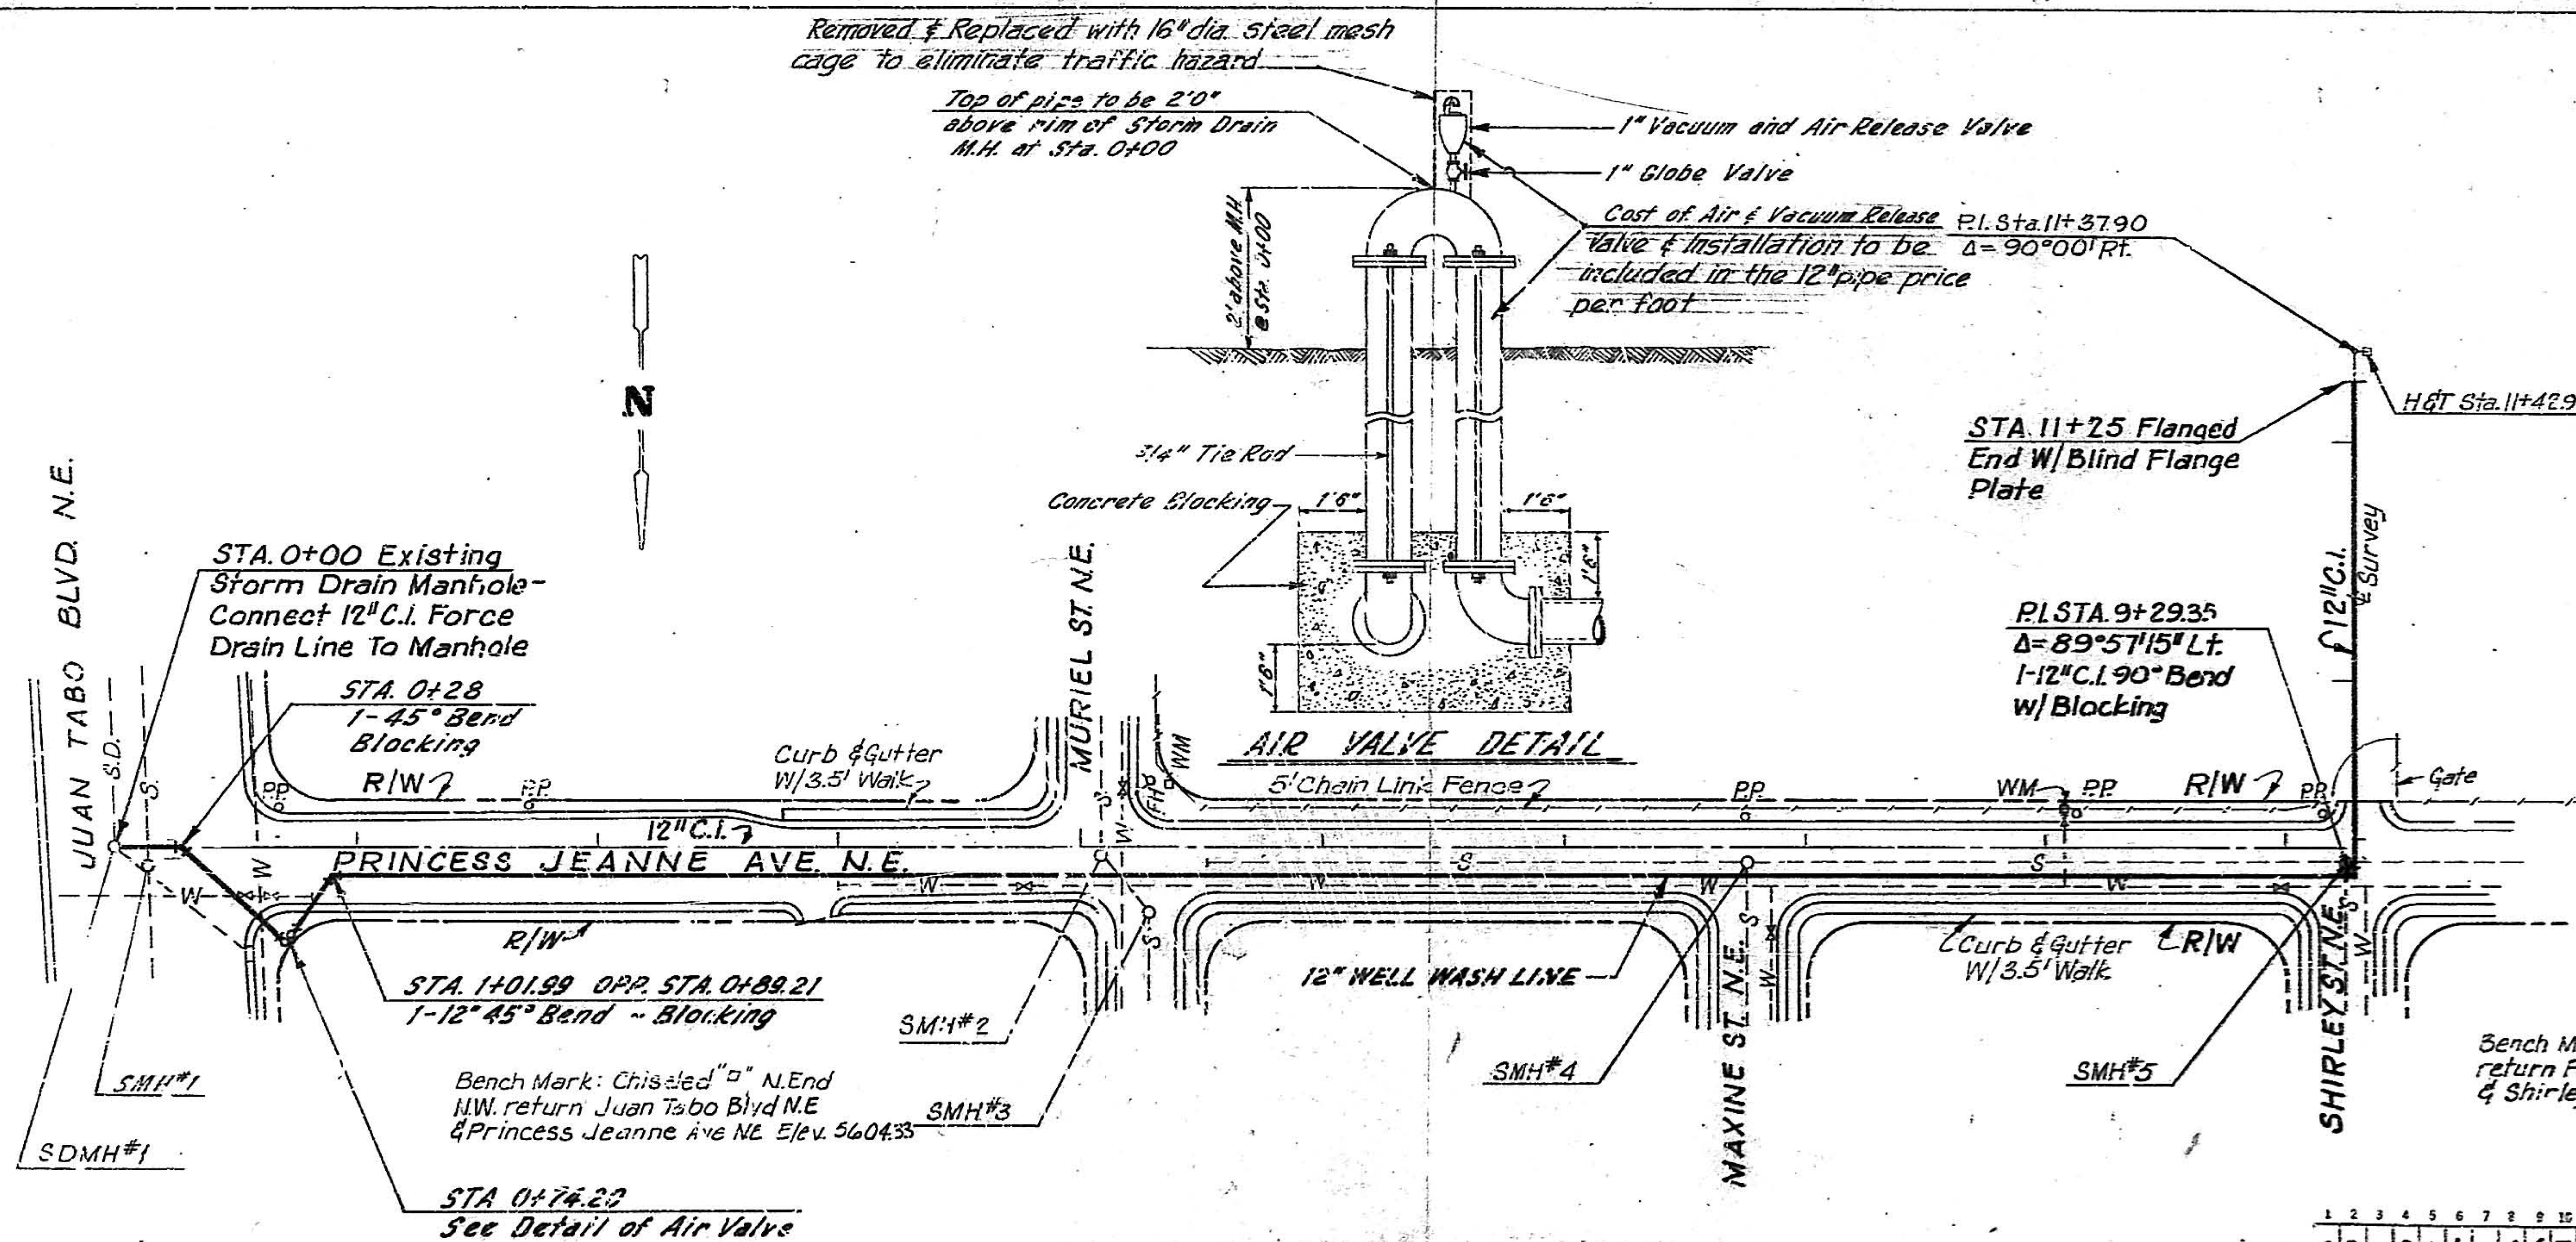

MANHOLE DATA

SDMH#1
S. Rim Elev. 5603.77
48\"/>

SMH#1
S. Rim Elev. 5604.16
8\"/>

SMH#2
S. Rim Elev. 5592.25
8\"/>

SMH#3
Rim Elev. 5591.92
8\"/>

SMH#4
S. Rim Elev. 5584.19
10\"/>

SMH#5
Rim Elev. 5576.41
10\"/>

Bench Mark: Chiselco "A" N. End NW
return Princess Jeanne Ave. N.E.
& Shirley St. N.E. Elev. 5575.99

SCALE
1" = 50' Horiz.
1" = 10' Vert.

