


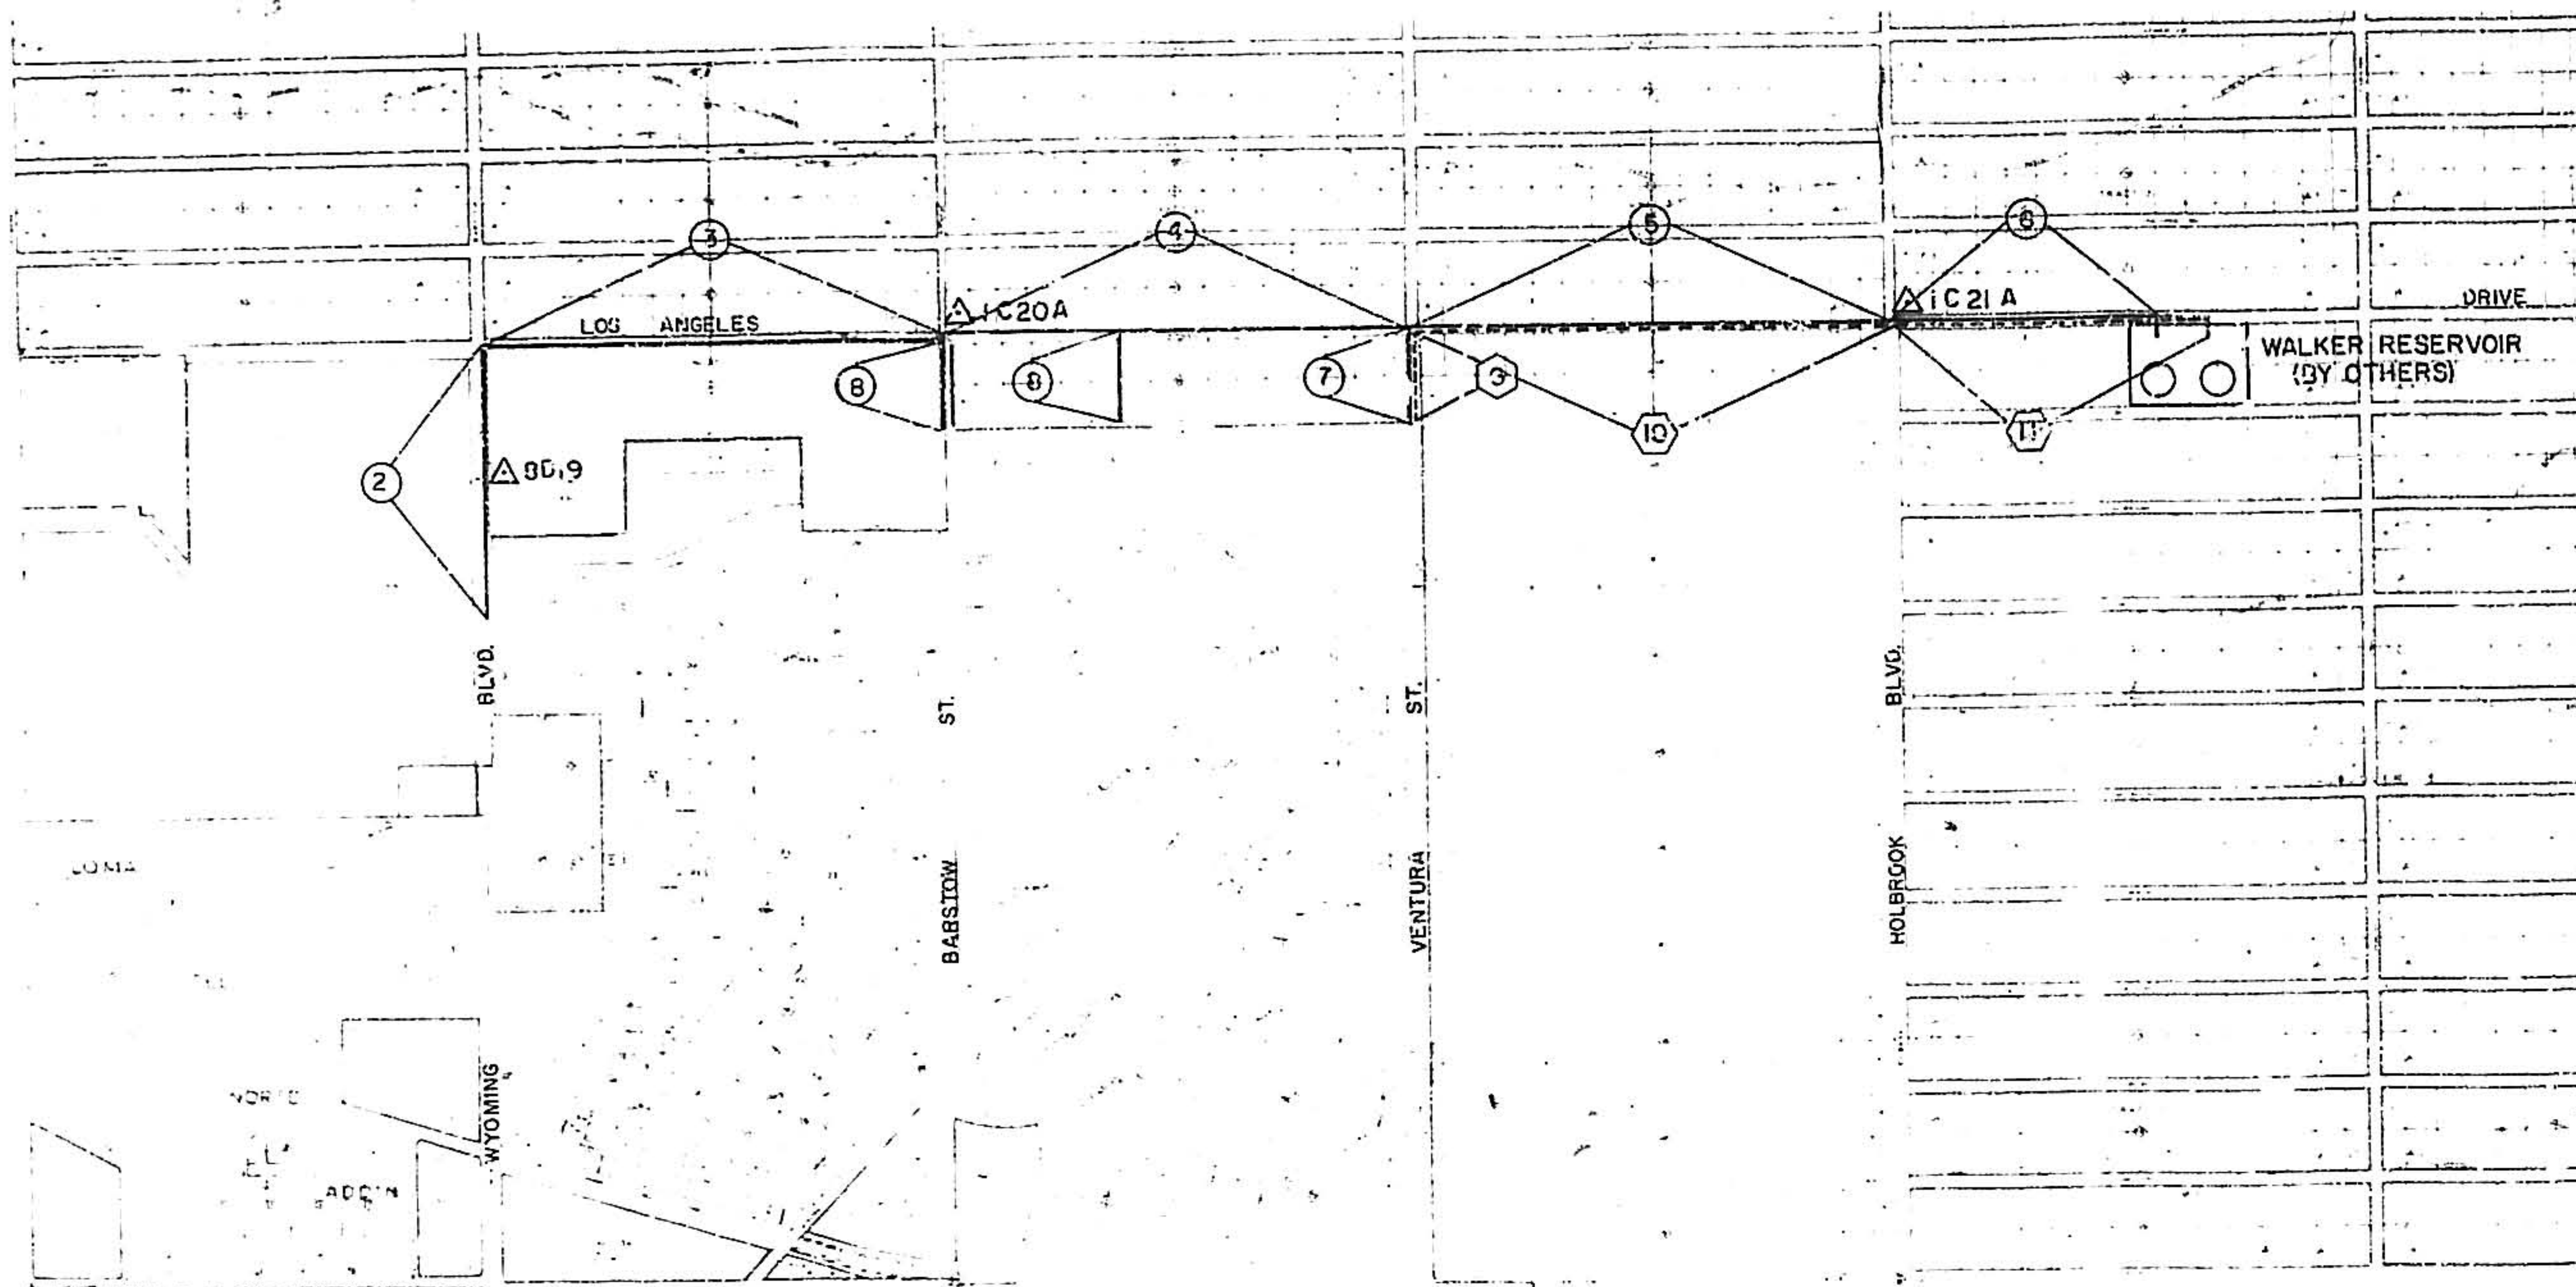

LOCATION MAP
SCALE: 1"=1000'

- (C) DENOTES SHEET NO. WATER LINES
 (D) DENOTES SHEET NO. DRAIN LINES
 (A) DENOTES BENCH MARKS
 8019 5400.45
 IC20A 5478.057
 IC21A 5634.65
 (V) DENOTES VALVE NUMBER FOR CROSS-REFERENCE TO VALVE CARDS.
 EMD DENOTES ELECTRONIC MARKER DISKS.

INDEX OF DRAWINGS

SHEET NO.	TITLE
1 OF 11	TITLE SHEET, INDEX OF DRAWINGS AND LOCATION MAP
2 OF 11	WYOMING BLVD. WATER LINE STA. 0+00 TO STA. 14+94.10
3 OF 11	LOS ANGELES DR. WATER LINE STA. 0+17.00 TO STA. 28+00
4 OF 11	LOS ANGELES DR. WATER LINE STA. 28+00 TO STA. 56+00
5 OF 11	LOS ANGELES DR. WATER LINE STA. 56+00 TO STA. 84+00
6 OF 11	LOS ANGELES DR. WATER LINE STA. 84+00 TO STA. 94+24.80
7 OF 11	VENTURA ST. WATER LINE STA. 0+00 TO STA. 5+43.00
8 OF 11	BARSTOW ST. WATER LINE STA. 0+00 TO STA. 4+98
9 OF 11	ROUGH RIDER ST. WATER LINE STA. 0+41.95 TO STA. 6+04.95
10 OF 11	VENTURA ST. DRAIN LINE STA. 0+00 TO STA. 5+28
11 OF 11	STA. 52+50.73 TO STA. 56+00
	LOS ANGELES DR. DRAIN LINE STA. 56+00 TO STA. 84+00
	LOS ANGELES DR. DRAIN LINE STA. 84+00 TO STA. 96+11.22

ALAMEDA TRUNK ZONE 4E WATER TRANSMISSION AND DRAIN LINES

NOTE:
ELECTRONIC MARKER DISKS PLACED AT ALL VALVES AND MANHOLES.

NOTE:
6", 8", 10" AND 12" WATERLINES ARE A.C.
18" LINE IS D.I.P.
42" AND 48" LINES ARE C.C.P.
6", 8", 10" AND 12" VALVES ARE M&H.
18"-DRESSER; 42" AND 48" ARE AMERICAN DARLING.

GORDON HERKENHOFF & ASSOCIATES, INC.

302 Eighth Street, N.W.
Albuquerque, New Mexico 87102

(505) 247-0294

HOBS
FARMINGTON
SANTA FE

RECORD DRAWING
DATE DEC 6 1981
JOB NO. 1688.21

PREPARED UNDER THE DIRECTION OF

WATER RESOURCES DEPARTMENT
APPROVAL OF AS BUILT DRAWINGS

Alfred P. de Billy
Date Feb. 3, 1982

APPROVED FOR CONSTRUCTION


CITY ENGINEER DATE


CITY OF ALBUQUERQUE
MUNICIPAL DEVELOPMENT DEPARTMENT
ENGINEERING DIVISION



TITLE SHEET
INDEX OF DRAWINGS, AND LOCATION MAP

APPROVALS	ENGINEER	DATE	APPROVALS	ENGINEER	DATE
City Engineer			Liquid Waste		
A.C.E. - Design			Traffic		
A.C.E. - Hydrology			Water		

DRAWING NO. SHEET 1 OF 11

 

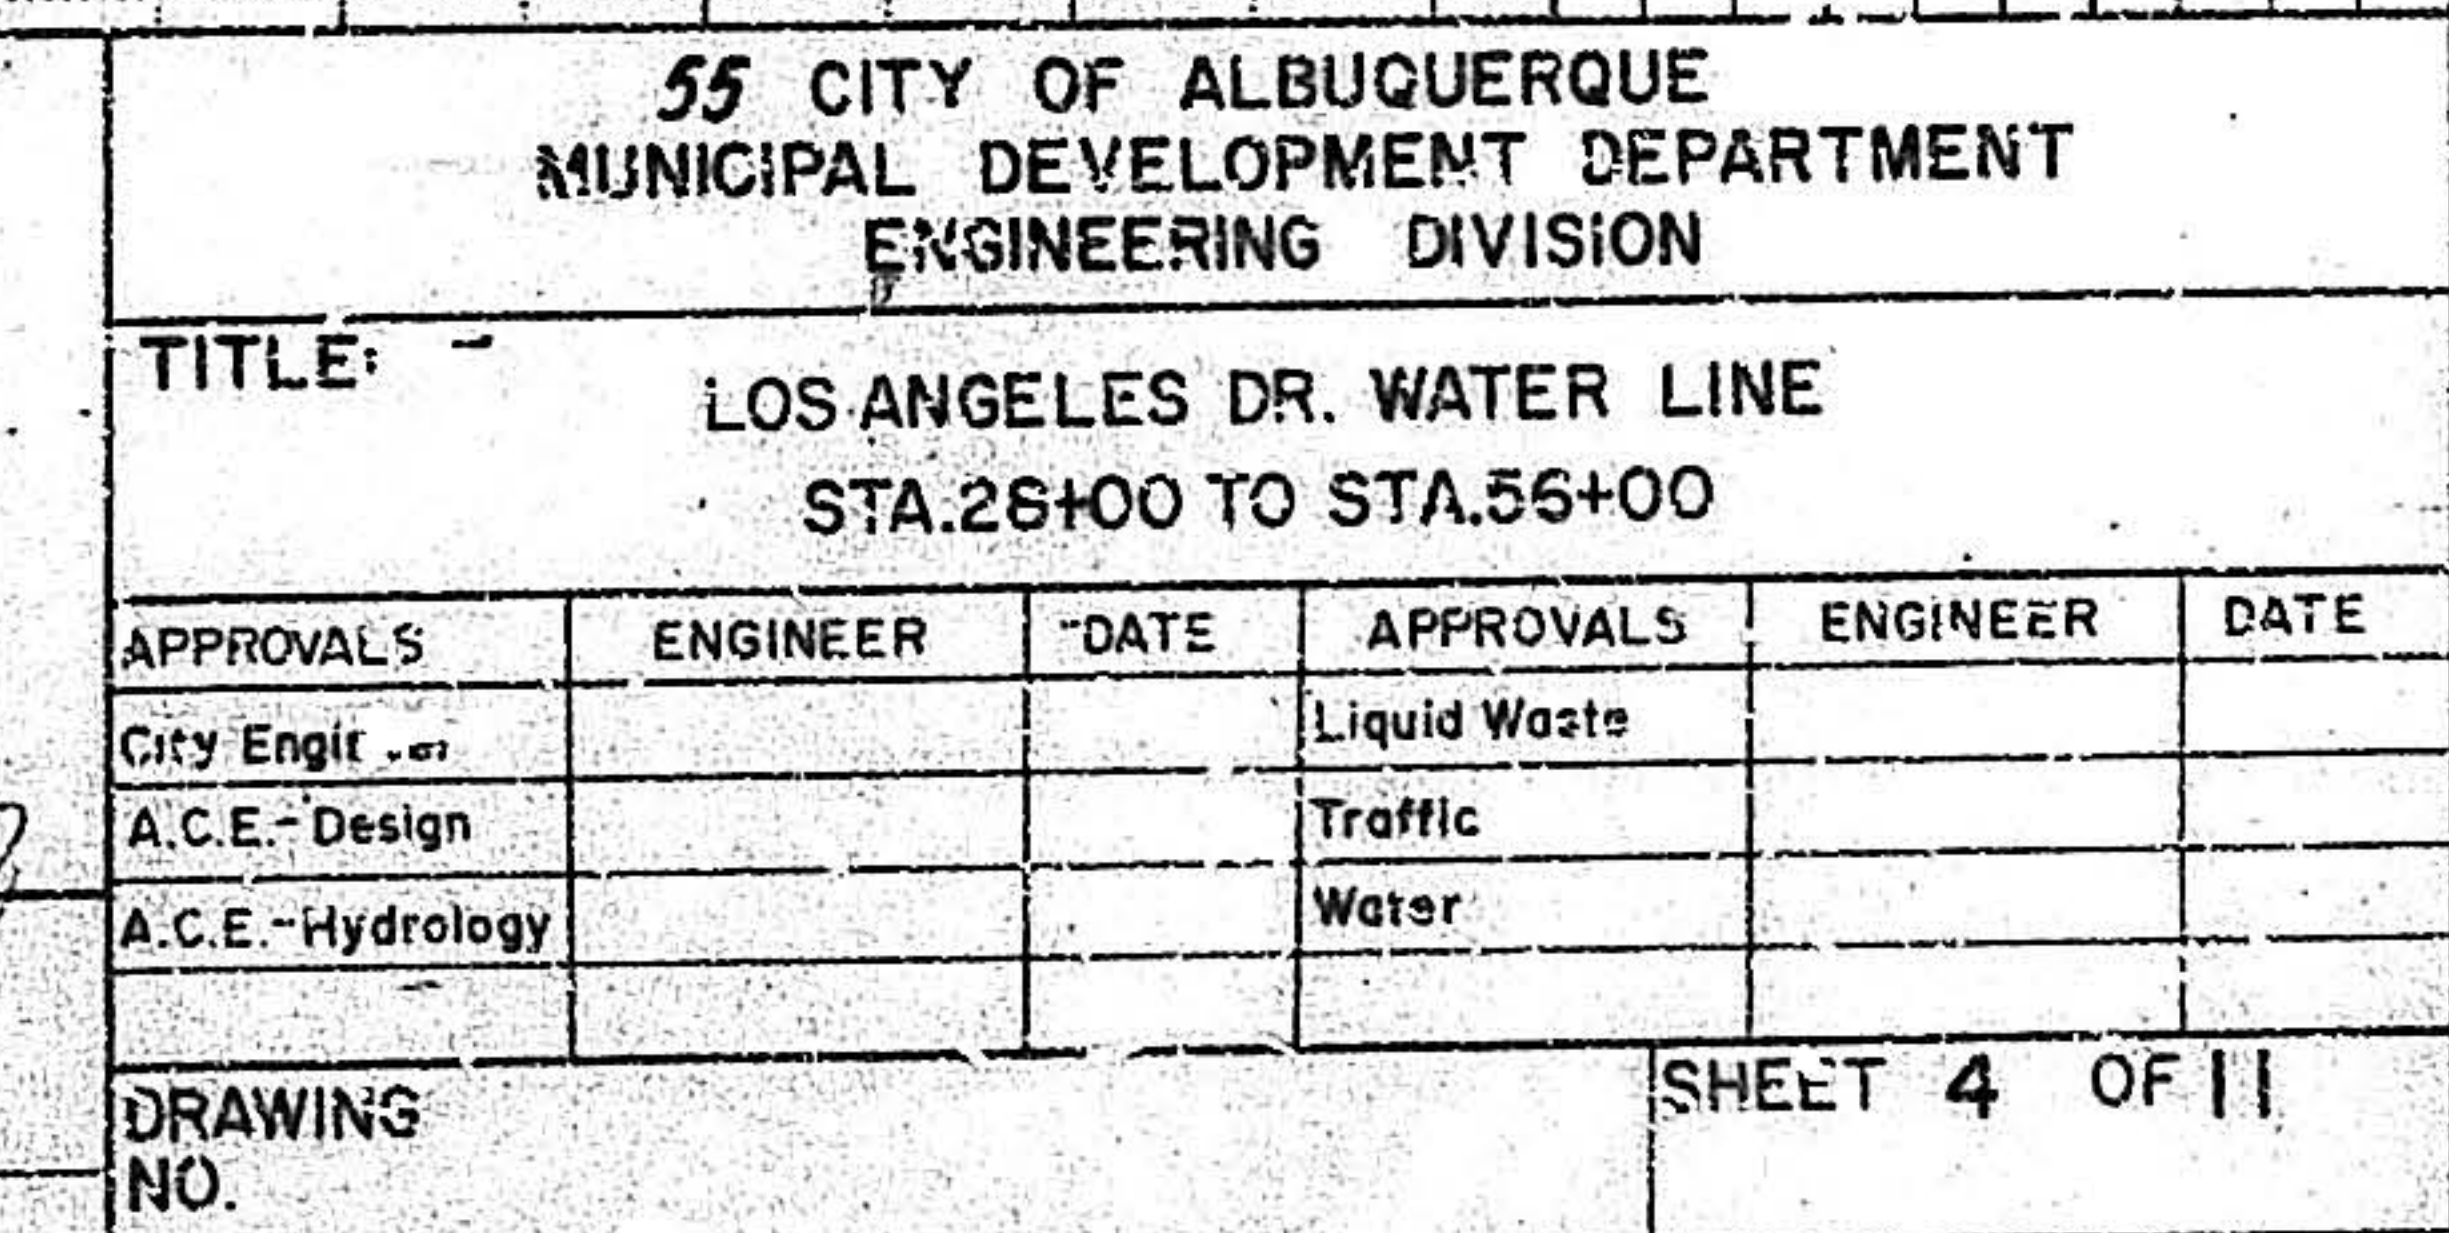

  [illegible]

NORTH ALBUQUERQUE ACRES

BLOCK 20 TRACT 3 UNIT 1

STA 92+21.00 W.L.
(45' RT SVY STA 92+21.00)
1-48" 30° Bend
216' Rigid joints west
78' Rigid joints south

LOS ANGELES


DRIVE

WALKER
RESERVOIR SITE

STA 93+09.80 W.L.
(133' RT SVY STA 92+21.00)
End of construction
1-48" Blind Flange
1-1" Corp. Stop (For Testing)

48" Water Line by Others

SCALES:
Horiz: 1"=100'
Vert: 1"=10'

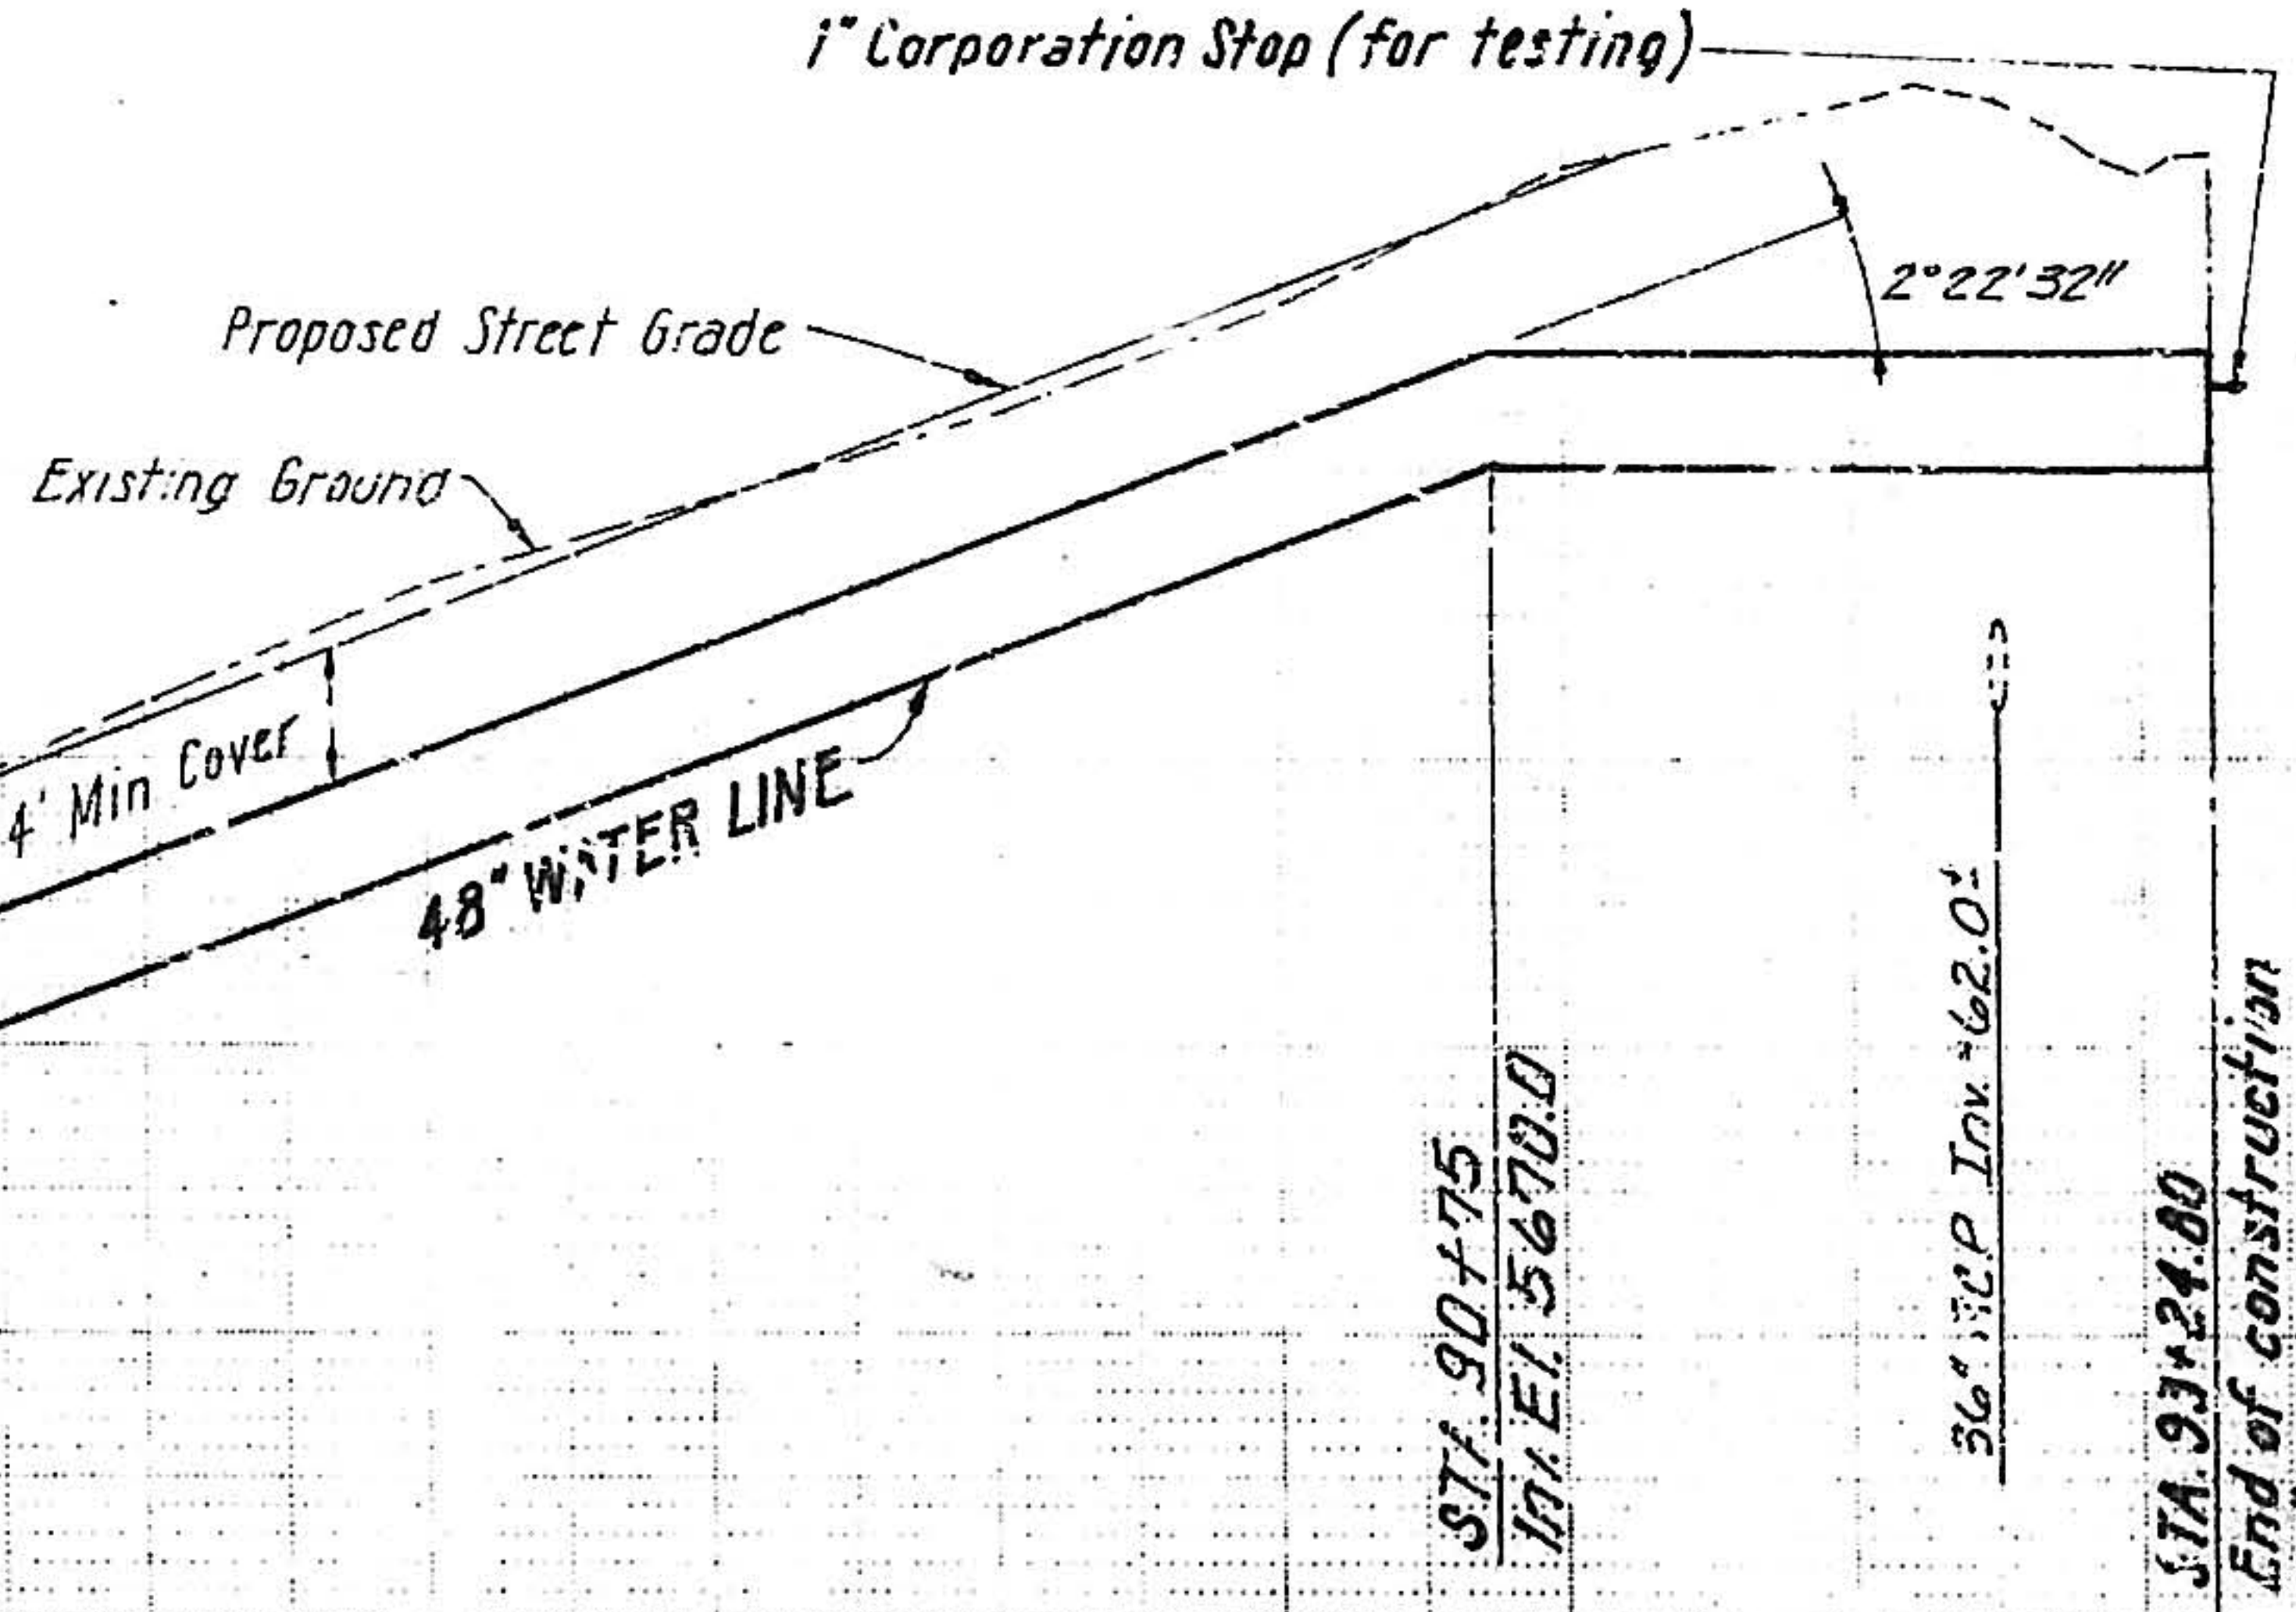


WORK RESOURCES DEPARTMENT
APPROVAL OF AS BUILT DRAWINGS
Charles G. H. H. H.
Date: 12.3.1982

PREPARED UNDER THE
DIRECTION OF
G. L. HERKENHOFF
CITY ENGINEER
APPROVED FOR
CONSTRUCTION
CITY ENGINEER DATE

CITY OF ALBUQUERQUE MUNICIPAL DEVELOPMENT DEPARTMENT ENGINEERING DIVISION					
TITLE: LOS ANGELES DR. WATER LINE STA.94+00 TO STA.93+24.80					
APPROVALS	ENGINEER	DATE	APPROVALS	ENGINEER	DATE
City Engineer			Liquid Waste		
A.C.E. - Design			Traffic		
A.C.E. - Hydrology			Water		
DRAWING NO.			SHEET 6 OF 11		

RECORD DRAWING
DATE DEC 1 1981

ALAMEDA TRUNK ZONE 4E

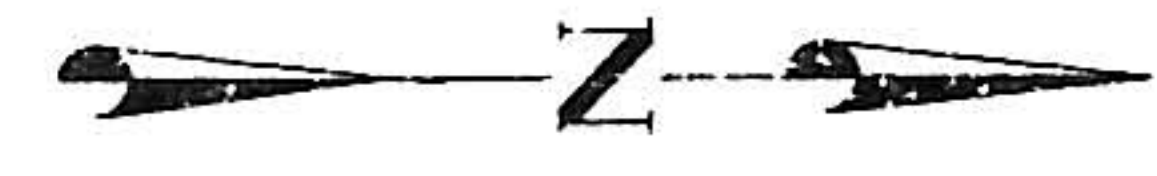

$$\frac{PI \text{ Sta } 11+73.14}{PI \text{ Sta } 52+90.73}$$

STA. 52+41.53 W.L.
(45' Pt Los Angeles Svy Sta 52+41.53)
Connect to 12" outlet
this Project.

36" R.C.P.
This Project
See Street 9

STA. 5+28.00 - 2" W.L.
End Construction 12"
W.L. Connect to 12"
Outlet this Project


CITY OF ALBUQUERQUE MUNICIPAL DEVELOPMENT DEPARTMENT ENGINEERING DIVISION						
TITLE: VENTURA ST. WATER LINE STA.0+00 TO 5+43.00						
APPROVALS	ENGINEER	DATE	APPROVALS	ENGINEER	DATE	
City Engineer			Liquid Waste			
A.C.E. - Design			Traffic			
A.C.E. - Hydrology			Water			
7						
DRAWING NO.				SHEET 7 OF 11		

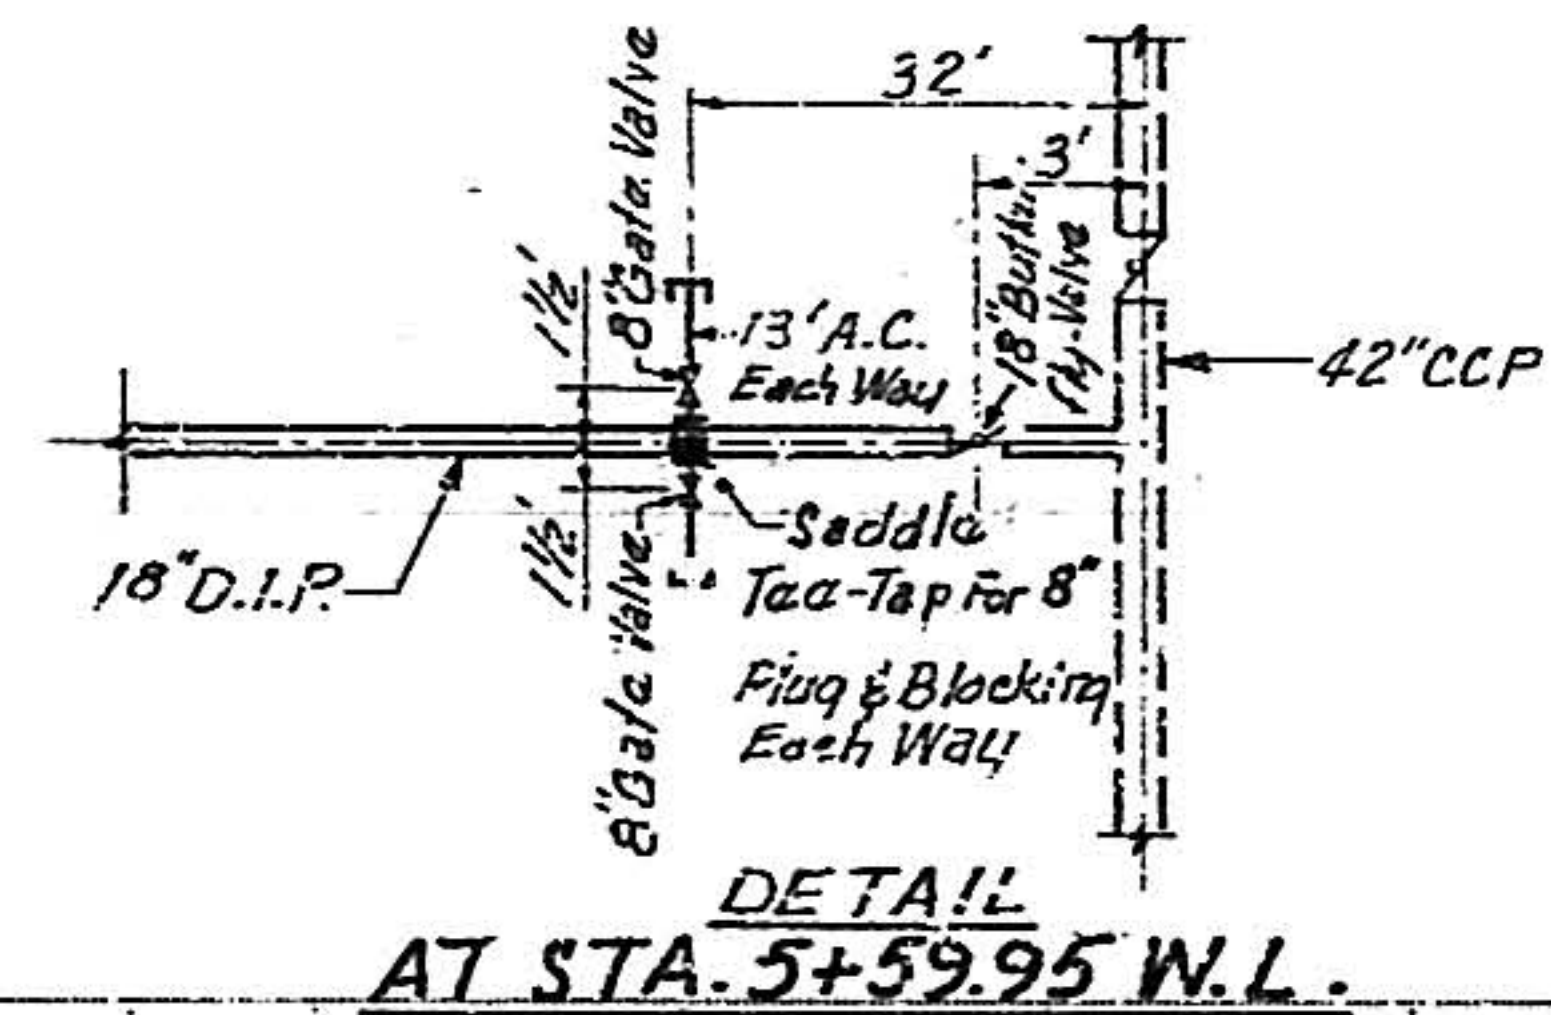



SCALES:
 Horiz: 1" = 100'
 Vert: 1" = 10'



RECORD DRAWING
DATE DEC 1 6 1921

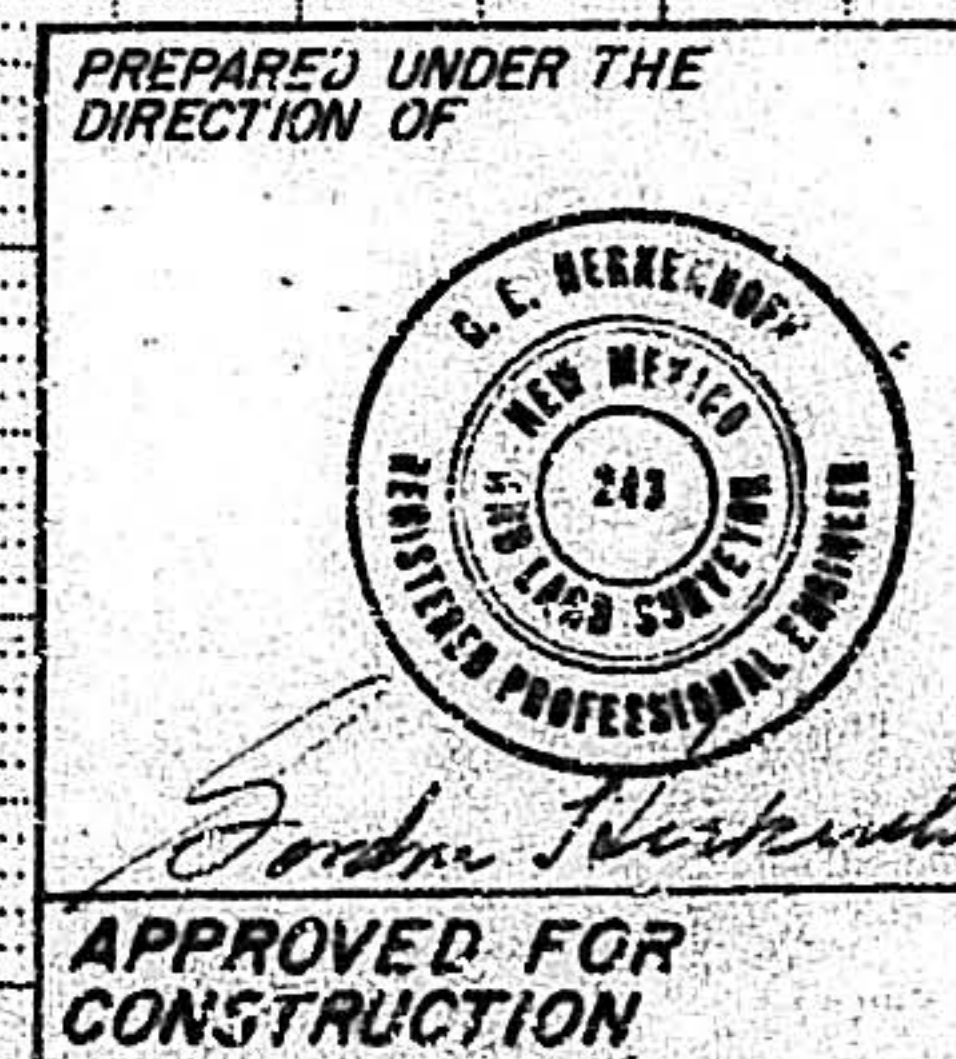


CITY OF ALBUQUERQUE MUNICIPAL DEVELOPMENT DEPARTMENT ENGINEERING DIVISION				
TITLE: BARSTOW ST. WATER LINE STA. 0+00 TO STA. 4+98 ROUGH RIDER ST. WATER LINE STA. 0+41.95 TO STA. 6+04.95				
APPROVALS	ENGINEER	DATE	APPROVALS	ENGINEER
City Eng. <i>[Signature]</i>			Liquid Waste	
A.C.E. Design			Traffic	
A.C.E. Hydrology			Water	
DRAWING NO.			SHEET 8 OF 11	

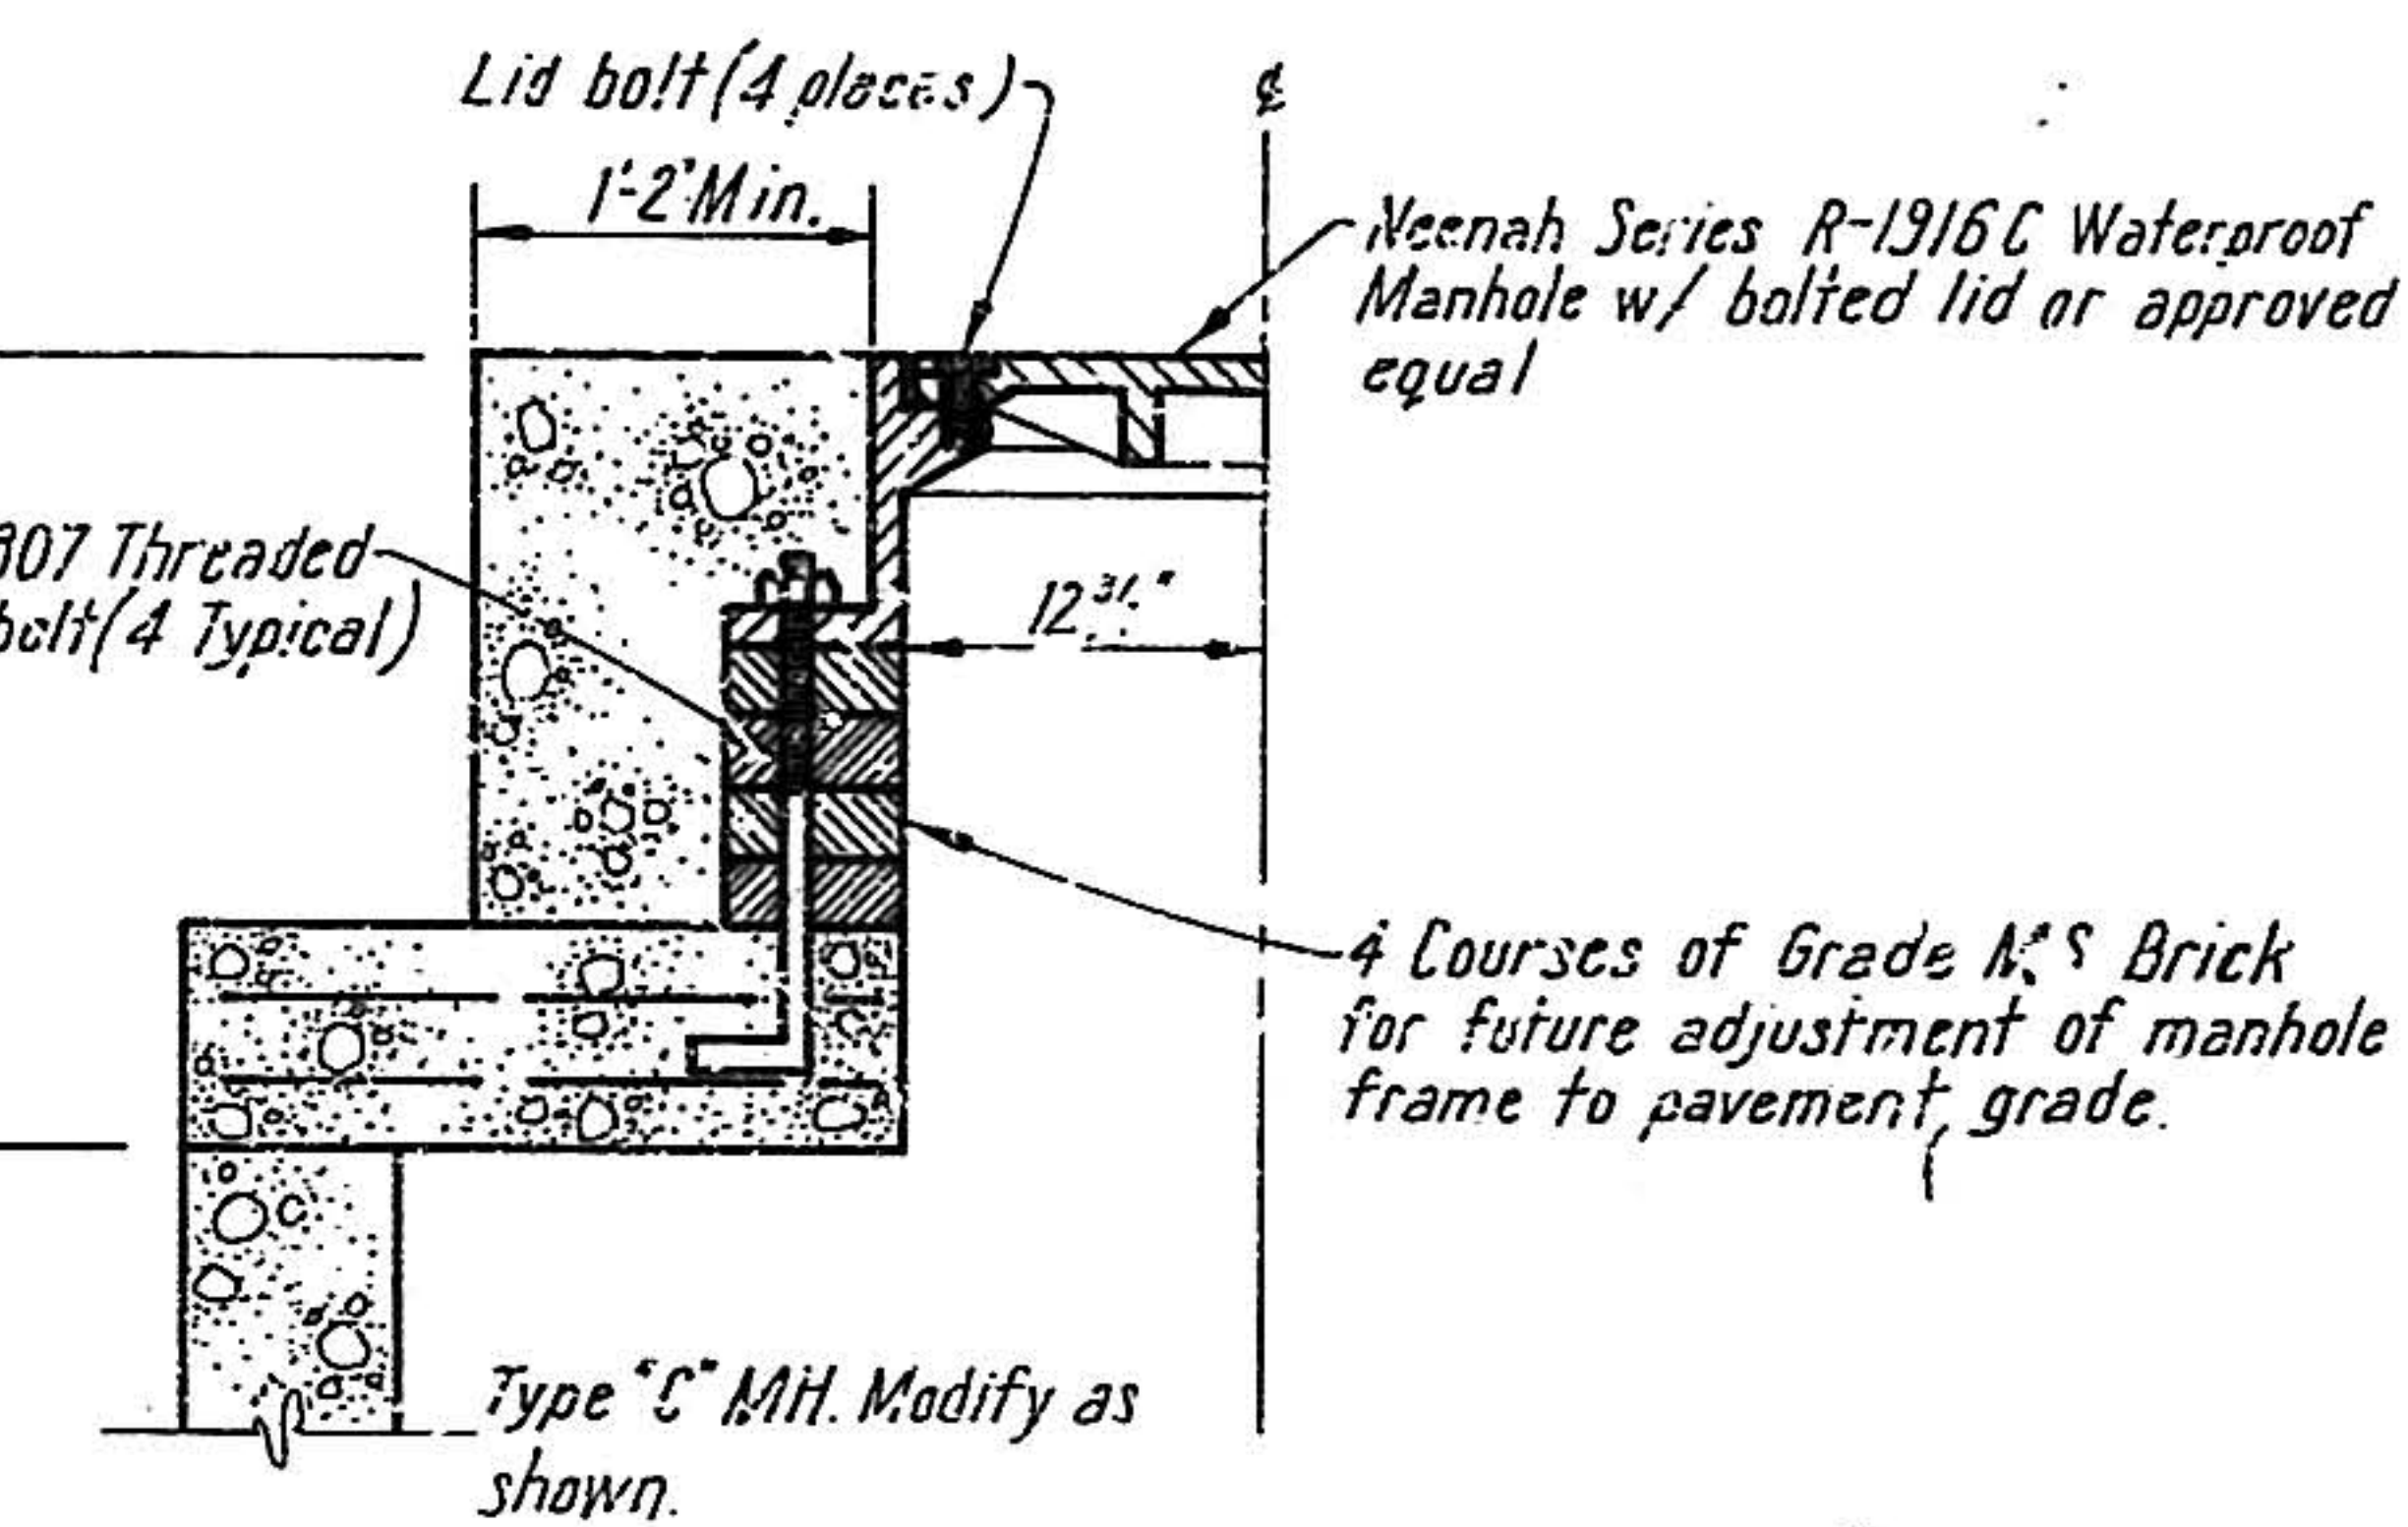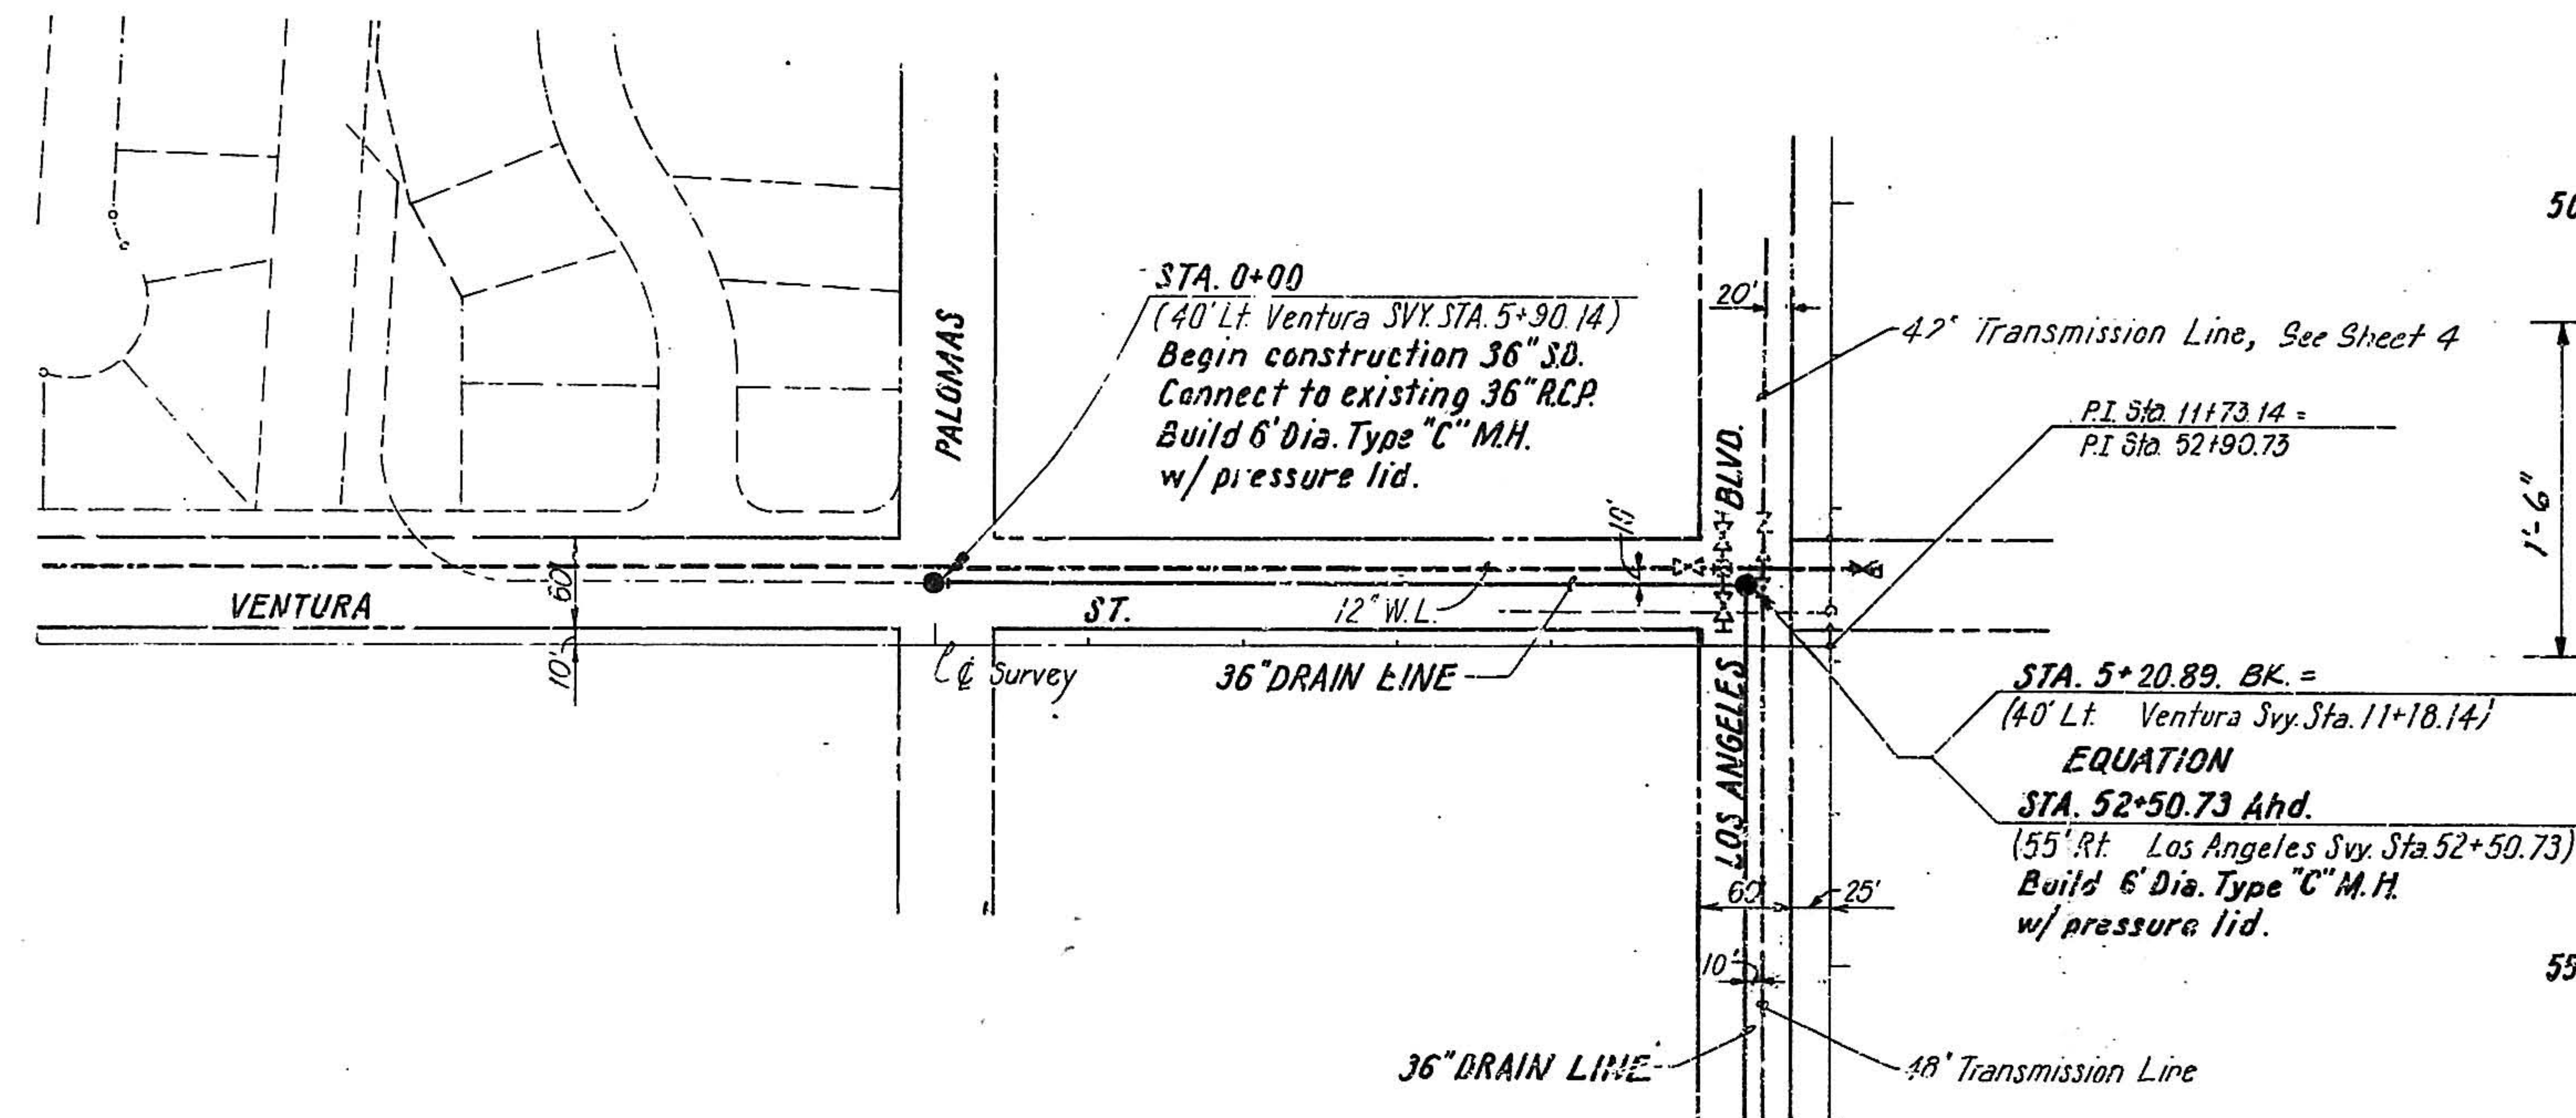

PRESSURE MANHOLE LID DETAIL
Not to Scale

NOTE: No Extra Payment for Pressure Manhole Lid

SCALES:
Horiz: 1"=100'
Vert: 1"=10'

 

WATER RESOURCES DEPARTMENT
APPROVAL OF AS-BUILT DRAWINGS
C. L. DEBERRY
DATE: Feb. 3, 1982

RECORD DRAWING
DATE: DEC 1 1981

ALAMEDA TRUNK ZONE 4E



APPROVED FOR
CONSTRUCTION
CITY ENGINEER
DATE



CITY OF ALBUQUERQUE MUNICIPAL DEVELOPMENT DEPARTMENT ENGINEERING DIVISION					
TITLE: VENTURA ST. DRAIN LINE STA. 0+00 TO STA. 5+28 STA. 52+50.73 TO STA. 56+00					
APPROVALS	ENGINEER	DATE	APPROVALS	ENGINEER	DATE
City Engineer			Liquid Waste		
A.C.E. Design			Traffic		
A.C.E. Hydrology			Water		
DRAWING NO.			SHEET 9 OF 11		

AS BUILT INFORMATION		BENCH MARKS		SURVEY INFORMATION		REFERENCES	
CONTRACTOR: New Concepts, Inc.	DATE	1-C20 A ELEV. = 5478.057	DATE	NO.	BY	MAP NO.	NO.
WORKED BY: GH/H	DATE	1-C21 A ELEV. = 5654.65	DATE	NO.	BY	EST. NO.	NO.
FIELD ACCEPTANCE BY: BL Speckhart 0/23	DATE		DATE	NO.	BY		NO.
DRAWING NO. 11-1	DATE		DATE	NO.	BY		NO.
MICRO-FILM INFORMATION	DATE		DATE	NO.	BY		NO.
RECORDED BY	DATE		DATE	NO.	BY		NO.


NORTH ALBUQUERQUE ACRES

BLOCK 20 TRACT 3 UNIT 3

BLOCK 41 TRACT A UNIT A

  

AS BUILT INFORMATION				BENCH MARKS				SURVEY INFORMATION				REFERENCES			
CONTRACTOR	NEW CONCRETE, INC.	DATE		WORK	GHVA	DATE		MAP NO.	EST. NO.	BY	DATE	MAP NO.	EST. NO.	BY	DATE
STATIONED BY	GHVA	DATE		FIELD	GHVA	DATE		NO.	WO. NO.	NO.	DATE	NO.	WO. NO.	NO.	DATE
ACCEPTANCE BY	CLAUDE A. FLETCHER, D.E.R.	DATE		REVISIONS		DATE		DESIGNED BY	DATE	DRAWN BY	DATE	REVISIONS		DATE	
RECORDED BY	GHVA	DATE		DESIGNED BY		DATE		DRAWN BY	DATE	CHECKED BY	DATE	REVISIONS		DATE	
NO.				NO.				NO.		NO.		NO.		NO.	

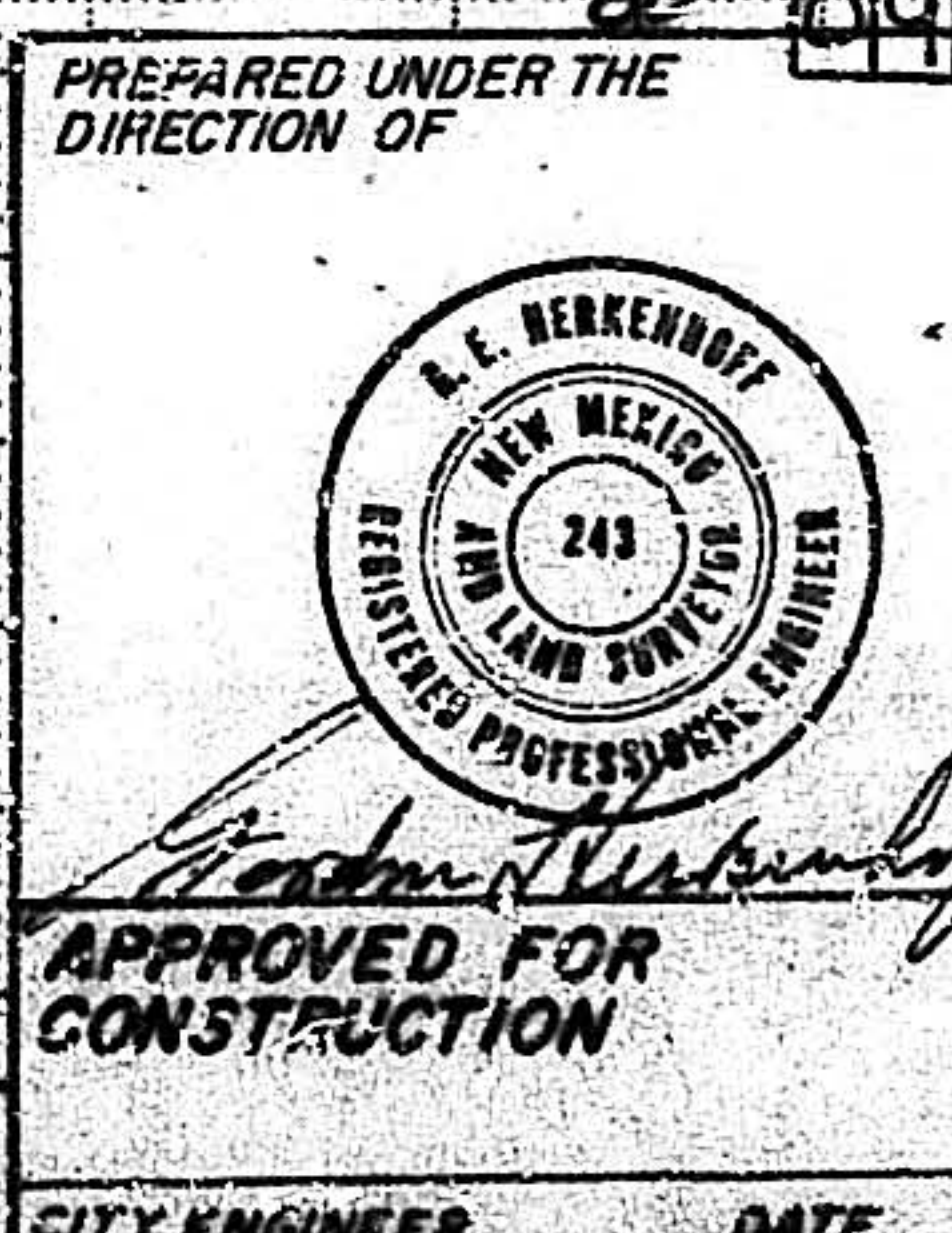

WATER RESOURCES DEPARTMENT
APPROVAL OF AS BUILT DRAWINGS
RECORD DRAWING
DATE DEC 1, 1981
APPROVED FOR CONSTRUCTION
CITY ENGINEER DATE

CITY OF ALBUQUERQUE
MUNICIPAL DEVELOPMENT DEPARTMENT
ENGINEERING DIVISION


TITLE: LOS ANGELES DR. DRAIN LINE
STA. 56+00 TO STA. 84+00

APPROVALS	ENGINEER	DATE	APPROVALS	ENGINEER	DATE
CITY ENGINEER			Liquid Waste		
A.C.E. - Design			Traffic		
A.C.E. - Hydrology			Water		


DRAWING NO. SHEET 10 OF 11

NORTH ALBUQUERQUE ACRES

BLOCK 20 TRACT 3 UNIT 1

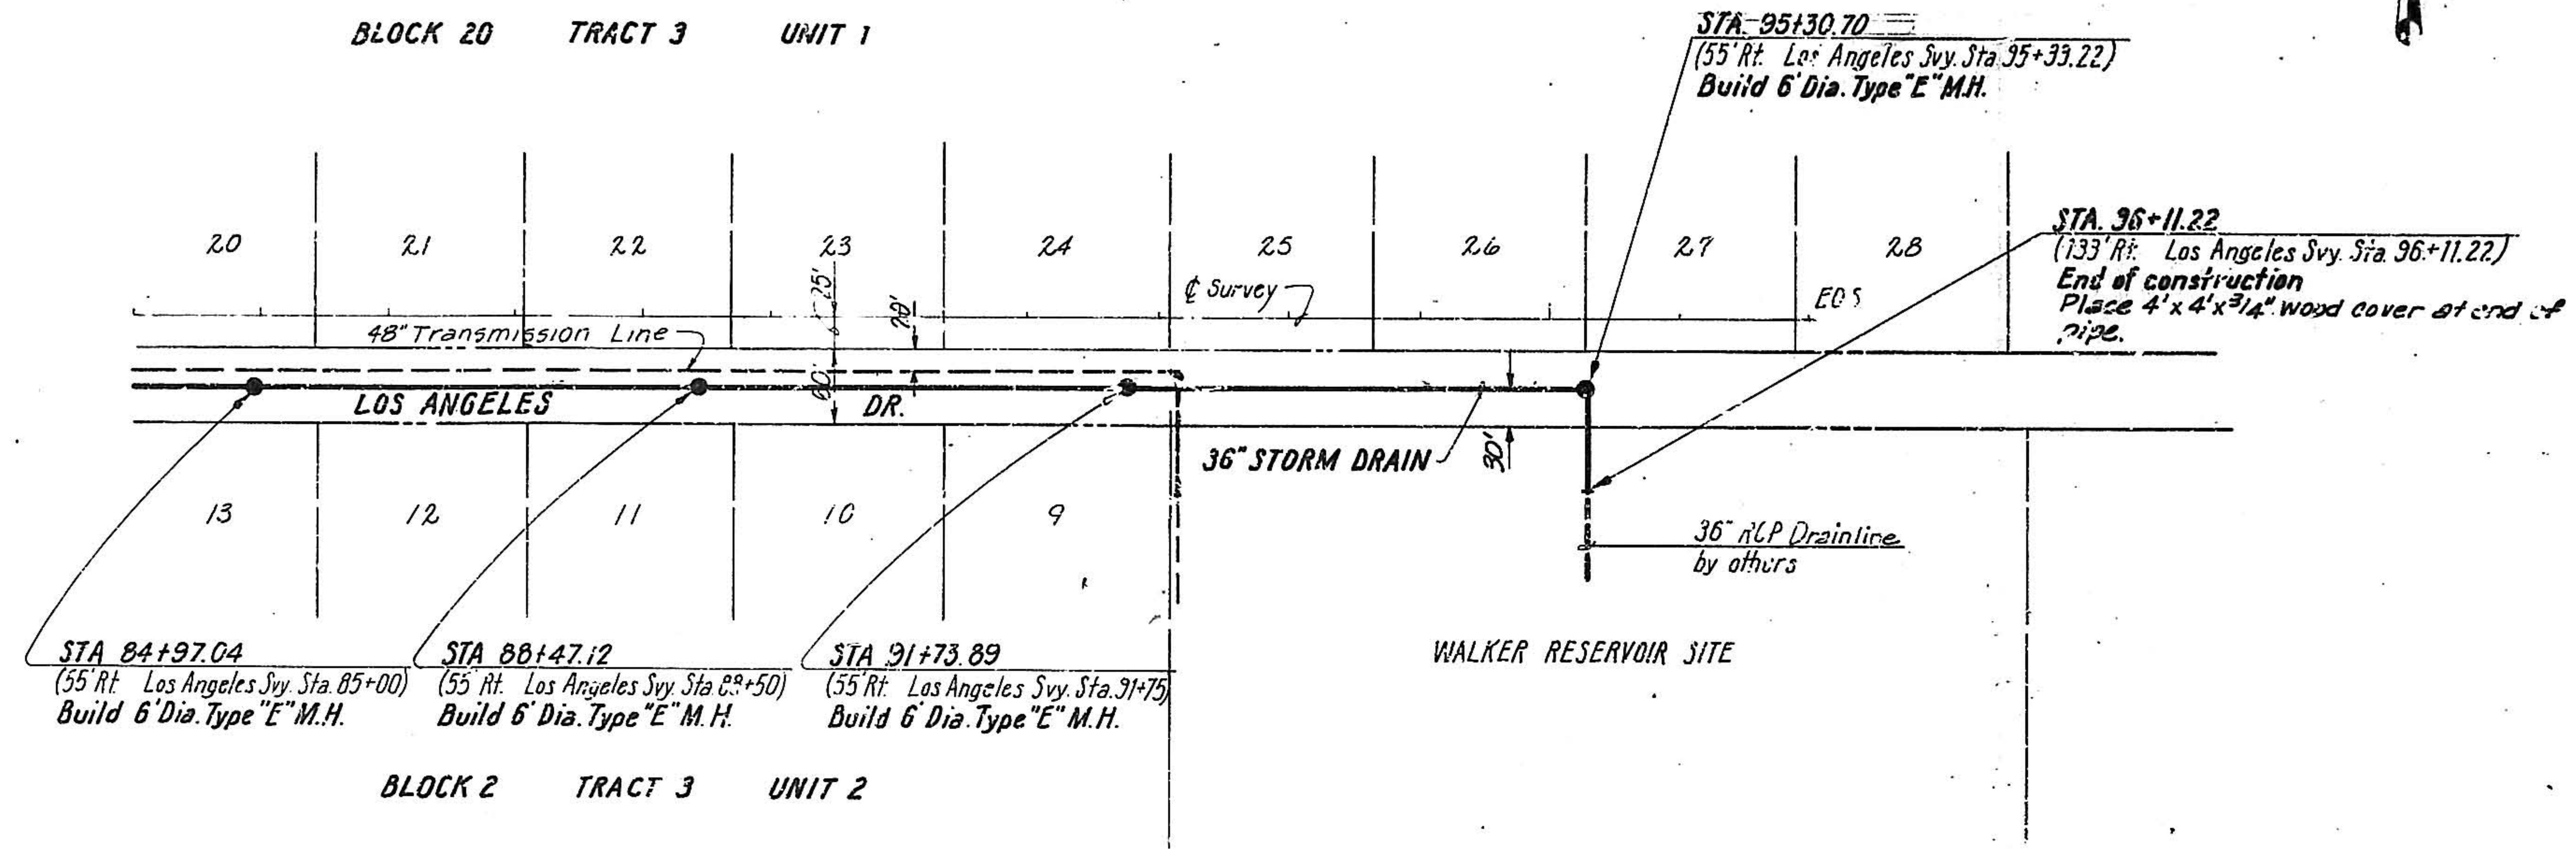


BLOCK 2 TRACT 3 UNIT 2

 

SCALES:
Horiz. 1"=100'
Vert. 1"=2'

RECORD DRAWING
DATE DEC 1 1981

WATER RESOURCES DEPARTMENT
APPROVAL OF AS BUILT DRAWINGS
Claude A. Piller
Date Feb 3, 1982

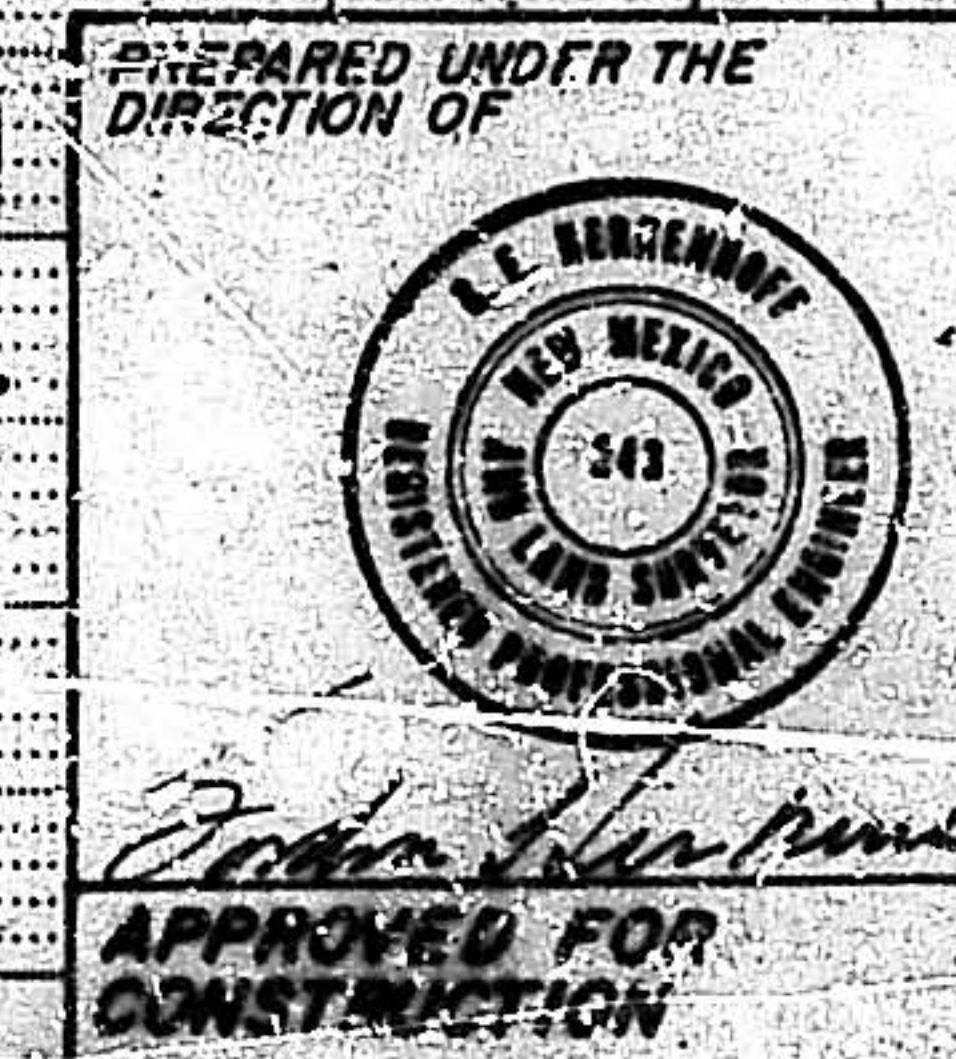

CITY OF ALBUQUERQUE MUNICIPAL DEVELOPMENT DEPARTMENT ENGINEERING DIVISION				
TITLE: LOS ANGELES DR. DRAIN LINE STA 84+00 TO STA 96+11.22				
APPROVALS	ENGINEER	DATE	APPROVALS	ENGINEER
CITY ENGINEER			Liquid Waste	
A.C.E. Design			Traffic	
A.C.E. Hydrology			Water	
DRAWING NO.		SHEET 11 OF 11		

AS BUILT INFORMATION		BENCH MARKS		SURVEY INFORMATION		REFERENCES		REVISIONS	
CONTRACTOR	Map Concepts, Inc.	1-C21A	ELEV. = 5634.65	MAP NO.	EST. NO.	WO. NO.	BY	NO.	DATE
STAMPED BY	G.H.A.	DATE							
APPROVED BY	CLAUDE A. PILLER	DATE							
FIELD CHECKED BY	B.L. SOUTHWICK	DATE							
CONDUCTED BY	G.H.A.	DATE							
MICRO-FILM INFORMATION		REMARKS		DESIGN		DATE		DATE	
RECORDED BY									
NO.									