


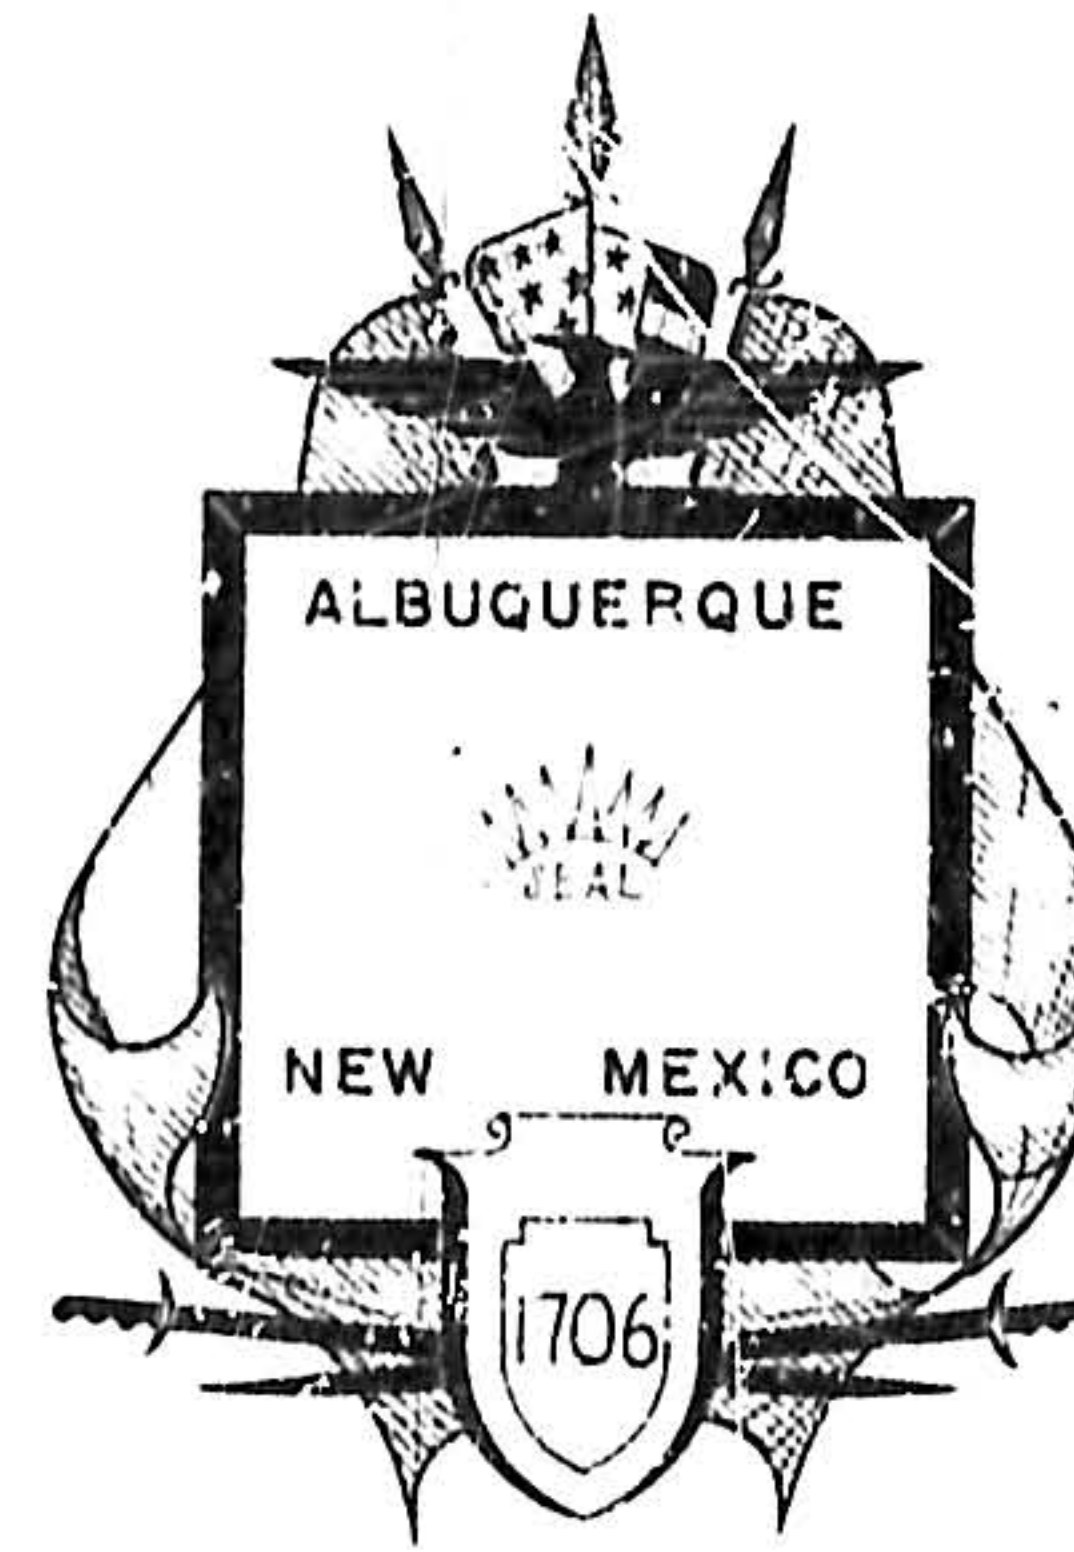

CITY OF ALBUQUERQUE  
DEPARTMENT OF PUBLIC WORKS

PLANS FOR  
CONSTRUCTION OF  
AS BUILTS

MILES TRANSMISSION LINE

|    |     
|----|-----|------|---|---|---|---|---|---|----|----|----|----|----|----|----|----|----|----|----|----|----|----|----|----|----|----|----|----|
| 1  | 2   | 3    | 4 | 5 | 6 | 7 | 8 | 9 | 10 | 11 | 12 | 13 | 14 | 15 | 16 | 17 | 18 | 19 | 20 | 21 | 22 | 23 | 24 | 25 | 26 | 27 | 28 | 29 |
| 09 | 006 | 0175 |   |   |   |   |   |   |    |    |    |    |    |    |    |    |    | 20 |    |    |    |    |    |    |    |    |    |    |



GORDON HERKENHOFF AND ASSOCIATES


ENGINEERS

RECORD DRAWING  
DATE 8/1/3

PLANNERS



BRUNING 44122

 


RECORD DRAWING  
DATE

09 006 0275 21

|                                           |                 |
|-------------------------------------------|-----------------|
| <b>ALBUQUERQUE - NEW MEXICO</b>           |                 |
| MILES TRANSMISSION LINE                   |                 |
| MILES TRANSMISSION LINES<br>PHASE 1 AND 2 | SEP '73<br>DATE |
| LOCATION MAP                              |                 |
| SCALE                                     |                 |
| GORDON HERKENHOFF & ASSOCIATES, INC.      |                 |
| ENGINEERS • PLANNERS                      |                 |
| ALBUQUERQUE                               | NEW MEXICO      |




|                |                           |    |      |
|----------------|---------------------------|----|------|
| <b>PROFILE</b> | SURVEYED                  | BY | DATE |
| NOTE BOOK      | PLOTTED                   |    |      |
| NO.            | GRADES CHECKED            |    |      |
|                | 1 M NOTED                 |    |      |
|                | STRUCTURE NOTATING NUMBER |    |      |


 




|                                        |   |          |            |
|----------------------------------------|---|----------|------------|
| <b>PROFILE</b><br><br>NOTE BOOK<br>NO. | SURVEYED _____<br>PLOTTED _____<br>L. RADES CHECKED _____<br>B. M. & NOTED _____<br>STRUCTURE NOTATIONS CHK'D _____                                                           | BY _____ | DATE _____ |
|                                        | <small>1. SURVEYED BY: _____<br/>2. PLOTTED BY: _____<br/>3. L. RADES CHECKED BY: _____<br/>4. B. M. &amp; NOTED BY: _____<br/>5. STRUCTURE NOTATIONS CHK'D BY: _____</small> |          |            |

 




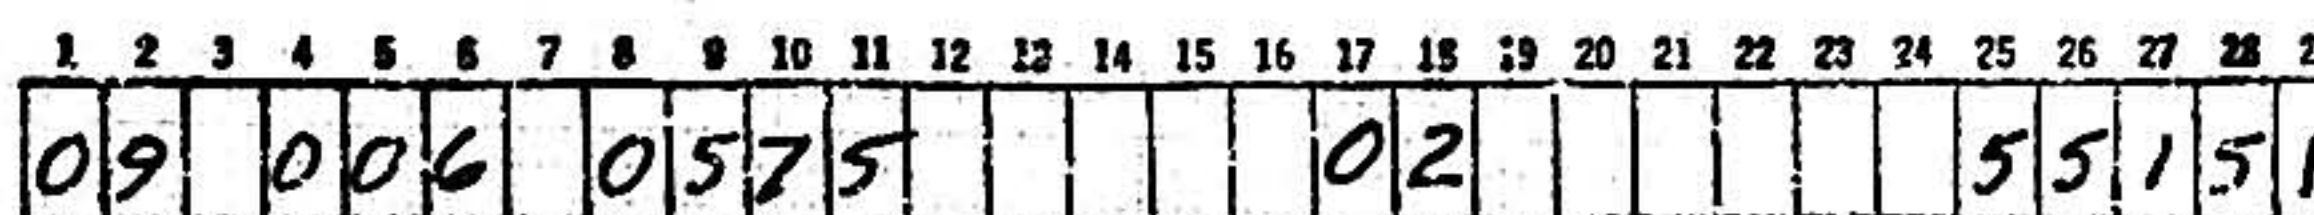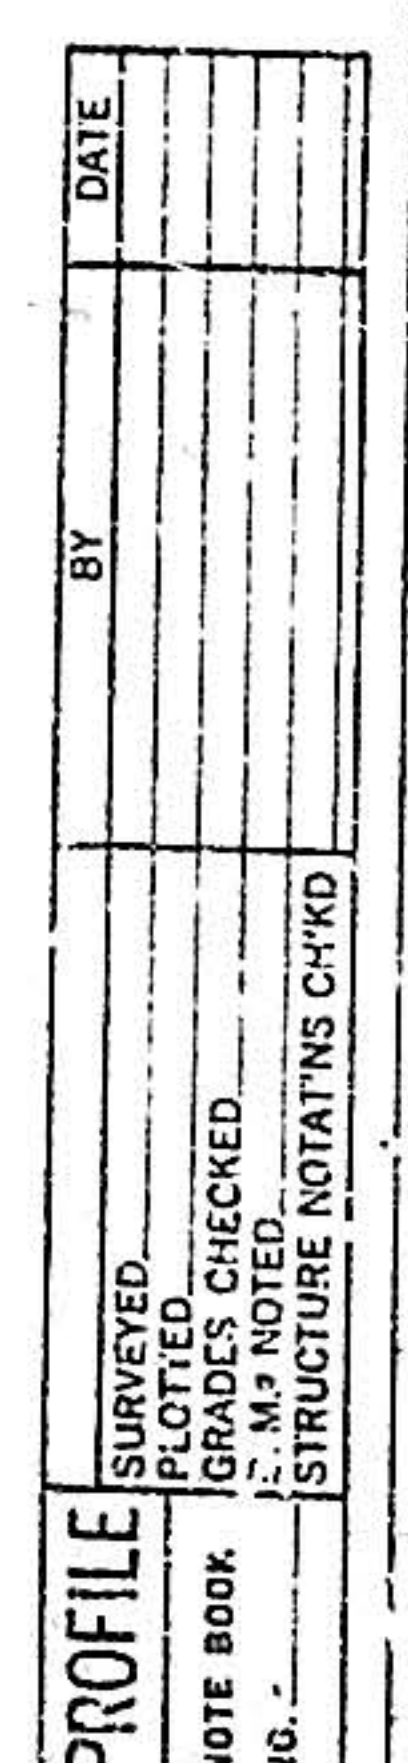






 





 






 






 

# PHASE 2

Scale  
Horizontal 1" = 50.0'  
Vertical 1" = 10.0'

 


|    |    
|----|----|----|----|----|---|---|---|---|----|----|----|----|----|----|----|----|----|----|----|----|----|----|----|----|----|----|----|----|
| 1  | 2  | 3  | 4  | 5  | 6 | 7 | 8 | 9 | 10 | 11 | 12 | 13 | 14 | 15 | 16 | 17 | 18 | 19 | 20 | 21 | 22 | 23 | 24 | 25 | 26 | 27 | 28 | 29 |
| 09 | 00 | 06 | 09 | 75 |   |   |   |   |    |    |    |    |    |    |    | 02 |    |    |    |    |    |    |    |    |    | 55 | 16 | 1  |

RECORD DRAWING  
DATE FEB 3 1976







 



|                 |                          |          |            |
|-----------------|--------------------------|----------|------------|
| PROFILE         | SURVEYED _____           | BY _____ | DATE _____ |
|                 | PLOTTED _____            |          |            |
|                 | GRADES CHECKED _____     |          |            |
|                 | B.M.# NOTED _____        |          |            |
| NO. _____       |                          |          |            |

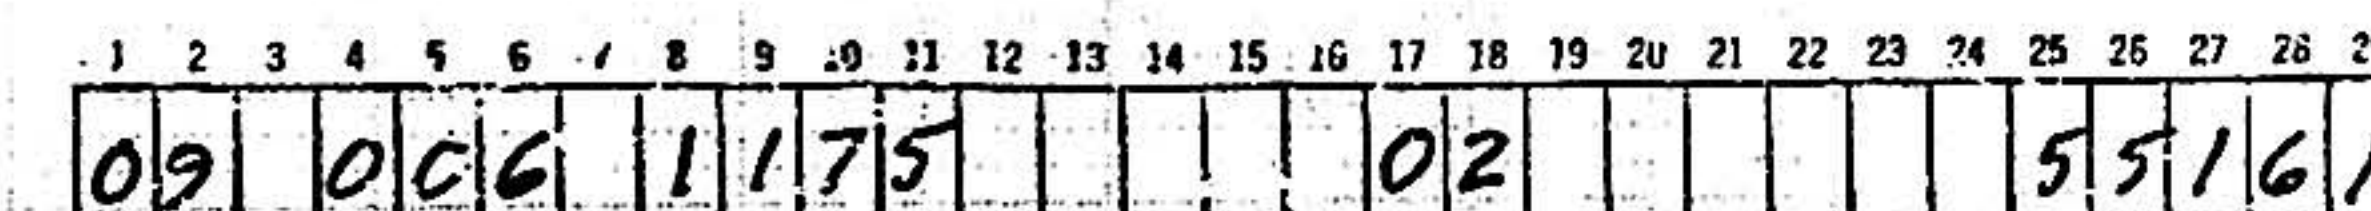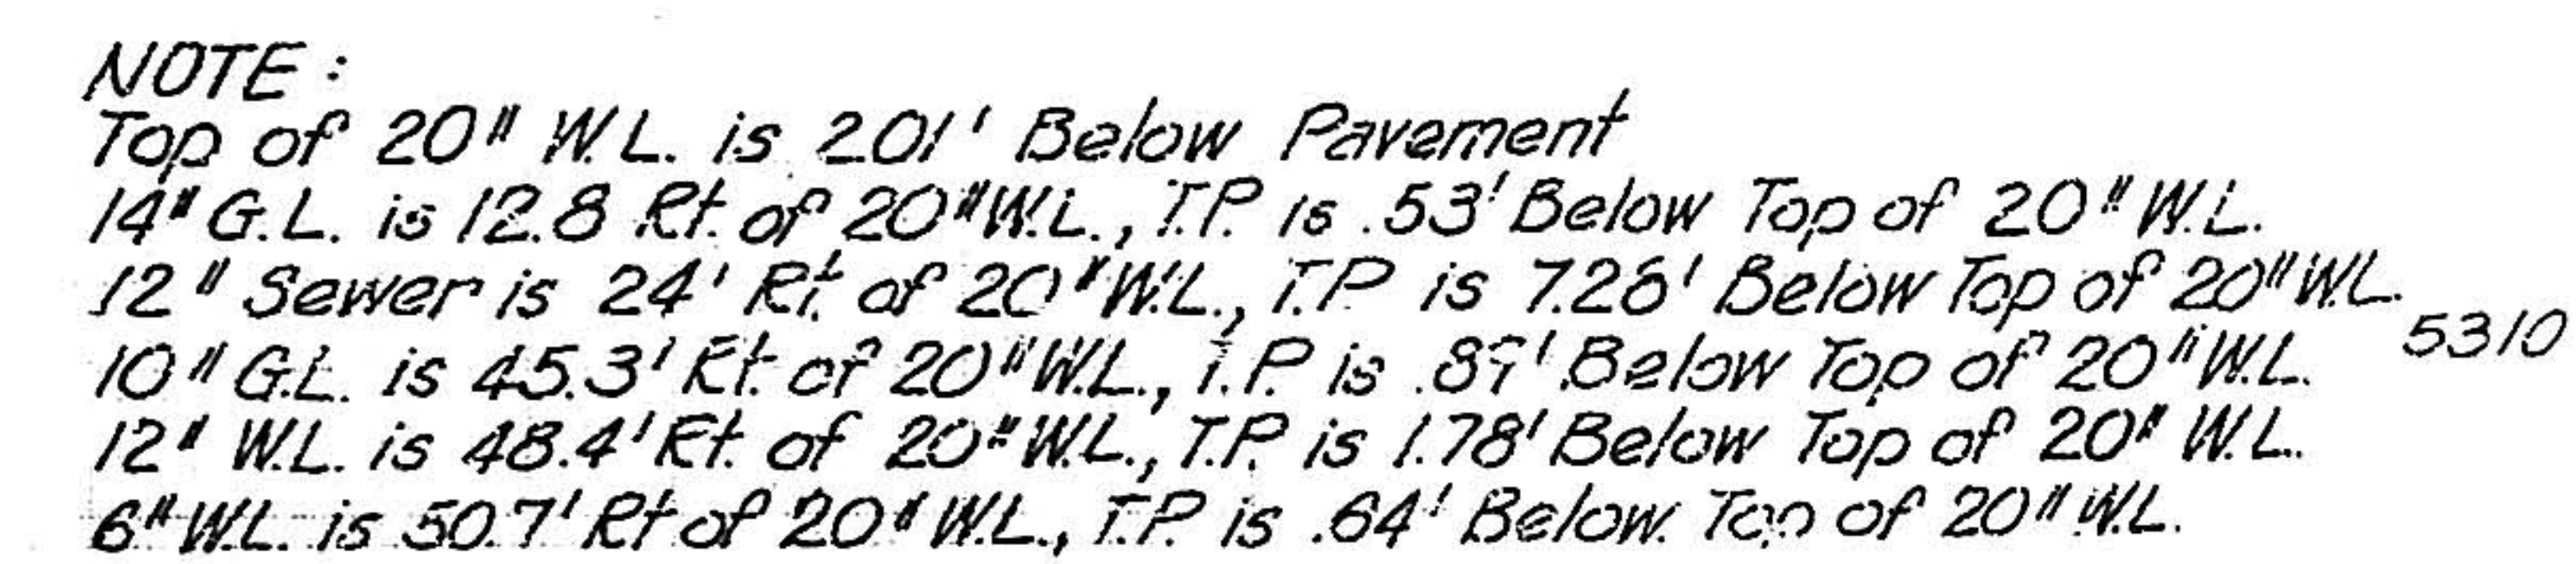

RECORD DRAWING



Revised July 10, 1974

MILES TRANSMISSION LINES

ET 11 QF 23




|           |                         |    |      |
|-----------|-------------------------|----|------|
| PROFILE   | SURVIVED                | BY | DATE |
| NOTE BOOK | NOTED                   |    |      |
| NO.       | GRADE'S CHECKED         |    |      |
|           | B.M.'S NOTED            |    |      |
|           | STRUCTURE NOTAT'NS CHKD |    |      |

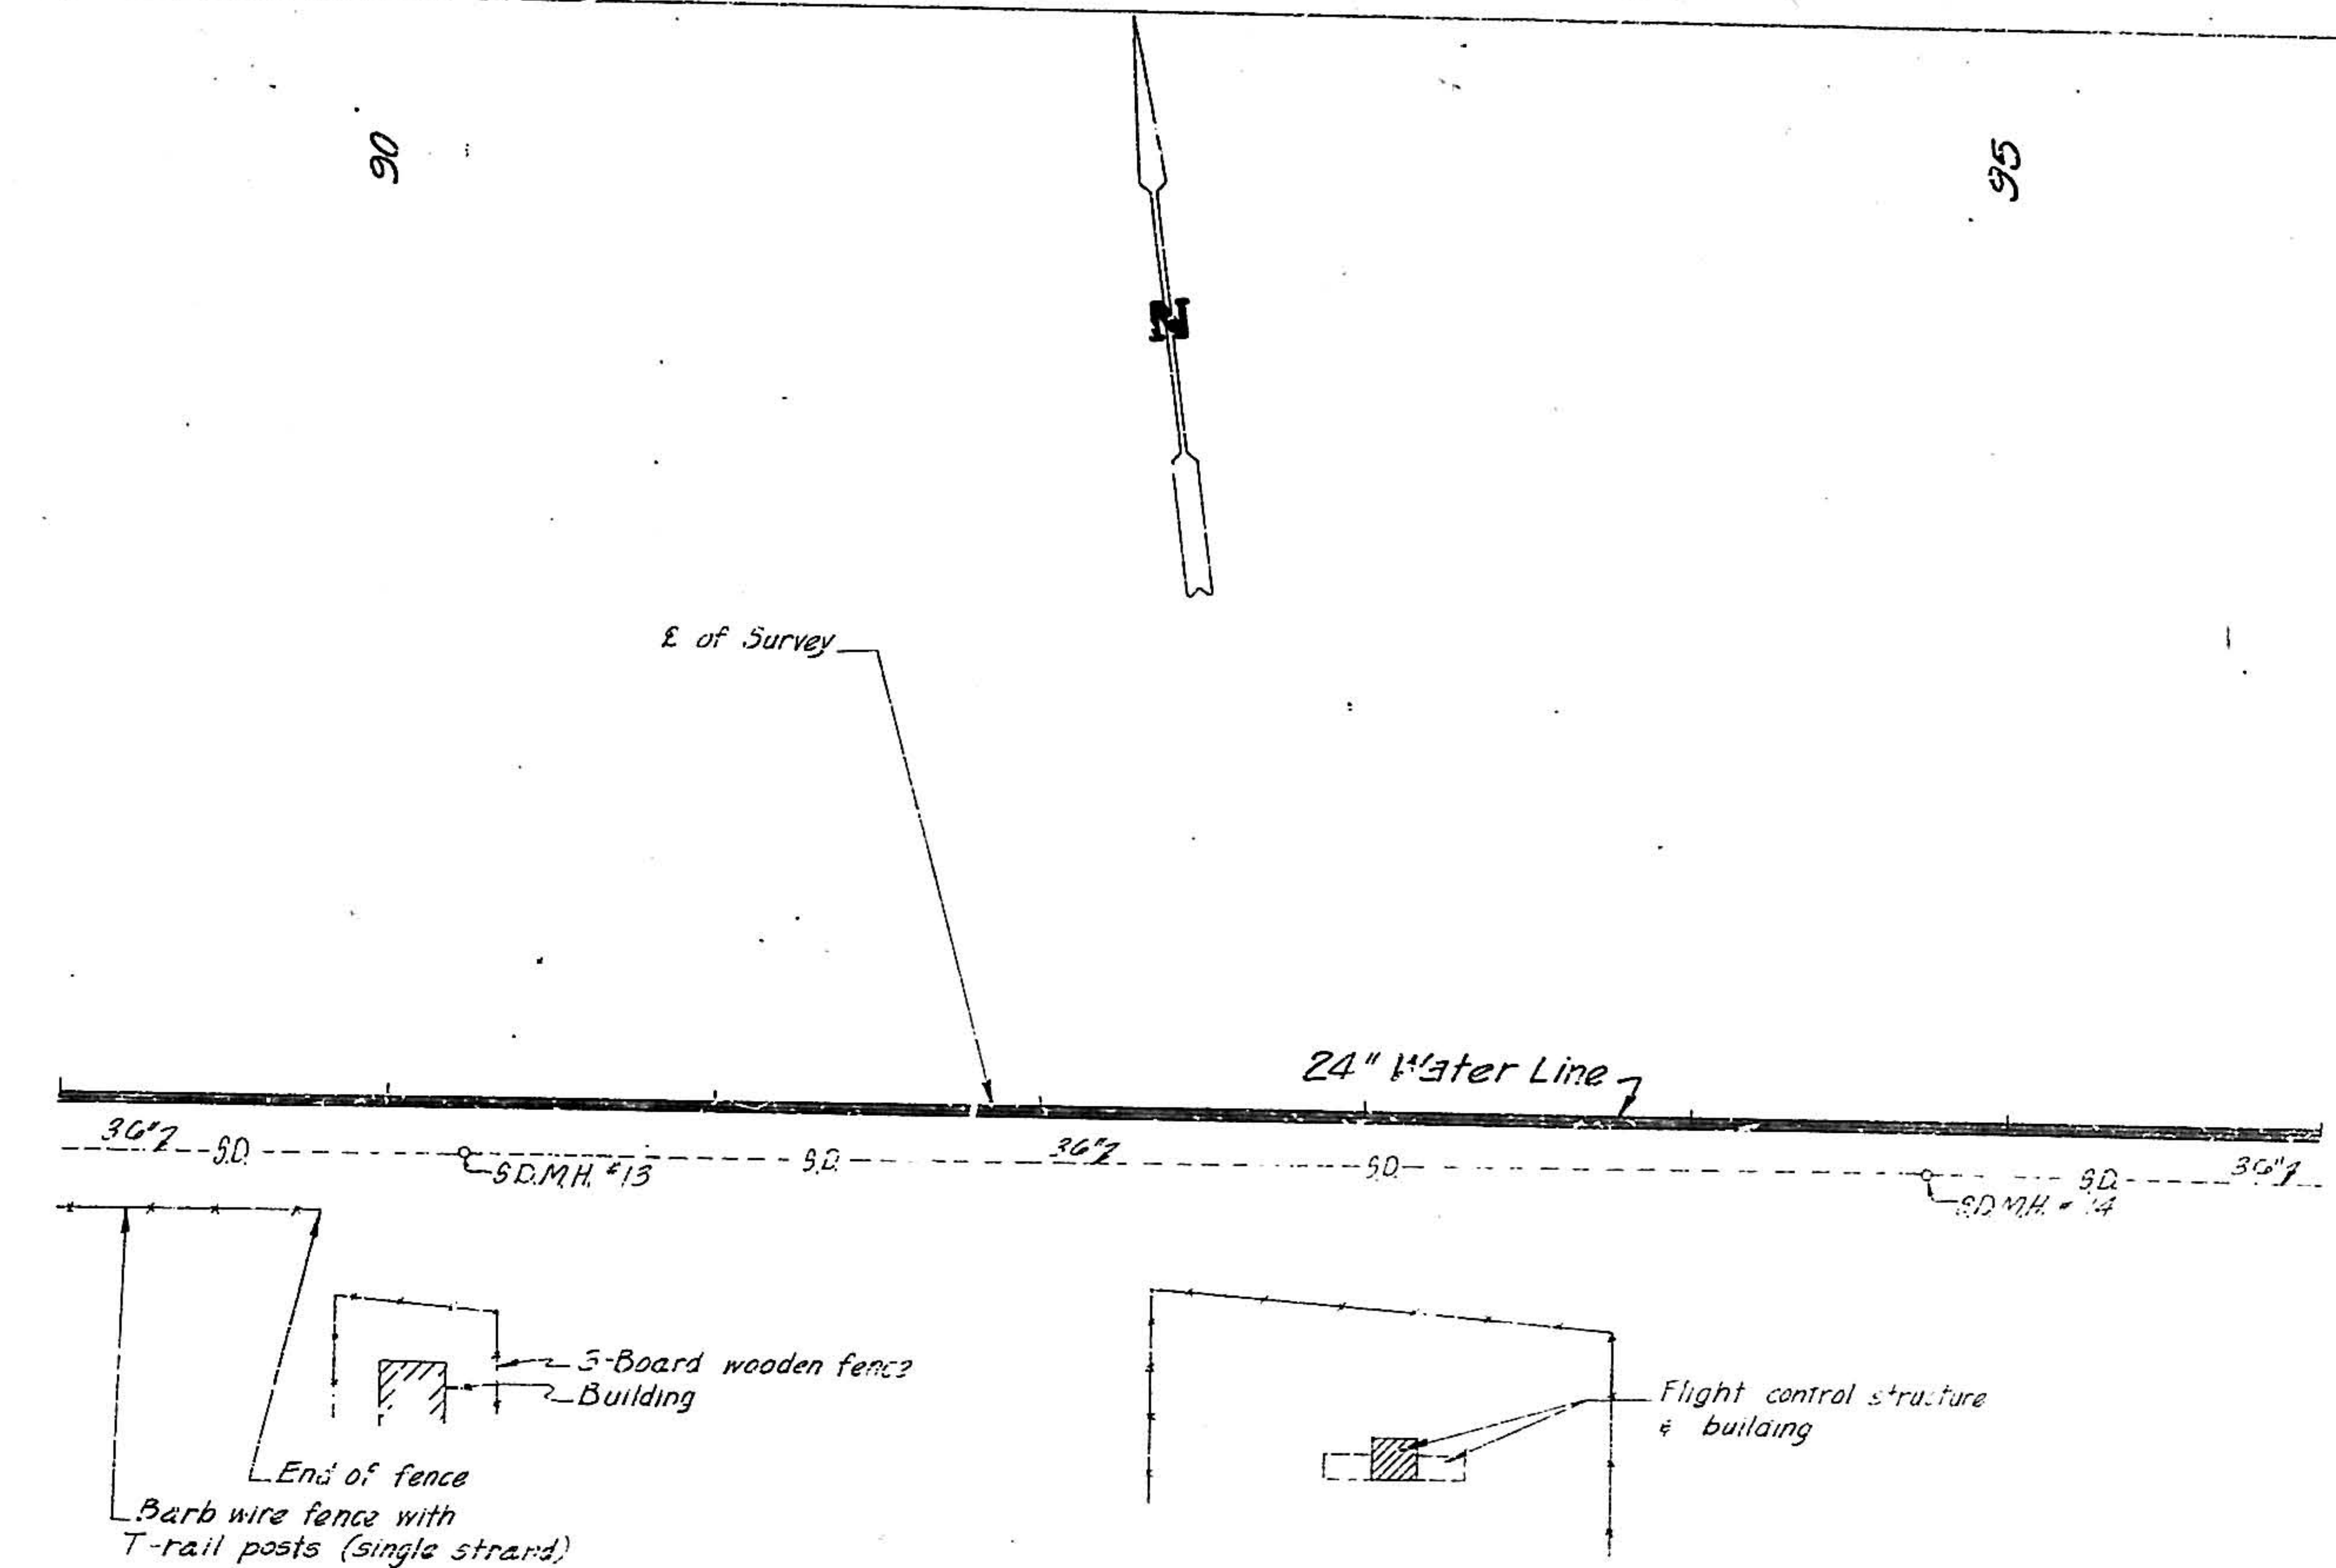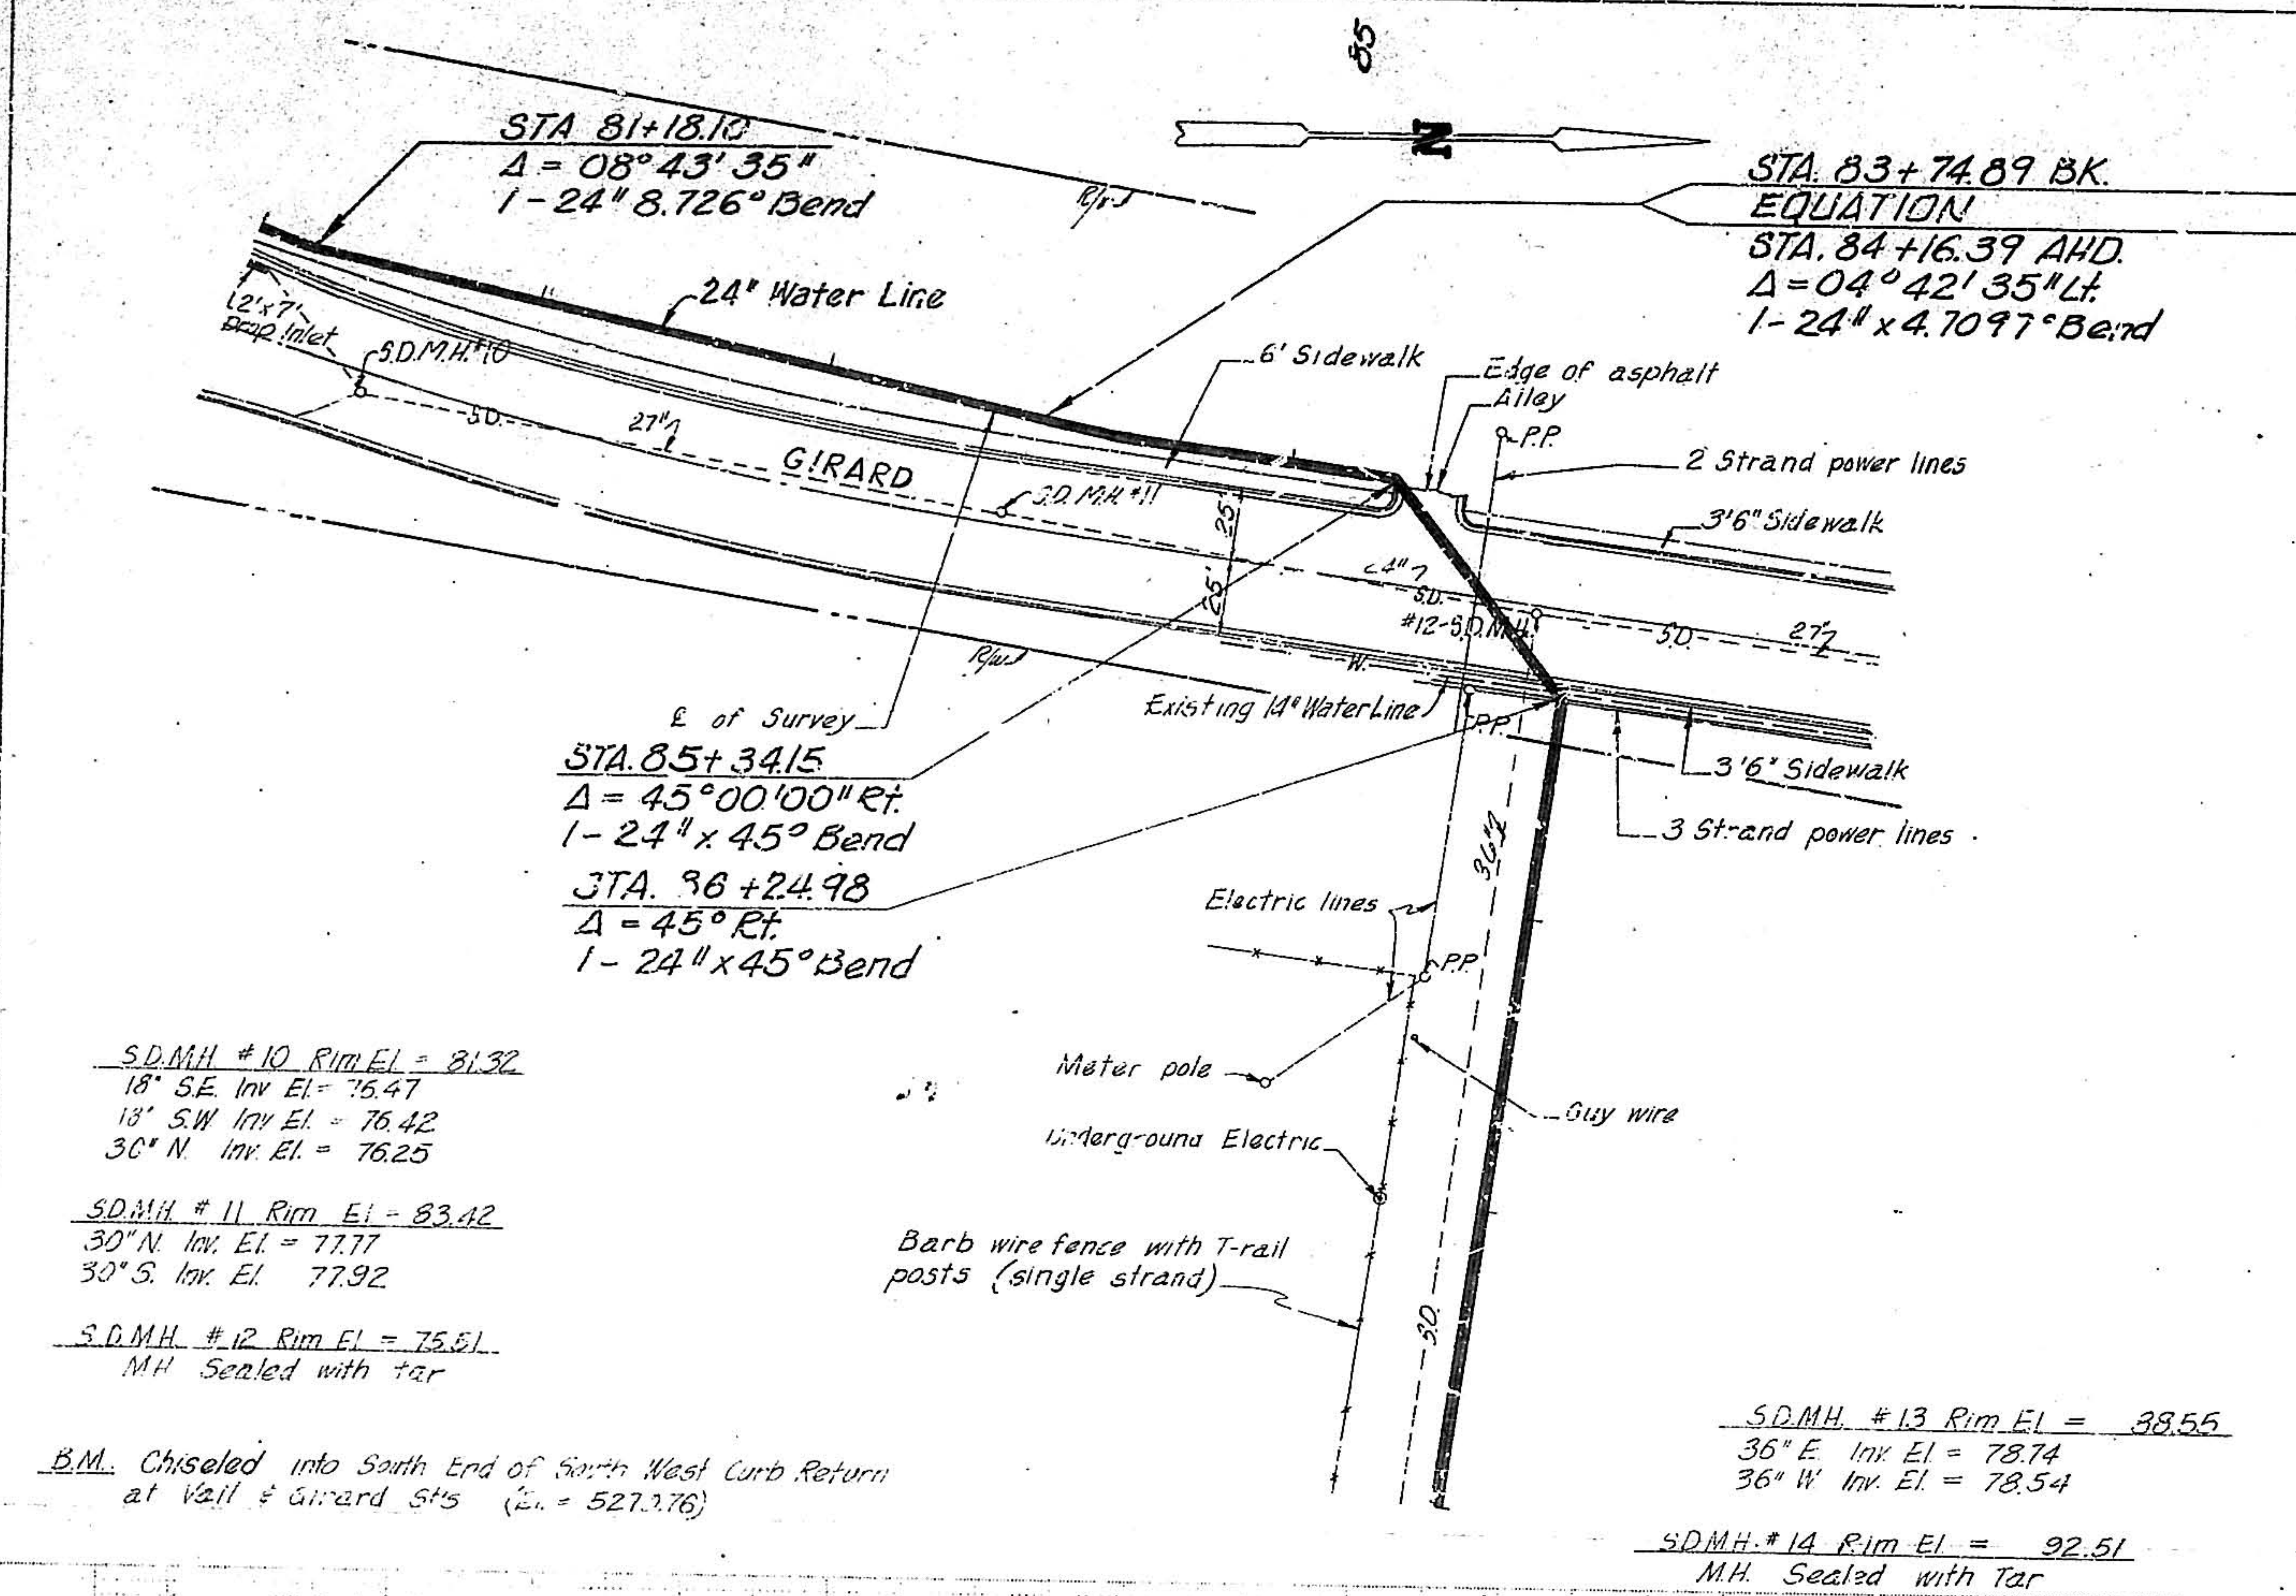

PHASE 2

Scale  
Horizontal: 1" = 50' 0"  
Vertical: 1" = 10' 0"

 


|    |   
|----|---|---|---|---|---|---|---|---|----|----|----|----|----|----|----|----|----|----|----|----|----|----|----|----|----|----|----|----|---|
| 1  | 2 | 3 | 4 | 5 | 6 | 7 | 8 | 9 | 10 | 11 | 12 | 13 | 14 | 15 | 16 | 17 | 18 | 19 | 20 | 21 | 22 | 23 | 24 | 25 | 26 | 27 | 28 | 29 |   |
| 09 |   |   | 0 | 0 | 6 |   |   | 1 | 2  | 7  | 5  |    |    |    |    |    | 0  | 2  |    |    |    |    |    |    | 5  | 6  | 1  | 6  | 2 |

RECORD DRAWING  
DATE FEB 8 1956



|      |    |          |         |                |                |     |
|------|----|----------|---------|----------------|----------------|-----|
| DATE | BY | SURVEYED | PLOTTED | GRADES CHECKED | IB, M, S NOTED | NO. |
|      |    |          |         |                |                |     |

 




 



PLATE 1 SINGLE PLAN - PROFILE - DOTTED  
CHARLES BRUNING COMPANY  
MADE IN U.S.A.

RECORD DRAWING  
DATE FEB 3 1976





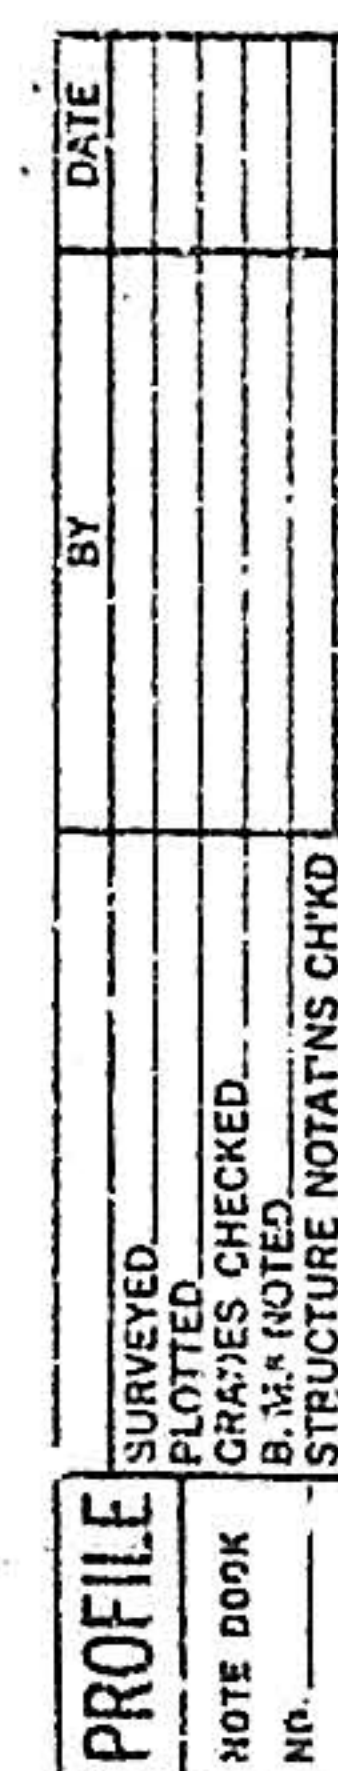

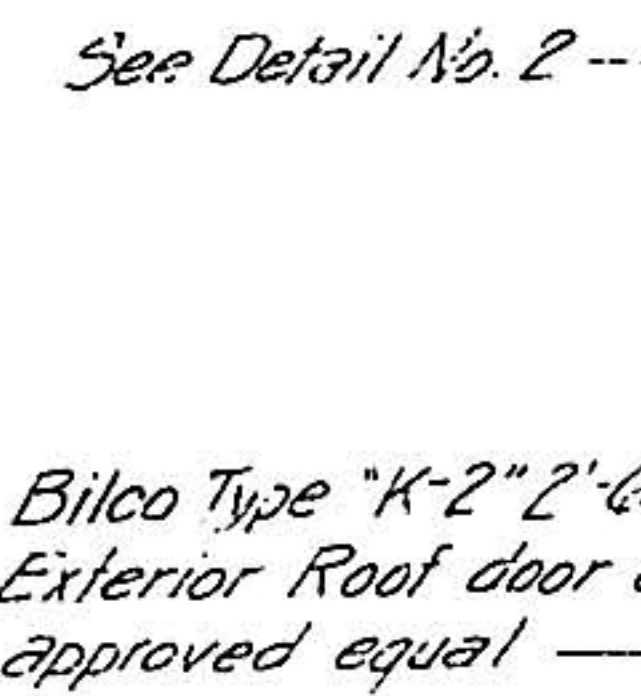

Hand-drawn technical drawing of a rectangular structure, likely a cabinet or box, with dimensions and labels. The drawing shows a top-down view with a central rectangular opening. Dimensions include 8'-2" for the overall width, 10'-6" for the overall height, and 3'-0 1/4" for the height of the central opening. Labels include "Lift handles", "L 2 1/2 x 2 x 1/4 Stiffener", and "C" for a circular feature. A small circle with a dot is labeled "C".

[illegible]

1/1/19

#5@6

#5@9

#5@7

#5@6

#4@18

#4@18

Wrap pipe with several layers of 30" x 6"

Gravel

6' to 6' Typ

[illegible]

Hand-drawn structural detail of a door frame and sill. The drawing shows a cross-section of a door frame with various dimensions and labels. Key dimensions include a total width of 2'-1" at the top, a door opening width of 1'-6", and a sill width of 3'-0 3/4". Labels include "L 4 x 4 x 3/8 (Frame)", "L 3 x 3 x 1/4 (Door Frame)", "L 4 x 3 x 1/4", "L 4 x 3 x 1/4 (Stiffener)", "1/4" Cover Plate", and "1/4" Cover". A note "3/8 x 4 = 1" is written at the bottom left. The drawing is a technical sketch showing the assembly of the door frame and sill with various structural components and dimensions.


| PIPE FITTING SCHEDULE |                                    |
|-----------------------|------------------------------------|
| ①                     | 36" x 36" x 30" Tee                |
| ②                     | 30" 90° Bend                       |
| ③                     | 30" Spool                          |
| ④                     | 36" Spool                          |
| ⑤                     | 35" Motor Operated Butterfly Valve |
| ⑥                     | 36" Dresser Coupling (Locking)     |
| ⑦                     | 30" Dresser Coupling               |
| ⑧                     | 30" Slanting Disc Check Valve      |
| ⑨                     | 36" 45° Bend                       |
| ⑩                     | 36" x 36" x 30" 45° Lateral        |

[illegible]


|                                                                                       |                          |                      |                   |
|---------------------------------------------------------------------------------------|--------------------------|----------------------|-------------------|
|  | MILES TRANSMISSION LINES |                      |                   |
|                                                                                       | BY PASS VALVE PIT<br>&   |                      | DEC 1973          |
|                                                                                       | COVER DETAILS            |                      | DATE              |
|                                                                                       |                          |                      | AS SHOWN<br>SCALE |
| <b>GORDON HERKENHOFF &amp; ASSOCIATES, INC.</b>                                       |                          |                      |                   |
| ALBUQUERQUE                                                                           |                          | ENGINEERS • PLANNERS | NEW MEXICO        |




| PLAN     | DATE |
|----------|------|
| SURVEYED | BY   |
| DESIGNED | BY   |
| NOTED    | BY   |
| CHECKED  | BY   |
| DATE     |      |

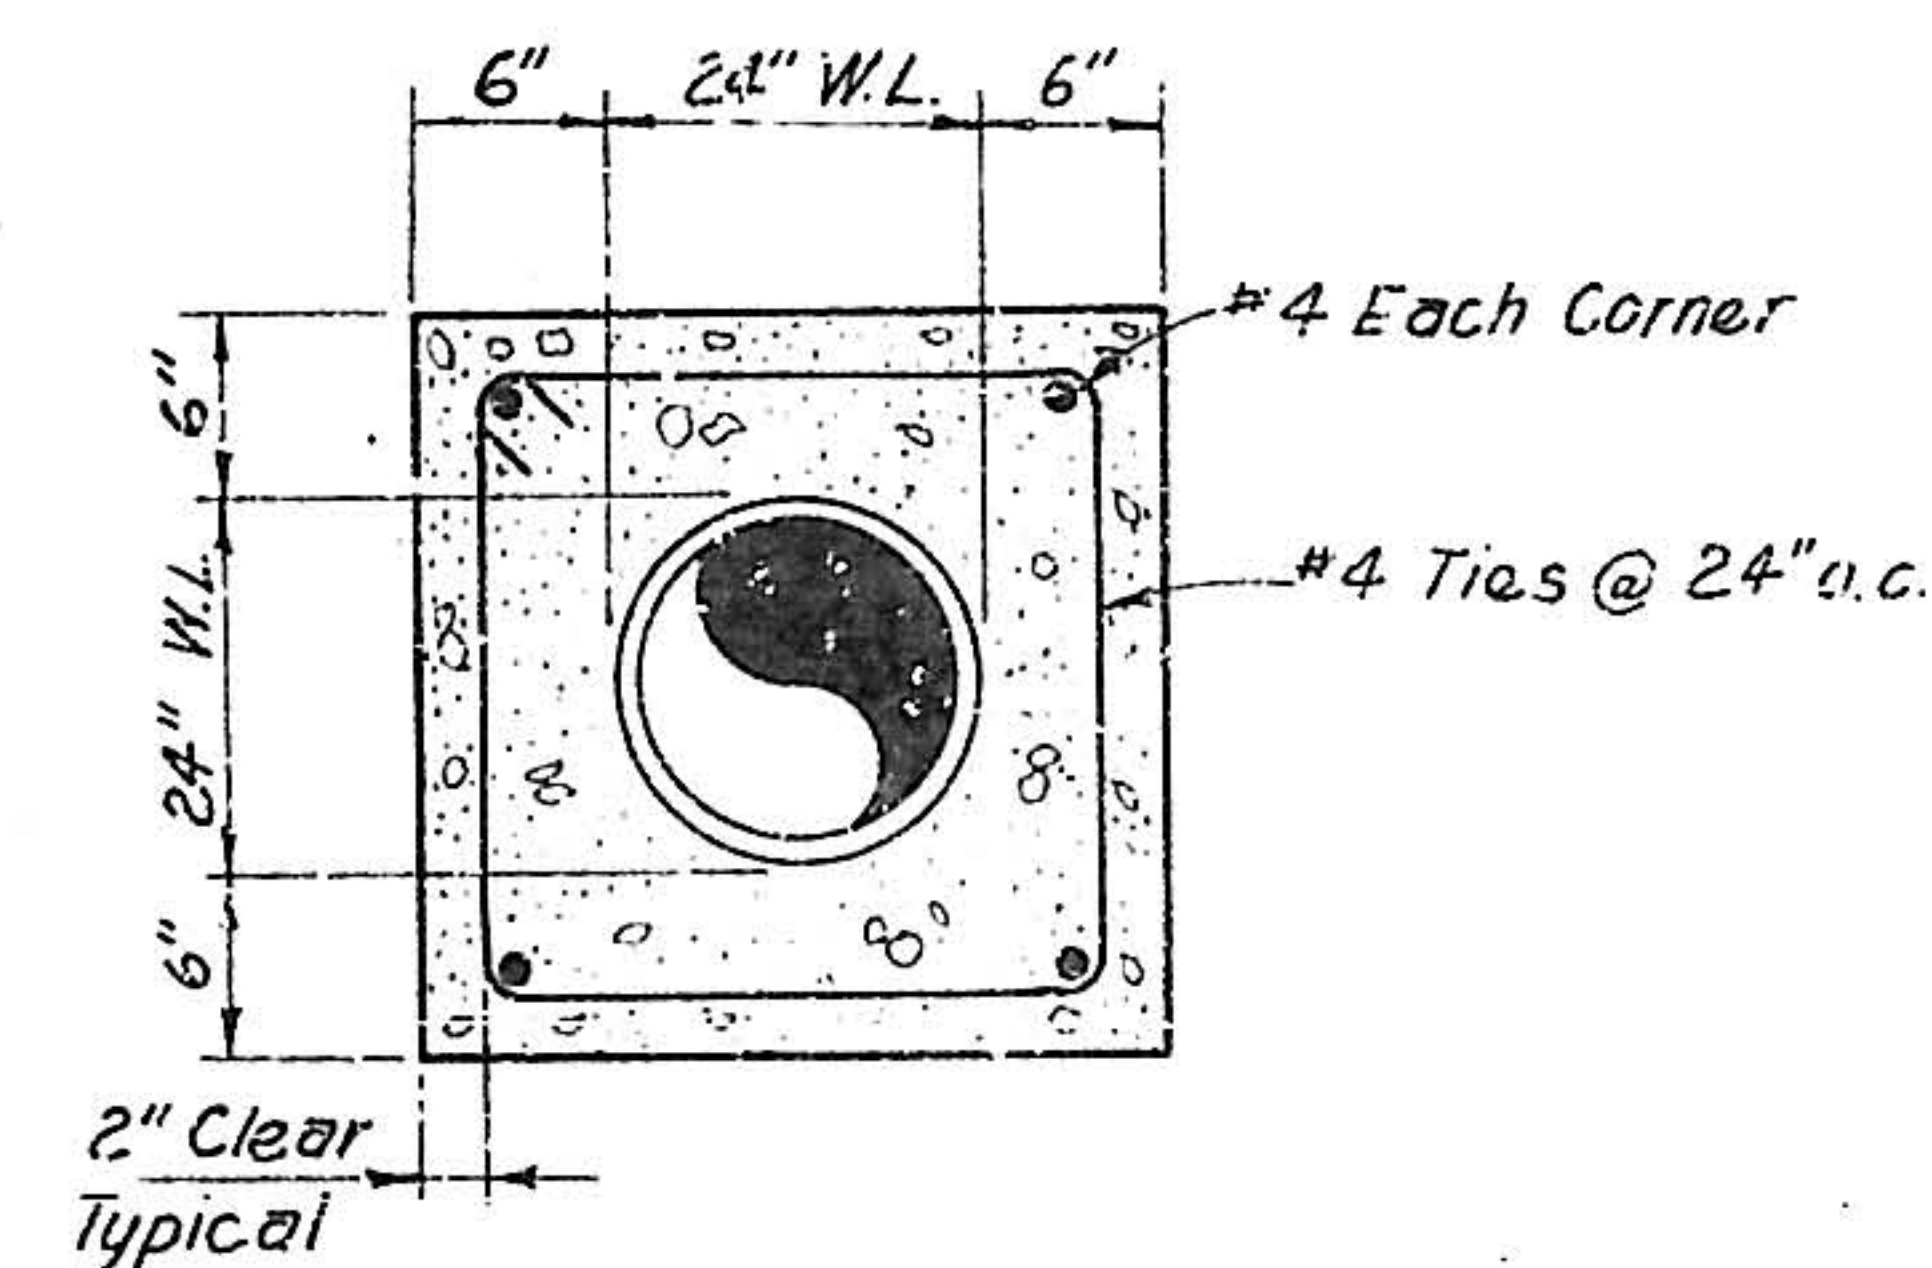

SECTION  
CONC. ENCASE. DETAILS

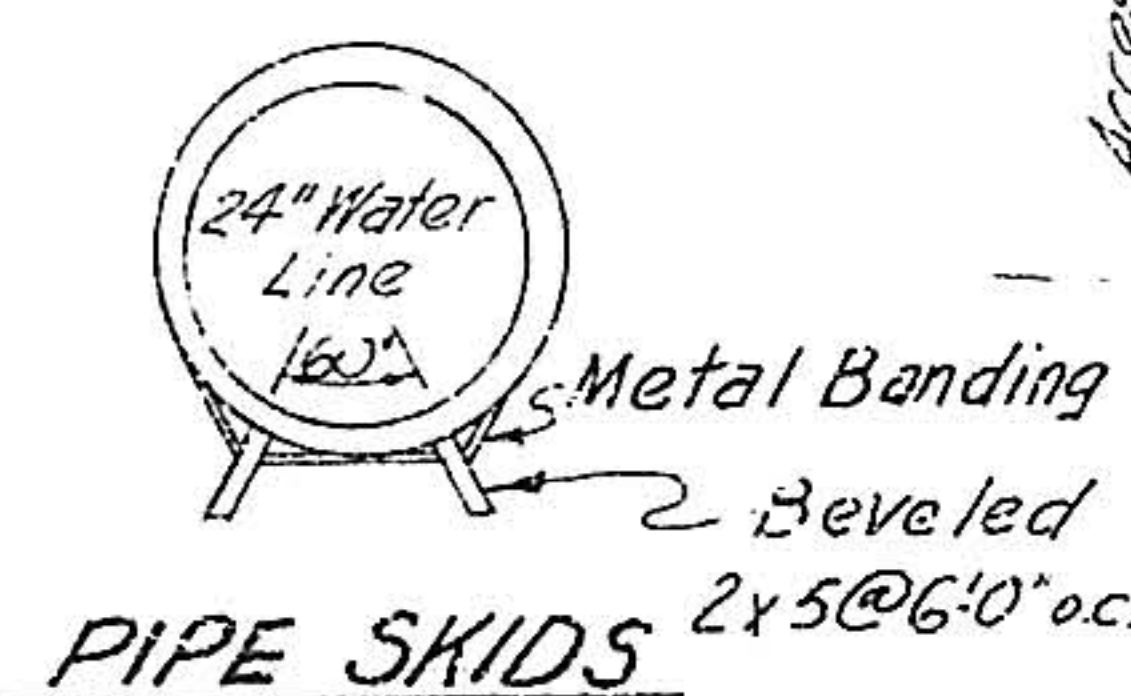


PIPE SKIDS

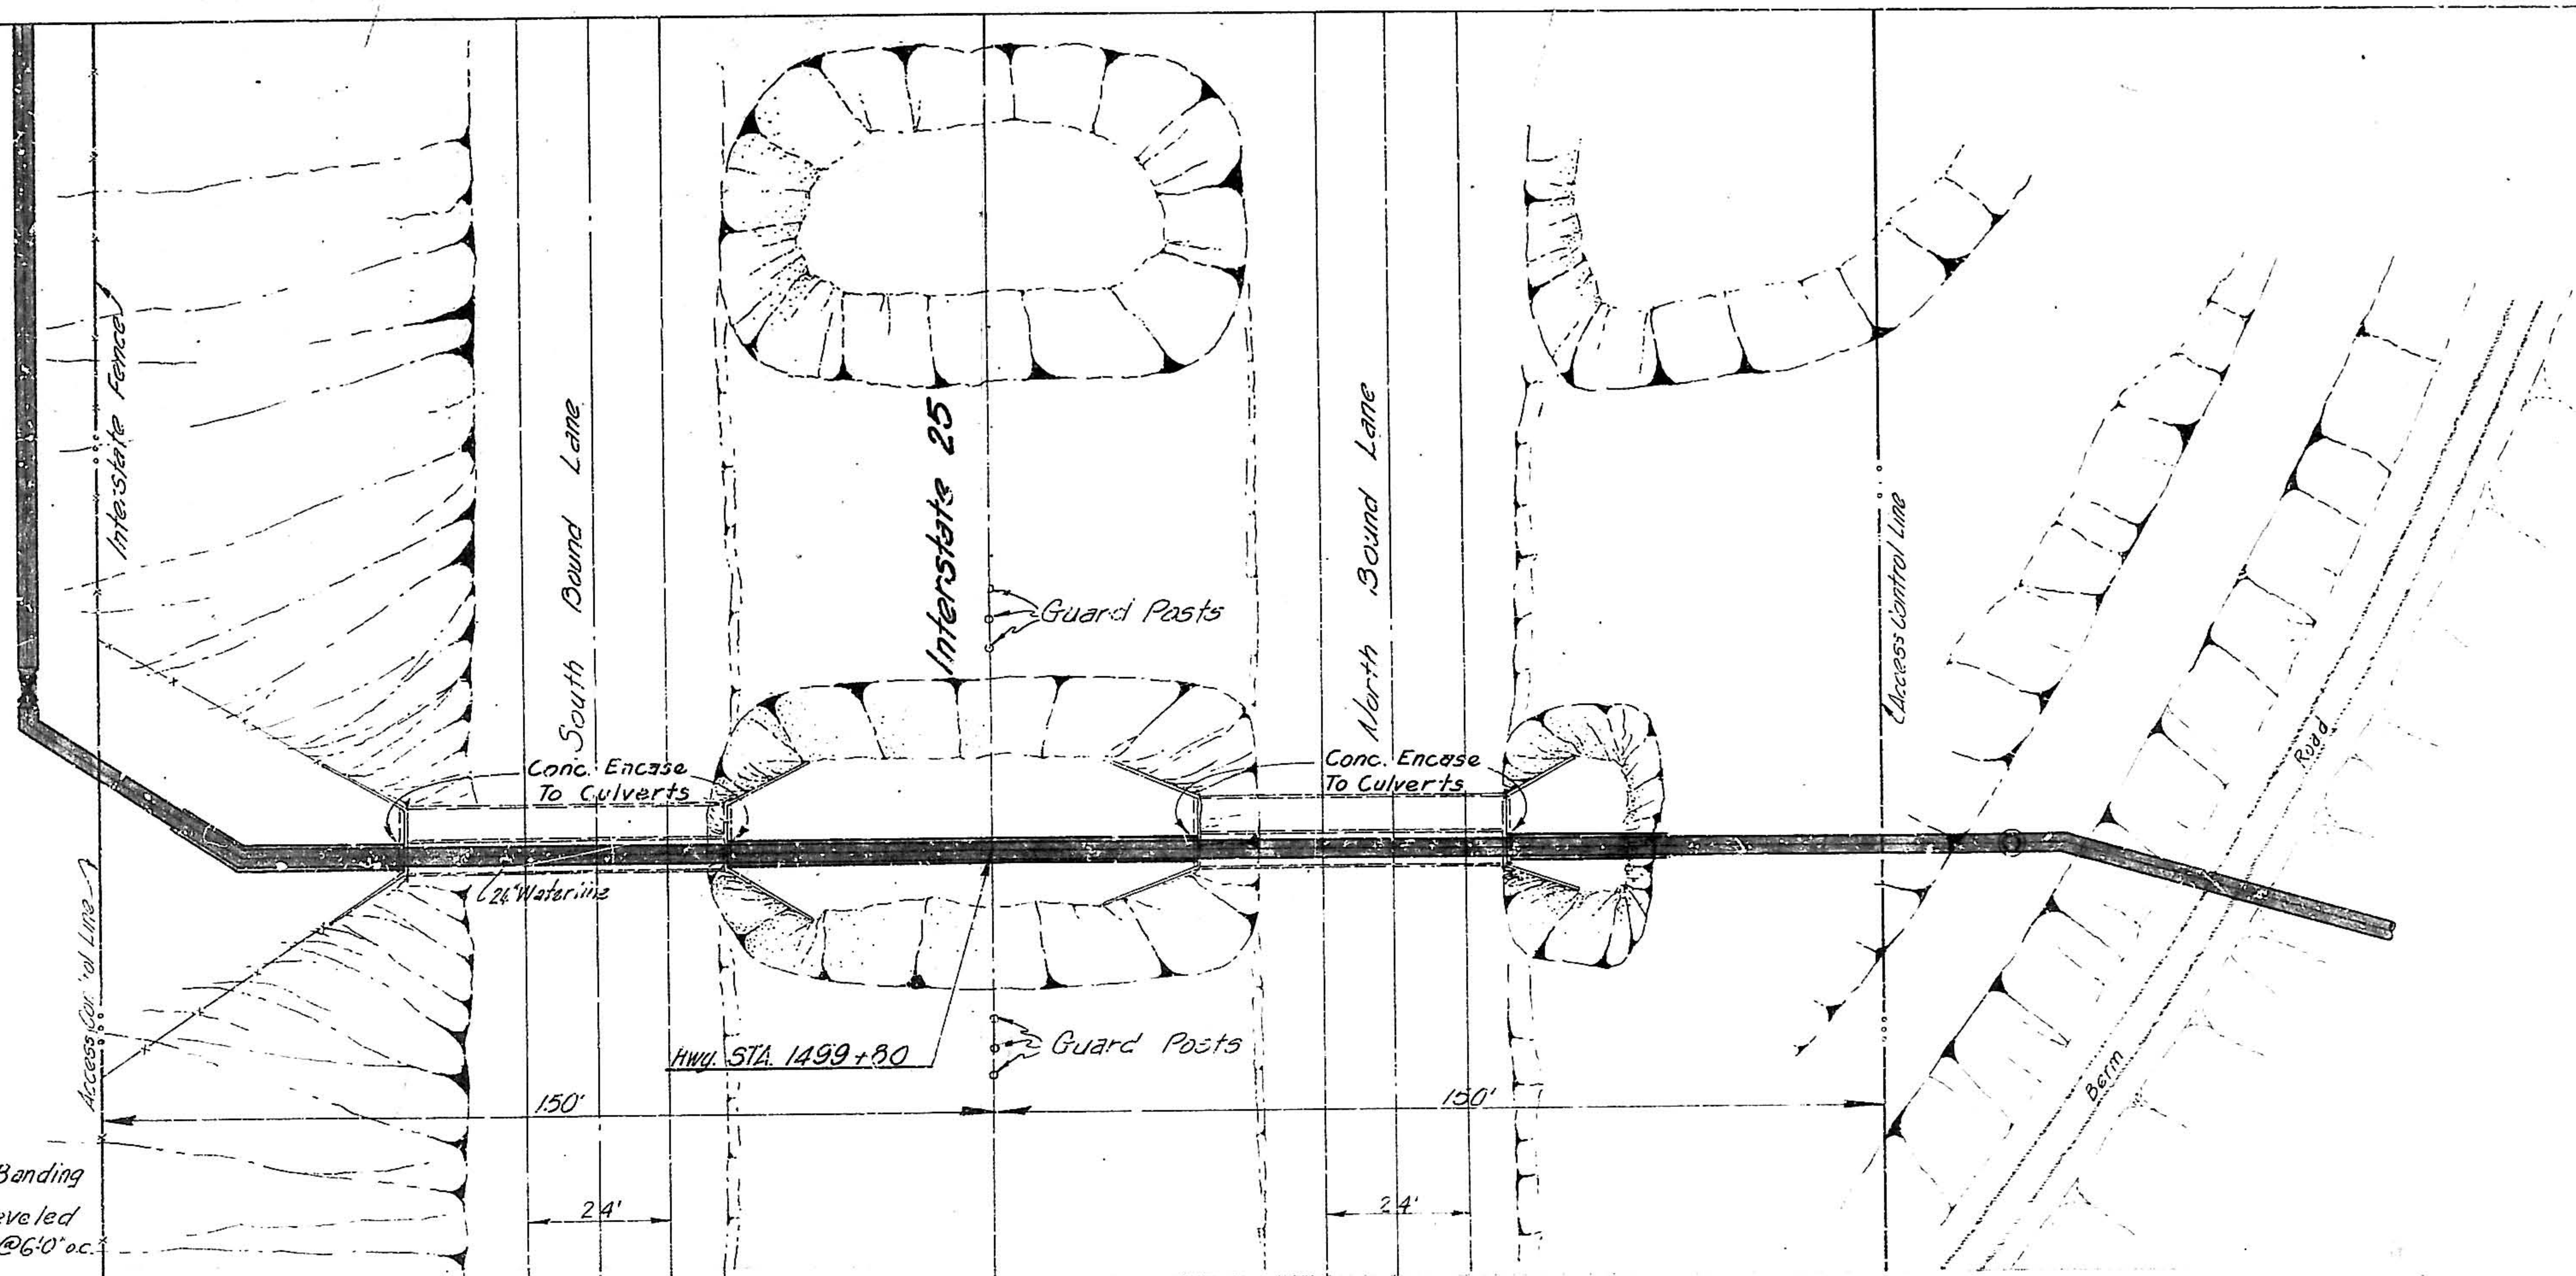

Scale  
Horizontal 1" = 20'  
Vertical 1" = 50'


| PROFILE  | DATE |
|----------|------|
| SURVEYED | BY   |
| DESIGNED | BY   |
| NOTED    | BY   |
| CHECKED  | BY   |
| DATE     |      |

 


|    |     |      |    |     |    |
|----|-----|------|----|-----|----|
| 09 | 006 | 1775 | 02 | 551 | 51 |
|----|-----|------|----|-----|----|

Revised Aug. 28, 1974




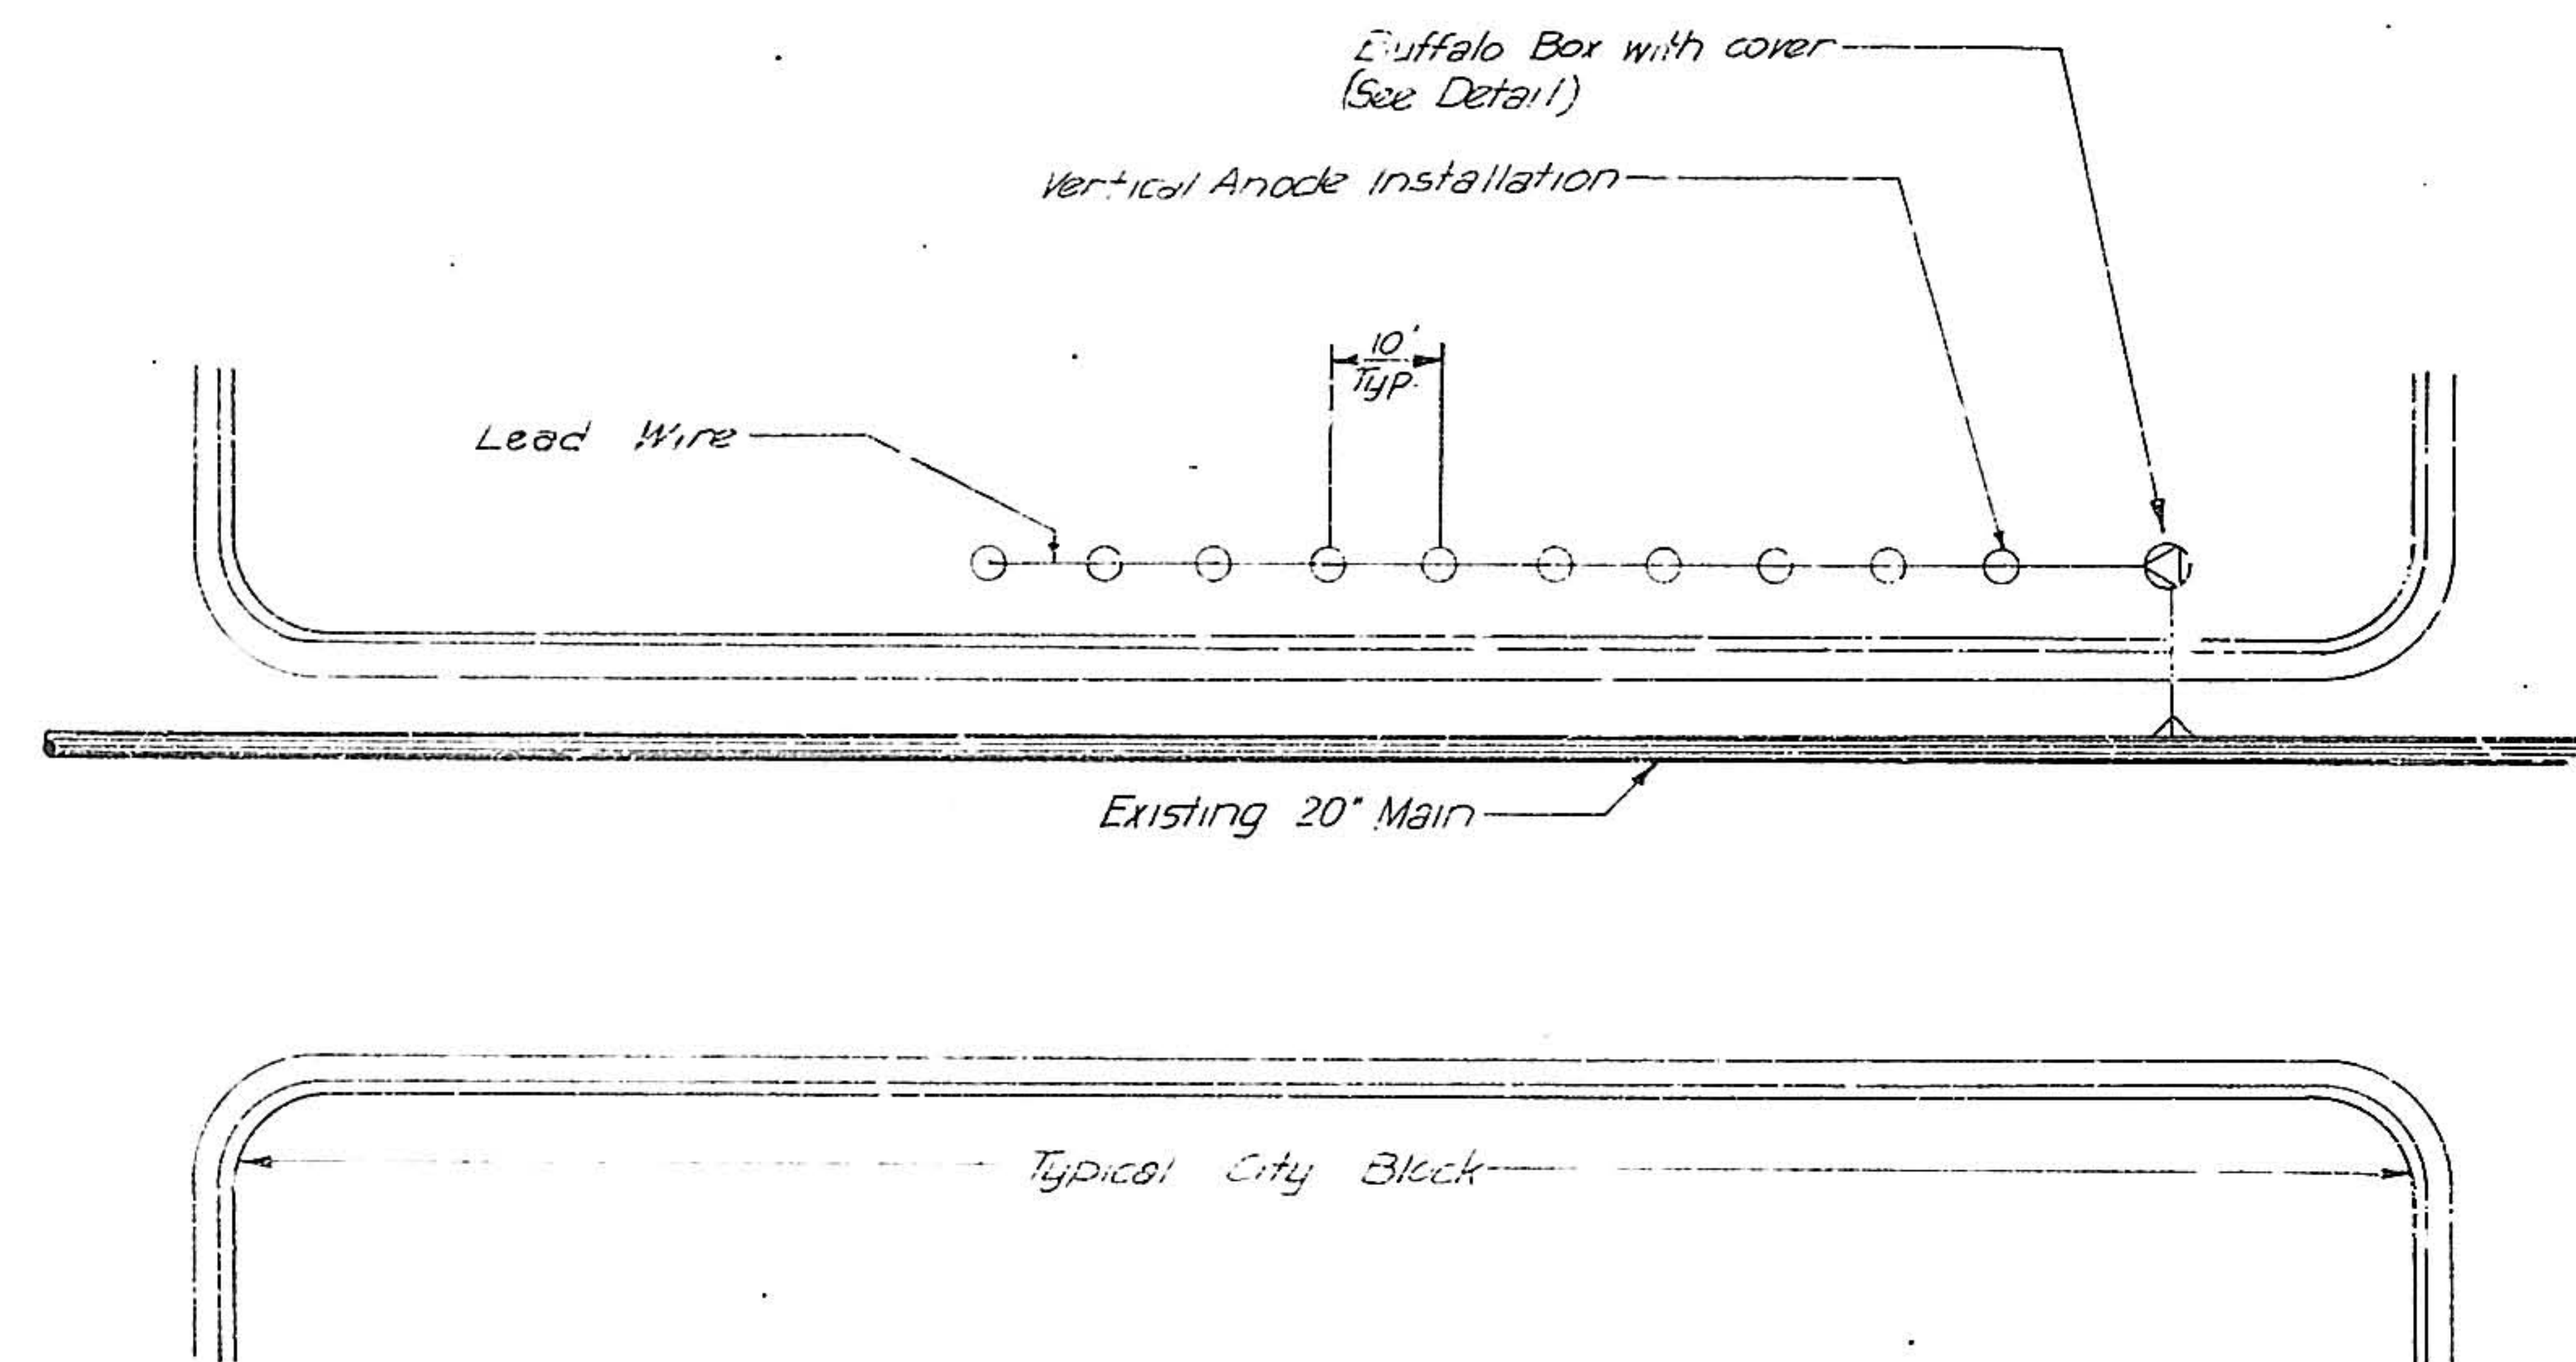


ANODE  
PLAN VIEW

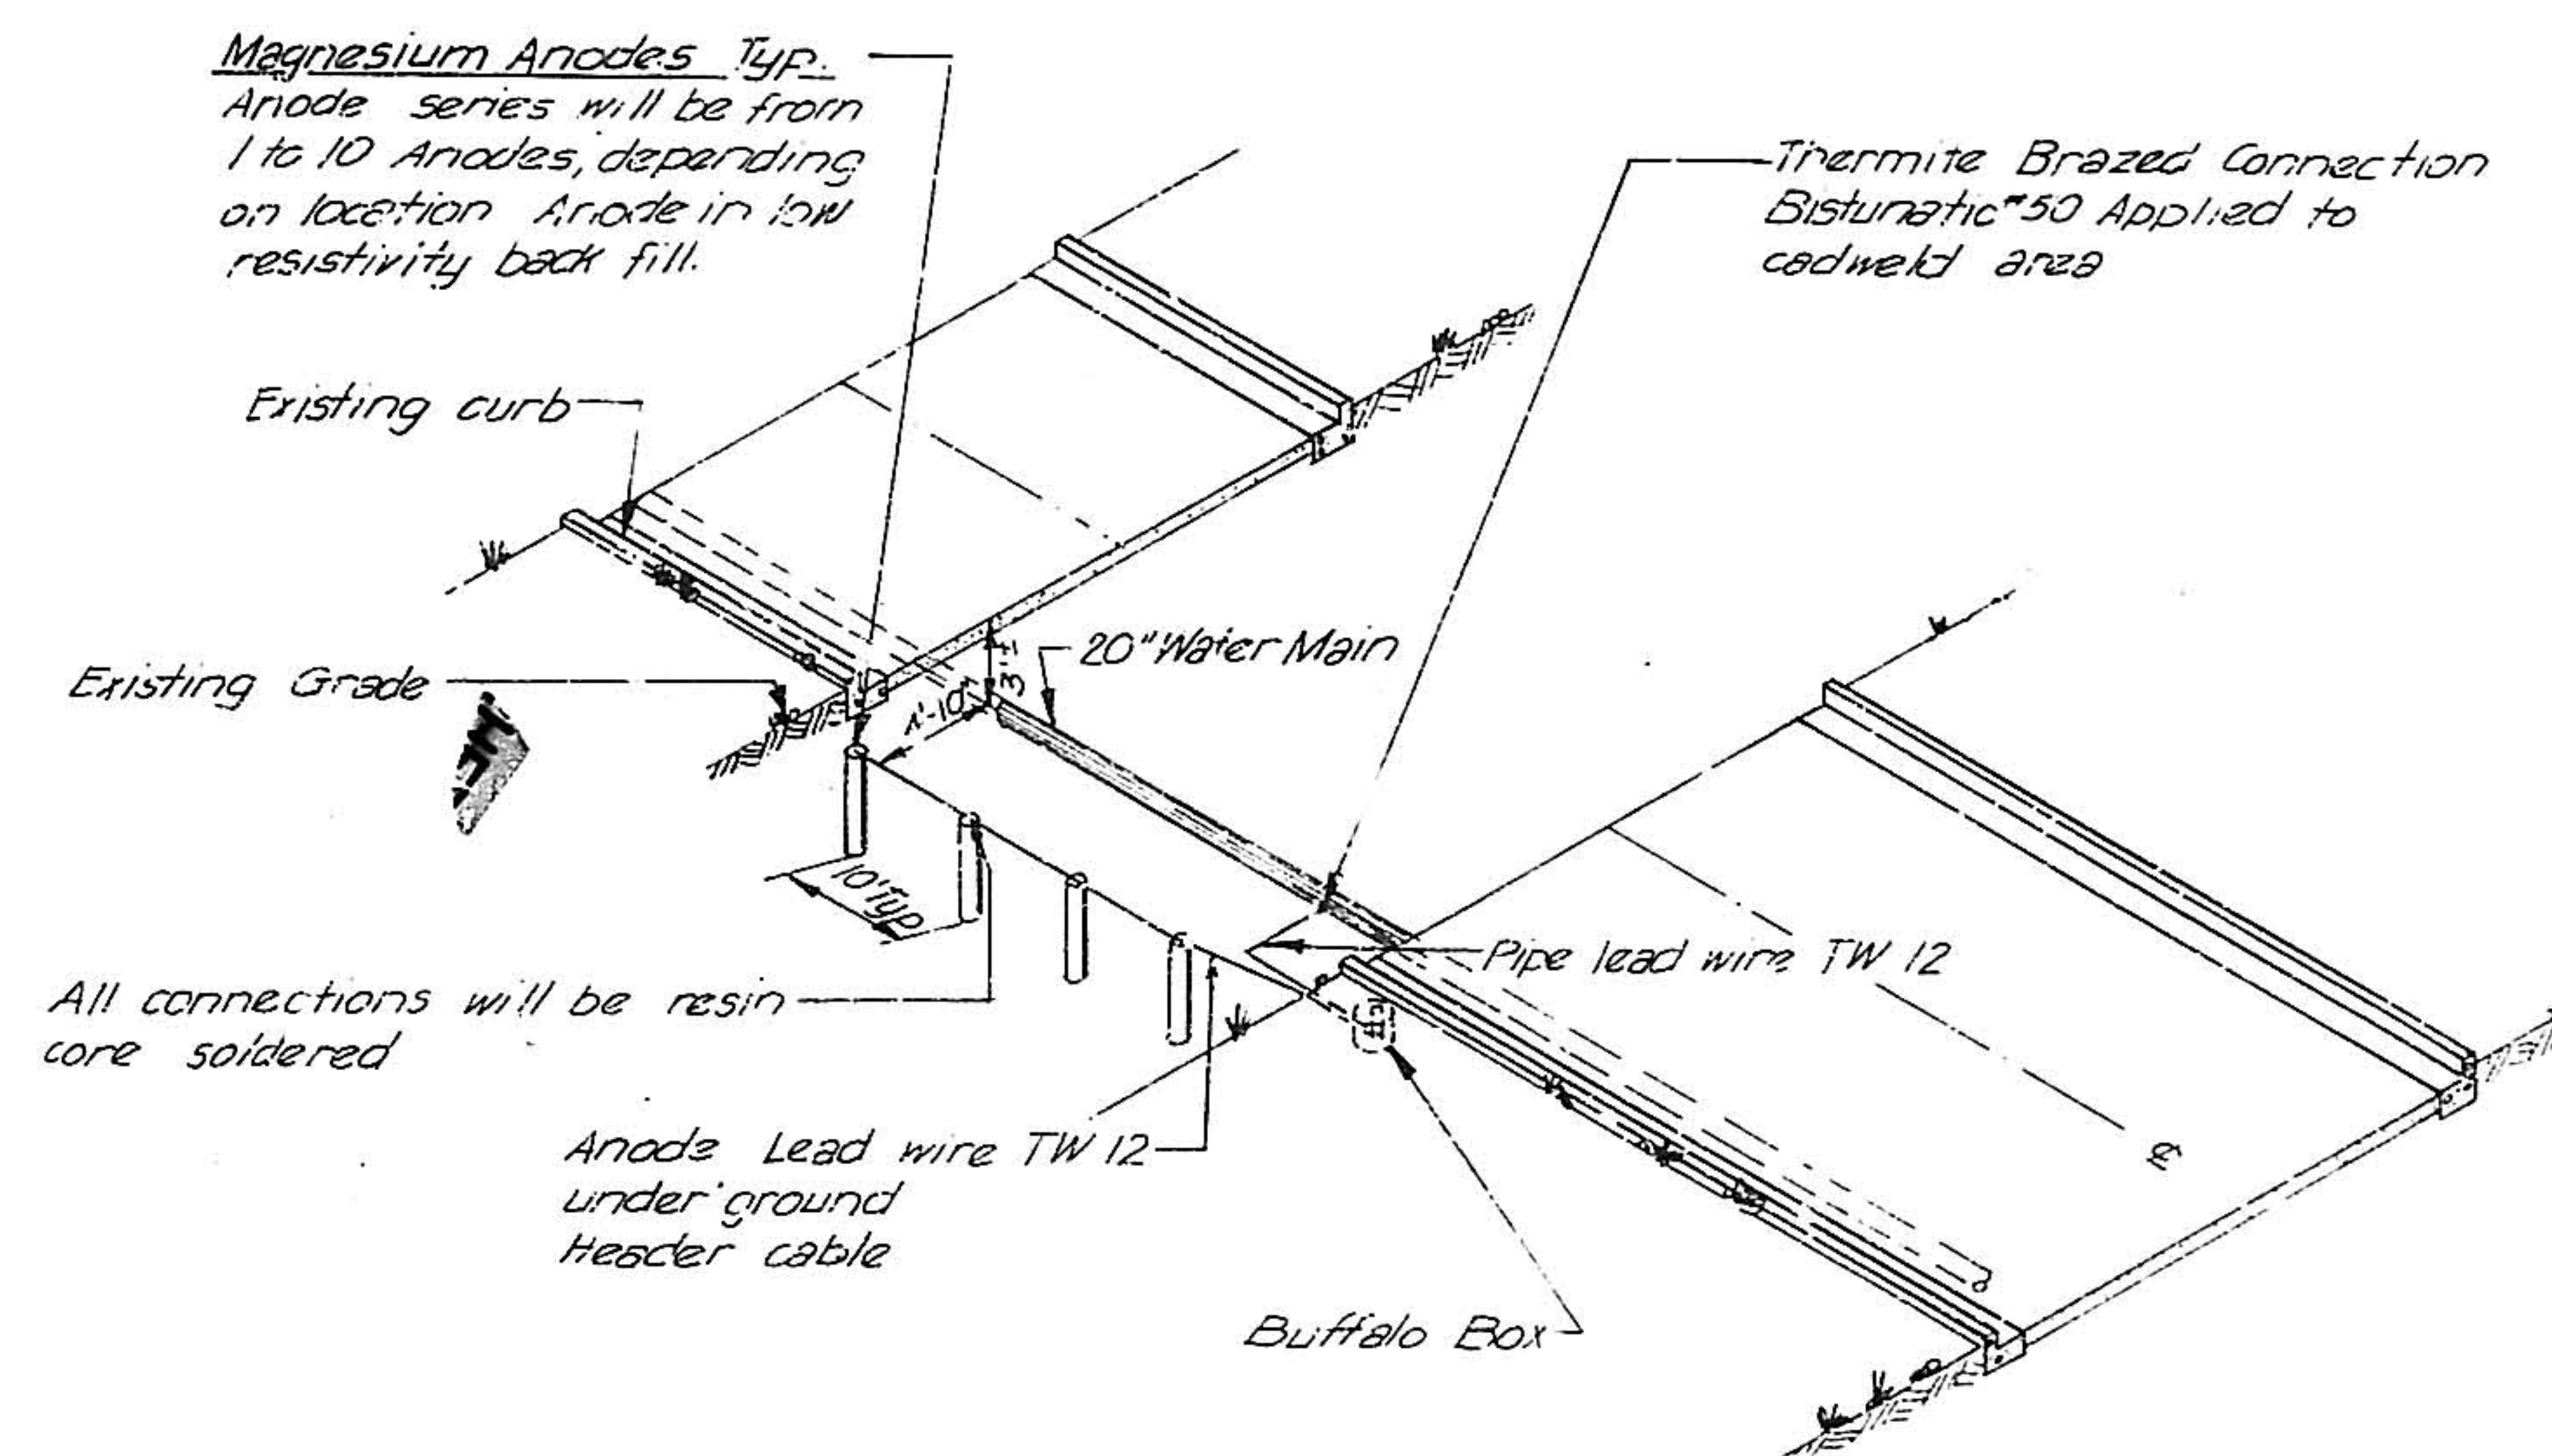

ANODE  
VERTICAL INSTALLATION

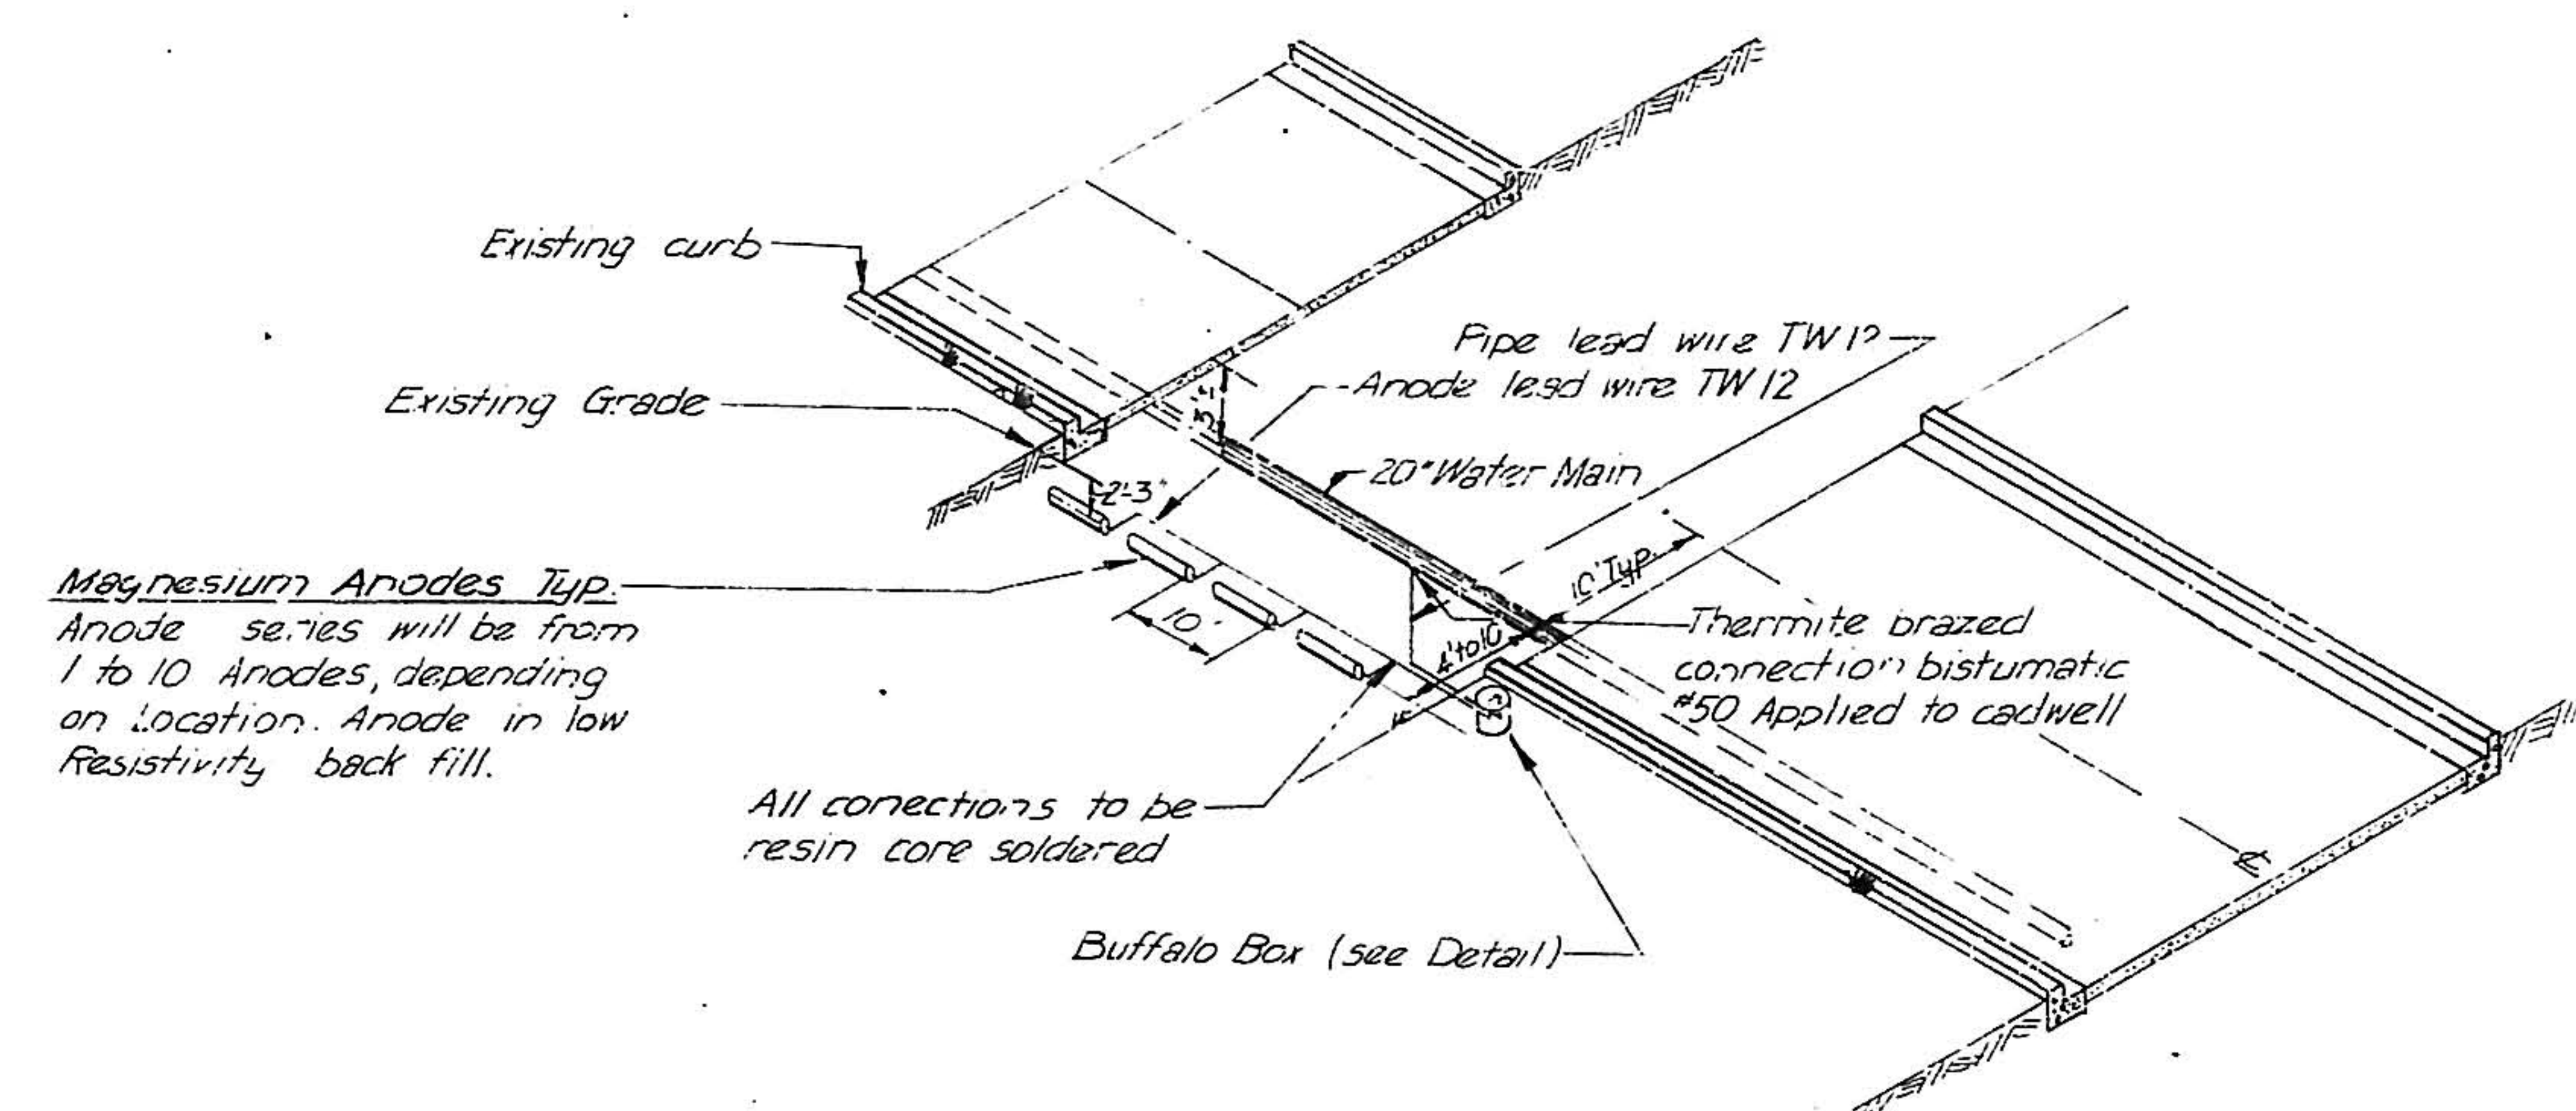

ANODE  
HORIZONTAL INSTALLATION





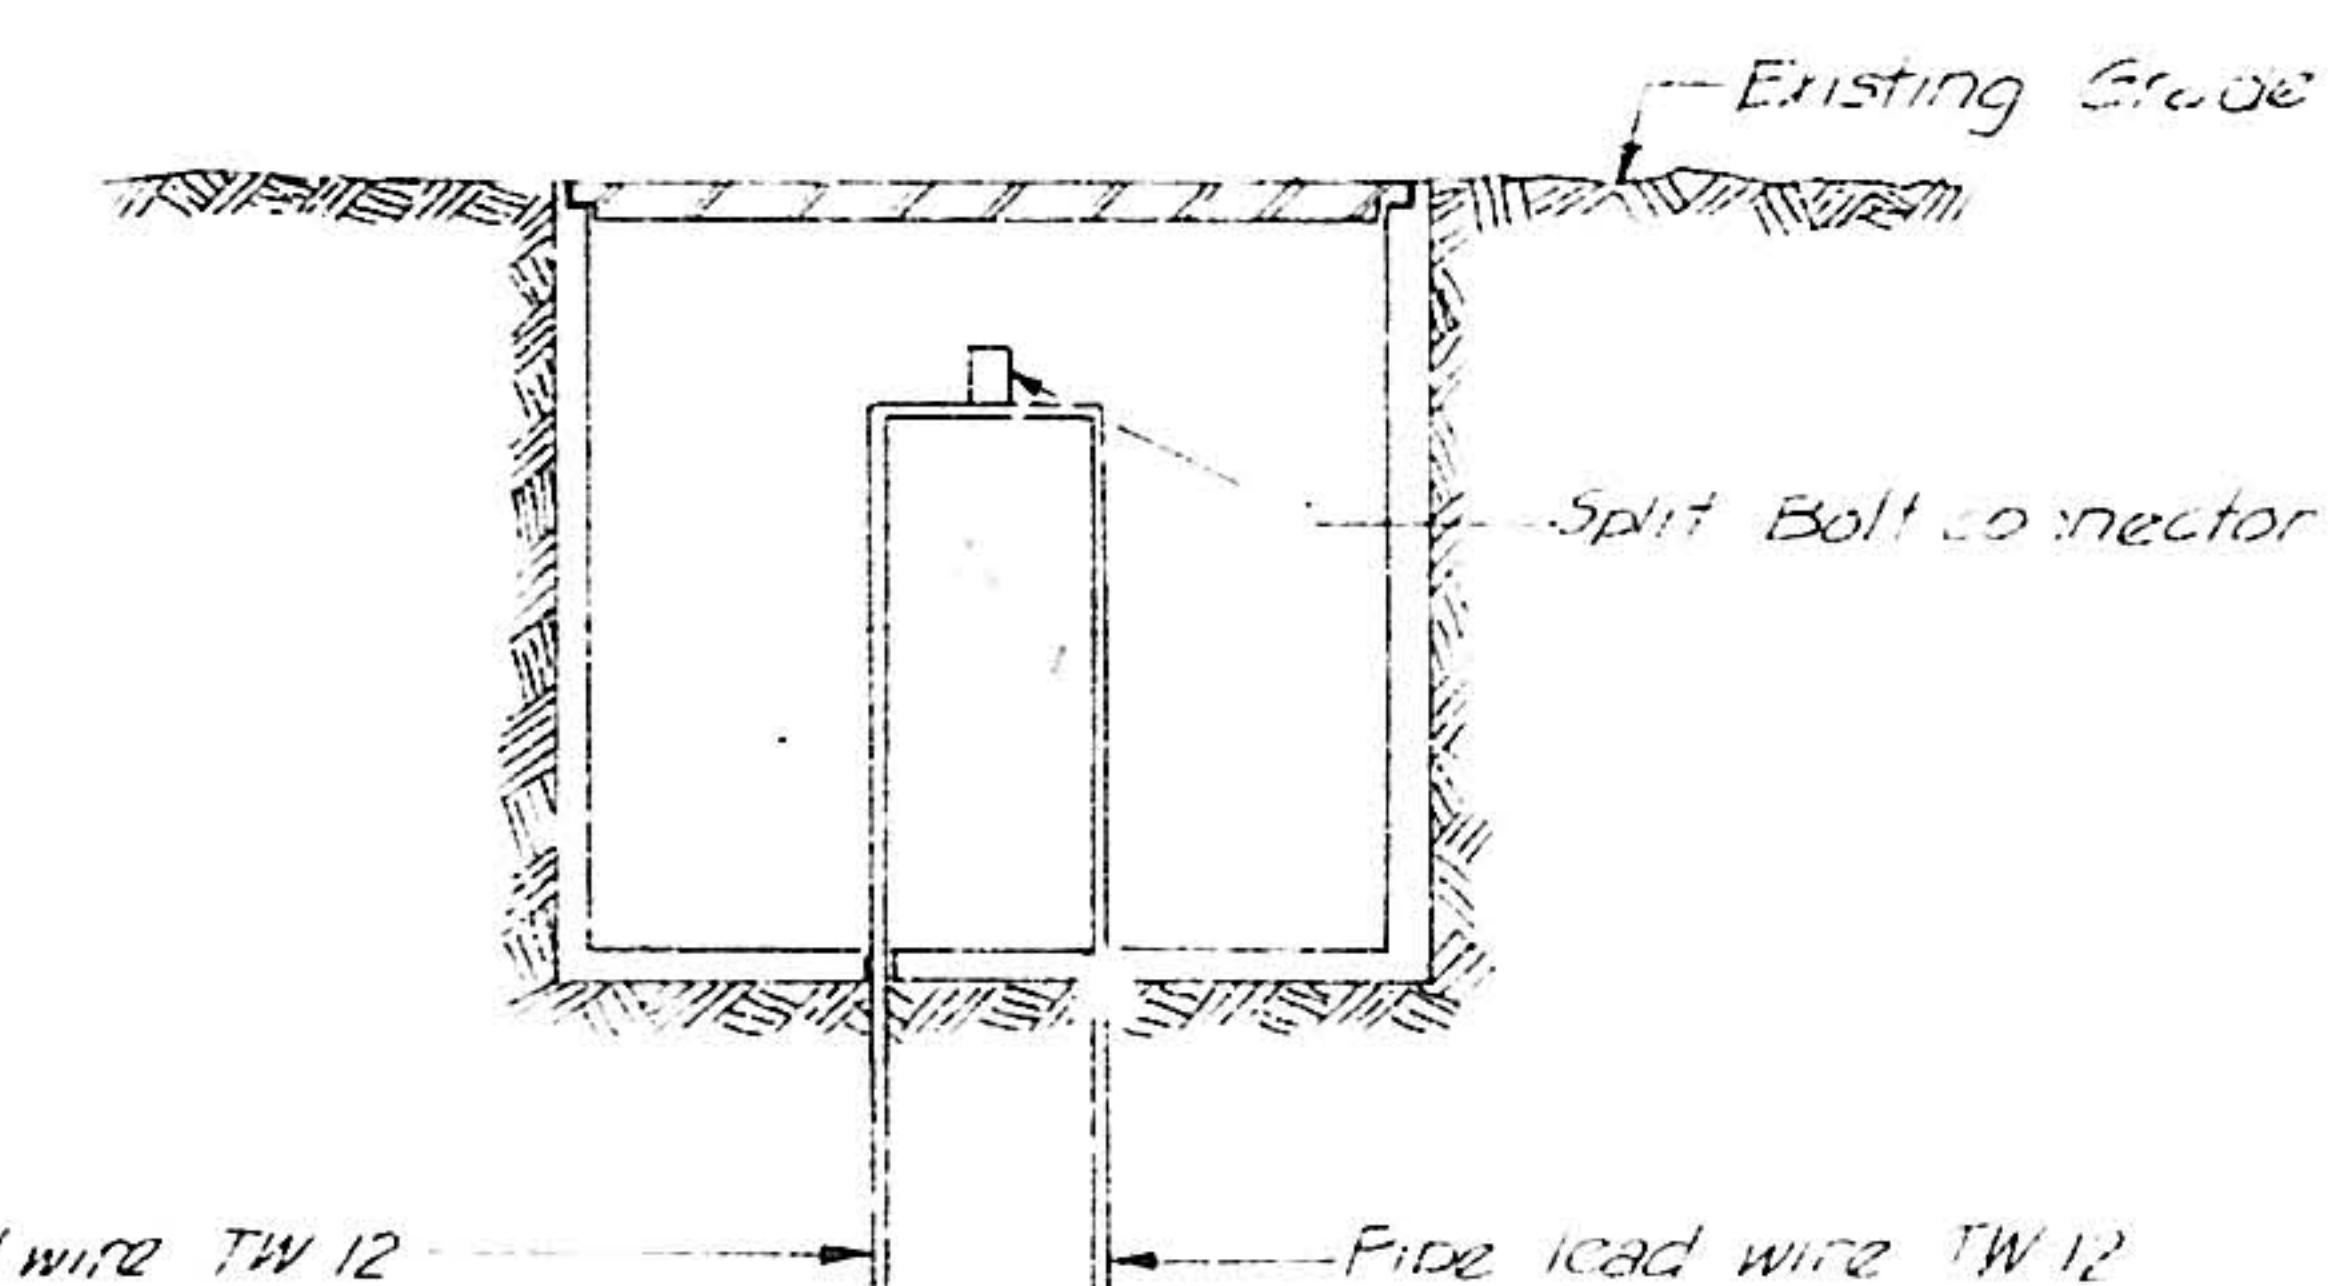


BUFFALO BOX

|    |    
|----|----|---|---|---|---|---|---|---|----|----|----|----|----|----|----|----|----|----|----|----|----|----|----|----|----|----|----|
| 1  | 2  | 3 | 4 | 5 | 6 | 7 | 8 | 9 | 10 | 11 | 12 | 13 | 14 | 15 | 16 | 17 | 18 | 19 | 20 | 21 | 22 | 23 | 24 | 25 | 26 | 27 | 28 |
| 09 | 00 | 6 |   |   

|                                      |            |
|--------------------------------------|------------|
| ALBUQUERQUE, NEW MEXICO              |            |
| MILES TRANSMISSION LINES             |            |
| PHASES 1 AND 2                       |            |
| CORROSION CONTROL                    |            |
| FOR                                  |            |
| SAN JOSE WATER LINE                  |            |
| GORDON HERKENHOFF & ASSOCIATES, INC. |            |
| ENGINEERS • PLANNERS                 |            |
| ALBUQUERQUE                          | NEW MEXICO |



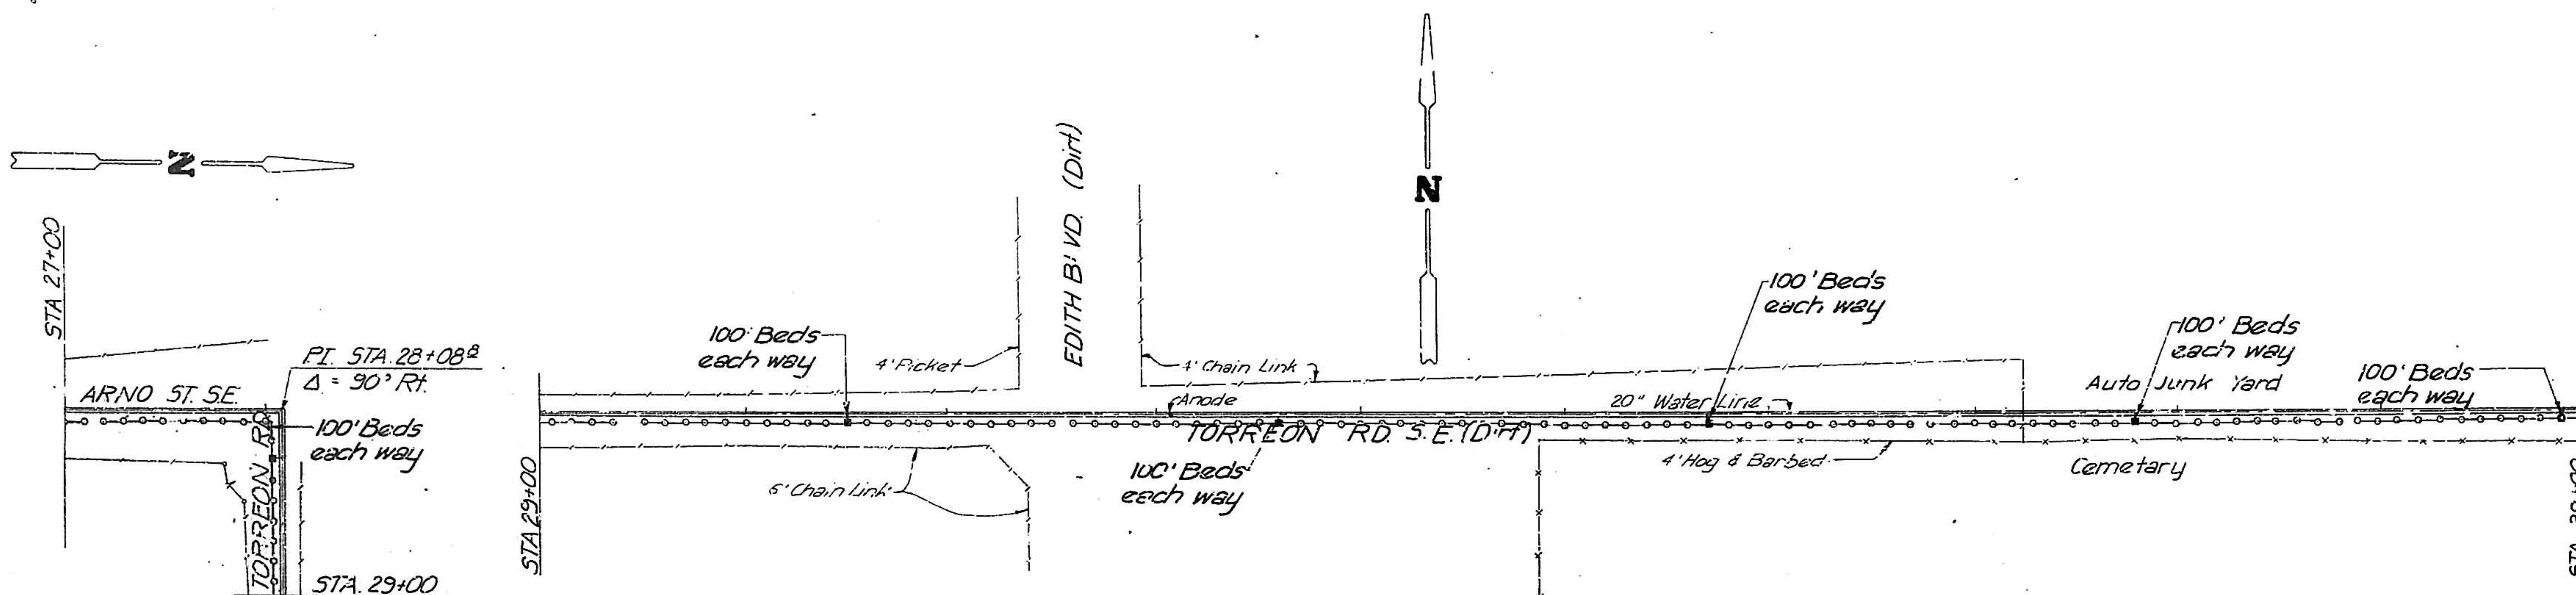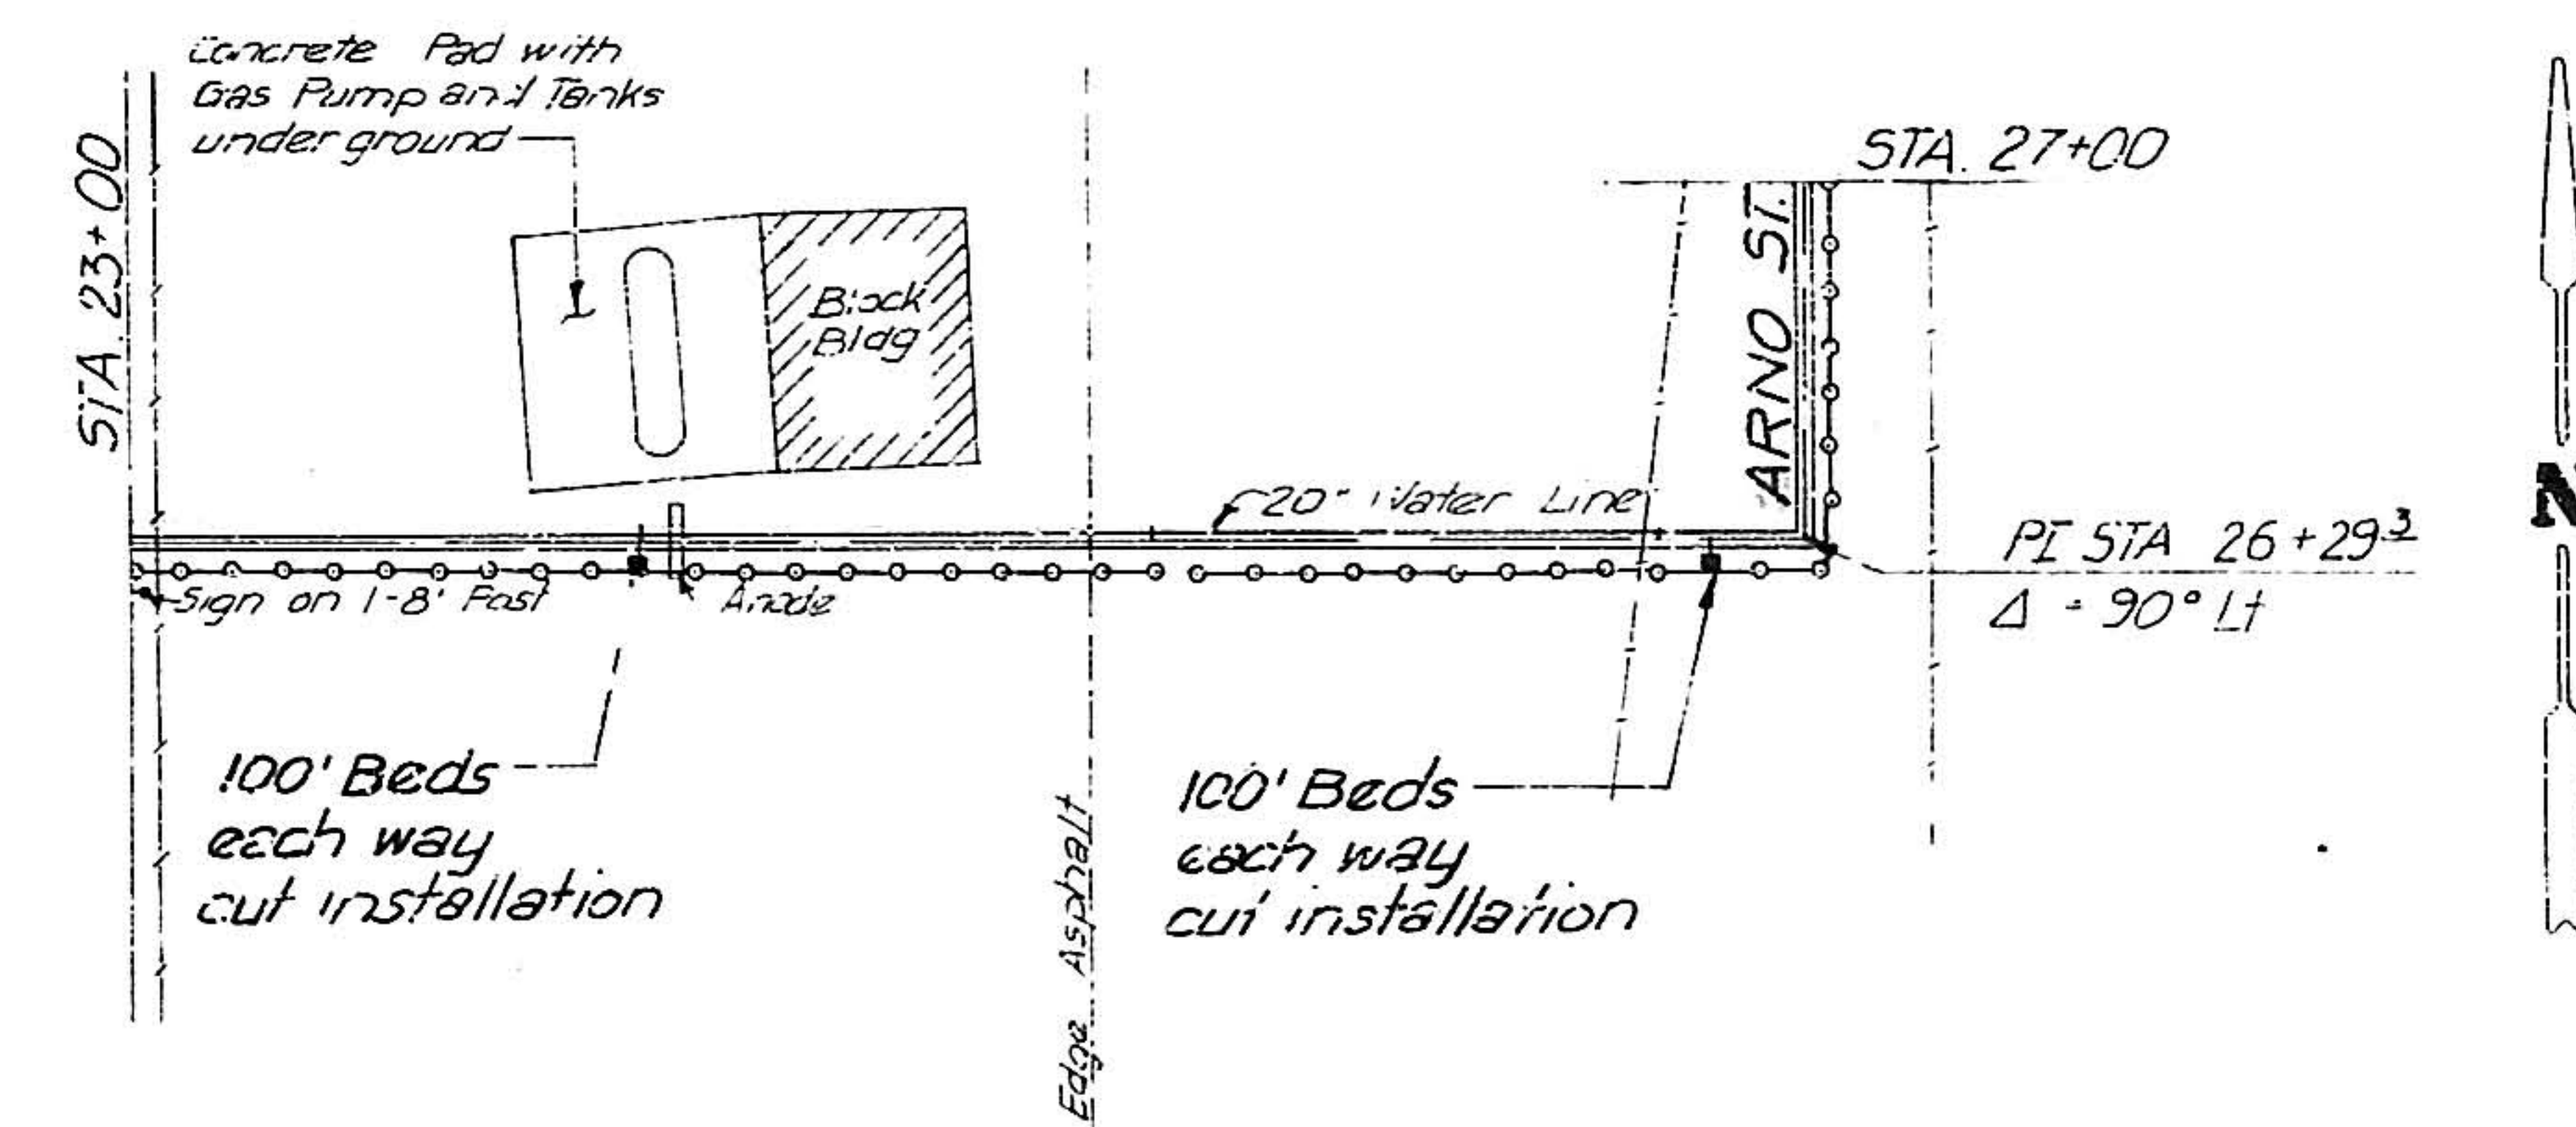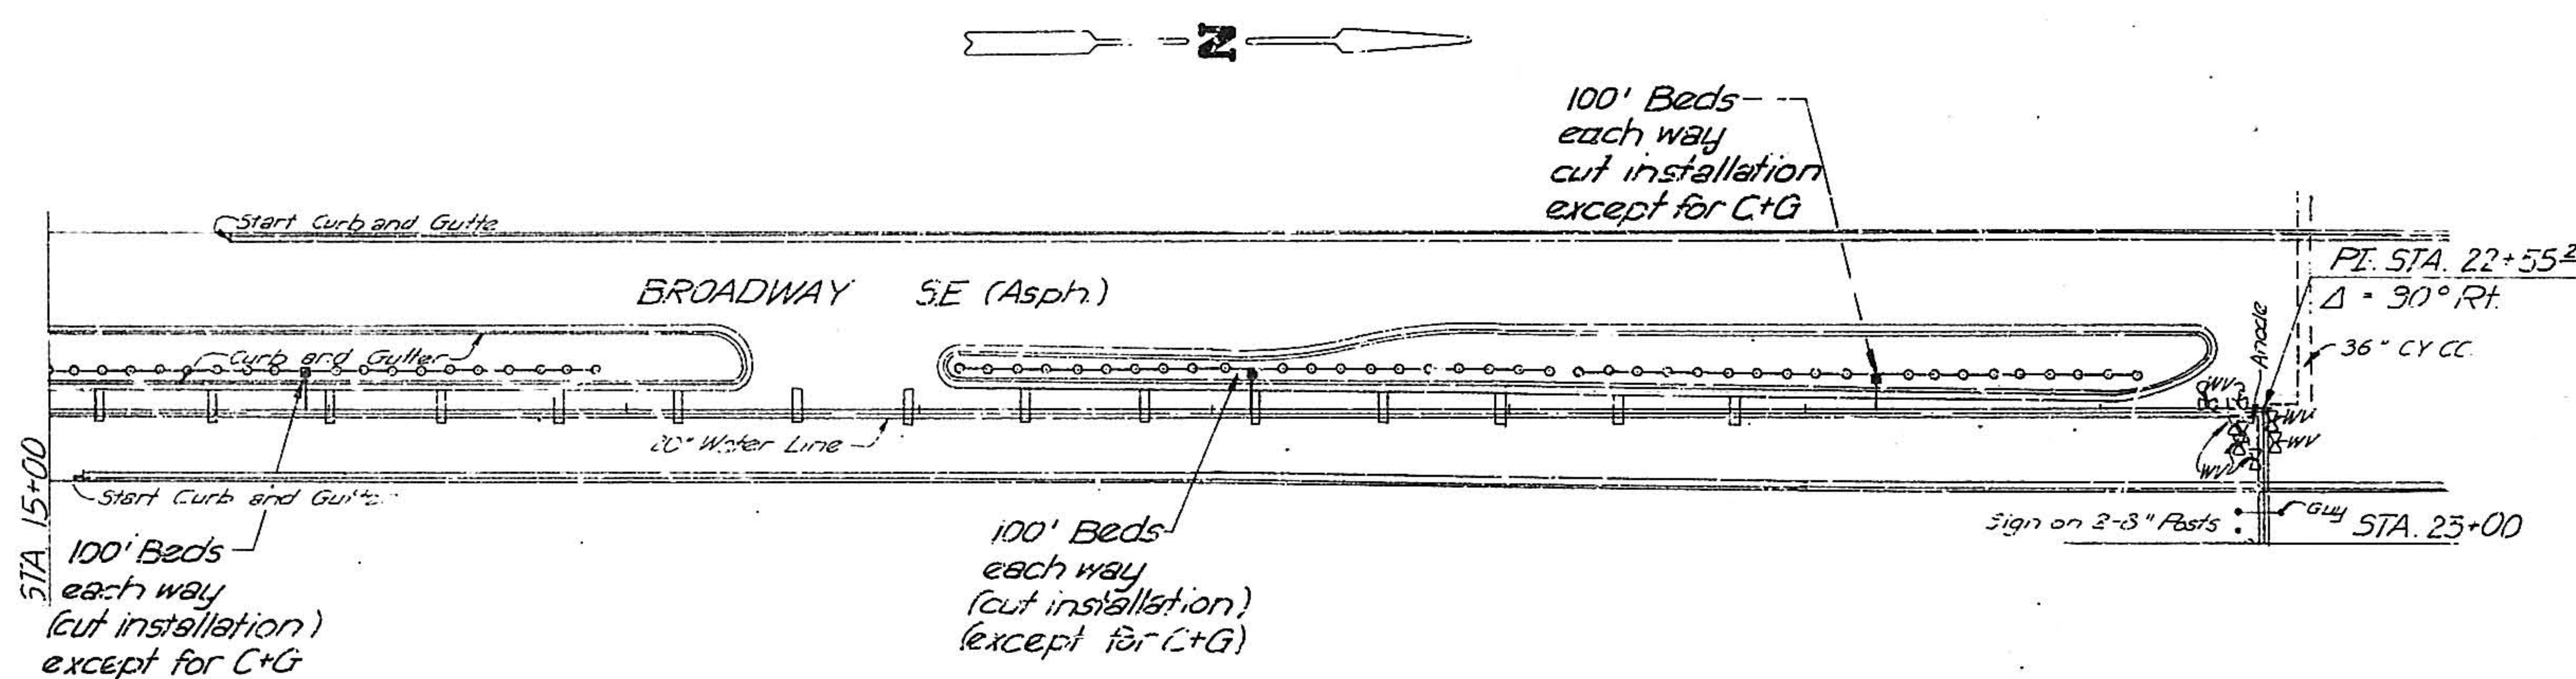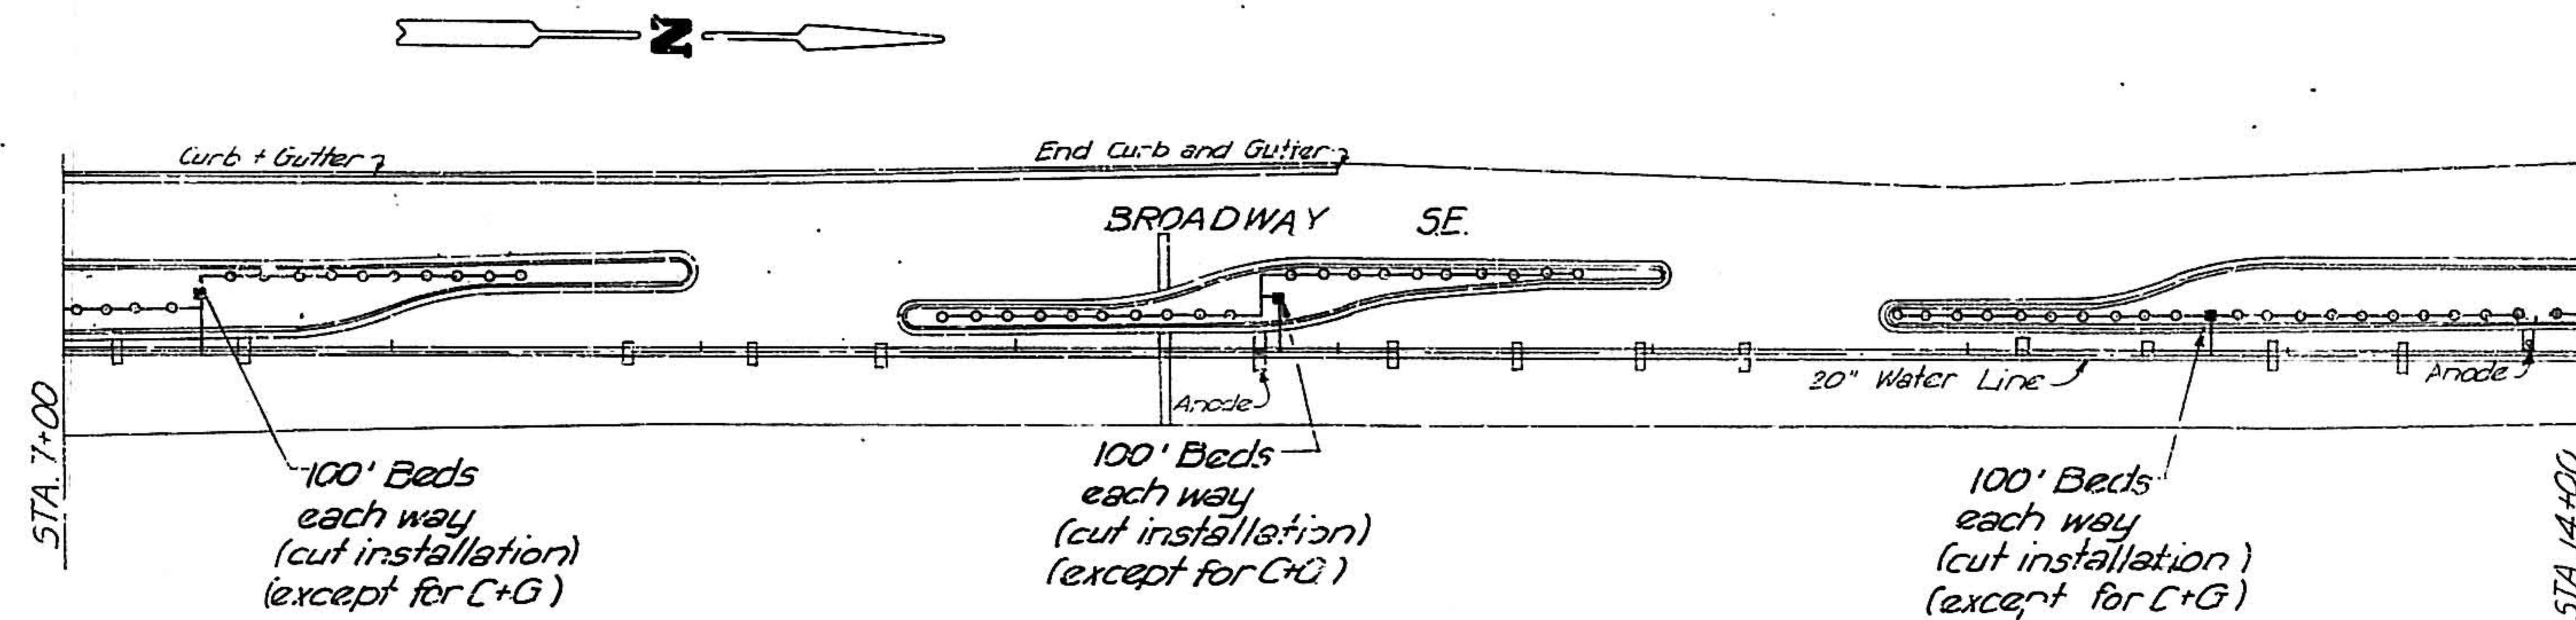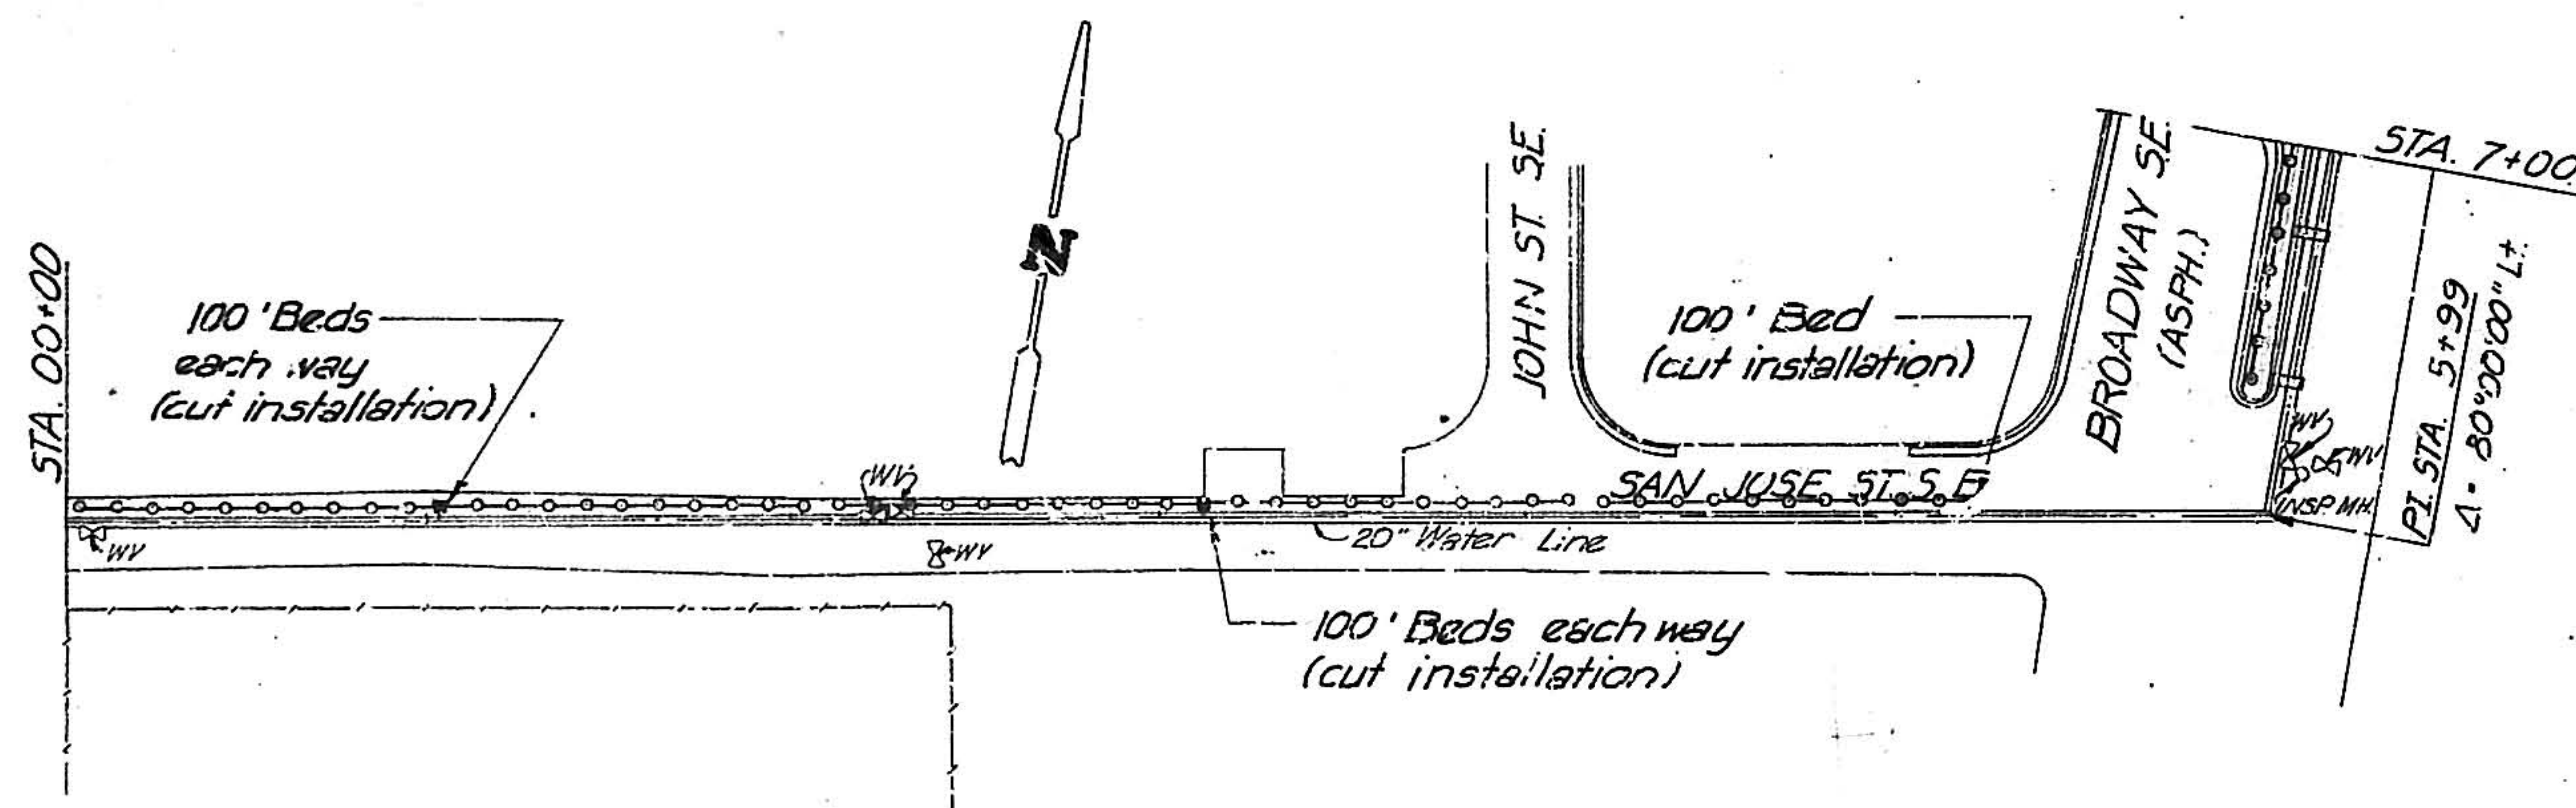


| |
|---|
| 1 | 2 |
|---|










 

|   |   
|---|---|---|---|---|---|---|---|---|----|----|----|----|----|----|----|----|----|----|----|----|----|----|----|----|----|----|----|----|----|---|
| 1 | 2 | 3 | 4 | 5 | 6 | 7 | 8 | 9 | 10 | 11 | 12 | 13 | 14 | 15 | 16 | 17 | 18 | 19 | 20 | 21 | 22 | 23 | 24 | 25 | 26 | 27 | 28 | 29 | 30 |   |
| 0 | 9 |   | 0 | 0 | 6 |   | 2 | 1 | 7  | 5  |    |    |    |    |    | 1  | 4  |    |    |    |    |    |    |    |    | 5  | 6  | 1  | 6  | 2 |



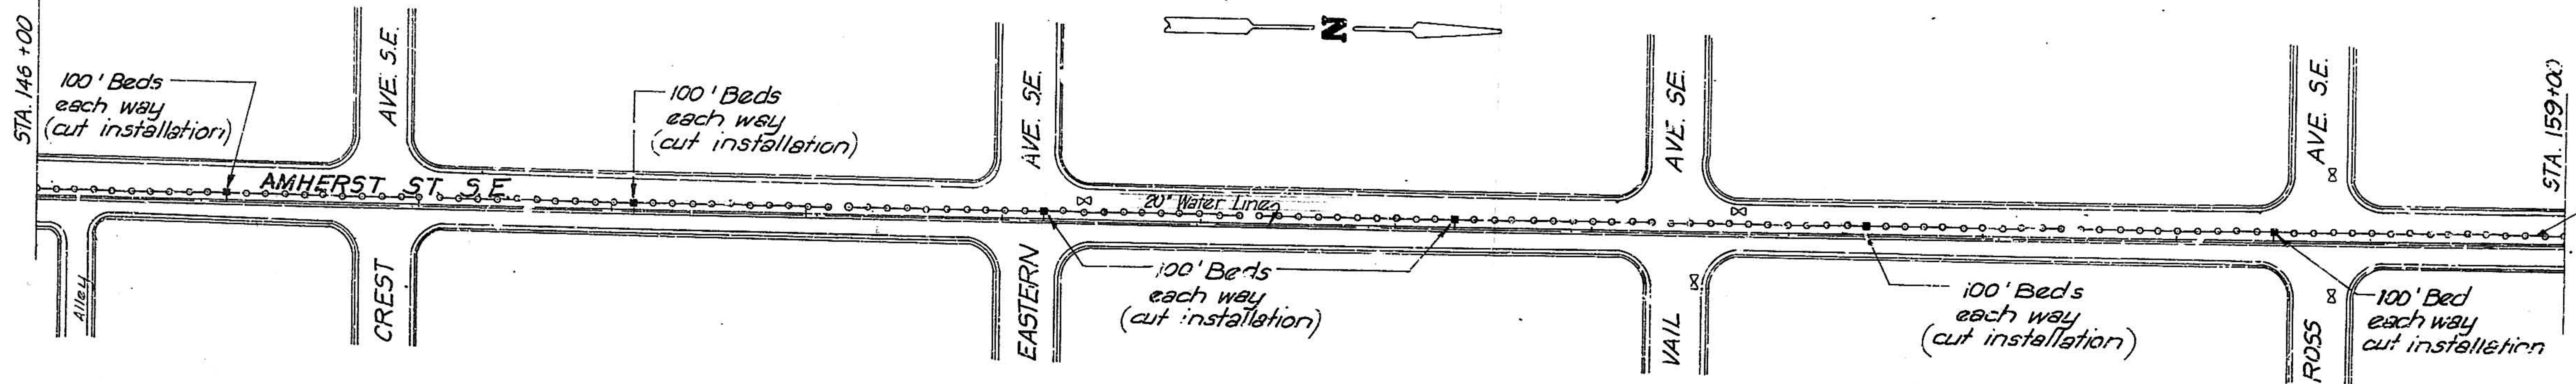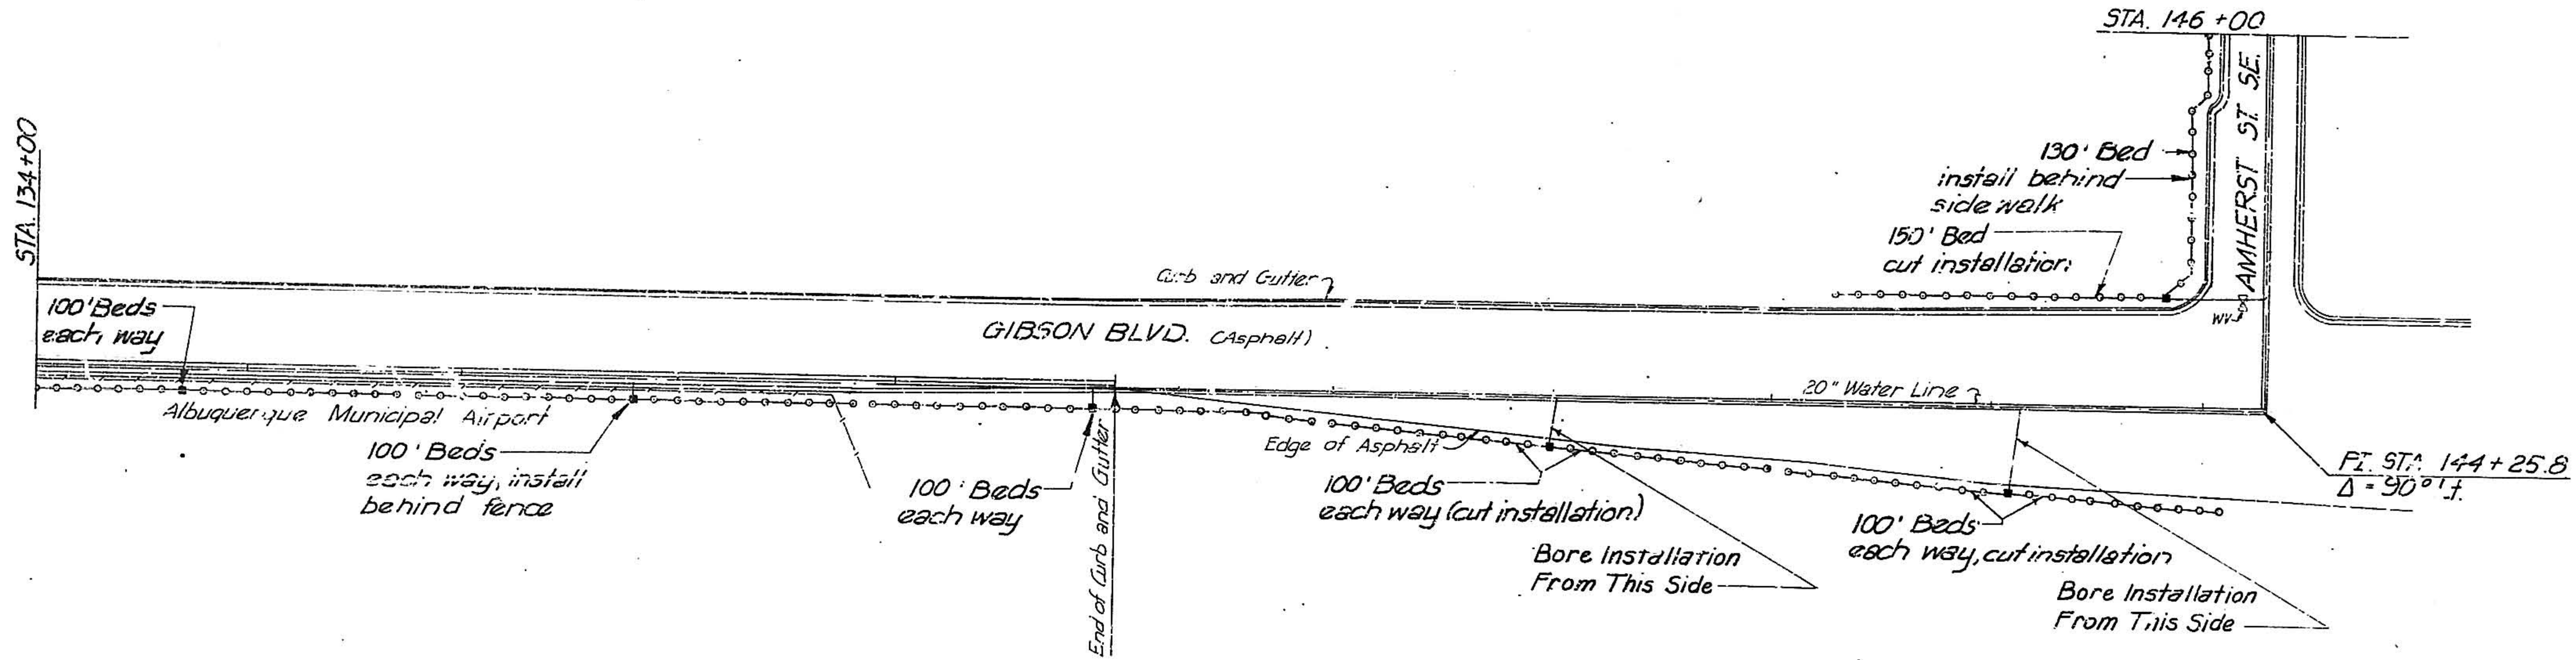 

|    |    
|----|----|----|----|----|---|---|---|---|----|----|----|----|----|----|----|----|----|----|----|----|----|----|----|----|----|----|----|----|----|
| 1  | 2  | 3  | 4  | 5  | 6 | 7 | 8 | 9 | 10 | 11 | 12 | 13 | 14 | 15 | 16 | 17 | 18 | 19 | 20 | 21 | 22 | 23 | 24 | 25 | 26 | 27 | 28 | 29 | 30 |
| 09 | 00 | 06 | 22 | 75 |   |   |   |   |    |    |    |    | 14 |    |    |    |    |    |    |    |    |    |    |    |    |    |    |    |    |


EA

100' Bed Cut Installation  
See Next Page

RECORD DRAWING  
DATE FEB 3 1974

|                                      |                   |
|--------------------------------------|-------------------|
| ALBUQUERQUE, NEW MEXICO              |                   |
| MILES TRANSMISSION LINES             |                   |
| PHASES 1 AND 2                       |                   |
| CORROSION CONTROL                    |                   |
| FOR                                  |                   |
| SAN JOSE WATER LINE                  |                   |
| GORDON HERKENHOFF & ASSOCIATES, INC. |                   |
| ENGINEERS • PLANNERS                 |                   |
| ALBUQUERQUE NEW MEXICO               |                   |
| JAN 1974<br>DATE                     | 1" = 50'<br>SCALE |



 

|    |    
|----|----|----|----|----|---|---|---|---|----|----|----|----|----|----|----|----|----|----|----|----|----|----|----|----|----|----|----|----|----|
| 1  | 2  | 3  | 4  | 5  | 6 | 7 | 8 | 9 | 10 | 11 | 12 | 13 | 14 | 15 | 16 | 17 | 18 | 19 | 20 | 21 | 22 | 23 | 24 | 25 | 26 | 27 | 28 | 29 | 30 |
| 09 | 00 | 06 | 23 | 75 |   |   

RECORD DRAWING  
DATE 1983

**ALBUQUERQUE, NEW MEXICO**

MILES TRANSMISSION LINES

PHASES 1 AND 2

CORROSION CONTROL

FOR

SAN JOSE WATER LINE

GORDON HERKENHOFF & ASSOCIATES, INC.

ENGINEERS • PLANNERS

ALBUQUERQUE NEW MEXICO

JAN 1974

DATE

1" = 50'

SCALE