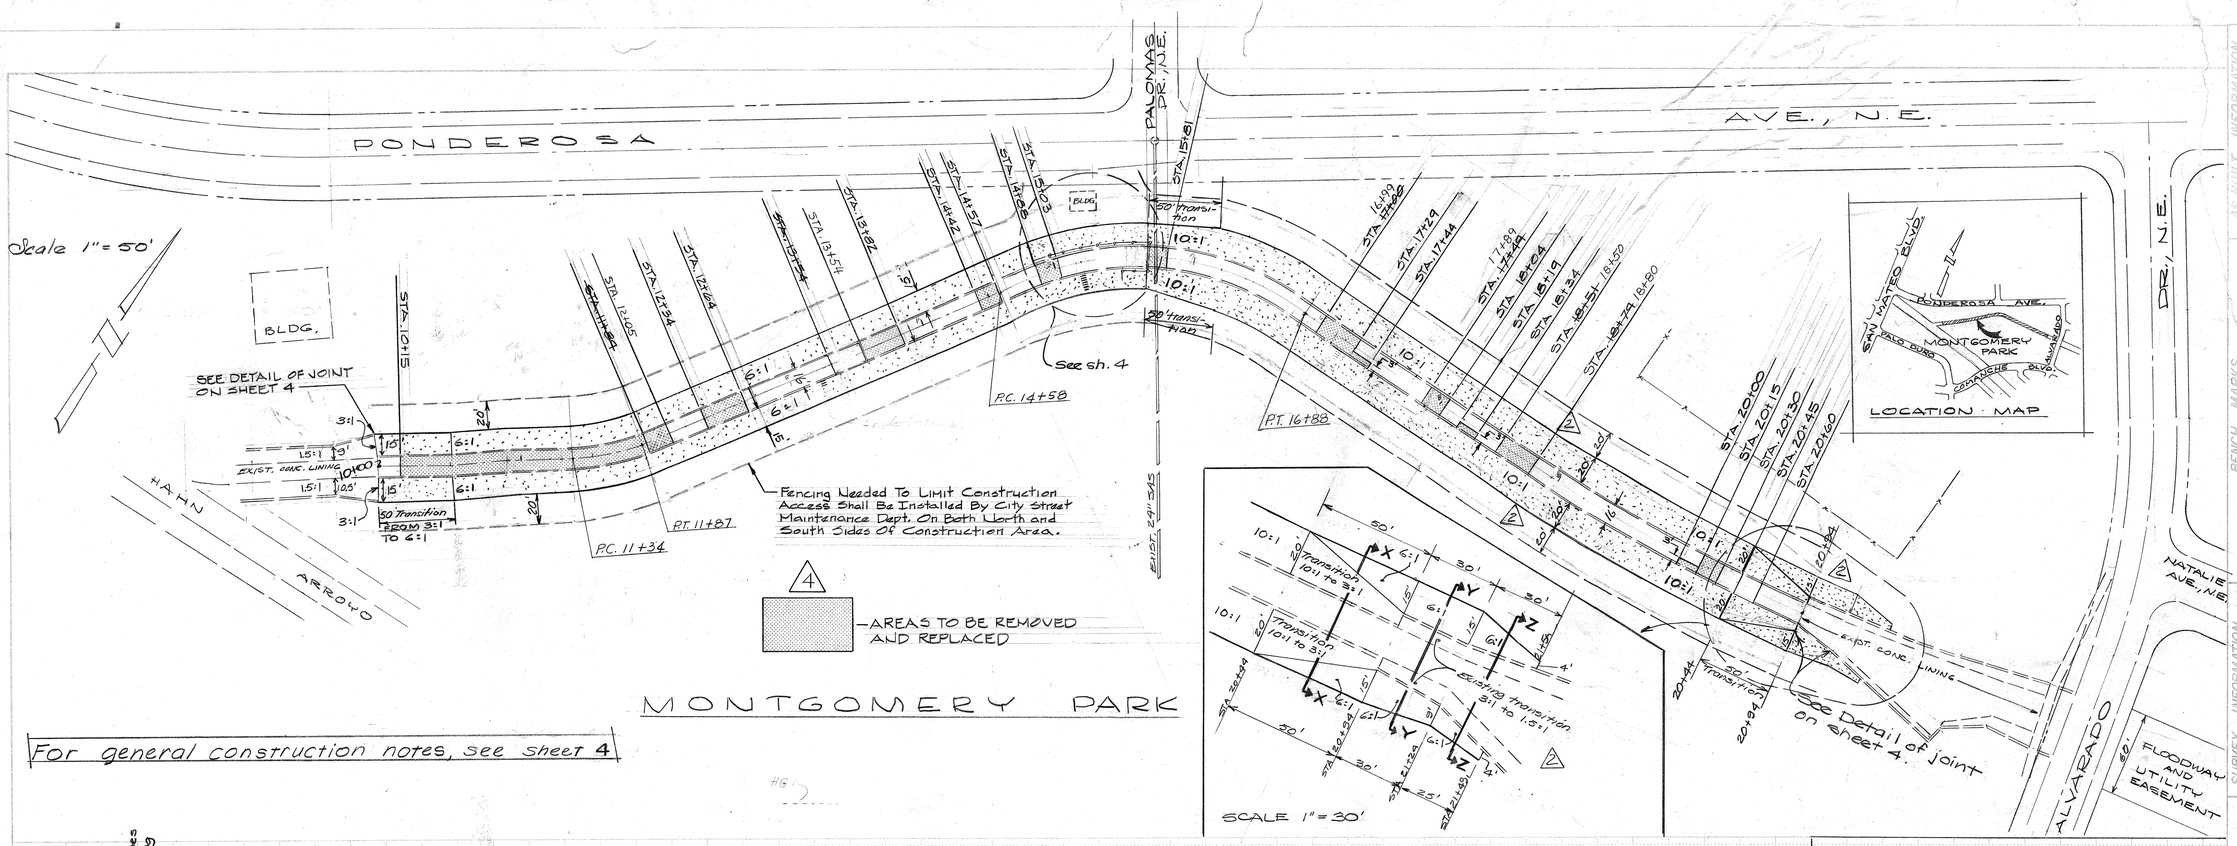

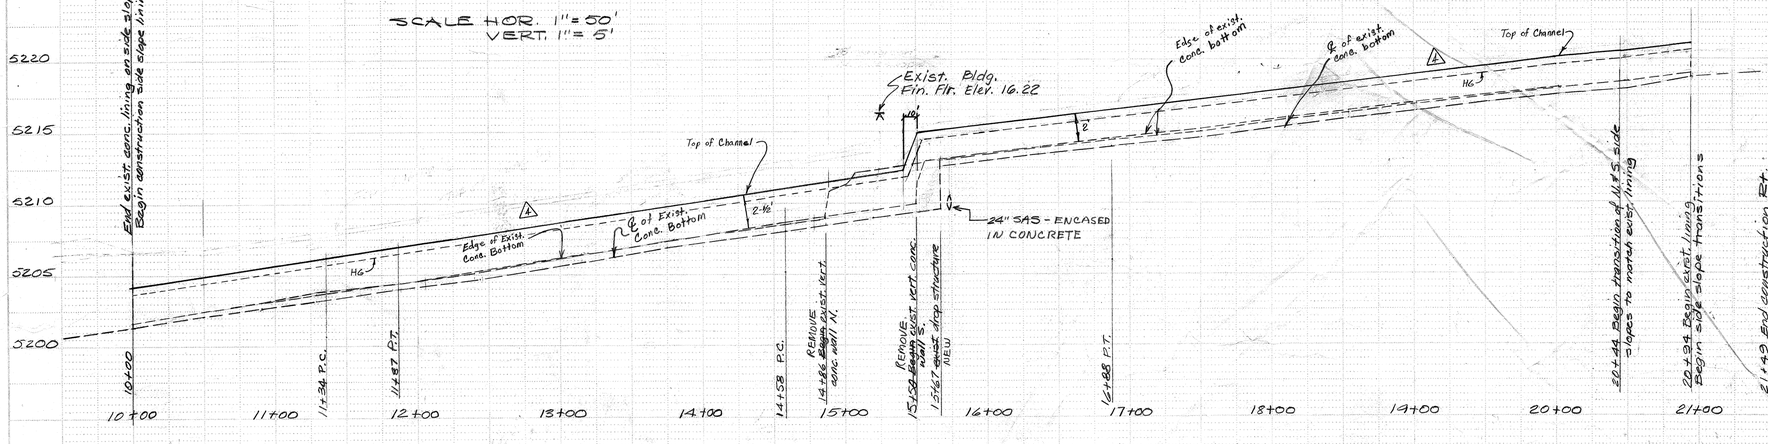

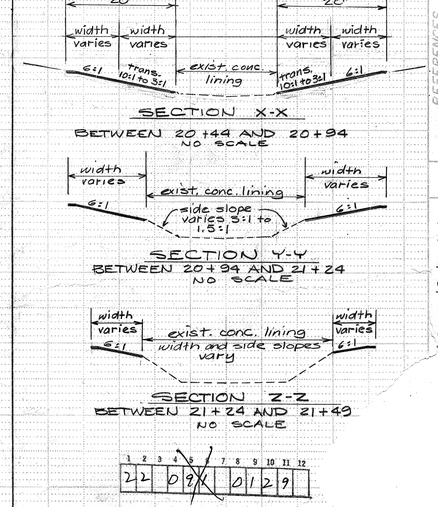

NOTES:

1. EXPANSION JOINTS -

STA. 10+00	SLOPES ONLY		15+67	SLOPES & FLOOR	
10+15	SLOPES & FLOOR		15+83	"	"
11+02	"	"	16+43	"	"
12+07	"	"	17+03	"	"
12+67	"	"	17+78	"	"
13+27	"	"	18+33	"	"
13+87	"	"	19+13	"	"
14+62	"	"	20+94	"	"
15+22	"	"			

2. CONTRACTION JOINTS EVERY 15'±

3. SLOPES FROM 10+15 TO 15+17 15' WIDE
SLOPES FROM 15+17 TO 15+67 15' TO 20' (TRANSITION)
SLOPES FROM 15+67 TO 20+94 20' WIDE

TWO WORKING DAYS PRIOR TO ANY EXCAVATION, CONTRACTOR MUST CONTACT 'INE LOCATING SERVICE, 765-1234, FOR LOCATION OF EXISTING UTILITIES.

ALL SHEETS
APPROVAL OF AS BUILT DRAWINGS
ASST. CITY ENGINEER - FIELD
DATE 2-11-82

NOTICE TO CONTRACTOR
PRIOR TO EXCAVATION, THE CONTRACTOR SHALL EXCAVATE AND VERIFY THE HORIZONTAL AND VERTICAL LOCATIONS OF ALL OBSTRUCTIONS. SHOULD A CONFLICT EXIST, THE CONTRACTOR SHALL NOTIFY THE ENGINEER OR SURVEYOR SO THAT THE CONFLICT CAN BE RESOLVED WITH A MINIMUM AMOUNT OF DELAY

REV. ⚠ APPROVAL	
Richard S Hollen	11/3/80
CITY ENGINEER	DATE
REV. ⚠ APPROVAL	
Richard S Hollen	12/1/80
CITY ENGINEER	DATE
APPROVED FOR CONSTRUCTION	
Richard S Hollen	JUL 3, 80
CITY ENGINEER	DATE

CITY OF ALBUQUERQUE
PUBLIC WORKS DEPARTMENT
ENGINEER

TITLE: MONTGOMERY PARK DRAINAGE C

APPROVALS	ENGINEER	DATE
City Engineer		
A.C.E.- Design	C.G.K. Bellah	12 Dec 80
A.C.E.- Hydrology		
PARKS & REC.	V.R. Allyn	7-2-80

DRAWING NO. SD-29-91

AS BUILT INFORMATION
CONTRACTOR
WORK STARTED BY
WORK COMPLETED
ACCEPTED/CP
FILE
VOL
PAGE

BENCH MARKS
RIM M.H. # 307-618 AT PONDEROSA
ELEV. 5217.10

SURVEY INFORMATION
FIELD NOTES

NO.	BY	DATE
PS-6	ANGEL	6-24-80
	& PALOMAS	

REFERENCES

MAP NO.	C-18 (M)
EST. NO.	
WO. NO.	
	SD-29-91

NO.	REMARKS	BY	DATE
1	Remove & Replace Lining Sta 14+86 to 15+67 (Remove 15'+67 to 20+94 & 21+54 Stationing Sheet 2)		

REVISIONS

2 2 0 9 X 0 1 2 9

2 0 0 9 1 0 1 2 9