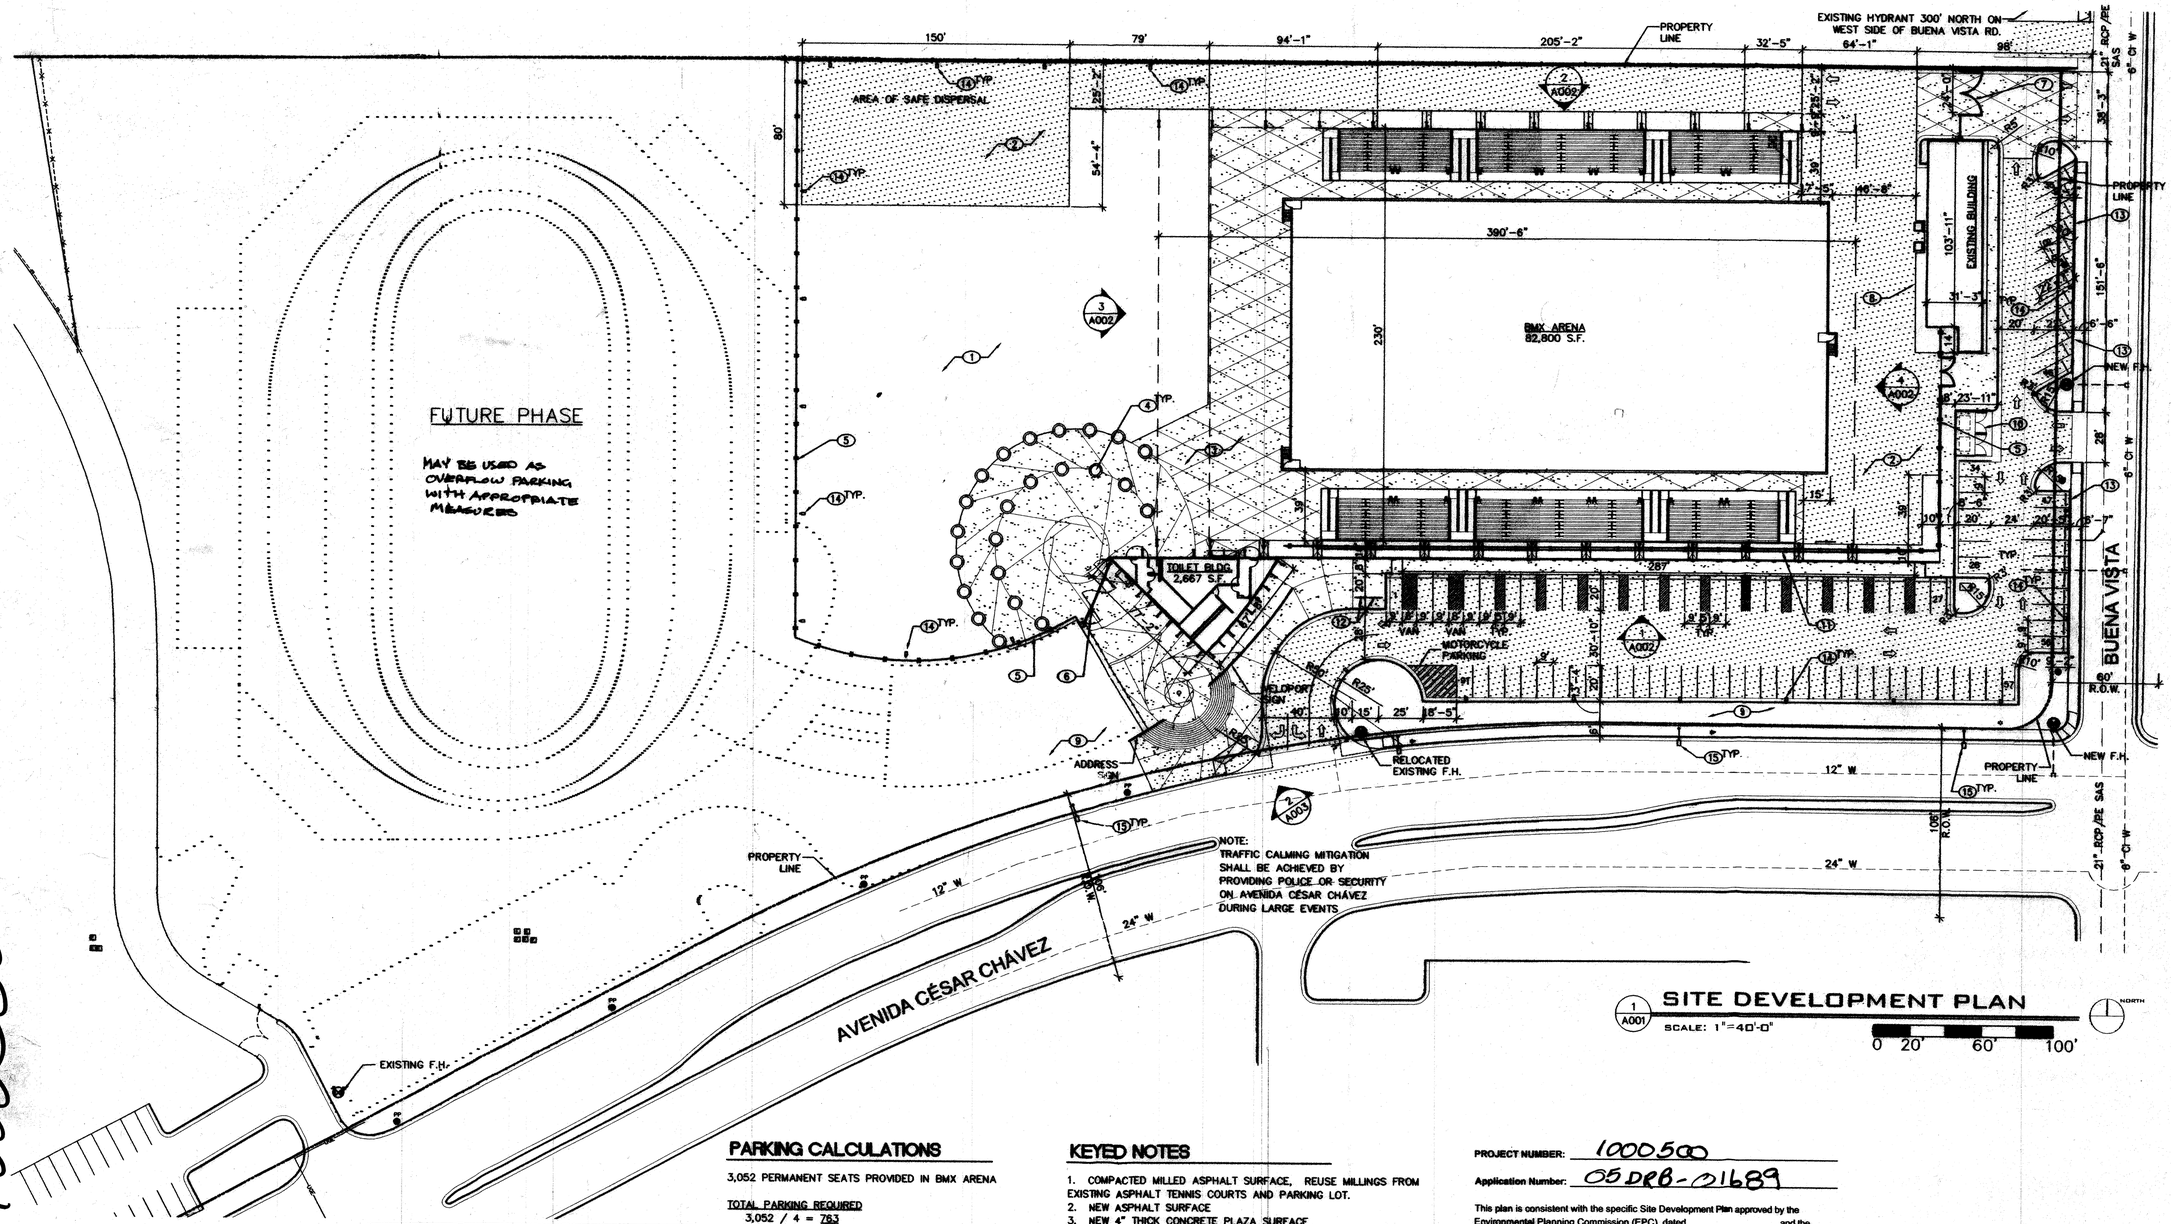

PROJECT 1000500

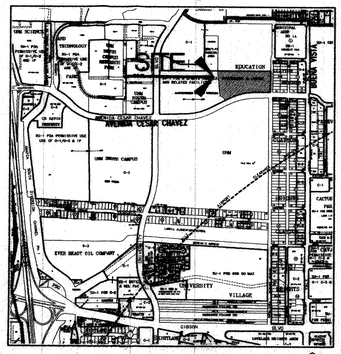

VICINITY MAP – L-15-Z NORTH

PARKING CALCULATIONS

3,052 PERMANENT SEATS PROVIDED IN BMX ARENA

TOTAL PARKING REQUIRED
3,052 / 4 = 763

TOTAL ACCESSIBLE PARKING REQUIRED
16 ACCESSIBLE SPACES
3 OF WHICH MUST BE VAN ACCESSIBLE

TOTAL PARKING PROVIDED
91 ON SITE PARKING SPACES
THE REMAINING 672 SPACES WILL BE PROVIDED THROUGH A SHARED PARKING AGREEMENT WITH UNM STADIUM PARKING ON THE SOUTH SIDE OF AVENIDA CESAR CHAVEZ

TOTAL ACCESSIBLE PARKING PROVIDED
13 PERMANENT ACCESSIBLE SPACES
3 PERMANENT VAN ACCESSIBLE SPACES
10 TEMPORARY ACCESSIBLE SPACES

BIKE SPACES REQUIRED
CONDITION 3.c. OF THE EPC NOTICE OF DECISION DATED FEB. 17, 2005 FOR PROJECT #1000500 STATES "The applicant shall provide a total of 25 bicycle parking spaces for both the Albuquerque Bicycle Park, Isotope Stadium..."

BIKE SPACES PROVIDED
14 PROVIDED IN PHASE 1
THE REMAINING 11 WILL BE PROVIDED IN A FUTURE CONSTRUCTION PHASE

KEYED NOTES

1. COMPACTED MILLED ASPHALT SURFACE, REUSE MILLINGS FROM EXISTING ASPHALT TENNIS COURTS AND PARKING LOT.
2. NEW ASPHALT SURFACE
3. NEW 4" THICK CONCRETE PLAZA SURFACE
4. 7'-8" DIAMETER RAISED TREE WELL/BENCH, REF. LANDSCAPE PLAN
5. NEW 6' HIGH CHAIN LINK FENCE
6. NEW 10' HIGH CUSTOM DESIGN PIVOT GATES
7. NEW 6' CHAIN LINK VEHICLE ACCESS GATE
8. NEW RETAINING WALL AROUND EXISTING BUILDING
9. PLANTING AREA, REF. LANDSCAPE PLAN
10. DOUBLE REFUSE CONTAINER ENCLOSURE, LOCATION APPROVED BY MICHAEL HOLTON ON 10.19.05, REF. DTL. 5/A003
11. 8' HIGH CHAIN LINK FENCE WITH BLACK PLASTIC COATING, DOUBLE LINES INDICATED SLOPING FENCE IN PLAN VIEW
12. STEEL PIPE BIKE RACK, SPACE FOR 7 BIKES
13. PROVIDE 3' HIGH CMU SCREEN WALL WITH STUCCO FINISH
14. NEW POLE MOUNTED SITE LIGHT, REF. DTL 3/A003
15. EXISTING STREET LIGHTS ALONG AVENIDA CÉSAR CHÁVEZ

PROJECT NUMBER: 1000500

Application Number: 05DRB-01689

This plan is consistent with the specific Site Development Plan approved by the Environmental Planning Commission (EPC), dated and the Findings and Conditions in the Official Notification of Decision are satisfied.

Is an Infrastructure List required? ( ) Yes (X) No If yes, then a set of approved DRC plans with a work order is required for any construction within Public Right-of-Way or for construction or public improvements.

DRB SITE DEVELOPMENT PLAN SIGNOFF APPROVAL:

Traffic Engineering/Transportation Division	11-15-05 Date
Water Utility Department	11/9/05 Date
Parks and Recreation Department	11/9/05 Date
City Engineer	11/9/05 Date
* Environmental Health Department (conditional)	N/A Date
Solid Waste Management	11/16/05 Date
DRB Chairperson, Planning Department	11/09/05 Date

AS BUILT INFORMATION
CONTRACTOR DATE:
WORK STAKED BY DATE:
INSPECTOR'S APPROVAL DATE:
FIELD VERIFICATION BY DATE:
DRAWING CORRECTED BY DATE:
MICRO-FILM INFORMATION
RECORDED BY DATE:
NO.

BENCH MARK
ALL ELEVATIONS ARE BASED UPON ALBUQUERQUE CONTROL SURVEY MONUMENT: 7-L15

SURVEY INFORMATION
FIELD NOTES

NO.	BY	DATE

ARCHITECTS STAMP

NO.	DATE	REVISIONS/REMARKS	BY

DESIGNED BY: DATE:
DRAWN BY: DATE:
CHECKED BY: DATE:

Kells + Craig
Architects, Inc. AIA
400 Gold SW
Suite 880
Albuquerque, New Mexico 87102
(505) 243-2724

G. DONALD DUDLEY AIA
ARCHITECT
SIMMS TOWER STUDIO 850
400 GOLD AVENUE SW
ALBUQUERQUE, NEW MEXICO
87102
TEL 505.243.8100
FAX 505.243.8101

CITY OF ALBUQUERQUE
DEPARTMENT OF MUNICIPAL DEVELOPMENT

TITLE: SITE DEVELOPMENT PLAN FOR BUILDING PERMIT
ALBUQUERQUE BICYCLE PARK PH. 1

NOVEMBER 8, 2005

Design Review Committee	City Engineer Approval	Last Design Update	MO./DAY/YR.	MO./DAY/YR.

City Project No.	Zone Map No.	Sheet	Of
7345-02	L-15-Z	A001	

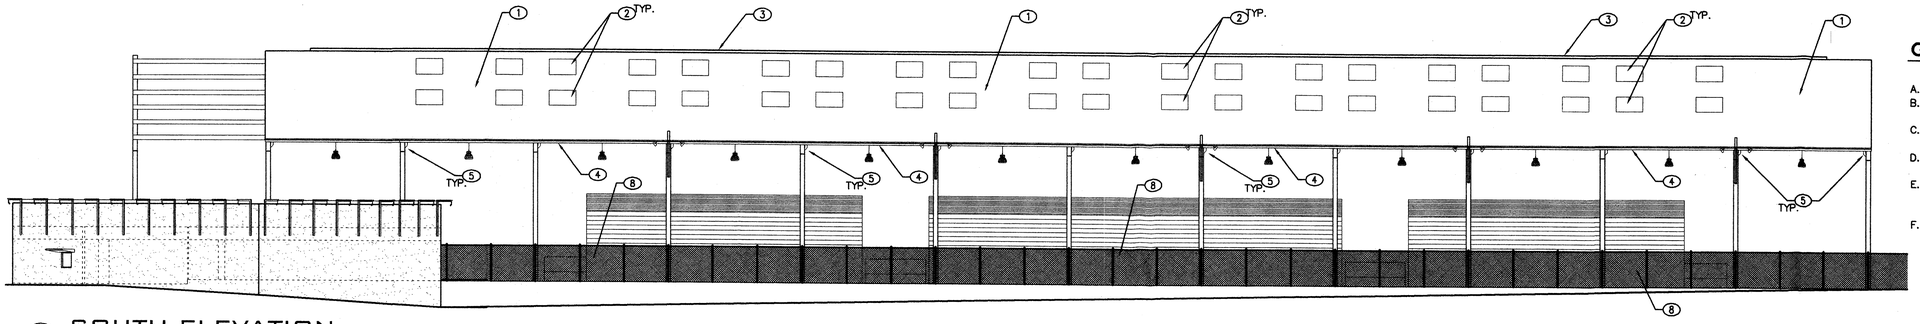

1 A002 SOUTH ELEVATION

SCALE: 1/16"=1'-0"

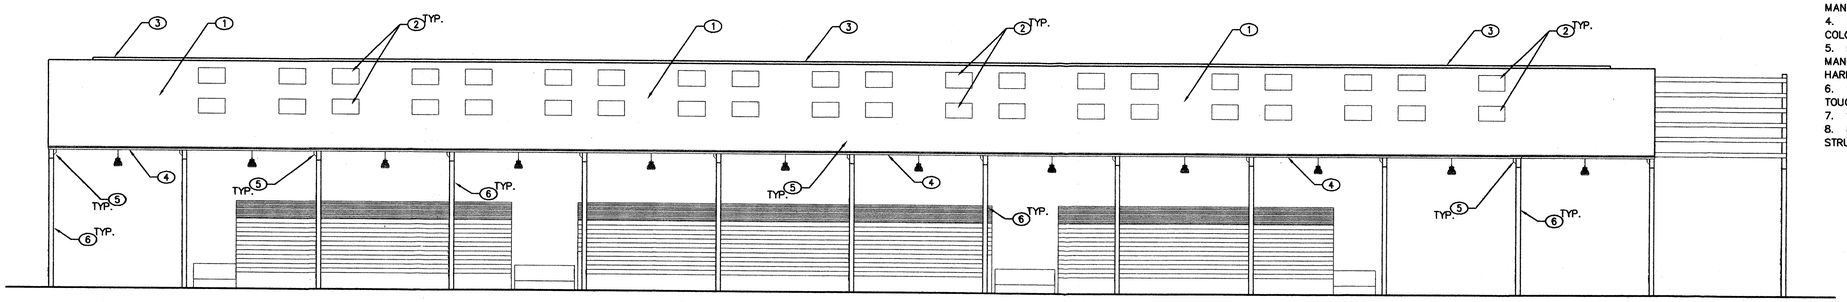

2 A002 NORTH ELEVATION

SCALE: 1/16"=1'-0"

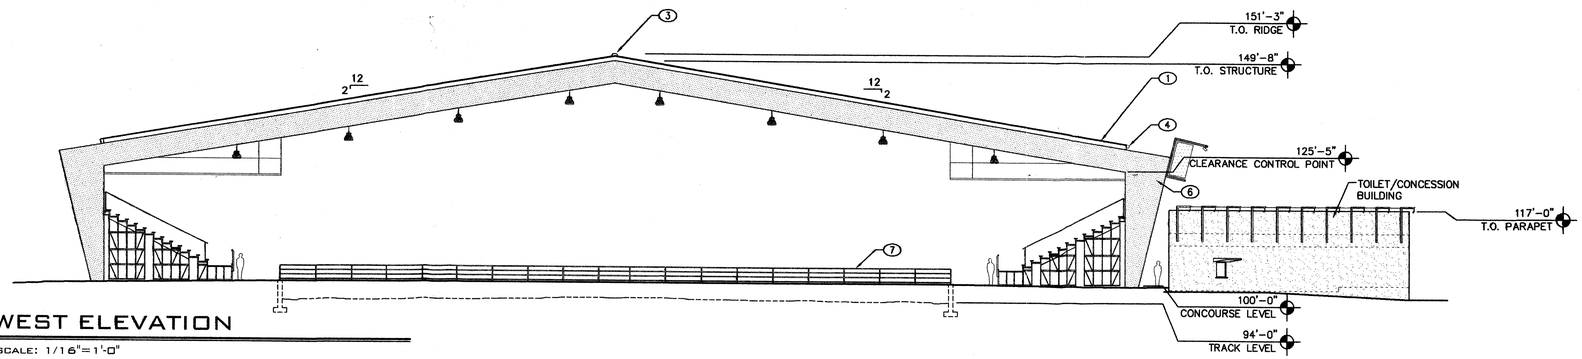

3 A002 WEST ELEVATION

SCALE: 1/16"=1'-0"

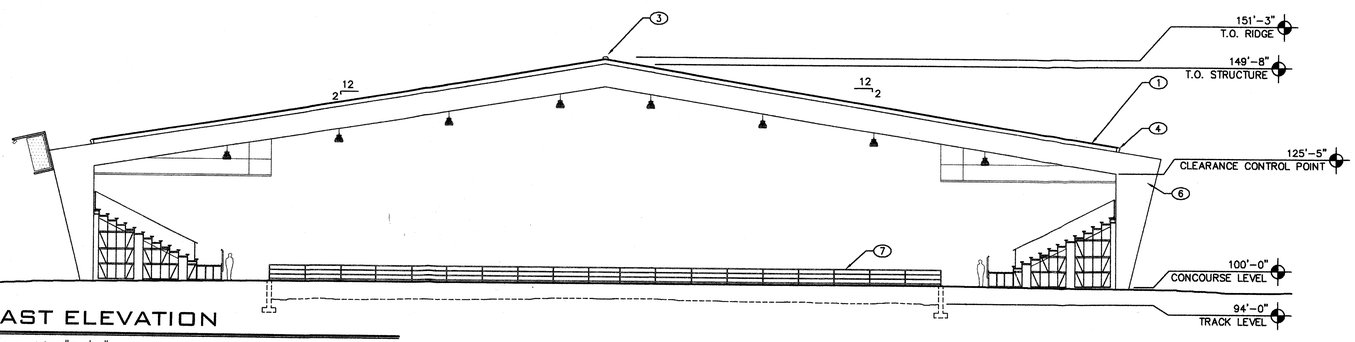

4 A002 EAST ELEVATION

SCALE: 1/16"=1'-0"

GENERAL NOTES

A. DO NOT SCALE DRAWINGS
B. CONTRACTOR TO COORDINATE ALL DRAWINGS PRIOR TO CONSTRUCTION
C. VERIFY EXISTING CONDITIONS IN FIELD. BRING DISCREPANCIES TO THE ATTENTION OF ARCHITECT
D. DIMENSIONS ARE TO FACE OF STUDS UNLESS OTHERWISE NOTED
E. F.F. INDICATES THAT THE DIMENSION IS A CRITICAL FINISHED DIMENSION MEASURED FROM FINISHED FACE TO FINISHED FACE
F. TOP OF TRACK AREA RETAINING WALL AND CONCOURSE LEVEL INDICATED AS 100'-0". ALL VERTICAL DIMENSIONS ARE MEASURED FROM THIS POINT

KEYED NOTES

1. PREFINISHED METAL ROOF PANEL, SLOPE 2:12
2. 6'x20' CLEAR SKYLIGHT PANEL WITH PROFILE TO MATCH ROOFING PANELS
3. PREFINISHED RIDGE VENT BY METAL PANEL MANUFACTURER, COLOR TO MATCH ROOF PANEL
4. METAL GUTTER PREFINISHED TO MATCH ROOFING PANEL COLOR
5. PROVIDE PREFINISHED DOWNSPOUT, AND ATTACH MANUFACTURERS HANGERS TO STEEL FRAME, REF. CIVIL FOR HARD PIPED CONNECTIONS
6. STRUCTURAL STEEL FRAME, FACTORY PRIME AND FIELD TOUCH-UP
7. STEEL HANDRAIL AROUND SUB-GRADE TRACK AREA
8. 8' CHAIN LINK FENCE ATTACHED TO OUTSIDE FACE OF STRUCTURAL STEEL FRAME

AS BUILT INFORMATION
CONTRACTOR DATE:
WORK STAKED BY DATE:
INSPECTOR'S APPROVAL DATE:
FIELD VERIFICATION BY DATE:
DRAWING CORRECTED BY DATE:
MICRO-FILM INFORMATION
RECORDED BY DATE:
NO.

BENCH MARK
ALL ELEVATIONS ARE BASED UPON ALBUQUERQUE CONTROL SURVEY MONUMENT: 7-L15

SURVEY INFORMATION
FIELD NOTES

NO.	BY	DATE

ARCHITECTS STAMP

NO.	DATE	REVISIONS/REMARKS	BY

DESIGNED BY: DATE:
DRAWN BY: DATE:
CHECKED BY: DATE:

Kells + Craig
Architects, Inc. AIA
400 Gold SW
Suite 880
Albuquerque, New Mexico 87102
(505) 243-2724

G. DONALD DUDLEY AIA
ARCHITECT
SIMMS TOWER STUDIO 850
400 GOLD AVENUE SW
ALBUQUERQUE, NEW MEXICO
87102
TEL 505.243.8100
FAX 505.243.8101

CITY OF ALBUQUERQUE
DEPARTMENT OF MUNICIPAL DEVELOPMENT

TITLE: ARENA ELEVATIONS
ALBUQUERQUE BICYCLE PARK PH. 1

OCTOBER 28, 2005

Design Review Committee	City Engineer Approval	Last Design Update	MO./DAY/YR.	MO./DAY/YR.

City Project No.	Zone Map No.	Sheet	Of
7345-90	L-15-Z	A002	

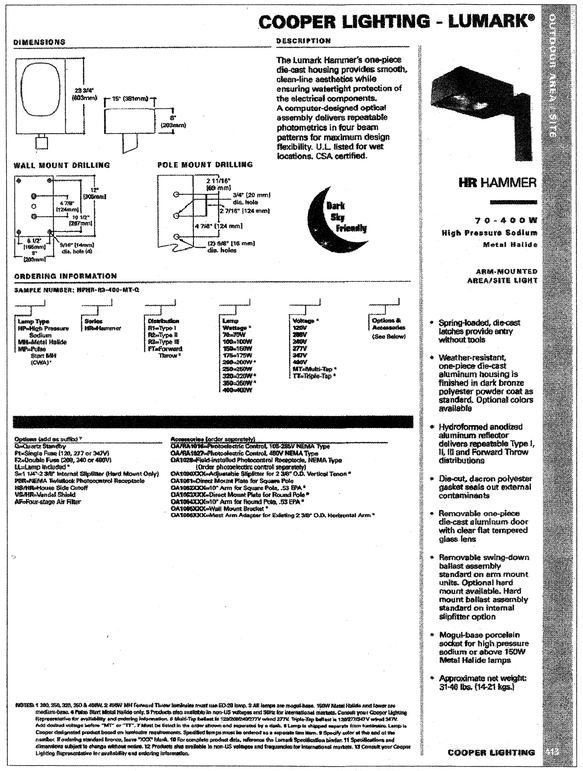

COOPER LIGHTING - LUMARK®

OUTDOOR AREA/SITE

DIMENSIONS

23 3/4" (603mm) · 15° (381mm) · 8" (203mm)

DESCRIPTION

The Lumark Hammer's one-piece die-cast housing provides smooth, clean-line aesthetics while ensuring watertight protection of the electrical components. A computer-designed optical assembly delivers repeatable photometrics in four beam patterns for maximum design flexibility. U.L. listed for wet locations. CSA certified.

WALL MOUNT DRILLING

4 7/8" [124mm] · 12" [305mm] · 10 1/2" [267mm] · 6 1/2" [165mm] · 9" [229mm] · 5/16" [14mm] dia. hole (4)

POLE MOUNT DRILLING

3 11/16" [93 mm] · 3/4" [20 mm] dia. hole · 2 7/16" [124 mm] · 4 7/8" [124 mm] · (2) 5/8" [16 mm] dia. holes

Dark Sky Friendly

HR HAMMER

70-400W
High Pressure Sodium
Metal Halide

ARM-MOUNTED AREA/SITE LIGHT

- Spring-loaded, die-cast latches provide entry without tools
- Weather-resistant, one-piece die-cast aluminum housing is finished in dark bronze polyester powder coat as standard. Optional colors available
- Hydroformed anodized aluminum reflector delivers repeatable Type I, II, III and Forward Throw distributions
- Die-cut, dacron polyester gasket seals out external contaminants
- Removable one-piece die-cast aluminum door with clear flat tempered glass lens
- Removable swing-down ballast assembly standard on arm mount units. Optional hard mount available. Hard mount ballast assembly standard on internal slipfitter option
- Mogul-base porcelain socket for high pressure sodium or above 150W Metal Halide lamps
- Approximate net weight: 31-46 lbs. (14-21 kgs.)

ORDERING INFORMATION

SAMPLE NUMBER: HPER-R3-400-MT-G

Lamp Type: HP=High Pressure Sodium; MH=Metal Halide; MP=Pulse Start MH (CWA)*
Series: HR=Hammer
Distribution: R3=Type I; R2=Type II; R5=Type III; FT=Forward Throw*
Lamp Wattage*: 70=70W; 100=100W; 150=150W; 175=175W; 200=200W*; 250=250W; 320=320W*; 350=350W*; 400=400W
Voltage*: 120V; 208V; 240V; 277V; 347V; 480V; MT=Multi-Tap*; TS=Triple-Tap*
Options & Accessories (See Below)

Options (add as suffix)*
G=Quartz Standby
P1=Single Fuse (120, 277 or 347V)
P2=Double Fuse (208, 240 or 480V)
L=Lamp Included*
Sr1 1/4"-2 3/8" Internal Slipfitter (Hard Mount Only)
PRR=NEMA Twistlock Photocontrol Receptacle
HS=Hinged-House Side Cutoff
VS=Visor-Vandal Shield
AF=Four-stage Air Filter

Accessories (order separately)
OA/RA1516=Photoelectric Control, 105-285V NEMA Type
OA/RA1527=Photoelectric Control, 480V NEMA Type
OA1029=Field-installed Photocontrol Receptacle, NEMA Type (Order photoelectric control separately)
OA1080XXX=Adjustable Slipfitter for 2 3/8" O.D. Vertical Tenon*
OA1081=Direct Mount Plate for Square Pole
OA1082XXX=10" Arm for Square Pole, .53 EPA*
OA1083XXX=Direct Mount Plate for Round Pole*
OA1084XXX=10" Arm for Round Pole, .53 EPA*
OA1085XXX=Wall Mount Bracket*
OA1086XXX=Mast Arm Adapter for Fitting 2 3/8" O.D. Horizontal Arm*

NOTES: 1 250, 310, 320, 350 & 400W, 2 400W MH Forward Throw lamps must use E23 lamp. 3 All lamps are mogul-base. 150W Metal Halide and lower are medium-base. 4 Pulse Start Metal Halide only. 5 Products also available in non-US voltages and 50Hz for international markets. Consult your Cooper Lighting Representative for availability and ordering information. 6 Multi-Tap ballast is 120/208/240/277V rated 277V. Triple-Tap ballast is 120/277/347V rated 347V. Add desired voltage before "MT" or "TS". If filled be listed in the order shown and separated by a dash. 8 Lamp is shipped separate from luminaire. Lamp is Cooper designated product based on luminaire requirements. Specified lamps must be ordered as a separate line item. 9 Specify color at the end of the number. If ordering standard bronze, leave "XXX" blank. 10 For complete product data, reference the Lumark Specification binder. 11 Specifications and dimensions subject to change without notice. 12 Products also available in non-US voltages and frequencies for international markets. 13 Consult your Cooper Lighting Representative for availability and ordering information.

COOPER LIGHTING 413

1/A003 POLE MOUNTED LIGHT
SCALE: NTS

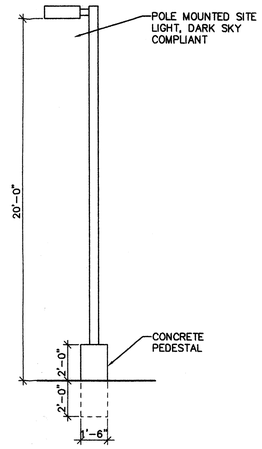

3/A003 POLE MOUNTED LIGHT
SCALE: 1/4"=1'-0"

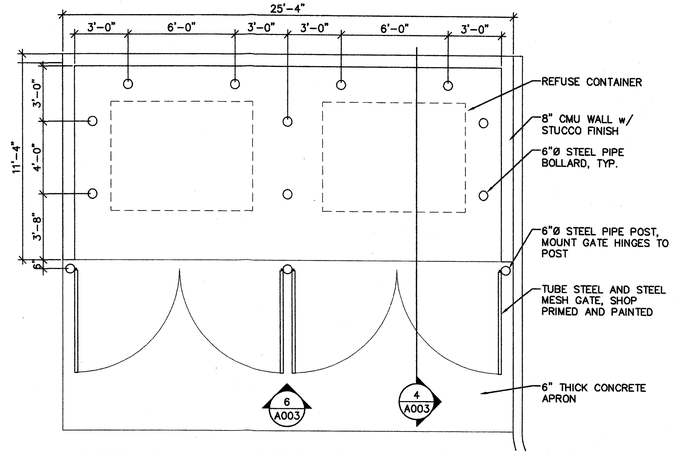

5/A003 REFUSE ENCLOSURE - PLAN
SCALE: 1/4"=1'-0"

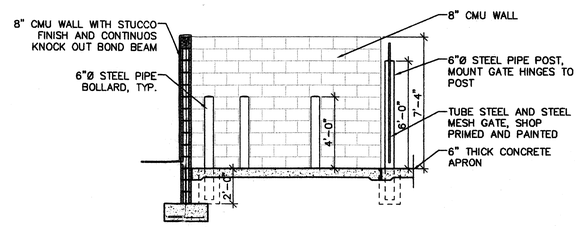

4/A003 REFUSE ENCLOSURE - SECT.
SCALE: 1/4"=1'-0"

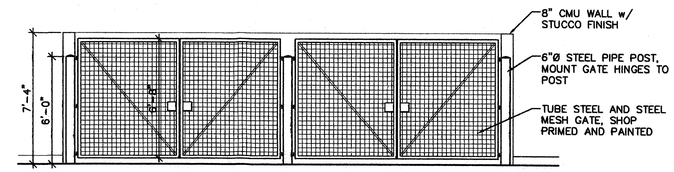

6/A003 REFUSE ENCLOSURE - ELEV.
SCALE: 1/4"=1'-0"

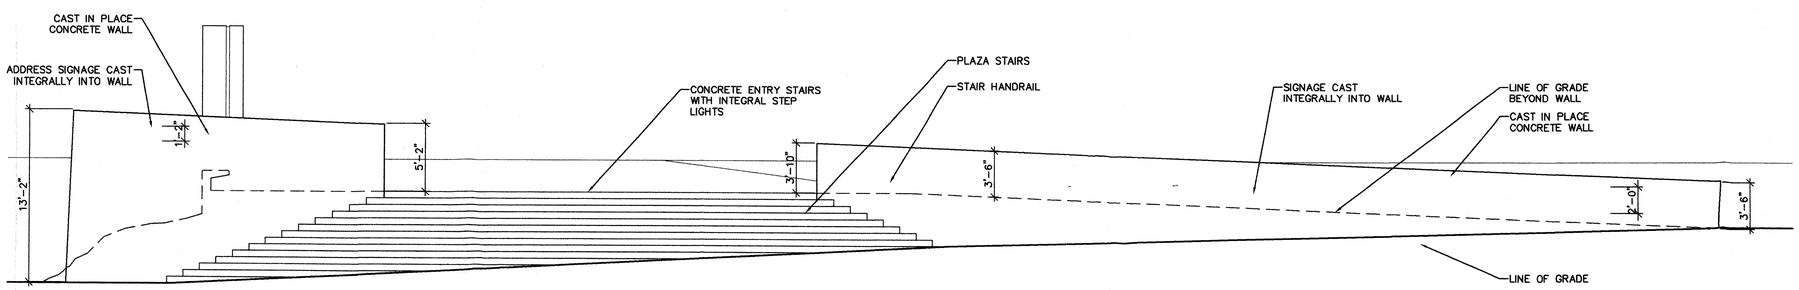

2/A003 PLAZA ENTRY ELEVATION
SCALE: 3/16"=1'-0"

AS BUILT INFORMATION	
CONTRACTOR	DATE:
WORK STAKED BY	DATE:
INSPECTOR'S APPROVAL	DATE:
FIELD VERIFICATION BY	DATE:
DRAWING CORRECTED BY	DATE:
MICRO-FILM INFORMATION	
RECORDED BY	DATE:
NO.	

BENCH MARK
ALL ELEVATIONS ARE BASED UPON ALBUQUERQUE CONTROL SURVEY MONUMENT: 7-L15

SURVEY INFORMATION
FIELD NOTES

NO.	BY	DATE

ARCHITECTS STAMP

NO.	DATE	REVISIONS/REMARKS	BY

DESIGNED BY: DATE:
DRAWN BY: DATE:
CHECKED BY: DATE:

Kells + Craig
Architects, Inc. AIA
400 Gold SW
Suite 880
Albuquerque, New Mexico 87102
(505) 243-2724

G. DONALD DUDLEY AIA
ARCHITECT
SIMMS TOWER STUDIO 850
400 GOLD AVENUE SW
ALBUQUERQUE, NEW MEXICO
87102
TEL 505.243.8100
FAX 505.243.8101

CITY OF ALBUQUERQUE
DEPARTMENT OF MUNICIPAL DEVELOPMENT

TITLE: SITE DETAILS
ALBUQUERQUE BICYCLE PARK PH. 1

OCTOBER 28, 2005

Design Review Committee	City Engineer Approval	Last Design Update	MO./DAY/YR.	MO./DAY/YR.

City Project No.	Zone Map No.	Sheet	Of
7345-90	L-15-Z	A003	

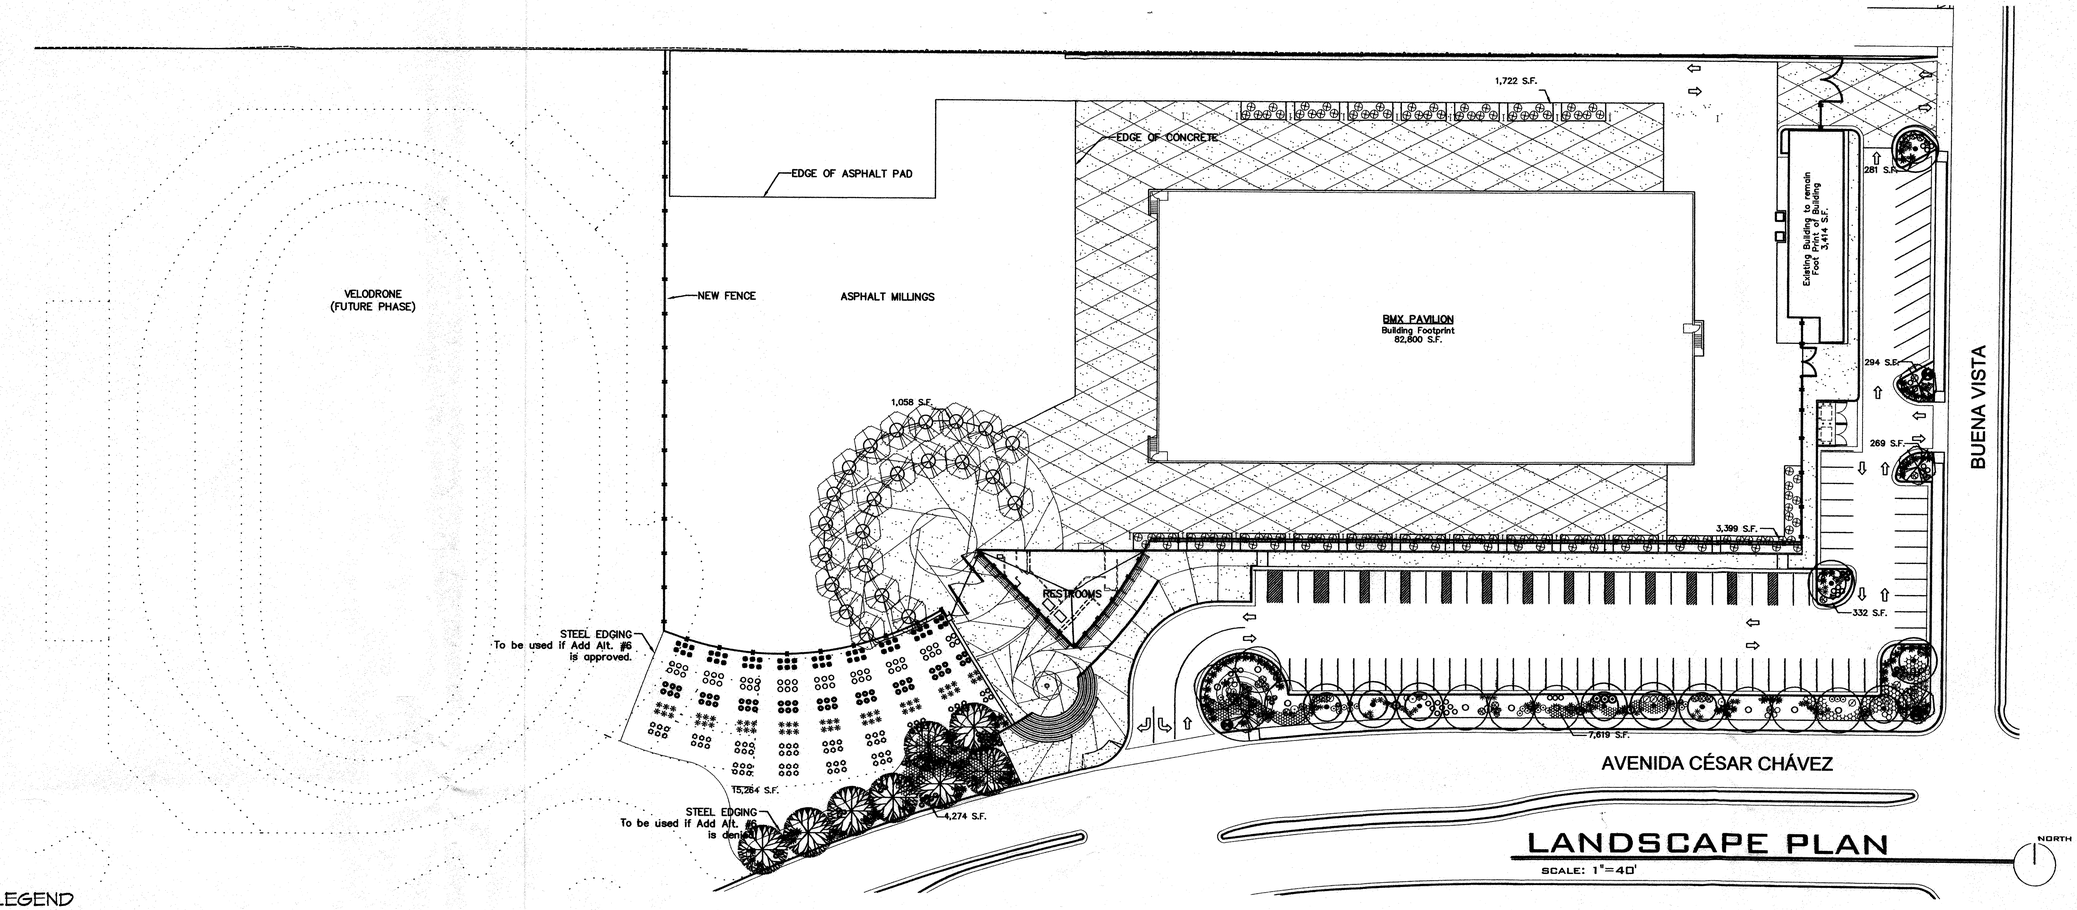

LANDSCAPE PLAN

SCALE: 1"=40'

PLANT LEGEND

Symbol	Scientific Name / Common Name	Size	Remarks	Water Use
Trees				
	Fraxinus oxycarpa 'Raywood'/ Raywood Ash	2" B&B	14' ht. x 6' spr. 35' ht. x 30' spr.	Medium+
	Pinus leucodermis/ Bosnian Pine	B&B	6' min ht. 20' ht. x 30 spr.	Medium
	Platanus mexicana/ Mexican Sycamore	2½" B&B	16' ht. x 6' spr. 70'ht x 60' spr.	Medium
	Pyrus calleryana/ Ornamental Pear	2" B&B	8' ht. x3' spr. 20' ht. x 15' spr.	Low
Shrubs				
	Caryopteris clandonensis/ Blue Mist	5-Gal.	3' o.c. 3' ht. x 3' spr.	Medium
	Chrysothamnus nauseosus/ Chamisa	5-Gal.	5' o.c. 4' ht. x 4' spr.	Low
	Cotoneaster apiculatus/ Cranberry Cotoneaster	5-Gal.	4' o.c. 3' ht. x 4' spr.	Medium
	Hesperaloe parviflora/ Red Yucca	5-Gal.	3' o.c. 3' ht. x 3' spr.	Medium
	Oenothera speciosa/ Mexican Evening Primrose	5-Gal.	4' o.c. 1' ht. x 4' spr.	Low +
	Perovskia atriplicifolia/ Russian Sage	5-Gal.	5' o.c. 4' ht. x 5' spr.	Medium
	Rosmarinus officinalis/ Rosemary	5-Gal.	3' o.c. 3' ht. x 3' spr.	Low +
	Cotoneaster horizintalis/ Rockspray Cotoneaster	5-Gal.		Low
Ornamental Grasses				
	Calamogrotis acutiflora/ Karl Forster Feather Reed Grass	5-Gal.		Low
	Pennisetum orientale "tall tales" Oriental Fountain Grass	5-Gal.	3' o.c. 3' ht. x 3' spr.	Medium
	Nassella tenuissima/ Threadgrass	5-Gal.	3' o.c. 2' ht. x 2' spr.	Low +
	Sporobolus cryptandrus/ Sand Dropseed	5-Gal.	3' o.c. 1' ht. x 2' spr.	Low
	Coraderia selloana\ Pampas Grass	5-Gal.	3' o.c. 6' ht. x 4'	Low

Symbol	Scientific Name / Common Name	Size	Remarks	Water Use
Ground cover (1 and 5 gallon)				
	Hedera hellix/English Ivy		5' o.c. 20' ht. x 5' spr.	Low +
	Moss Rock Boulders			
	6" Cobble			

GENERAL LANDSCAPE NOTES

1. Prior to beginning work on the project, the Landscape Contractor shall review the project in the field with the Owner's Representative.
2. If discrepancies occur between the drawings and the site, the Landscape Contractor shall notify the Owner's Representative for clarification prior to proceeding on that portion of work.
3. All planting areas are to have weeds and competitive vegetation removed prior to preparation for planting.
4. All existing plant materials shall be protected during construction. Damaged materials shall be replaced in kind at the Contractor's expense.
5. Plant quantities are provided for Contractor's convenience only, plans shall take precedence.
6. The Owner's Representative shall approve all plant material prior to planting. In addition, the Owner's Representative reserves the right to refuse any plant material deemed unacceptable. The Owner's Representative is to approve any and all substitutions.
7. It is the Landscape Contractor's responsibility to locate all underground utilities prior to commencement of planting operations.
8. Planting areas shall be top dressed with 3" layer of Santa Fe Brown crusher fines unless noted otherwise.

IRRIGATION SYSTEM

Irrigation system standards outlined in the Water Conservation Landscaping and Water Waste Ordinance shall be strictly adhered to. A fully automated irrigation system will be used to irrigate tree, shrub and groundcover planting areas. A temporary spray system will be provided to establish the native seeded areas.

MAINTENANCE RESPONSIBILITY

Maintenance of the landscaping and irrigation system, including those areas within the public R.O.W., shall be the responsibility of the Lessee.

LANDSCAPE NOTE

The Landscape Plan for this site shall limit the provision of high water use turf to a maximum of 20 percent of the provided landscape area, and shall be in compliance with the Water Conservation Ordinance. Seventy-five percent of the landscape area shall be covered with living plant material, as measured by the mature canopy of the plant.

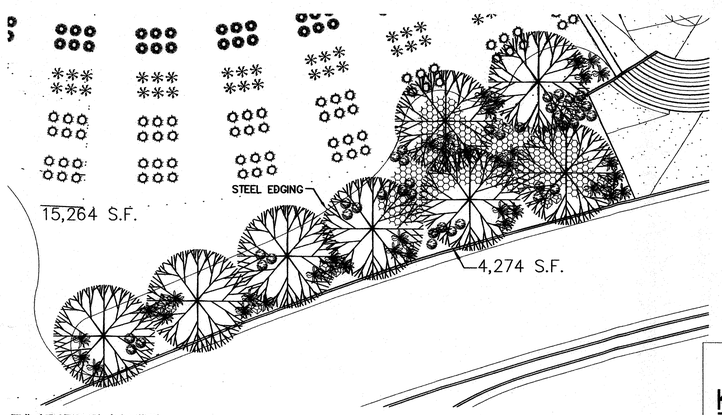

ENLARGED PLAN VIEW

NTS

LANDSCAPE REQUIREMENTS

Site Area: 6.07 acres	264,375 SF
Building Footprint:	86,214 SF
Total Area:	178,161 SF
Required Landscape %:	.15
Landscape Area Required:	26,724 SF
Landscape Area Provided:	(19%) 34,512 SF

CONSENSUS PLANNING

OCTOBER 28, 2005

Design Review Committee	City Engineer Approval	Last Design Update	MO./DAY/YR.	MO./DAY/YR.

City Project No.	Zone Map No.	Sheet	Of
7345-90	L-15-Z		

AS BUILT INFORMATION

	DATE:
CONTRACTOR	
WORK STAKED BY	
INSPECTOR'S APPROVAL	
FIELD VERIFICATION BY	
DRAWING CORRECTED BY	

MICRO-FILM INFORMATION

RECORDED BY	
NO.	

BENCH MARK

ALL ELEVATIONS ARE BASED UPON ALBUQUERQUE CONTROL SURVEY MONUMENT: 7-L15

SURVEY INFORMATION

FIELD NOTES

NO.	BY	DATE

ARCHITECTS STAMP

NO.	DATE	REVISIONS/REMARKS	BY

DESIGNED BY: KQ DATE: 10/2/05
DRAWN BY: KQ DATE: 10/20/05
CHECKED BY: JS DATE: 10/25/05

Kells + Craig
Architects, Inc. AIA
400 Gold SW
Suite 880
Albuquerque, New Mexico 87102
(505) 243-2724

G. DONALD DUDLEY AIA
ARCHITECT
SIMMS TOWER STUDIO 850
400 GOLD AVENUE SW
ALBUQUERQUE, NEW MEXICO
87102
TEL 505.243.8100
FAX 505.243.8101

CITY OF ALBUQUERQUE
DEPARTMENT OF MUNICIPAL
DEVELOPMENT

TITLE: SITE DEVELOPMENT PLAN - LANDSCAPE

ALBUQUERQUE BICYCLE PARK PH. 1

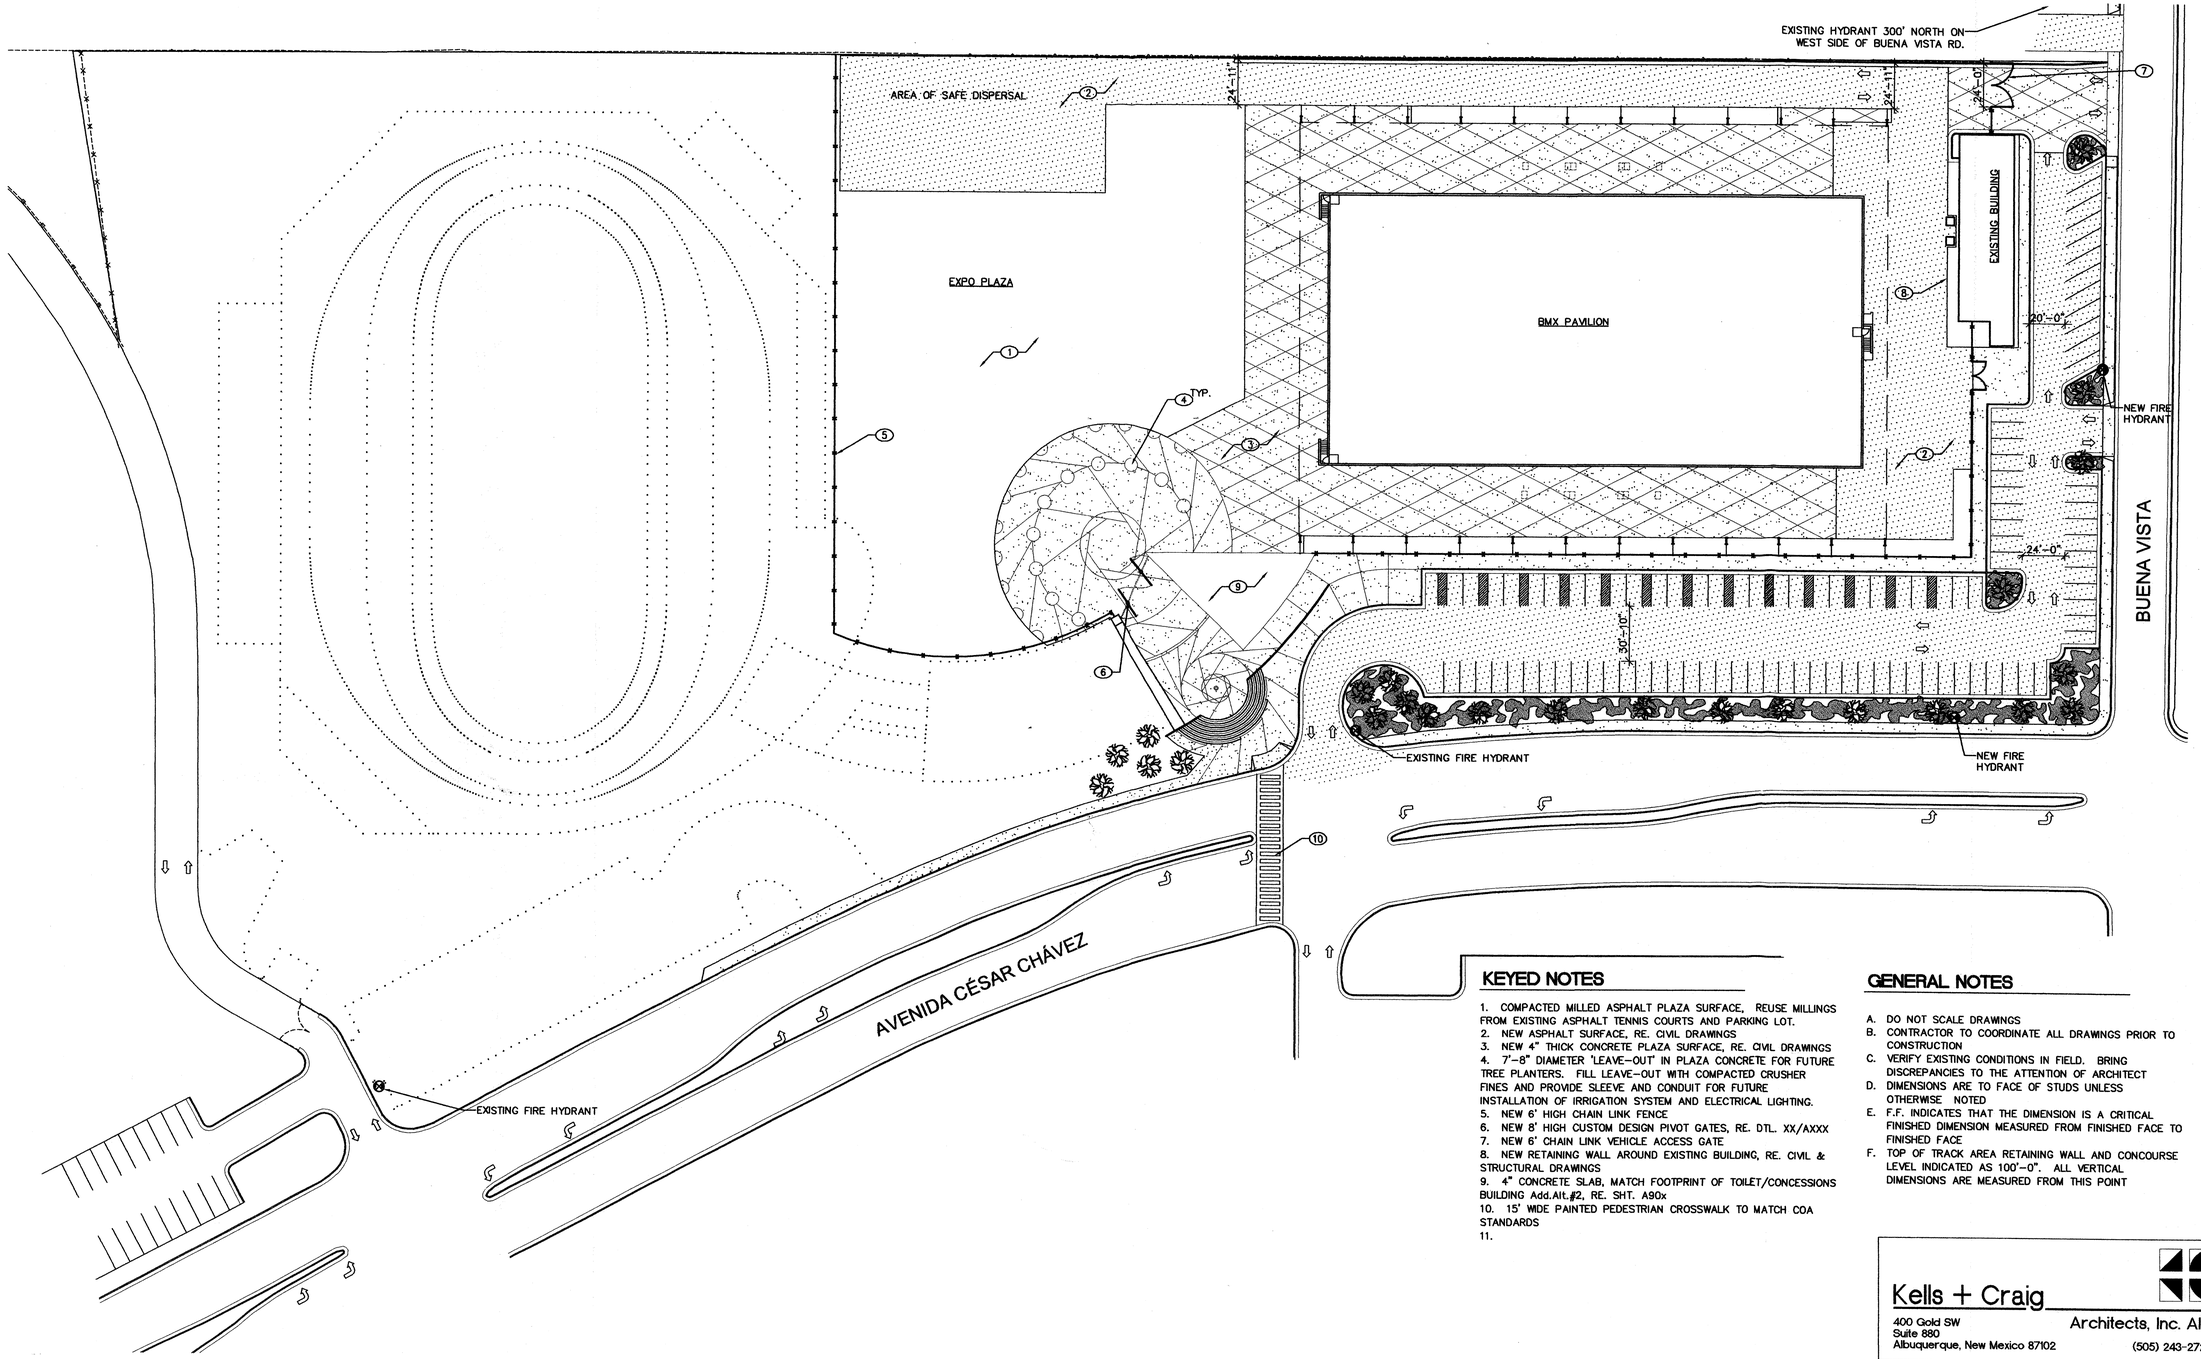

1 AS101 FIRE DEPT. APPROVAL PLAN

SCALE: 1"=40'-0"

NOTE:
FOR REFERENCE ONLY. REFER TO SITE DEVELOPMENT PLAN SHEET A001 FOR SITE PLAN INFORMATION.

KEYED NOTES

1. COMPACTED MILLED ASPHALT PLAZA SURFACE, REUSE MILLINGS FROM EXISTING ASPHALT TENNIS COURTS AND PARKING LOT.
2. NEW ASPHALT SURFACE, RE. CIVIL DRAWINGS
3. NEW 4" THICK CONCRETE PLAZA SURFACE, RE. CIVIL DRAWINGS
4. 7'-8" DIAMETER 'LEAVE-OUT' IN PLAZA CONCRETE FOR FUTURE TREE PLANTERS. FILL LEAVE-OUT WITH COMPACTED CRUSHER FINES AND PROVIDE SLEEVE AND CONDUIT FOR FUTURE INSTALLATION OF IRRIGATION SYSTEM AND ELECTRICAL LIGHTING.
5. NEW 6' HIGH CHAIN LINK FENCE
6. NEW 8' HIGH CUSTOM DESIGN PIVOT GATES, RE. DTL. XX/AXXX
7. NEW 6' CHAIN LINK VEHICLE ACCESS GATE
8. NEW RETAINING WALL AROUND EXISTING BUILDING, RE. CIVIL & STRUCTURAL DRAWINGS
9. 4" CONCRETE SLAB, MATCH FOOTPRINT OF TOILET/CONCESSIONS BUILDING Add.Alt.#2, RE. SHT. A90x
10. 15' WIDE PAINTED PEDESTRIAN CROSSWALK TO MATCH COA STANDARDS
11.

GENERAL NOTES

A. DO NOT SCALE DRAWINGS
B. CONTRACTOR TO COORDINATE ALL DRAWINGS PRIOR TO CONSTRUCTION
C. VERIFY EXISTING CONDITIONS IN FIELD. BRING DISCREPANCIES TO THE ATTENTION OF ARCHITECT
D. DIMENSIONS ARE TO FACE OF STUDS UNLESS OTHERWISE NOTED
E. F.F. INDICATES THAT THE DIMENSION IS A CRITICAL FINISHED DIMENSION MEASURED FROM FINISHED FACE TO FINISHED FACE
F. TOP OF TRACK AREA RETAINING WALL AND CONCOURSE LEVEL INDICATED AS 100'-0". ALL VERTICAL DIMENSIONS ARE MEASURED FROM THIS POINT

AS BUILT INFORMATION
CONTRACTOR DATE:
WORK STAKED BY DATE:
INSPECTOR'S APPROVAL DATE:
FIELD VERIFICATION BY DATE:
DRAWING CORRECTED BY DATE:
MICRO-FILM INFORMATION
RECORDED BY DATE:
NO.

BENCH MARK
ALL ELEVATIONS ARE BASED UPON ALBUQUERQUE CONTROL SURVEY MONUMENT: 7-L15

SURVEY INFORMATION
FIELD NOTES

NO.	BY	DATE

ARCHITECTS STAMP

NO.	DATE	REVISIONS/REMARKS	BY

DESIGNED BY: DATE:
DRAWN BY: DATE:
CHECKED BY: DATE:

Kells + Craig
Architects, Inc. AIA
400 Gold SW
Suite 880
Albuquerque, New Mexico 87102
(505) 243-2724

G. DONALD DUDLEY AIA
ARCHITECT
SIMMS TOWER STUDIO 850
400 GOLD AVENUE SW
ALBUQUERQUE, NEW MEXICO
87102
TEL 505.243.8100
FAX 505.243.8101

CITY OF ALBUQUERQUE
DEPARTMENT OF MUNICIPAL DEVELOPMENT

TITLE:
ALBUQUERQUE BICYCLE PARK PH. 1

AFD PLANS CHECKING OFFICE
924-3611
APPROVED/DISAPPROVED
HYDRANT(S) ONLY
10-5-05
SIGNATURE & DATE

OCTOBER 4, 2005

Design Review Committee	City Engineer Approval	Last Design Update	MO./DAY/YR.	MO./DAY/YR.

City Project No.	Zone Map No.	Sheet 2 Of 69
7345-90	L-15-Z	AS101

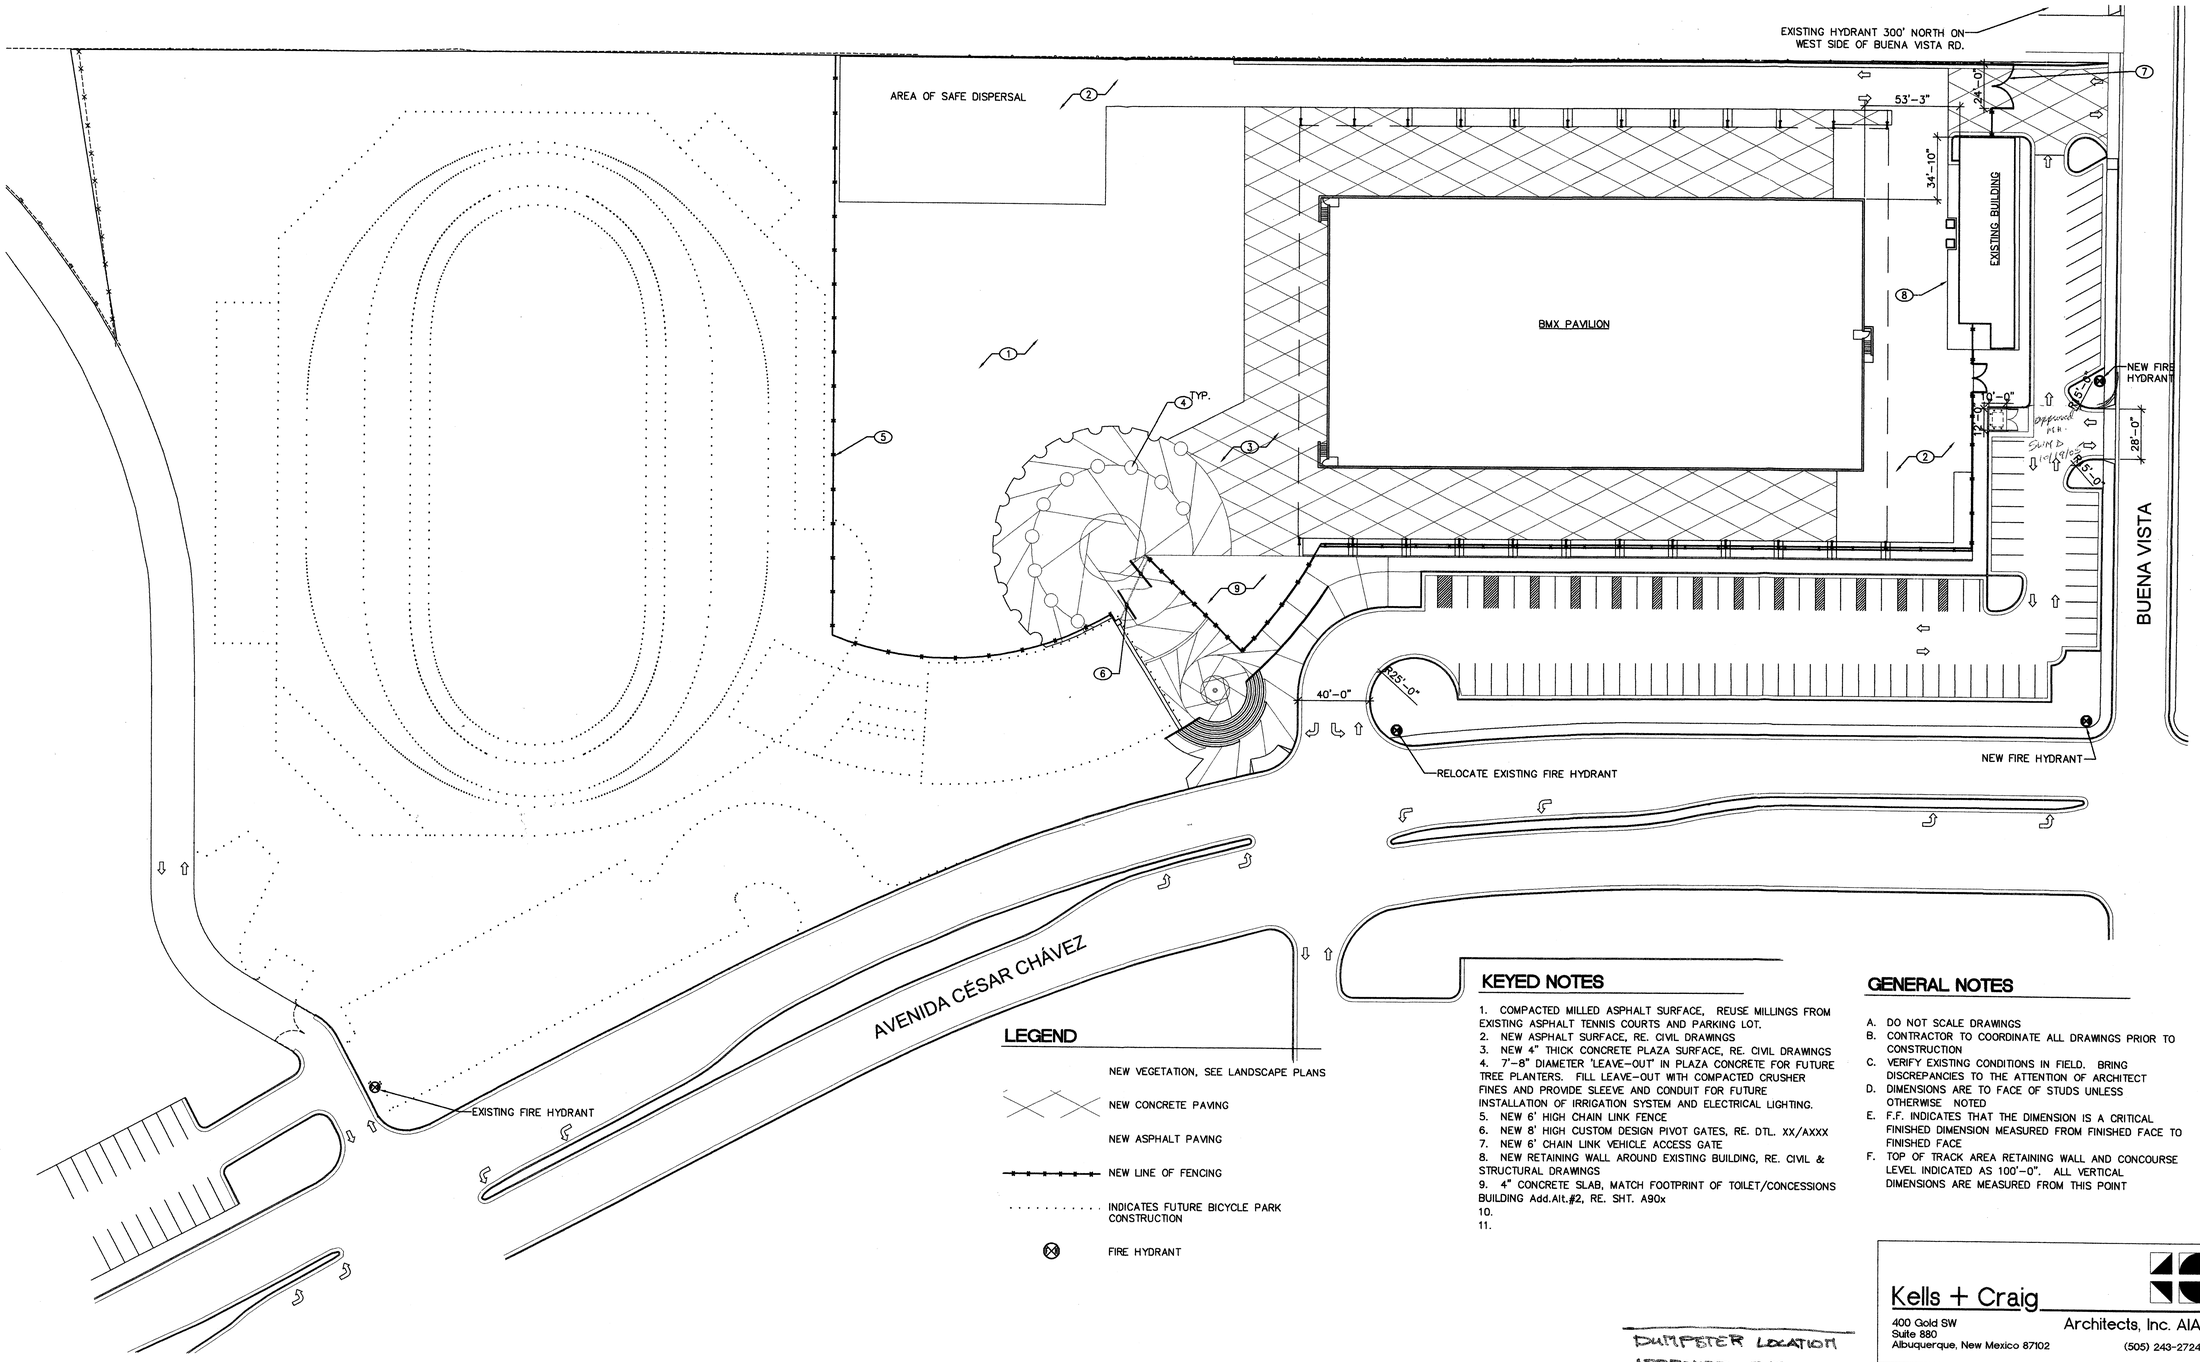

LEGEND

- NEW VEGETATION, SEE LANDSCAPE PLANS
- NEW CONCRETE PAVING
- NEW ASPHALT PAVING
- NEW LINE OF FENCING
- INDICATES FUTURE BICYCLE PARK CONSTRUCTION
- FIRE HYDRANT

KEYED NOTES

1. COMPACTED MILLED ASPHALT SURFACE, REUSE MILLINGS FROM EXISTING ASPHALT TENNIS COURTS AND PARKING LOT.
2. NEW ASPHALT SURFACE, RE. CIVIL DRAWINGS
3. NEW 4" THICK CONCRETE PLAZA SURFACE, RE. CIVIL DRAWINGS
4. 7'-8" DIAMETER 'LEAVE-OUT' IN PLAZA CONCRETE FOR FUTURE TREE PLANTERS. FILL LEAVE-OUT WITH COMPACTED CRUSHER FINES AND PROVIDE SLEEVE AND CONDUIT FOR FUTURE INSTALLATION OF IRRIGATION SYSTEM AND ELECTRICAL LIGHTING.
5. NEW 6' HIGH CHAIN LINK FENCE
6. NEW 8' HIGH CUSTOM DESIGN PIVOT GATES, RE. DTL. XX/AXXX
7. NEW 6' CHAIN LINK VEHICLE ACCESS GATE
8. NEW RETAINING WALL AROUND EXISTING BUILDING, RE. CIVIL & STRUCTURAL DRAWINGS
9. 4" CONCRETE SLAB, MATCH FOOTPRINT OF TOILET/CONCESSIONS BUILDING Add.Alt.#2, RE. SHT. A90x
10.
11.

GENERAL NOTES

A. DO NOT SCALE DRAWINGS
B. CONTRACTOR TO COORDINATE ALL DRAWINGS PRIOR TO CONSTRUCTION
C. VERIFY EXISTING CONDITIONS IN FIELD. BRING DISCREPANCIES TO THE ATTENTION OF ARCHITECT
D. DIMENSIONS ARE TO FACE OF STUDS UNLESS OTHERWISE NOTED
E. F.F. INDICATES THAT THE DIMENSION IS A CRITICAL FINISHED DIMENSION MEASURED FROM FINISHED FACE TO FINISHED FACE
F. TOP OF TRACK AREA RETAINING WALL AND CONCOURSE LEVEL INDICATED AS 100'-0". ALL VERTICAL DIMENSIONS ARE MEASURED FROM THIS POINT

2 AS101 **SOLID WASTE APPROVAL PLAN**

SCALE: 1"=40'-0"

NORTH

NOTE:
FOR REFERENCE ONLY. REFER TO SITE DEVELOPMENT PLAN SHEET A001 FOR SITE PLAN INFORMATION.

DUMPSTER LOCATION APPROVED BY MICHAEL HOLTOM ON 10.19.05

AFD PLANS CHECKING OFFICE
924-3611
APPROVED/NOT APPROVED
HYDRANT(S) OKAY
10-2-05
SIGNATURE & DATE

10.19.05
~~OCTOBER 4, 2005~~

AS BUILT INFORMATION
CONTRACTOR DATE:
WORK STAKED BY DATE:
INSPECTOR'S APPROVAL DATE:
FIELD VERIFICATION BY DATE:
DRAWING CORRECTED BY DATE:
MICRO-FILM INFORMATION
RECORDED BY DATE:
NO.

BENCH MARK
ALL ELEVATIONS ARE BASED UPON ALBUQUERQUE CONTROL SURVEY MONUMENT: 7-L15

SURVEY INFORMATION
FIELD NOTES

NO.	BY	DATE

ARCHITECTS STAMP

NO.	DATE	REVISIONS/REMARKS	BY

DESIGNED BY: DATE:
DRAWN BY: DATE:
CHECKED BY: DATE:

Kells + Craig
Architects, Inc. AIA
400 Gold SW
Suite 880
Albuquerque, New Mexico 87102
(505) 243-2724

G. DONALD DUDLEY AIA
ARCHITECT
SIMMS TOWER STUDIO 850
400 GOLD AVENUE SW
ALBUQUERQUE, NEW MEXICO
87102
TEL 505.243.8100
FAX 505.243.8101

CITY OF ALBUQUERQUE
DEPARTMENT OF MUNICIPAL DEVELOPMENT

TITLE:
ALBUQUERQUE BICYCLE PARK PH. 1

Design Review Committee	City Engineer Approval	Last Design Update	MO/DAY/YR.	MO/DAY/YR.

City Project No.	Zone Map No.	Sheet 2 Of 69
7345-90	L-15-Z	AS101