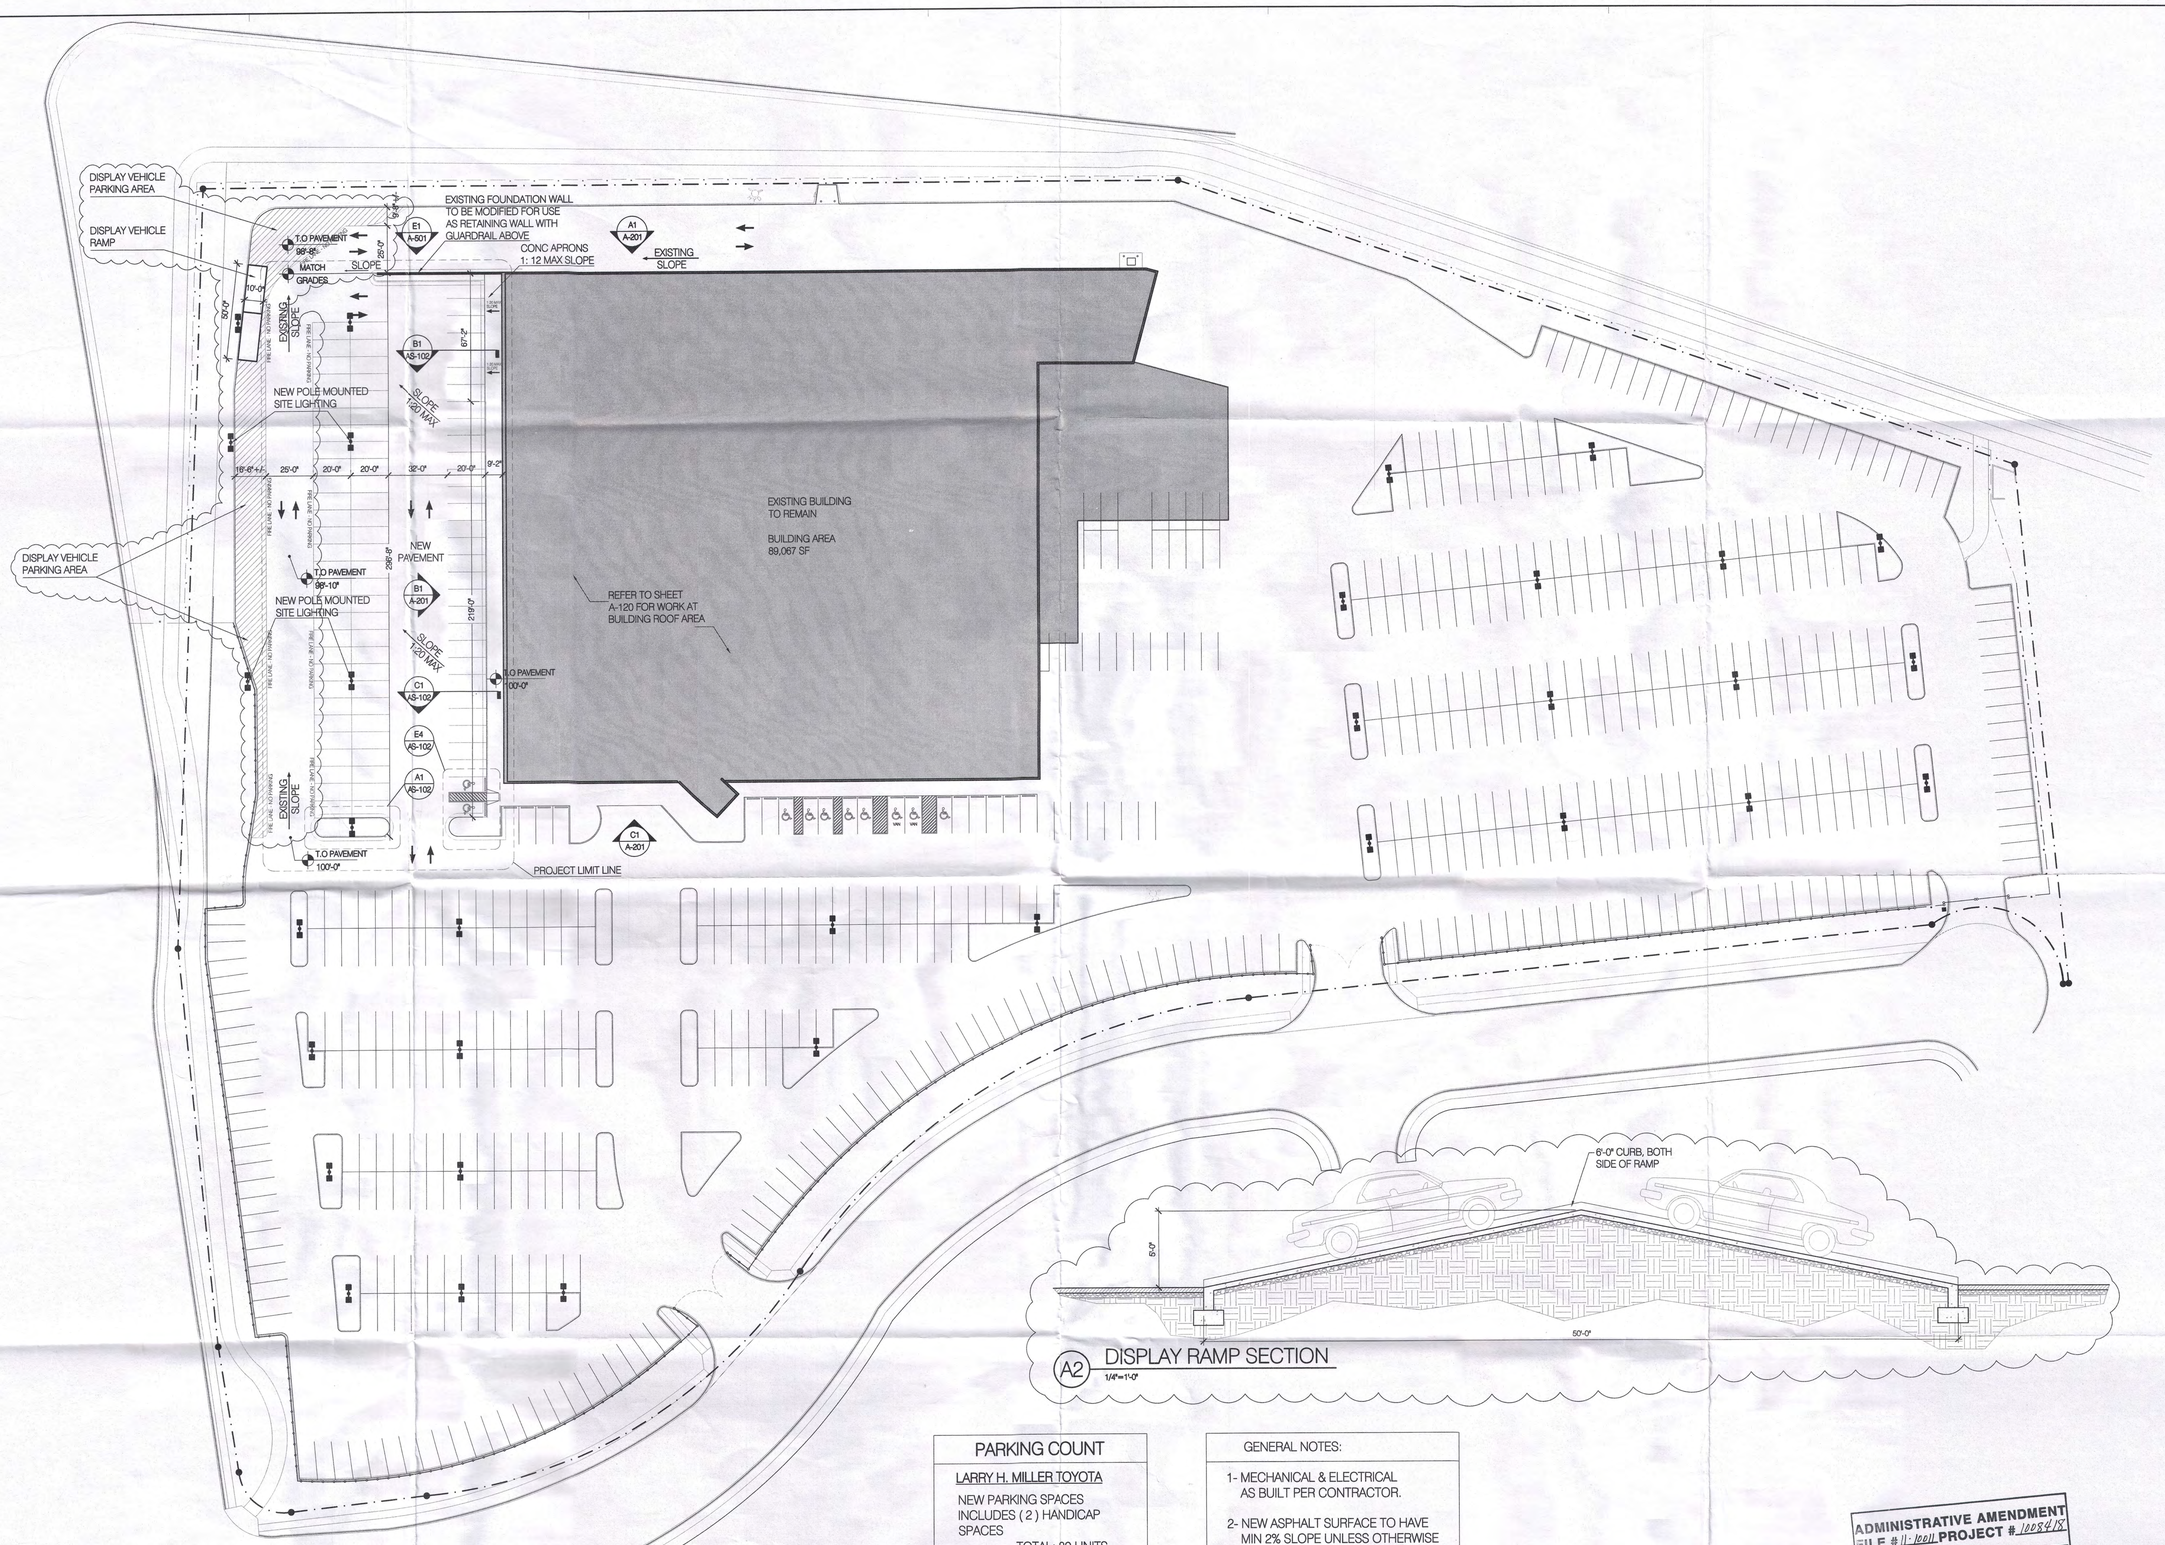

A1 OVERALL SITE PLAN
SCALE: 1/32"= 1'-0"
0 20' 40' 80'

A2 DISPLAY RAMP SECTION
1/4"=1'-0"

PARKING COUNT

LARRY H. MILLER TOYOTA

NEW PARKING SPACES INCLUDES (2) HANDICAP SPACES
TOTAL: 89 UNITS

EXISTING PARKING SPACES INCLUDES (8) HANDICAP SPACES
TOTAL: 594 UNITS

TOTAL SPACES PROVIDED: 683 UNITS

GENERAL NOTES:

1- MECHANICAL & ELECTRICAL AS BUILT PER CONTRACTOR.

2- NEW ASPHALT SURFACE TO HAVE MIN 2% SLOPE UNLESS OTHERWISE NOTED.

NEW TOTAL BUILDING AREA
89,067 SF

AREA TO BE TOUCH

ADMINISTRATIVE AMENDMENT
FILE # 11-10011 PROJECT # 1008418
add more display area @ NW corner
C.Marone 1-25-11
APPROVED BY DATE

FFKR ARCHITECTS
bogue building
730 pacific avenue
salt lake city
Utah 84104
t 801-521-6186
f 801-539-1916
ffkr.com

LARRY H. MILLER TOYOTA
10401 COPPER AVE
ALBUQUERQUE, NEW MEXICO
PERMIT SET

SEAL

DATE	STATUS
06.8.2010	PERMIT SET
2010-DEC-08	DISPLAY AREA

PROJECT NUMBER	09115
CAD DWG FILE	
DRAWN BY	GG/HJ
CHECKED BY	JF/TJ
SCALE	AS NOTED

OVERALL SITE PLAN

AS-101