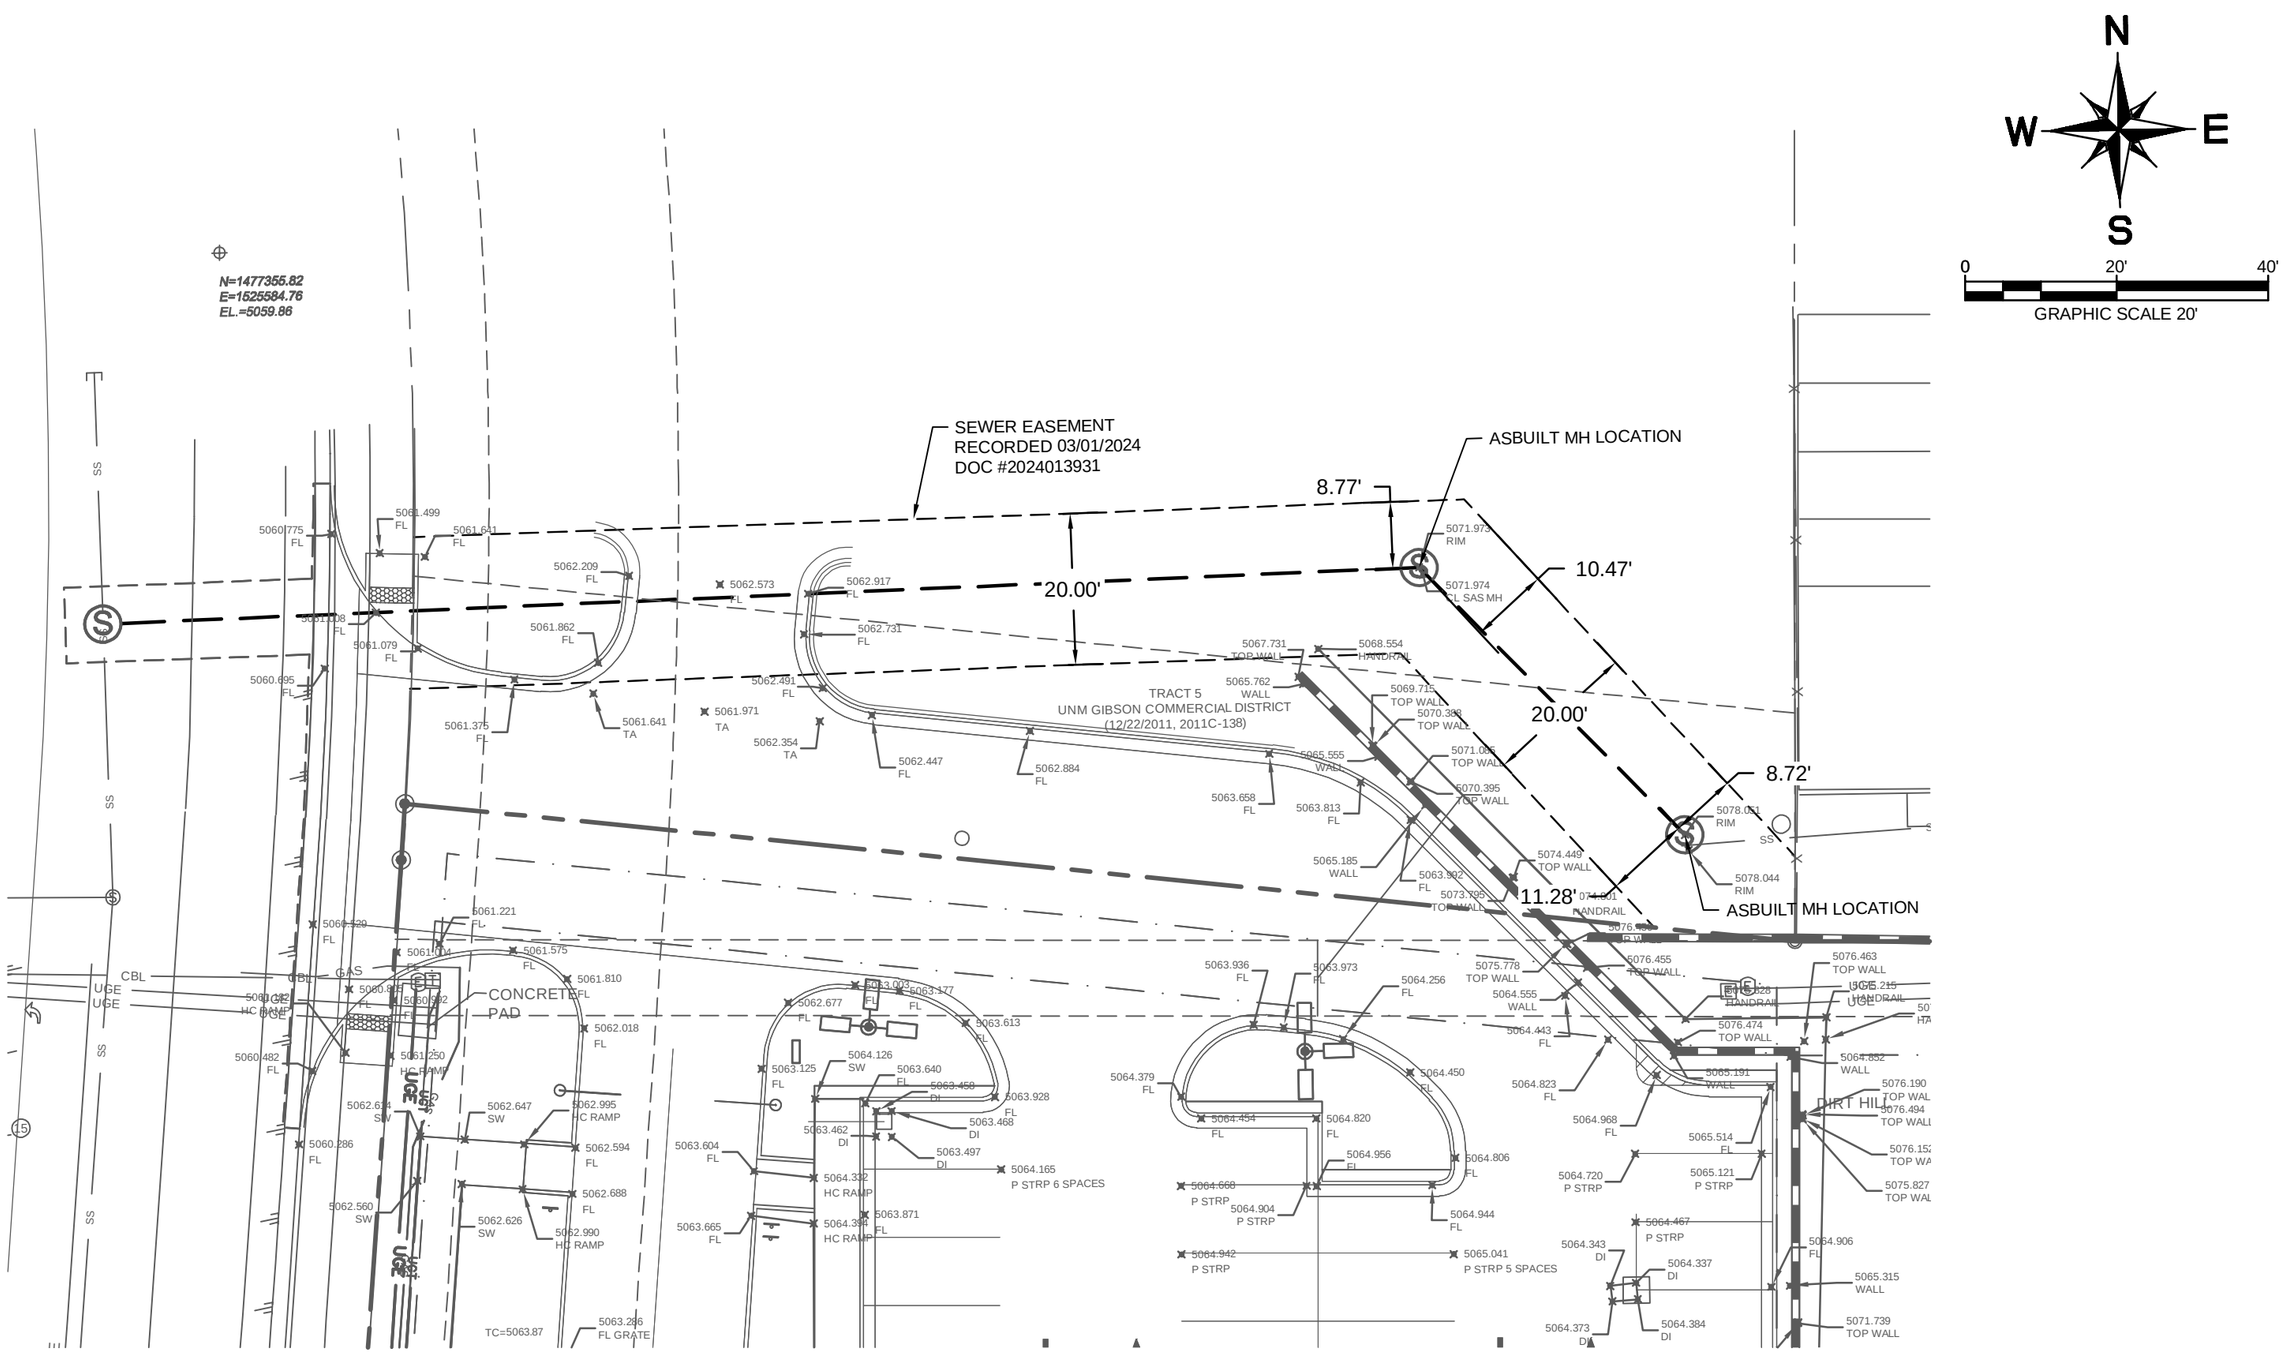
N
W
E
S
0
20'
40'
GRAPHIC SCALE 20'
N=1477355.82
E=1525584.76
EL.=5059.86
SEWER EASEMENT
RECORDED 03/01/2024
DOC #2024013931
ASBUILT MH LOCATION
8.77'
10.47'
20.00'
20.00'
8.72'
11.28'
ASBUILT MH LOCATION
TRACT 5
UNM GIBSON COMMERCIAL DISTRICT
(12/22/2011, 2011C-138)
CONCRETE
PAD
DIRT HIL
TC=5063.87
5063.286
FL GRATE
5064.165
P STRP 6 SPACES
5065.041
P STRP 5 SPACES