HYDROLOGY

K15/D18

K15-D18

REGINA HALL

DRAINAGE PLAN

1 PLAN

REGINA HALL DRAINAGE PLAN

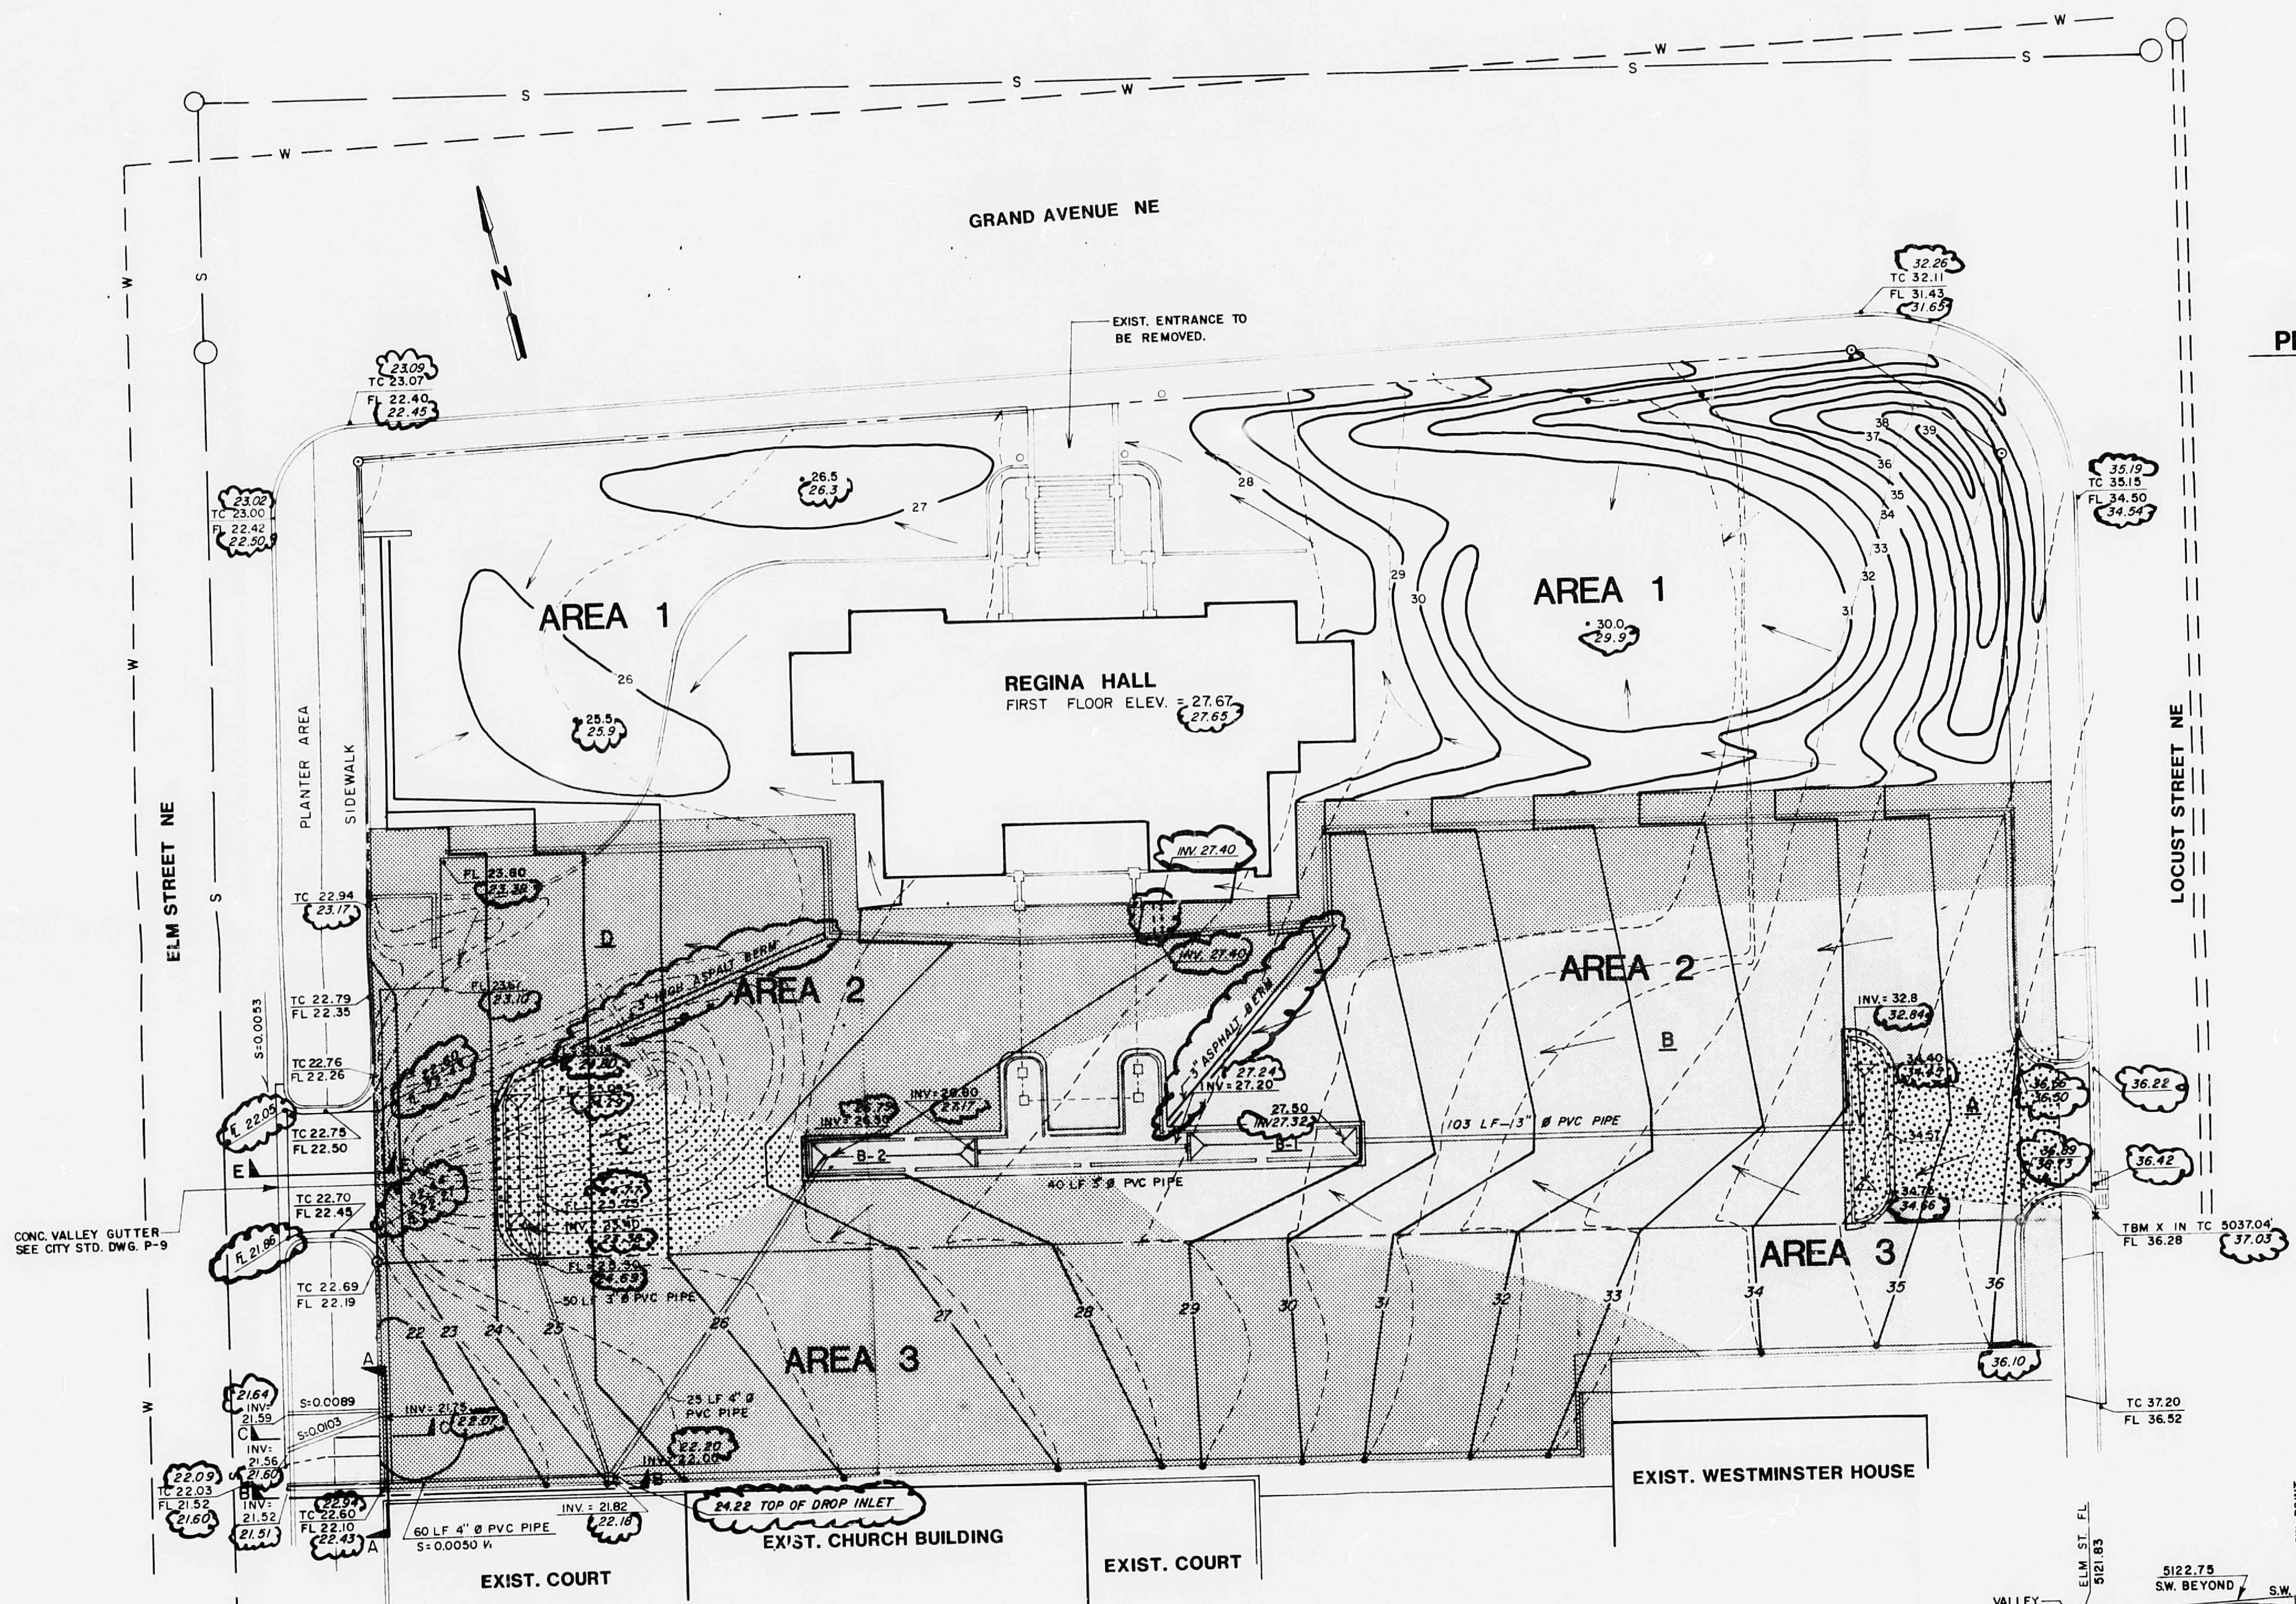

DRAINAGE PLAN

SCALE: 1"=20'

34.75 — DESIGN ELEVATION
34.66 — AS BUILT ELEVATIONS SURVEYED BY BOYLE ENGINEERING CORP. 12/1/83

12-1-83

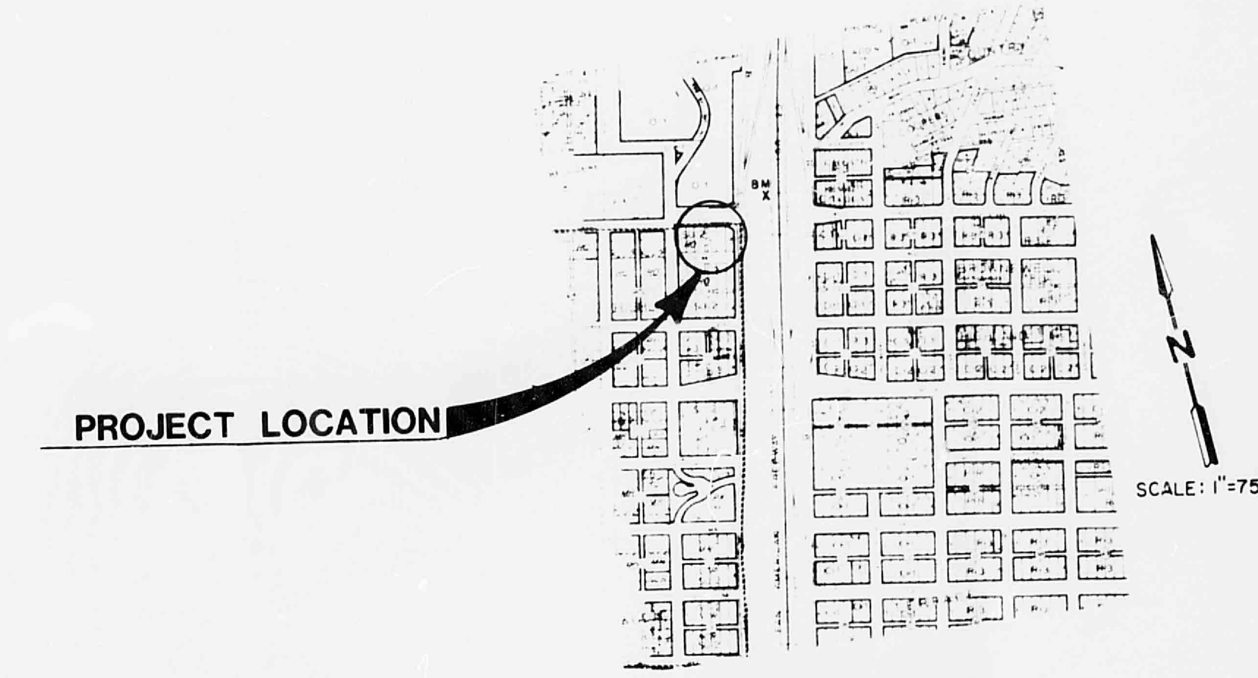

VICINITY MAP

ZONE ATLAS NO. K-15-Z

BENCH MARK LOCATION:
ALL ELEVATIONS SHOWN HEREON ARE REFERENCED TO NMSHC MONUMENT "I-25-26", A BRASS CAP 6 FEET WEST OF THE NORTHWEST CORNER OF THE BRIDGE FOR SOUTH-BOUND LANE OF I-25 AT GRAND AVENUE OVERPASS. ELEV.= 5068.8'

LEGEND	
	DRAINAGE SUBAREAS
(dotted)	A
	B
(dense dotted)	C
(shaded)	D

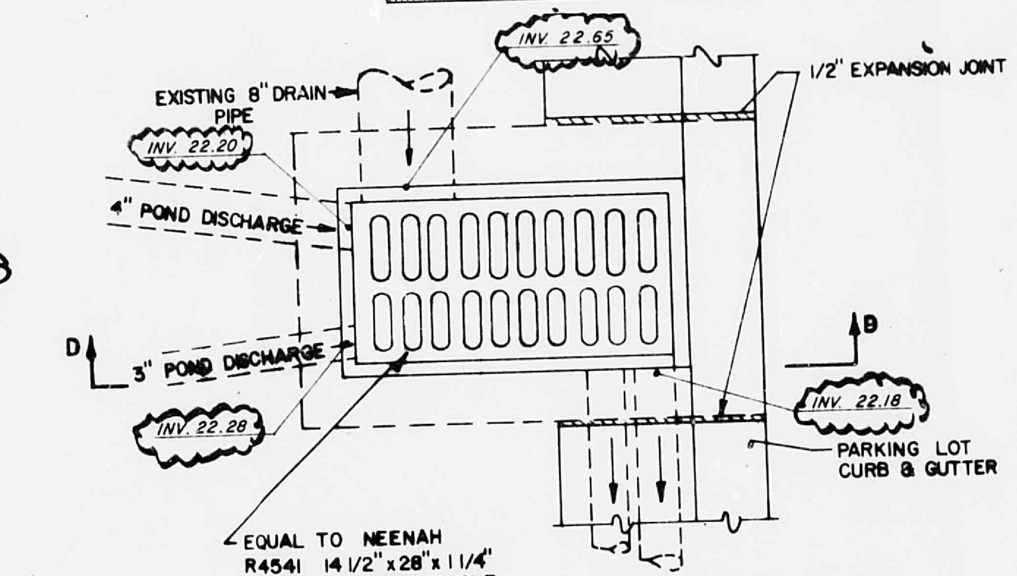

JUNCTION BOX PLAN NTS.

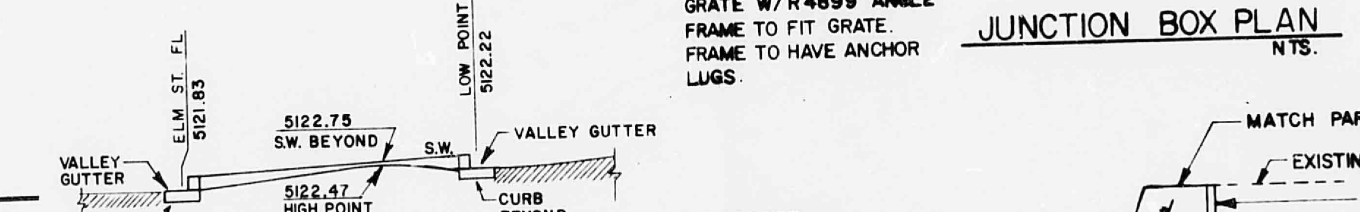

SECTION E-E NTS

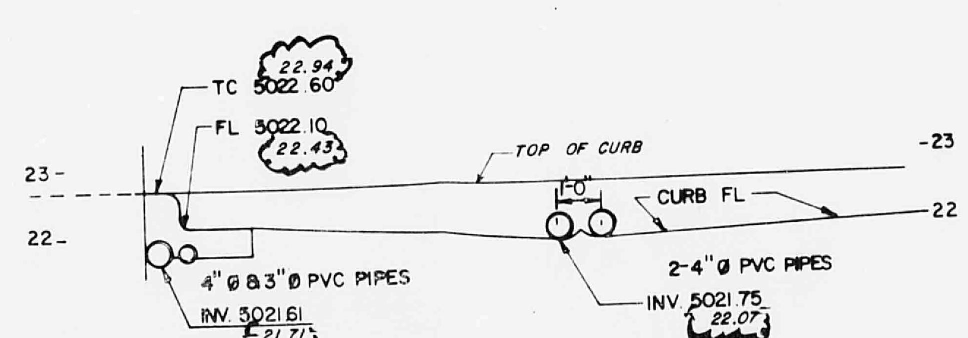

SECTION A-A NTS.

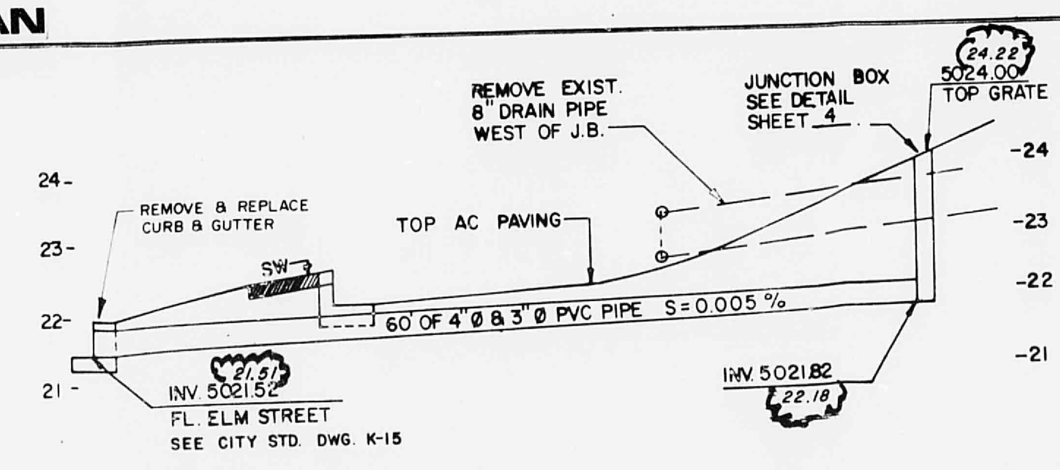

SECTION B-B NTS.

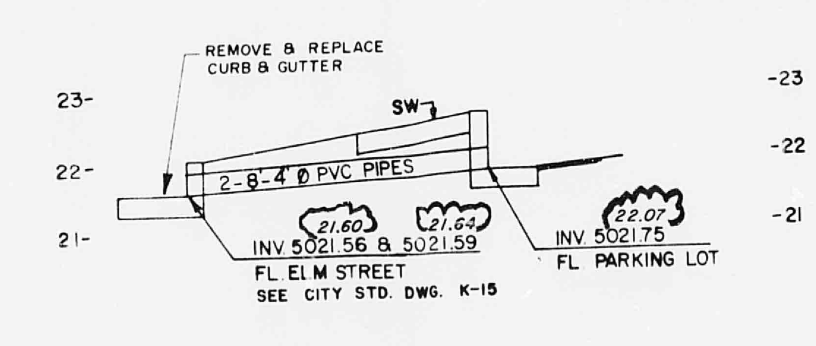

SECTION C-C NTS.

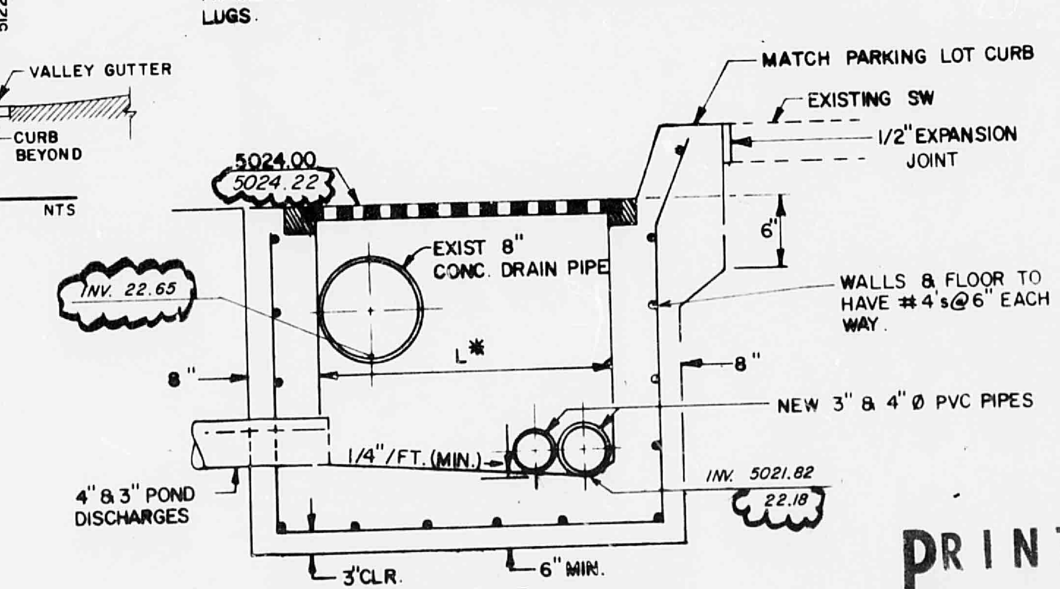

SECTION D-D NTS.

* LENGTH AND WIDTH OF INSIDE OF BOX TO EQUAL INSIDE DIMENSIONS OF ANGLE FRAME.

RECEIVED DEC 05 1983 ENGINEERING

PRINTED DEC 2 1983 BOYLE ENGINEERING CORPORATION

K15/D18

FRANK D. LOVELADY NEW MEXICO 6512 REGISTERED PROFESSIONAL ENGINEER

REGINA HALL DRAINAGE PLAN

STEVENS MALLORY PEARL & CAMPBELL, P.A.
ARCHITECTS 115 AMHERST S.E. ALBUQUERQUE, NEW MEXICO 87106

CHECKED F. D. L.

DRAWN J. D. M.

DATE 12/20/82

1 OF 1