



City of Albuquerque

P.O. BOX 1293 ALBUQUERQUE, NEW MEXICO 87103

December 12, 2002

Rick Beltramo, P.E.
Bohannon Huston, Inc.
7500 Jefferson NE
Albuquerque, New Mexico 87109

RE: RIDGEVIEW SUBDIVISION UNIT 1 (A-12/D1F)
Engineers Certification for Release of Financial Guaranty
Engineers Stamp dated 3/2/2001
Engineers Certification dated 12/9/2002

Dear Rick:

Based upon the information provided in your Engineers Certification submittal dated 12/12/2002, the above referenced plan is adequate to satisfy the Grading and Drainage Certification for Release of Financial Guaranty.


If you have any questions, please call me at 924-3981.

Sincerely,

Teresa A. Martin
Hydrology Plan Checker
Development & Bldg. Ser. Division

BM

c: Arlene Portillo, COA--Project # 657981
File

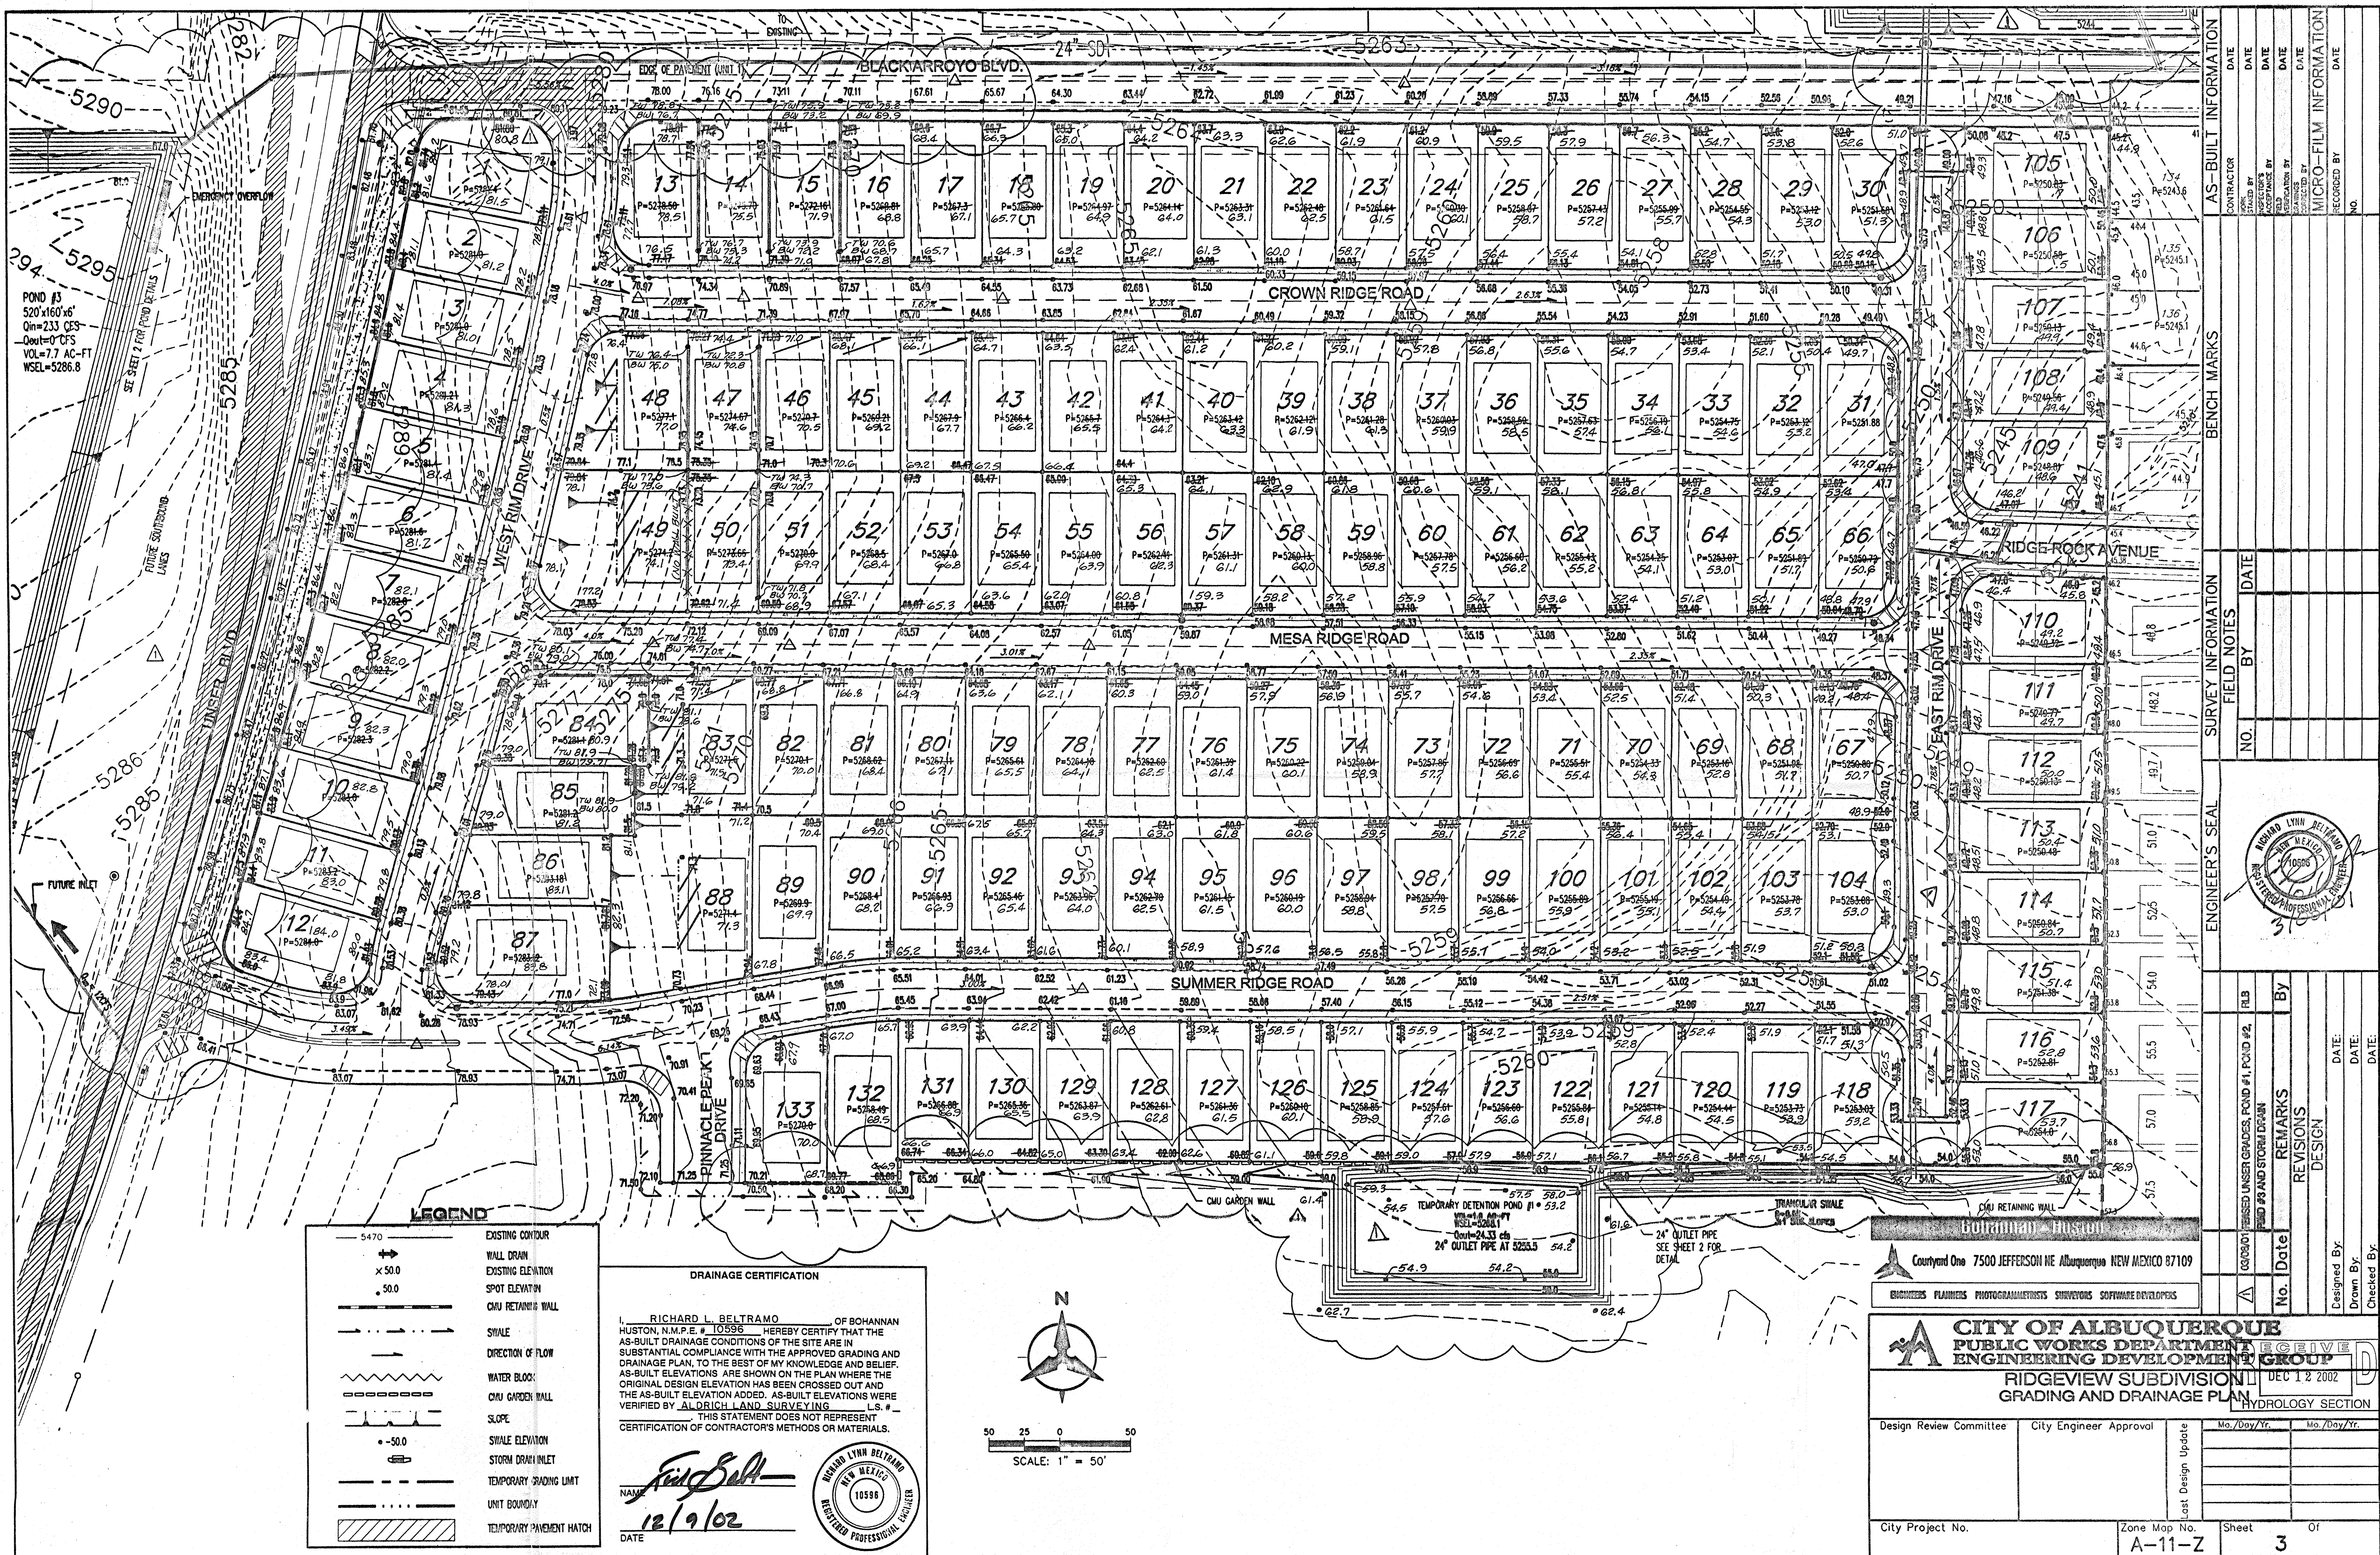

AS-BUILT INFORMATION		BENCH MARKS	
SURVEY INFORMATION		FIELD NOTES	
NO.	DATE	NO.	DATE
ENGINEER'S SEAL		REVISIONS	
		NO.	DATE
		BY	DATE
DESIGNED BY		REVISIONS	
DRAWN BY	DATE	NO.	DATE
CHECKED BY	DATE	BY	DATE