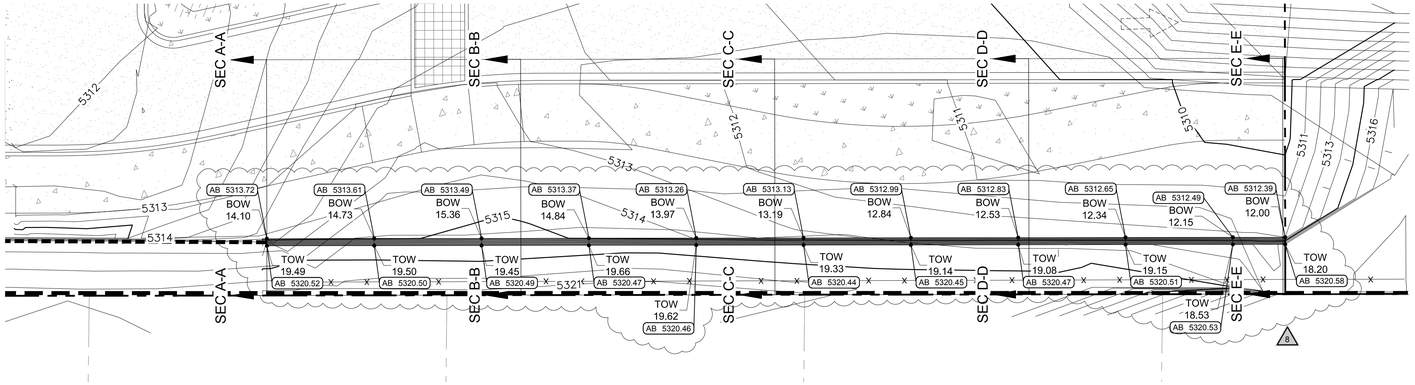

DRAINAGE CERTIFICATION WITH SURVEY WORK BY PROFESSIONAL SURVEYOR

I, LANCE VANDEMARK, NMPE 21777, OF THE FIRM THE VERTEX COMPANIES, INC., HEREBY CERTIFY THAT THIS PROJECT HAS BEEN GRADED AND WILL DRAIN IN SUBSTANTIAL COMPLIANCE WITH AND IN ACCORDANCE WITH THE DESIGN INTENT OF THE APPROVED PLAN DATED 09/08/2016. THE RECORD INFORMATION EDITED ONTO THE ORIGINAL DESIGN DOCUMENT HAS BEEN OBTAINED BY THOMAS JOHNSON, NMPS 06/09/2017 OF THE FIRM WAYJOHN SURVEYING, INC. I FURTHER CERTIFY THAT THE SURVEY DATA PROVIDED IS REPRESENTATIVE OF ACTUAL SITE CONDITIONS AND IS TRUE AND CORRECT TO THE BEST OF MY KNOWLEDGE AND BELIEF. THIS CERTIFICATION IS SUBMITTED IN SUPPORT OF A REQUEST FOR CERTIFICATE OF OCCUPANCY.

THE RECORD INFORMATION PRESENTED HEREON IS NOT NECESSARILY COMPLETE AND INTENDED ONLY TO VERIFY SUBSTANTIAL COMPLIANCE OF THE GRADING AND DRAINAGE ASPECTS OF THIS PROJECT. THOSE RELYING ON THE RECORD DOCUMENT ARE ADVISED TO OBTAIN INDEPENDENT VERIFICATION OF ITS ACCURACY BEFORE USING IT FOR ANY OTHER PURPOSE.

Digitally signed by Lance VanDemark
Date: 2017.07.12 14:53:34 -06'00'

LANCE P. VANDEMARK
NEW MEXICO
21777
07/12/2017
LICENSED PROFESSIONAL ENGINEER

Signature of Engineer

ENGINEER'S STAMP

Date 07/12/17

AS-BUILT SPOT ELEVATION AB 5312.48 8

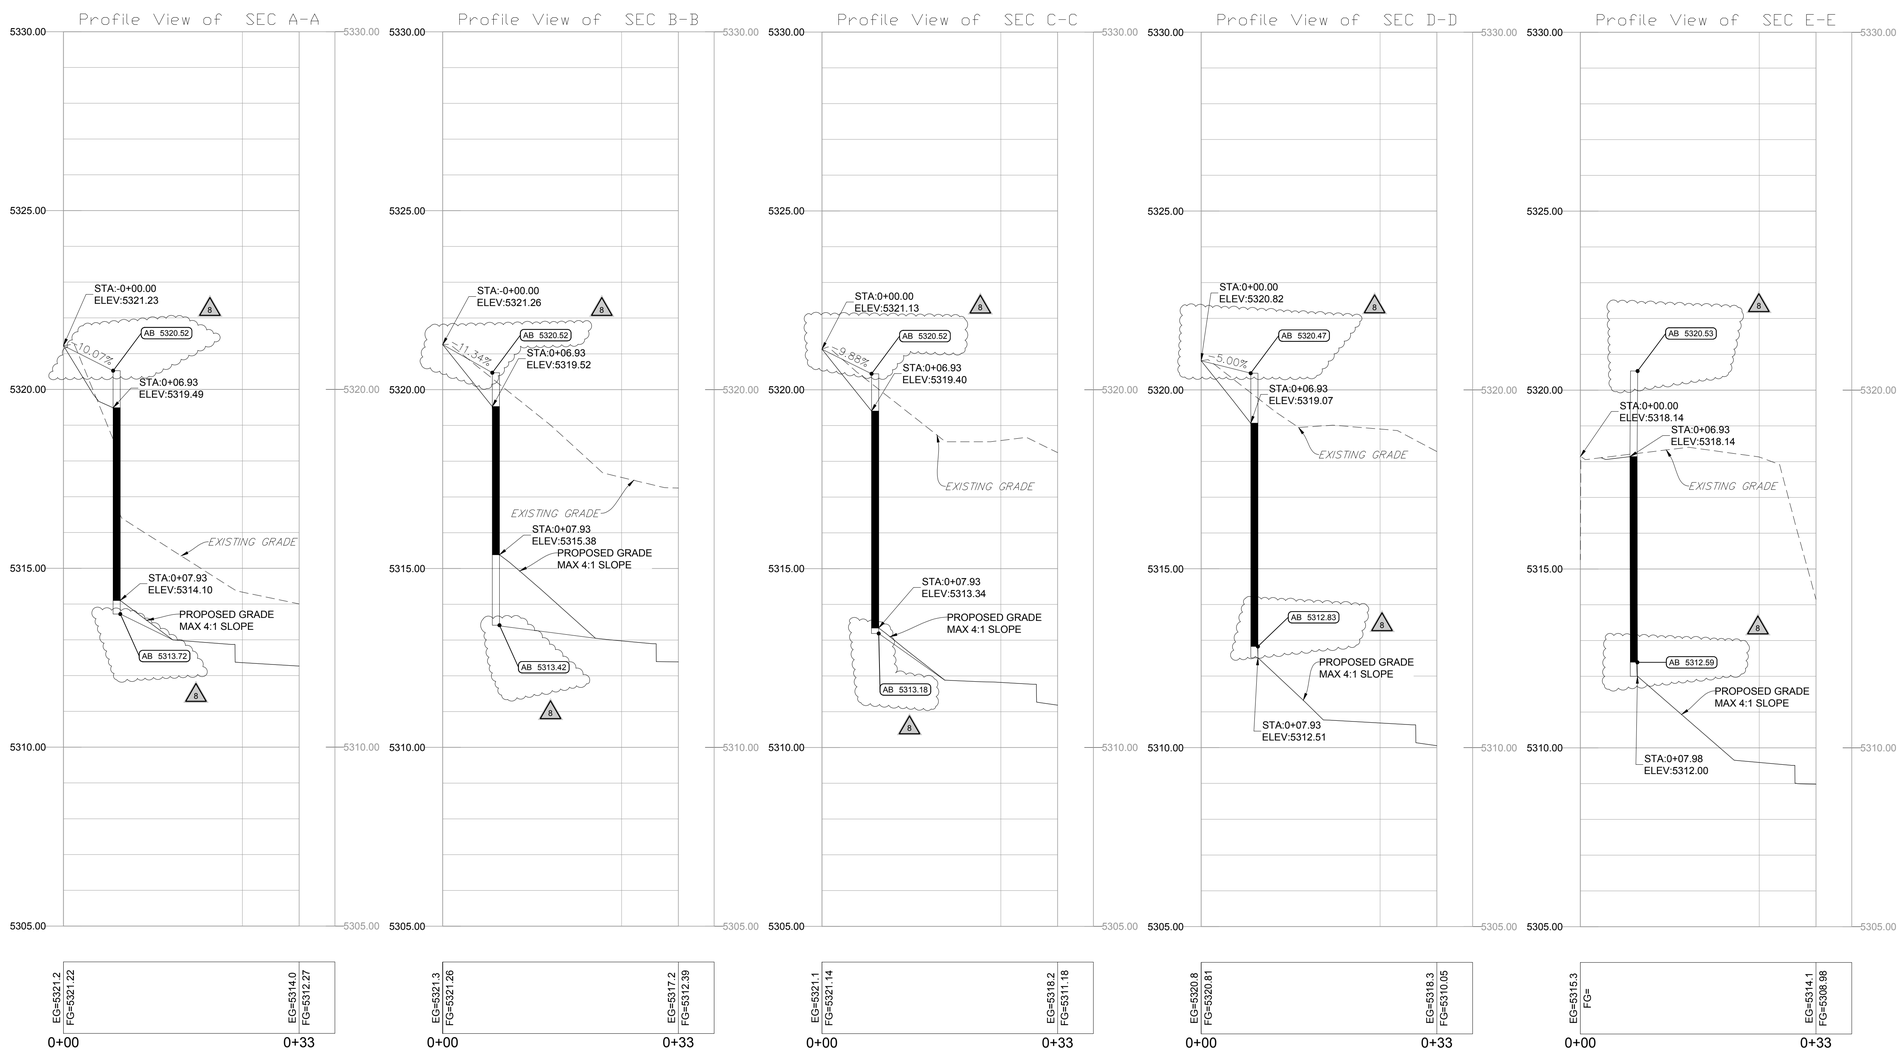

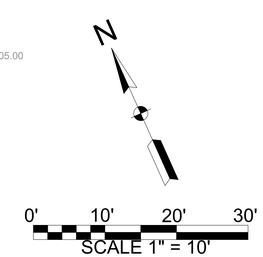

HCI ENGINEERING
A DIVISION OF
HABERER CARPENTRY INC.
621 SOUTHPARK DR., SUITE 1600
LITTLETON, CO. 80120
info@hciengineering.com

MARK D. MCCLUGGAGE AIA, CCS
1525 E. Douglas Wichita, KS 67211
Tel: (316) 265-5307 Fax: (316) 265-5646
www.gbinc.com

VERTEX
Main: 303.623.9116 | Direct: 720.545.0459
3734 Osage Street | Denver, CO 80211
CONTACT: LANCE VANDEMARK, P.E.

12134.230

5 DRB 1ST SUB	10.03.16
7 REVISION 7	02.09.17
8 AS-BUILT	07.12.17

CONTRACT DATE:
BUILDING TYPE: EXPLORER MED54
PLAN VERSION: ARRIL 2015 (N)
SITE NUMBER:
STORE NUMBER:

TACO BELL

UNSER BLVD
ALBUQUERQUE, NM 87114

EXPLORER
MEDIUM54

AS-BUILT
CDS WALL DETAIL

CD3.0