



City of Albuquerque

P.O. BOX 1293 ALBUQUERQUE, NEW MEXICO 87103

October 1, 2003

Glenn Broughton, P.E.
Bohannon Huston, Inc.
7500 Jefferson NE – Courtyard 1
Albuquerque, NM 87109

**Re: Quarters BBQ Restaurant, 3700 Ellison Dr. NW, Certificate of Occupancy
Engineer's Stamp dated 6-04-02 (A14/D9C)
Certification dated 9-23-03**

Dear Mr. Broughton,

Based upon the information provided in your submittal dated 9-23-03, the above referenced certification is approved for release of permanent Certificate of Occupancy by Hydrology.

If you have any questions, you can contact me at 924-3981.

Sincerely,

Kristal D. Metro
Engineering Associate, Planning Dept.
Development and Building Services

C: Phyllis Villanueva
file

DRAINAGE AND TRANSPORTATION INFORMATION SHEET

(REV. 1/11/2002)

PROJECT TITLE: Quarters BBQ Restaurant ZONE MAP/DRG. FILE # A-14 / D 9 C
DRB #: _____ EPC#: _____ WORK ORDER#: _____

LEGAL DESCRIPTION: _____
CITY ADDRESS: 3700 Ellison Drive NW

ENGINEERING FIRM: Bohannon Huston, Inc. CONTACT: Glenn Broughton
ADDRESS: 7500 Jefferson NE – Courtyard I PHONE: (505) 823-1000
CITY, STATE: Albuquerque, NM ZIP CODE: 87109

OWNER: _____ CONTACT: _____
ADDRESS: _____ PHONE: _____
CITY, STATE: _____ ZIP CODE: _____

ARCHITECT: Martin Grummer CONTACT: _____
ADDRESS: 331 Wellesley Place NE PHONE: (505) 265-2507
CITY, STATE: Albuquerque, NM ZIP CODE: 87106

SURVEYOR: _____ CONTACT: _____
ADDRESS: _____ PHONE: _____
CITY, STATE: _____ ZIP CODE: _____

CONTRACTOR: _____ CONTACT: _____
ADDRESS: _____ PHONE: _____
CITY, STATE: _____ ZIP CODE: _____

CHECK TYPE OF SUBMITTAL:


- ☐ DRAINAGE REPORT
☐ DRAINAGE PLAN
☒ CONCEPTUAL GRADING & DRAINAGE PLAN
☒ GRADING PLAN
☐ EROSION CONTROL PLAN
☐ ENGINEER'S CERTIFICATION (HYDROLOGY)
☐ CLOMR/LOMR
☐ TRAFFIC CIRCULATION LAYOUT (TCL)
☐ ENGINEERS CERTIFICATION (TCL)
☐ ENGINEERS CERTIFICATION (DRB APPR. SITE PLAN)
☐ OTHER

CHECK TYPE OF APPROVAL SOUGHT:

- ☐ SIA / FINANCIAL GUARANTEE RELEASE
☐ PRELIMINARY PLAT APPROVAL
☐ S. DEV. PLAN FOR SUB'D. APPROVAL
☐ S. DEV. PLAN FOR BLDG. PERMIT APPROVAL
☐ SECTOR PLAN APPROVAL
☐ FINAL PLAT APPROVAL
☐ FOUNDATION PERMIT APPROVAL
☐ BUILDING PERMIT APPROVAL
☒ CERTIFICATE OF OCCUPANCY (PERM.)
☐ CERTIFICATE OF OCCUPANCY (TEMP.)
☐ GRADING PERMIT APPROVAL
☐ PAVING PERMIT APPROVAL
☐ WORK ORDER APPROVAL
☐ OTHER (SPECIFY)

WAS A PRE-DESIGN CONFERENCE ATTENDED:


- ☐ YES
☐ NO
☐ COPY PROVIDED

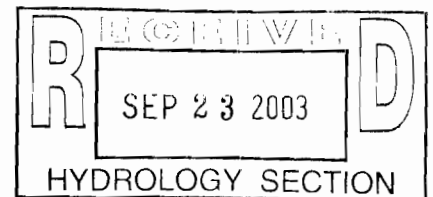

DATE SUBMITTED: _____ BY: _____

Requests for approvals of Site Development Plans and/or Subdivision Plats shall be accompanied by a drainage submittal. The particular nature, location and scope of the proposed development defines the degree of drainage detail. One or more of the following levels of submittal may be required based on the following:

- 1. Conceptual Grading and Drainage Plan:** Required for approval of Site Development Plans greater than five (5) acres and Sector Plans.
- 2. Drainage Plans:** Required for building permits, grading permits, paving permits and site plans less than five (5) acres.
- 3. Drainage Report:** Required for subdivisions containing more than ten (10) lots or constituting five (5) acres or more.

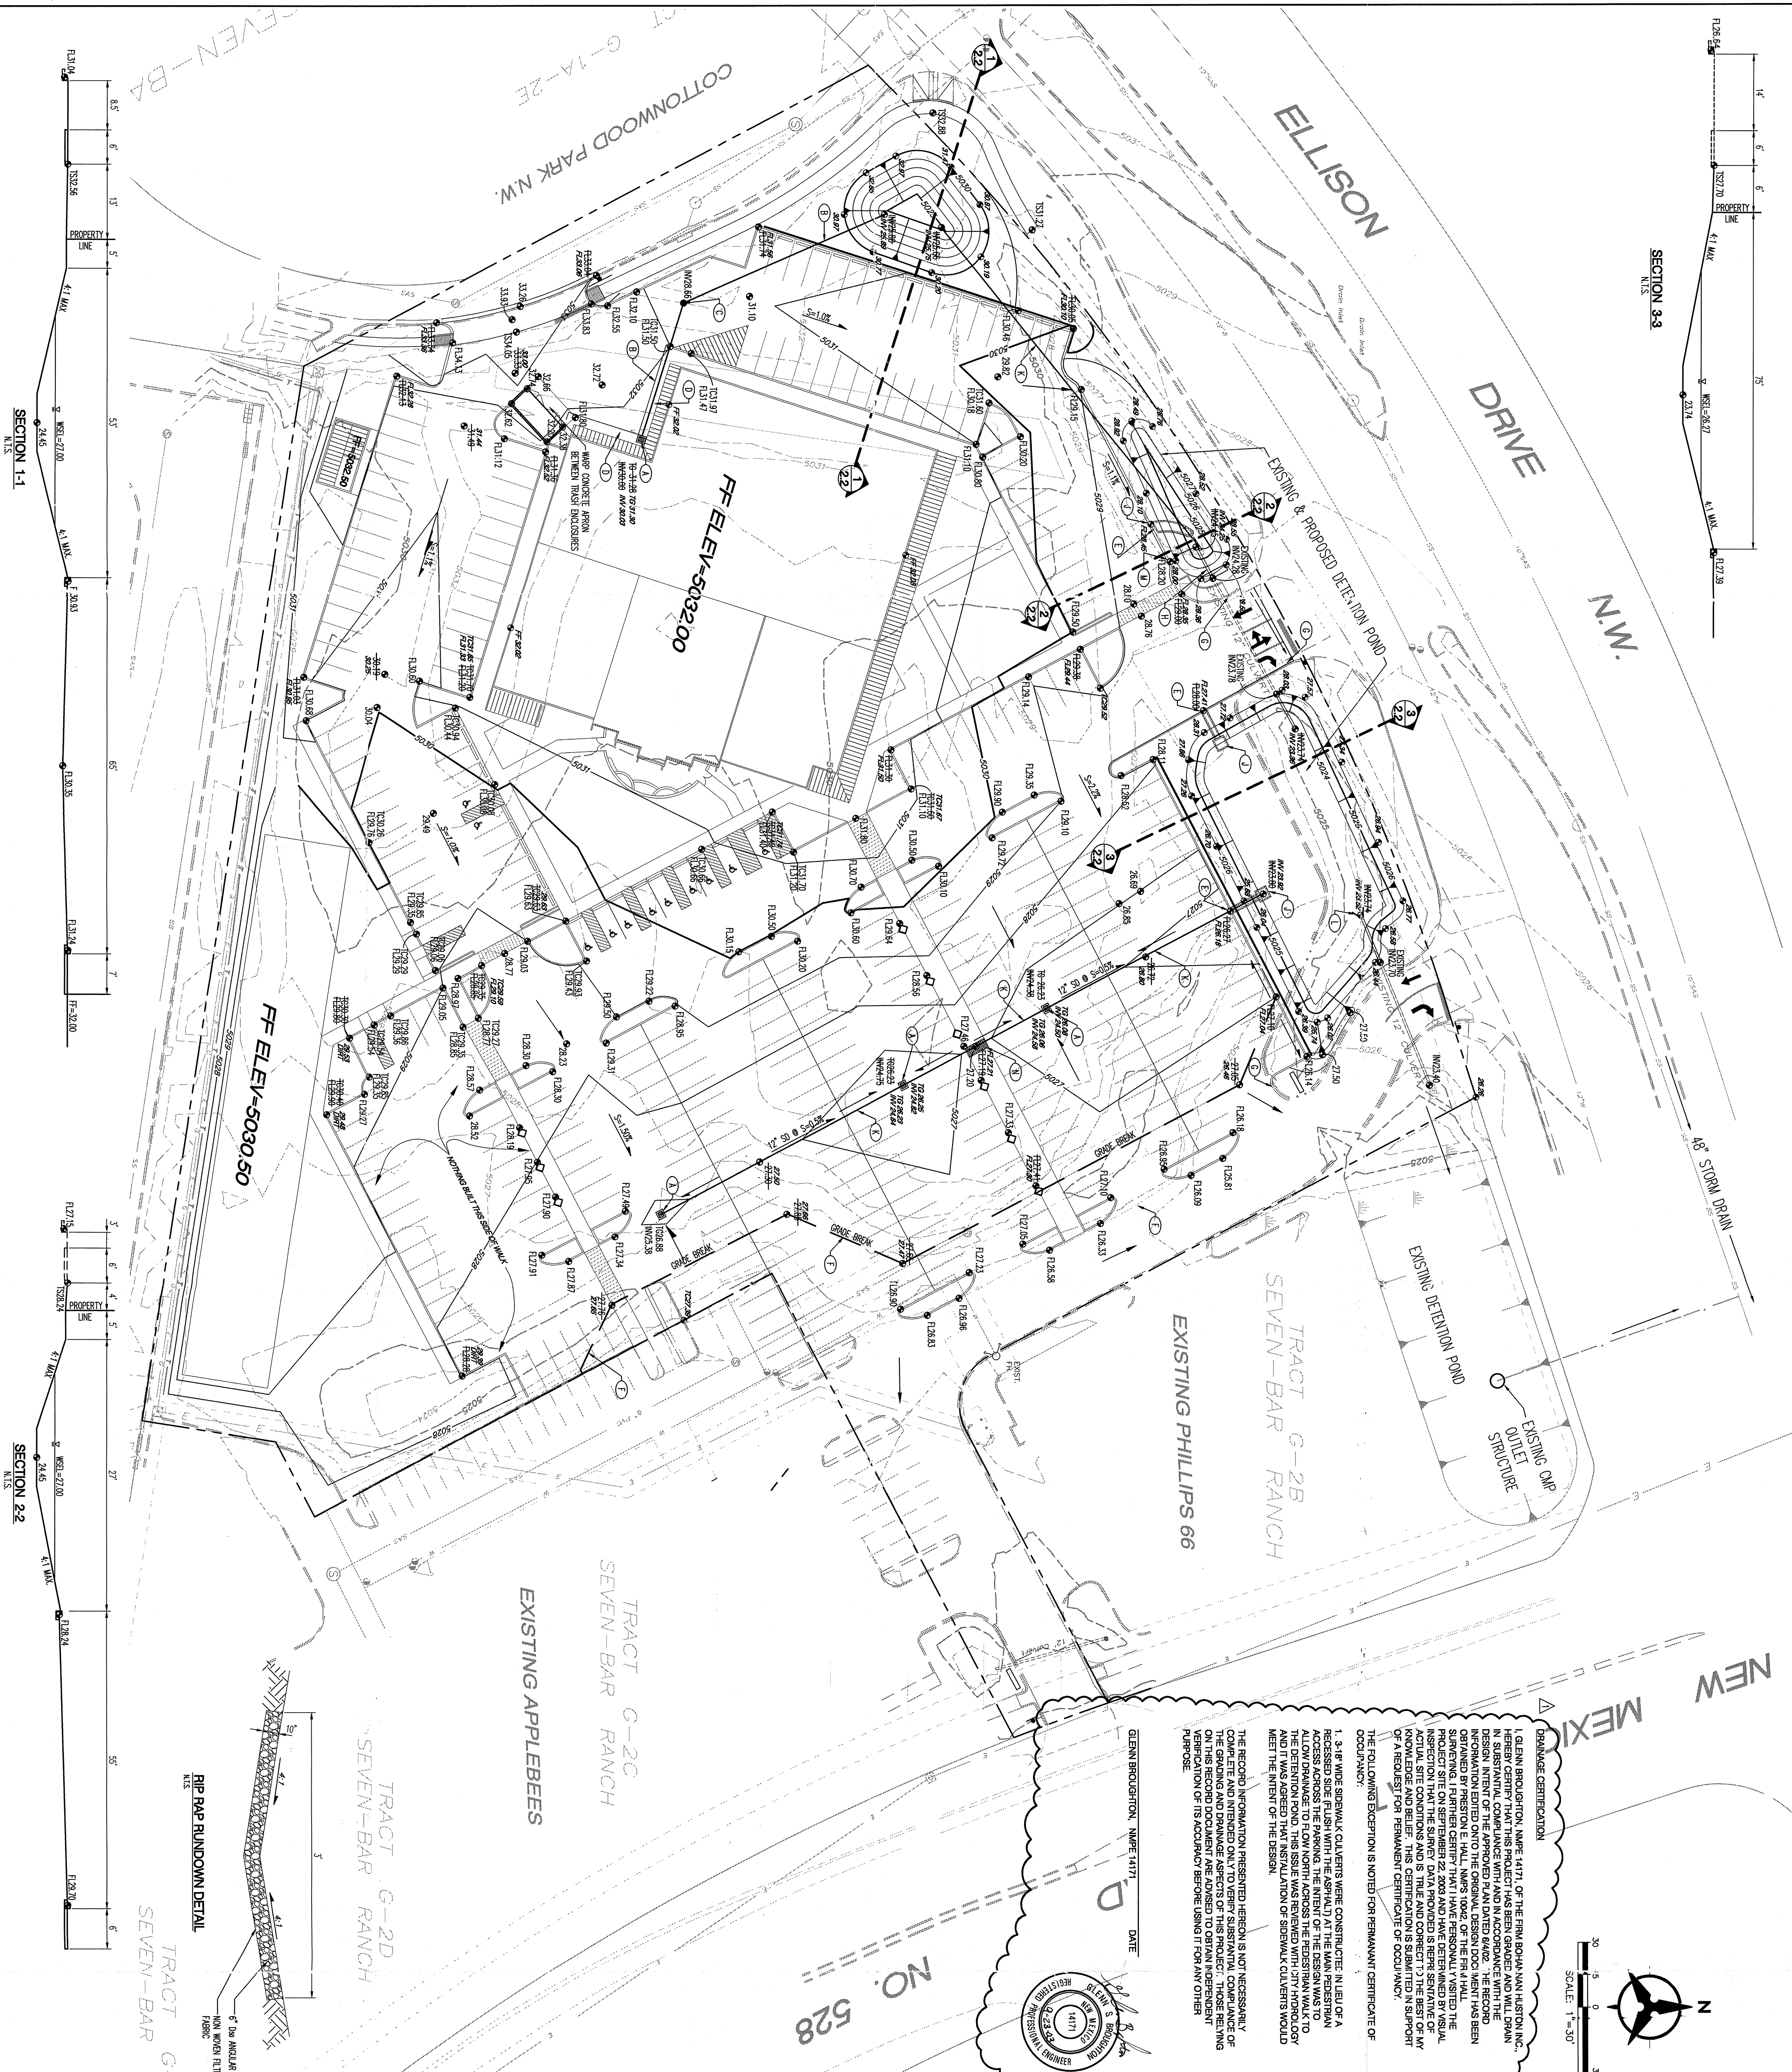

ZONE FILMS A-14

- 5304' ±
 PROPERTY LINE
 EXISTING CONTOURS
 EXISTING GROUND SPOT ELEVATION
 EXISTING ELECTRICAL POLE
 PROPOSED SPOT ELEVATION
 TO = TOP OF CURB, P = LOW LINE
 OF = TOP OF WALL, R = SECTION OF WALL

- Public Response, Extensions, See City
Workorder Plans
- 9/25/23
- _____ 5007 _____
- _____ PROPOSED DIRECTION OF FLOW _____
- _____ PROPOSED INLET CONTROLS _____
- _____ PROPOSED INTER CONTROLS _____
- _____ PROPOSED CURB & GUTTER _____
- _____ PROPOSED STORM DRAIN INLET _____
- _____ PROPOSED STORM DRAIN MANHOLE _____
- _____ PROPOSED STORM DRAIN INLET _____
- _____ EXISTING STORM DRAIN MANHOLE _____
- _____ (SEE ARCHITECTURAL) _____
- _____ SITE WALL _____
- _____ RESULT ELEVATION _____


- ## KEYED NOTES



GRADING NOTES



DATE:	PROJECT:		
	TITLE:		
	<div style="text-align: center;"> REVISION </div>	<div style="text-align: center;">  </div>	DRAINAGE CERTIFICATION

DATE:

DRAWN BY: 00/00/00

ED
CHECKED BY:

	GSB
	400001750 BY

GSB


SHEET NO:

C-2.2

[illegible]

TNE
THOMSEN NELLO
ENGINEERING
MECHANICAL CONSULTING
FOR BUILDING SYSTEMS



915 YALE BLVD., S.E.
ALBUQUERQUE, NEW MEXICO 87106
(505) 888-5808



MARTIN FM GRUMMER
ARCHITECT
331 WELLESLEY PLACE NE
ALBUQUERQUE, NEW MEXICO 87106
(505) 265-2507


Nellos Brothers Inc. dba.
Quarters BBQ Restaurant
and Package Liquor

GRADING

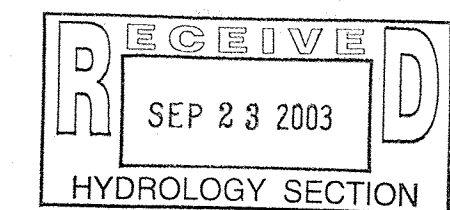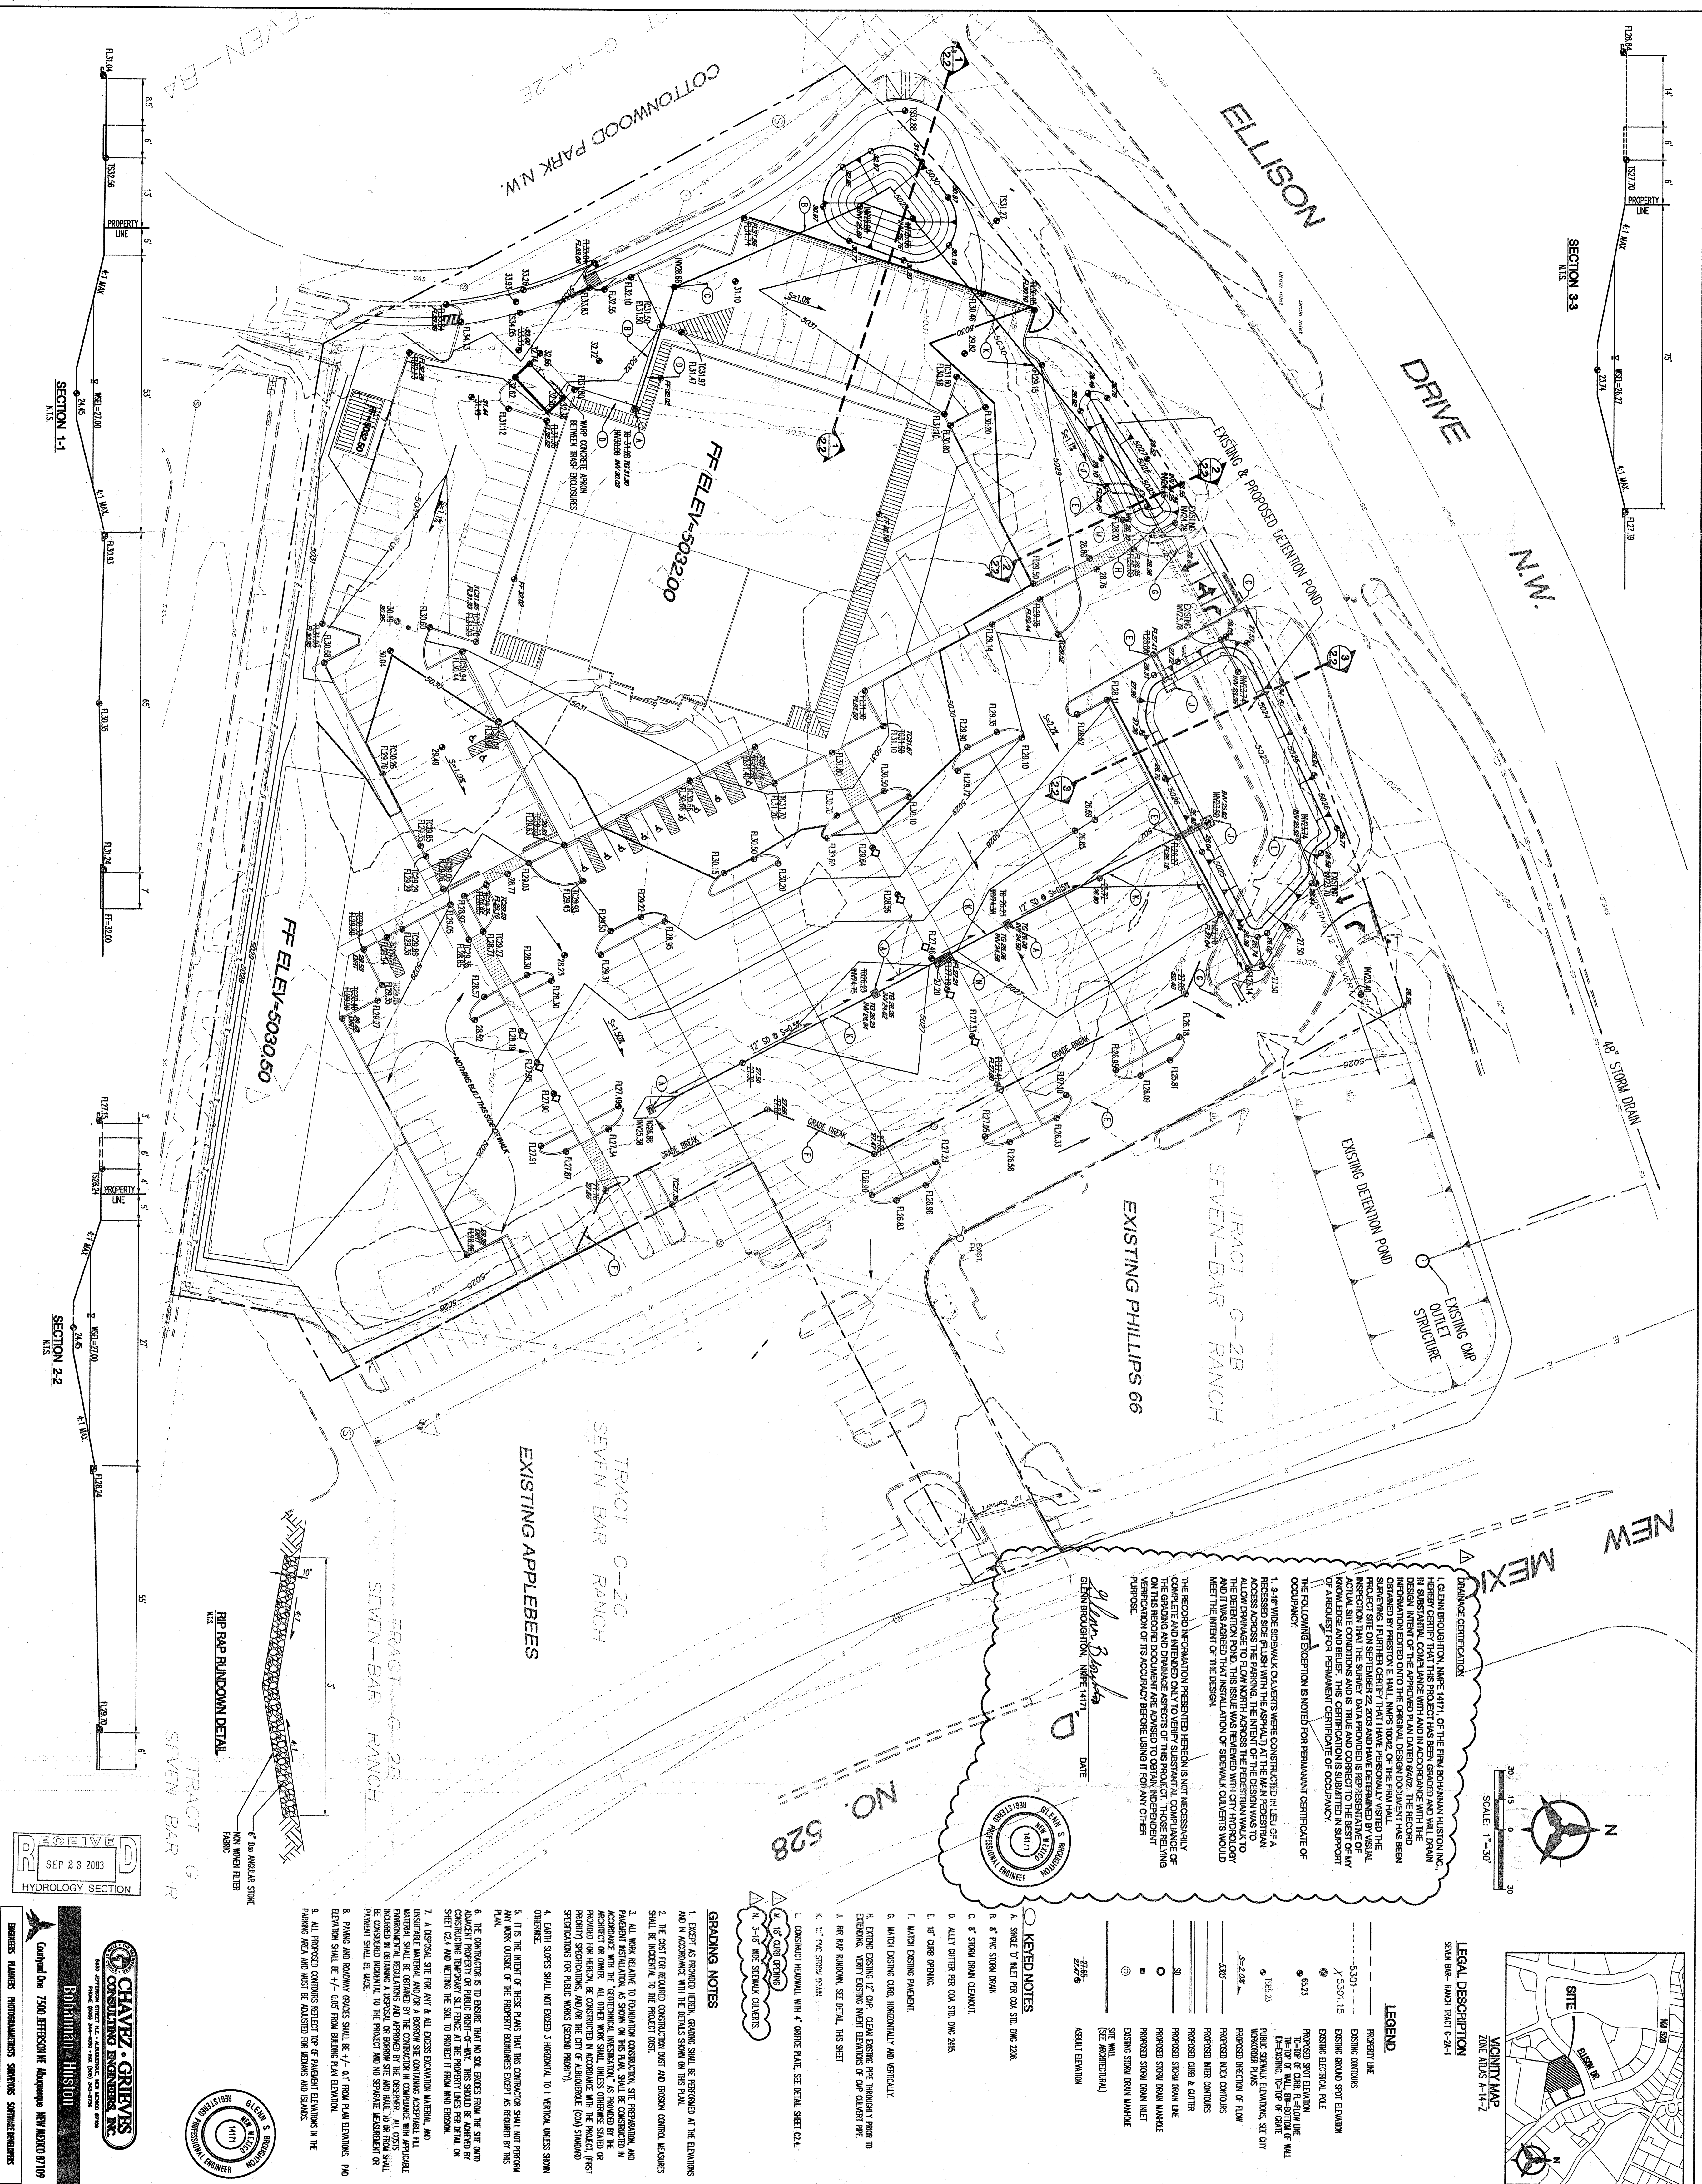

CHAVEZ-GRIEVES
CONSULTING ENGINEERS, INC.


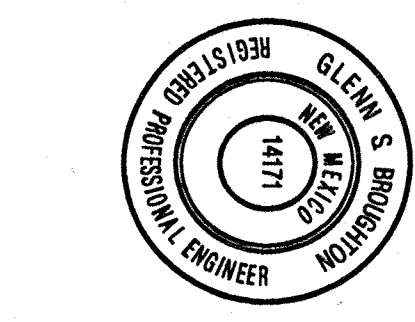



DATE: 06/03/02
DRAWN BY: ED
CHECKED BY: CSB
APPROVED BY: CSB

REVISIONS
1. BOUNDARY CERTIFICATION

PROJECT: Nello Brothers Inc. dba. Quarters BBQ Restaurant and Package Liquor
TITLE: GRADING

PROJECT: Nello Brothers Inc. dba. Quarters BBQ Restaurant and Package Liquor
TITLE: GRADING

