RECORD DRAWINGS

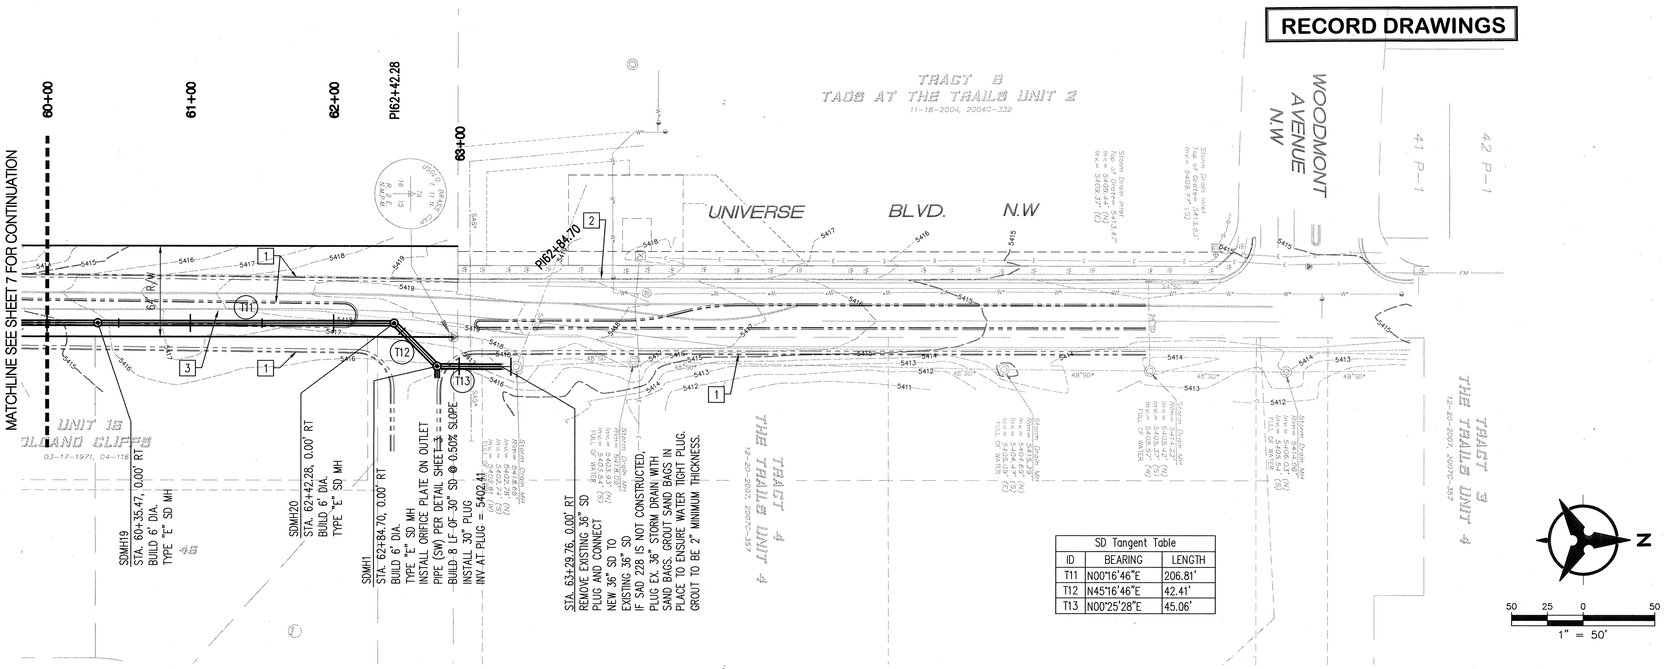

SD Tangent Table		
ID	BEARING	LENGTH
T11	N00°16'46"E	206.81'
T12	N45°16'46"E	42.41'
T13	N00°25'28"E	45.06'

STA. 60+00.00 - 63+36.00

ELEVATIONS ARE IN NAVD 88

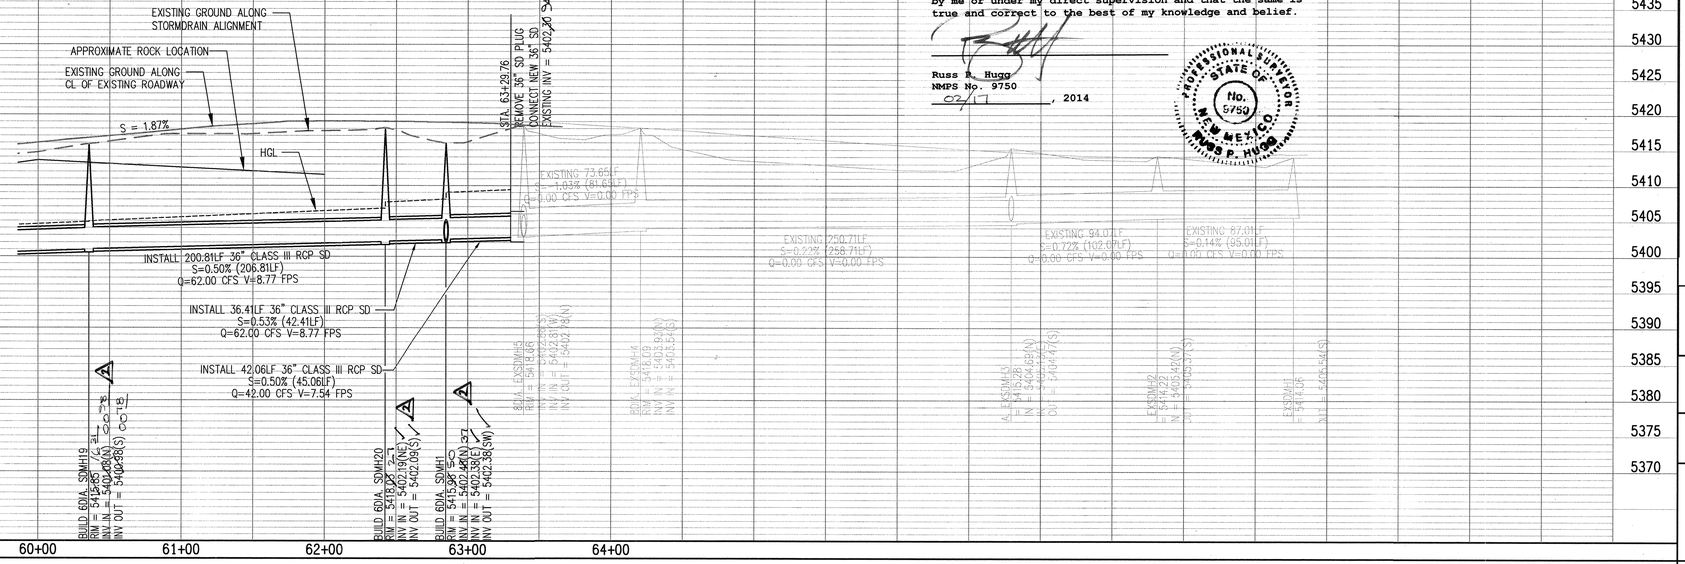

SURVEYORS CERTIFICATION

I, Russ P. Hugg, New Mexico Professional Surveyor Number 9750, hereby certify that the as-built information shown hereon is the result of an actual field survey performed by me or under my direct supervision and that the same is true and correct to the best of my knowledge and belief.

Russ P. Hugg
NMPS No. 9750
02/17, 2014

PROFESSIONAL SURVEYOR STATE OF NEW MEXICO No. 9750 RUSS P. HUGG

GENERAL NOTES

1. THE CONTRACTOR SHALL FIELD VERIFY ALL EXISTING UTILITY LOCATIONS AND NOTIFY THE ENGINEER IMMEDIATELY OF ANY DISCREPANCIES. CONTRACTOR SHALL COORDINATE RELOCATION OF UTILITY LINES WITH UTILITY COMPANIES AS REQUIRED.
2. ALL CURVE DATA AND DIMENSIONS ARE CALCULATED FROM CENTERLINE OF PIPE OR MANHOLE. ALL SAS & SD SLOPES ARE CALCULATED TO TRUE PIPE DIMENSIONS FROM INVERT TO INVERT. (PAY ITEMS ARE SHOWN IN PARENTHESES)
3. GRADE ELEVATIONS, WHERE NOTED, ARE FOR FLOWLINE OF STANDARD CURB UNLESS OTHERWISE SPECIFIED.
4. CONTRACTOR IS RESPONSIBLE FOR REPAIR AND/OR REPLACEMENT OF ALL DAMAGED EXISTING UTILITY CONDUITS AND EXISTING LINES.
5. CONTRACTOR SHALL PARK EQUIPMENT AND VEHICLES AS NOT TO INTERFERE WITH NORMAL ACTIVITIES OF RESIDENTS OR OTHER CONTRACTORS ON SITE.
6. ANY DAMAGE TO THE EXISTING FACILITIES (CURB & GUTTER, PAVEMENT, LANDSCAPING, ETC.) DURING CONSTRUCTION SHALL BE REPLACED AT THE CONTRACTORS' EXPENSE.
7. MH RIMS & CATCH BASIN INLET ELEVATIONS, FIRE HYDRANT & FLANGE ELEVATIONS ARE APPROXIMATE. CONTRACTOR SHALL FIELD VERIFY AND ADJUST TO FINAL PAVEMENT OR SURFACE GRADES.
8. STORM DRAIN STATIONING FOLLOWS CL OF STORM DRAIN UNLESS OTHERWISE NOTED
9. STATIONING OF DROP INLET IS TO MIDDLE OF DOWN HILL GRATE AT FACE OF CURB.
10. FLOWLINE ELEVATIONS FOR DROP INLETS ARE PROJECTED FROM FLOWLINE OF STANDARD CURB TO MIDDLE OF DOWNHILL GRATE.
11. ALL WATERLINE FITTINGS, VALVES, BENDS, TEES, CROSSES AND APPURTENANCES SHALL USE RESTRAINED JOINTS UNLESS OTHERWISE NOTED ON THE PLANS.
12. AT UTILITY CROSSING WHERE LESS THAN 1 FOOT OF COVER OVER STORM DRAIN PIPE IS PRESENT LEAN FILL IS TO BE USED FOR A DISTANCE OF 5 FEET ON EACH SIDE OF THE SD ℄ FROM TOP OF STORM DRAIN TO BOTTOM OF SANITARY SEWER OR WATER LINE.
13. RCP SHALL BE INSTALLED SO THAT THE JOINT GAP AT THE HOME POSITION SHALL CONFORM TO THE APPROVED MANUFACTURER'S RECOMMENDATIONS. MANUFACTURER'S RECOMMENDED JOINT GAP TOLERANCES FOR EACH PIPE SIZE AND TYPE SHALL BE SUBMITTED TO THE ENGINEER FOR APPROVAL PRIOR TO PLACEMENT OF PIPE. RCP JOINTS SHALL NOT BE GROUTED UNLESS DIRECTED BY THE ENGINEER AFTER CITY APPROVAL.
14. ALL EXCAVATION, TRENCHING AND SHORING ACTIVITIES MUST BE CARRIED-OUT IN ACCORDANCE WITH OSHA 29 CFR 1926.650 SUBPART P.

KEYED NOTES

[1] FUTURE CURB & GUTTER
[2] EXISTING CURB & GUTTER
[3] EXISTING EDGE OF ASPHALT
[4] EXISTING 48" STORM DRAIN

SURVEY INFORMATION
FIELD NOTES

NO.	BY	DATE
A	Sarv-Tek	3/14

BENCH MARKS

ACS MONUMENT STAMPED "CC_TA_16_15_11N_2E"
GEOGRAPHIC POSITION (NAD 83)
N.M. STATE PLANE COORDINATES (CENTRAL ZONE)
X = 1,497,693.917 Y = 1,521,076.443
GROUND-TO-GRID FACTOR = 0.999667560
Δα = -00°16'30.67"
NAVD 1988 ELEVATION = 5417.800

AS-BUILT INFORMATION

CONTRACTOR	DYTHAN	DATE 3/14
STAKED BY	Sarv-Tek	DATE 6/12
INSPECTION'S PERFORMED BY	RHF	DATE 3/14
FIELD VERIFICATION BY	Sarv-Tek	DATE 7/14
DRAWINGS CORRECTED BY	Sarv-Tek	DATE 7/14
MICRO-FILM INFORMATION		
RECORDED BY		DATE
NO.		

ENGINEER'S SEAL
RUSS P. HUGG 14664 NEW MEXICO PROFESSIONAL ENGINEER 2/13/15

No.	Date	By	REMARKS
			REVISIONS
			DESIGN
			Designed By: SJS DATE: 10/2012
			Drawn By: DH DATE: 10/2012
			Checked By: SJS DATE: 10/2012

Bohannan Huston

CITY OF ALBUQUERQUE
PUBLIC WORKS DEPARTMENT

THE TRAILS UNIVERSE STORM DRAIN
UTILITY PLAN AND PROFILE
STA. 60+00.00 - 63+36.00

Design Review Committee	City Engineer Approval	Last Design Update	Mo./Day/Yr.	Mo./Day/Yr.
APPROVED MAR 12 2013 DESIGN REVIEW COMMITTEE	APPROVED JUL 2013 CITY ENGINEER			

City Project No.	Zone Map No.	Sheet	Of
761283	C-9 / D-9	8	19

SCALE: 1" = 50' (HORIZ.)
1" = 10' (VERT.)

P:\20130203\CDP\Plans\PNP\Universe SD_Upnp06.dwg
February 13, 2013 - 9:20am