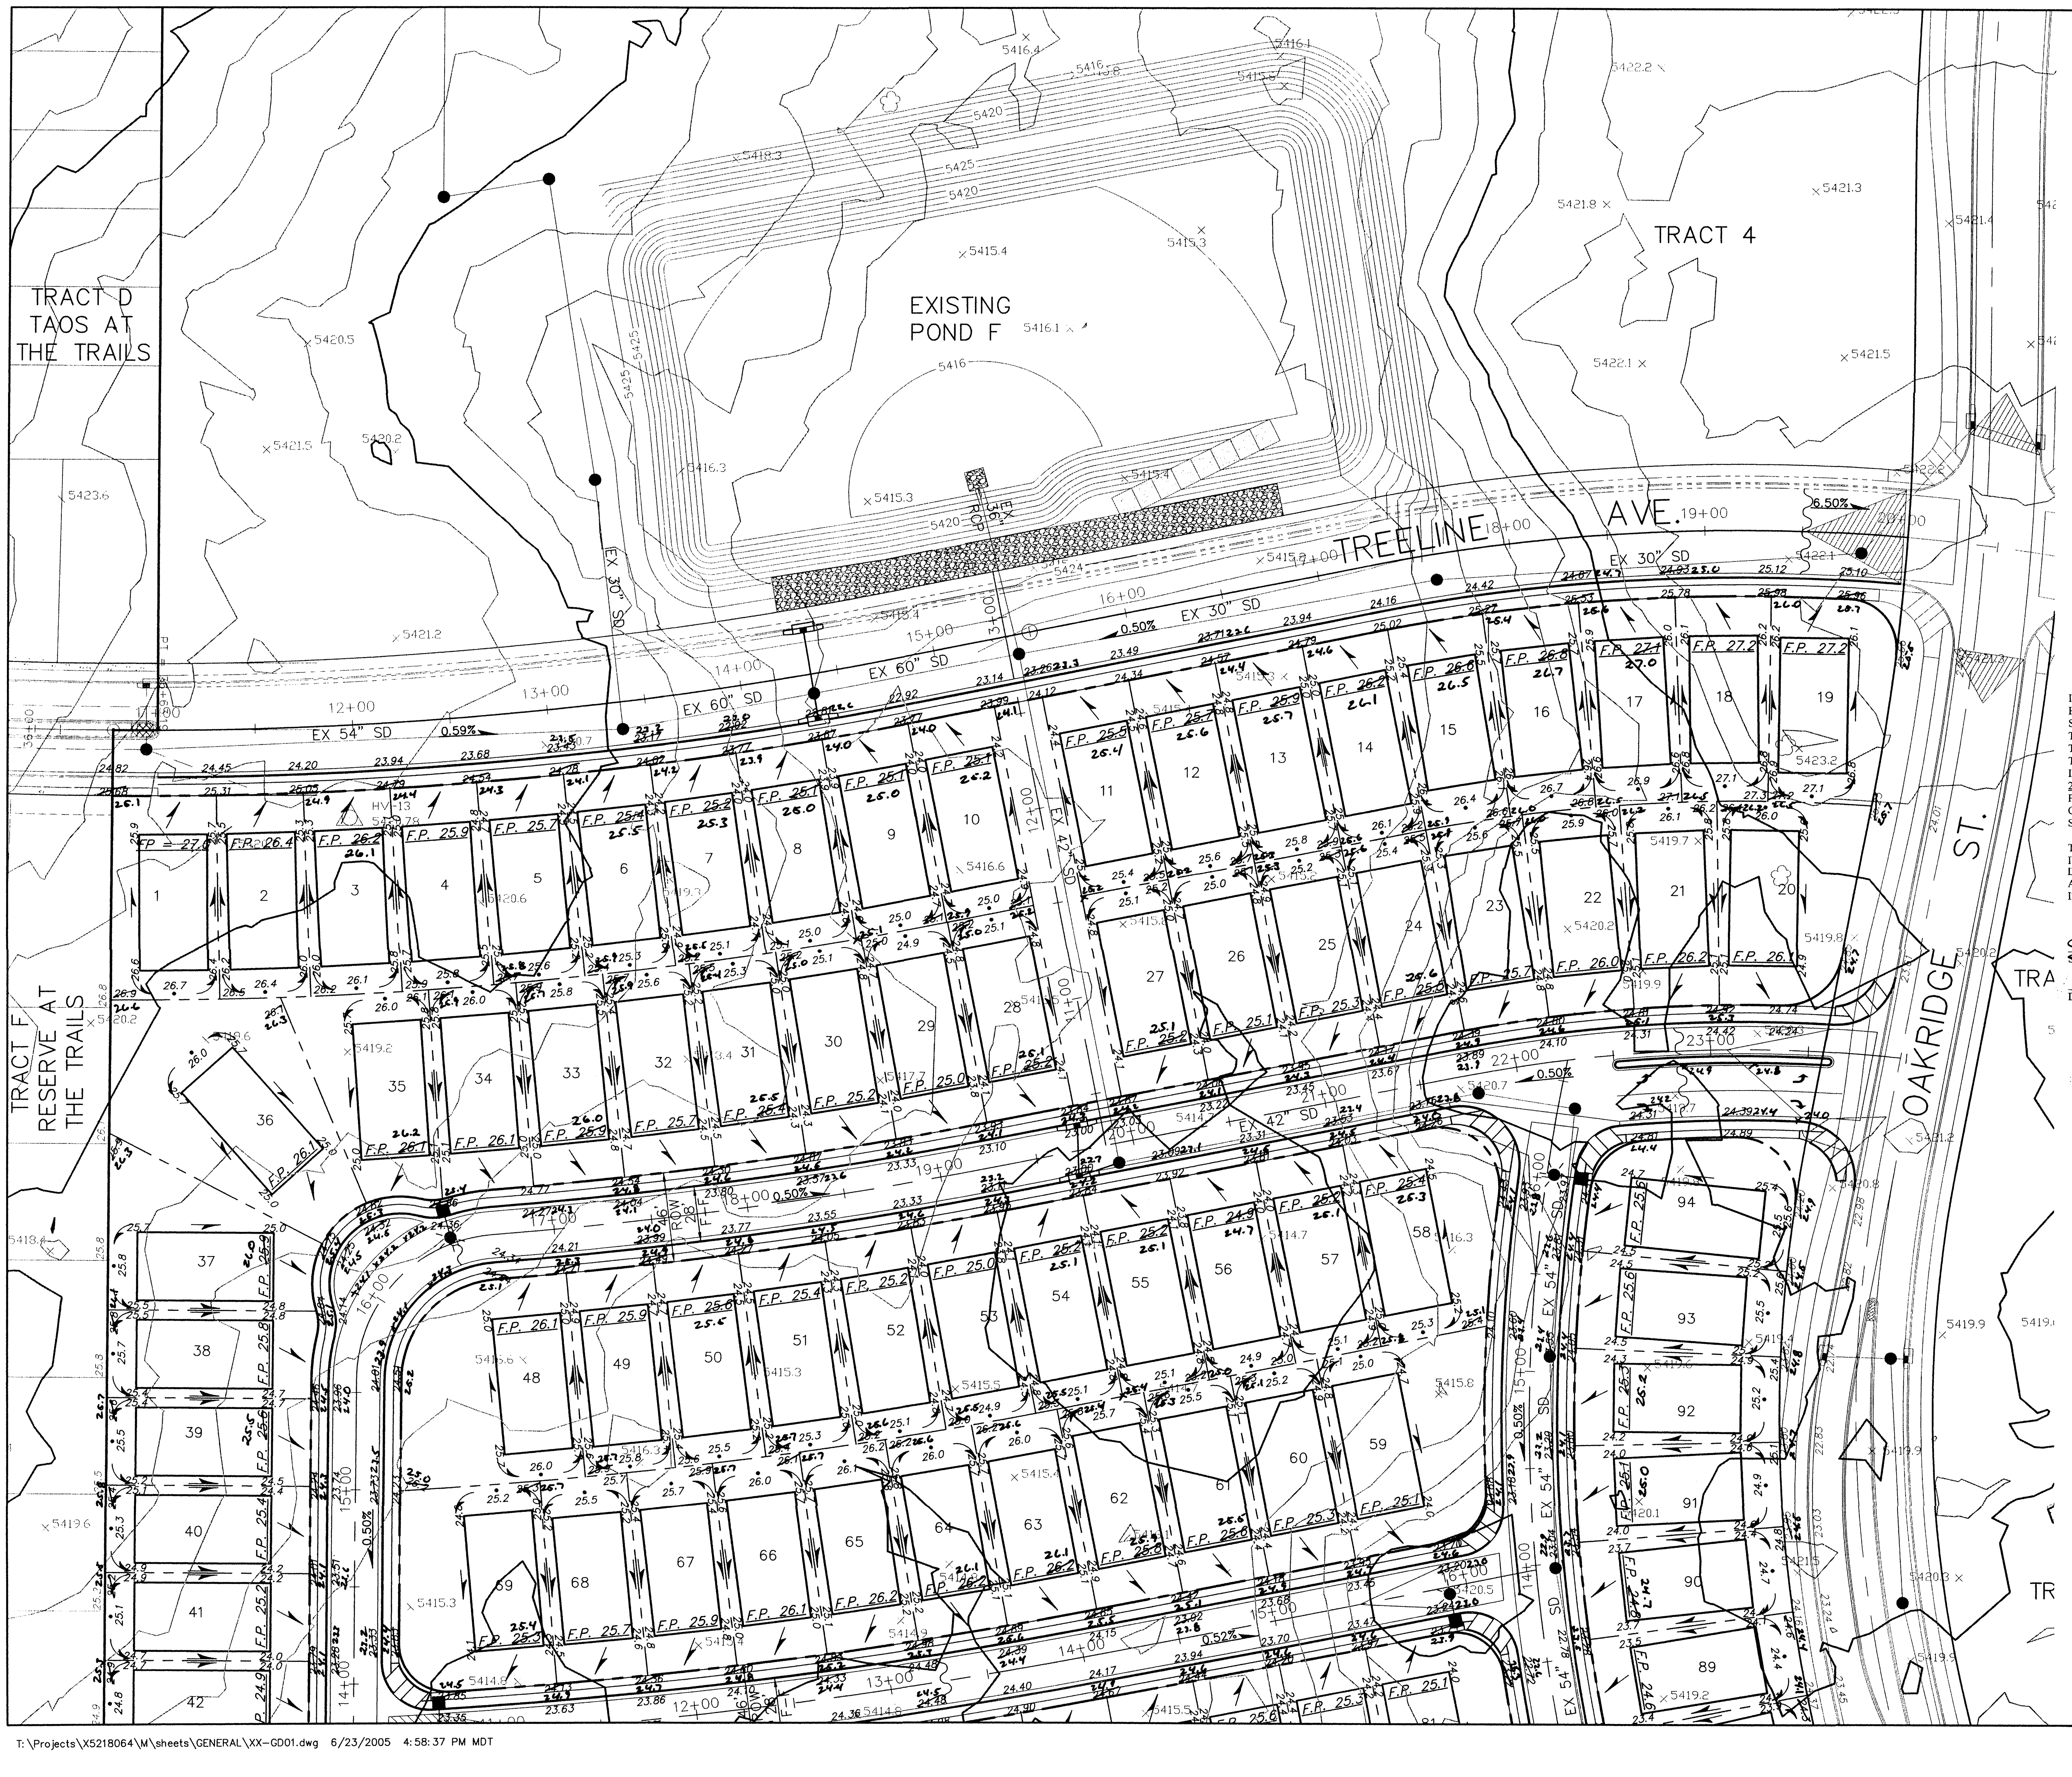

LEGEND

- ▬ ▬ ▬ RETAINING WALL
- 〰 HIGH POINT
- → DIRECTION OF FLOW
- •xx.xx ℄ LINE ELEVATION
- ━━ BASIN BOUNDARY
- ▬ TYPE DOUBLE C INLET
- (X–X) RETAINING WALL POINT

N

GRAPHIC SCALE

40 0 20 40 80 160

SCALE: 1 INCH = 40 FT.

DRAINAGE CERT W/ SURVEY WORK BY OTHERS
12/28/01

DRAINAGE CERTIFICATION

I, Steve J. Salazar, NMPE 16241, OF THE FIRM Wilson & Company, Inc., HEREBY CERTIFY THAT THIS PROJECT HAS BEEN GRADED AND WILL DRAIN IN SUBSTANTIAL COMPLIANCE WITH AND IN ACCORDANCE WITH THE DESIGN INTENT OF THE APPROVED PLAN DATED 7-7-05. THE RECORD INFORMATION EDITED ONTO THE ORIGINAL DESIGN DOCUMENT HAS BEEN OBTAINED BY Russ P. Hugg, NMPS 9750, OF THE FIRM Survtek.

I FURTHER CERTIFY THAT I HAVE PERSONALLY VISITED THE PROJECT SITE ON October 20, 2006 AND HAVE DETERMINED BY VISUAL INSPECTION THAT THE SURVEY DATA PROVIDED IS REPRESENTATIVE OF ACTUAL SITE CONDITIONS AND IS TRUE AND CORRECT TO THE BEST OF MY KNOWLEDGE AND BELIEF. THIS CERTIFICATION IS SUBMITTED IN SUPPORT OF A REQUEST FOR PERMANENT CERTIFICATE OF OCCUPANCY.

THE RECORD INFORMATION PRESENTED HEREON IS NOT NECESSARILY COMPLETE AND INTENDED ONLY TO VERIFY SUBSTANTIAL COMPLIANCE OF THE GRADING AND DRAINAGE ASPECTS OF THIS PROJECT. THOSE RELYING ON THIS RECORD DOCUMENT ARE ADVISED TO OBTAIN INDEPENDENT VERIFICATION OF ITS ACCURACY BEFORE USING IT FOR ANY OTHER PURPOSE.

Steve J. Salazar, NMPE 16241

DATE 10/25/06

STEVE J. SALAZAR 16241

RECEIVED
OCT 25 2006
HYDROLOGY SECTION

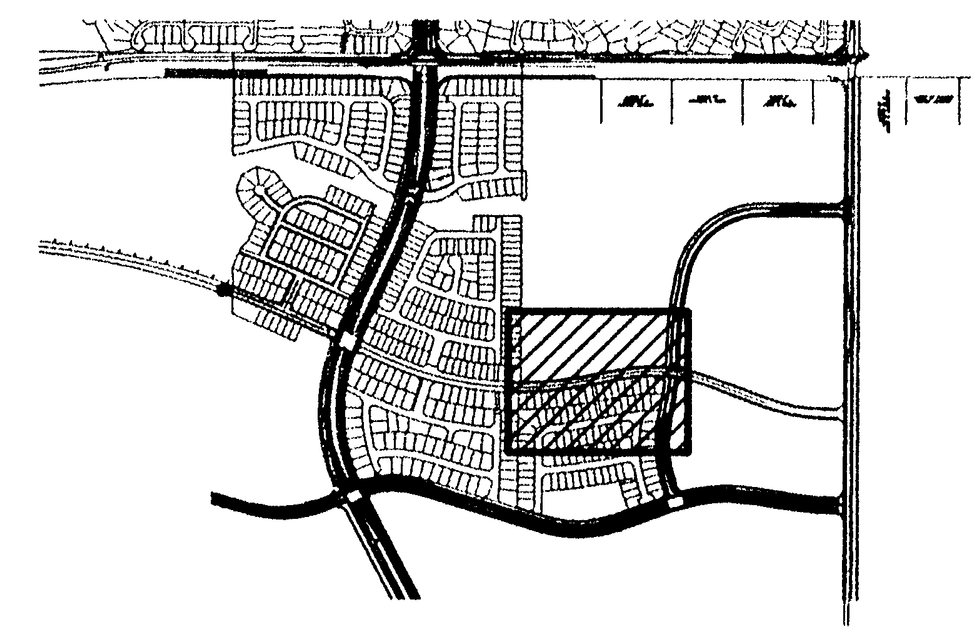

WILSON & COMPANY
2600 THE AMERICAN ROAD S.E.
SUITE 100
RIO RANCHO, NEW MEXICO
87124
(505) 898-8021

CITY OF ALBUQUERQUE
PUBLIC WORKS DEPARTMENT
ENGINEERING GROUP

TRACT 6 OF THE TRAILS UNIT II
GRADING & DRAINAGE PLAN

Design Review Committee	City Engineer Approval	Last Design Update	Mo./Day/Yr.	Mo./Day/Yr.

City Project No.	Zone Map No.	Sheet	Of
—	C-9-Z	PLATE 3A	

ENGINEER'S SEAL

16241
7/7/05

REVISIONS

NO.	DATE	REMARKS	BY
△1	9-12-05	FIELD REVISION DUE TO DRC APPRO.	

WILSON & COMPANY, ENGINEERS & ARCHITECTS

DESIGNED BY	DMD	DATE	JULY 05
DRAWN BY	DMD	DATE	JULY 05
CHECKED BY	SJS	DATE	JULY 05

SURVEY INFORMATION

FIELD NOTES

NO.	BY	DATE

BENCH MARKS

ACS BRASS TABLET STAMPED "2–B10 1980"
Geographic Position (NAD 1927)
N.M. State Plane Coordinates (Central Zone)
X= 357,543.73 Y= 1,527,976.48
Ground–to–Grid Factor = 0.99966354
$\Delta\alpha$ = –00°16'30"
SLD 1929 Elevation = 5429.35

AS–BUILT INFORMATION

CONTRACTOR
WORK STAKED BY DATE
INSPECTOR'S ACCEPTANCE BY DATE
FIELD VERIFICATION BY DATE
DRAWINGS CORRECTED BY DATE

MICRO–FILM INFORMATION

RECORDED BY DATE
NO.

T:\Projects\X5218064\M\sheets\GENERAL\XX-GD01.dwg 6/23/2005 4:58:37 PM MDT

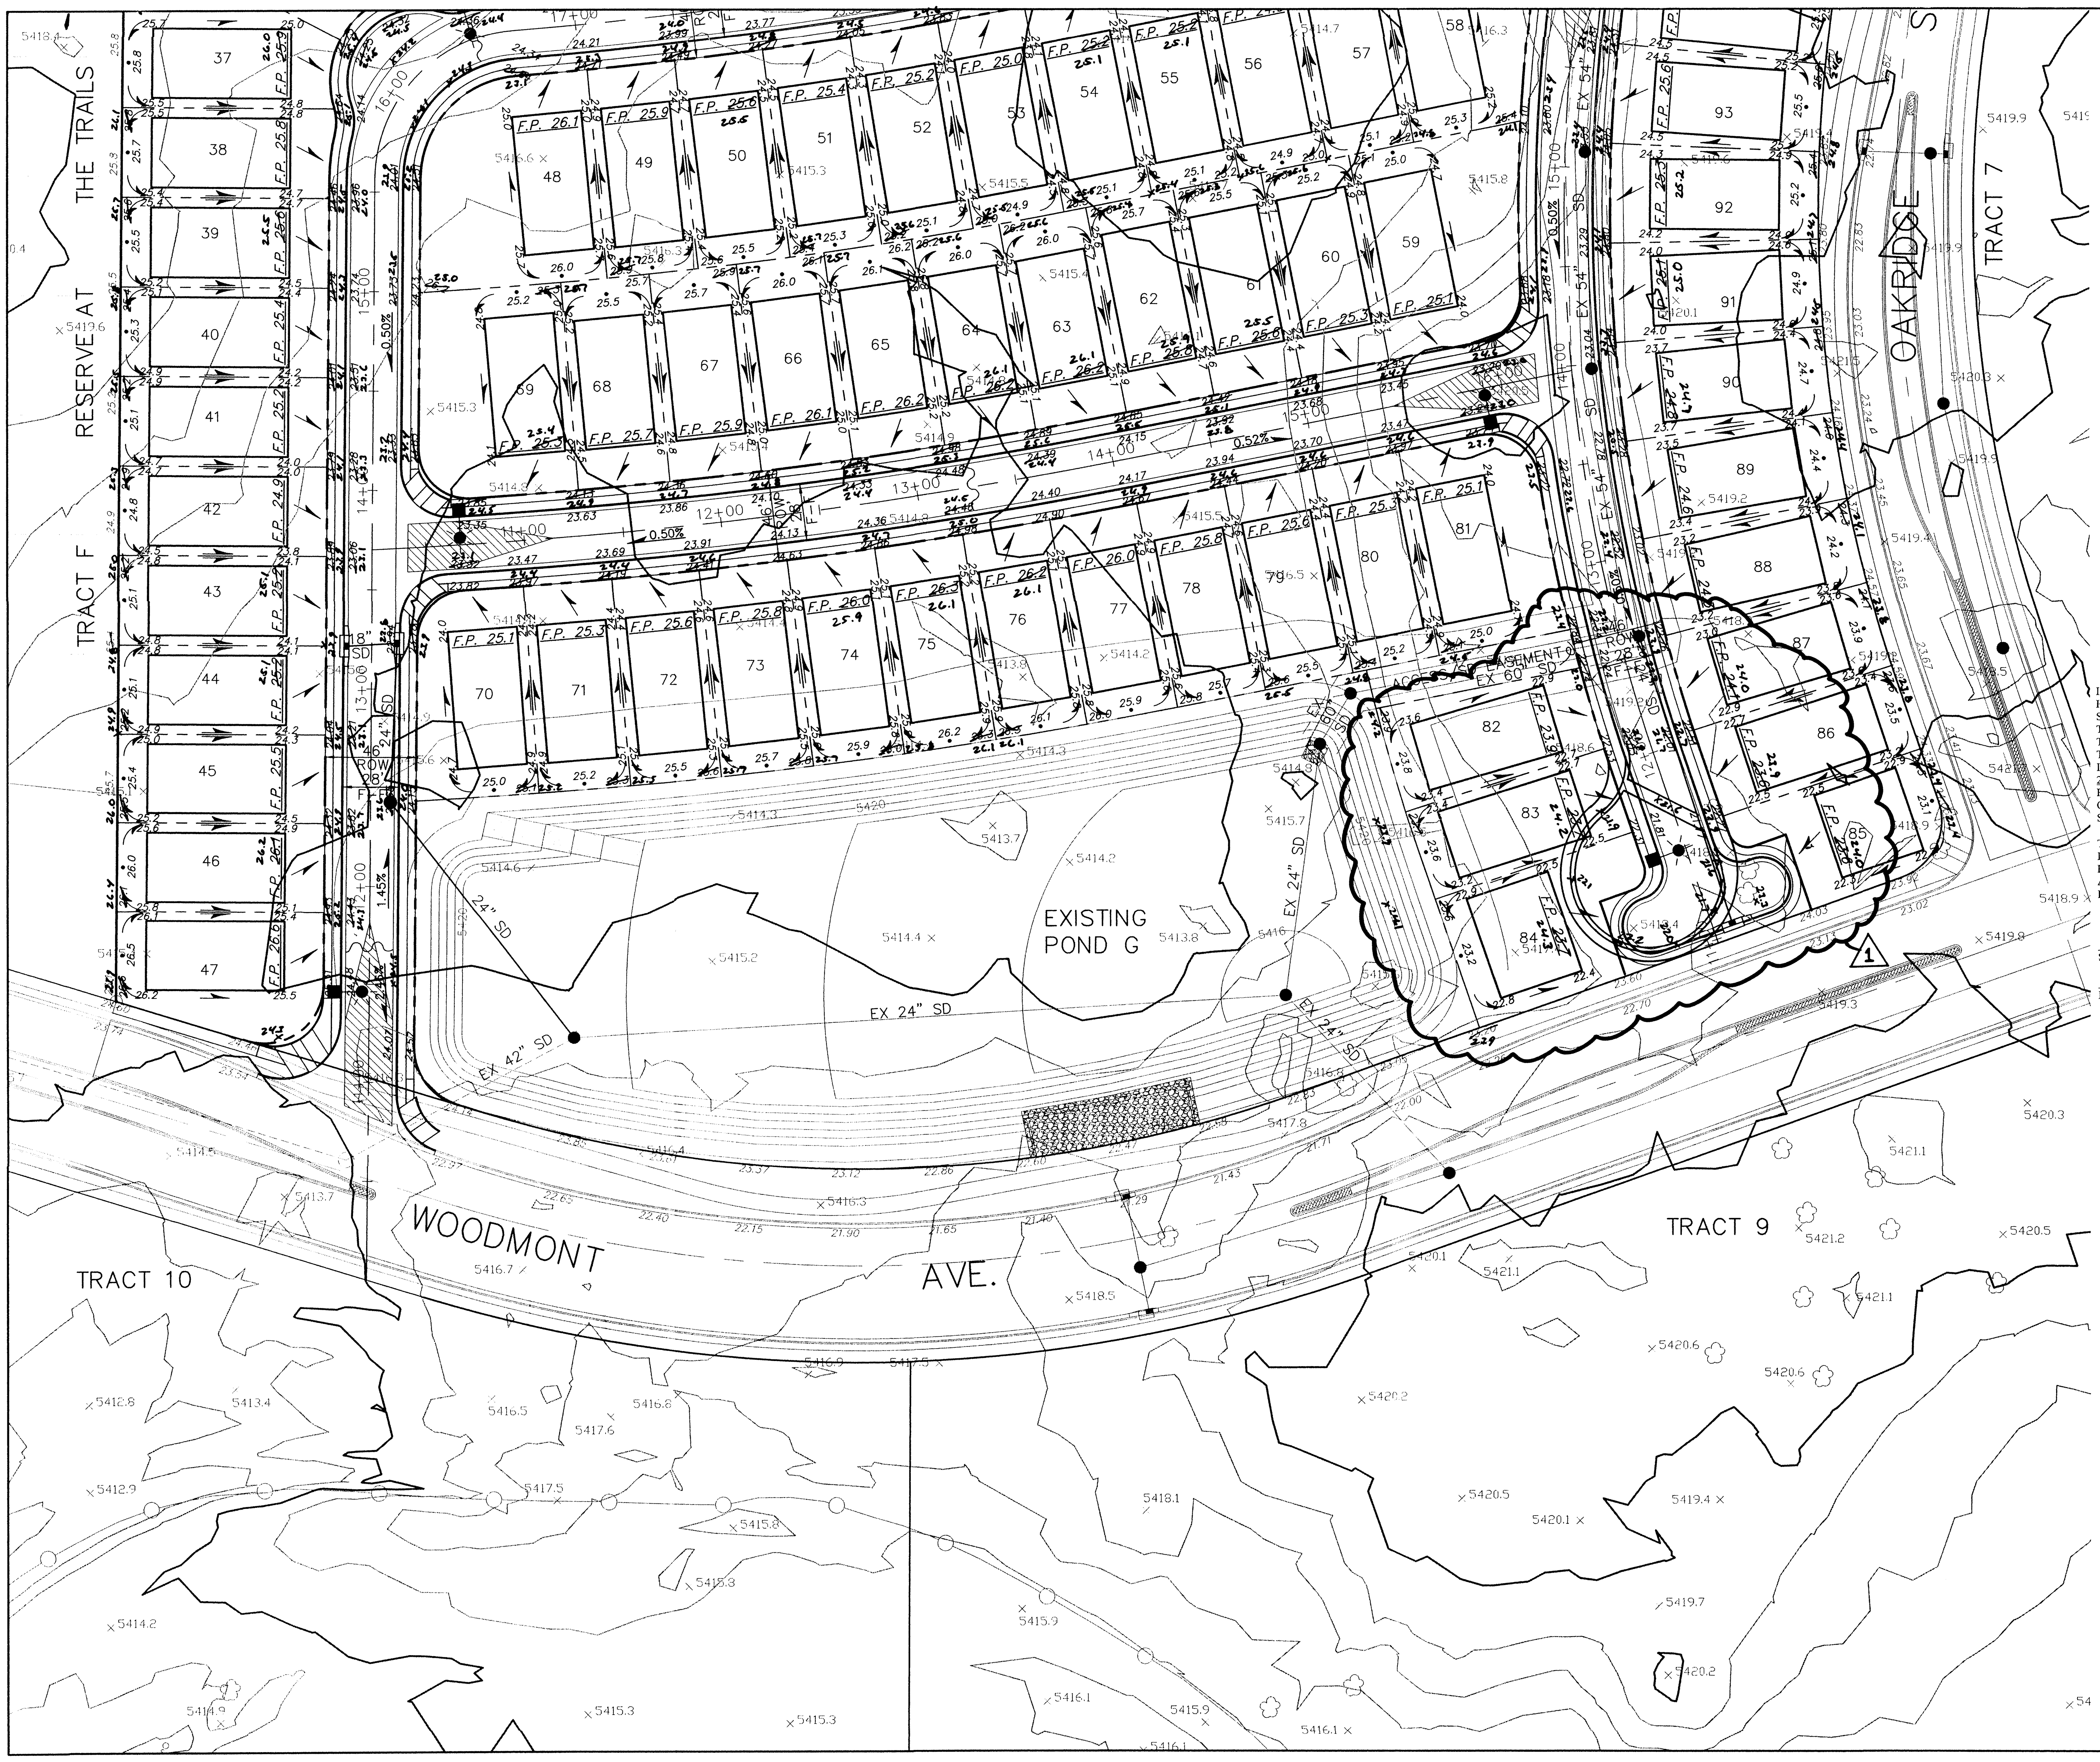
THE TRAILS
RESERVE AT
TRACT F
TRACT 7
TRACT 9
TRACT 10
OAKRIDGE
WOODMONT
AVE.
EXISTING
POND G
EX 42" SD
EX 24" SD
24" SD
EX 54" SD
EX 60"
37
38
39
40
41
42
43
44
45
46
47
48
49
50
51
52
53
54
55
56
57
58
59
60
61
62
63
64
65
66
67
68
69
70
71
72
73
74
75
76
77
78
79
80
81
82
83
84
85
86
87
88
89
90
91
92
93

LEGEND

▬ ▬ ▬ ▬	RETAINING WALL
∿∿∿	HIGH POINT
→	DIRECTION OF FLOW
• XX.XX	℄ LINE ELEVATION
▬▬▬	BASIN BOUNDARY
■	TYPE DOUBLE C INLET
(X–X)	RETAINING WALL POINT

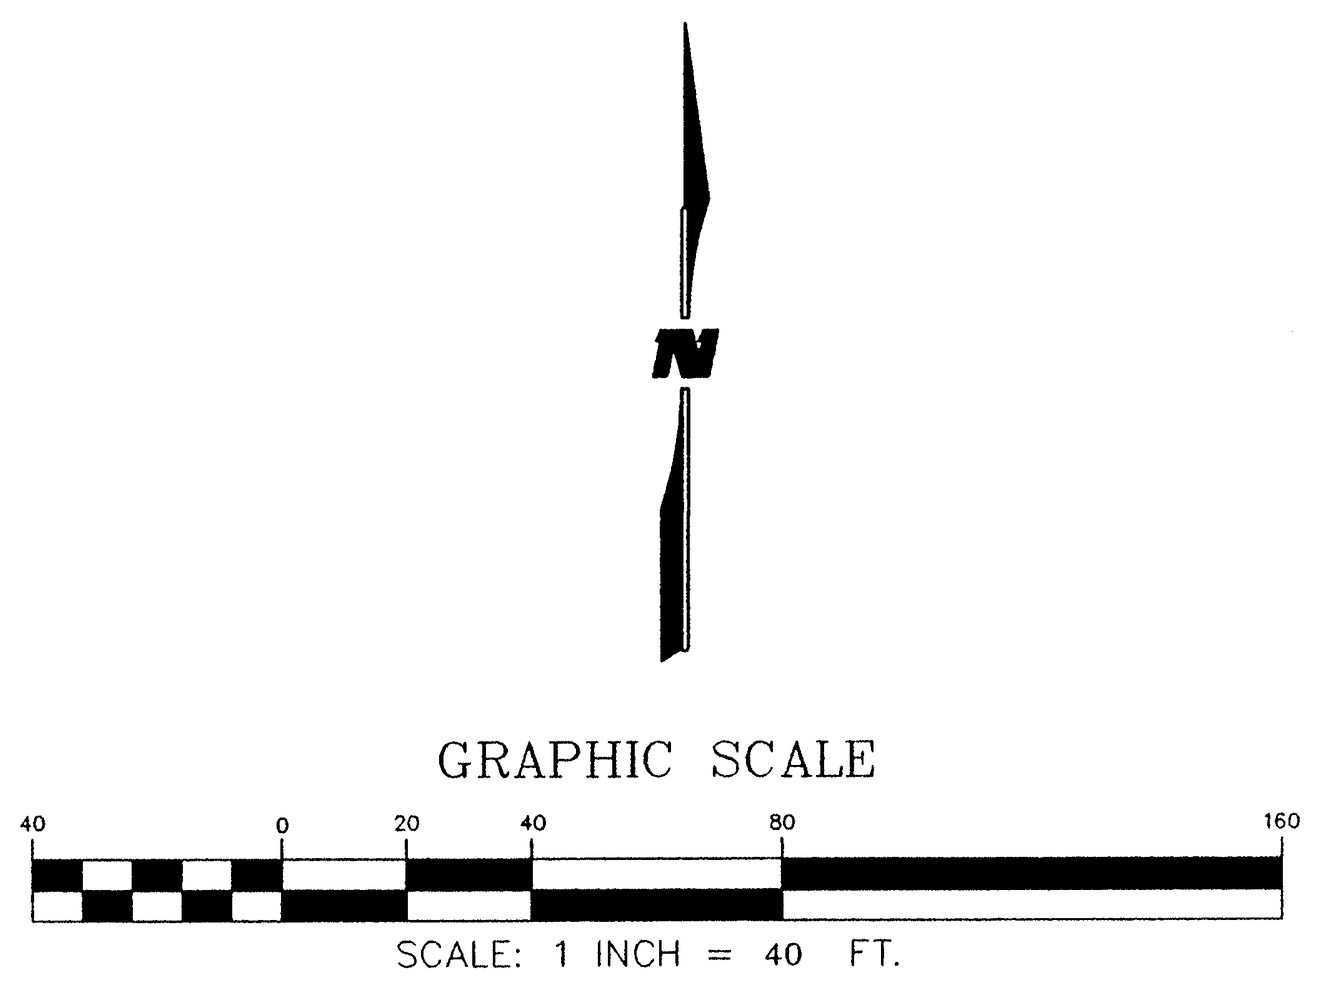
N
GRAPHIC SCALE
40
0
20
40
80
160
SCALE: 1 INCH = 40 FT.

DRAINAGE CERT W/ SURVEY WORK BY OTHERS
12/28/01

DRAINAGE CERTIFICATION

I, Steve J. Salazar , NMPE 16241 ,OF THE FIRM Wilson & Company, Inc. , HEREBY CERTIFY THAT THIS PROJECT HAS BEEN GRADED AND WILL DRAIN IN SUBSTANTIAL COMPLIANCE WITH AND IN ACCORDANCE WITH THE DESIGN INTENT OF THE APPROVED PLAN DATED 7-7-05 . THE RECORD INFORMATION EDITED ONTO THE ORIGINAL DESIGN DOCUMENT HAS BEEN OBTAINED BY Russ P. Hugg , NMPS 9750, OF THE FIRM Survtek.

I FURTHER CERTIFY THAT I HAVE PERSONALLY VISITED THE PROJECT SITE ON October 20, 2006 AND HAVE DETERMINED BY VISUAL INSPECTION THAT THE SURVEY DATA PROVIDED IS REPRESENTATIVE OF ACTUAL SITE CONDITIONS AND IS TRUE AND CORRECT TO THE BEST OF MY KNOWLEDGE AND BELIEF. THIS CERTIFICATION IS SUBMITTED IN SUPPORT OF A REQUEST FOR PERMANENT CERTIFICATE OF OCCUPANCY.

THE RECORD INFORMATION PRESENTED HEREON IS NOT NECESSARILY COMPLETE AND INTENDED ONLY TO VERIFY SUBSTANTIAL COMPLIANCE OF THE GRADING AND DRAINAGE ASPECTS OF THIS PROJECT. THOSE RELYING ON THIS RECORD DOCUMENT ARE ADVISED TO OBTAIN INDEPENDENT VERIFICATION OF ITS ACCURACY BEFORE USING IT FOR ANY OTHER PURPOSE.

Steve J. Salazar, NMPE 16241

DATE 10/25/06

16241

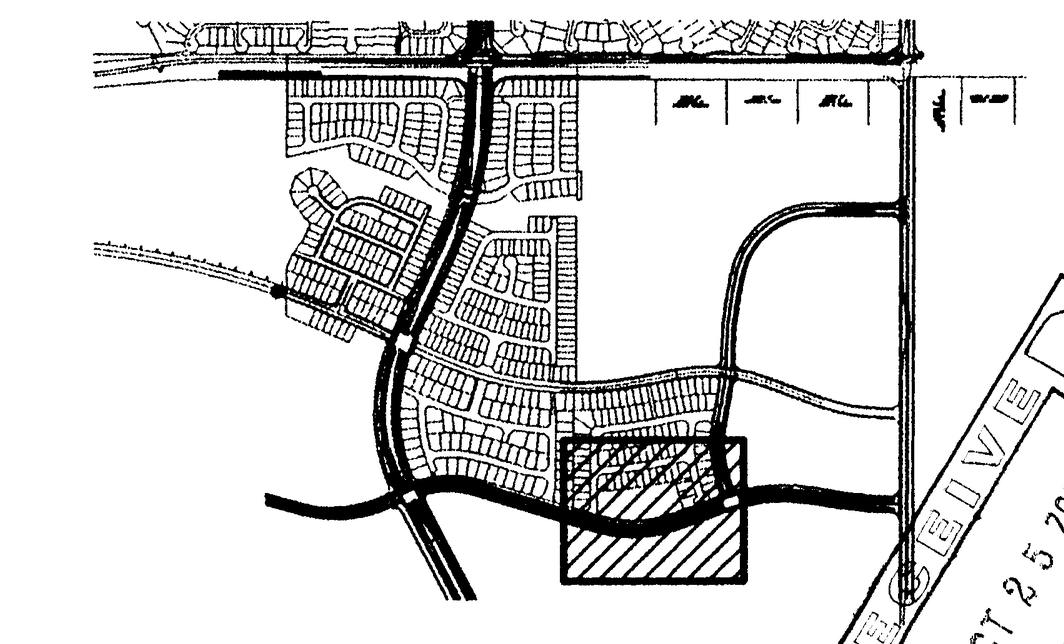

RECEIVED
OCT 25 2006
HYDROLOGY SECTION

WILSON & COMPANY
2600 THE AMERICAN ROAD S.E.
SUITE 100
RIO RANCHO, NEW MEXICO
87124
(505) 898-8021

CITY OF ALBUQUERQUE
PUBLIC WORKS DEPARTMENT
ENGINEERING GROUP

TRACT 6 OF THE TRAILS UNIT II
GRADING & DRAINAGE PLAN

Design Review Committee	City Engineer Approval	Last Design Update	Mo./Day/Yr.	Mo./Day/Yr.

City Project No.	Zone Map No.	Sheet Of
—	C-9-Z	PLATE 3B

AS-BUILT INFORMATION

CONTRACTOR	DATE
WORK STAKED BY	DATE
INSPECTOR'S ACCEPTANCE BY	DATE
FIELD VERIFICATION BY	DATE
DRAWINGS CORRECTED BY	DATE

MICRO-FILM INFORMATION

RECORDED BY	DATE
NO.	

BENCH MARKS

ACS BRASS TABLET STAMPED "2-B10 1980"
Geographic Position (NAD 1927)
N.M. State Plane Coordinates (Central Zone)
X= 357,543.73 Y= 1,527,976.48
Ground-to-Grid Factor = 0.99966354
Δα = -00°16'30"
SLD 1929 Elevation = 5429.35

SURVEY INFORMATION

FIELD NOTES

NO.	BY	DATE

ENGINEER'S SEAL

16241
S. J. SALAZAR

REVISIONS

NO.	DATE	REMARKS	BY
1	9-12-05	FIELD REVISION DUE TO DRC APPR.	

WILSON & COMPANY, ENGINEERS & ARCHITECTS

DESIGNED BY	DMD	DATE	JULY 05
DRAWN BY	DMD	DATE	JULY 05
CHECKED BY	SJS	DATE	JULY 05

T:\Projects\X5218064\M\sheets\GENERAL\XX-GD02.dwg 6/23/2005 4:49:55 PM MDT