HYDROLOGY

C18/D7

ONE PLAN

I PLAN FOR

LASERTECHNICS
INC. SITE
C18-D8

AF 22440A

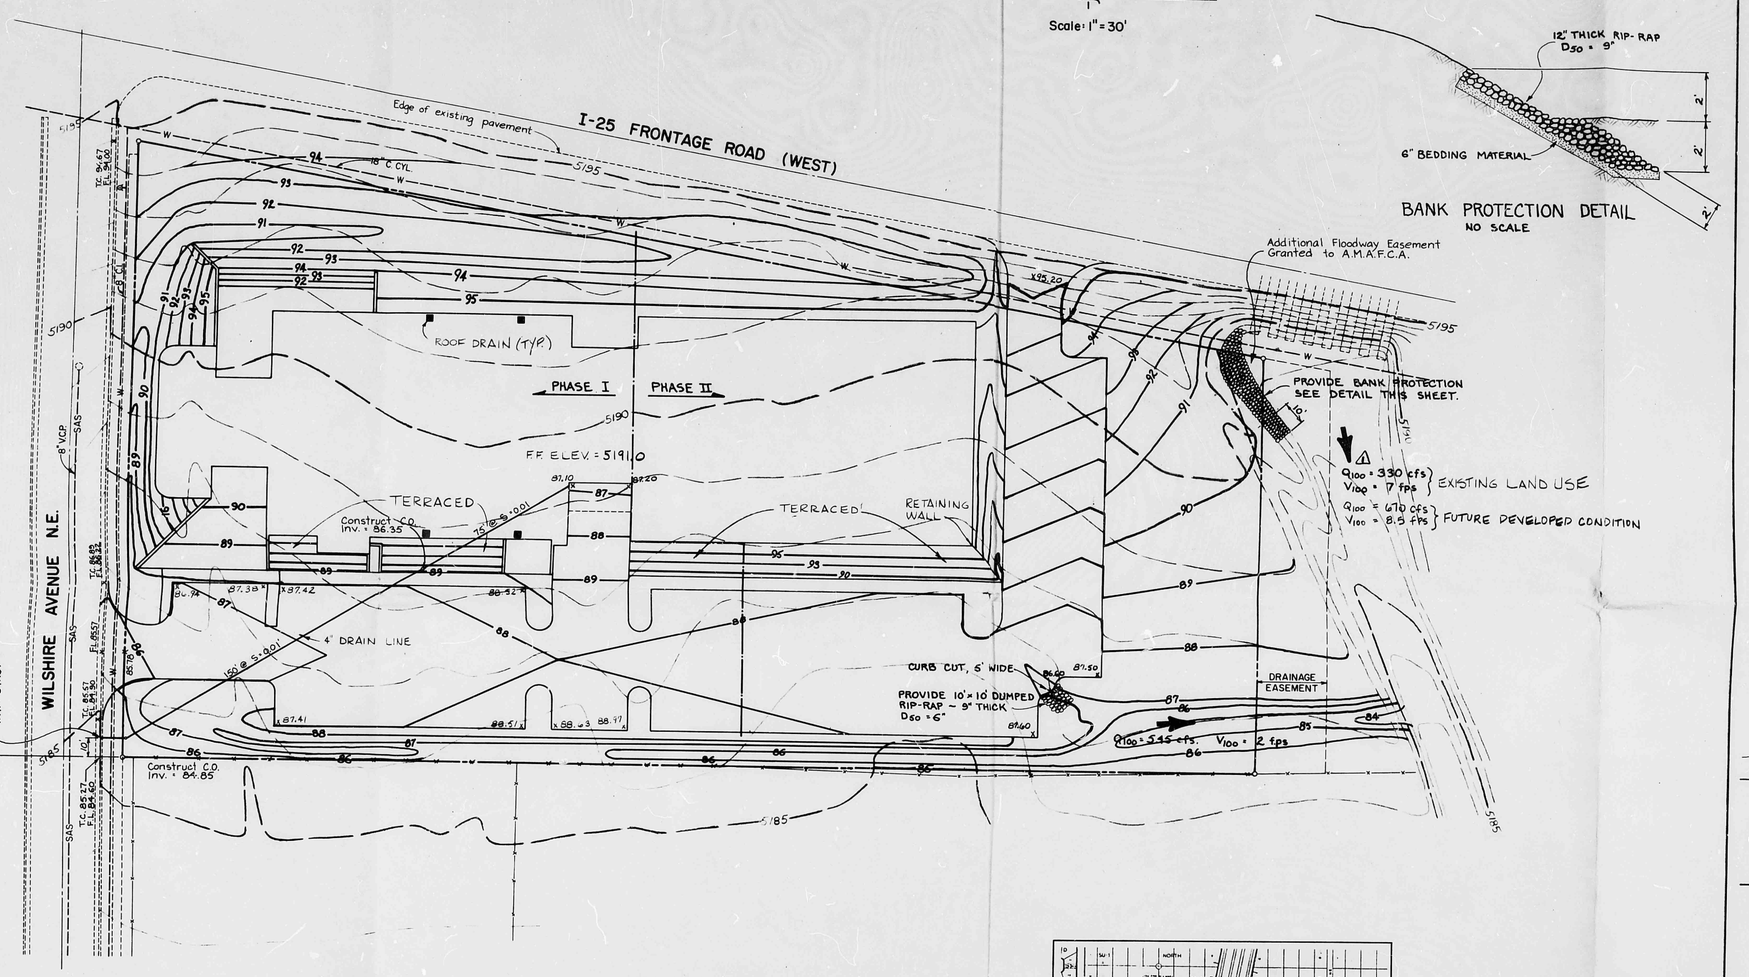

Notes:

1. This project is to be constructed in two phases. Phase I is scheduled to begin with the approval of this plan. Phase II will begin at a later date. Erosion control measures will be taken with Phase I construction in compliance with the approved erosion control plan.
2. Site grading will insure that all nuisance flows generated by landscape irrigation will be retained on-site.

— 85 — EXISTING CONTOUR
— 86 — PROPOSED CONTOUR
× PROPOSED SPOT ELEVATION
RIP RAP
Q_{100} / V_{100} 100 YR ~ 6 HR RUNOFF
PHASE DIVISION LINE

Approvals:

AMAFCA — Date

New Mexico State Highway Department — Date

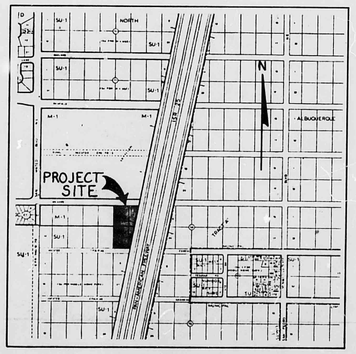

VICINITY MAP
APPROX. SCALE: 1" = 800'

SURVEY INFORMATION			BENCH MARKS	AS BUILT INFORMATION
FIELD NOTES			Square chisled in top of south curb line of Wilshire Ave. N.E., 165.00 feet west of northwest property corner of Tract 6, North Albuquerque Acres. Elevation: 5182.39	CONTRACTOR
NO.	BY	DATE		WORK STAKED BY
				INSPECTOR'S ACCEPTANCE BY — DATE
				AS-BUILT VERIFICATION BY — DATE
				DRAWINGS CORRECTED BY — DATE
				MICRO-FILM INFORMATION
				RECORDED BY — DATE
				NO.

ENGINEER'S SEAL

NO.	DATE	REMARKS	BY
1	9-14-83	REVISED ARROYO FLOW RATES & ADDED TBM DESCRIPTION	DAL

REVISIONS

DESIGNED BY R.C. DATE 8/12/83
DRAWN BY J.L. DATE 8/24/83
CHECKED BY DATE

CITY OF ALBUQUERQUE
MUNICIPAL DEVELOPMENT DEPARTMENT
ENGINEERING DIVISION

TITLE:
LASERTECHNICS - GRADING PLAN

APPROVALS	ENGINEER	DATE	APPROVALS	ENGINEER	DATE
City Engineer			Liquid Waste		
A.C.E. - Design			Traffic		
A.C.E. - Hydrology			Water		

DRAWING NO. — MAP NO. C-18 — SHEET OF

C18/D8