

CITY OF ALBUQUERQUE

Planning Department
Brennon Williams, Director



Mayor Timothy M. Keller

April 30, 2020

Verlyn Miller, P.E.
Miller Engineering Consultants, Inc
3500 Comanche NE Bldg. F
Albuquerque, NM 87107

RE: North Domingo BACA Multigenerational Center – Phase III
7521 Carmel Ave. NE
Permanent C.O. - Accepted
Engineer's Certification Date: 03/21/20
Engineer's Stamp Date: 05/17/18
Hydrology File: C19D043A

PO Box 1293

Dear Mr. Miller:

Albuquerque

Based on the Certification received 04/29/20 and site visit 4/30/20, this certification is approved in support of Permanent Release of Occupancy by Hydrology.

If you have any questions, please contact me at 924-3995 or rbrissette@cabq.gov.

NM 87103

Sincerely,

Renée C. Brissette

www.cabq.gov

Renée C. Brissette, P.E. CFM
Senior Engineer, Hydrology
Planning Department



City of Albuquerque

Planning Department
Development & Building Services Division

DRAINAGE AND TRANSPORTATION INFORMATION SHEET (REV 6/2018)

North Domingo Baca Multi-

Project Title: Generational Center - Phase III **Building Permit #:** _____ **Hydrology File #:** 619D043A
DRB#: _____ **EPC#:** _____ **Work Order#:** _____
Legal Description: Portions of Tract A, North Domingo Baca Park, Bernalillo Co., Book 2006C, Page 125, Doc. #2006055834
City Address: 7521 Carmel Ave. NE, Albuquerque, NM 87113

Applicant: Miller Engineering Consultants, Inc. **Contact:** Verlyn A. Miller
Address: 3500 Comanche NE, Bldg. F, Albuquerque, NM 87107
Phone#: 505-888-7500 **Fax#:** 505-888-3800 **E-mail:** vmiller@mecnm.com

Other Contact: Architect: Vigil & Associates **Contact:** David Madden
Address: 4477 Irving NW, Suite A, Albuquerque, NM 87114
Phone#: 505-890-5030 **Fax#:** 505-890-5031 **E-mail:** dave@va-architects.com

TYPE OF DEVELOPMENT: _____ PLAT (# of lots) _____ RESIDENCE _____ ☒ DRB SITE _____ ADMIN SITE

IS THIS A RESUBMITTAL? _____ Yes ☒ No

DEPARTMENT _____ TRANSPORTATION ☒ HYDROLOGY/DRAINAGE

Check all that Apply:

TYPE OF SUBMITTAL:

- ☒ ENGINEER/ARCHITECT CERTIFICATION
____ PAD CERTIFICATION
____ CONCEPTUAL G & D PLAN
____ GRADING PLAN
____ DRAINAGE REPORT
____ DRAINAGE MASTER PLAN
____ FLOODPLAIN DEVELOPMENT PERMIT APPLIC
____ ELEVATION CERTIFICATE
____ CLOMR/LOMR
____ TRAFFIC CIRCULATION LAYOUT (TCL)
____ TRAFFIC IMPACT STUDY (TIS)
____ STREET LIGHT LAYOUT
____ OTHER (SPECIFY) _____
____ PRE-DESIGN MEETING?

TYPE OF APPROVAL/ACCEPTANCE SOUGHT:

- ____ BUILDING PERMIT APPROVAL
☒ CERTIFICATE OF OCCUPANCY
____ PRELIMINARY PLAT APPROVAL
____ SITE PLAN FOR SUB'D APPROVAL
____ SITE PLAN FOR BLDG. PERMIT APPROVAL
____ FINAL PLAT APPROVAL
____ SIA/ RELEASE OF FINANCIAL GUARANTEE
____ FOUNDATION PERMIT APPROVAL
____ GRADING PERMIT APPROVAL
____ SO-19 APPROVAL
____ PAVING PERMIT APPROVAL
____ GRADING/ PAD CERTIFICATION
____ WORK ORDER APPROVAL
____ CLOMR/LOMR
____ FLOODPLAIN DEVELOPMENT PERMIT
____ OTHER (SPECIFY) _____

DATE SUBMITTED: 4/1/2020

By: _____

COA STAFF:

ELECTRONIC SUBMITTAL RECEIVED: _____

FEE PAID: _____

DETAILED GRADING AND DRAINAGE PLAN

SCALE: 1" = 30'


SEE GRADING AND DRAINAGE
SHEET C-104 FOR DETAILED
SPOT ELEVATIONS

SEE GRADING AND DRAINAGE
SHEET C-104 FOR DETAILED
SPOT ELEVATIONS

DRAINAGE CERTIFICATION
I, VERLYN A. MILLER, NMPE 14507, OF THE FIRM MILLER ENGINEERING CONSULTANTS, HEREBY CERTIFY THAT THIS PROJECT HAS BEEN GRADED AND WILL DRAIN IN SUBSTANTIAL COMPLIANCE WITH AND IN ACCORDANCE WITH THE DESIGN INTENT OF THE APPROVED CONSTRUCTION DRAWINGS DATED MARCH 27, 2020. THE RECORD INFORMATION EDITED ONTO THE ORIGINAL HAS BEEN OBTAINED BY THOMAS D. JOHNSTON, NMPS 14269 OF WAYJON SURVEYING. I FURTHER CERTIFY THAT I HAVE PERSONALLY VISITED THE PROJECT SITE ON MARCH 31, 2020 AND HAVE DETERMINED BY VISUAL INSPECTION THAT THE SURVEY DATA PROVIDED IS REPRESENTATIVE OF ACTUAL SITE CONDITIONS AND ARE TRUE AND CORRECT TO THE BEST OF MY KNOWLEDGE AND BELIEF. THIS CERTIFICATION IS SUBMITTED IN SUPPORT OF A REQUEST FOR A CERTIFICATE OF OCCUPANCY THE CITY OF ALBUQUERQUE.

THE RECORD INFORMATION PRESENTED HEREON IS NOT NECESSARILY COMPLETE AND INTENDED ONLY TO VERIFY SUBSTANTIAL COMPLIANCE OF THE CONSTRUCTION DRAWINGS OF THIS PROJECT. THOSE RELYING ON THIS RECORD DOCUMENT ARE ADVISED TO OBTAIN INDEPENDENT VERIFICATION OF ITS ACCURACY BEFORE USING IT FOR ANY OTHER PURPOSE.

VERLYN A. MILLER
NEW MEXICO
14507
DATE 3/31/2020

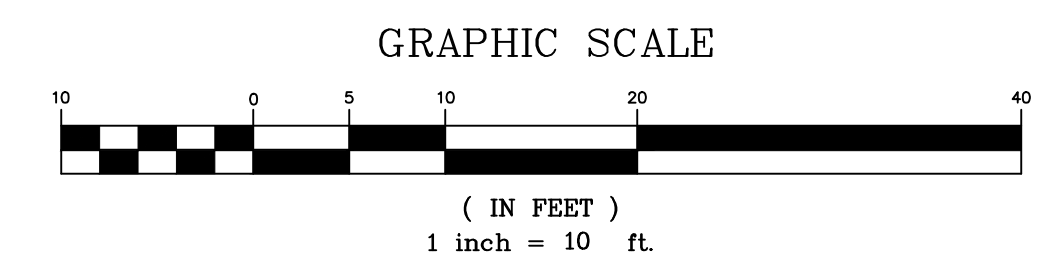

GENERAL SHEET NOTES

1. TWO WORKING DAYS PRIOR TO ANY EXCAVATION CONTRACTOR MUST CONTACT LINE LOCATING SERVICE 280-1990 FOR LOCATION OR EXISTING UTILITIES.
2. BACKFILL AND COMPACTION FOR SITEWORK SHALL BE ACCORDING TO THE GEOTECHNICAL REPORT FOR THE PROJECT.
3. MAINTENANCE OF THESE FACILITIES SHALL BE THE RESPONSIBILITY OF THE OWNER(S) OF THE PROPERTY SERVED.
4. NOT USED
5. THE CONTRACTOR SHALL FIELD VERIFY LOCATION AND SIZE OF ALL UTILITIES PRIOR TO CONSTRUCTION.
6. ALL DISTURBED AREAS SHALL RECEIVE LANDSCAPE FABRIC WITH SEEDING. SEE GENERAL NOTES.
7. CONTRACTOR SHALL FIELD VERIFY THE FINISH FLOOR ELEVATIONS ON THE EXISTING BUILDINGS AND NOTIFY THE PROJECT ENGINEER OF ANY DISCREPANCIES PRIOR TO CONSTRUCTION.
8. CONTRACTOR SHALL CONTACT THE PROJECT ENGINEER IF THERE IS A CONFLICT BETWEEN THE STORM DRAIN LINES ON THIS SHEET AND THE EXISTING UTILITIES SHOWN ON THIS SHEET. SO THAT THE PROPER ADJUSTMENTS CAN BE MADE PRIOR TO CONSTRUCTION.
9. FOR ALL STORM DRAIN SYSTEM AND CISTERN INFORMATION SEE THIS SHEET.
10. FOR ALL SEWER LINE INFORMATION SEE SHEET C-102.
11. FOR DETAILED SPOT ELEVATIONS AND DETAILED INFORMATION ON THE STORM SEWER SYSTEM SEE SHEET C-104.
12. ALL EXISTING UTILITIES WITH SURFACE FEATURES SHALL BE ADJUSTED TO GRADE AS SHOWN ON THE GRADING AND DRAINAGE SHEETS C-103 AND 104.
13. CONTRACTOR SHALL VERIFY ALL TOP OF WALL ELEVATIONS WITH THE ARCHITECTURAL DETAILS. IF THERE IS A DISCREPANCY THE CONTRACTOR SHALL NOTIFY THE PROJECT ARCHITECT IMMEDIATELY FOR A RESOLUTION TO THE DISCREPANCY.
14. AN AUTOCAD FILE WILL BE AVAILABLE TO THE CONSTRUCTION SURVEYOR TO LOCATE ALL CIVIL RELATED ITEMS HORIZONTALLY.
15. FOR LOCATION OF PROPOSED GAS LINE SEE MECHANICAL SITE PLAN.

SHEET KEYNOTES

1. NEW EARTHENED SWALE. IF LONGITUDINAL SLOPE EXCEEDS 3% PLACE CLASS B RIP RAP (LOOSE). SEE SHEET C-502 FOR DETAILS.
2. NEW RETAINING WALL SYSTEM. SEE STRUCTURAL PLANS FOR DETAILS.
3. EXISTING SIDEWALK TO REMAIN.
4. EXISTING BUILDINGS TO REMAIN.
5. NEW BUILDING SEE ARCHITECTURAL PLANS FOR DETAILS.
6. EXISTING ASPHALT SURFACE TO REMAIN.
7. NEW WATER HARVEST AREA. TOP = 73.0. INV. = 70.00. SEE SHT. C-502 FOR DETAIL.
8. NEW 18" STORM DRAIN PIPE. SLOPE=1% MIN.
9. NEW NYLOPLAST 18" DRAIN BASIN. SEE DETAIL SHEET C-501.
10. NEW AMPHITHEATER. SEE ARCHITECTURAL PLANS FOR DETAILS.
11. NEW CONCRETE FLATWORK. SEE ARCHITECTURAL PLANS FOR DETAILS. SEE AS-103 FOR JOINT PATTERN.
12. NEW LOOSE RIP RAP (CLASS B) RUNDOWN. SEE SHT. C-502 FOR DETAIL.
13. SAWCUT EXISTING CONCRETE TO CLEAN STRAIGHT EDGE AND MATCH EXISTING CONCRETE.
14. NOT USED.
15. NEW 12" NYLOPLAST INLINE DRAIN WITH CONCRETE COLLAR AND SPLASH BLOCK. (ADA COMPLIANT GRATE) SEE D3/C502 FOR DETAIL.
16. CONTRACTOR SHALL FIELD VERIFY LOCATION OF DOWNSPOUT PRIOR TO CONSTRUCTION. SEE DETAIL SHEETS C-501 AND C-503.
17. NEW 24" NYLOPLAST DRAIN BASIN WITH SOLID COVER. CONNECT NEW 18" STORM DRAIN PIPE TO EXISTING 18" STORM DRAIN PIPE. SEE DETAIL SHEET 501.
18. NEW BENCH WITH CONCRETE FLAT WORK. SEE LANDSCAPING PLANS FOR DETAILS.
19. NEW SYNTHETIC TURF. SEE ARCHITECTURAL PLANS FOR DETAILS.
20. NEW HANDICAP RAMP WITH HAND RAILS. SEE ARCHITECTURAL PLANS FOR DETAILS.
21. WHEN CROSSING NEW RETAINING WALL SYSTEM WITH STORM DRAIN PIPE, THE CONTRACTOR SHALL PLACE NEW STORM DRAIN PIPE 8" MINIMUM FROM THE BOTTOM OF THE PROPOSED FOOTING ON THE NEW RETAINING WALL.
22. CONNECT NEW ROOF DRAIN PIPE TO NEW 6" STORM DRAIN PIPE (INV. = 2' BELOW FG).
23. INSTALL NEW 6" STORM DRAIN PIPE TO PROVIDE CONNECTION TO STORM DRAIN MAIN LINE. SEE MECHANICAL SHEETS FOR EXACT LOCATION OF ROOF DRAINS AND FOR PIPE SIZES. ALL APPURTENANCES (INCLUDING BENDS, TEE, WYVES, COUPLERS, ETC.) REQUIRED FOR CONNECTION AND TO MEET THE 18" MINIMUM DEPTH BELOW NEW FOOTING ON RETAIN WALL SHALL BE CONSIDERED INCIDENTAL TO 6" STORM DRAIN PIPING ITEM.
24. NEW 6" STORM DRAIN PIPE. SLOPE=1% MIN.
25. 8" x 6" x 6" STORM DRAIN TEE.
26. 6" x 6" x 90" STORM DRAIN BEND WITH DOUBLE CLEAN OUTS.
27. NEW STAIRS WITH WALLS AND HAND RAILS. SEE ARCHITECTURAL PLANS FOR DETAILS.
28. NEW 12" STORM DRAIN PIPE. SLOPE=1% MIN.
29. 18" x 12" x 18" STORM DRAIN TEE.
30. 18" x 18" x 45" STORM DRAIN BEND.
31. NEW 18" NYLOPLAST INLINE DRAIN (ADA COMPLIANT GRATE) SEE DETAIL SHEET C-501.
32. NOT USED.
33. NEW 12" DRAINAGE SIDEWALK CULVERT WITH STEEL PLATE AS PER COA STANDARD DRAWING 2236. NEW 12" x 6" WEEP HOLE IN WALL. MATCH INVERT OF SIDEWALK CULVERT WITH BOTTOM OF NEW WEEP HOLE.
34. 8" x 6" x 45" STORM DRAIN BEND.
35. CONNECT NEW 6" STORM DRAIN PIPE TO EXISTING 6" STORM DRAIN PIPE WITH 6"X8" STORM DRAIN TEE. CONTRACTOR SHALL LOCATE AND FIELD VERIFY EXISTING STORM DRAIN LOCATION AND ELEVATION PRIOR TO CONSTRUCTION. IF THERE ARE ANY ISSUES WITH ELEVATIONS AND GRAVITY FLOW FROM THE ROOF DRAINS, THE CONTRACTOR SHALL IMMEDIATELY NOTIFY THE PROJECT ENGINEER.
36. EXISTING 6" STORM DRAIN PIPE TO REMAIN.
37. MATCH TOP OF NEW CONCRETE ELEVATION WITH EXISTING TOP OF CONCRETE ELEVATION.
38. EXISTING STORM DRAIN INLET TO REMAIN. CLEAN AND REPAIR EXISTING STORM DRAIN INLET AS NECESSARY. ADJUST TOP OF GRATE TO BELOW NEW GRADE. ELEVATION AND CHANGE GRATE TO SOLID COVER. CONTRACTOR TO COORDINATE WITH CITY PROJECT MANAGER PRIOR TO CONSTRUCTION.
39. NOT USED.
40. NEW STAND UP PIPE OUTFLOW DEVICE DETAIL. SEE DETAIL SHEET C-503.
41. NEW EDCONRAIN SERIES #12 TRENCH SYSTEM WITH A SQUARE BOTTOM INVERT AND ADA COMPLIANT GRATE OR APPROVED EQUAL. THE CONTRACTOR SHALL PROVIDE A SHOP DRAWING SUBMITTAL TO THE ARCHITECT AND ENGINEER FOR REVIEW AND APPROVAL 5 DAYS PRIOR TO THE BID OPENING.
42. NEW EDCONRAIN SERIES #12 12" CATCH BASIN WITH A SQUARE BOTTOM INVERT AND ADA COMPLIANT GRATE OR APPROVED EQUAL. THE CONTRACTOR SHALL PROVIDE A SHOP DRAWING SUBMITTAL TO THE ARCHITECT AND ENGINEER FOR REVIEW AND APPROVAL 5 DAYS PRIOR TO THE BID OPENING.
43. NEW 24" DRAINAGE SIDEWALK CULVERT WITH STEEL PLATE AS PER COA STANDARD DRAWING 2236.
44. CONTRACTOR SHALL CLEAN EXISTING STORM DRAIN PIPING OF DEBRIS, FROM THE INLET ON THE WEST SIDE OF THE SERVICE ENTRANCE TO THE INLET ON THE WEST SIDE OF THE ENTRANCE TO THE EXISTING PARKING LOT.
45. 12" x 12" x 12" STORM DRAIN PIPE TEE.
46. 44" 6" x 11.5" STORM DRAIN BEND WITH DOUBLE CLEAN OUTS.
47. 18" x 12" x 18" STORM DRAIN PIPE TEE.
48. RELOCATE EXISTING ELECTRICAL LINE AS NECESSARY TO CONSTRUCT THE POND. THE RELOCATION OF THE EXISTING ELECTRICAL LINE SHALL MEET CODE FOR COVER.
49. RELOCATE EXISTING IRRIGATION BOXES AND LINES AS NECESSARY TO CONSTRUCT THE POND. THE RELOCATION OF THE EXISTING IRRIGATION LINE SHALL MEET CODE FOR COVER.
50. LOWER EXISTING NON POTABLE WATER AS NECESSARY TO CONSTRUCT THE POND. THE RELOCATION OF THE EXISTING NON POTABLE WATER LINE SHALL MEET CODE FOR COVER.
51. RELOCATE EXISTING ELECTRICAL BOX OUT OF THE PONDING AREA.
52. NEW CLASS B (LOOSE) RIP RAP RUNDOWN. SEE DETAIL SHEET C-502.
53. NEW ROOF DRAIN AND CLASS B (LOOSE) RIP RAP PAD. SEE DETAIL SHEET C-504.
54. EXISTING HDPE GROUND SOURCE WATER PIPING TO REMAIN UNDISTURBED DURING ALL CONSTRUCTION ACTIVITIES INCLUDING OVER EXCAVATION AND EXCAVATION FOR BUILDING AND RETAINING WALL FOUNDATIONS. CONTRACTOR SHALL PROVIDE FOR SUBSURFACE UTILITY ENGINEERING COMPANY TO VERIFY PIPE LOCATION AND PIPE DEPTH PRIOR TO CONSTRUCTION.
55. PLAYGROUND EQUIPMENT AND STRUCTURES. SEE STRUCTURAL SHEETS FOR FOUNDATION AND INSPECTION REQUIREMENTS. SEE PLAN AAAS-103 FOR PLAN AND SHEET AS-503 FOR DETAILS.

AS-BUILT INFORMATION	








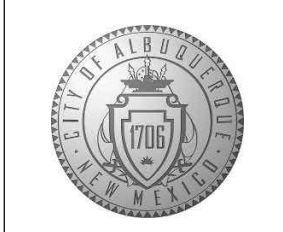


MILLER ENGINEERING CONSULTANTS
Engineers • Planners
3500 COMANCHE, NE
ALBUQUERQUE, NM 87107
WWW.MECNM.COM

CITY OF ALBUQUERQUE
CAPITAL IMPLEMENTATION PROGRAM

NORTH DOMINGO BACA MULTIGENERATIONAL CENTER - PHASE III
7521 CARMEL AVE. NE, ALBUQUERQUE, NM 87113

DETAILED GRADING AND DRAINAGE PLAN

Design Review Committee	City Engineer Approval	Mo./Day/Yr.	Mo./Day/Yr.
City Project No.	Zone Map No.	Sheet	
	L-13-Z		

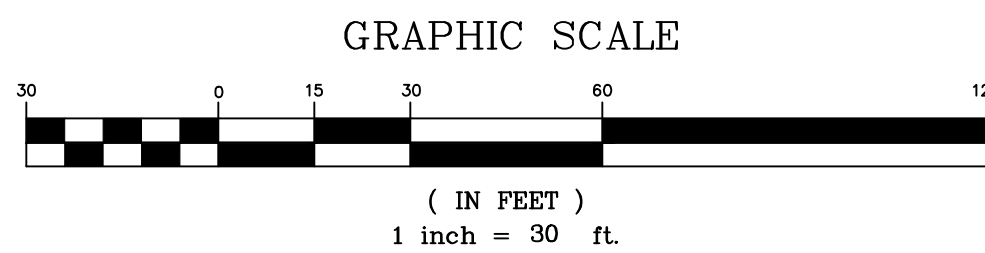


THE RECORD INFORMATION PRESENTED HEREON IS NOT NECESSARILY COMPLETE AND INTENDED ONLY TO VERIFY SUBSTANTIAL COMPLIANCE OF THE CONSTRUCTION DRAWINGS OF THIS PROJECT. THOSE RELYING ON THIS RECORD DOCUMENT ARE ADVISED TO OBTAIN INDEPENDENT VERIFICATION OF ITS ACCURACY BEFORE USING IT FOR ANY OTHER PURPOSE.

LEGEND

1. TWO WORKING DAYS PRIOR TO ANY EXCAVATION CONTRACTOR MUST CONTACT LINE LOCATING SERVICE 260-1990 FOR LOCATION OR EXISTING UTILITIES.
2. BACKFILL AND COMPACTION FOR SITEWORK SHALL BE ACCORDING TO THE GEOTECHNICAL REPORT FOR THE PROJECT.
3. MAINTENANCE OF THESE FACILITIES SHALL BE THE RESPONSIBILITY OF THE OWNER/S/O OF THE PROPERTY SERVED.
4. NOT USED
5. MAINTENANCE CONTRACTOR SHALL FIELD VERIFY LOCATION AND SIZE OF ALL UTILITIES PRIOR TO CONSTRUCTION.
6. ALL DISTURBED AREAS SHALL RECEIVE LANDSCAPE FABRIC WITH SEEDING, SOD, OR GRASS.
7. CONTRACTOR SHALL FIELD VERIFY THE FINISH FLOOR ELEVATIONS ON THE EXISTING BUILDINGS AND NOTIFY THE PROJECT ENGINEER OF ANY DISCREPANCIES PRIOR TO CONSTRUCTION.
8. CONTRACTOR SHALL CONTACT THE PROJECT ENGINEER IF THERE IS A CONFLICT BETWEEN THE STORM DRAIN LINES AND EXISTING UTILITIES, SO THAT THE PROBLEM CAN BE MADE PRIOR TO CONSTRUCTION.
9. FOR ALL STORM DRAIN SYSTEM INFORMATION SEE SHEET C-102.
10. FOR ADDITIONAL SITE KEYNOTES AND SPOT ELEVATIONS SEE SHT. 100 AND C104.

- | | | |
|---|---|--|
|  | GAS METER | |
|  | GAS VALVE | |
|  | TRENCH CABINET | |
|  | TELEPHONE MANHOLE | |
|  | CABLE MANHOLE | |
|  | CABLE CABINET | |
|  | WATER VALVE | |
|  | WATER METER | |
|  | FIRE HYDRANT | |
|  | WELL HEAD | |
|  | WATER MANHOLE | |
|  | FLAGPOLE | |
|  | ROAD DRAIN | |
|  | MAILBOX | |
|  | SANITARY SEWER MANHOLE |  |
|  | SAS CLEANOUT |  DECIDUOUS TREE |
|  | SPRINKLER |  SHRUB |
|  | IRRIGATION BOX | |
|  | STORM DRAIN MANHOLE | |
|  | STORM DRAIN INLET | |
|  | IRRIGATION VALVE | |
|  | SIGN | |
|  | CURB CUT/INDICATION OF ACCESS
TO ROADWAY | |
|  | CRAWL SPACE | |
| 5075.50 | SPOT ELEVATION | |
| BC 5075.50 | BACK OF CURB ELEVATION | |
| FL 5075.50 | FLOW LINE ELEVATION | |
| FP 5075.50 | EDGE OF PAVEMENT ELEVATION | |
| TA 5075.50 | TOP OF ASPHALT ELEVATION | |
| TC 5075.50 | TOP OF CONCRETE ELEVATION | |
| TW 5075.50 | ELEVATION ON HIGH SIDE OF WALL | |

CENTER - PHASE III 7113		
GE PLAN		
Last Design Update	Mo./Day/Yr.	Mo./Day/Yr.
Sheet	C-101	

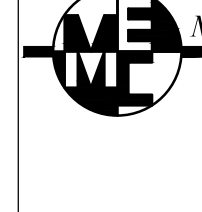

MILLER ENGINEERING CONSULTANTS
Engineers • Planners
3500 COMANCHE, NE
BUILDING F
ALBUQUERQUE, NM 87107
(505) 888-7500
(505) 888-3800 (FAX)
WWW.MECNM.COM

CITY OF ALBUQUERQUE
CAPITAL IMPLEMENTATION PROGRAM

NORTH DOMINGO BACA MULTIGENERATIONAL CENTER - PHASE III
7521 CARMEL AVE. NE ALBUQUERQUE, NM 87113

OVERALL GRADING AND DRAINAGE PLAN

Design Review Committee

City Engineer Approval


	Mo./Day/Yr.	Mo./Day/Yr.
--	-------------	-------------

City Project No. _____

Zone Map No	
-------------	--

Shee

C-101

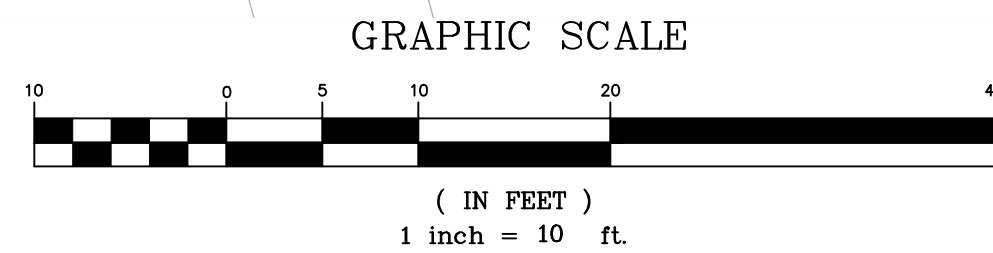


VERLYN A. MILLER
NEW MEXICO
DATE 3/31/2020

LEGEND


REVISIONS		BY
		SE
		SE
		SE
		SE

DESIGN	
Designed By:	Date:
Drawn By:	Date:
Checked By:	Date:

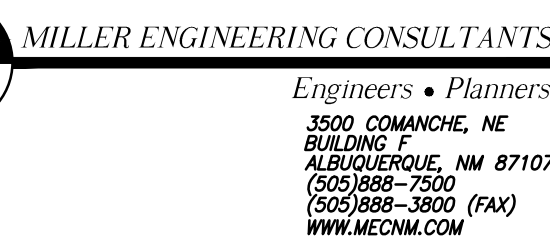

Design Review Committee	City Engineer Approval	Last Design Update	Mo./Day/Yr.	Mo./Day/Yr.
City Project No.	Zone Map No.	Sheet	C-103	

SCALE: 1" = 30'

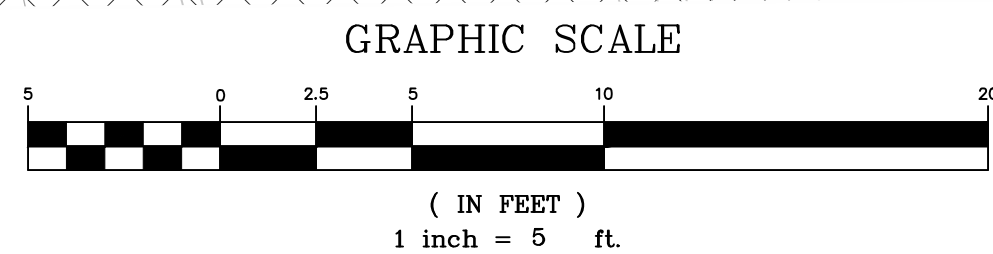

SCALE: 1" = 30'



SCALE: 1" = 30'

LEGEND

 **MILLER ENGINEERING CONSULTANTS**
Engineers • Planners
3500 COMANCHE, NE
BUILDING F
ALBUQUERQUE, NM 87107
(505) 888-7500
(505) 888-3800 (FAX)
WWW.MECNM.COM

Sheet

C-104