PUBLIC WORKS/HYDROLOGY

C22/D20

U.C.L.S. LOG NO. 90111415190232

TRACT A
PRINCE OF PEACE CHURCH

(BEING A REPLAT OF LOTS 2, 3, 31, AND PORTIONS OF LOTS 1, 4 AND 32, BLOCK 17, TRACT 2, UNIT 1, NORTH ALBUQUERQUE ACRES)

BERNALILLO COUNTY, NEW MEXICO

OCTOBER 1990

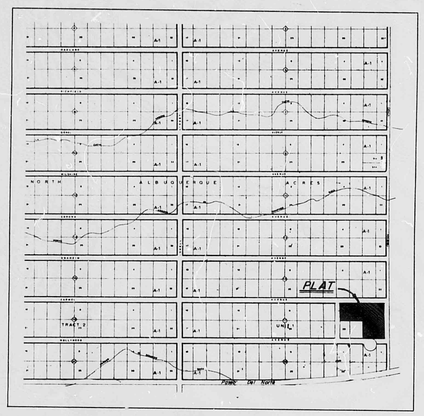

VICINITY MAP
N. T. S.

GENERAL NOTES

1. Bearings are grid and based on the New Mexico State Plane Coordinate System, Central Zone, and rotated to grid at the Albuquerque City Survey Monument "1-D23".
2. Distances are ground.
3. Distances along curved lines are arc lengths.
4. Delta Alpha = -00° 08' 29"
5. Combined ground to grid factor = 0.9996160
6. All corners are a 5/8" rebar and survcap stamped "HUGG LS 5823" unless otherwise indicated.
7. Zone Atlas Page C-22.
8. Information shown in parenthesis () is record.

ACKNOWLEDGEMENT

STATE OF NEW MEXICO
COUNTY OF BERNALILLO ss

On this 26th day of November, 1990 before me the undersigned, a Notary Public, personally appeared John A.Huchmala, to me known to be Property Manager of the Roman Catholic Church, Archdiocese of Santa Fe, a Corporation Sole, who acknowledged to me that he signed and sealed the accompanying instrument as his free and voluntary act and deed and that he is so authorized to act.

Margarita E Mess
Notary Public

DECLARATION

The purpose of this replat is to combine the lots and portions of lots remaining after portions were taken for right of way for the Pasec Del Norte/Tramway Boulevard Project by Bernalillo County into one tract.

LEGAL DESCRIPTION

That certain parcel of land situate within projected Section 15, Township 11 North, Range 4 East, New Mexico Principal Meridian, Elena Gallegos Grant, Bernalillo County, New Mexico, comprising Lots One (1), Two (2), Three (3), Four (4), Thirty one (31) and Thirty two (32), Block Seventeen (17), Tract 2, Unit 1, North Albuquerque Acres, as the same are shown and designated on the plat entitled "TRACT 2 UNIT 1, NORTH ALBUQUERQUE ACRES, ALBUQUERQUE, BERNALILLO COUNTY, NEW MEXICO", filed in the office of the County Clerk of Bernalillo County, New Mexico, on March 23, 1931, in Volume D, folio 130, EXCEPT that portion of said Lots One (1), Four (4) and Thirty two (32) conveyed to the County of Bernalillo for street right of way by Warranty Deeds filed in the office of the County Clerk of Bernalillo County, New Mexico, on October 25, 1990, in Volume 90-17, pages 4902, 4903 and 4904, more particularly described as follows:

BEGINNING at the Southeast corner of the parcel herein described, the intersection of the Northerly right of way line of Hollywood Avenue N. E. with the New Westerly right of way line of Tennyson Street N. E. (a 5/8" rebar and survcap stamped "LS 7924" found in place), whence the Albuquerque City Survey Monument "1-D23" bears S 12° 27' 18" E, 3475.73 feet distant; Thence,

N 89° 40' 18" W, 235.71 feet along said Northerly right of way line of Hollywood Avenue N. E. and the Southerly line of Lots 32 and 31 to the Southwest corner of said Lot 32 (a 5/8" rebar and survcap stamped "LS 7924" found in place); Thence,

N 00° 05' 10" E, 234.00 feet to the corner common to Lots 2, 3, 30 and 31 (a 5/8" rebar and survcap stamped "HUGG LS 5823" set;) Thence,

N 89° 38' 27" W, 269.58 feet along the Southerly line of said Lots 3 and 4 to a point on the Easterly right of way line of a Public Road (a 5/8" rebar and survcap stamped "LS 7924" found in place); Thence,

N 00° 11' 10" E, 208.02 feet along said Easterly right of way line of a Public Road to a point (a 5/8" rebar and survcap stamped "LS 7924" found in place); Thence,

N 45° 06' 30" E, 35.31 feet along said Easterly right of way line of a Public Road to the Northwest corner of the parcel herein described, a point on the Southerly right of way line of Carmel Avenue N. E. and the Northerly line of said Lot 4 (a 5/8" rebar and survcap stamped "LS 7924" found in place); Thence,

S 89° 44' 17" E, 480.44 feet along said Southerly right of way line of Carmel Avenue N. E. and the Northerly line of said Lots 4, 3, 2 and 1 to an intersection with said new Westerly right of way line of Tennyson Street N. E. and the Northeast corner of the parcel herein described (a 5/1" rebar and survcap stamped "LS 7924" found in place); Thence,

S 00° 08' 46" W, 467.78 feet along said new Westerly right of way line of Tennyson Street N. E. to the Southeast corner and point of beginning of the parcel herein described.

Said parcel contains 3.9686 acres, more or less.

SURVEYED and REPLATTED and now comprising TRACT A, PRINCE OF PEACE CHURCH (BEING A REPLAT OF LOTS 2, 3, 31, AND PORTIONS OF LOTS 1, 4 AND 32, BLOCK 17, TRACT 2, UNIT 1, NORTH ALBUQUERQUE ACRES), BERNALILLO COUNTY, NEW MEXICO, with free consent of and in accordance with the wishes and desires of the undersigned owner(s) and proprietor(s) thereof. Said owner(s) and proprietor(s) do hereby consent to all of the foregoing, grant all easements shown hereon to the use of the public forever and do hereby acknowledge that they are so authorized to act.

THE ROMAN CATHOLIC CHURCH, ARCHDIOCESE OF SANTA FE
A Corporation Sole

John A. Huchmala
John A. Huchmala, Property Manager

APPROVALS

Traffic Engineer, City of Albuquerque Public Works Department	Date
Nial Chat	11-28-90
City Surveyor, City of Albuquerque Public Works Department	Date
Utility Development Division, City of Albuquerque Public Works Department	Date
Albuquerque Metropolitan Arroyo Flood Control Authority	Date
City Engineer, City of Albuquerque Public Works Department	Date
Property Management, City of Albuquerque	Date
Parks and Recreation Department, City of Albuquerque	Date

APPROVAL as specified by the Albuquerque Subdivision Ordinance.

Chairman, Albuquerque/Bernalillo County Development Review Board	Date
DRB 90-408	

SURVEYORS CERTIFICATION

I, Garry P. Hugg, New Mexico Professional Surveyor Number 5823, hereby certify that this plat of survey was prepared from field notes of an actual ground survey performed by me or under my supervision; that it meets the Standards for Land Surveys in New Mexico as adopted by the New Mexico State Board of Registration for Professional Engineers and Professional Surveyors; that it meets the minimum requirements for surveys and monumentation of the Albuquerque Subdivision Ordinance; that it shows all easements of record; and that it is true and correct to the best of my knowledge and belief.

Garry P. Hugg
NMPS No. 5823
October 31, 1990

PROFESSIONAL SURVEYOR STATE OF NEW MEXICO No. 5823 GARRY P. HUGG

SHEET 1 OF 2

Hugg Surveying inc.
4100 Southern Blvd., S.E., Suite 180-C Rio Rancho,New Mexico 87124 Phone (505) 892 8800

5/2/91

PLANS/PLATS ON FILE

FILE DESC: C22/D20

PLANS/PLATS 7

CITY OF ALBUQUERQUE
THIS MICROIMAGE IS THE BEST POSSIBLE REPRODUCTION DUE TO THE POOR QUALITY OF THE ORIGINAL DOCUMENT.

R# 24 DATE 3/14/92 LOC ESR

CITY OF ALBUQUERQUE

This microimage is certified to be a complete and accurate copy of the original as it appears in the files of the Public Works Department and was created in the normal course of business.

The photographic process used meets the Basic Microfilm Standards of the National Micrographics Association (MS115-1977)

DIRECTOR 11/5/92

NOTARY PUBLIC

OFFICIAL SEAL
Roberta Duran
NOTARY PUBLIC
STATE OF NEW MEXICO

D 24 C 20 B 16 A 12 | CITY OF ALBUQUERQUE C D

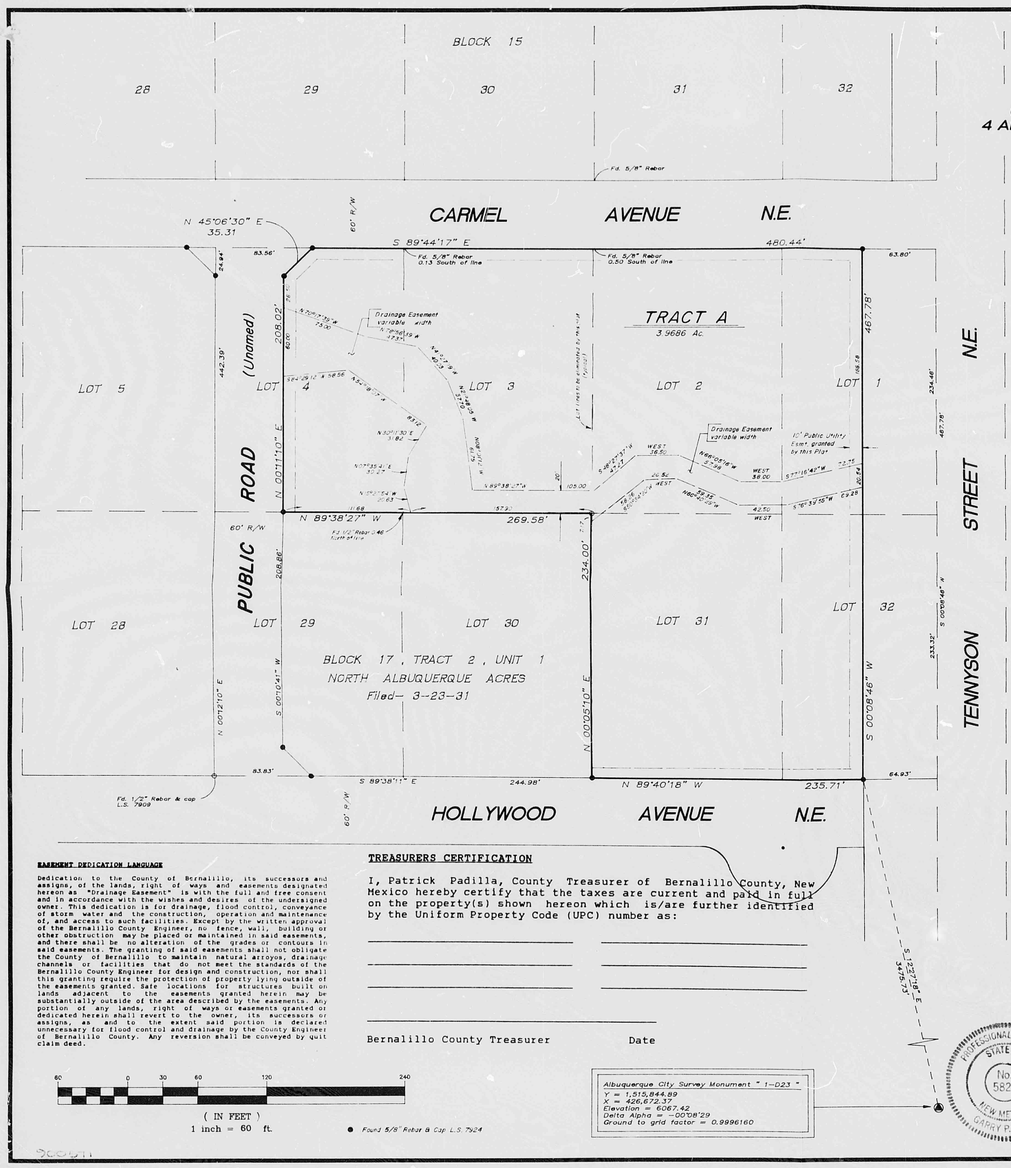

TRACT A
PRINCE OF PEACE CHURCH

(BEING A REPLAT OF LOTS 2, 3, 31, AND PORTIONS OF LOTS 1, 4 AND 32, BLOCK 17, TRACT 2, UNIT 1, NORTH ALBUQUERQUE ACRES)

BERNALILLO COUNTY, NEW MEXICO

OCTOBER, 1990

PUBLIC UTILITY EASEMENTS

PUBLIC UTILITY EASEMENTS shown on this plat are ten (10) feet wide and are granted for the common and joint use of:

A. The Public Service Company of New Mexico for installation, maintenance, and service of overhead and underground electrical lines, transformers, and other equipment and related facilities reasonably necessary to provide electrical service.

B. Mountain Bell for the installation, maintenance, and service of such lines, cable, and other related equipment and facilities reasonably necessary to provide communication services, including but not limited to ground pedestals and closures.

C. Jones Intercable for the installation, maintenance, and service of such lines, cable, and other related equipment and facilities reasonably necessary to provide Cable TV service.

Included, is the right to build, rebuild, construct, reconstruct, locate, relocate, change, remove, modify, renew, operate, and maintain facilities for the purposes described above, together with free access to, from, and over said easements, including sufficient working area space for electric transformers, with the right and privilege to trim and remove trees, shrubs or bushes which interfere with the purposes set forth herein. No building, sign, pool (aboveground or subsurface), hot tub, concrete or wood pool decking, or other structure shall be erected or constructed on said easements, nor shall any well be drilled or operated thereon. Property owners shall be solely responsible for correcting any violations of National Electric Safety Code by construction of pools, decking, or any structures adjacent to or near easements shown on this plat.

APPROVALS

Public Service Company of New Mexico — 12-7-90 — Date

Gas Company of New Mexico — 11-28-90 — Date

U. S. West Communications — 11 18 90 — Date

APPROVALS

LAND DIVISION NUMBER _____

Bernalillo County Planning Director — Date

Bernalillo County Public Works Department — 5/3/91 — Date

Bernalillo County Environmental Health Department — Date

NOTE: City of Albuquerque Water and Sanitary Sewer Service is currently not available to these properties.

SHEET 2 OF 2

EASEMENT DEDICATION LANGUAGE

Dedication to the County of Bernalillo, its successors and assigns, of the lands, right of ways and easements designated hereon as "Drainage Easement" is with the full and free consent and in accordance with the wishes and desires of the undersigned owner. This dedication is for drainage, flood control, conveyance of storm water and the construction, operation and maintenance of, and access to such facilities. Except by the written approval of the Bernalillo County Engineer, no fence, wall, building or other obstruction may be placed or maintained in said easements, and there shall be no alteration of the grades or contours in said easements. The granting of said easements shall not obligate the County of Bernalillo to maintain natural arroyos, drainage channels or facilities that do not meet the standards of the Bernalillo County Engineer for design and construction, nor shall this granting require the protection of property lying outside of the easements granted. Safe locations for structures built on lands adjacent to the easements granted herein may be substantially outside of the area described by the easements. Any portion of any lands, right of ways or easements granted or dedicated herein shall revert to the owner, its successors or assigns, as and to the extent said portion is declared unnecessary for flood control and drainage by the County Engineer of Bernalillo County. Any reversion shall be conveyed by quit claim deed.

TREASURERS CERTIFICATION

I, Patrick Padilla, County Treasurer of Bernalillo County, New Mexico hereby certify that the taxes are current and paid in full on the property(s) shown hereon which is/are further identified by the Uniform Property Code (UPC) number as:

_____ _____

_____ _____

_____ _____

_____

Bernalillo County Treasurer — Date

60 0 30 60 120 240

(IN FEET)

1 inch = 60 ft.

● Found 5/8" Rebar & Cap L.S. 7924

Albuquerque City Survey Monument " 1-D23 "
Y = 1,515,844.89
X = 426,672.37
Elevation = 6067.42
Delta Alpha = -0°08'29"
Ground to grid factor = 0.9996160

PROFESSIONAL SURVEYOR STATE OF NEW MEXICO No. 5823 GARY P. HUGG

Hugg Surveying inc.
4100 Southern Blvd., S.E., Suite 180-C Rio Rancho, New Mexico 87124 Phone (505) 892 8800

CITY OF ALBUQUERQUE
THIS MICROIMAGE IS THE BEST POSSIBLE REPRODUCTION DUE TO THE POOR QUALITY OF THE ORIGINAL DOCUMENT.

R# 24 DATE 3/14/02 OP ESR

CITY OF ALBUQUERQUE

This microimage is certified to be a complete and accurate copy of the original as it appears in the files of the **Public Works Department** and was created in the normal course of business.

The photographic process used meets the Basic Microfilm Standards of the National Micrographics Association (MS115-1977)

DIRECTOR 11/5/02

NOTARY PUBLIC

OFFICIAL SEAL
Roberta Duran
NOTARY PUBLIC
STATE OF NEW MEXICO
My commission expires: 6/08/02

C B A

C B A

C20 B16 A12

CITY OF ALBUQUERQUE C

SCALE: 1"=30'

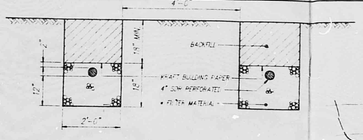

* CLEAN STONE OR GRAVEL GRADED UNIFORMLY FROM 2 1/2" TO 3/4" N. MATERIAL LESS THAN 1/2"

TYPICAL SECTION THROUGH LEACHFIELD

SECTION

PLAN

JUNCTION BOX DETAIL

EARTHWORK QUANTITIES
CUT = 1,000 C.Y.
FILL = 6200 C.Y.

NOTES:
1. TOPOGRAPHIC SURVEY PERFORMED BY HUGG SURVEYING
3. SITE CONTRIBUTES FLOW TO 1 FLOOD ZONE AS SHOWN
4. ADD 6000 TO ALL SPOT ELEVS. ALL ELEVS ARE MEAN SEA LEVEL (M.S.L.) CONTOUR INTERVAL 1'

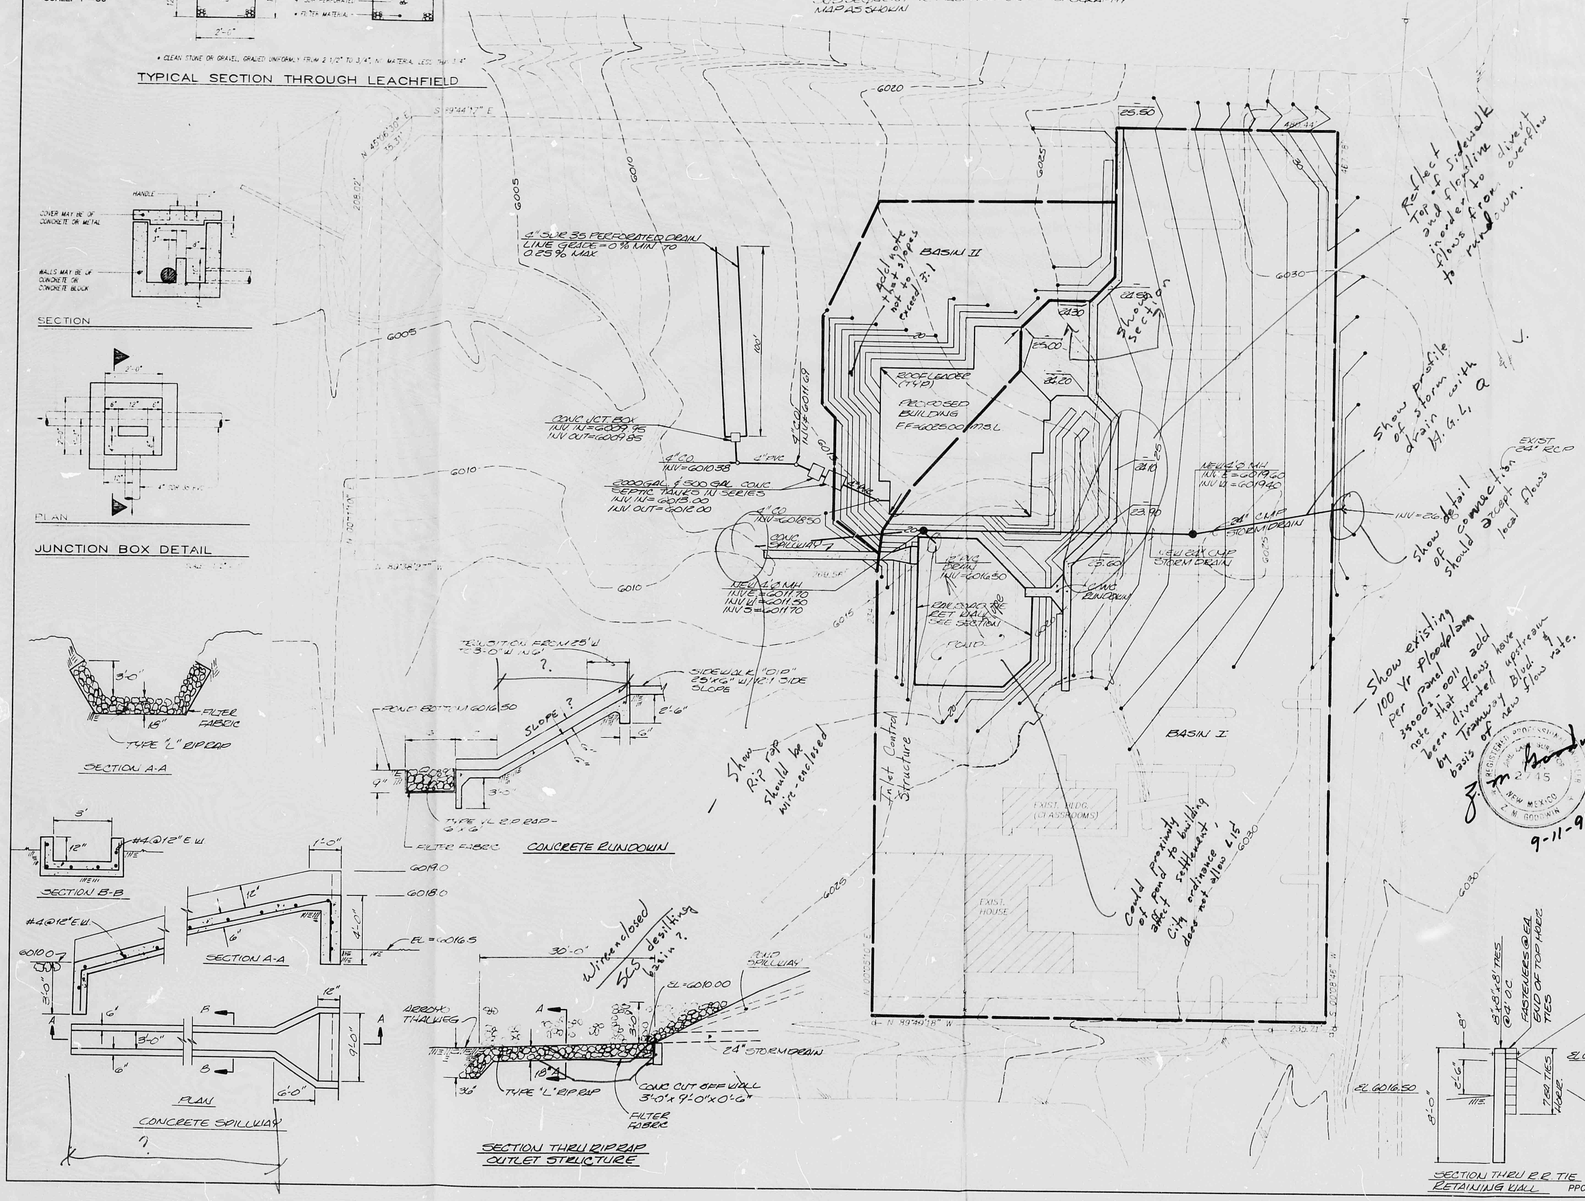

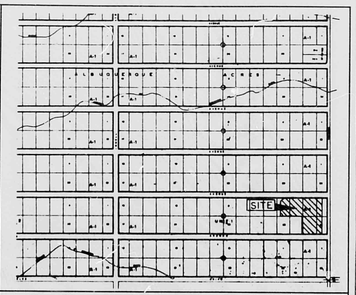

VICINITY MAP ZONE MAP: C-22-Z

TBM (TEMPORARY BENCHMARK)

NORTHEAST PROPERTY CORNER TOP OF #5/8" REBAR W/CAP MARKED L.S. 7924.
TBM ELEVATION = 6032.94

BENCHMARK

THE STATION MARK IS A STANDARD ACS BRASS TABLET, STAMPED "1-023", SET IN TOP OF A CONCRETE POST PROJECTING 0.1 FT. ABOVE GROUND.
X = 426,672.37, Y = 1,515,844.89, Z = 6067.423

LEGAL DESCRIPTION

TRACT A, A REPLAT OF LOTS 2, 3, 31 AND PORTIONS OF LOTS 1, 4, AND 32, BLOCK 17, TRACT 2, UNIT 1, NORTH ALBUQUERQUE ACRES.

LEGEND

— — WL — —	EXISTING ASPHALT PAVING
==========	EXISTING R.C.P.
—— - ——	PROPERTY LINE
------25------	CONTOUR
69 TC / 69 FL	EXIST. SPOT ELEVATION
MH	MANHOLE
FF=	FINISHED FLOOR
6025.50	PROPOSED SPOT ELEVATION
—101—	FINISHED CONTOUR

APPROVALS

CITY / COUNTY FLOOD PLAIN ADMINISTRATOR — DATE

COUNTY SURFACE HYDROLOGIST — DATE

AMAFCA — DATE

PRINCE OF PEACE CATHOLIC CHURCH

GRADING & DRAINAGE PLAN

D. MARK GOODWIN & ASSOCIATES, P.A.
CONSULTING ENGINEERS & SURVEYORS
P.O. BOX 90606
ALBUQUERQUE, NEW MEXICO 87199
(505) 828-2200

Designed: DMG	Drawn: JMB	Checked: DMG	Sheet C1 of 1
Scale: 1"=30'	Date: 8/91	Job: 9134	

9-11-91

SEP 12 1991

CITY OF ALBUQUERQUE
THIS MICROIMAGE IS THE BEST POSSIBLE REPRODUCTION DUE TO THE POOR QUALITY OF THE ORIGINAL DOCUMENT.

R# 24 DATE 3/14/12 DP

CITY OF ALBUQUERQUE
This microimage is certified to be a complete and accurate copy of the original as it appears in the files of the Public Works Department and was created in the normal course of business.
The photographic process used meets the Basic Microfilm Standards of the National Micrographics Association (MS115-1977)

DIRECTOR 11/5/12

NOTARY PUBLIC
OFFICIAL SEAL
Roberta Duran
NOTARY PUBLIC
STATE OF NEW MEXICO
My commission expires: 8/07/12

D 24 C 20 B 16 A 12

CITY OF ALBUQUERQUE C D

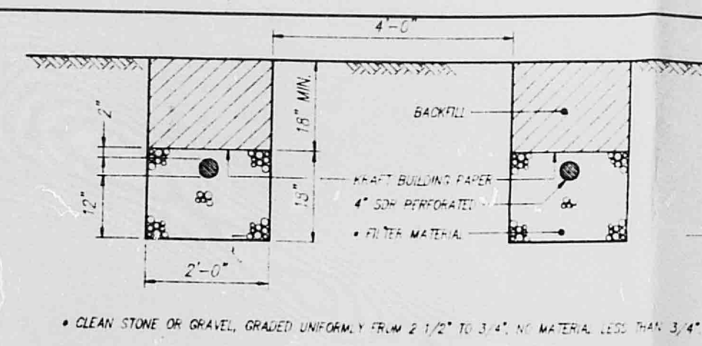

TYPICAL SECTION THROUGH LEACHFIELD

EARTHWORK QUANTITIES
CUT = 1,000 C.Y.
FILL = 6,200 C.Y.

NOTES:

1. TOPOGRAPHIC SURVEY PERFORMED BY HUGG SURVEYING
2. ZANE GOODWIN, P.E. L.S. PERFORMED A FIELD INVESTIGATION 8-12-91. NO GRADING, FILLING OR EXCAVATION HAS BEEN PERFORMED SUBSEQUENT TO PREPARATION OF TOPOGRAPHY MAP AS SHOWN
3. SITE CONTRIBUTES FLOW TO 1 FLOOD ZONE AS SHOWN
4. ADD 6000 TO ALL SPOT ELEV'S. ALL ELEV'S ARE MEAN SEA LEVEL (MSL) CONTOUR INTERVAL = 1'
5. WHERE EVER USED ON THIS PROJECT, FILTER FABRIC SHALL CONFORM TO THE REQUIREMENTS IN CITY OF ALBUQUERQUE STANDARD SPECIFICATIONS FOR PUBLIC WORKS CONST. PARA. 603.9.1
6. MAX. GRADE SLOPE AROUND BUILDING IS 3:1.
7. WHERE NEW 21" CMP STORM DRAIN RUNS ADJACENT TO NEW BLDG. FOUNDATION, SPECIAL CARE MUST BE TAKEN TO INSURE JOINTS ARE WATER TIGHT.

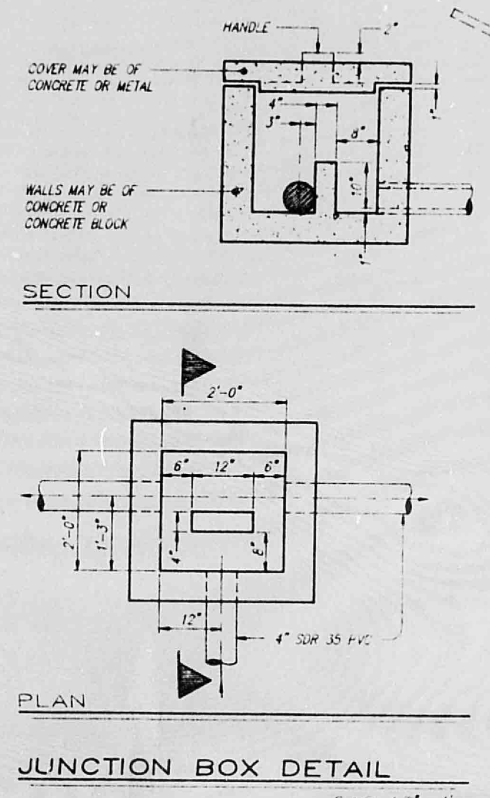

JUNCTION BOX DETAIL

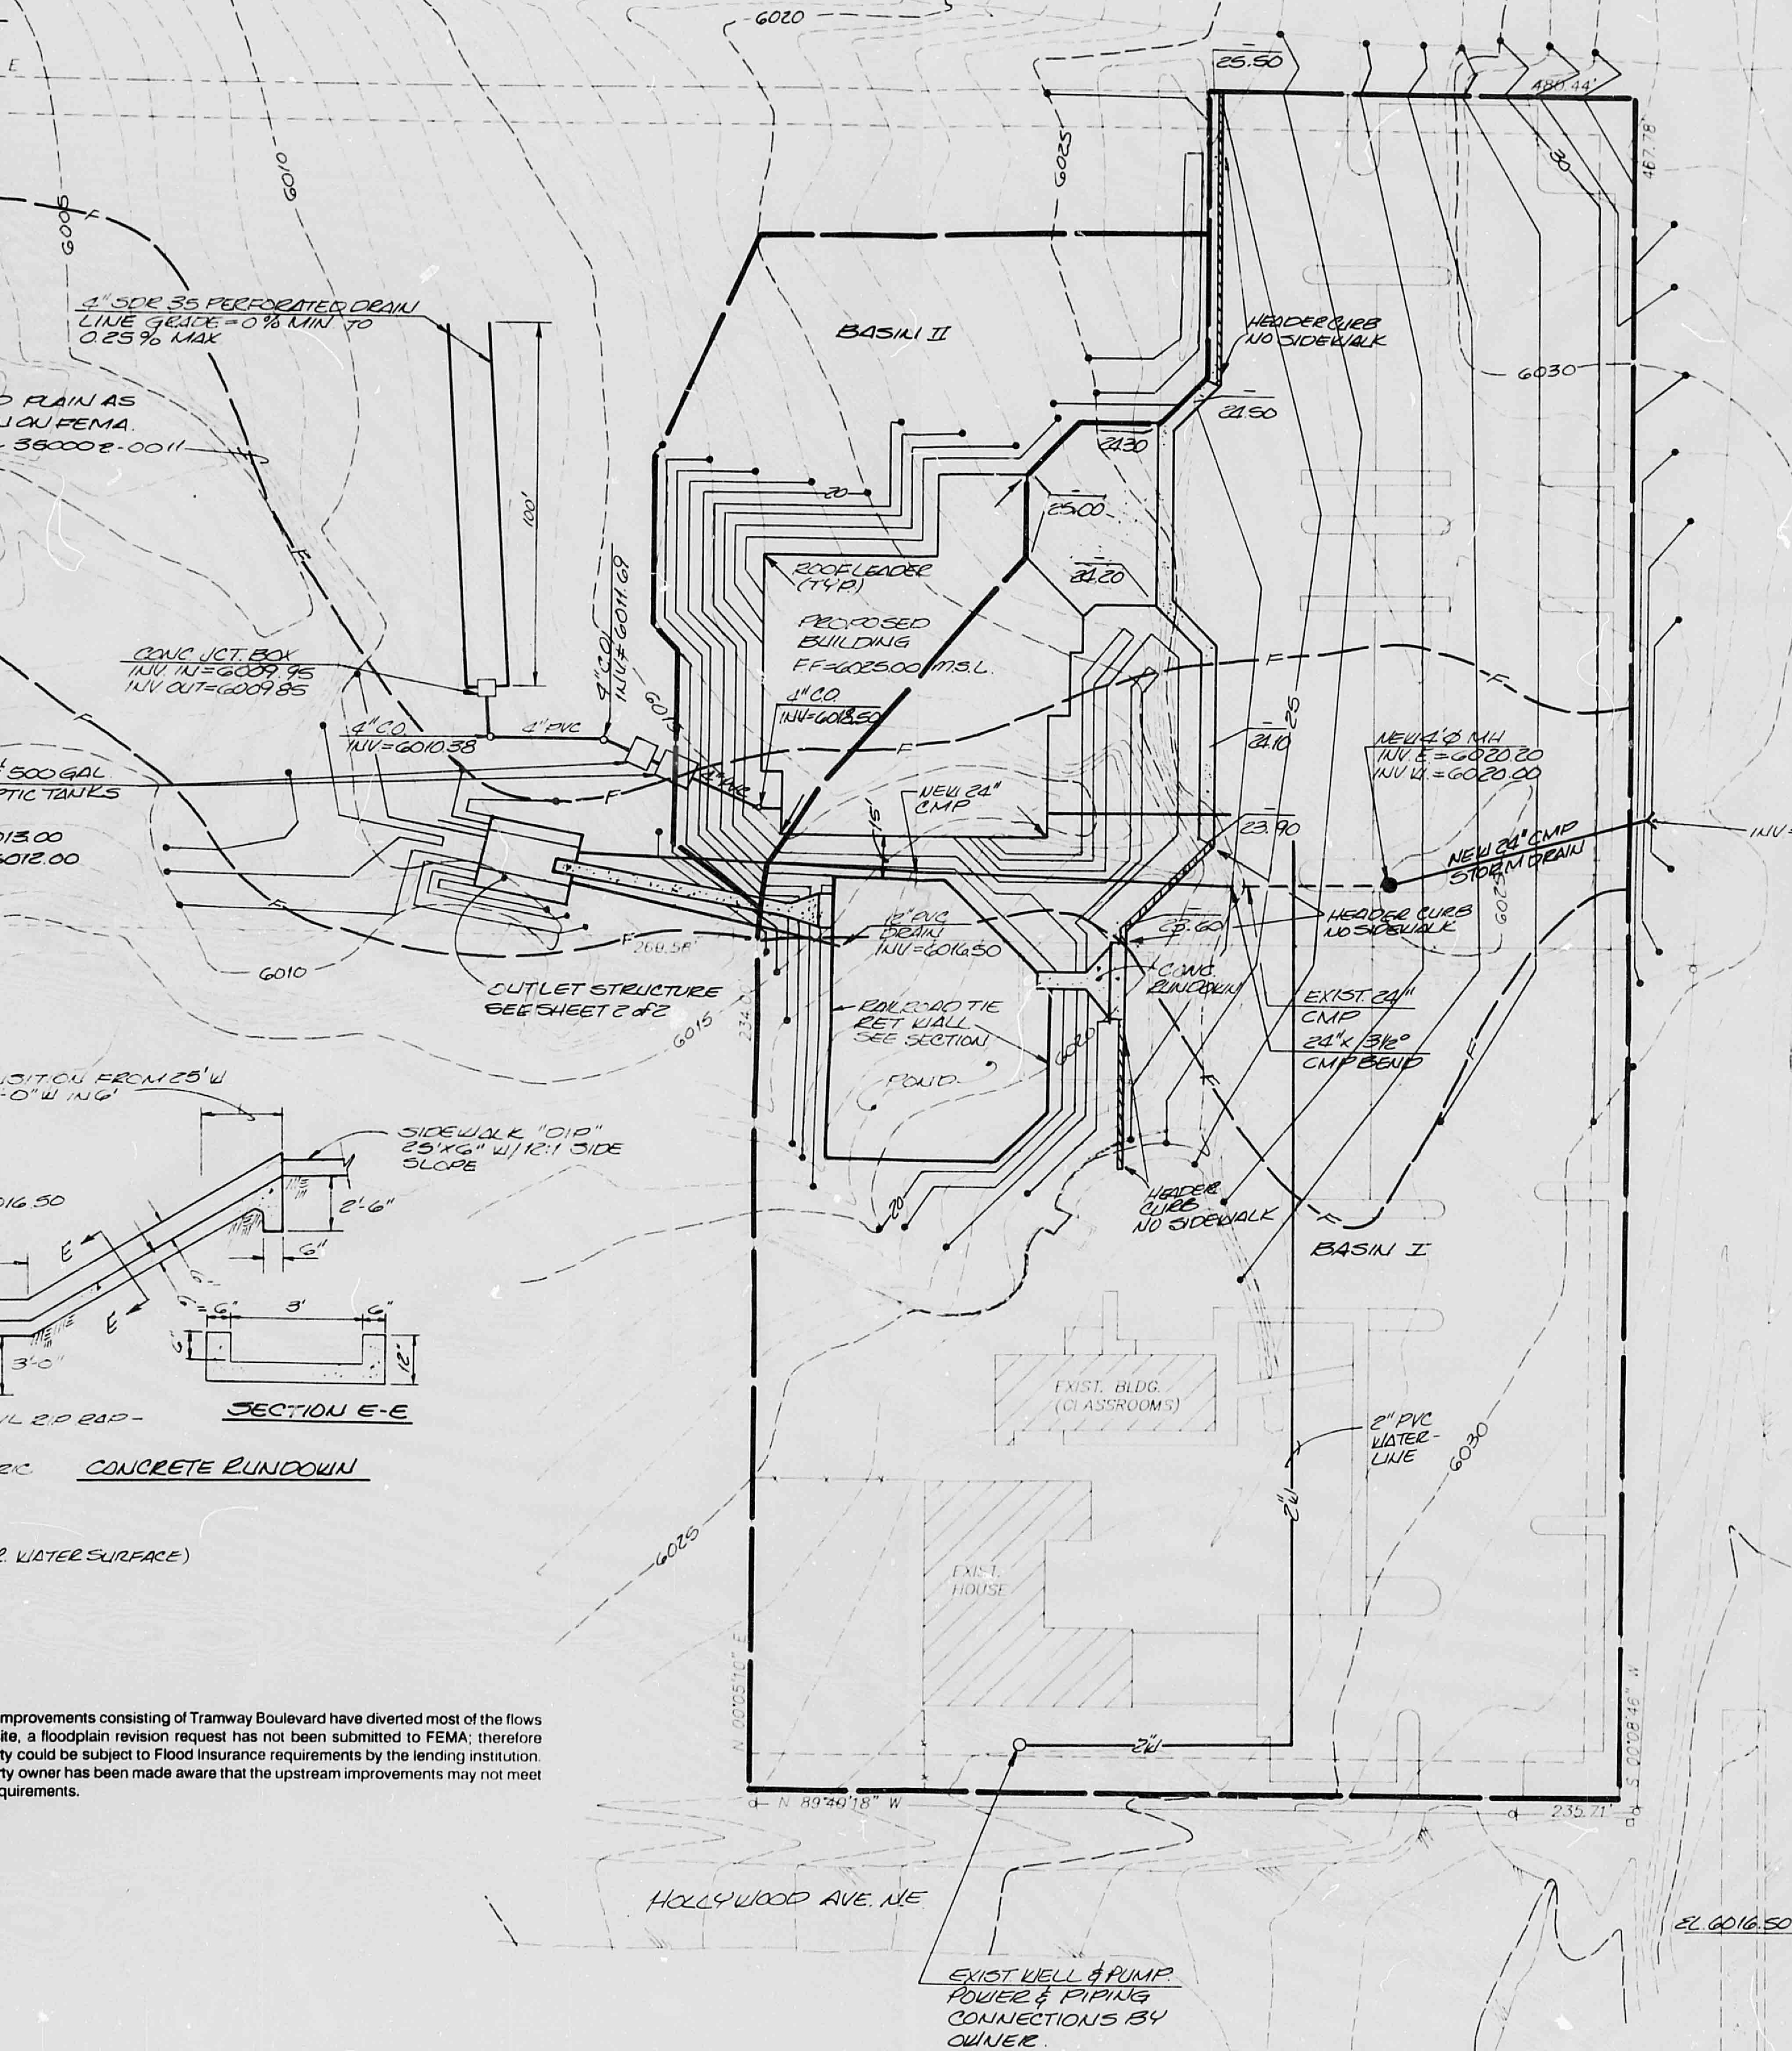

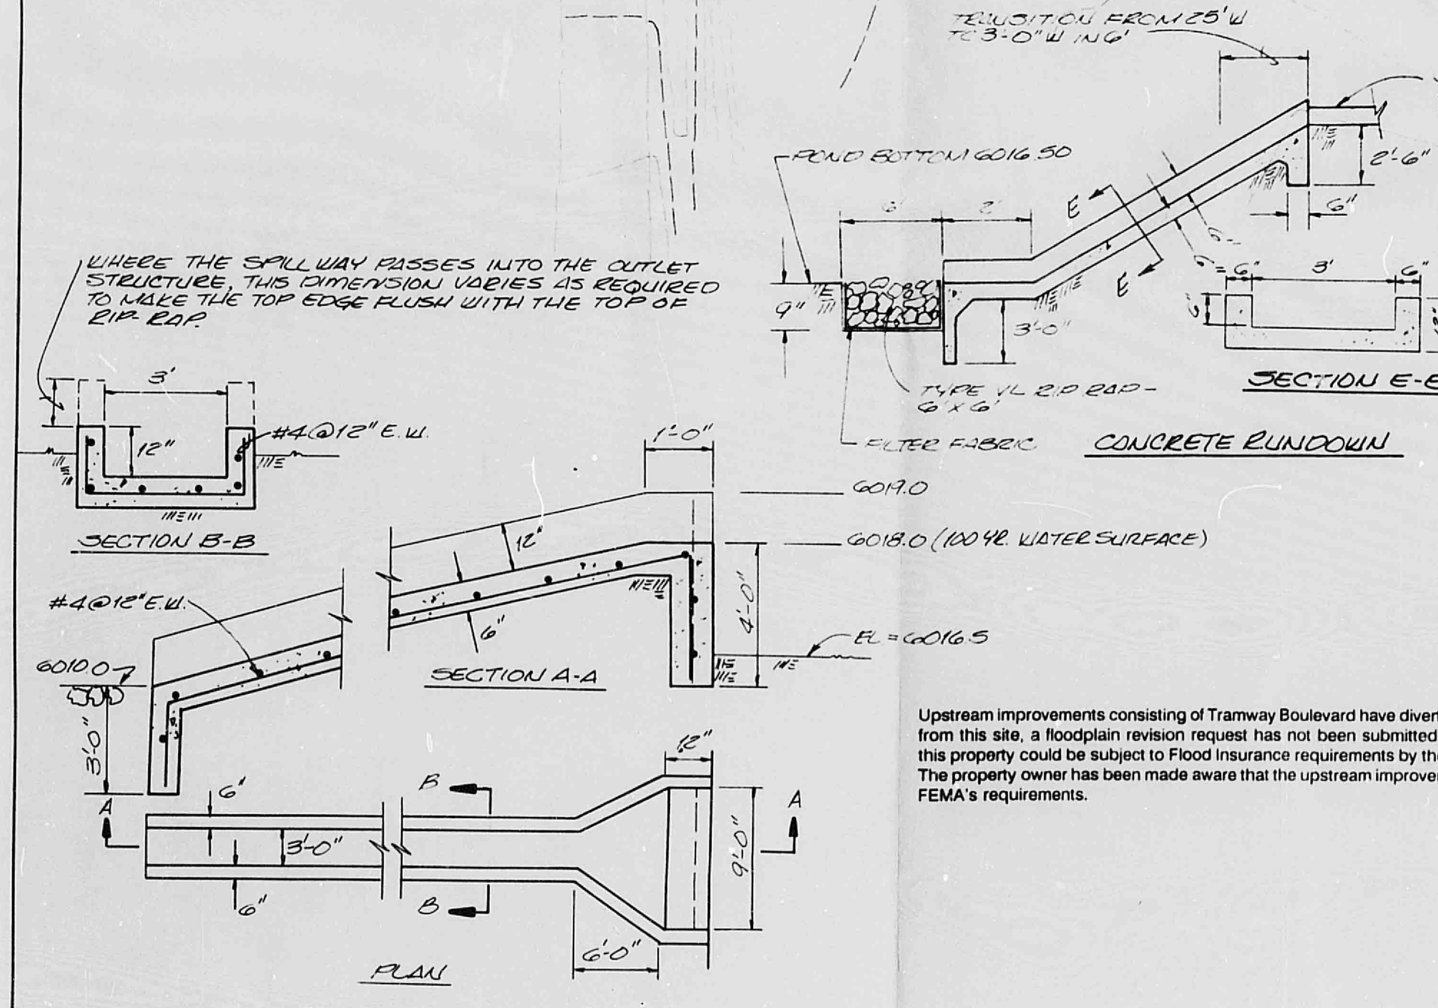

Upstream improvements consisting of Tramway Boulevard have diverted most of the flows from this site, a floodplain revision request has not been submitted to FEMA; therefore this property could be subject to Flood Insurance requirements by the lending institution. The property owner has been made aware that the upstream improvements may not meet FEMA's requirements.

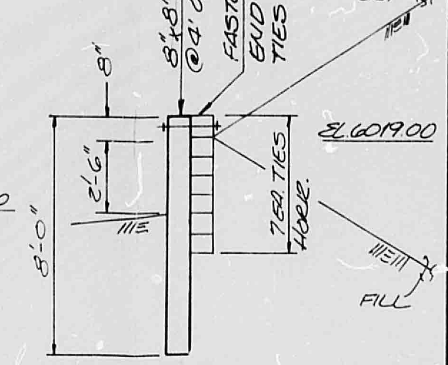

SECTION THRU R.R. TIE RETAINING WALL

PPC\SITE

Z. M. Goodwin
9-11-91
Rev 10-10-91
Rev 10-18-91

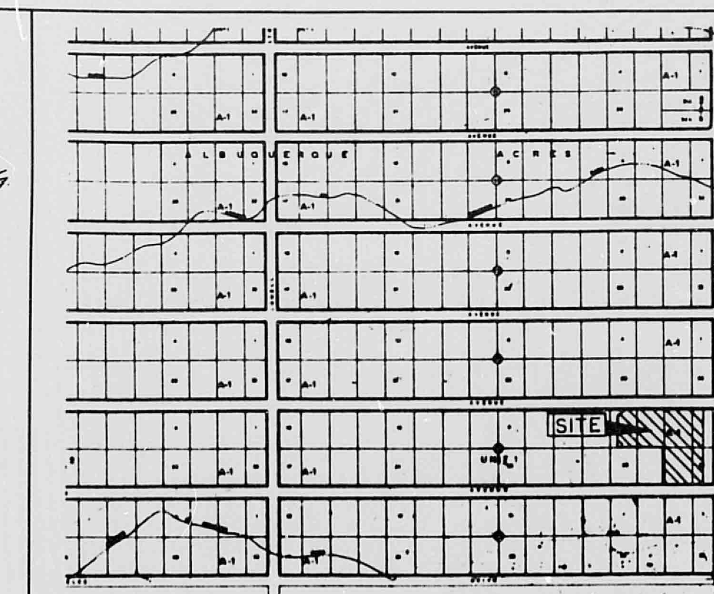

VICINITY MAP — ZONE MAP: C-22-Z

TBM (TEMPORARY BENCHMARK)

NORTHEAST PROPERTY CORNER TOP OF #5/8" REBAR W/CAP MARKED L.S. 7924. TBM ELEVATION = 6032.94

BENCHMARK

THE STATION MARK IS A STANDARD ACS BRASS TABLET, STAMPED "I-D23", SET IN TOP OF A CONCRETE POST PROJECTING 0.1 FT. ABOVE GROUND.
X = 426,672.37, Y = 1,515,844.89, Z = 6067.423

LEGAL DESCRIPTION

TRACT A, A REPLAT OF LOTS 2, 3, 31 AND PORTIONS OF LOTS 1, 4, AND 32, BLOCK 17, TRACT 2, UNIT 1, NORTH ALBUQUERQUE ACRES.

LEGEND

	EXISTING ASPHALT PAVING
	EXISTING R.C.P.
	PROPERTY LINE
——25——	CONTOUR
69 TC / 69 FL	EXIST. SPOT ELEVATION
O MH	MANHOLE
FF=	FINISHED FLOOR
25.50	PROPOSED SPOT ELEVATION
—101—	FINISHED CONTOUR

APPROVALS

for CITY / COUNTY FLOOD PLAIN ADMINISTRATOR — Bernie J Montoya 10/23/91 — DATE

COUNTY SURFACE HYDROLOGIST — DATE

AMAFCA — DATE

PRINCE OF PEACE CATHOLIC CHURCH

GRADING & DRAINAGE PLAN

dmg
D. MARK GOODWIN & ASSOCIATES, P.A.
CONSULTING ENGINEERS & SURVEYORS
P.O. BOX 90606
ALBUQUERQUE, NEW MEXICO 87199
(505) 828-2200

Designed: DMG	Drawn: JMB	Checked: DMG	Sheet C1 of 2
Scale: 1"=30'	Date: 8/91	Job: 9134	

CITY OF ALBUQUERQUE
THIS MICROIMAGE IS THE BEST POSSIBLE REPRODUCTION DUE TO THE POOR QUALITY OF THE ORIGINAL DOCUMENT.

R# 24 DATE 3-14-02 OP EJP

CITY OF ALBUQUERQUE

This microimage is certified to be a complete and accurate copy of the original as it appears in the files of the Public Works Department and was created in the normal course of business.

The photographic process used meets the Basic Microfilm Standards of the National Micrographics Association (MS115-1977)

DIRECTOR 11/5/02

Roberta Duran
NOTARY PUBLIC
OFFICIAL SEAL
Roberta Duran
NOTARY PUBLIC
STATE OF NEW MEXICO
07/08/02

D 24 C 20 B 16 A 12 CITY OF ALBUQUERQUE C D

PUBLIC WORKS/HYDROLOGY

2 of 2

C22/D20

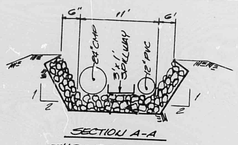

SECTION A-A
THRU RIPRAP OUTLET STRUCTURE

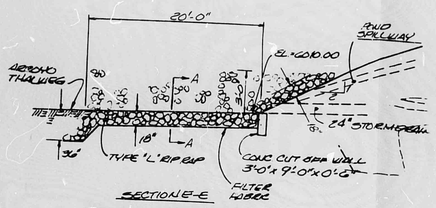

SECTION E-E
SECTION THRU RIPRAP OUTLET STRUCTURE

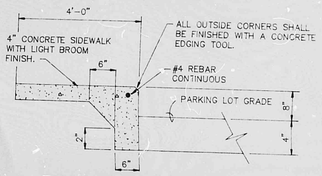

TURN-DOWN SIDEWALK DETAIL

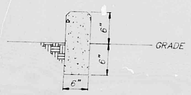

HEADER CURB WITHOUT SIDEWALK

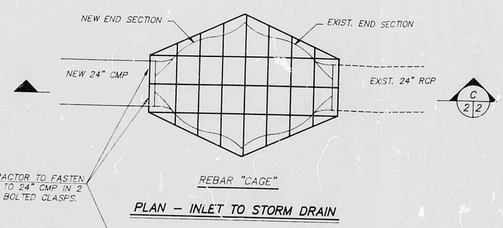

REBAR "CAGE"

PLAN – INLET TO STORM DRAIN

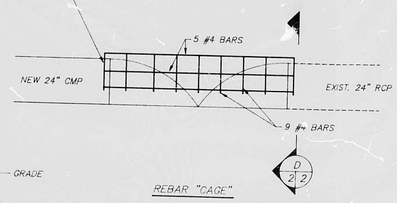

REBAR "CAGE"

SECTION C

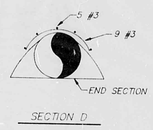

SECTION D

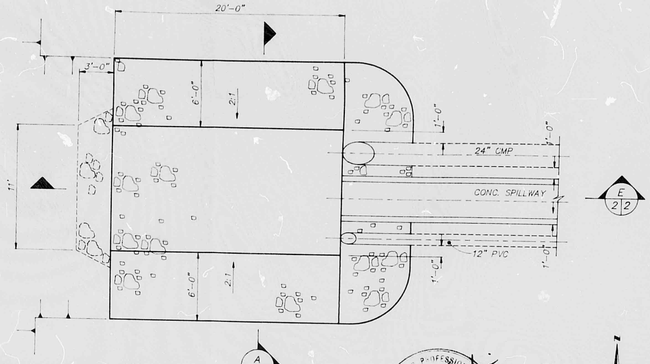

PLAN – RIPRAP STRUCTURE

dmg
D. MARK GOODWIN & ASSOCIATES, P.A.
CONSULTING ENGINEERS & SURVEYORS
P.O. BOX 90606
ALBUQUERQUE, NEW MEXICO 87199
(505) 828-2200

STORM DRAIN PLAN & PROFILE

SCALE:
HORIZ. 1"=10'
VERT. 1"=5'

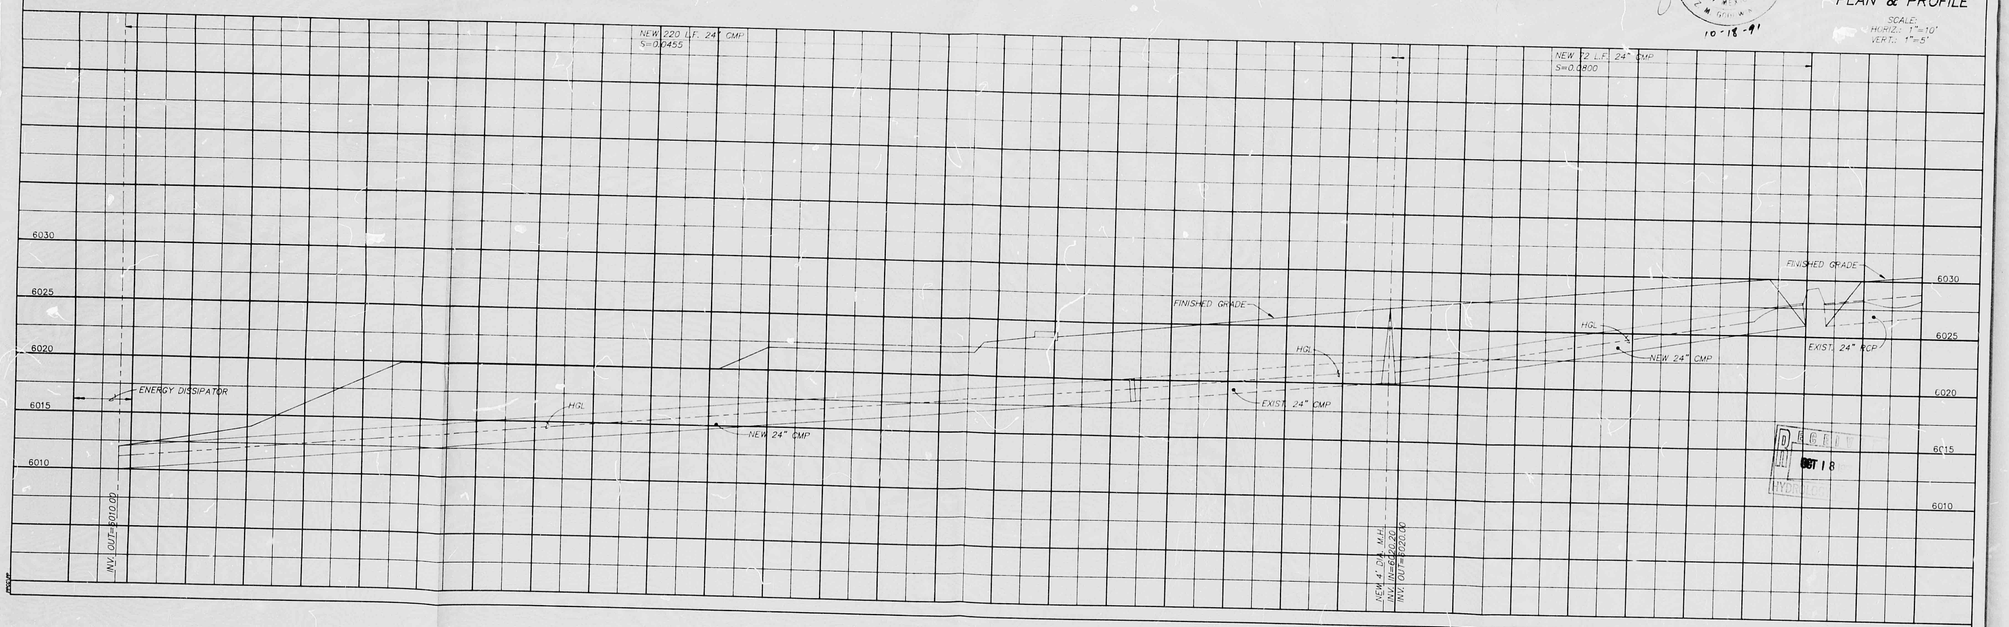

CITY OF ALBUQUERQUE
THIS MICROIMAGE IS THE BEST POSSIBLE REPRODUCTION DUE TO THE POOR QUALITY OF THE ORIGINAL DOCUMENT.

R# 24 DATE 3/4/92 DD EP

CITY OF ALBUQUERQUE

This microimage is certified to be a complete and accurate copy of the original as it appears in the files of the Public Works Department and was created in the normal course of business.

The photographic process used meets the Basic Microfilm Standards of the National Micrographics Association (MS115-1977)

DIRECTOR 11/5/92

NOTARY PUBLIC
OFFICIAL SEAL
Roberta Duran
NOTARY PUBLIC
STATE OF NEW MEXICO
MY COMMISSION EXPIRES 9/30/92

RECEIVED
OCT 18
PWD

D 24 C 20 B 16 A 12 | CITY OF ALBUQUERQUE C D

SCALE: 1"=30'

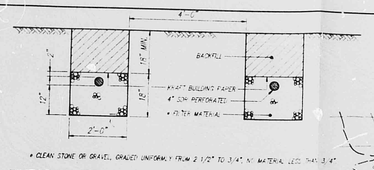

* CLEAN STONE OR GRAVEL, GRADED UNIFORMLY FROM 2 1/2" TO 3/4" W. MATERIAL LEC 540, 3.4"

TYPICAL SECTION THROUGH LEACHFIELD

SECTION

PLAN

JUNCTION BOX DETAIL

SCALE: 1/2" = 1'

EARTHWORK QUANTITIES

CUT = 1,000 C.Y.
FILL = 6,800 C.Y.

NOTES:

1. TOPOGRAPHIC SURVEY PERFORMED BY HUGG SURVEYING
2. ZONE GOODWIN, P.E. L.S. PERFORMED A FIELD INVESTIGATION & S.I.V. NO GRADING, FILLING OR EXCAVATION HAS BEEN PERFORMED SUBSEQUENT TO PREPARATION OF TOPOGRAPHY MAP AS SHOWN
3. SITE CONTRIBUTES FLOW TO 1 FLOOD ZONE AS SHOWN
4. ADD 6000 TO ALL SPOT ELEVS. ALL ELEVS ARE MEAN SEA LEVEL (M.S.L.) CONTOUR INTERVAL = 1'
5. WHERE EVER USED ON THIS PROJECT, FILTER FABRIC SHALL CONFORM TO THE REQUIREMENTS AS SET FORTH IN THE STANDARD SPECIFICATIONS FOR PUBLIC WORKS CONST. PAR. 603.9
6. MAX. GRADE SLOPE AROUND BUILDING IS 3:1.
7. WHERE NEW 24" CMP STORM DRAIN RUNS ADJACENT TO NEW BLDG FOUNDATION, SPECIAL CARE MUST BE TAKEN TO INSURE JOINTS ARE WATER TIGHT

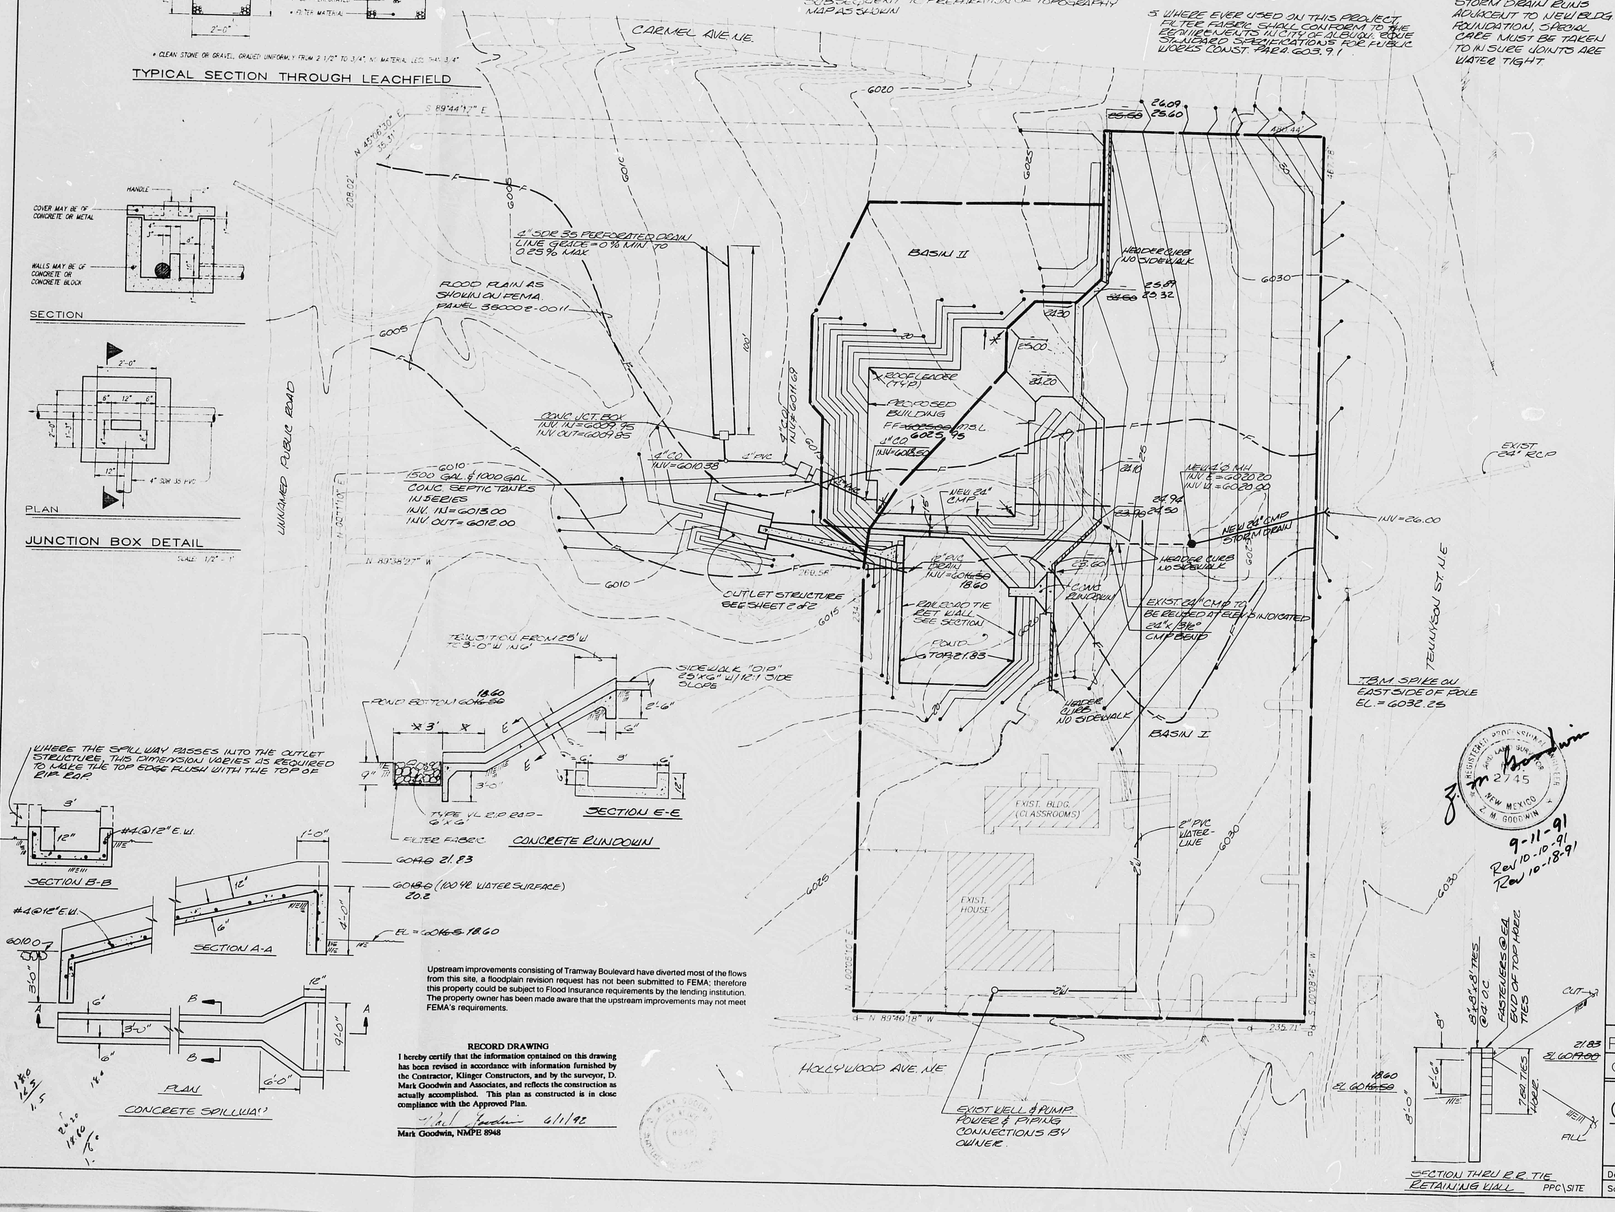

Upstream improvements consisting of Tramway Boulevard have diverted most of the flows from this site, a floodplain revision request has not been submitted to FEMA; therefore this property could be subject to Flood Insurance requirements by the lending institution. The property owner has been made aware that the upstream improvements may not meet FEMA's requirements.

RECORD DRAWING

I hereby certify that the information contained on this drawing has been revised in accordance with information furnished by the Contractor, Klinger Constructors, and by the surveyor, D. Mark Goodwin and Associates, and reflects the construction as actually accomplished. This plan as constructed is in close compliance with the Approved Plan.

Mark Goodwin 6/1/92

Mark Goodwin, NMPE 8948

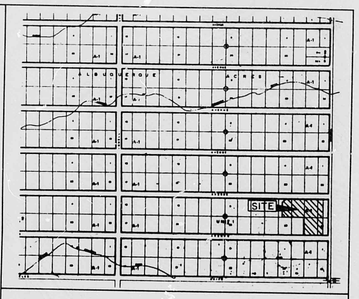

VICINITY MAP ZONE MAP: C-22-Z

TBM (TEMPORARY BENCHMARK)

NORTHEAST PROPERTY CORNER TOP OF #5/8" REBAR W/CAP MARKED L.S. 7924. TBM ELEVATION = 6032.94

BENCHMARK

THE STATION MARK IS A STANDARD ACS BRASS TABLET, STAMPED "1-D23", SET IN TOP OF A CONCRETE POST PROJECTING 0.1 FT. ABOVE GROUND.
X = 426,672.37, Y = 1,515,844.89, Z = 6067.423

LEGAL DESCRIPTION

TRACT A, A REPLAT OF LOTS 2, 3, 31 AND PORTIONS OF LOTS 1, 4, AND 32, BLOCK 17, TRACT 2, UNIT 1, NORTH ALBUQUERQUE ACRES.

LEGEND

- EXISTING ASPHALT PAVING
- EXISTING R.C.P.
- PROPERTY LINE
- CONTOUR
- 69 TC / 69 FL — EXIST. SPOT ELEVATION
- MH — MANHOLE
- FF= — FINISHED FLOOR
- 99.99 — PROPOSED SPOT ELEVATION
- 101 — FINISHED CONTOUR

APPROVALS

for CITY / COUNTY FLOOD PLAIN ADMINISTRATOR	DATE 9-11-91
COUNTY SURFACE HYDROLOGIST	DATE 10/24/91
AMAFCA	DATE 10/25/91

Rev 10-10-91
Rev 10-18-91

RECEIVED JUN 1 1992 HYDROLOGY DIVISION

PRINCE OF PEACE CATHOLIC CHURCH
GRADING & DRAINAGE PLAN

D. MARK GOODWIN & ASSOCIATES, P.A.
CONSULTING ENGINEERS & SURVEYORS
P.O. BOX 90606
ALBUQUERQUE, NEW MEXICO 87199
(505) 828-2200

Designed: DMG	Drawn: JMB	Checked: DMG	Sheet C1 of 2
Scale: 1"=30'	Date: 8/91	Job: 9134	

CITY OF ALBUQUERQUE
THIS MICROIMAGE IS THE BEST POSSIBLE REPRODUCTION DUE TO THE POOR QUALITY OF THE ORIGINAL DOCUMENT.

R# 24 DATE 3/14/02 DP

CITY OF ALBUQUERQUE
This microimage is certified to be a complete and accurate copy of the original as it appears in the files of the Public Works Department and was created in the normal course of business.
The photographic process used meets the Basic Microfilm Standards of the National Micrographics Association (MS115-1977)

DIRECTOR 11/5/02

NOTARY PUBLIC
OFFICIAL SEAL
Roberta Duran
NOTARY PUBLIC
STATE OF NEW MEXICO
My commission expires: 7/07/02

D 24 C 20 B 16 A 12 | CITY OF ALBUQUERQUE C D

dmg D. MARK GOODWIN & ASSOCIATES, P.A.
CONSULTING ENGINEERS & SURVEYORS
P.O. BOX 90606
ALBUQUERQUE, NEW MEXICO 87199
(505) 828-2200

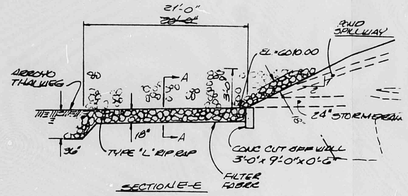

SECTION E-E

SECTION THRU RIPRAP OUTLET STRUCTURE

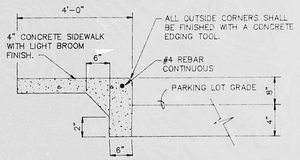

TURN-DOWN SIDEWALK DETAIL

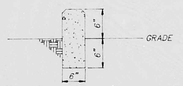

HEADER CURB WITHOUT SIDEWALK

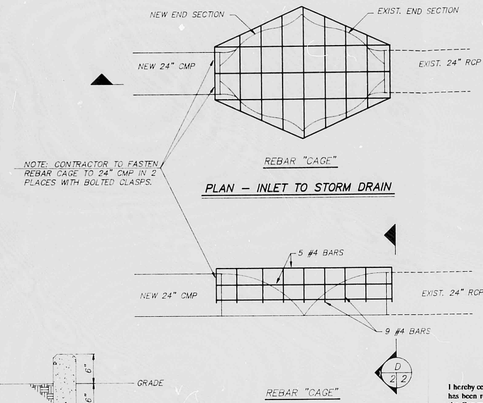

PLAN – INLET TO STORM DRAIN

REBAR "CAGE"

SECTION C

SECTION D

RECORD DRAWING

I hereby certify that the information contained on this drawing has been revised in accordance with information furnished by the Contractor, Klinger Constructors, and by the surveyor, D. Mark Goodwin and Associates, and reflects the construction as actually accomplished. This plan as constructed is in close compliance with the Approved Plan.

6/1/92

Mark Goodwin, NMPE 8948

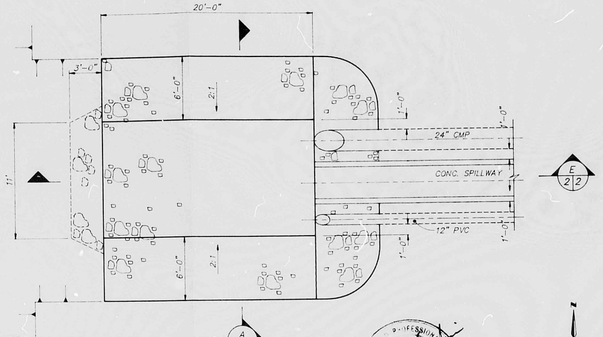

PLAN – RIPRAP STRUCTURE

10-18-91

STORM DRAIN PLAN & PROFILE

SCALE:
HORIZ.: 1"=10'
VERT.: 1"=5'

RECEIVED
JUN 1 1992
HYDROLOGY DIV.

Sheet 2 of 2

CITY OF ALBUQUERQUE
THIS MICROIMAGE IS THE BEST POSSIBLE REPRODUCTION DUE TO THE POOR QUALITY OF THE ORIGINAL DOCUMENT.

R# 34 DATE 3/4/02 DOP EP

CITY OF ALBUQUERQUE

This microimage is certified to be a complete and accurate copy of the original as it appears in the files of the Public Works Department and was created in the normal course of business.

The photographic process used meets the Basic Microfilm Standards of the National Micrographics Association (MS115-1977)

11/5/02
DIRECTOR

NOTARY PUBLIC
OFFICIAL SEAL
Roberta Duran
NOTARY PUBLIC
STATE OF NEW MEXICO
My commission expires: 2/27/05

D 24 C 20 B 16 A 12 | CITY OF ALBUQUERQUE C D