HYDROLOGY

C23/D1E
1 PLAN

C23/DIE

1 PLAN

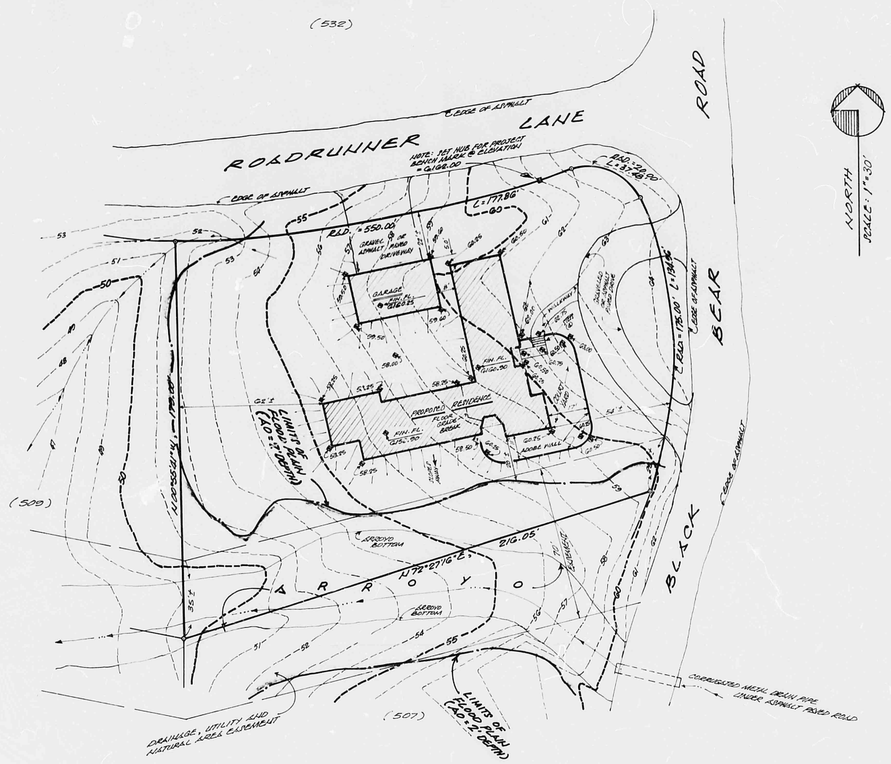

NOTES:
1.) GENERAL LAYOUT(S) OF DRIVEWAYS ARE TO BE FIELD LOCATED BY CONTRACTOR.
2.) SLOPE GRADES AWAY FROM BUILDING STRUCTURE(S).

✱ (VERIFICATION OF FLOOR ELEVATION(S) OBTAINED 11-23-87)

DESIGNED ELEVATION:		AS BUILT ELEVATION(S):
UPPER LEVEL (HOUSE) =	6160.90	6160.85
LOWER LEVEL (HOUSE) =	6158.90	6158.90
GARAGE =	6160.25	6158.89

RECEIVED
DEC 07 1987
HYDROLOGY SECTION

ZONE MAP "C-23-Z"

LEON J. VALDEZ
NEW MEXICO
6861
11-30-87

FINISHED FLOOR ELEVATION CERTIFICATION OF BOVE' RESIDENCE

(LOT 508, UNIT 5, SANDIA HEIGHTS SOUTH SUBDIVISION)
BERNALILLO COUNTY, NEW MEXICO
NOVEMBER, 1987