


THE COORDINATES SHOWN HEREON ARE MODIFIED (SURFACE) N.M. STATE PLANE COORDINATES, CENTRAL ZONE-NAD 83(HARN) AND WERE DERIVED BY SCALING STATE PLANE COORDINATES BY THE PROJECT COMBINED FACTOR OF 1.000323835. THE STATE PLANE COORDINATES ARE REFERRED TO THE NGS CONTROL POINT "REEVES 2". THE ELEVATIONS SHOWN HEREON ARE REFERRED TO THE SEA LEVEL, NAVD 88, AND HAVE BEEN ADJUSTED TO CONTROL STATION "REEVES 2" AS WELL (PUBLISHED ELEVATION = 5076.00').

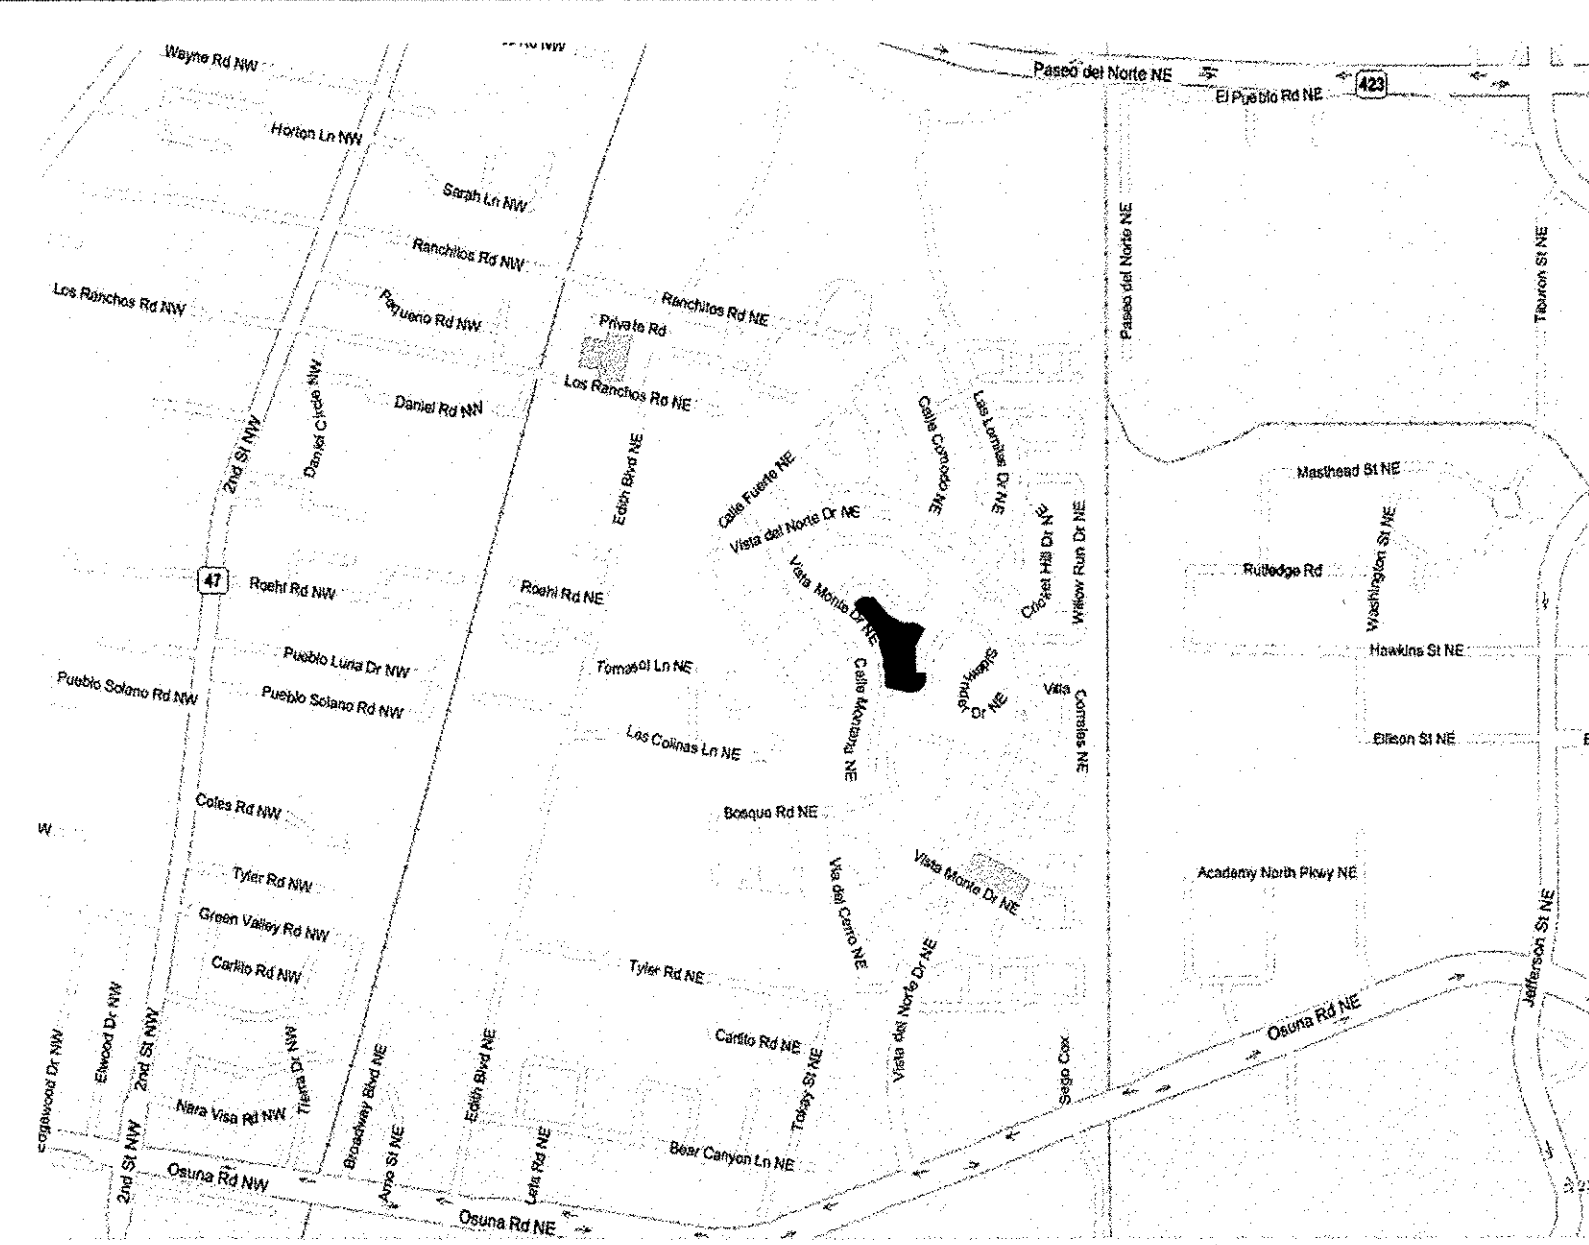

NOT TO SCALE

BENCH MARKS

TO REACH THE STATION FROM THE INTERSECTION OF EDITH BLVD., AND EL PUEBLO RD., GO EAST ON EL PUEBLO RD. 0.3 MI. TO THE DIVERSION CHANNEL. GO SOUTH ALONG THE EAST SIDE OF THE DIVERSION CHANNEL 0.45 MI. TO A SIGN ON THE DIVERSION MARKS. SET A STANDARD NOS 3.5" BRGS CHP IN THE CENTER OF THE FLUSH IN THE CENTER OF A CONCRETE APRON.

ENGINEER'S SEAL

DAVID H. WILSON
NEW MEXICO
13703
REGISTERED PROFESSIONAL ENGINEER
04/10/07

PROJECT DEVELOPMENT																	
WORK PLAN																	
	<table border="1"> <thead> <tr> <th>Mo./Day/Yr.</th> <th>Mo./Day/Yr.</th> </tr> </thead> <tbody> <tr><td></td><td></td></tr> <tr><td></td><td></td></tr> <tr><td></td><td></td></tr> <tr><td></td><td></td></tr> <tr><td></td><td></td></tr> <tr><td></td><td></td></tr> <tr><td></td><td></td></tr> </tbody> </table>	Mo./Day/Yr.	Mo./Day/Yr.														
Mo./Day/Yr.	Mo./Day/Yr.																
No.	Sheet 2 OF 12																

EARTHWORK SCHEDULE
CUT 400.5 CU YD
FILL 7065.0 CU YD
+20% SHRINK
NET = 7997 CU YD FILL




 **Gannett Fleming West, Inc.**
2155 Louisiana NE, Suite 7000 Albuquerque, New Mexico 87110
Office: (505) 265-8468 Facsimile: (505) 881-2513


 CITY OF ALBUQUERQUE
 DEPARTMENT OF MUNICIPAL DEVELOPMENT

TITLE: PASEO DE ESTRELLA PARK
GRADING AND DRAINAGE PLAN

Design Review Committee	City Engineer Approval	Last Design Update	Mo./Day/Yr.	Mo./Day/Yr.
City Project No. 7453.01		Zone Map No. D-16	Sheet 2 OF	

RECEIVED
APR 10 2007
HYDROLOGY SECTION

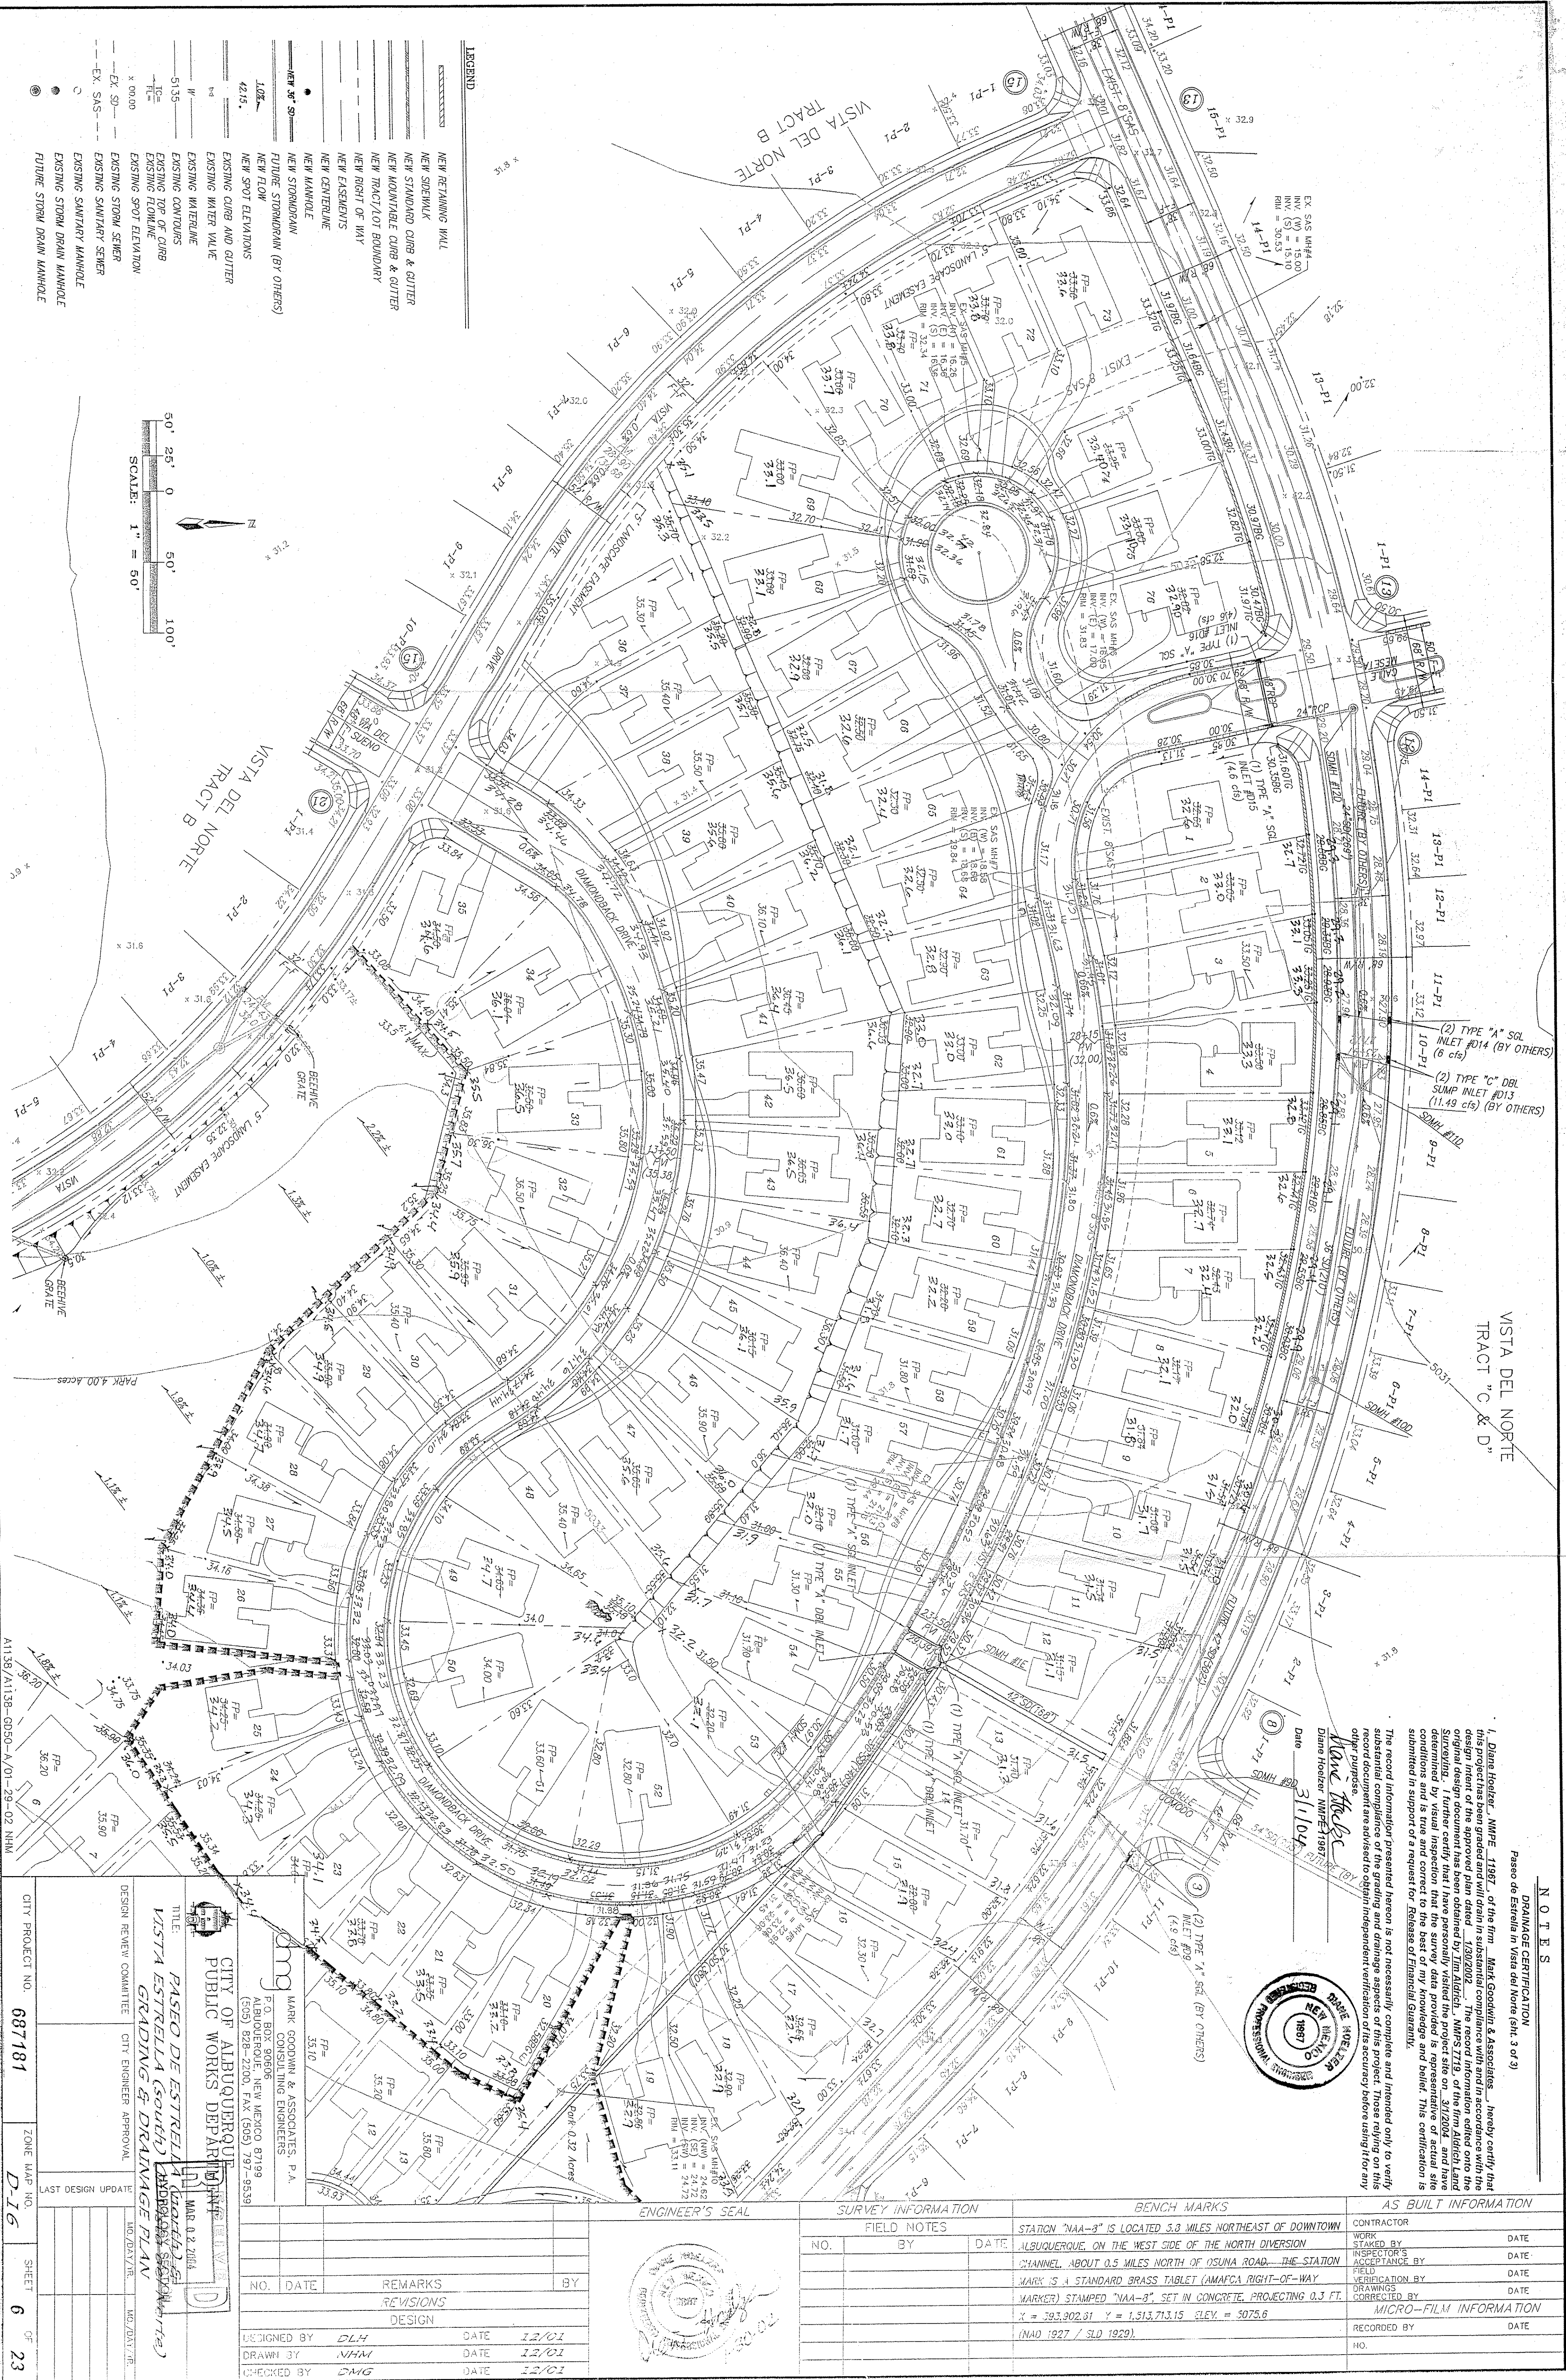


VISTA DEL NORTE
TRACT "C" & "D"

NOTES

1. Diane Horton, NME 11887, of the firm Mark Goodwin & Associates, hereby certifies that this project has been prepared and will be in substantial compliance with the requirements of the original design document. The record information shall be submitted to the City of Albuquerque, New Mexico, for review and approval. I further certify that I have personally visited the project site on 3/1/04, and have determined by visual inspection that the survey data provided is representative of actual site conditions and is true and correct to the best of my knowledge and belief. This certification is submitted in support of a request for Release of Financial Guaranty.

The record information presented herein is not necessarily complete and intended only to verify substantial compliance of the grading and drainage aspects of this project. Those relying on this record information are advised to obtain independent verification of its accuracy before using it for any other purpose.

Diane Horton
Diane Horton, NME 11887
Date 3/1/04



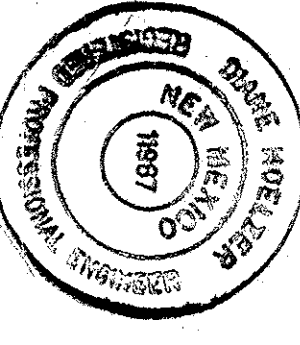



SURVEY INFORMATION			BENCH MARKS		AS BUILT INFORMATION	
FIELD NOTES						
NO.	BY	DATE			CONTRACTOR	DATE
			STATION "NAA-3" IS LOCATED 3.3 MILES NORTHEAST OF DOWNTOWN ALBUQUERQUE, ON THE WEST SIDE OF THE NORTH DIVERSION CHANNEL, ABOUT 0.5 MILES NORTH OF OSUNA ROAD. THE STATION MARK IS A STANDARD BRASS TABLET (AMARCA RIGHT-OF-WAY) MARKER STAMPED "NAA-3", SET IN CONCRETE, PROJECTING 0.3 FT. X = 783,902.31 Y = 1,513,713.15 ELEV. = 3075.6 (NAD 1927 / SLD 1929).		WORK STAKED BY	DATE
					INSPECTOR'S ACCEPTANCE BY	DATE
					FIELD VERIFICATION BY	DATE
					DRAWINGS CORRECTED BY	DATE
					MICRO-FILM INFORMATION	
					RECORDED BY	DATE
					HO.	

REVISIONS		BY	
NO.	DATE		
DESIGN			
DESIGNED BY	DLH	DATE	12/01
DRAWN BY	NHM	DATE	12/01
CHECKED BY	DWG	DATE	12/01

CITY OF ALBUQUERQUE
PUBLIC WORKS DEPARTMENT
PASEO DE ESTRELLA (SOUTH) GRADING & DRAINAGE PLAN
DATE: MAR 02 2004
F.O. BOX 90606
ALBUQUERQUE, NEW MEXICO 87199
(505) 626-2200 FAX (505) 737-9539

CITY PROJECT NO.	687181	ZONE MAP NO.	D-16	SHEET	6	OF	23
DESIGN REVIEW COMMITTEE	CITY ENGINEER APPROVAL	LAST DESIGN UPDATE	NO. DATE	NO. DATE	NO. DATE	NO. DATE	NO. DATE

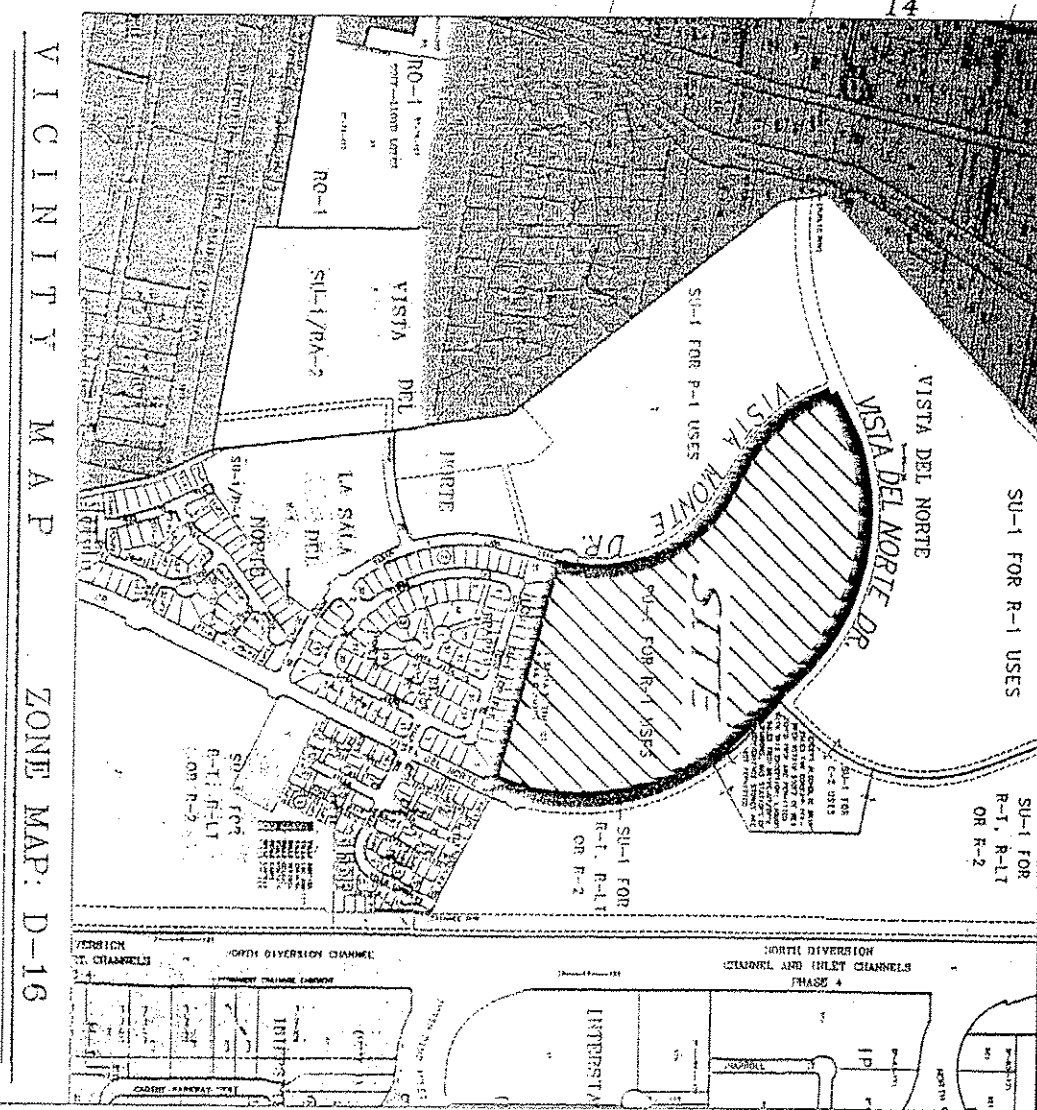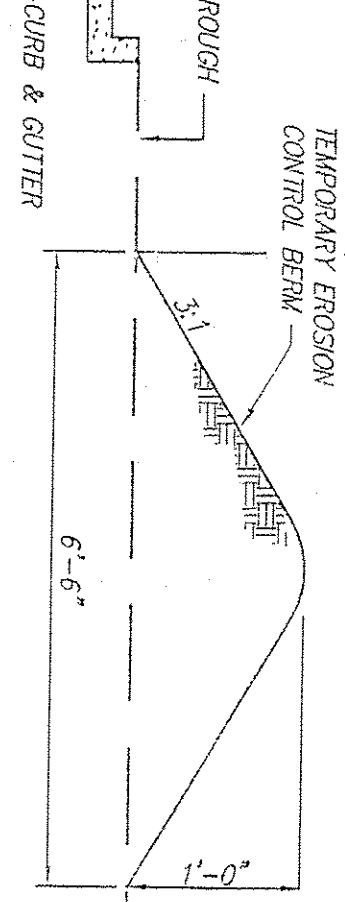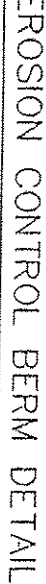

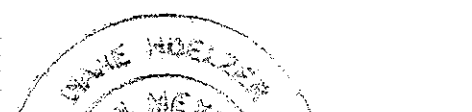				ENGINEER'S SEAL		SURVEY INFORMATION			BENCH MARKS			AS BUILT INFORMATION			
						FIELD NOTES			STATION "NAA-8" IS LOCATED 3.0 MILES NORTHEAST OF DOWNTOWN ALBUQUERQUE, ON THE WEST SIDE OF THE NORTH DIVERSION CHANNEL, ABOUT 0.5 MILES NORTH OF OSUNA ROAD. THE STATION MARK IS A STANDARD BRASS TABLET (AMAFCA RIGHT-OF-WAY MARKER) STAMPED "NAA-8", SET IN CONCRETE, PROJECTING 0.3 FT. X = 393,902.61 Y = 1,513,713.15 ELEV. = 5075.6 (NAD 1927 / SLD 1929).			CONTRACTOR			
NO.		BY				DATE		WORK STAKED BY				DATE			
								INSPECTOR'S ACCEPTANCE BY				DATE			
								FIELD VERIFICATION BY				DATE			
								DRAWINGS CORRECTED BY				DATE			
NO.		DATE		REMARKS		BY									
				REVISIONS											
				DESIGN							MICRO-FILM INFORMATION				
DESIGNED BY		DLH		DATE		12/01					RECORDED BY				
DRAWN BY		NHM		DATE		12/01					DATE				
CHECKED BY		DMG		DATE		12/01									

cmg
MARK GOODMAN & ASSOCIATES, P.A.
CONSULTING ENGINEERS
P.O. BOX 90606
ALBUQUERQUE, NEW MEXICO 87169
(505) 828-2200, FAX (505) 797-9539

PUBLIC WORKS DEPARTMENT

VISTA ESTRELLA (South) (in Vista del Norte)
GRADING & DRAINAGE PLAN

DESIGN REVIEW COMMITTEE	CITY ENGINEER APPROVAL
-------------------------	------------------------

CITY PROJECT NO. 607404

HYDROLOGY DEPARTMENT APPROVAL

A1138/A1138-GD50

Feb. 25, 2002

DATE _____

01-30-02 NHM

A1138/A1138-GD50-A.DWG/ 01-30-02 NHM

A1138/A1138-GD50
















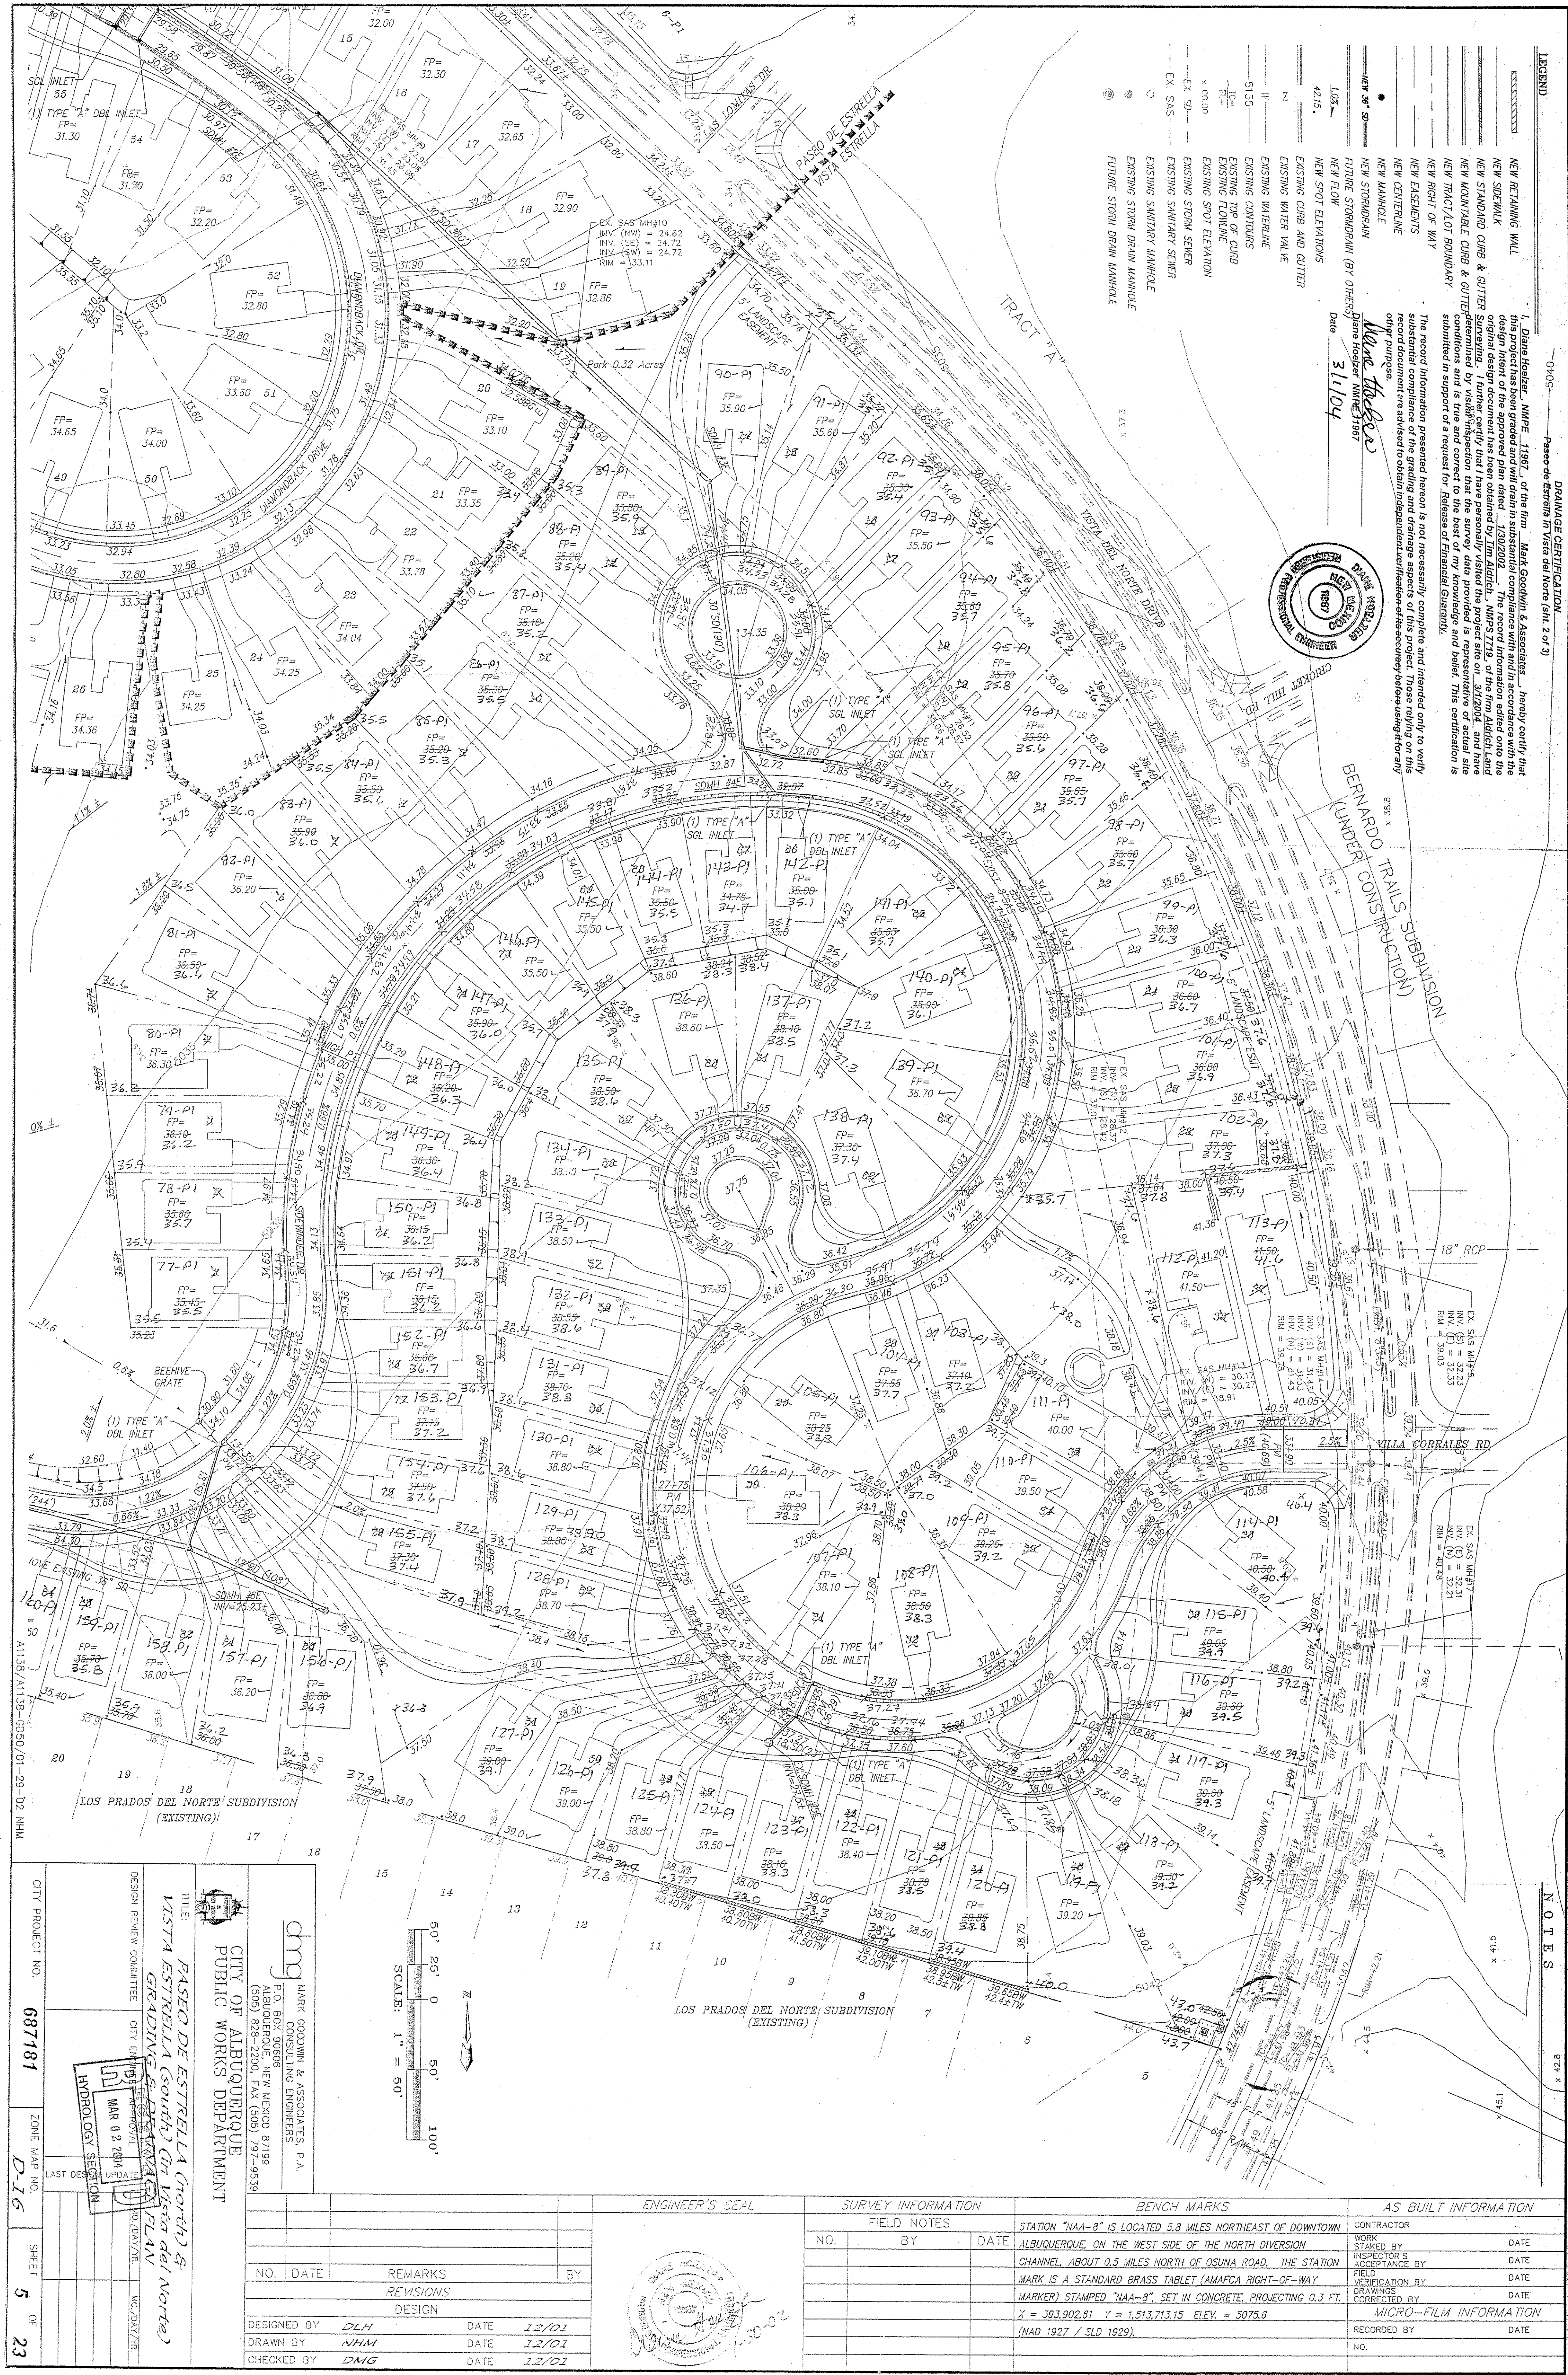

LEGEND

- NEW RETAINING WALL
- NEW SIDEWALK
- NEW STANDING CURB & GUTTER
- NEW STANDING CURB & GUTTER
- NEW TRACT LOT BOUNDARY
- NEW RIGHT OF WAY
- NEW EASEMENTS
- NEW CENTERLINE
- NEW MANHOLE
- NEW STORMDRAIN (BY OTHERS)
- NEW FLOW
- NEW 30" ELEVATIONS
- EXISTING CURB AND GUTTER
- EXISTING WATER VALVE
- EXISTING WATERLINE
- EXISTING CONTROLS
- EXISTING TOP OF CURB
- EXISTING FLOWLINE
- EXISTING SPOT ELEVATION
- EXISTING STORM SEWER
- EXISTING SANITARY SEWER
- EXISTING SANITARY MANHOLE
- EXISTING STORM DRAIN MANHOLE
- FUTURE STORM DRAIN MANHOLE

0405

Drainage Certification

Passo de Estrella in Vista del Norte (sh. 2019)

1. Diane Hodel, N.M.P.E. 11951, of the firm Mark Goodwin & Associates, hereby certify that this project has been graded and will drain in substantial compliance with and in accordance with the design intent of the approved plan dated 1/30/02. The record information edited onto the original design document has been obtained by Tim Aldrich, N.M.P.E. 1719, of the firm Aldrich Land Surveying, Inc. and that I have personally visited the project site on 3/12/04, and have reviewed the record information and the original design document. I am a duly licensed Professional Engineer in the State of New Mexico and I am a duly licensed Professional Engineer in the State of New Mexico. This certification is submitted in support of a request for Release of Financial Liability.

The record information presented herein is not necessarily complete and intended only to verify substantial compliance of the grading and drainage aspects of this project. Those relying on this record information are advised to obtain independent verification of its accuracy before using for any other purpose.

Plane Table No. 1187

Date 3/1/04

NOTES

8 2/4 x

1 5/4 x

CITY PROJECT NO.	687181	ZONE MAP NO.	D-16	SHEET	5	OF	23
TITLE: PASO DE ESTRELLA (South) City Vista del Norte							
GRADING & DRAINAGE PLAN							
DESIGN REVIEW COMMITTEE							
CITY ENGINEER							
CITY CLERK							
CITY MANAGER							
CITY COMMISSIONER							
CITY COUNCIL							
CITY DEPARTMENT							
