HYDROLOGY

D17/D3E
2 PLANS

D17/D3E

2 PLANS

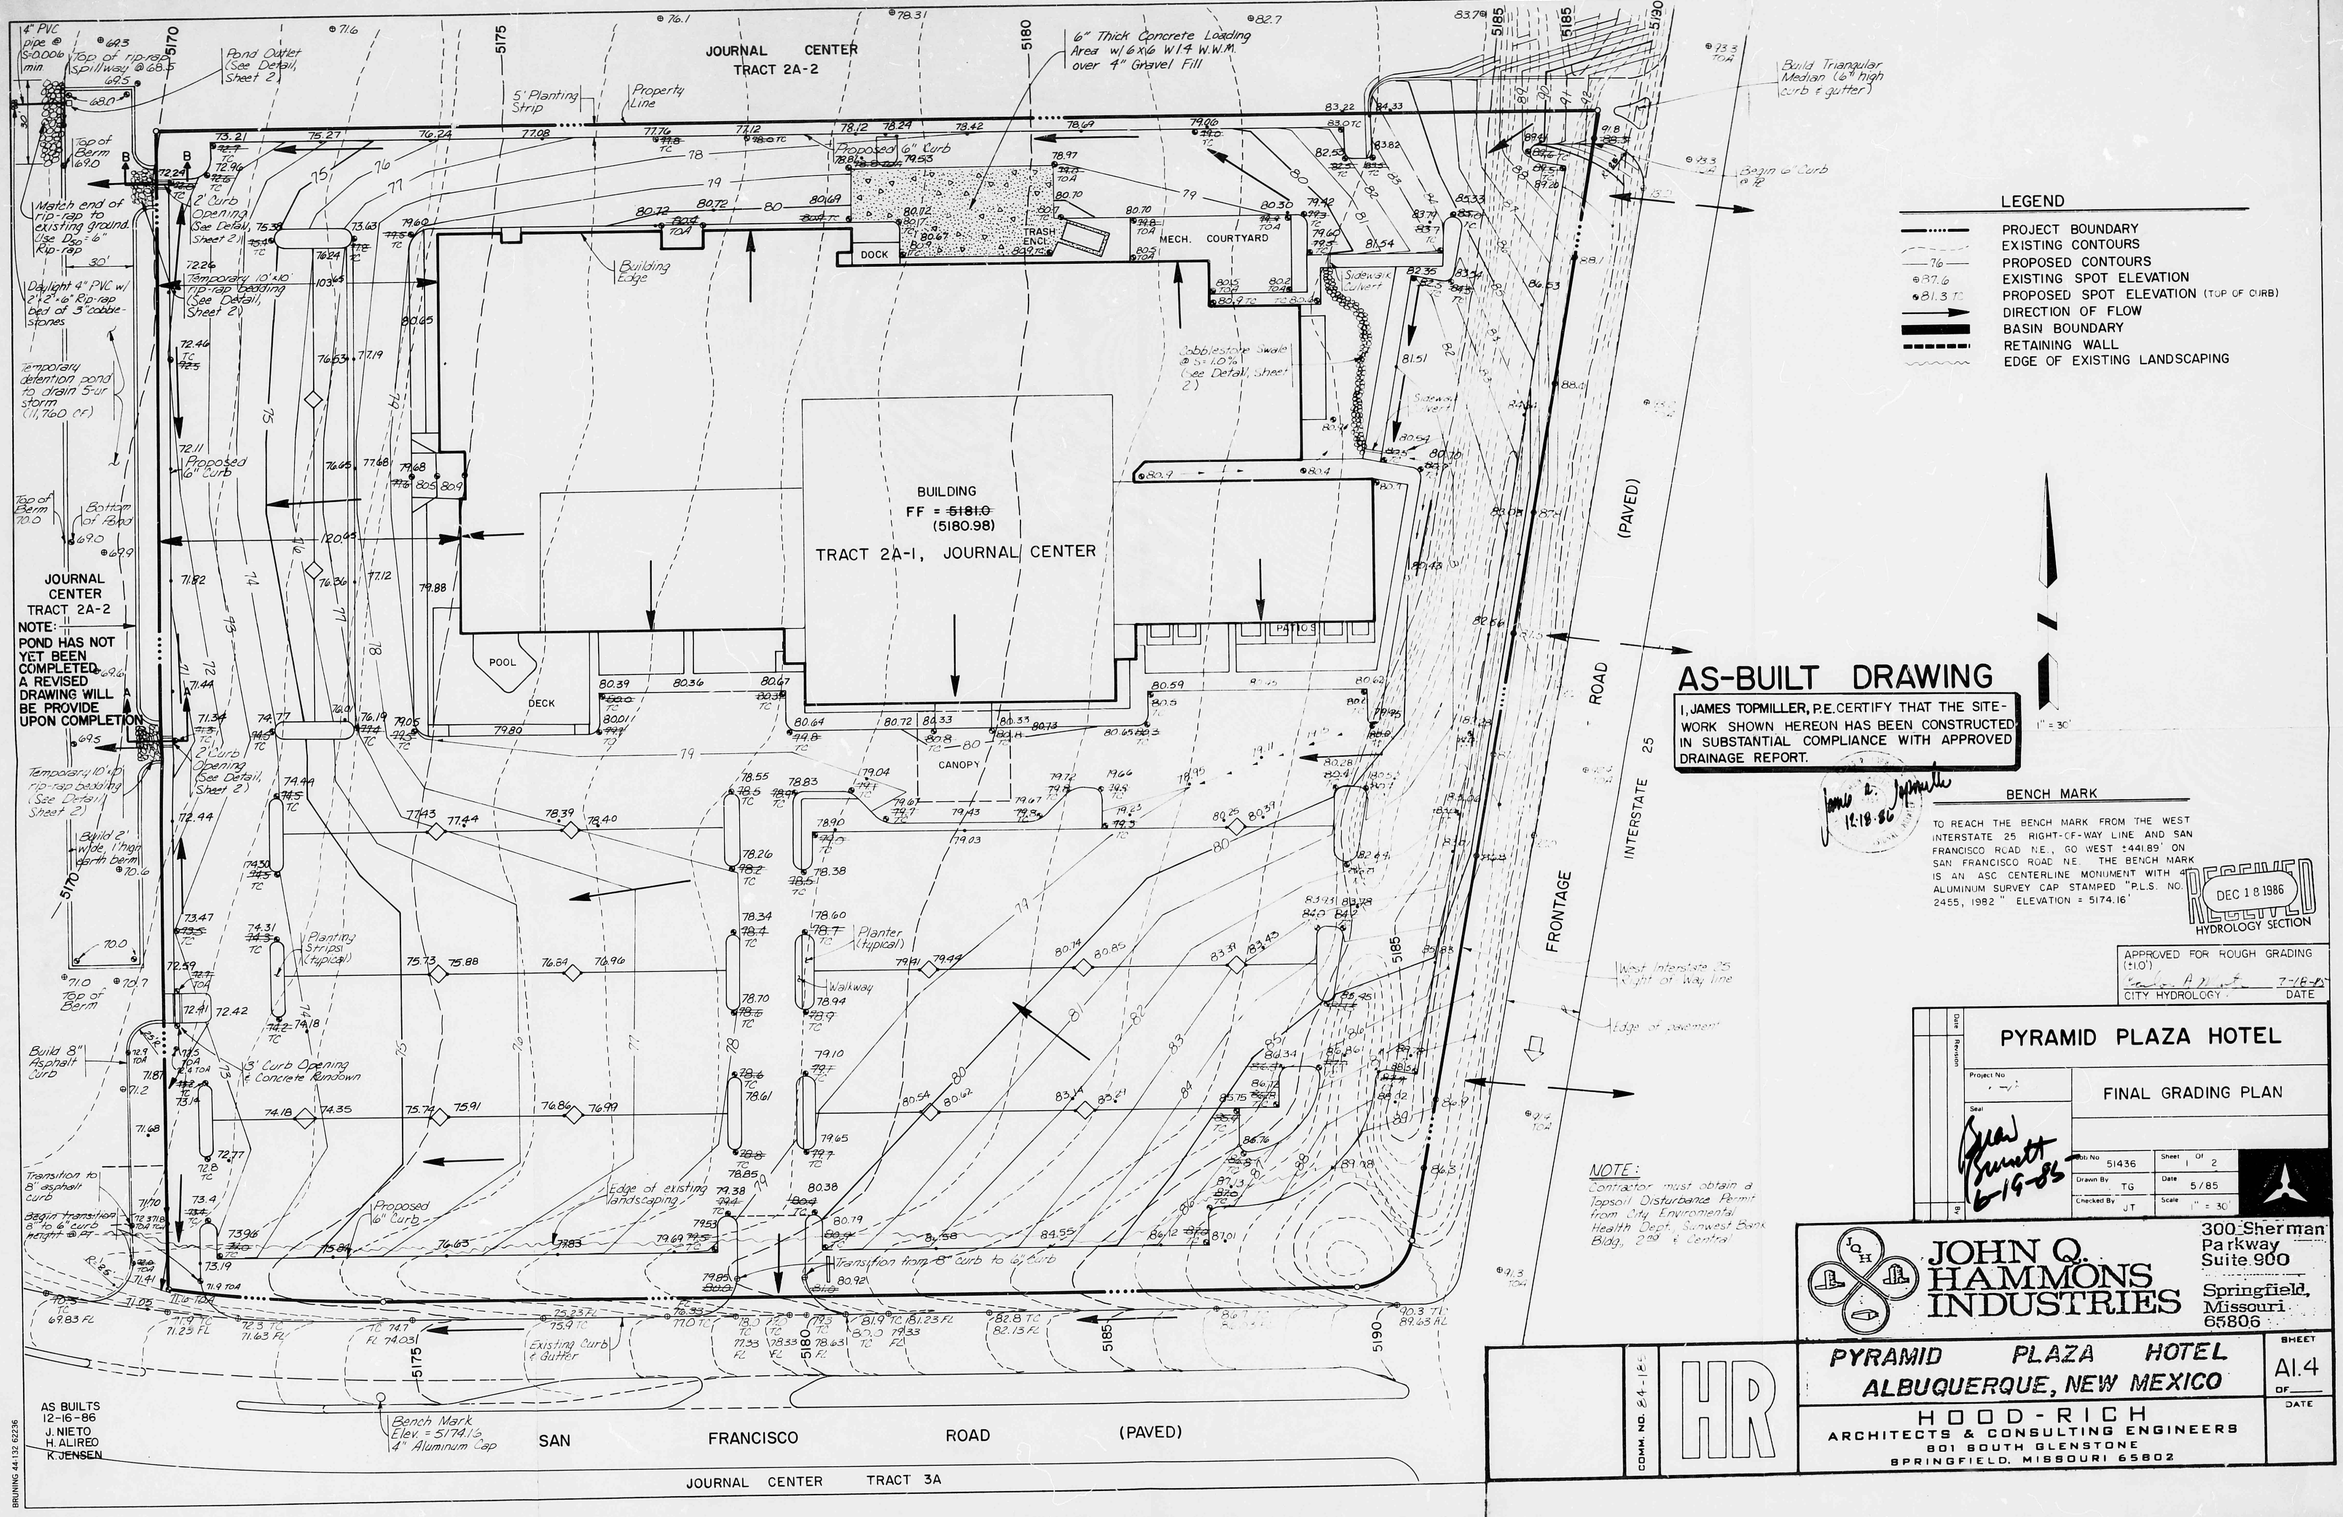

LEGEND

- PROJECT BOUNDARY
- EXISTING CONTOURS
- PROPOSED CONTOURS
- EXISTING SPOT ELEVATION
- PROPOSED SPOT ELEVATION (TOP OF CURB)
- DIRECTION OF FLOW
- BASIN BOUNDARY
- RETAINING WALL
- EDGE OF EXISTING LANDSCAPING

1" = 30'

AS-BUILT DRAWING

I, JAMES TOPMILLER, P.E. CERTIFY THAT THE SITE-WORK SHOWN HEREON HAS BEEN CONSTRUCTED IN SUBSTANTIAL COMPLIANCE WITH APPROVED DRAINAGE REPORT.

James E. Topmiller 12-18-86

BENCH MARK

TO REACH THE BENCH MARK FROM THE WEST INTERSTATE 25 RIGHT-OF-WAY LINE AND SAN FRANCISCO ROAD N.E., GO WEST ±441.89' ON SAN FRANCISCO ROAD N.E. THE BENCH MARK IS AN ASC CENTERLINE MONUMENT WITH 4" ALUMINUM SURVEY CAP STAMPED "P.L.S. NO. 2455, 1982" ELEVATION = 5174.16'

RECEIVED DEC 18 1986 HYDROLOGY SECTION

APPROVED FOR ROUGH GRADING (±1.0')
CITY HYDROLOGY — DATE 7-18-85

Date	Revision	By

PYRAMID PLAZA HOTEL

FINAL GRADING PLAN

Project No.
Seal: Glen Summitt 6-19-85

Job No.	51436	Sheet	1 Of 2
Drawn By	TG	Date	5/85
Checked By	JT	Scale	1" = 30'

JOHN Q. HAMMONS INDUSTRIES
300 Sherman Parkway
Suite 900
Springfield, Missouri 65806


HR

PYRAMID PLAZA HOTEL
ALBUQUERQUE, NEW MEXICO

HOOD-RICH
ARCHITECTS & CONSULTING ENGINEERS
801 SOUTH GLENSTONE
SPRINGFIELD, MISSOURI 65802

SHEET A1.4 OF ___ DATE

NOTE: Contractor must obtain a Topsoil Disturbance Permit from City Enviromental Health Dept., Sunwest Bank Bldg., 2nd & Central

BRUNING 44-132 62236

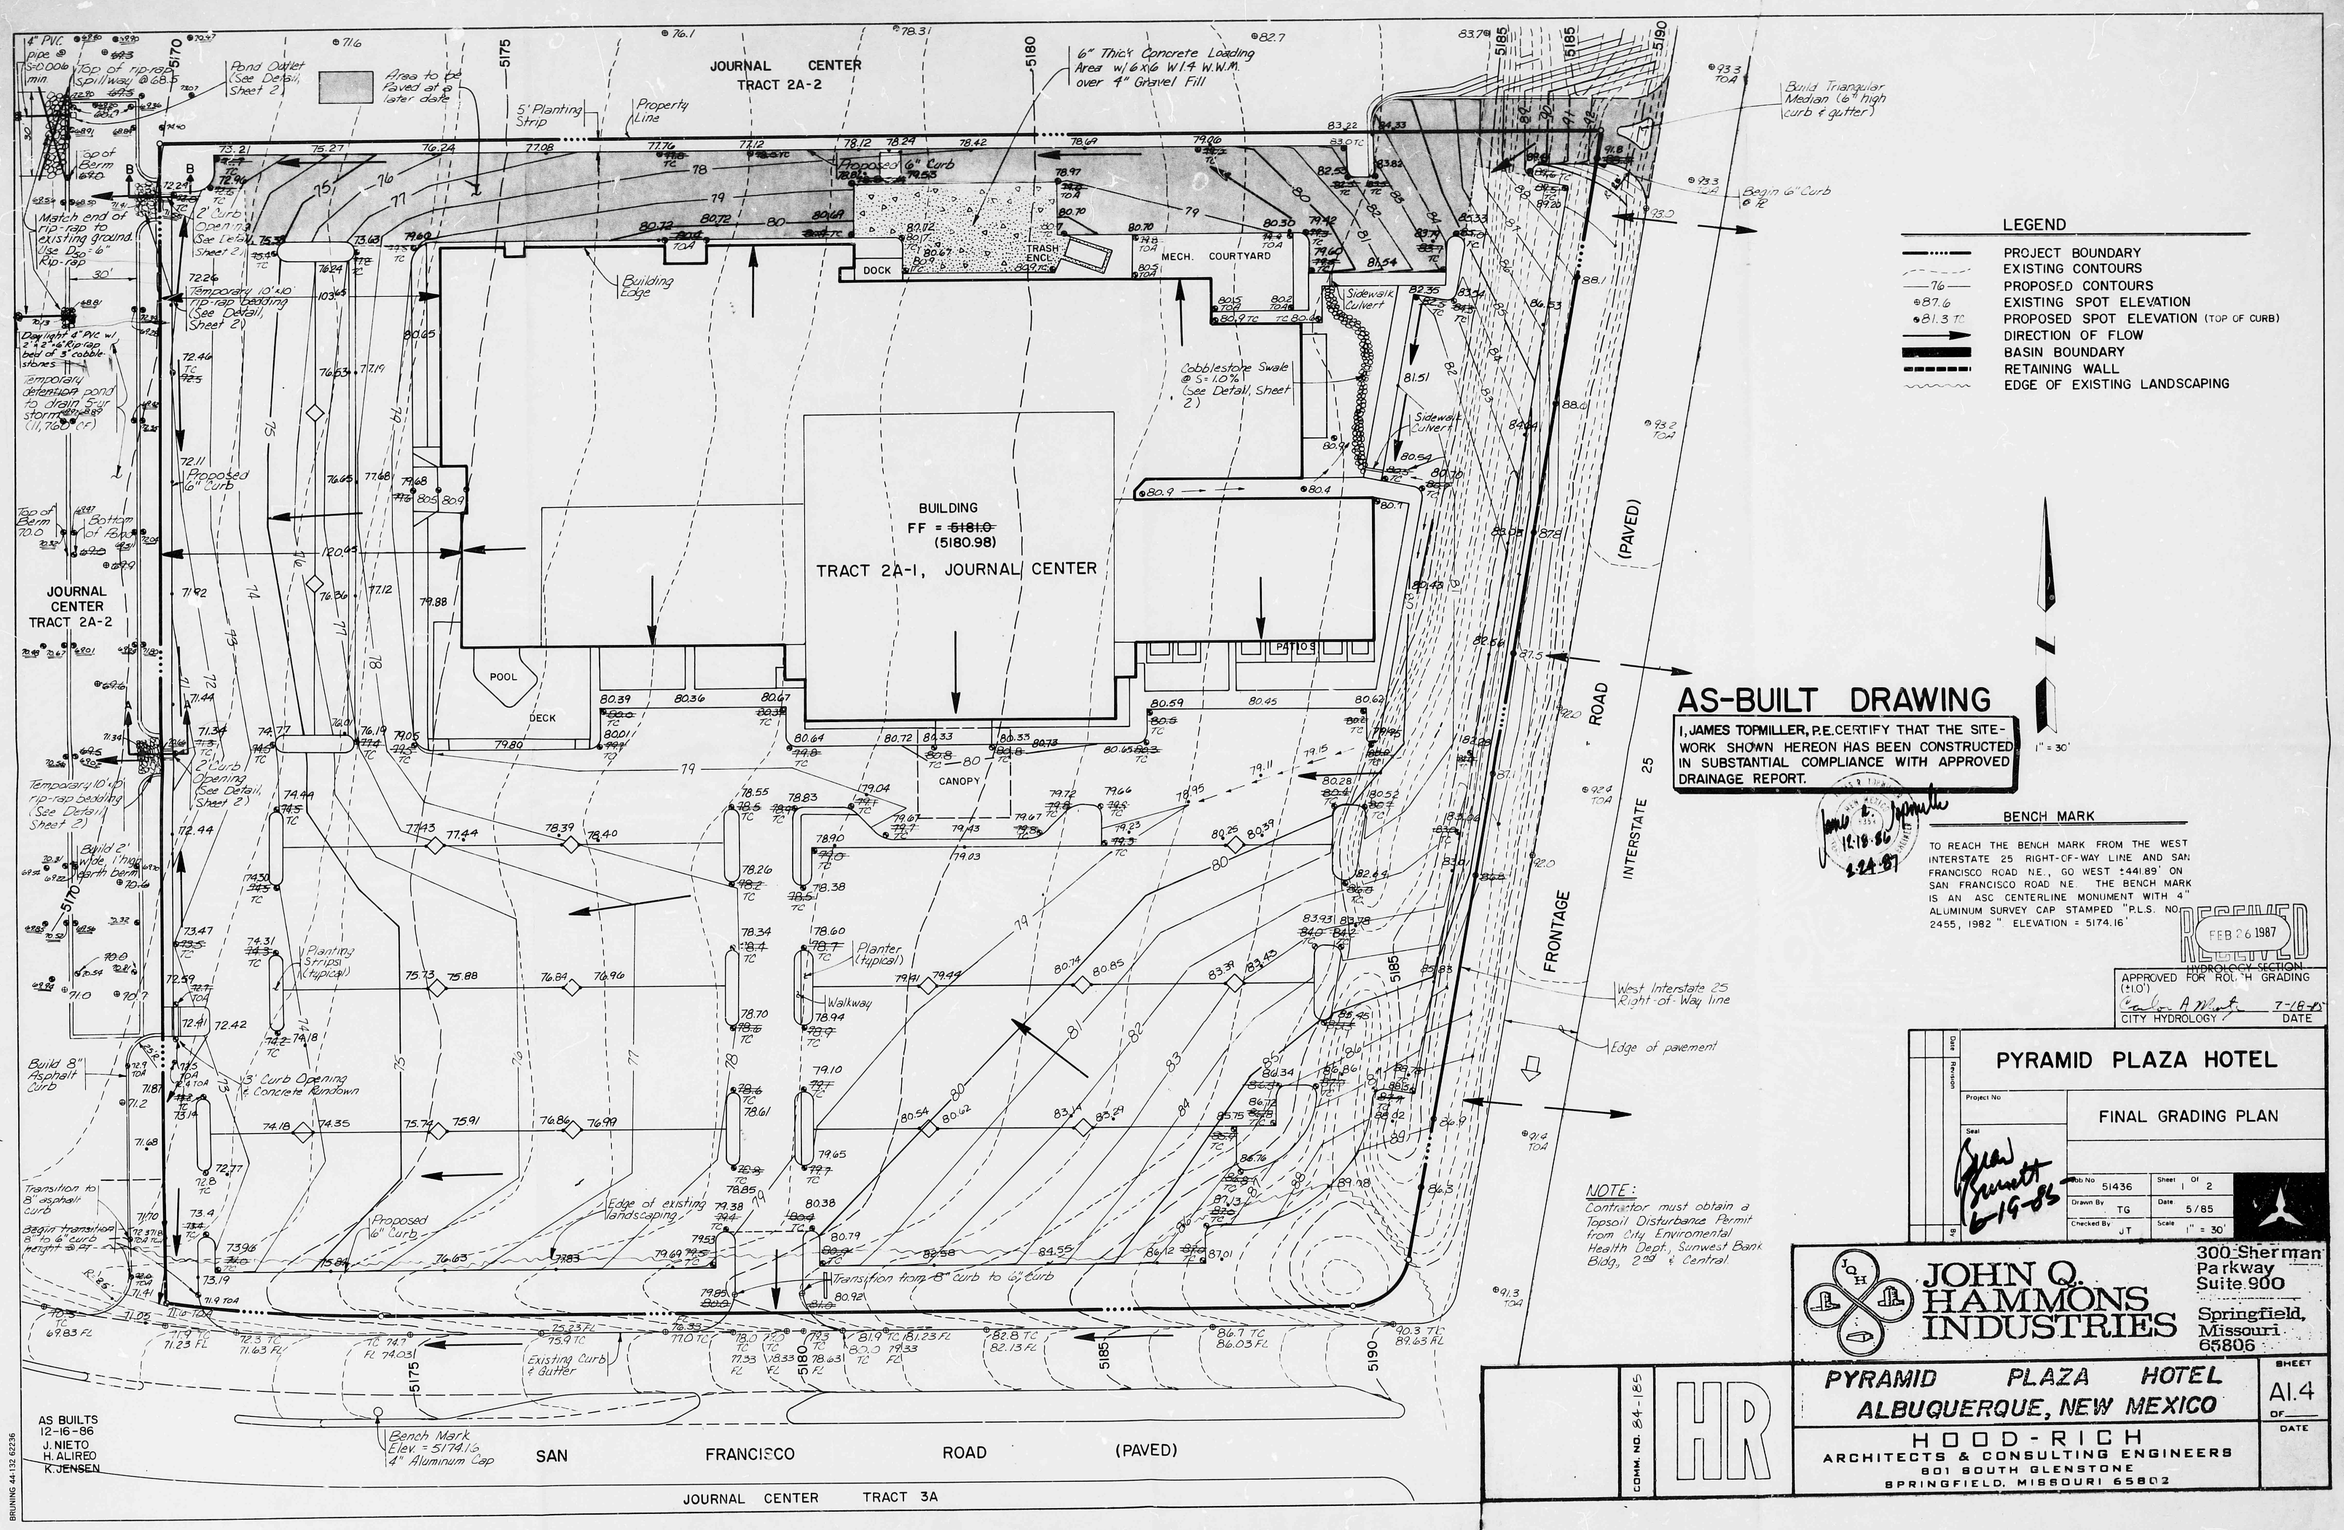

LEGEND

- PROJECT BOUNDARY
- EXISTING CONTOURS
- PROPOSED CONTOURS
- EXISTING SPOT ELEVATION
- PROPOSED SPOT ELEVATION (TOP OF CURB)
- DIRECTION OF FLOW
- BASIN BOUNDARY
- RETAINING WALL
- EDGE OF EXISTING LANDSCAPING

1" = 30'

AS-BUILT DRAWING

I, JAMES TOPMILLER, P.E. CERTIFY THAT THE SITE-WORK SHOWN HEREON HAS BEEN CONSTRUCTED IN SUBSTANTIAL COMPLIANCE WITH APPROVED DRAINAGE REPORT.

12-19-86
1-24-87

BENCH MARK

TO REACH THE BENCH MARK FROM THE WEST INTERSTATE 25 RIGHT-OF-WAY LINE AND SAN FRANCISCO ROAD N.E., GO WEST ±441.89' ON SAN FRANCISCO ROAD N.E. THE BENCH MARK IS AN ASC CENTERLINE MONUMENT WITH 4" ALUMINUM SURVEY CAP STAMPED "P.L.S. NO. 2455, 1982" ELEVATION = 5174.16'

RECEIVED FEB 26 1987 HYDROLOGY SECTION

APPROVED FOR ROUGH GRADING (±1.0)
CITY HYDROLOGY — DATE 7-18-85

NOTE: Contractor must obtain a Topsoil Disturbance Permit from City Enviromental Health Dept., Sunwest Bank Bldg., 2nd & Central

Date	Revision

PYRAMID PLAZA HOTEL

Project No

FINAL GRADING PLAN

Seal

6-19-85

Job No	51436	Sheet	1 Of 2
Drawn By	TG	Date	5/85
Checked By	JT	Scale	1" = 30'

JOHN Q. HAMMONS INDUSTRIES
300 Sherman Parkway Suite 900
Springfield, Missouri 65806

COMM. NO. 84-185

HR

PYRAMID PLAZA HOTEL
ALBUQUERQUE, NEW MEXICO

HOOD-RICH
ARCHITECTS & CONSULTING ENGINEERS
801 SOUTH GLENSTONE
SPRINGFIELD, MISSOURI 65802

SHEET A1.4 OF ___ DATE