HYDROLOGY D17/D17A

1 PLAN

PLAN

BODY SHOP ADDITION
MUNOZ

D17 - D17A

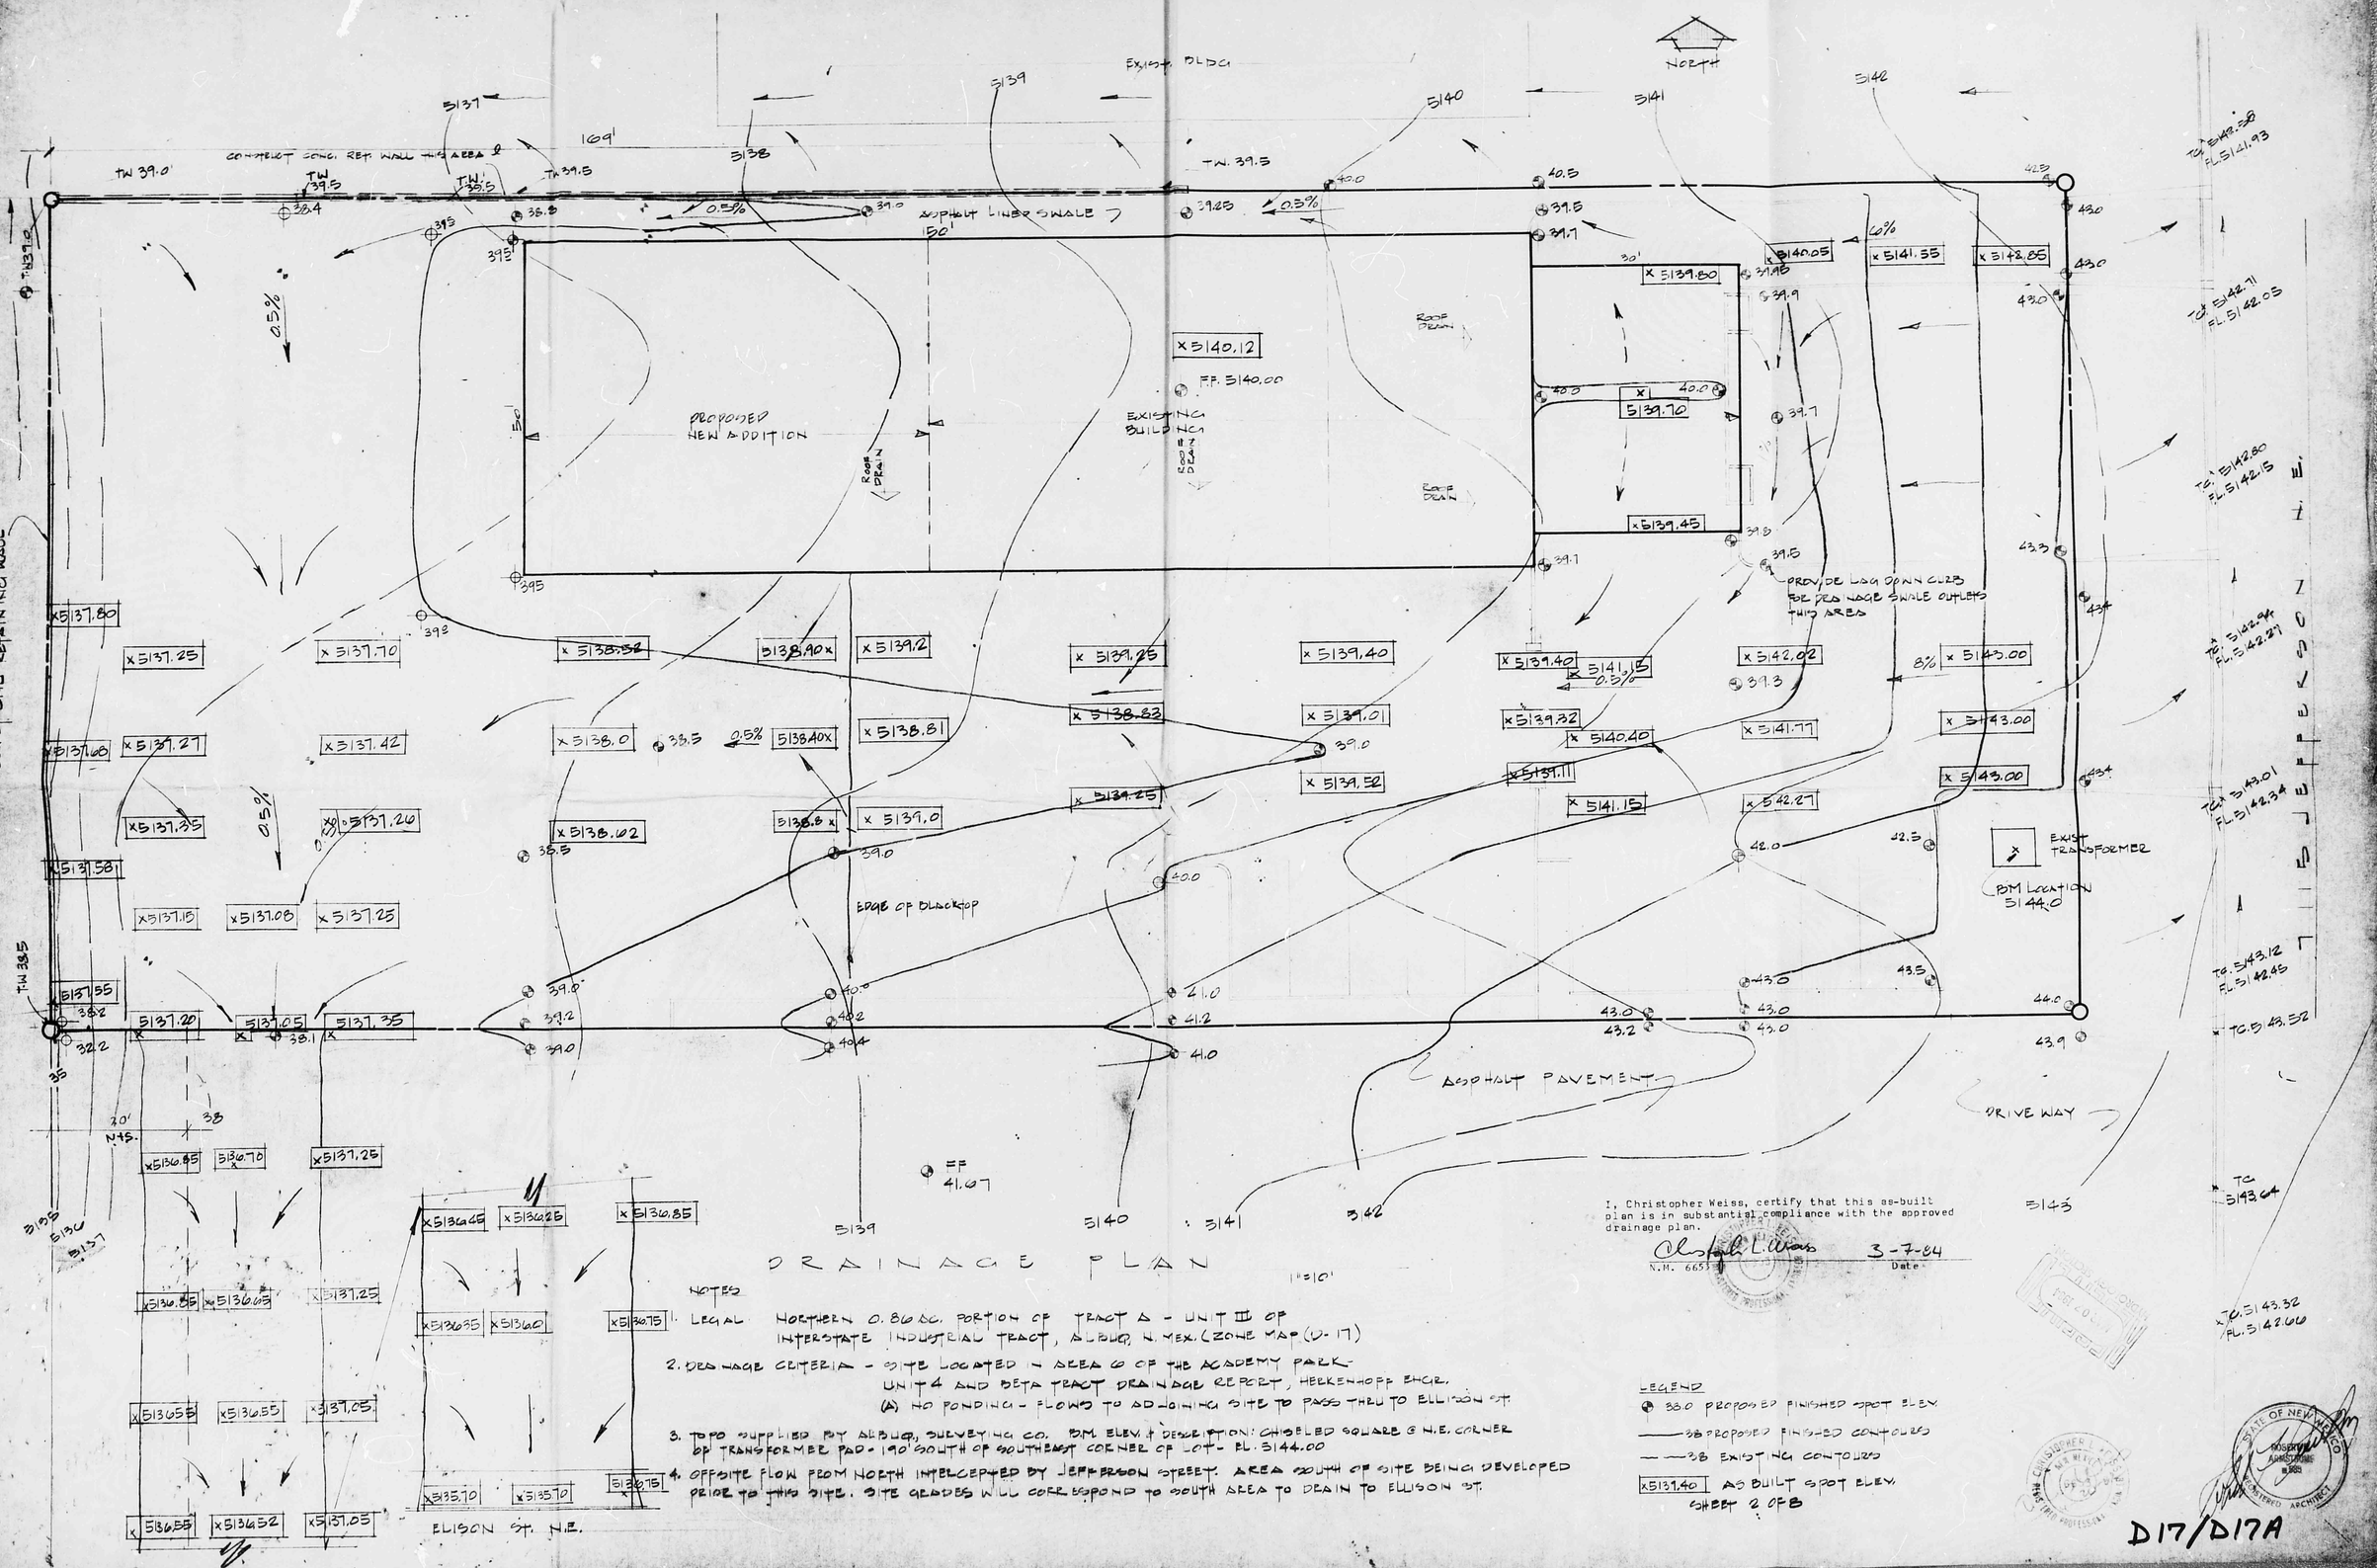

NOTES

1. LEGAL NORTHERN 0.86 AC. PORTION OF TRACT A - UNIT III OF INTERSTATE INDUSTRIAL TRACT, ALBUQ. N. MEX. (ZONE MAP (V-17)
2. DRAINAGE CRITERIA - SITE LOCATED IN AREA G OF THE ACADEMY PARK UNIT 4 AND BETA TRACT DRAINAGE REPORT, HERKENHOFF ENGR.
   (A) NO PONDING - FLOWS TO ADJOINING SITE TO PASS THRU TO ELLISON ST.
3. TOPO SUPPLIED BY ALBUQ. SURVEYING CO. B.M. ELEV. & DESCRIPTION: CHISELED SQUARE @ N.E. CORNER OF TRANSFORMER PAD - 190' SOUTH OF SOUTHEAST CORNER OF LOT - EL. 5144.00
4. OFFSITE FLOW FROM NORTH INTERCEPTED BY JEFFERSON STREET. AREA SOUTH OF SITE BEING DEVELOPED PRIOR TO THIS SITE. SITE GRADES WILL CORRESPOND TO SOUTH AREA TO DRAIN TO ELLISON ST.

I, Christopher Weiss, certify that this as-built plan is in substantial compliance with the approved drainage plan.

Christopher L. Weiss 3-7-84
N.M. 6651 Date

LEGEND

- 38.0 PROPOSED FINISHED SPOT ELEV.
- 38 PROPOSED FINISHED CONTOURS
- 38 EXISTING CONTOURS
- x5131.40 AS BUILT SPOT ELEV.

SHEET 2 OF 8

D17/D17A