HYDROLOGY D18/D18 STORAGE UNIT

D18 / D18

STORAGE UNIT

1 PLAN

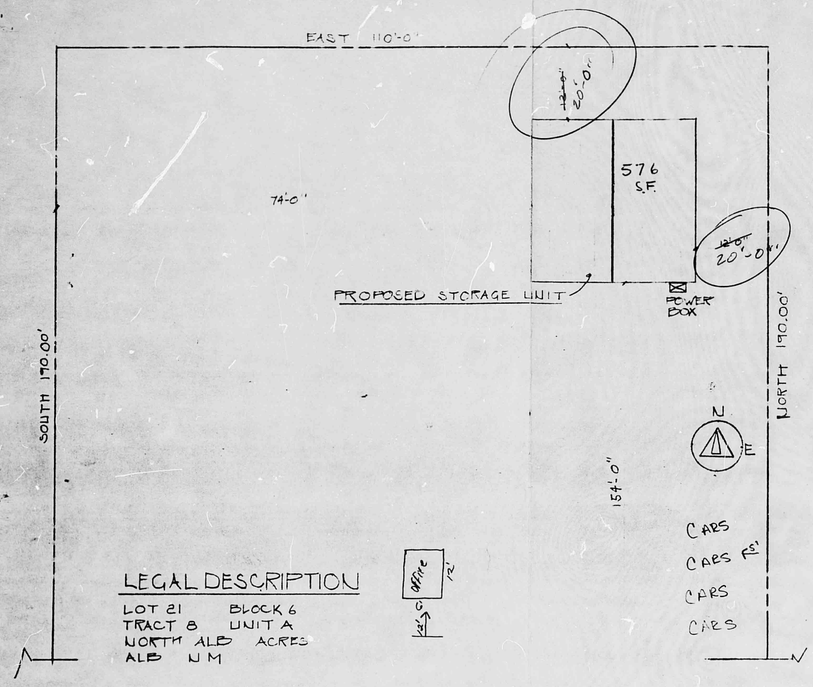

PLOT PLAN 3/32" = 1'-0"

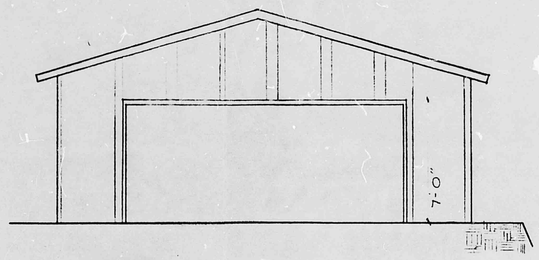

[redacted] ELEVATION 1/4" = 1'-0"
SOUTH

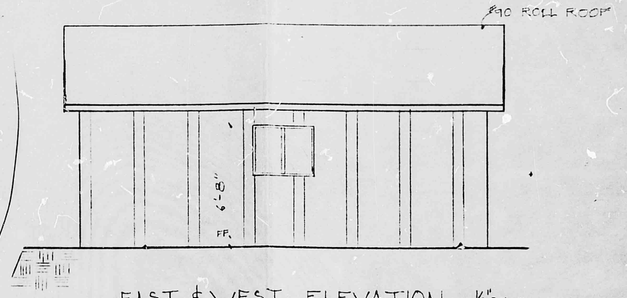

EAST & WEST ELEVATION 1/4" = 1'-0"

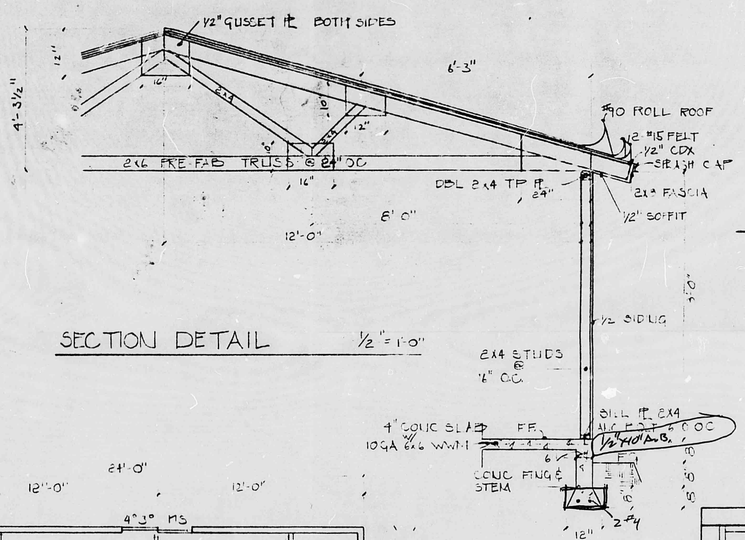

SECTION DETAIL 1/2" = 1'-0"

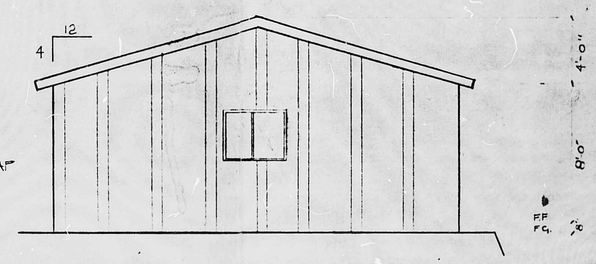

NORTH ELEVATION 1/4" = 1'-0"

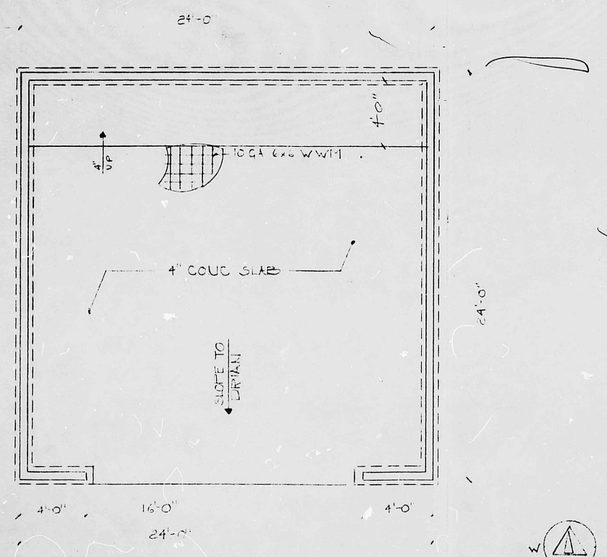

FOUNDATION PLAN 1/4" = 1'-0"

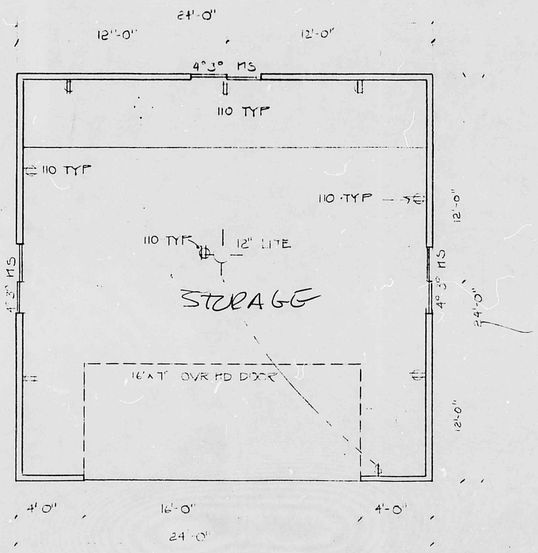

FLOOR PLAN 1/4" = 1'-0"

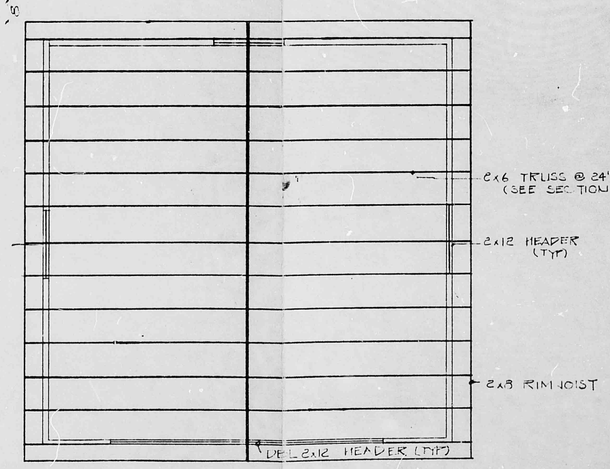

ROOF FRAMING PLAN 1/4" = 1'-0"

RECEIVED
JUL 30 1985
HYDROLOGY SECTION

ALBUQUERQUE
BLDG. DEPT.
JUN 10 1985
U.B.C.
PLAN CHECK
SECTION

2-CAR
GARAGE
576 □ UNHEATED