PUBLIC WORKS/HYDROLOGY

D21/D2

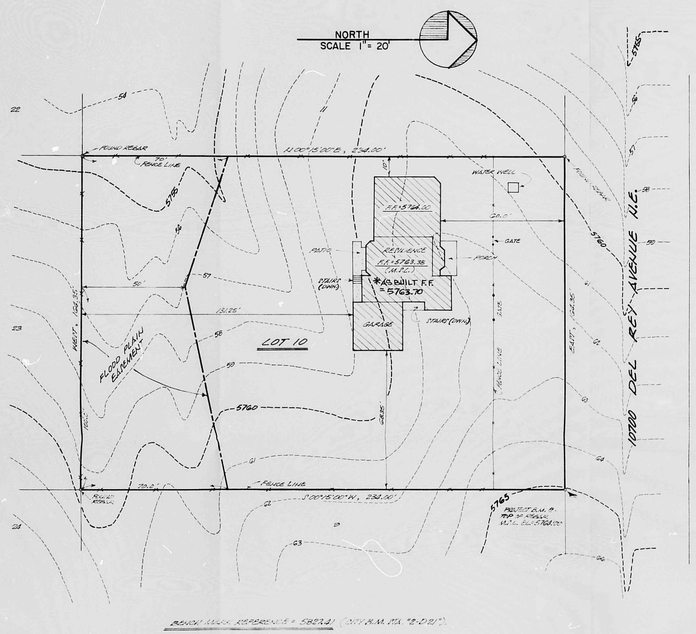

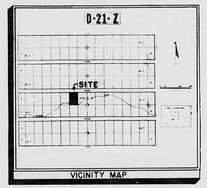

SURVEYOR'S CERTIFICATION:

I, JOHN B. TORRES, NEW MEXICO PROFESSIONAL LAND SURVEYOR NO. 3221, LICENSED AND REGISTERED UNDER THE LAWS OF THE STATE OF NEW MEXICO, DO HEREBY CERTIFY THAT THIS SURVEY WAS PREPARED BY ME OR UNDER MY SUPERVISION AND DIRECTION; AND THAT THE SAME IS TRUE AND CORRECT TO THE BEST OF MY BELIEF AND KNOWLEDGE.

JOHN B. TORRES, N.M.R.P.L.S. NO. 3221

NEW MEXICO PROFESSIONAL SURVEYOR NO. 3221

NOTE: FINISH FLOOR ELEVATION
(REVISED FEBRUARY 02, 1988)

* DESIGNED FLOOR ELEVATION = 5763.36

** AS-BUILT FLOOR ELEVATION = 5763.70

RECEIVED
FEB 02 1988
HYDROLOGY SECTION

GENERAL NOTES:

1.) TOPOGRAPHY SURVEY OBTAINED BY "TRANSIT-STADIA" METHOD.

2.) NO SEARCH HAS BEEN MADE FOR EASEMENTS OF RECORD WITHIN THE SUBJECT PROPERTY OTHER THAN THOSE SHOWN ON THE PLAT OF RECORD.

3.) NO PROPERTY CORNERS HAVE BEEN SET PER THIS SURVEY.

LEGAL DESCRIPTION

LOT NUMBERED TEN (10) IN BLOCK NUMBERED SEVENTEEN (17), TRACT NUMBERED THREE (3), UNIT NUMBERED TWO (2), NORTH ALBUQUERQUE ACRES, AS THE SAME IS SHOWN AND DESIGNATED ON THE PLAT THEREOF, FILED IN THE OFFICE OF THE COUNTY CLERK OF BERNALILLO COUNTY, NEW MEXICO, ON JUNE 8, 1931.

CERTIFICATION
OF
FLOODPLAIN SURVEY MAP
LOT 10, BLOCK 17, UNIT 2, TRACT 3
NORTH ALBUQUERQUE ACRES
BERNALILLO COUNTY, NEW MEXICO
SEPTEMBER, 1987

R# 34 DATE 3-15-02 OP EPP

CITY OF ALBUQUERQUE

This microimage is certified to be a complete and accurate copy of the original as it appears in the files of the **Public Works Department** and was created in the normal course of business.

The photographic process used meets the Basic Microfilm Standards of the National Micrographics Association (MS1A5-1977)

DIRECTOR

NOTARY PUBLIC

OFFICIAL SEAL
Roberta Duran
NOTARY PUBLIC
My Commission Expires
07/07/02

CITY OF ALBUQUERQUE
THIS MICROIMAGE IS THE BEST POSSIBLE REPRODUCTION DUE TO THE POOR QUALITY OF THE ORIGINAL DOCUMENT.

PLANS/PLATS ON FILE

FILE DESC: D21/D2

PLANS/PLATS 1

E 30 D 24 C 20 B 16 A 12

CITY OF ALBUQUERQUE

C D F