Note:
Subbasins contributing to each concentration point have been added together and treated as one subbasin for volume calculations.

WATERSHED MAP - OSUNA WEST END SUBBASINS
SCALE: 1"=600'

SURVEY INFORMATION
BENCH MARKS
FIELD NOTES
NO. BY DATE

AS BUILT INFORMATION
CONTRACTOR
WORK STAKED BY DATE
INSPECTOR'S
FIELD BOOK BY DATE
FIELD
DRAWING BY DATE
CORRECTED BY DATE
MICRO-FILM INFORMATION
RECORDED BY DATE
NO.

ENGINEER'S SEAL

30% REVIEW

PRELIMINARY
NOT FOR CONSTRUCTION
12/31/2010

NO.	DATE	REMARKS	BY
		REVISIONS	
		DESIGN	

DESIGNED BY: DATE:
DRAWN BY: DATE:
CHECKED BY: DATE:

T·Y· LIN INTERNATIONAL
engineers | planners | scientists
500 4th Street NW Suite 403
Bank of America Centre
Albuquerque, NM 87102

CITY OF ALBUQUERQUE
MUNICIPAL DEVELOPMENT DEPARTMENT
ENGINEERING DIVISION

TITLE: OSUNA ROAD WIDENING
DRAINAGE EXHIBIT
WATERSHED MAP

Design Review Committee	City Engineer Approval	Last Design Update	Mo./Day/Yr.	Mo./Day/Yr.

City Project No.	Zone Map No.	Sheet	Of
5575.91	E16, E17	1	1

Q:\221706.00 - Osuna Road City of Albuquerque\CADD\Drainage Exhibits\1706-WATERSHED-BASE.dwg

PROPOSED DRAINAGE BASINS
SCALE: 1"=300'

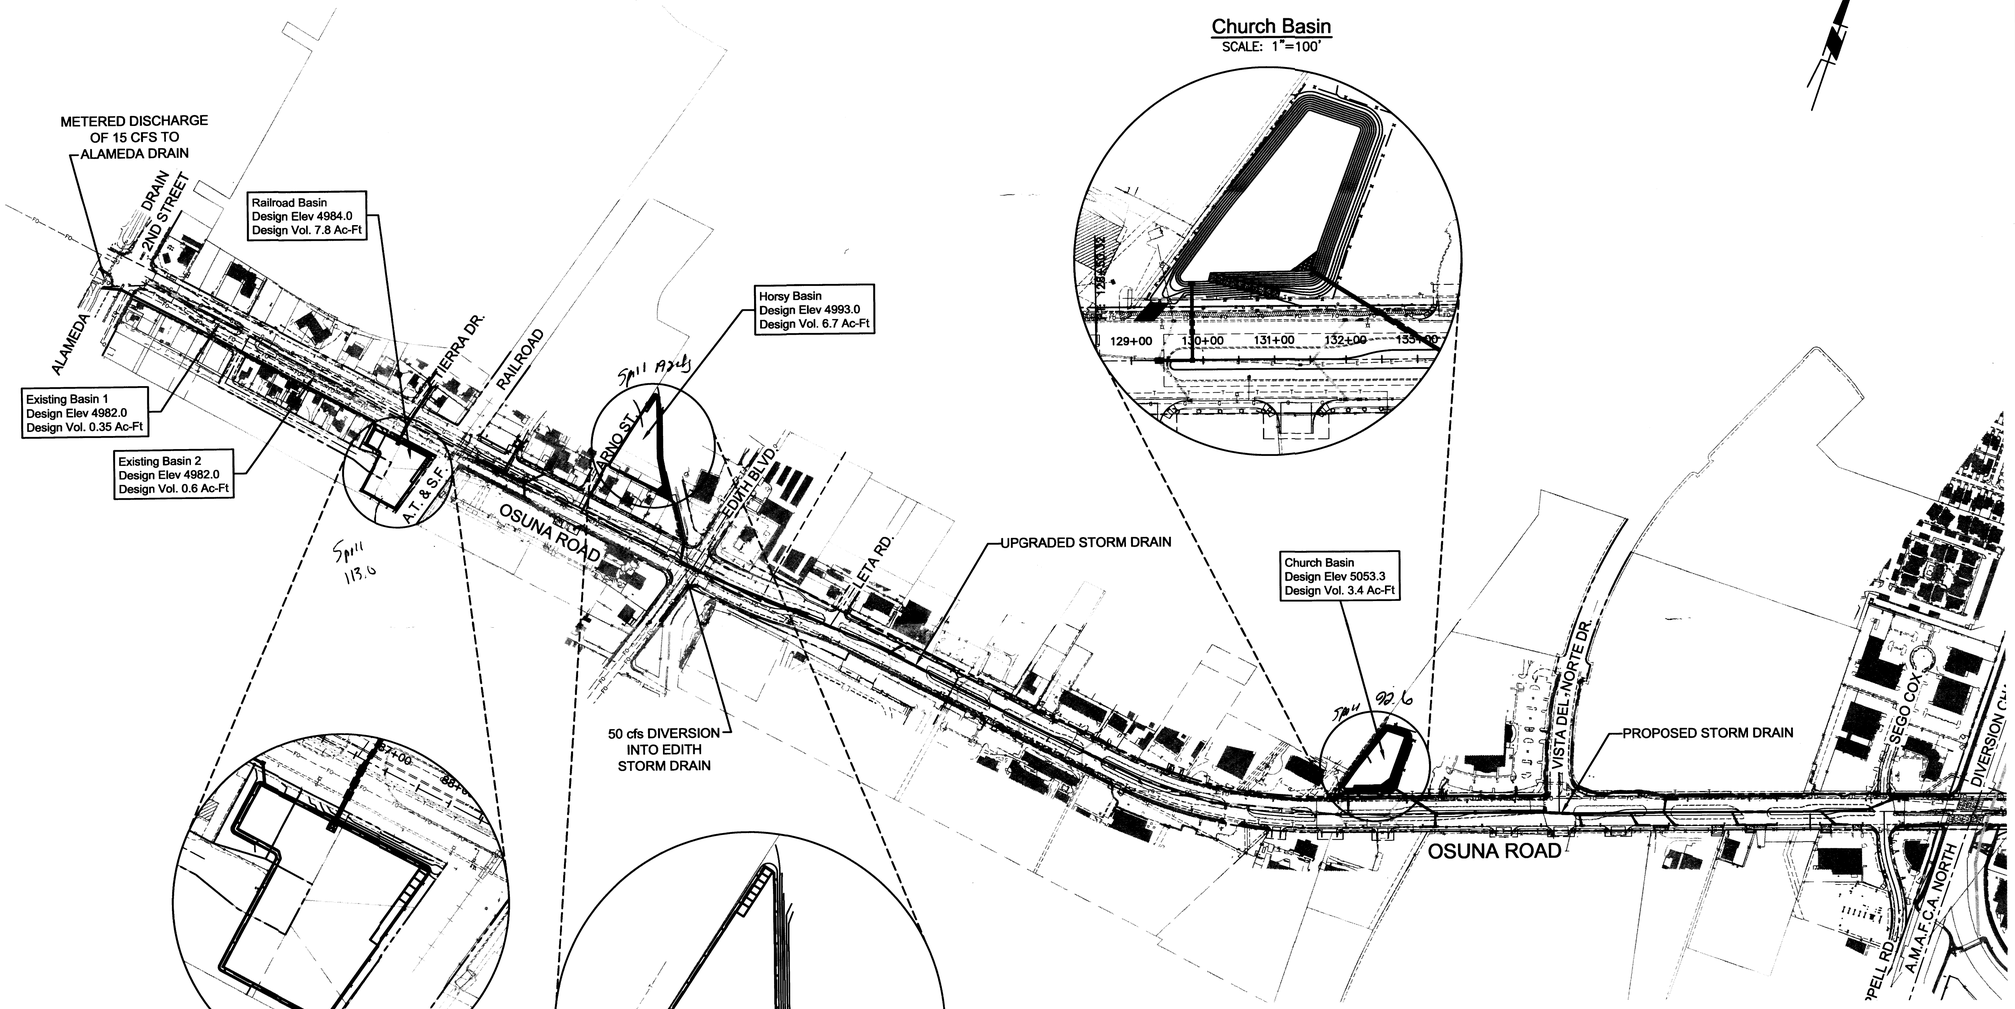

Church Basin
SCALE: 1"=100'

Railroad Basin
SCALE: 1"=100'

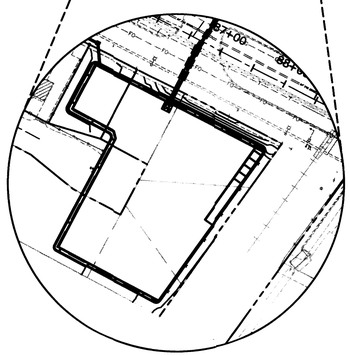

Horsy Basin
SCALE: 1"=100'

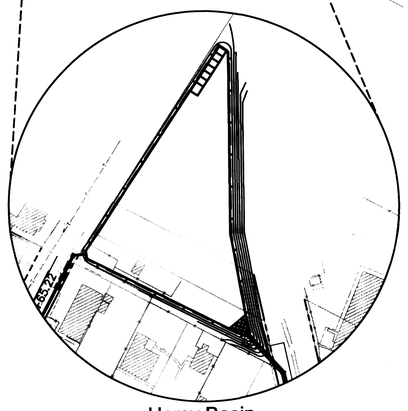

BASIN	INFLOW (CFS)	STORAGE REQUIRED (AC-FT)	STORAGE PROVIDED (AC-FT)
CHURCH	96.6	3.4	5.2
HORSY	192.0	6.7	7.9
RAILROAD	113.0	7.8	8.9

AS BUILT INFORMATION
BENCH MARKS
CONTRACTOR — DATE
WORK STAKED BY — DATE
INSPECTED & ACCEPTANCE BY — DATE
FIELD VERIFICATION BY — DATE
DRAWINGS CORRECTED BY — DATE
MICRO-FILM INFORMATION
RECORDED BY — DATE
NO.

SURVEY INFORMATION
FIELD NOTES
NO. | BY | DATE

ENGINEER'S SEAL

PRELIMINARY
NOT FOR CONSTRUCTION

REMARKS | BY
REVISIONS
DESIGN
NO. | DATE
DESIGNED BY: — DATE: —
DRAWN BY: — DATE: —
CHECKED BY: — DATE: —

T·Y· LIN INTERNATIONAL
engineers | planners | scientists
500 4th Street NW Suite 403
Bank of America Centre
Albuquerque, NM 87102

CITY OF ALBUQUERQUE
MUNICIPAL DEVELOPMENT DEPARTMENT
ENGINEERING DIVISION

TITLE: OSUNA ROAD WIDENING
BASIN LAYOUT
EXHIBIT 5

Design Review Committee	City Engineer Approval	Last Design Update	Mo./Day/Yr.	Mo./Day/Yr.

City Project No. 5575.92 | Zone Map No. E16, E17 | Sheet 1 Of 1

Q:\221706.00 - Osuna Road City of Albuquerque\CADD\Drainage Exhibits\1706-DRAINAGE-EXHIBIT.dwg