HYDROLOGY

E19/D11A
ONE PLAN

E 19- D 11A

1 PLAN

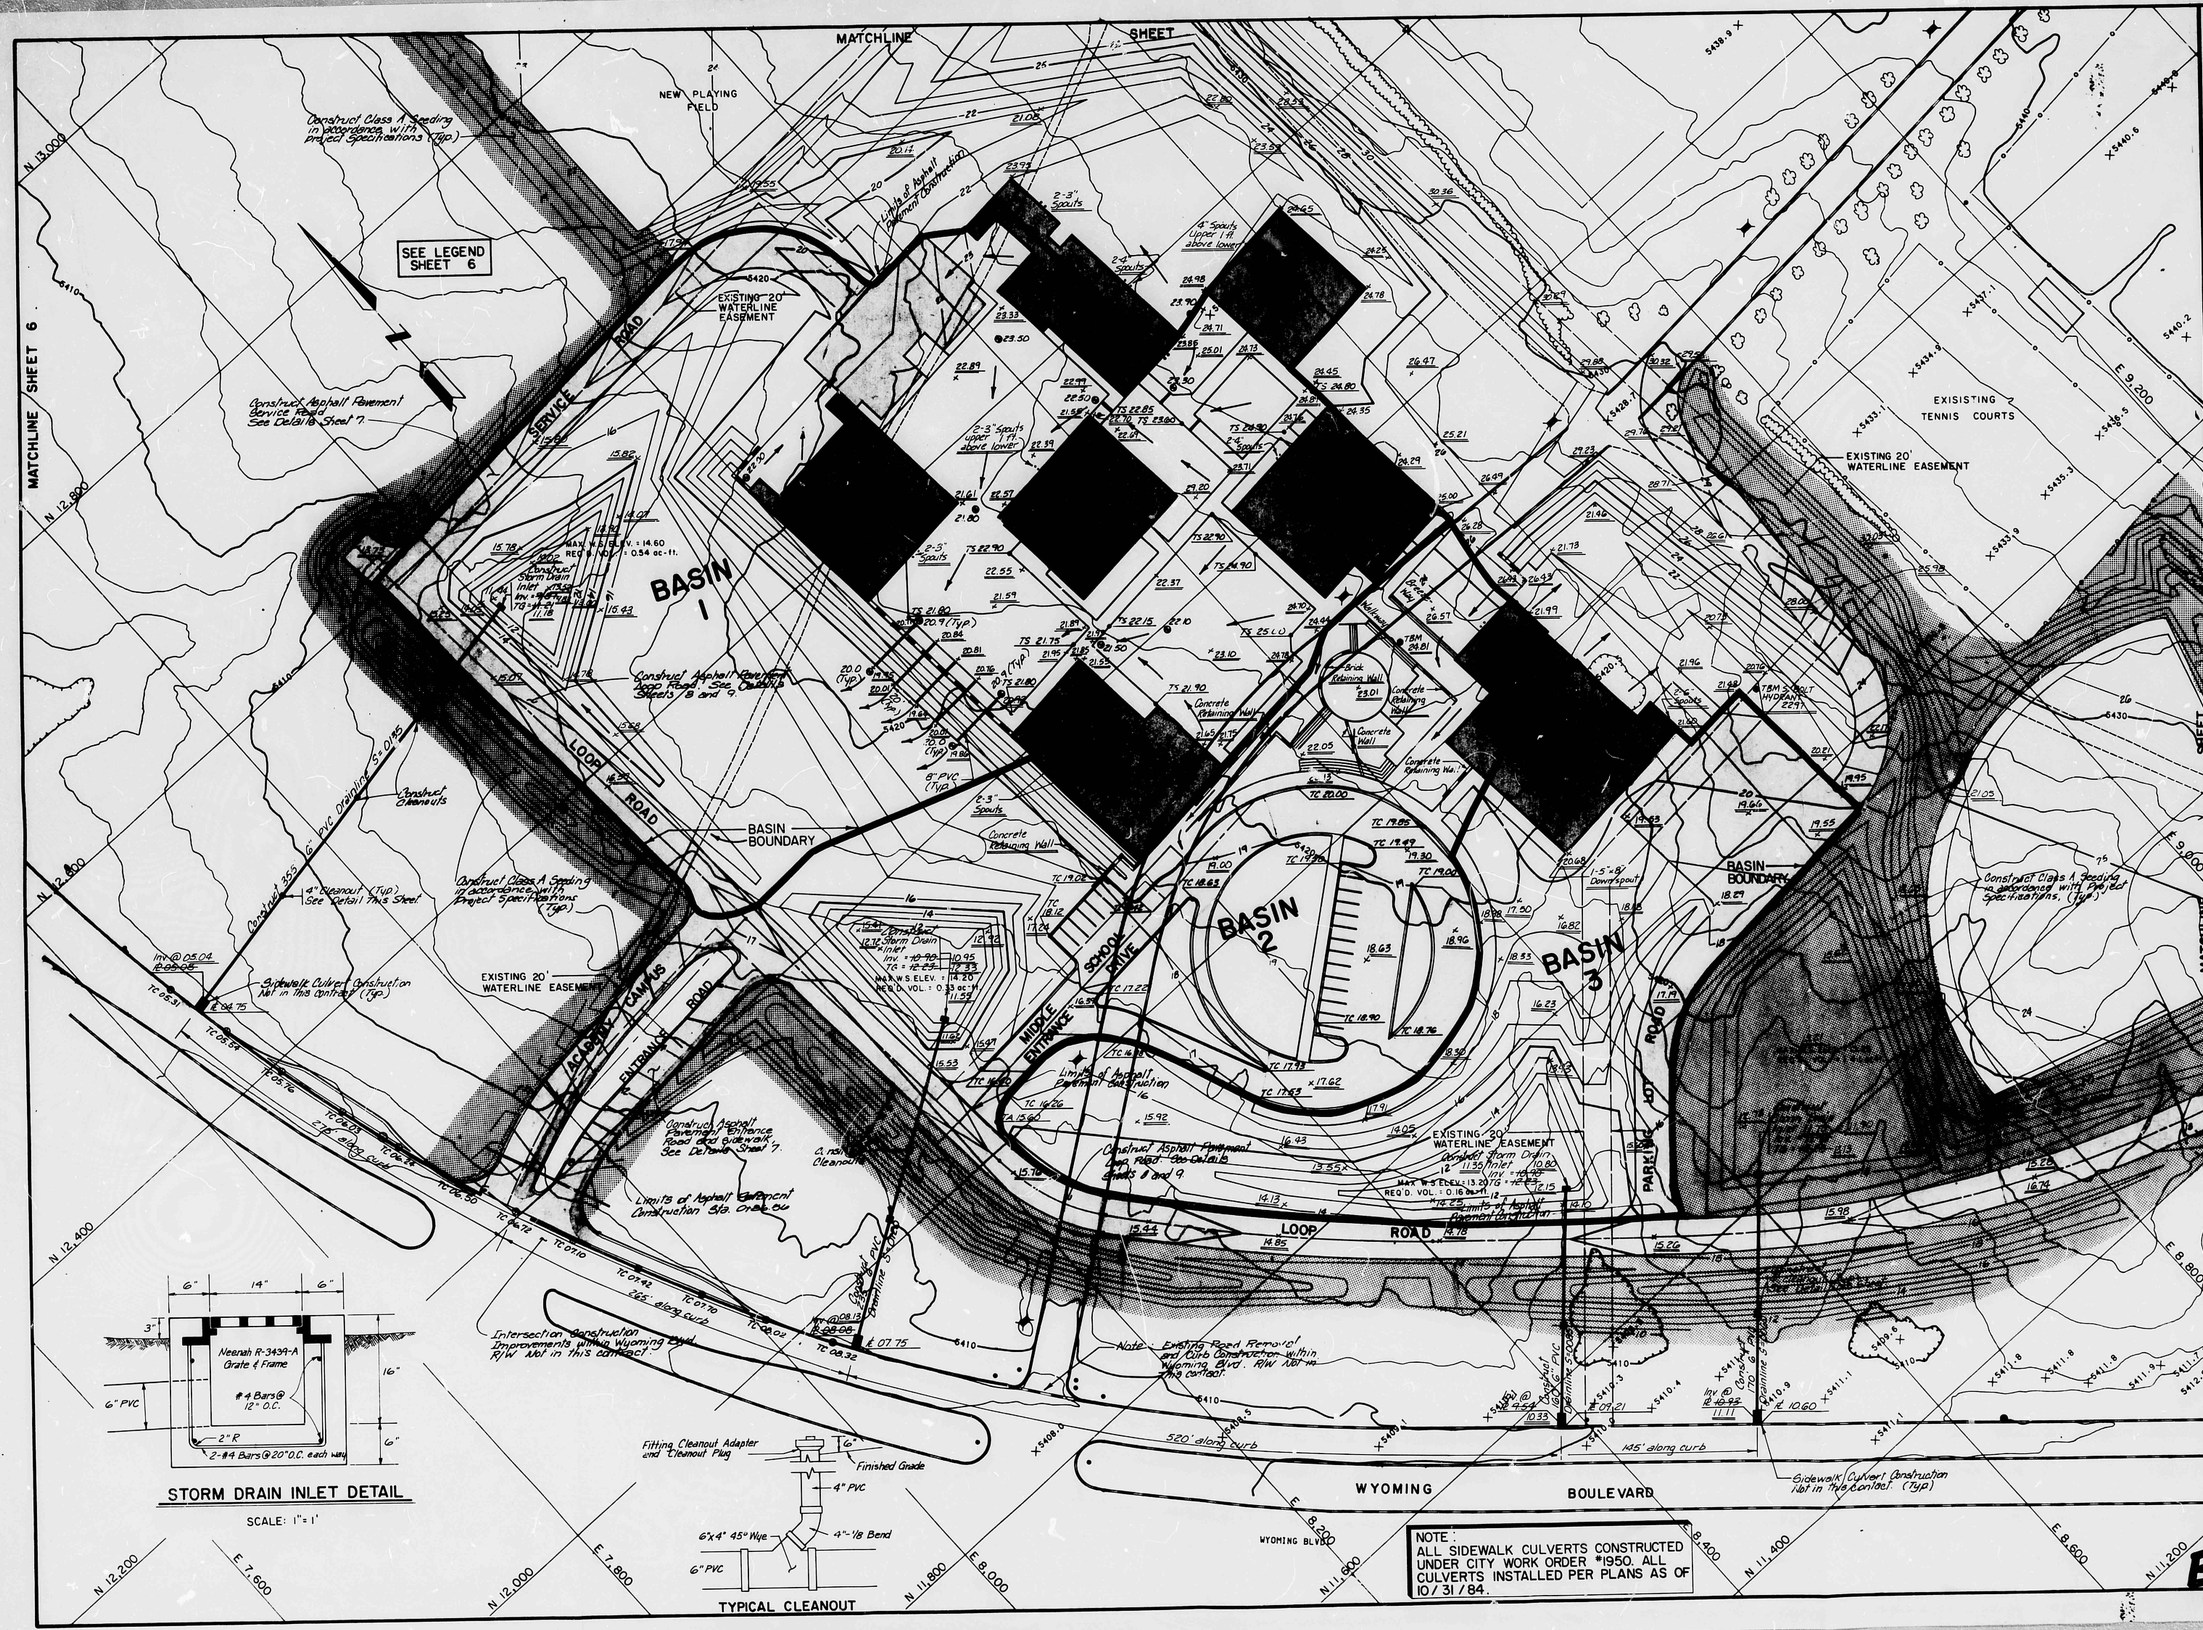

STORM DRAIN INLET DETAIL

SCALE: 1" = 1'

TYPICAL CLEANOUT

NOTE:
ALL SIDEWALK CULVERTS CONSTRUCTED UNDER CITY WORK ORDER #1950. ALL CULVERTS INSTALLED PER PLANS AS OF 10/31/84.

ALBUQUERQUE ACADEMY CAMPUS

MIDDLE SCHOOL IMPROVEMENTS
AS-BUILT DRAWING

Job No. 31363 | Sheet 5 of 9 | Date: 11/83
Drawn By: PE, UK | Checked By: DMYM | Scale: 1" = 50'

KEY PLAN

I, BRIAN BURNETT, P.E., CERTIFY THAT THE AS-BUILT PLAN IS IN SUBSTANTIAL COMPLIANCE WITH THE APPROVED DRAINAGE REPORT

Brian Burnett
11-12-84

NOTE:
AS-BUILT INFORMATION SHOWN WITH DOUBLE UNDERLINING

GRID IS BASED ON LOCAL COORDINATE SYSTEM

LOCAL COORDINATES: E 10,000.00, N 10,000.00
N.M. STATE PLANE COORDINATES: E 399,394.95, N 1,498,657.39

RECEIVED
NOV 13 1984
DESIGN HYDROLOGY SECTION

E19/D11A