HYDROLOGY

E19/D23

ONE PLAN

1 PLAN FOR

APARTMENTS - ACADEMY

+ TRUCHAS DR.

E19 - D23

1 PLAN

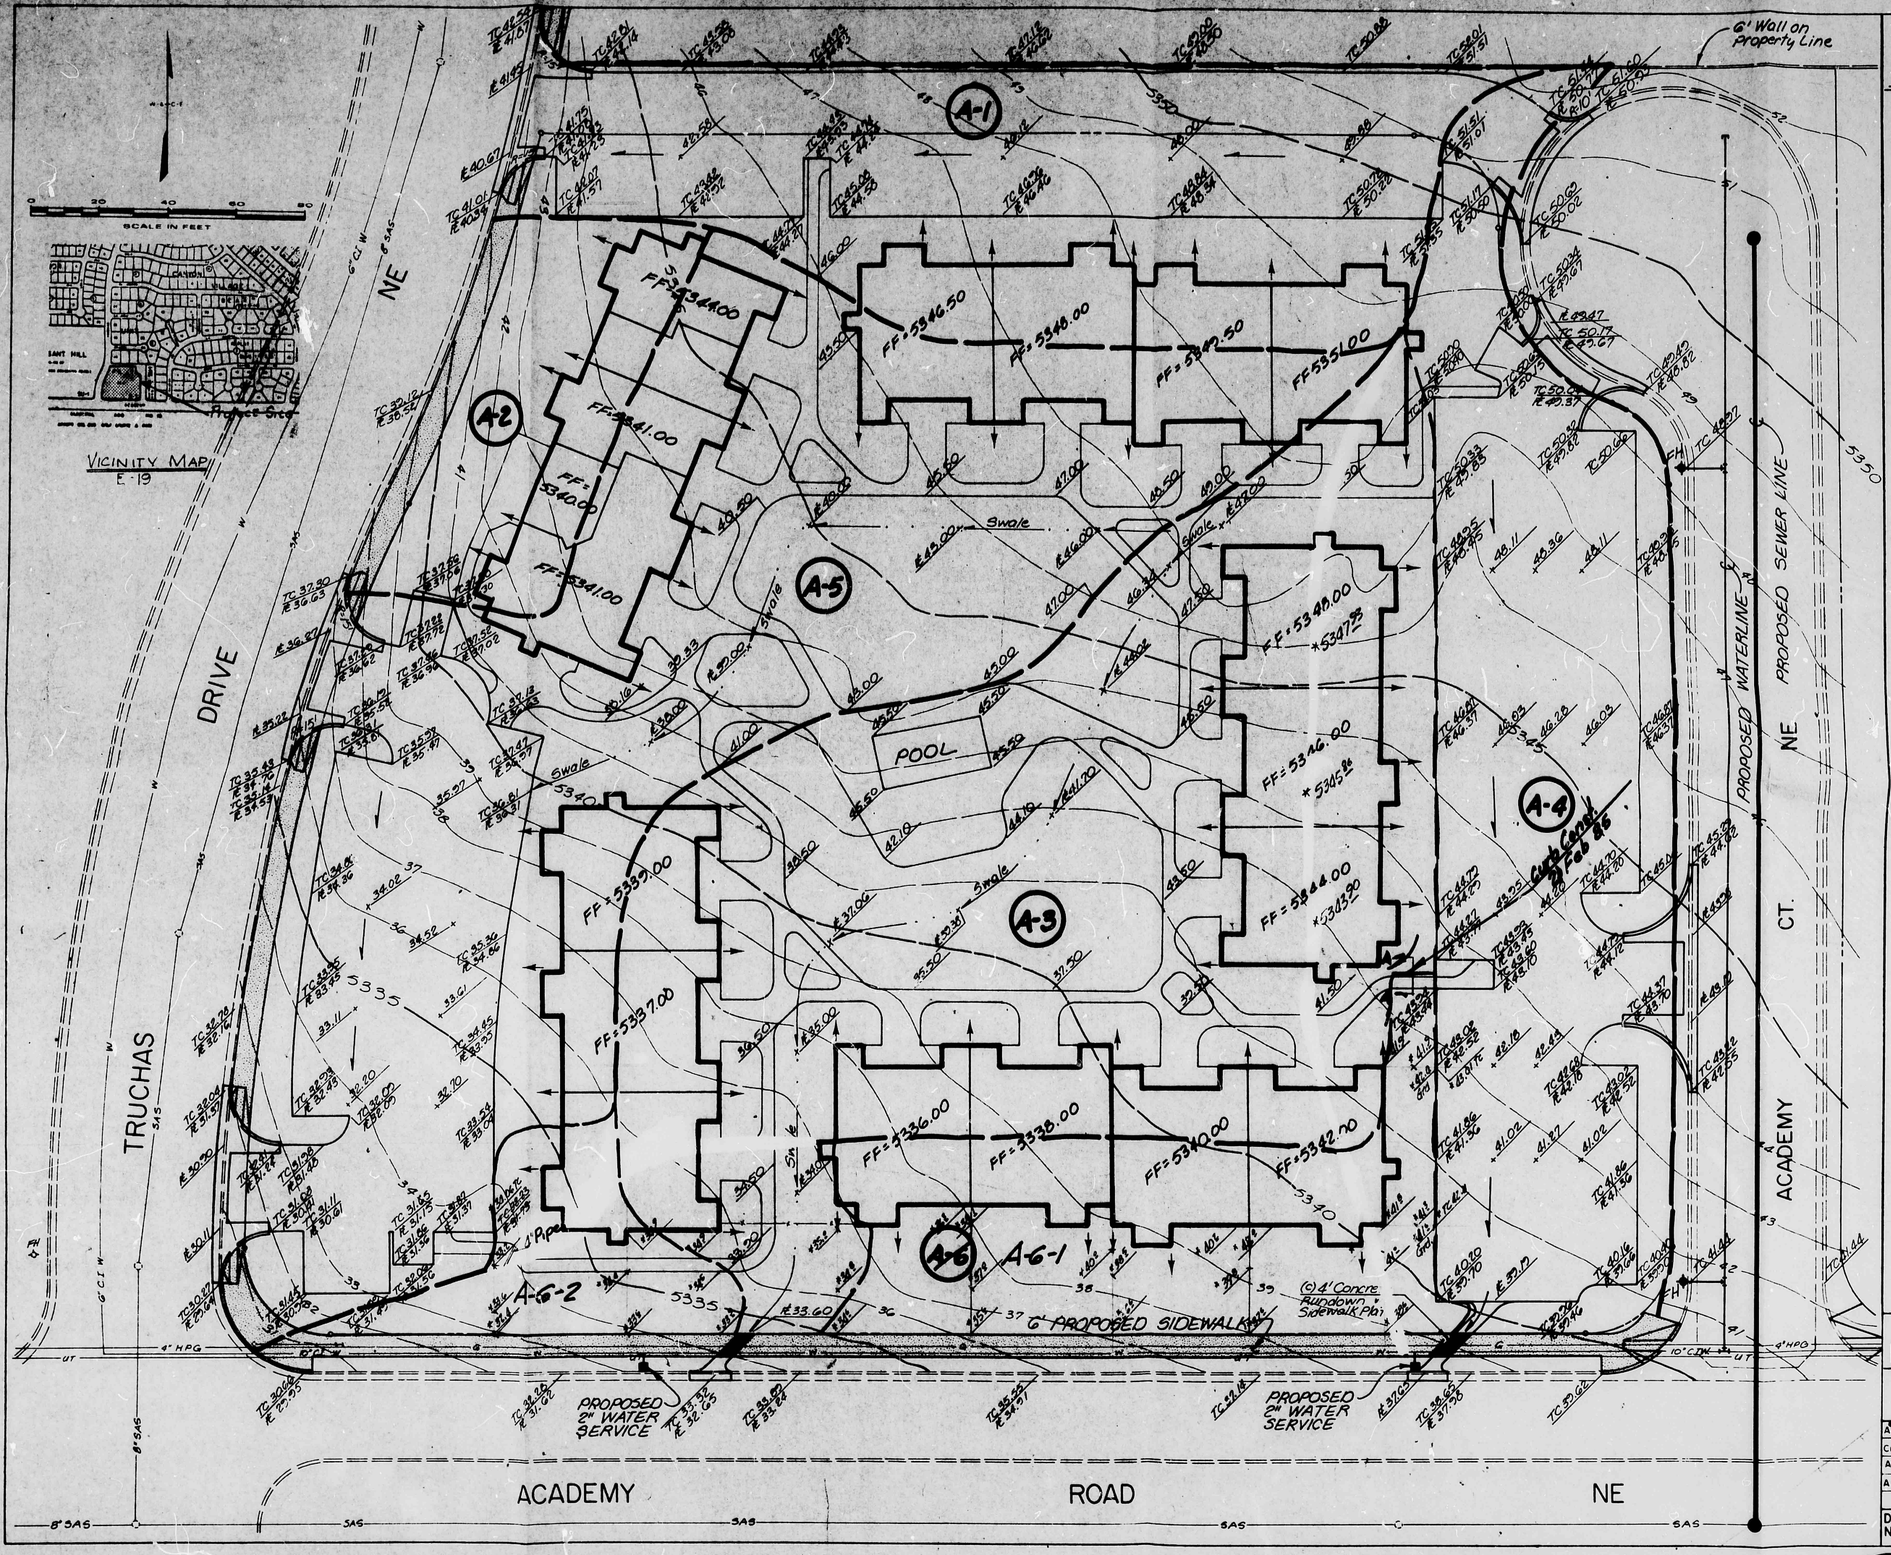

NOTE:

1) Contractor shall take such measures neccessary to retain all sediment on property during construction.

2) Contractor shall take such measures neccessary to keep dust from blowing during construction.

3) Landscaping will be depressed so small amounts of runoff will be retained on site.

4) Academy Ct. will be constructed as a AHBA Project.

5) Grading Plan Elevations are for rough grading. Some modifications may be made to accomodate the landscape structure of the project.

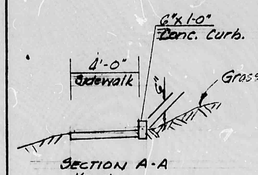

RECEIVED
FEB 25 1985
HYDROLOGY SECTION

LEGEND

TC = Top of Curb
FL = Flow Line
← Roof Drain
Existing Contour
Finished Grade
As Const. Elev. From Survey dated 1 Feb 1985

This project has been const. in substantial compliance with approved drainage report (E-19/D23)

ROBERT L. MAYER
NEW MEXICO
REGISTERED PROFESSIONAL ENGINEER
7/2/85

AS BUILT INFORMATION	
CONTRACTOR	
WORK STAKED BY	DATE
STAKING CHECKED BY	
ACCEPTANCE BY	DATE
FIELD VERIFICATION BY	DATE
DRAWINGS CORRECTED BY	DATE
MICRO-FILM INFORMATION	
RECORDED BY	DATE
NO.	

BENCH MARKS

A Standard ACS Brass Tablet Stamped "1-F19A-1978" Set in the Median On Academy Rd. NE East of the Intersection of Truchas Dr. NE & Academy Rd. NE.
Elev. = 5328.52

SURVEY INFORMATION

NO.	FIELD NOTES BY	DATE

ENGINEER'S SEAL

NO.	DATE	REMARKS	BY
		REVISIONS	

DESIGN

DESIGNED BY	DATE
DRAWN BY	DATE
CHECKED BY	DATE

CITY OF ALBUQUERQUE

RANCHO VERDE APARTMENTS

GRADING PLAN

APPROVALS	ENGINEER	DATE	APPROVALS	ENGINEER	DATE
City Engineer			Liquid Waste		
A C E - Design			Traffic		
A C E - Hydrology			Water		

DRAWING NO. | MAP NO. E-19 | SHEET OF

WILSON & COMPANY
ENGINEERS & ARCHITECTS
ALBUQUERQUE, NEW MEXICO

E19/D23