

CITY OF ALBUQUERQUE



August 22, 2007

Vicky Warwick
P.O. Box 362
Ruidoso, NM 88355
505-937-6777

Re: Drainage at 10812 Malaguena Lane NE

Dear Ms. Warwick,

This letter is issued in response to a complaint about recent changes made to your lot (10812 Malaguena Ln. NE) that adversely affect the overall drainage plan for this area. Per the approved grading and drainage plan for the Academy Ridge East Subdivision Phase 1, "rear lot discharges will be collected in a swale type ditch and transmitted from lot to lot through holes built into the block walls between lots. Every sixth lot (counting downstream) will provide a 5 foot private drainage easement and a swale to convey the collected flow to the street." The grading plan for this site designates your lot as a lot that must convey the collected flow to the street. Your changes have blocked this conveyance and have caused flooding problems for your neighbors upstream, possibly making you liable for any damages.

In the spirit of cooperation, I ask that you take the appropriate measures necessary to restore the original drainage flow and alleviate the upstream flooding issues. Please contact me at your earliest convenience at 924-3981 to discuss possible remediation methods or if you have any questions. If you are not the property owner, please contact me.

Sincerely,

Kristal D. Metro, P.E., CFM
Senior Engineer, Planning Dept.
Development and Building Services

C: Arlene Jacobs, 6221 Academy Ridge Ct. NE, Albuquerque, NM 87111

File

CC: Resident, 10812 Malaguena Ln. NE, Albuquerque, NM 87111

8/29/07

Rec'd call from Vicky Warwick

When purchased home 7 yrs ago, hole was not in wall

-neighbor punched hole in wall (early summer '07)

w/ sledgehammer, caused flooding in their yard

Hoping for some design advice

Albuquerque - Making History 1706-2006

P.O. Box 1293

Albuquerque

New Mexico 87103

www.cabq.gov




DRAINAGE

EASEMENT



10517	10520	10524	10525	10526	
-------	-------	

ZONE ATLAS E-21

APPROVED FOR DRAINAGE
 DATE 6/29/88
 SIGNATURE [Signature]

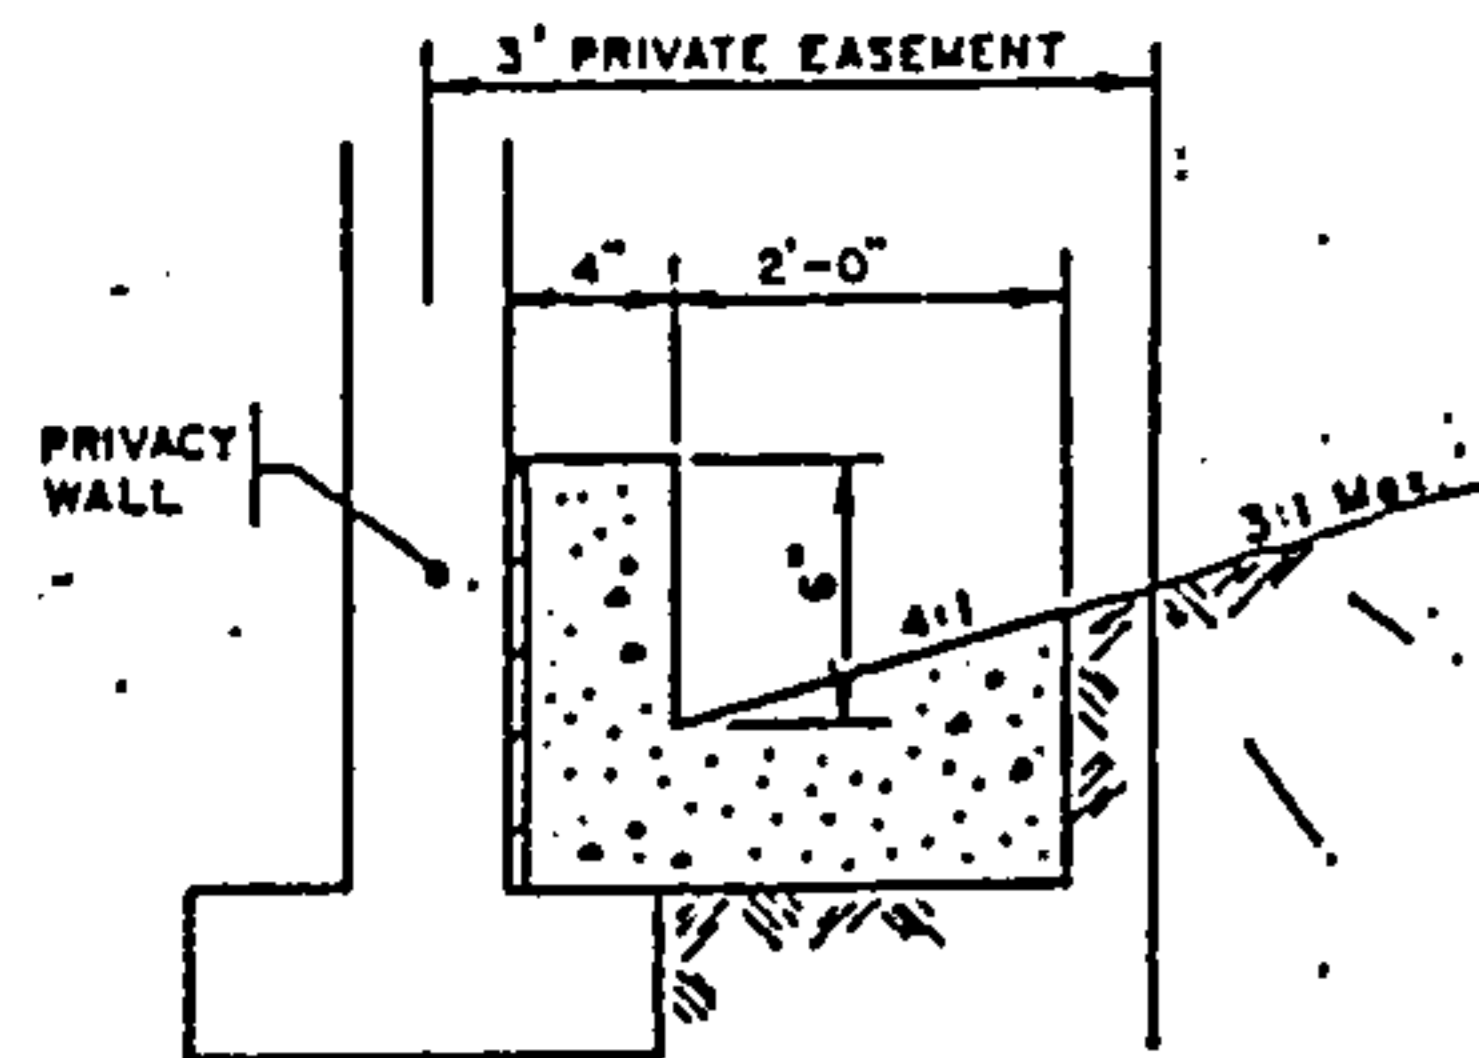

REAR YARD ALTERNATE PRIVATE DRAINAGE RUNDOWN DETAIL
 NOT TO SCALE

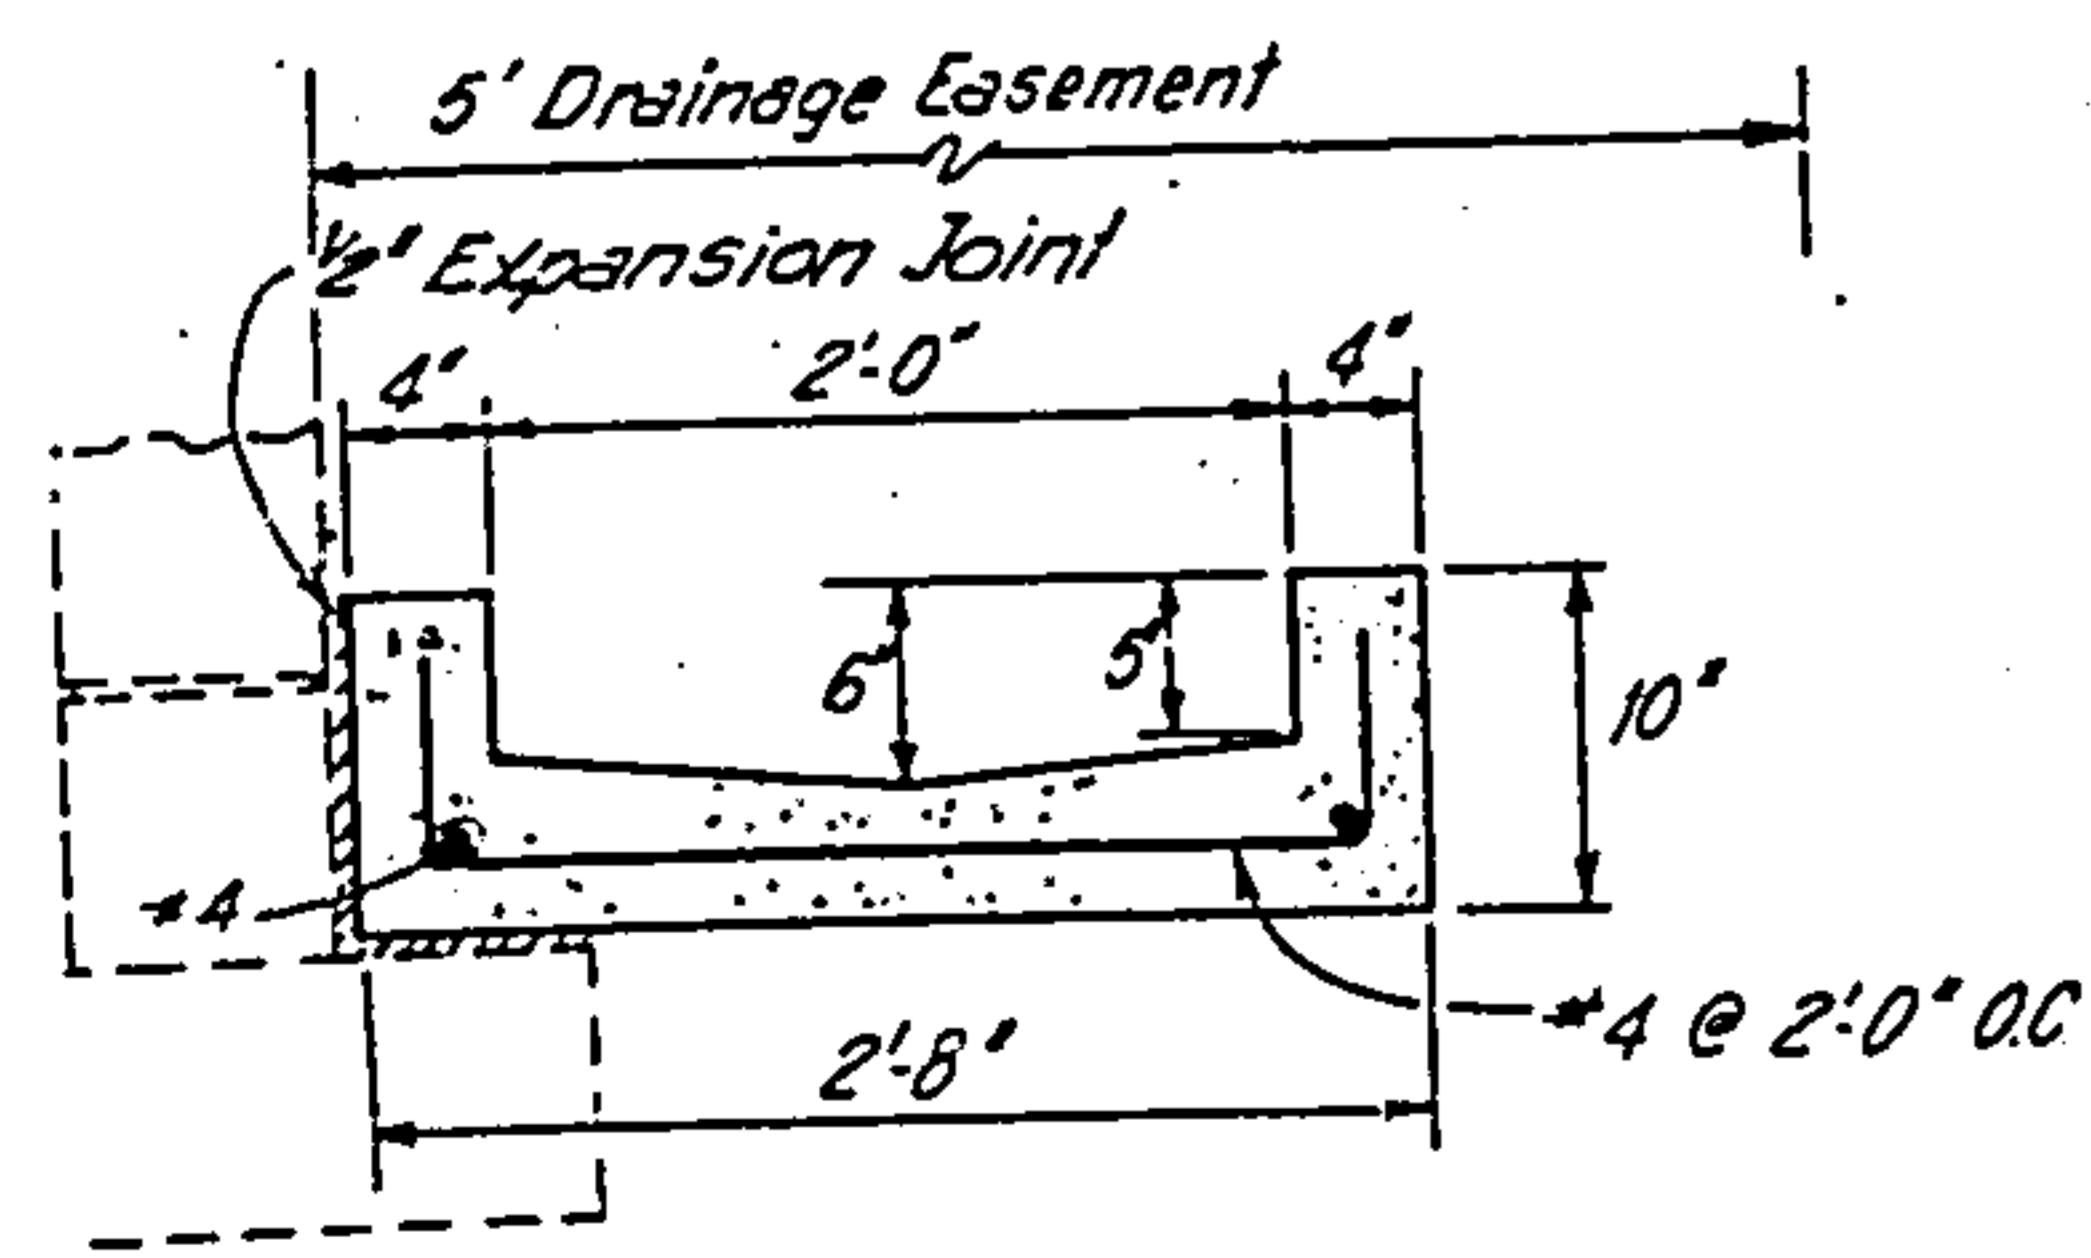 

DRAINAGE RUNDOWN DETAIL
 To Be Built by Others

NO SCALE

Contractor's grading operations shall not disturb this area until the proposed storm drainage improvements at Malaguena Lane are in place and functioning.

12-31-75

RECORD DRAWINGS
 Date 12/05

CITY OF ALBUQUERQUE
 MUNICIPAL DEVELOPMENT DEPARTMENT
 ENGINEERING DIVISION

TITLE: ACADEMY RIDGE EAST PHASE I
 GRADING PLAN

APPROVALS	ENGINEER	DATE	APPROVALS	ENGINEER
City Engineer	[Signature]	6/29/88	Liquid Waste	NA [Signature]
A-C-E-Design	[Signature]	6/29/88	Traffic	NA [Signature]
Hydrology	[Signature]	5/29/85	Water	NA [Signature]

DRAWING NO. 2289 MAP NO. E-21 SHEET 11 OF 10


SURVEY INFORMATION		BENCH MARKS		AS-BUILT INFORMATION	
NO.	DATE	NO.	DATE	NO.	DATE
		ACS Brass Cap "6"-E22"	Elev 5934.53	CONTRACTOR	KCC Inc.
		Location is 12 miles East of the intersection of Academy Road N.E. of Eubank Blvd. N.E. Station is then 375 South on the South Right of Way of the Bear Canyon Tributary			

DRAWING 44 132 637A



City of Albuquerque

P.O. BOX 1293 ALBUQUERQUE, NEW MEXICO 87103

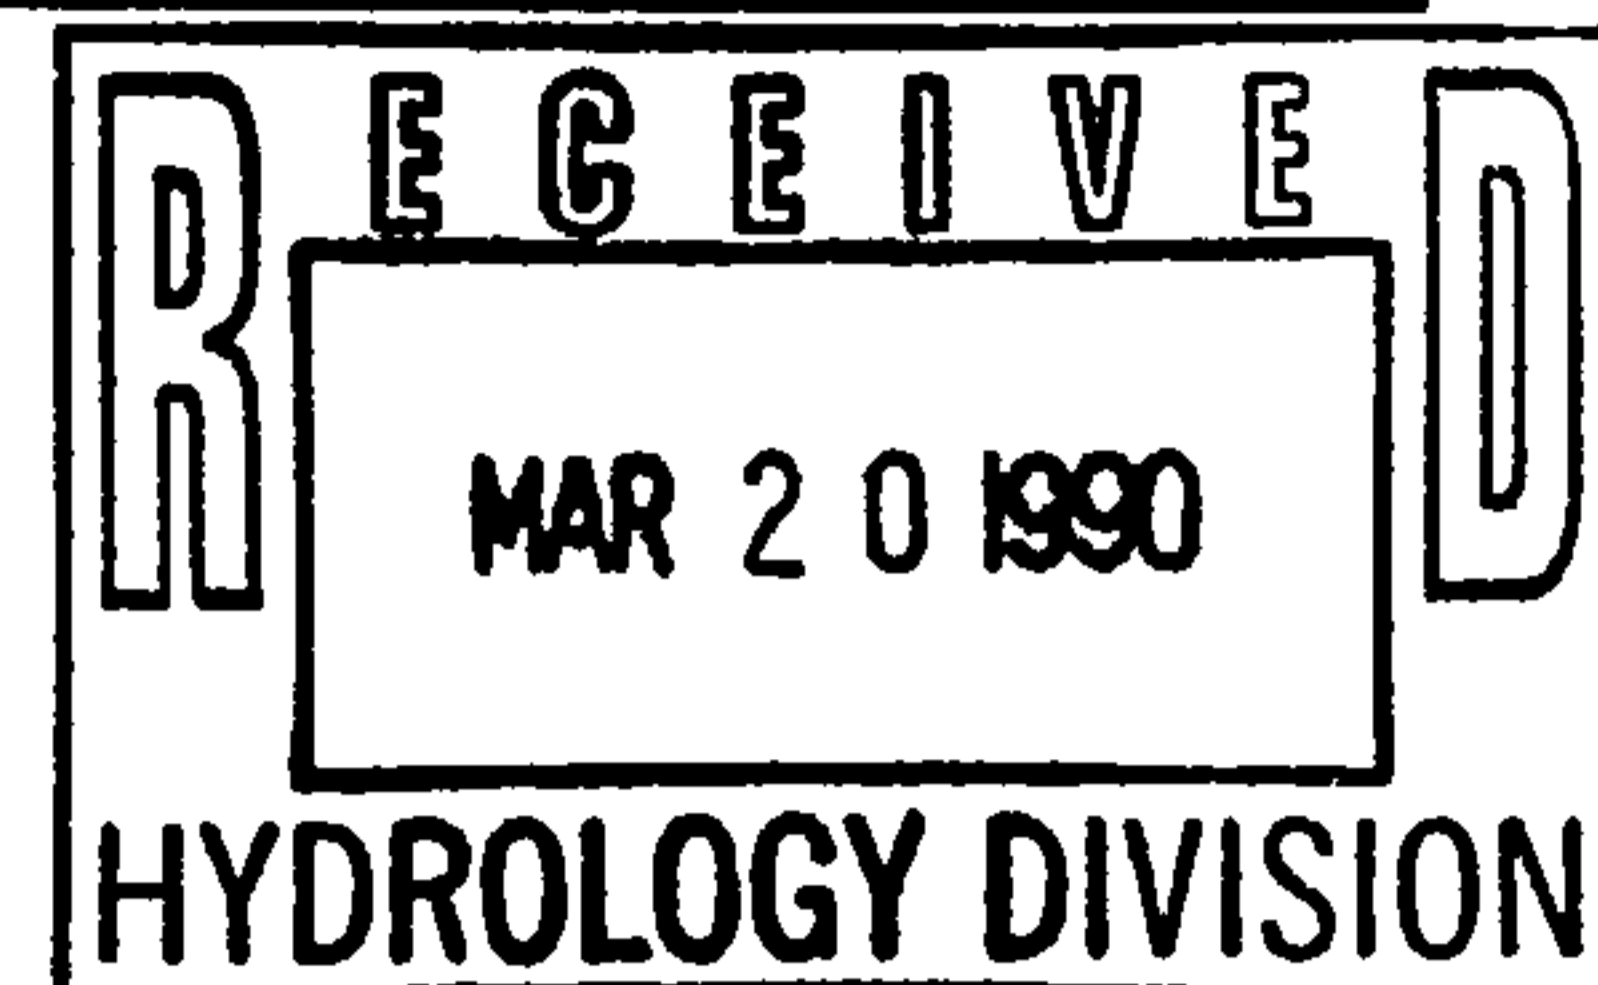

March 19, 1990

CERTIFICATE OF COMPLETION AND ACCEPTANCE

Ms. Lynn Johnson
Centex Homes
10701 Montgomery Blvd. N.E.
Albuquerque, NM 87111

RE: PROJECT NO. 3977, ACADEMY RIDGE EAST III, -(MAP-NO. -E-82)

Dear Ms. Johnson:

This is to certify that the City of Albuquerque accepts Project No. 3977 as being completed according to approved plans and construction specifications. The City of Albuquerque will accept for continuous maintenance all public infrastructure improvements constructed as part of Project No. 3977.

The project is described as follows:

- Removed and re-built catch basin, Type "A", to accommodate driveway on Malaguena Lane east of Academy Ridge Dr.
- The contractor's correction period begins the date of this letter and will be effective for a period of one (1) year.

Sincerely,

Brian L. Speicher, P.E.
Chief Construction Engineer
Design/Construction Division
Engineering Group
Public Works Department

BLS:kt



City of Albuquerque

P.O. BOX 1293 ALBUQUERQUE, NEW MEXICO 87103

MAYOR
KEN SCHULTZ

CHIEF
ADMINISTRATIVE OFFICER
GENE ROMO

DEPUTY CAO
PUBLIC SERVICES
FRANK MARTINEZ

DEPUTY CAO
PLANNING/DEVELOPMENT
BILL MUELLER

February 5, 1988

Kerry Davis, P.E.
Bohannon-Huston, Inc.
7500 Jefferson Street, NE
Albuquerque, New Mexico 87109

RE: AMENDMENT TO ACADEMY RIDGE EAST, UNIT III DRAINAGE PLAN
RECEIVED JANUARY 6, 1988 FOR RUNDOWN REVISION APPROVAL
(E-21/D29) (W.O. NO. 3001)

Dear Mr. Davis:

The proposed amendment to combine the rear yard flows from Lots 19-32 with those of lots 6-1 and outfall to Malaguena Lane is approved. Provide this office with a revised Grading Plan with an engineer's stamp and revision date. The construction set for City Project 3001 must also be updated.

If you have any questions, call me at 768-2650.

Cordially,

Roger A. Green, P.E.
C.E./Hydrology Section

RAG/bsj

xc: Richard Mallett

FILE COPY



City of Albuquerque

P.O. BOX 1293 ALBUQUERQUE, NEW MEXICO 87103

HYDROLOGY SECTION
123 Central NW, Albuquerque, NM 87102
(505) 766-7644

October 7, 1986

Kerry Davis
Bohannon-Huston, Inc.
7500 Jefferson Street, NE
Albuquerque, New Mexico 87109

RE: REVISED CONSTRUCTION PLANS FOR CITY WORK ORDER PROJECT NO.
2767 (E-21/D29) RECEIVED OCTOBER 2, 1986


Dear Kerry:

The above referenced plans with the revision date of September, 1986,
are approved.

Please attach a copy of these approved plans to the construction sets
for sign-off and for the contractors use.

If I can be of further assistance, please call me at 768-2650.

Cordially,

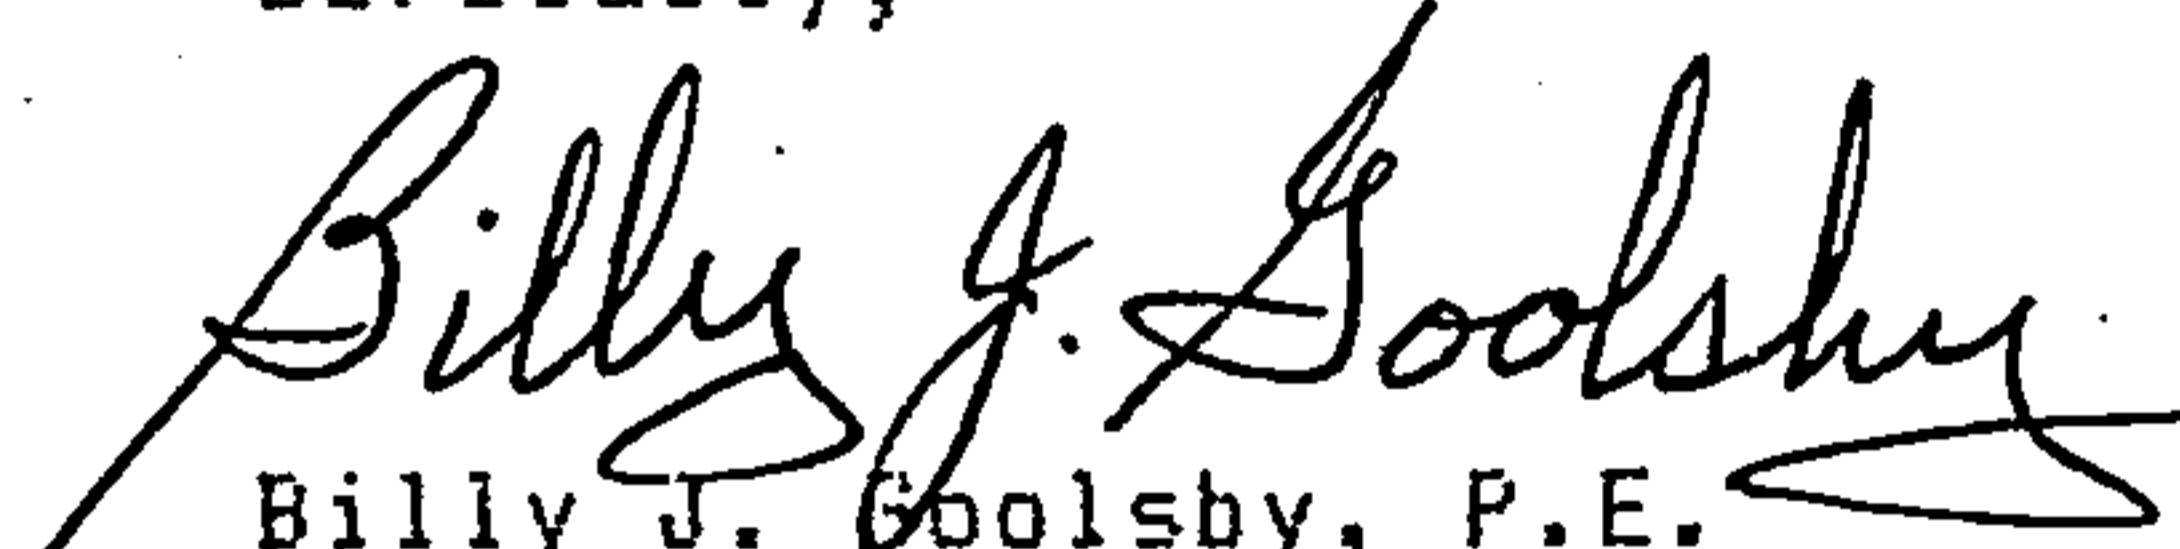
Billy J. Goolsby, P.E.
C.E./Hydrology Section

BJG/bsj

PUBLIC WORKS DEPARTMENT

Walter Nickerson, P.E., City Engineer

ENGINEERING GROUP

Telephone (505) 768-2500

AN EQUAL OPPORTUNITY EMPLOYER

FILE COPY



City of Albuquerque

P.O. BOX 1293 ALBUQUERQUE, NEW MEXICO 87103

HYDROLOGY SECTION
123 Central NW, Albuquerque, NM 87102
(505) 766-7644

September 17, 1986

Kerry Davis
Bohannon-Huston, Inc.
7500 Jefferson Street, NE
Albuquerque, New Mexico 87109

RE: REVISED DRAINAGE & CONSTRUCTION PLANS FOR ACADEMY RIDGE
EAST, UNIT III (E-21/D29) RECEIVED SEPTEMBER 12, 1986

Dear Kerry:

The above referenced plans, dated September 9, 1986, are approved for
inclusion in the Work Order set for sign-off at D.R.C.

Please see that these plans are included in the package prior to DRC
signature session.

If I can be of further assistance, please call.

Cordially,

Billy G. Goolsby
Billy G. Goolsby, P.E.
C.E./Hydrology Section

BJG/bsj

PUBLIC WORKS DEPARTMENT

Walter Nickerson, P.E., City Engineer


ENGINEERING GROUP

Telephone (505) 768-2500


AN EQUAL OPPORTUNITY EMPLOYER



PROJECT NAME Academy Ridge East Phase I
 PROJECT NO. [blank]
 SUBJECT [blank]
 CH.D. [blank]
 DATE 6/23/88
 SHEET HYDROLOGY SECTION
 BY [signature]
 DATE 6/23/88

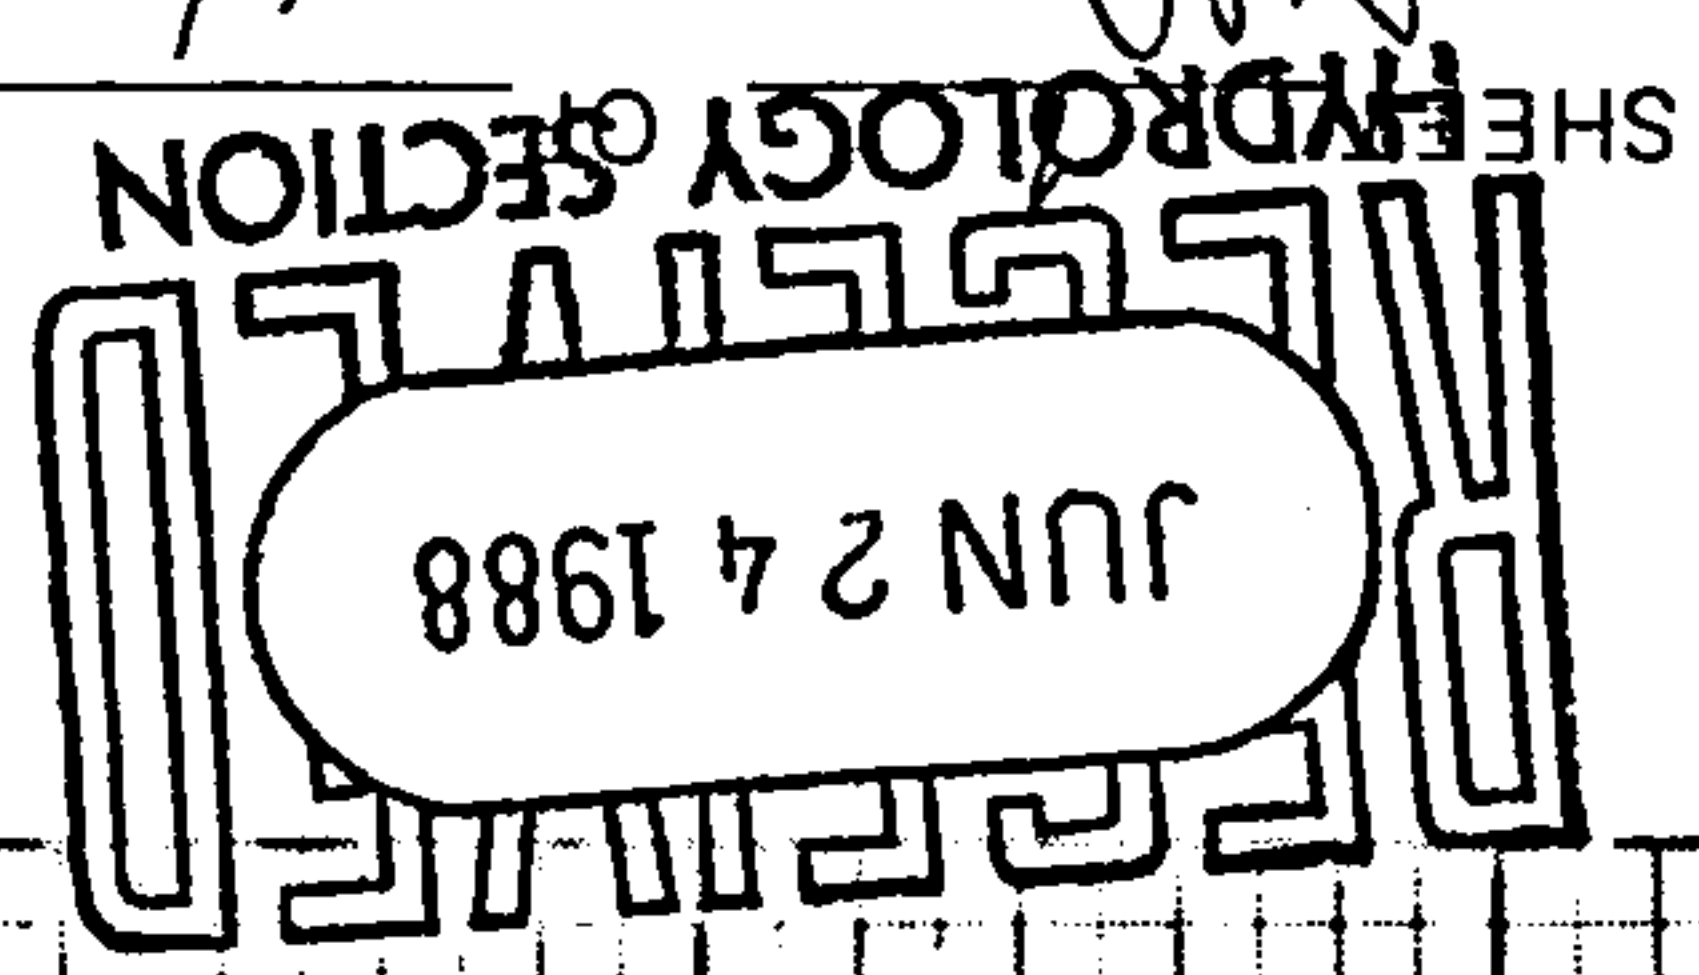

TYPICAL LOT

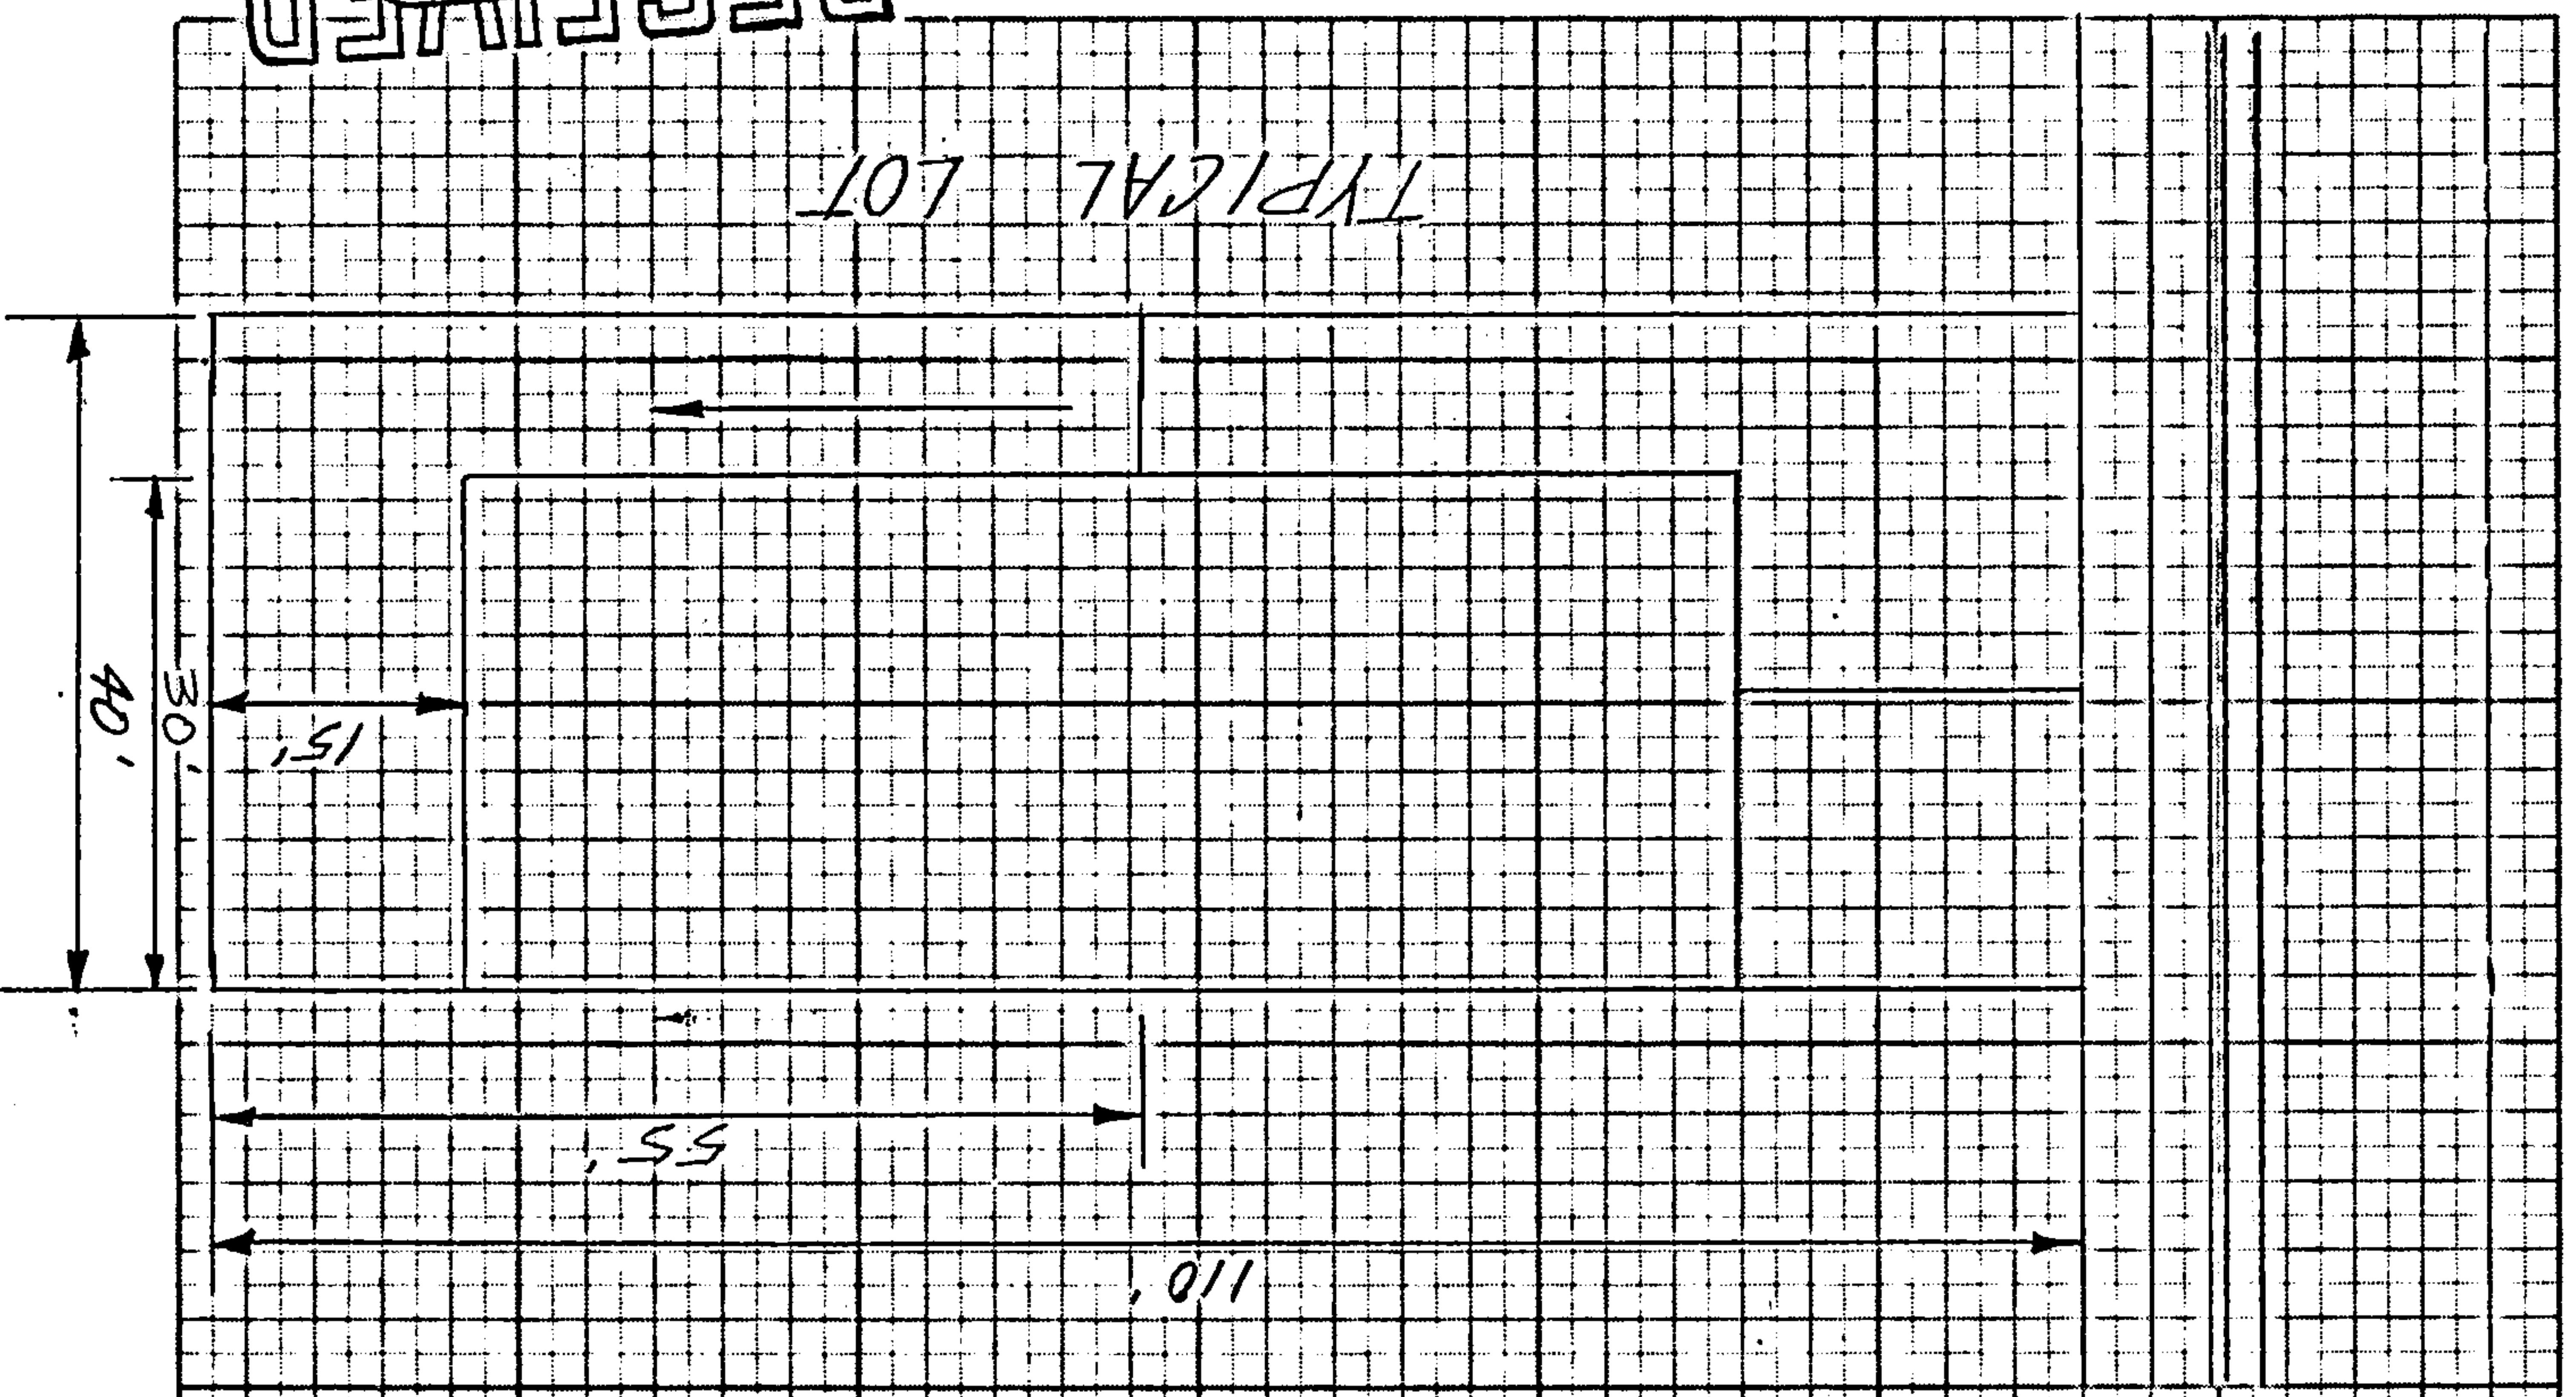

As per Builder's house designs, approx. 20% of roof area discharges to rear of yard.
 Assume that 1/2 of side yard discharges to rear of yard.
 Rear Yard Area $(40' \times 15') = 600 \text{ SF}$
 $(40' \times 10') = 400 \text{ SF}$
 $1000 \text{ SF} @ 0.25(C)$
 Roof Area $(30' \times 15') = 450 \text{ SF} @ 0.90(C)$
 Total Area = 1450 SF
 Composite "C" Factor $(1000 \times 0.25) + (450 \times 0.90) = 1450$
 $1450 / 1450 = 0.45$

$$10 \text{ LOT Total Area} = \frac{10(1450)}{43,560} = 0.33 \text{ Ac}$$

$$I = (6 \text{ hr. rain}) 6.84 t_c^{-0.51}$$

$$I = (7.5)(6.84)(10)^{-0.51}$$

$$I = 5.28''$$

$$Q = CIA$$

$$Q = (0.45)(5.28)(0.33)$$

$$Q = 0.78 \text{ cfs.}$$



PROJECT NAME Academy Ridge East SHEET 2 OF _____

PROJECT NO. _____ Phase I BY _____ DATE _____

SUBJECT _____ CH'D _____ DATE _____

MH - STA 1+75.00 CARROTHERS ST.

HG = 5763.91

24" SD. Q = 28 CFS

INV. = 5762.05

TYPE 'C' INLET 'V' DEPTH STA 10+88.94

d = 24"


Q = 14 CFS

A = 3.14 FT²

V = 4.5 FPS

$$V_{min} = 1.33 + 1.2 \frac{V^2}{2g} + d$$

$$= 1.33 + 1.2 (0.31) + 2.0 = 3.71'$$

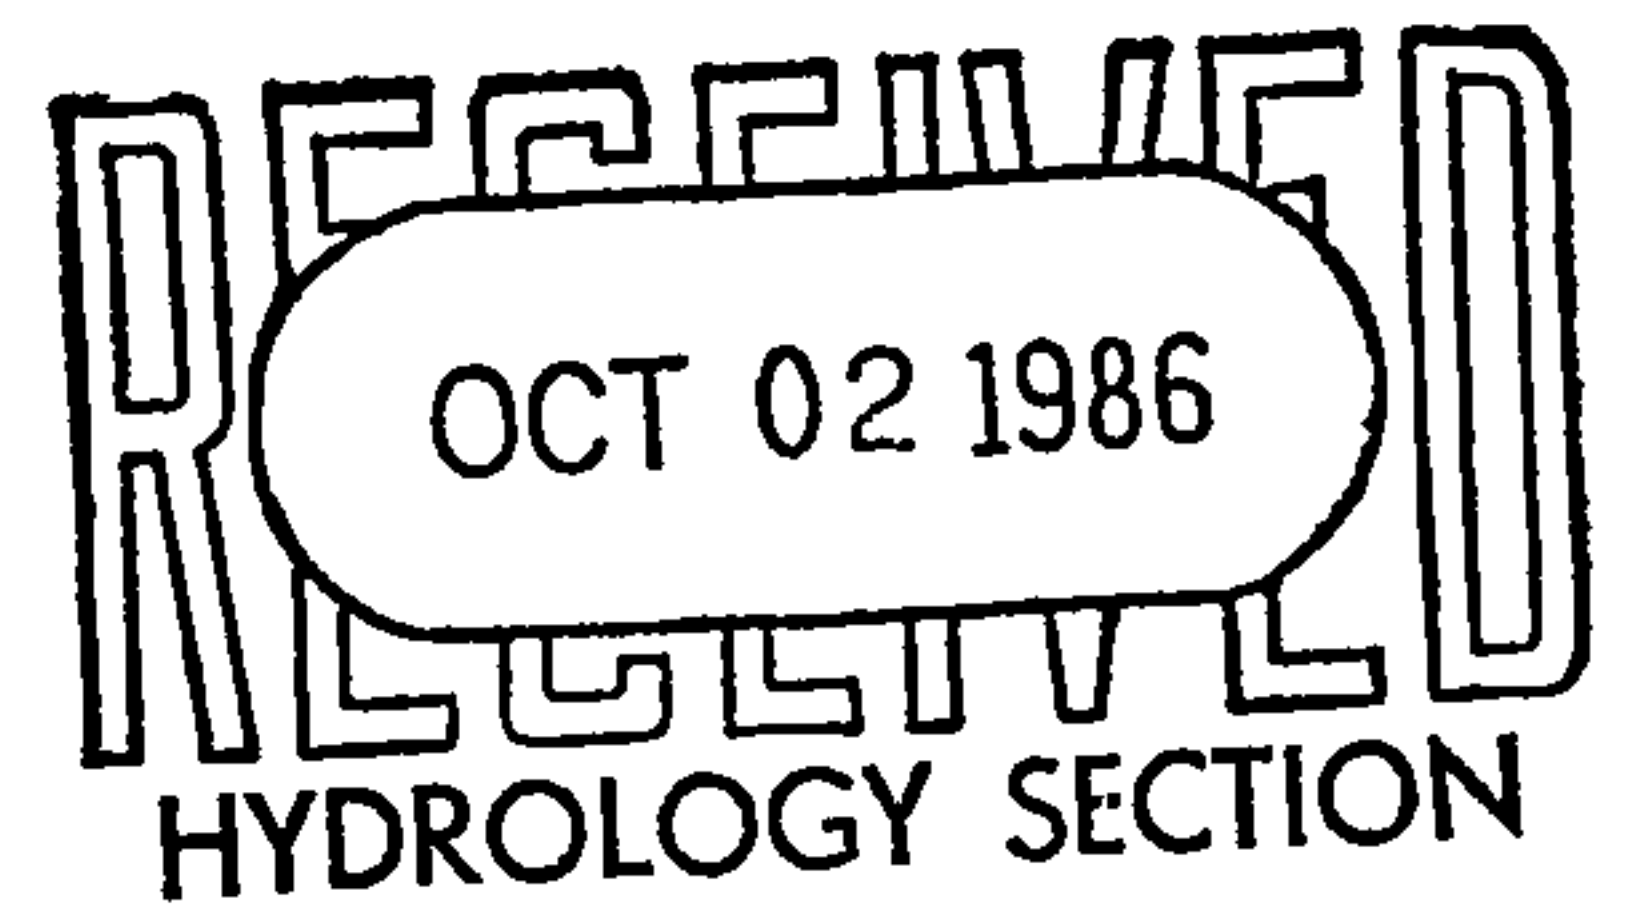

ACTUAL DEPTH

TC = 73.80

INV. = 69.63

4.17' ✓

TYPE 'A' INLET 'V' DEPTH STA 11+50.69

d = 18"

Q = 8 CFS

A = 1.77 FT²

V = 4.5 FPS

$$V_{min} = 1.33 + 1.2 \frac{V^2}{2g} + d$$


$$= 1.33 + 1.2 (0.31) + 1.5 = 3.20$$

TC = 74.59

INV 70.79

3.81' ✓



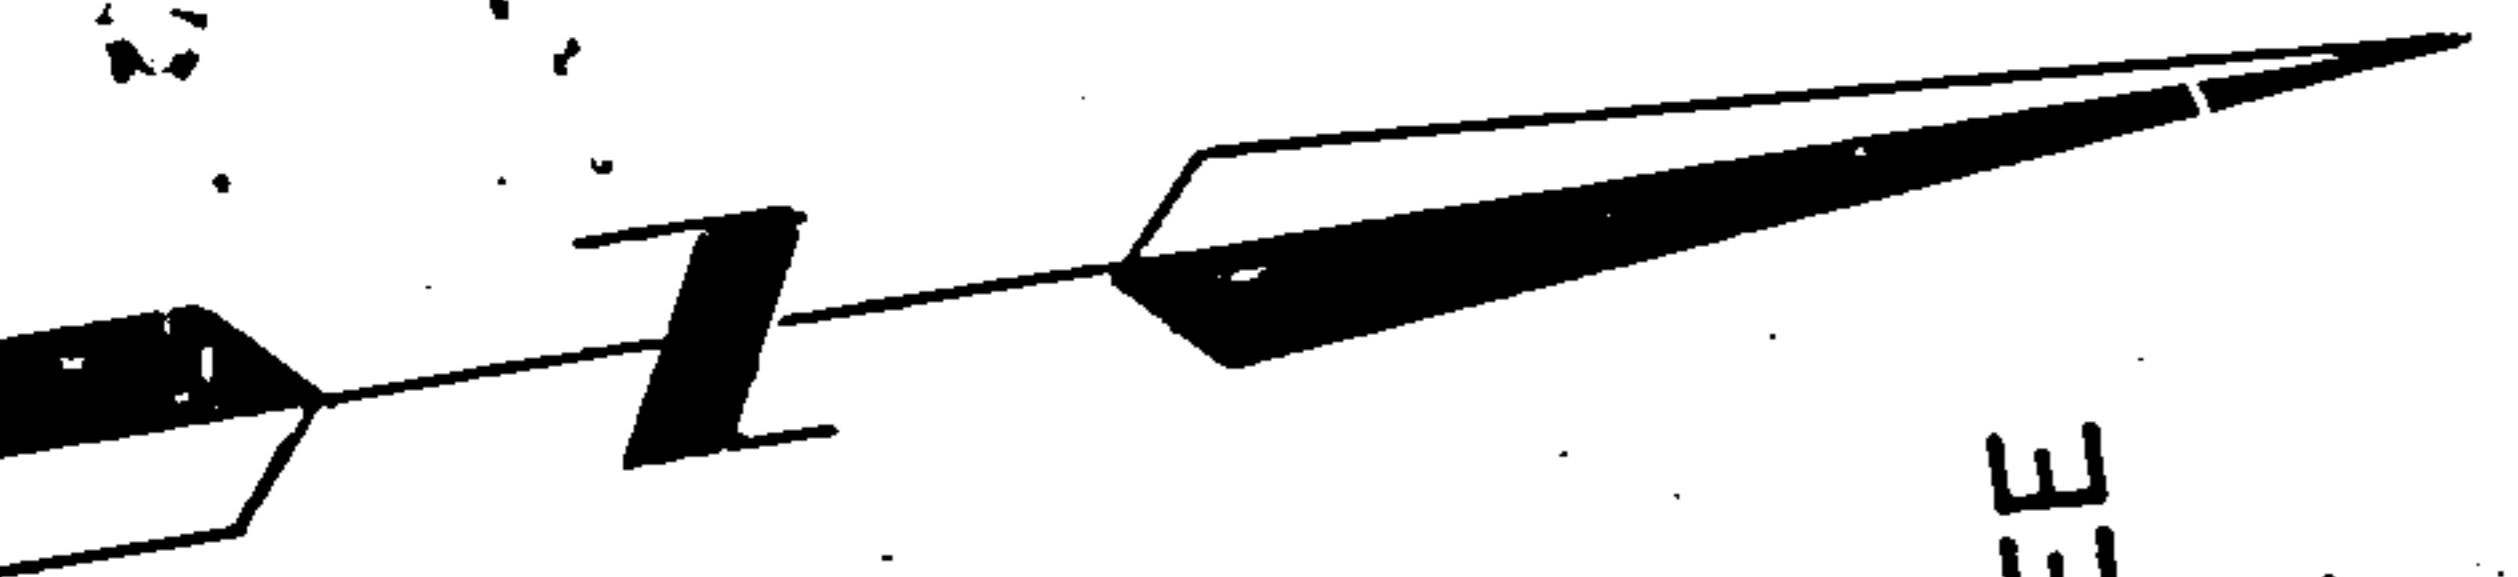

PI. STA. 3
 $\Delta = 16^\circ 24'$
 $R = 797.36'$
 $L = 228.43'$
 $T = 115.00'$

BEAR TRIBUTARY SEE
 FOR CONTINUATION SHT. 17.

ACADEMY RIDGE RD.
 FOR CONTINUATION SEE
 SHT. 16

PC. STA. 2+45.00

Existing 60' drainage R/W

TC	FL
73.90	73.88
73.72	73.73
73.49	73.57
73.22	73.26
73.06	73.05
72.90	72.86

TC	FL
73.95	73.92
74.07	73.99
74.07	73.94

DETAIL SHT. 18

2. 0+00
 Storm Drain

Sta. 0+00
 Carruthers Street

STA. 0+20.00 CARRUTHERS ST =
 STA. 39+76.20 DRAINAGE &
 ACCESS RIGHT-OF-WAY

Build Concrete Cutoff Wall
 as per C.O.A. Std. P-8-3
 Place 2 Type III Barricades
 at end of pavement

STA. 1+95 CARRUTHERS STREET =
 STA. 10+45.94 ACADEMY RIDGE ROAD

Sta. 0+00 10' Lt Carruthers Street
 Remove
 1-6" Cap & Blocking
 Install
 205 LF 6" PVC, DIP or AC
 1-6" Gate Valve w/Type "A" Box & Lid
 1-6" 90° Bend
 2-6" 45° Bends
 Blocking

Sta. 1+95 Carruthers St.
 Install
 50 LF 8" PVC
 1-8" Plug
 $S = 0.021/ft$
 Inv. @ plug = 66.80

Sta. 10+35
 Sta 2+05.
 Install
 1-8" x 8"
 1-8" x 6"
 2-8" Gate
 60 LF 8"
 1-8" Cap
 Blocking
 1-6" Cap


TC	FL
73.39	73.41
72.98	72.88
73.80	73.71
TC 50	FL 87
73.49	72.82
73.56	72.89
73.64	72.97
70	73.09

TC	FL
73.82	73.84
74.36	73.84
73.80	73.84


Station	TC	FL
73.39 RT		
73.65 RT		
67 RT		
73.06 RT		

Sta. 1+95 Carruthers St. =
Sta. 10+45.94 Academy
Ridge Road

ts Lt. + Rt.
+ Rt. TC = ~~5772.96~~ 73.01 Lt., 73.04 Rt.
8.71 Lt.
Rt. Connect to


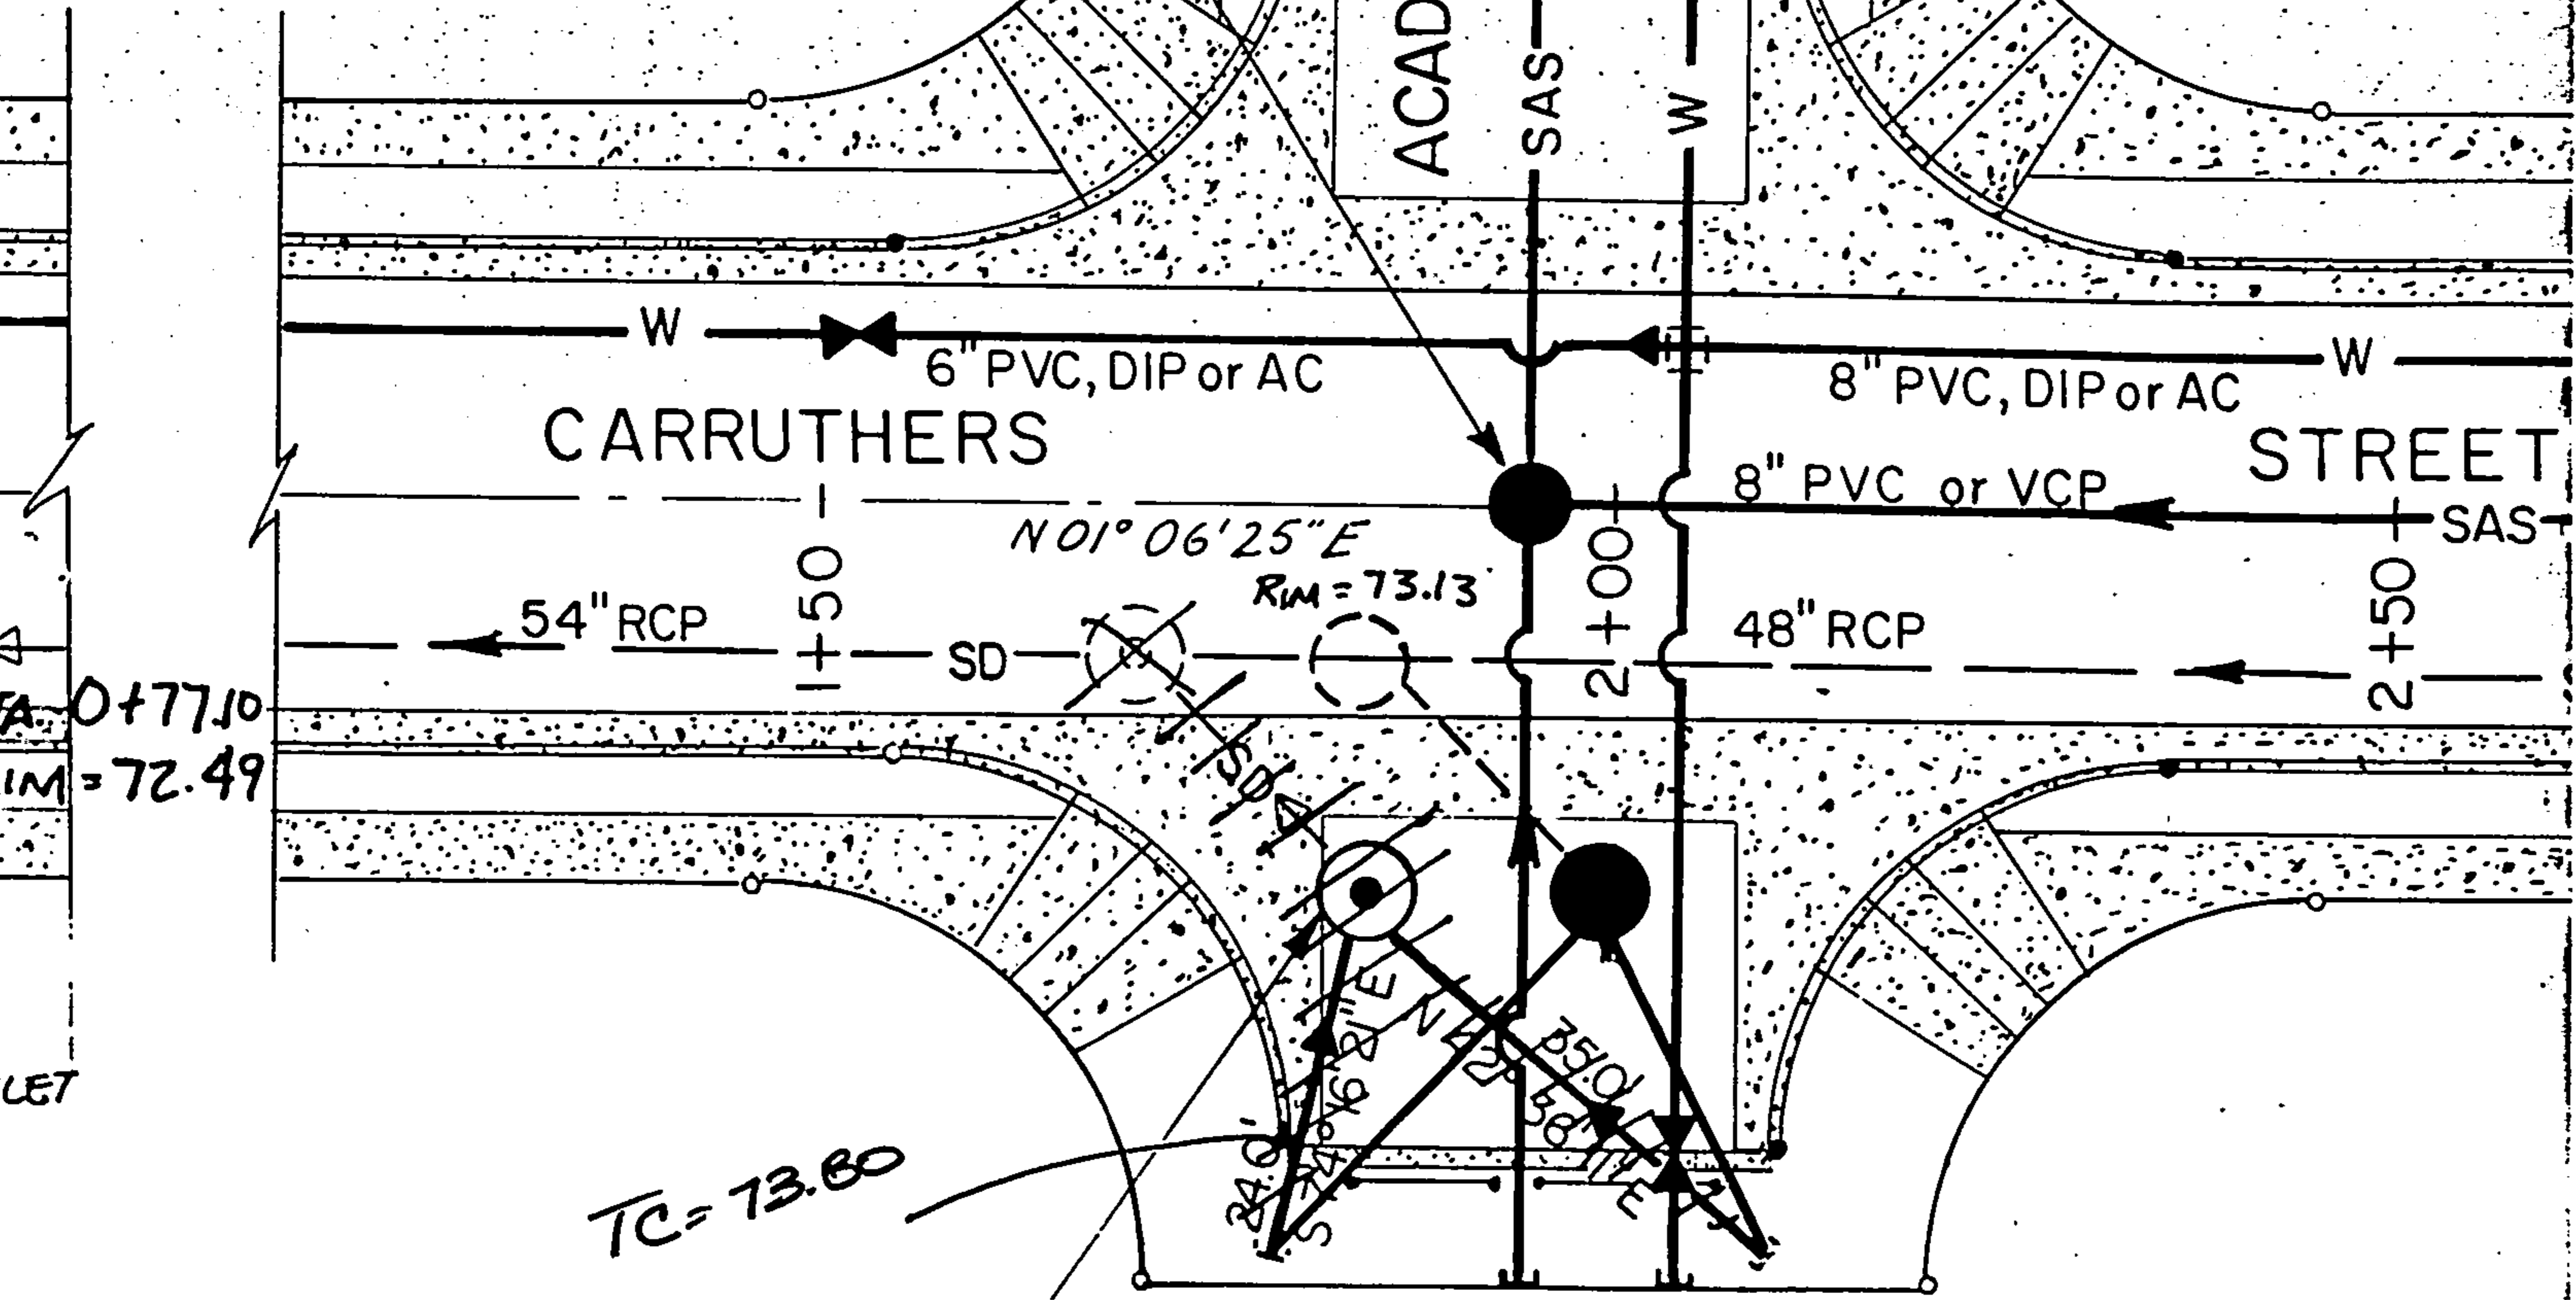


TC = 73.80

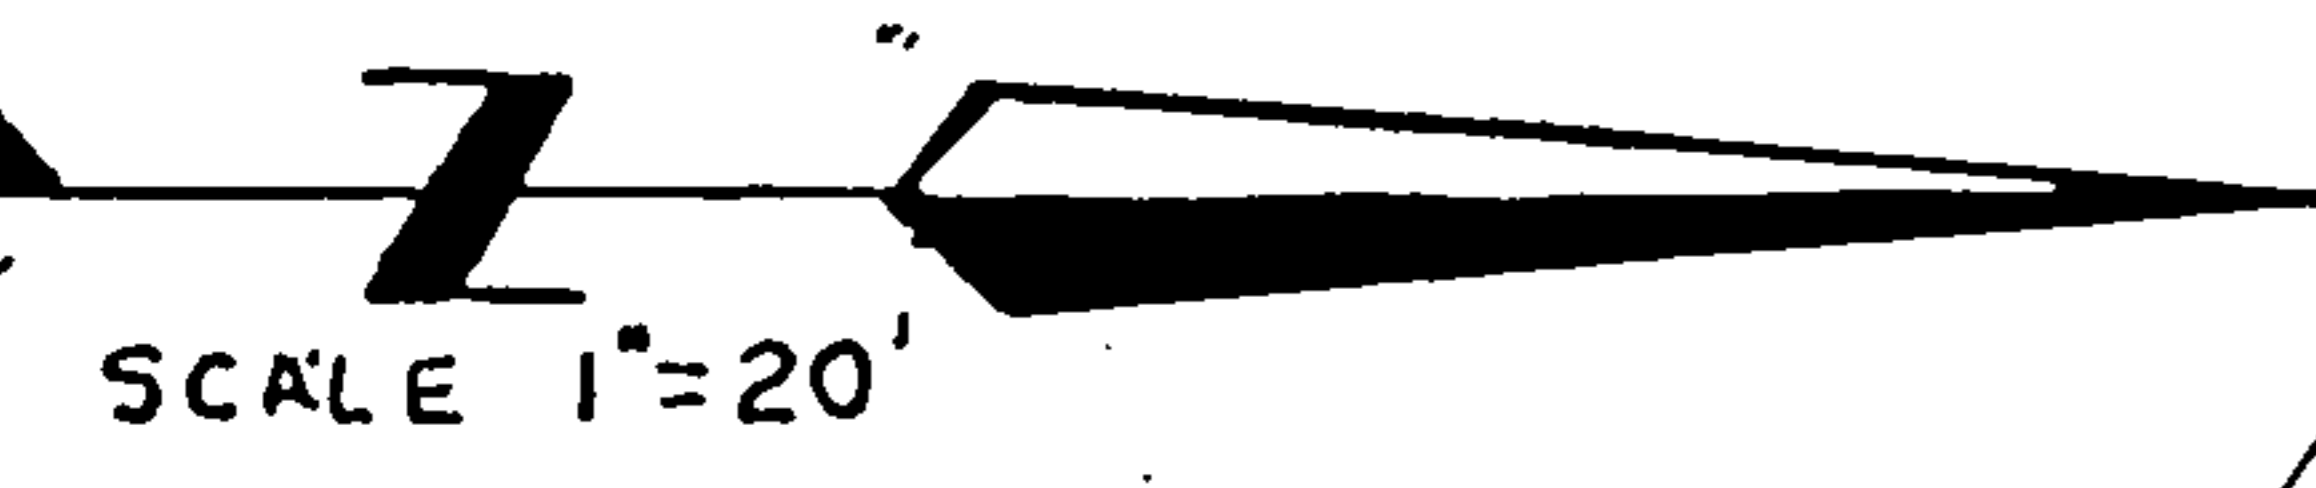

2+00
Sta ~~1+85.00~~, 25' Rt. Carruthers St.
Build 6' Dia Type 'E' M.H.
inv. (W) = 5762.66
(NE) = ~~5762.81~~ 5763.13
(SE) = ~~5763.52~~ 5766.65
Rim = ~~5773.69~~ 5773.22
Install 24"
39.24 LF 18" RCP Rt. ~~S=0.2471~~ ^{S=0.068} INV. = 69.36
21.25 LF 18" RCP Lt. ~~S=0.0110~~ INV. = 63.65
Place Sandbags at End of
Pipes to plug

98.83
~~38.83~~ Carruthers Street =
+81.75 Malaguena Lane

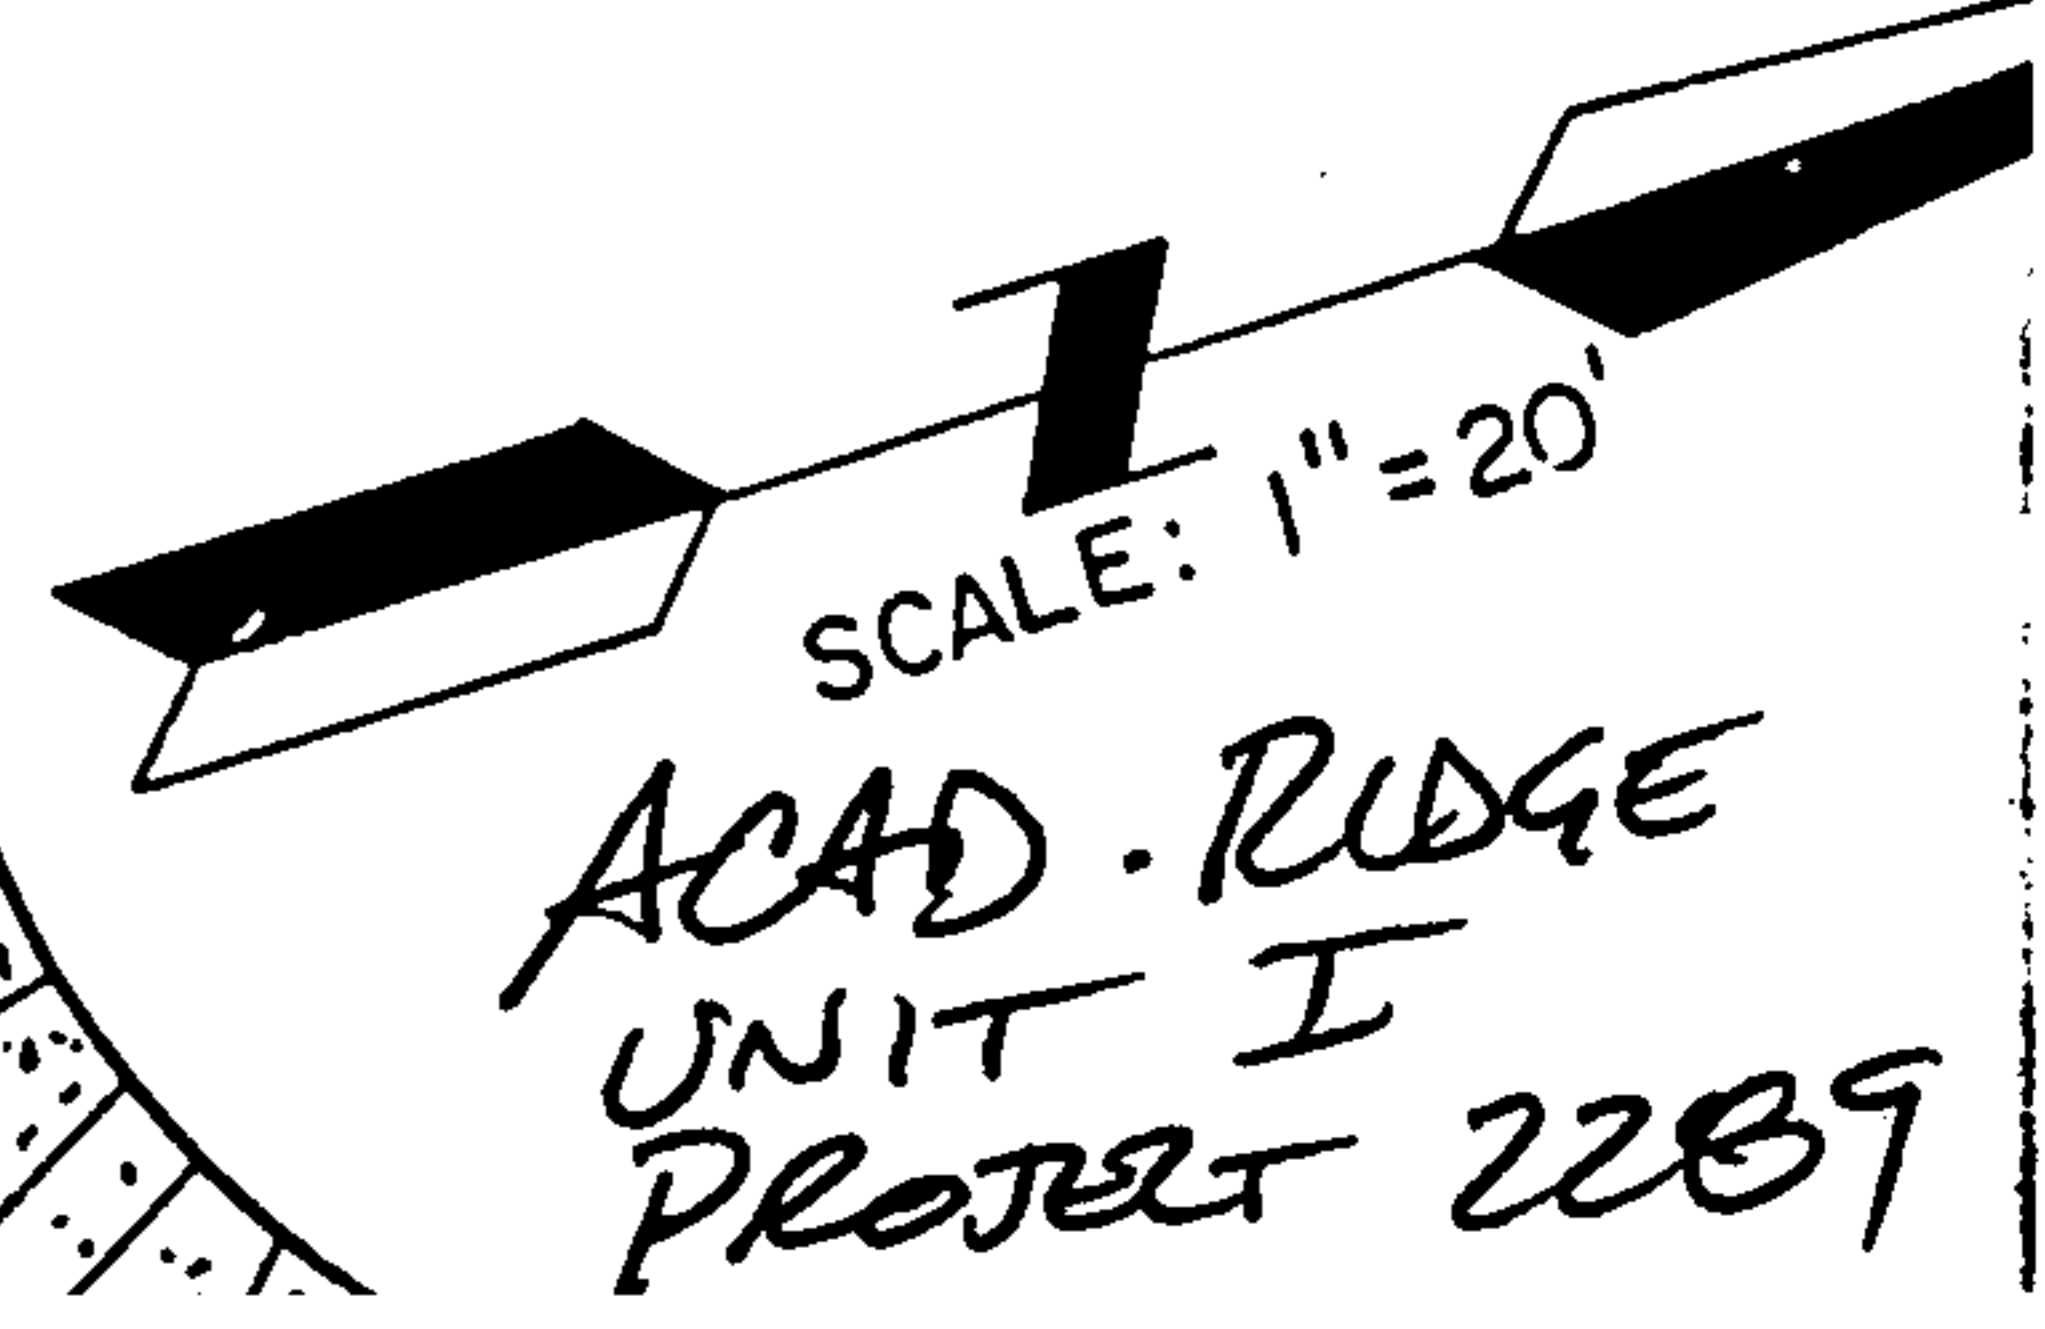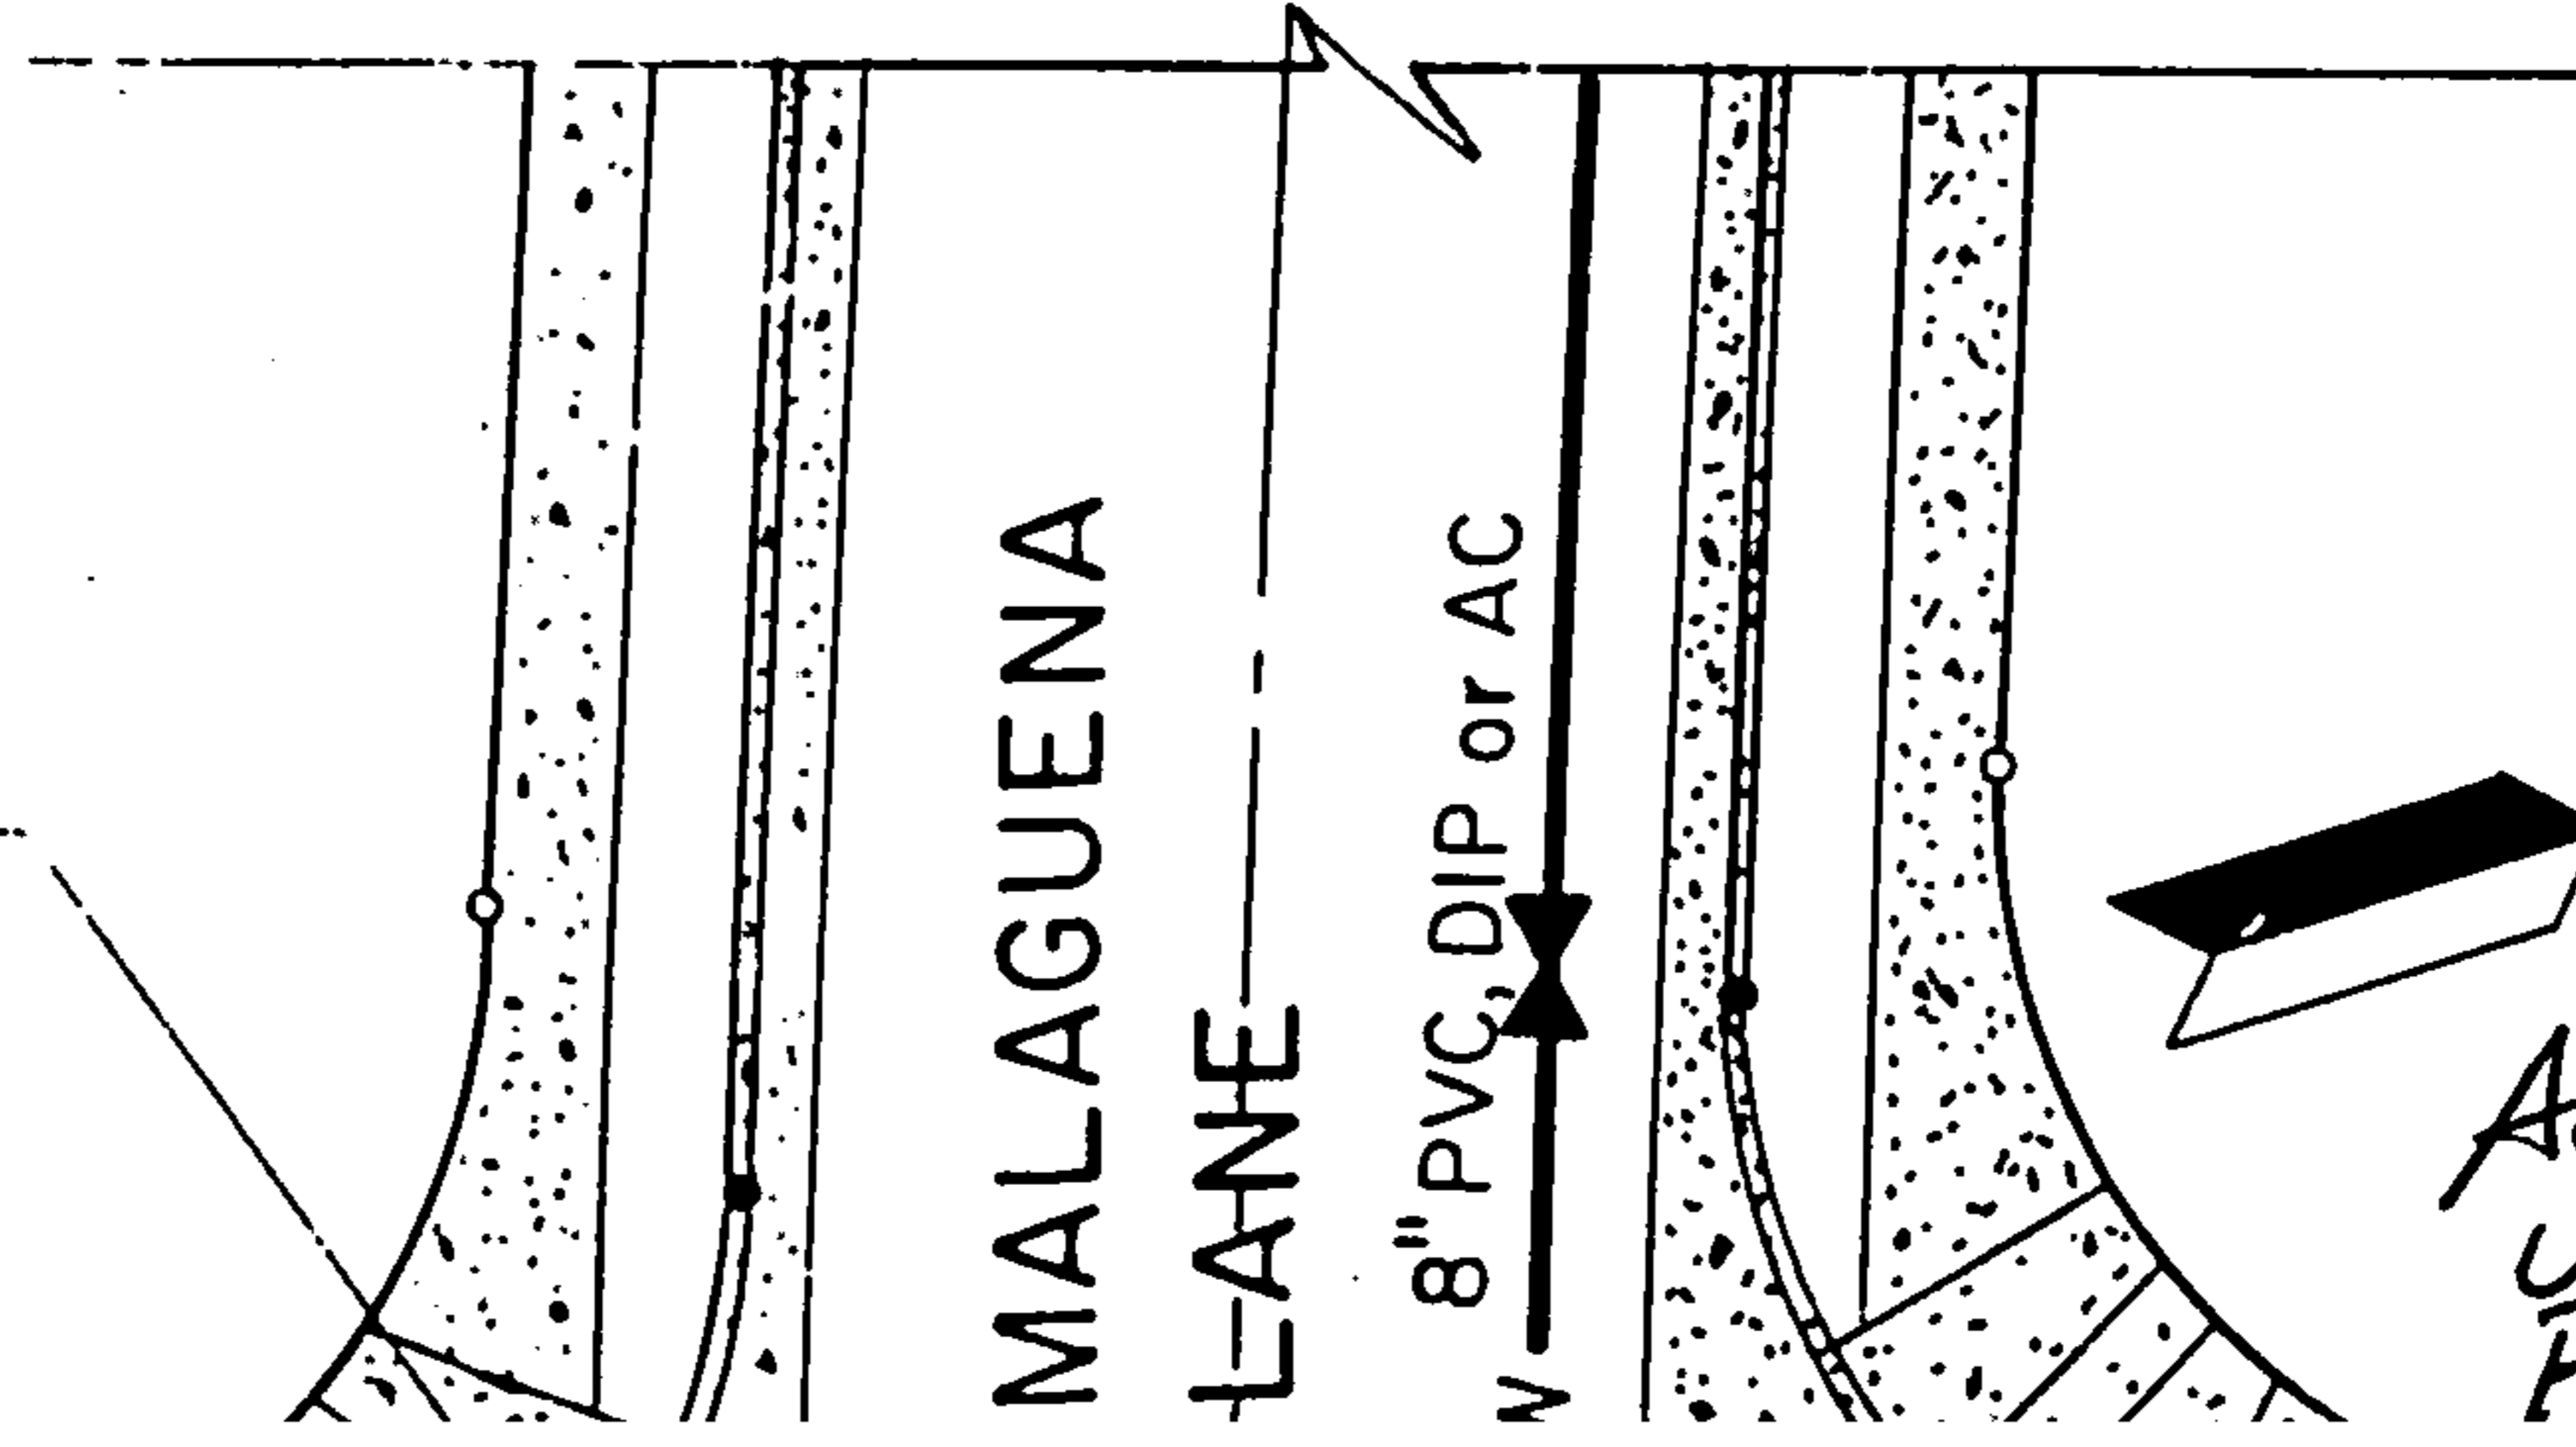

ACAD. RIDGE
UNIT I
PROJECT 2289

177
CFS

OPERATORS ST.

STA

48" RCP SD

5' 1" 1/2
S
C

18" RCP A
8 CFS

STA 1495.00

5'-18" RCP

ACADEMY RIDGE RD.

18" RCP
7 CFS

5'-15" RCP

5' 1/2
C

18" RCP
14 CFS

24" RCP
20 CFS

STA 1485-
15' RT.
BUILD 4' DIA
TYPE 'E' MH.
INU

12' 18" RCP
 $Q = 8 \text{ CFS}$
 $S = 0.01' / \text{FT}$

STA 1470.00
BUILD 6' DIA. TYPE
'E' MH.

54" RCP SD

205
CFS

INTERSECTION - CARRUTHERS ST. & ACADEMY RIDGE ROAD.

PEAK FLOW IN MAINLINE

$$Q = 177 \text{ CFS}$$

PEAK FLOW BASIN A-6 PLUS ROUTED FLOW FROM A-4

$$Q = 40 \text{ CFS}$$

ACADEMY RIDGE ROAD EAST:

$$\frac{1}{2}Q = 20 \text{ CFS}$$

$$S = 4.0\%$$

$$D = 0.45' \text{ [DPM 22.3-D-1]}$$

→ INSTALL 2-TYPE 'A' INLETS - 1 EACH SIDE

$$Q_{\text{REMOVED}} = 8 \text{ CFS PER INLET [DPM 22.3-D-5]}$$

$$Q_{\text{REMAINING}} = 40 \text{ CFS} - 16 \text{ CFS} = 24 \text{ CFS}$$

$$\frac{1}{2}Q = 12 \text{ CFS}$$

$$S = 4.0\%$$

$$D = 0.38'$$

→ INSTALL 2-TYPE 'C' INLETS - 1 EACH SIDE

$$Q_{\text{REMOVED}} = 6 \text{ CFS PER INLET}$$

TOTAL INPUT TO CARRUTHERS LATERAL =

$$16 \text{ CFS} + 12 \text{ CFS} = 28 \text{ CFS}$$

TOTAL FLOW IN CARRUTHERS LATERAL =

$$177 \text{ CFS} + 28 \text{ CFS} = 205 \text{ CFS}$$

→ INSTALL VALLEY GUTTER TO ALLOW REMAINING FLOW TO CROSS ACADEMY RIDGE ROAD AND FLOW SOUTH ON CARRUTHERS ROAD.

TOTAL FLOW ON CARRUTHERS ROAD =

$$14 \text{ CFS} + 12 \text{ CFS} = 26 \text{ CFS}$$

$$\frac{1}{2}Q = 13 \text{ CFS}$$


PROJECT NAME ACADEMY RIDGE EAST SHEET _____ OF _____

PROJECT NO. 71442 BY KID DATE 7/18/84

SUBJECT CARRUTHERS LATERAL CH'D _____ DATE _____



n Drain E =
 Bear Tributary
 54.69)
 Install E.M.D.
 Eye, Inv. 55.58
 Install E.M.D.
 Eye

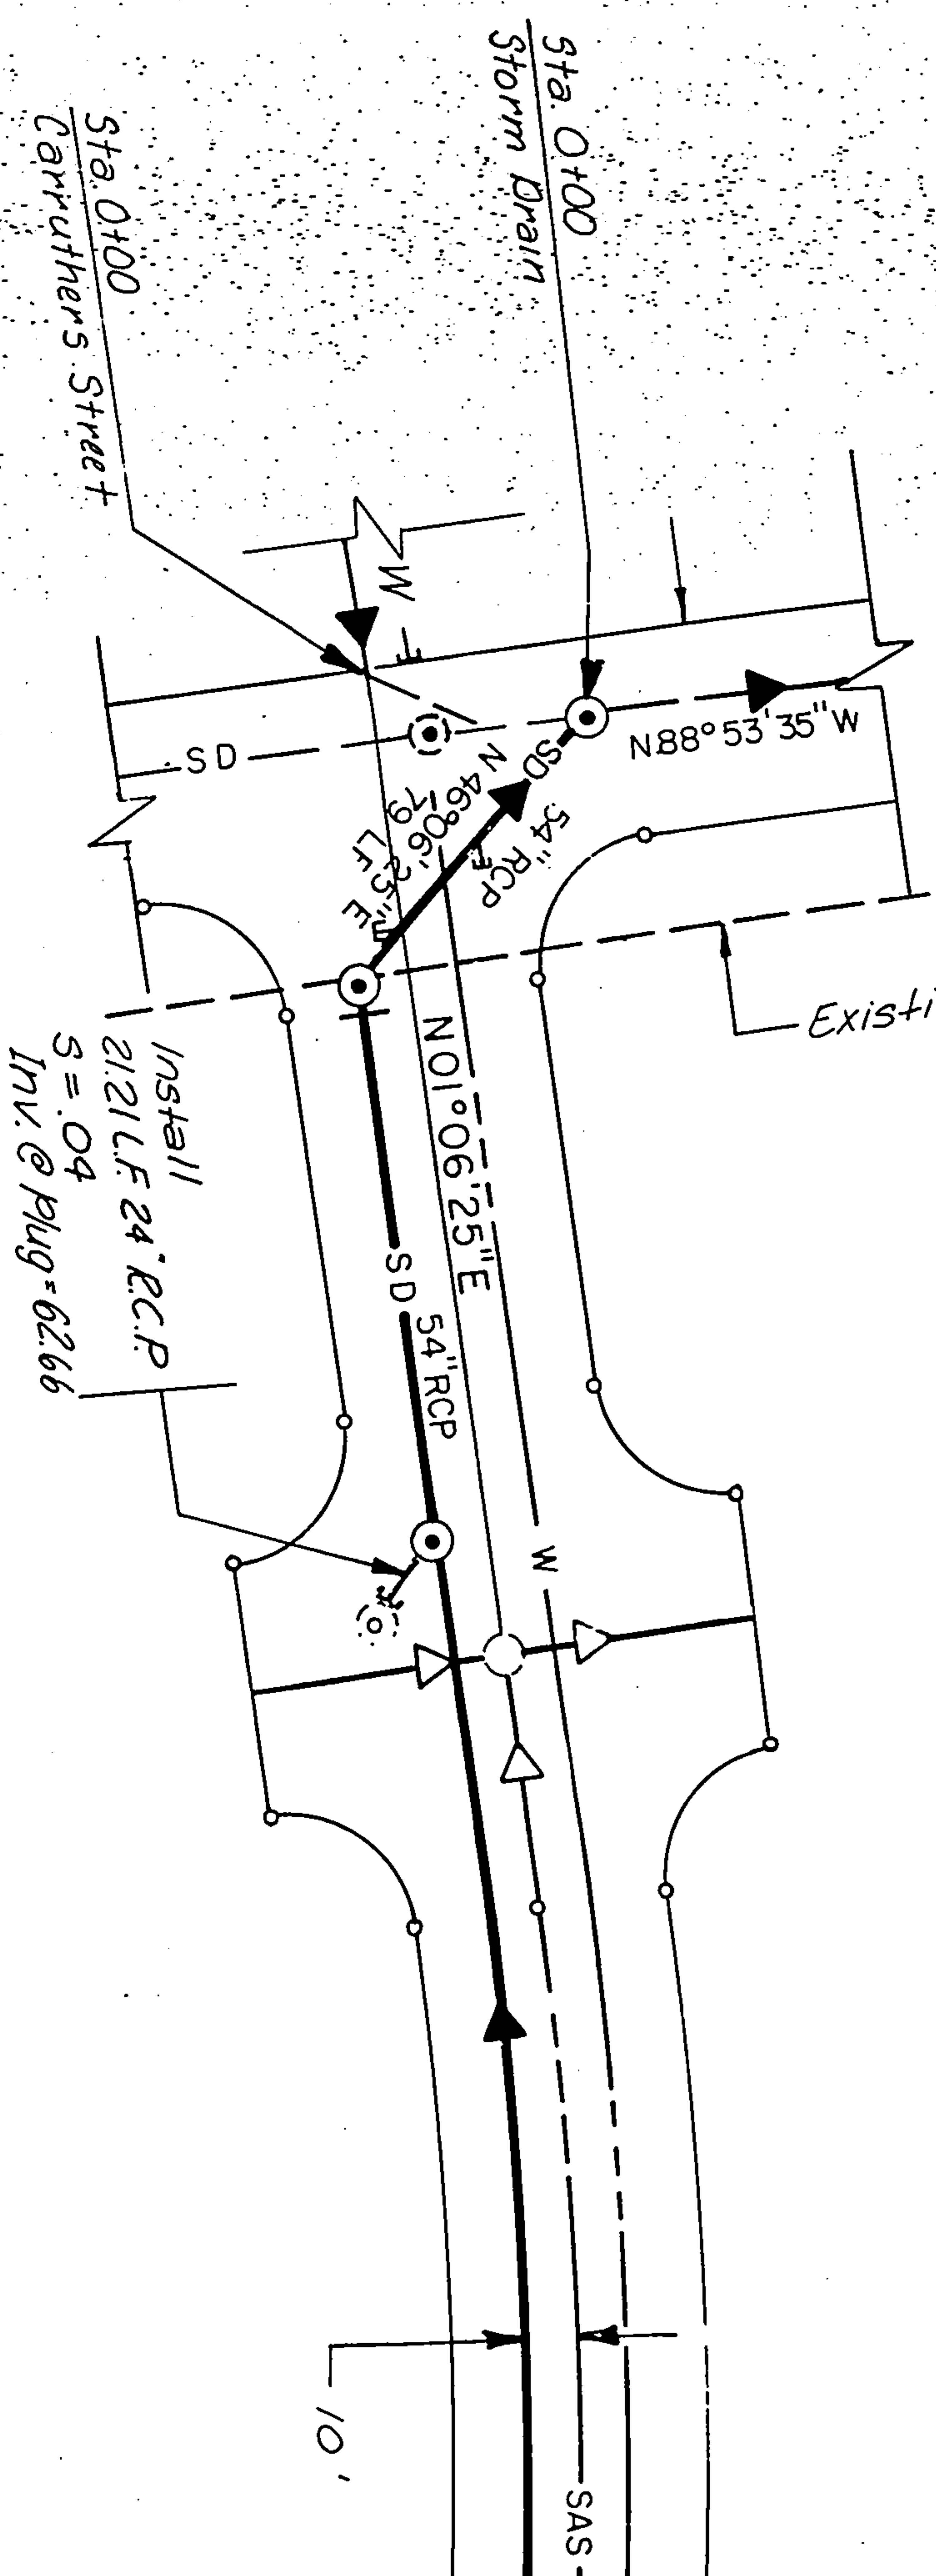

BEAR TRIBUTARY
 SEE SHEET 59
 S.A.D NO. 205

Existing 60' drainage R/W

Install
 2121 L.F. 24" R.C.P.
 S = .04
 Inv. @ Plug = 62.66

ACADEMY RIDGE

P.C. STA. 2+

1-115.00


S.A.D-205
 Project 1721

CULVERT RATING TABLE

FLOW DEPTH INCHES	18" 12CH DIAMETER PIPE FLOW AREA SQ. FT.	DISCHARGE CFS	VELOCITY FPS.
1.00000	0.03862	0.66315	1.53519
2.00000	0.16733	0.27354	2.54856
3.00000	0.19359	0.63427	3.27631
4.00000	0.29241	1.13759	3.89045
5.00000	0.40056	1.77084	4.42093
6.00000	0.51564	2.51821	4.88369
7.00000	0.63565	3.36134	5.28622
8.00000	0.75883	4.28017	5.64049
9.00000	0.88357	5.25216	5.94424
10.00000	1.00831	6.25317	6.20161
11.00000	1.13150	7.25682	6.41346
12.00000	1.25151	8.23415	6.57938
13.00000	1.36654	9.15277	6.69755
14.00000	1.47474	9.97533	6.76413
15.00000	1.57355	10.65611	6.77201
16.00000	1.65981	11.13264	6.70716
17.00000	1.72852	11.29617	6.53516
18.00000	1.76715	10.50433	5.94424


CULVERT RATING TABLE

FLOW DEPTH INCHES	24" 12CH DIAMETER PIPE FLOW AREA SQ. FT.	DISCHARGE CFS	VELOCITY FPS.
1.00000	0.04479	0.14713	3.28501
2.00000	0.12504	0.64328	5.14454
3.00000	0.22665	1.50675	6.64777
4.00000	0.34416	2.73195	7.93793
5.00000	0.47417	4.30392	9.07492
6.00000	0.61418	6.19769	10.09064
7.00000	0.76224	8.38937	11.00574
8.00000	0.91669	10.84657	11.83234
9.00000	1.07605	13.53649	12.57975
10.00000	1.23901	16.42230	13.25436
11.00000	1.40432	19.46485	13.86068
12.00000	1.57079	22.62236	14.40186
13.00000	1.73727	25.85039	14.87990
14.00000	1.90258	29.10153	15.29584
15.00000	2.06554	32.32512	15.64974
16.00000	2.22490	35.46652	15.94071
17.00000	2.37935	38.46613	16.16669
18.00000	2.52741	41.25769	16.32412
19.00000	2.66742	43.76541	16.40737
20.00000	2.79743	45.89854	16.40741
21.00000	2.91494	47.54010	16.30914
22.00000	3.01655	48.51834	16.08406
23.00000	3.09680	48.50477	15.66286
24.00000	3.14154	45.24477	14.40186

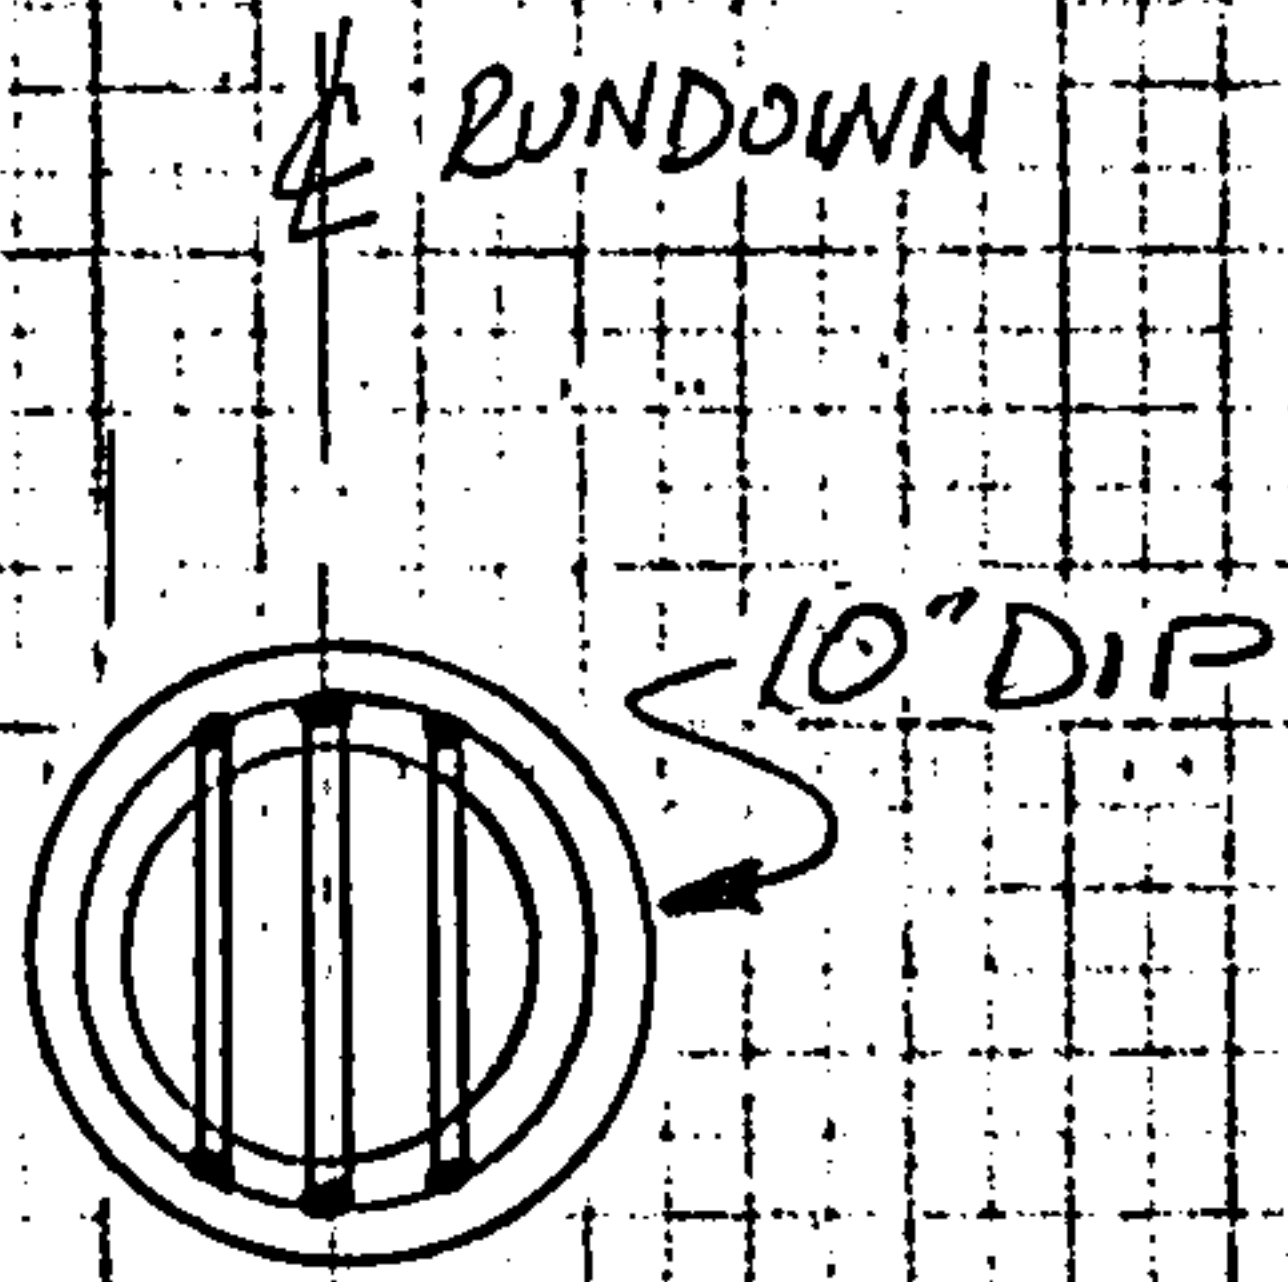

PLAN

WELD 3-#4 REBAR INTO PIPE BELL @ 2 1/2" O.C. AS SHOWN FOR SAFETY GRATING

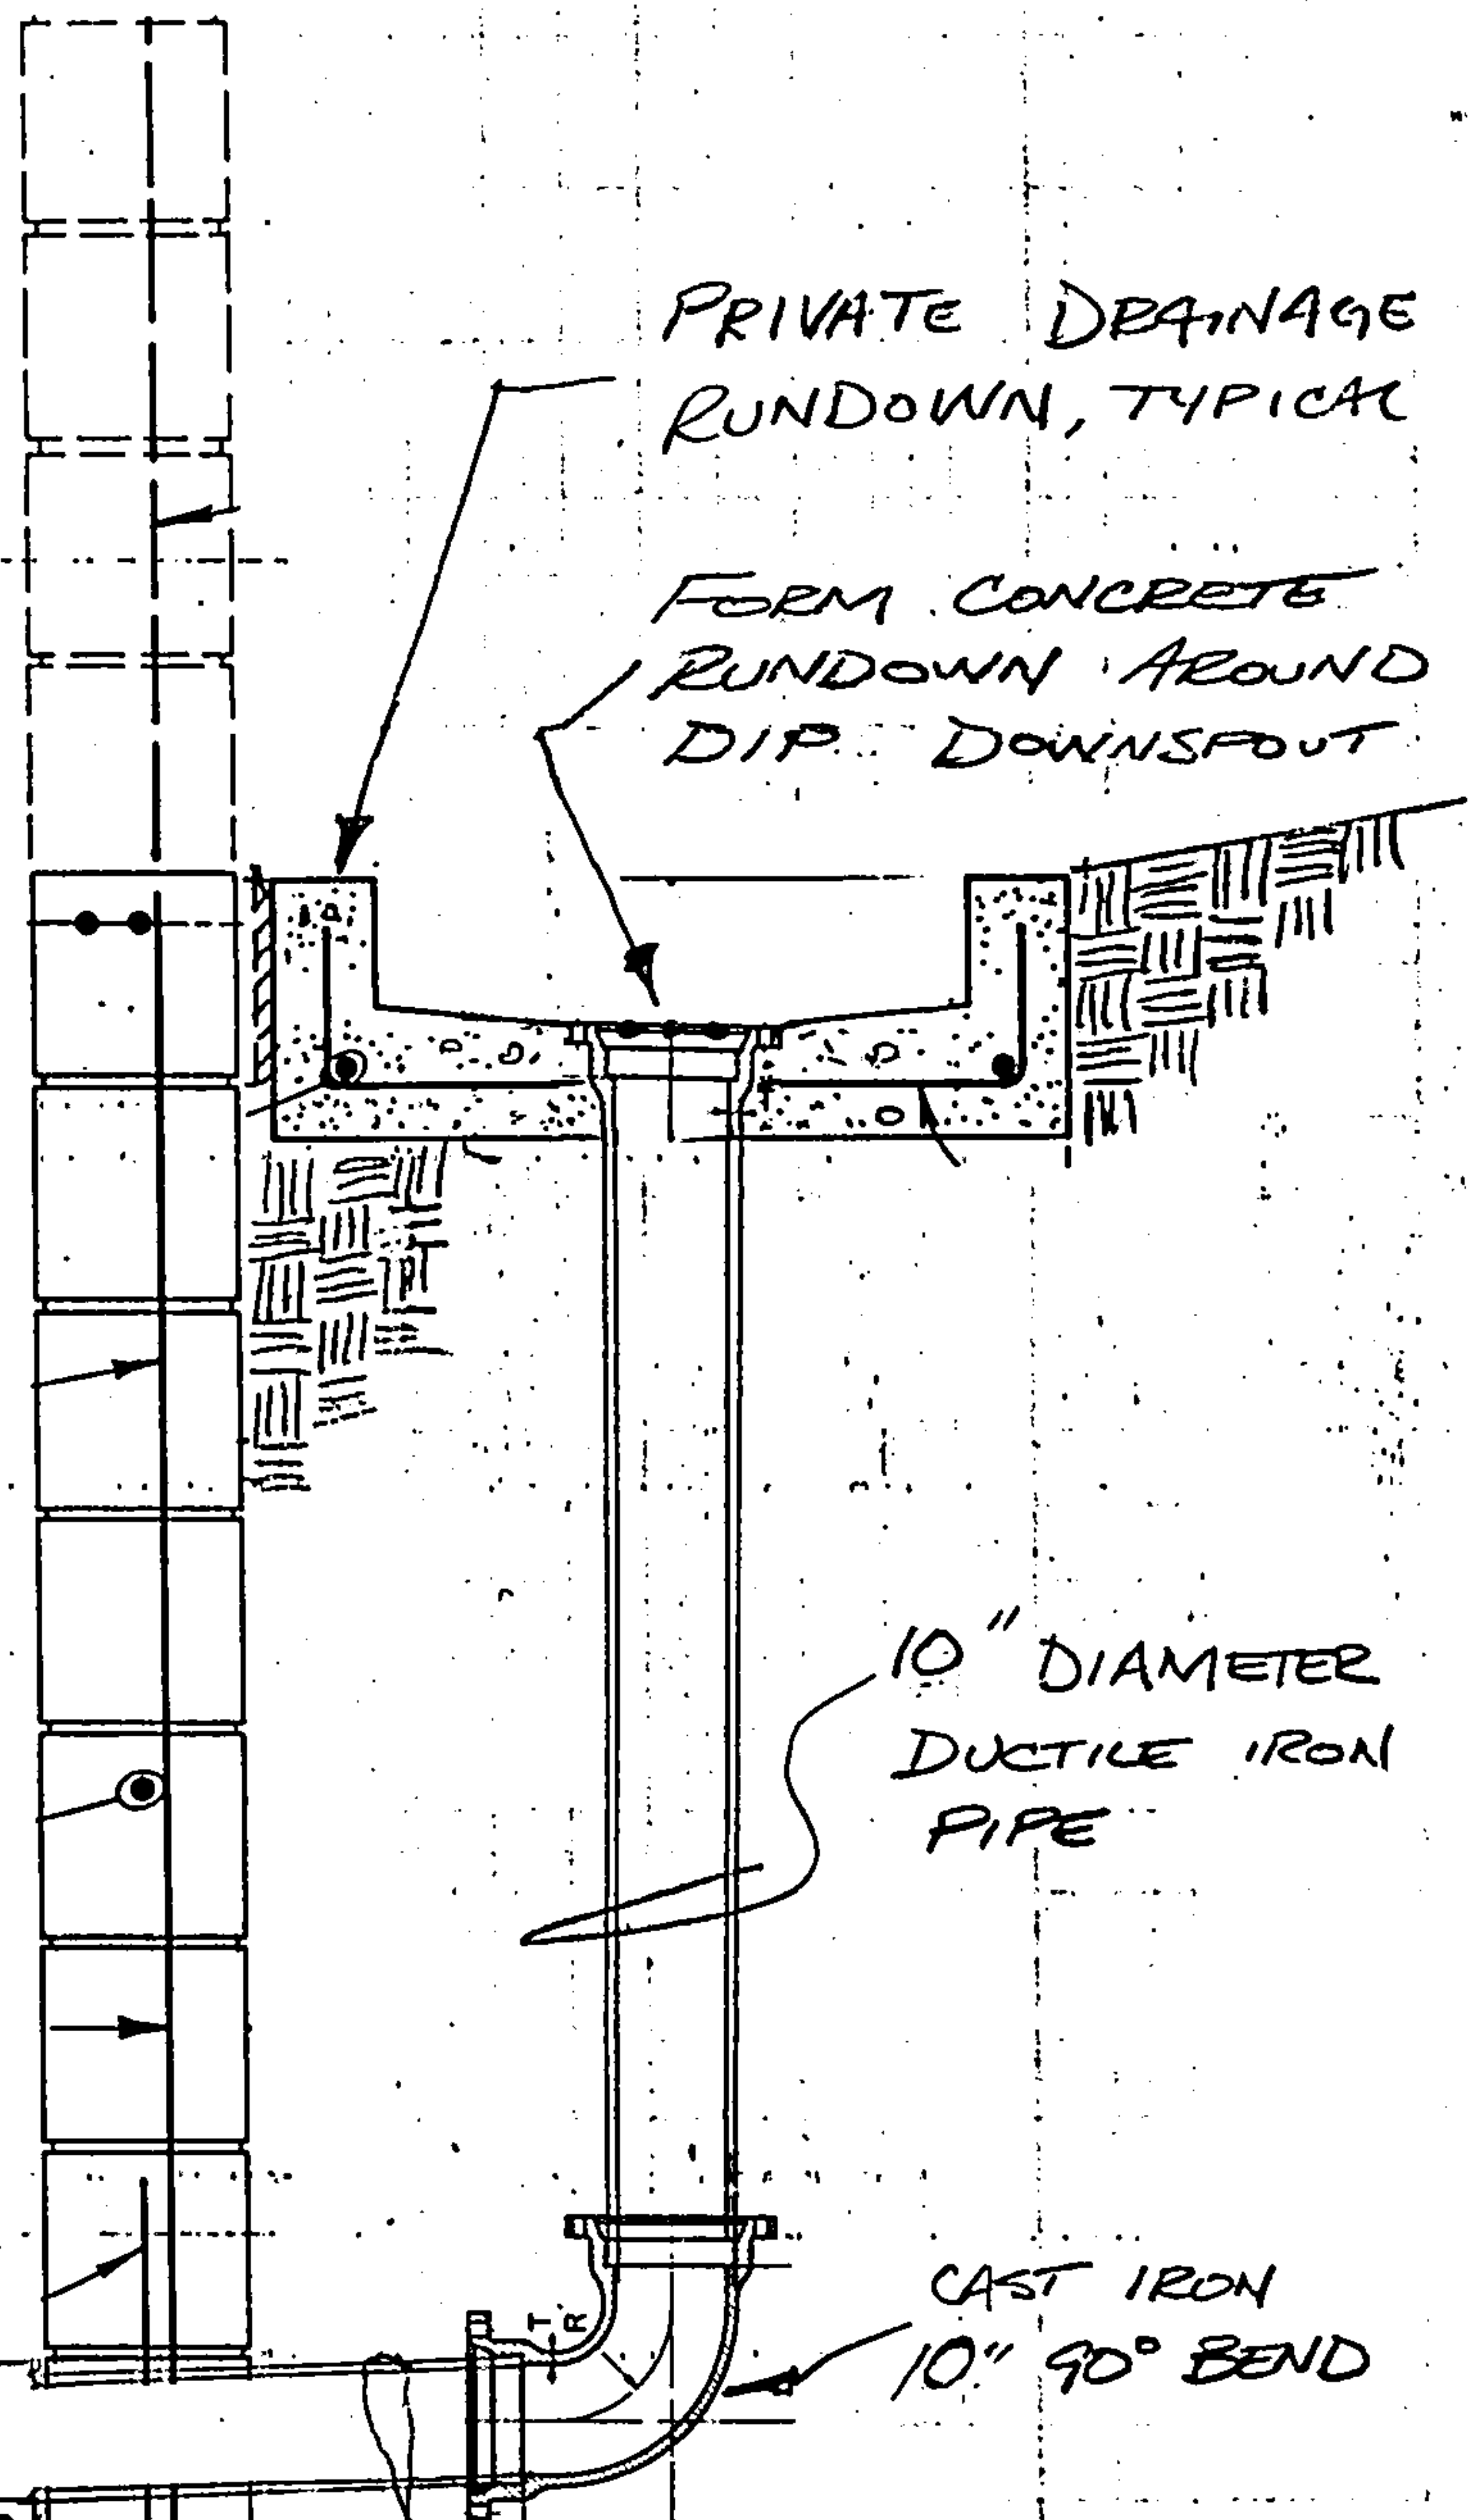

PRIVATE DRAINAGE RUNDOWN, TYPICAL


FORM CONCRETE RUNDOWN AROUND DIP. DOWNSPOUT

10" DIAMETER DUCTILE IRON PIPE

CAST IRON 10" 90° BEND

10" DIP

STD RUNDOWN SECTION AS SHOWN UPPER RE

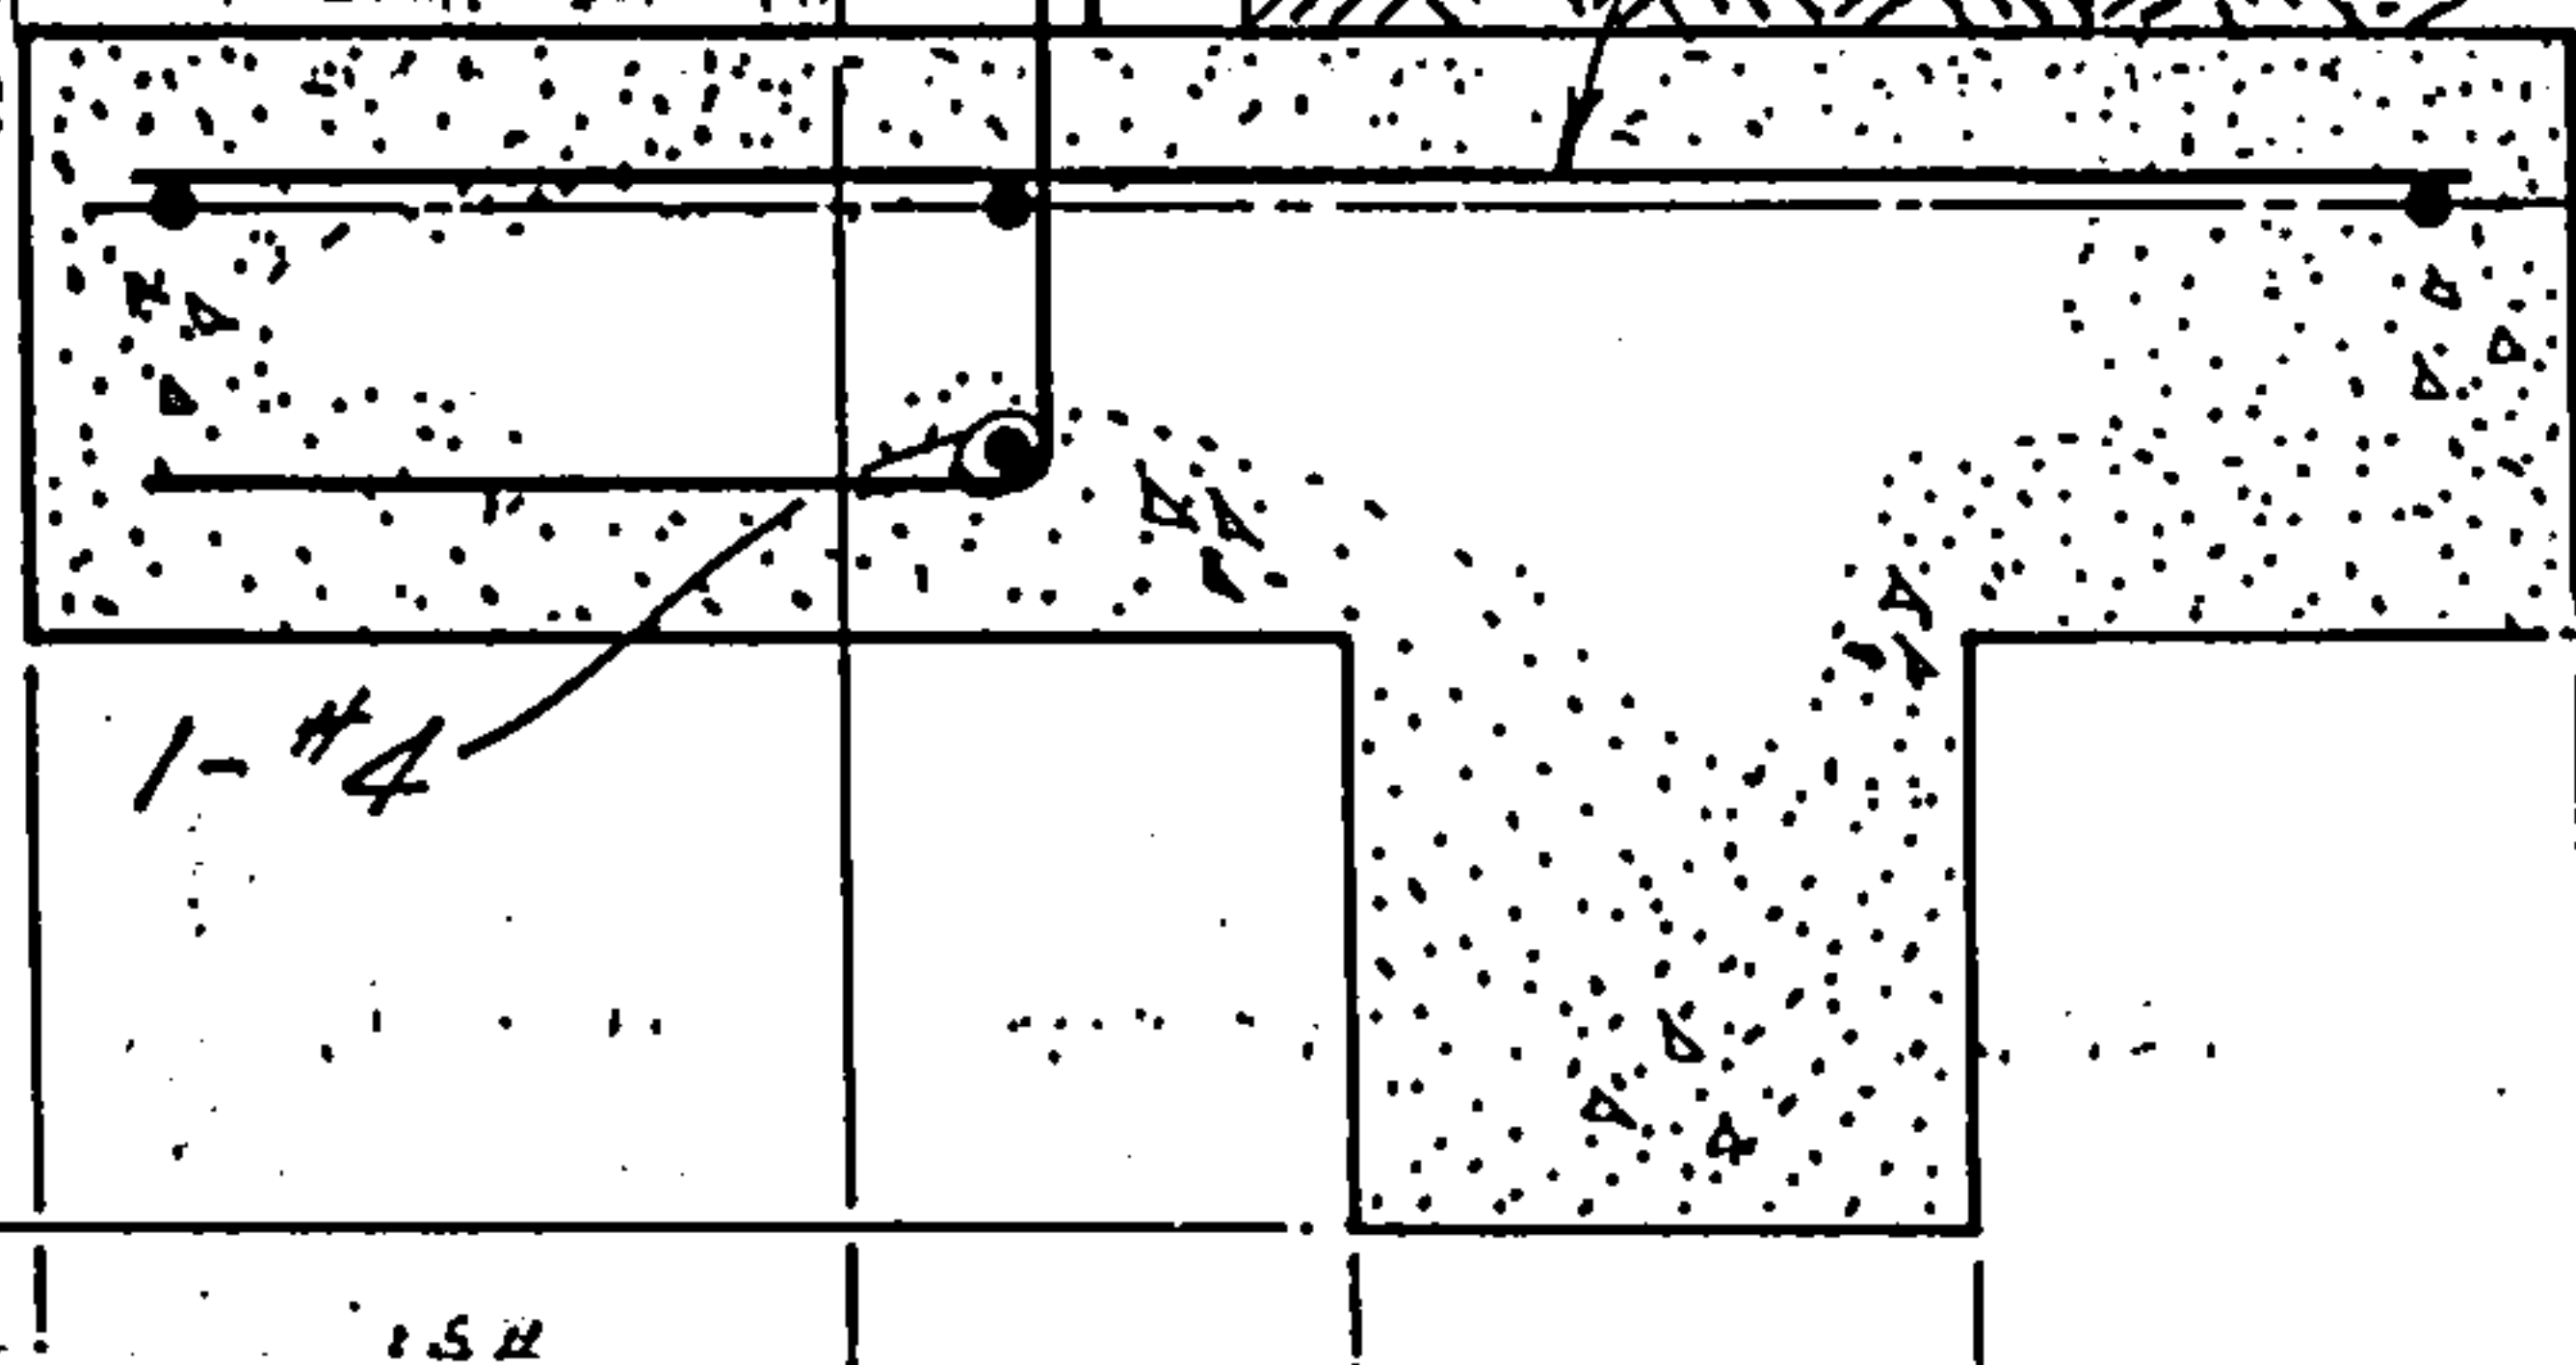


1-#4

1.5H



PROJECT NAME ACADEMY RIDGE EAST SHEET 1 OF 1
 PROJECT NO. 61820 BY K. DAVIS DATE _____
 SUBJECT DOWNSPOUT DETAIL CH'D _____ DATE _____

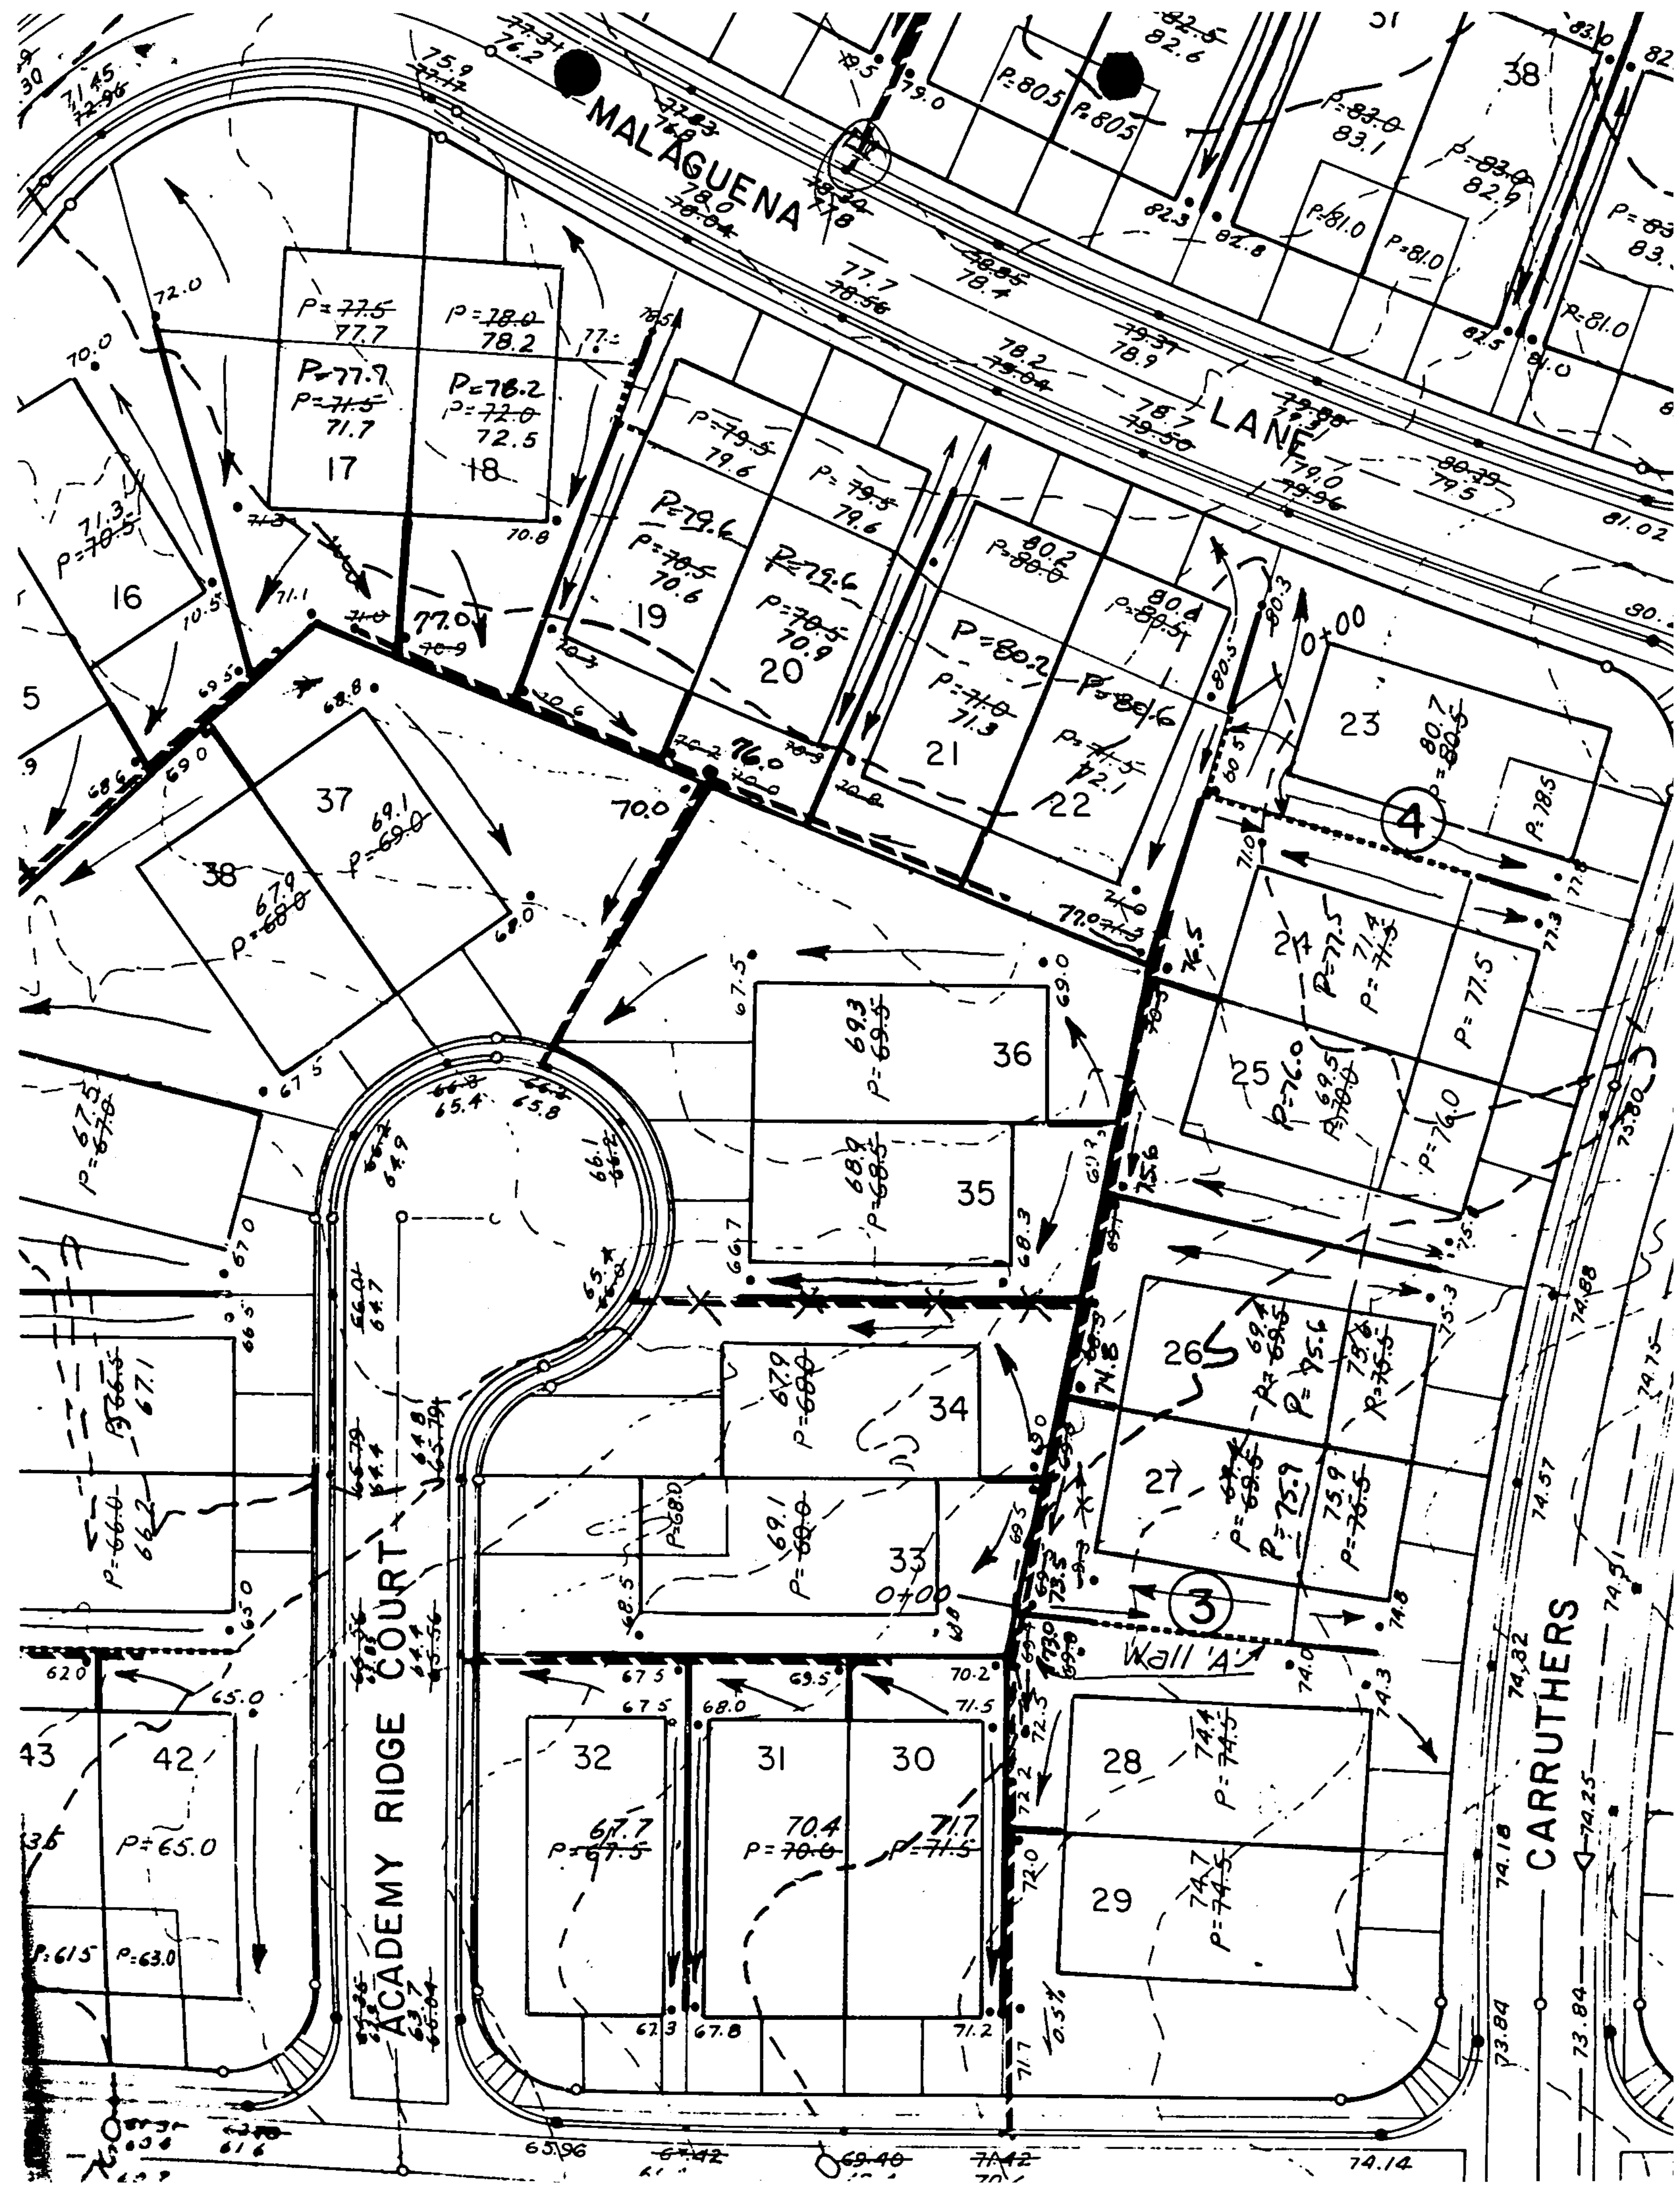


Only PROJECT: Academy Ridge East

SUMMARY OF HYDRAULIC CALCULATIONS

BY: KLS
DATE: 24 Feb '86
SHEET 1 OF 1

STATION	STRUC	CONDUIT						OPEN CHANNEL FLOW								PRESSURE CONDUIT								ELEVATIONS							
		Q	n	PIPE	L	S	S _f	PIPE HYDRAULICS				LOSSES				LOSSES								E.G.	hv	H.G.	soffit	d _n	invert		
								Q _{full}	q _{full}	q _{D-full}	d _n	V _{full}	V _{v_{full}}	V	H _f	H _x	A	V	H _f	H _b	H _j	H _{mh}	H _x							E _{hl}	
0+00	WYE																								26 ²¹	1.30	24 ⁹¹		2 ⁰¹	22 ⁹⁰	
0+34 ⁴⁹	45° Bend	45	0.013	36"	34 ⁴⁹	0.010	0.00455	67	0 ⁶⁷	0 ⁶⁷	2 ⁰¹	9 ⁴⁴	0 ⁹⁷	9 ¹⁶	0 ³⁴											26 ⁵⁵	1.30	25 ²⁵	.71	2 ⁰¹	23 ²⁴
2+02 ⁶⁹	MH	45	0.013	36"	168 ²⁰	0.010	0.00455	67	0 ⁶⁷	0 ⁶⁷	2 ⁰¹	9 ⁴⁴	0 ⁹⁷	9 ¹⁶	1 ⁶⁸	0 ⁰⁹										26 ⁵⁵	1.30	25 ²⁵		2 ⁰¹	23 ²⁴
4+98 ⁰⁶	MH	25	0.013	24"	295 ³⁷	0.020	0.01221	32	0 ⁷⁸	0 ⁷³	1 ⁴⁶	10 ¹⁹	0 ⁹⁸	9 ⁹⁹	5 ⁹¹										28 ³²	1.30	27 ⁰²		2 ⁰¹	25 ⁰¹	
5+12 ⁴⁷	MH	25	0.013	24"	234 ¹¹	0.020	0.01221	32	0 ⁷⁸	0 ⁷³	1 ⁴⁶	10 ¹⁹	0 ⁹⁸	9 ⁹⁹	0 ¹⁷										28 ⁰²	1.55	26 ⁴⁷		1 ⁴⁶	25 ⁰¹	
																									33 ⁹³	1.55	32 ³⁸		1 ⁴⁶	30 ⁹²	
																									33 ⁹³	1.55	32 ³⁸		1 ⁴⁶	30 ⁹²	
																									34 ⁴⁰	1.55	32 ⁸⁵		1 ⁴⁶	31 ³⁹	

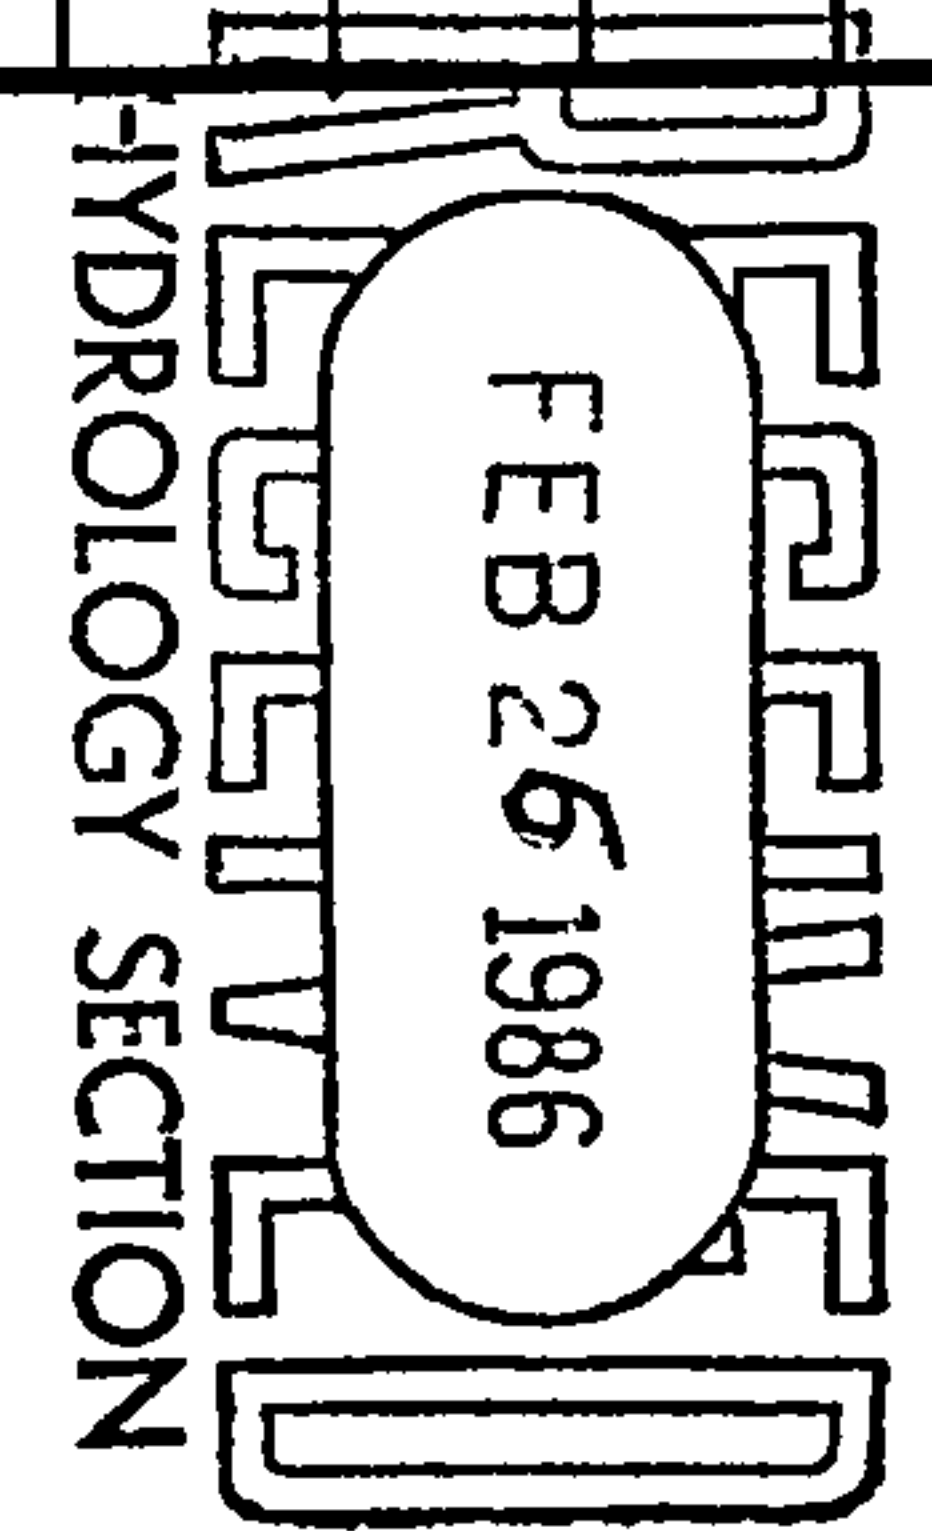

For inlet design only - SD is existing

INTERSECTION - CARRUTHERS ST. & ACADEMY RIDGE ROAD.

PEAK FLOW IN MAINLINE

Q = 177 CFS

PEAK FLOW BASIN A-6 PLUS ROUTED FLOW FROM A-4

Q = 40 CFS

ACADEMY RIDGE ROAD EAST:

1/2 Q = 20 CFS

S = 4.0%

D = 0.45' [DPM 22.3-D-1]

INSTALL 2-TYPE 'A' INLETS - 1 EACH SIDE

Q REMOVED = 8 CFS PER INLET [DPM 22.3-D-5]

Q REMAINING = 40 CFS - 16 CFS = 24 CFS

1/2 Q = 12 CFS

S = 4.0%

D = 0.38'

INSTALL 2-TYPE 'C' INLETS - 1 EACH SIDE

Q REMOVED = 6 CFS PER INLET

TOTAL INPT. TO CARRUTHERS LATERAL =

16 CFS + 12 CFS = 28 CFS

TOTAL FLOW IN CARRUTHERS LATERAL =

177 CFS + 28 CFS = 205 CFS

INSTALL VALLEY GUTTER TO ALLOW REMAINING FLOW TO CROSS ACADEMY RIDGE ROAD AND FLOW SOUTH ON CARRUTHERS ROAD.

TOTAL FLOW ON CARRUTHERS ROAD =

14 CFS + 12 CFS = 26 CFS

1/2 Q = 13 CFS



PROJECT NAME ACADEMY RIDGE EAST SHEET _____ OF _____
PROJECT NO. 41442 BY KLD DATE 7/18/84
SUBJECT CARRUTHERS LATERAL CH'D _____ DATE _____

SUMP CONDITION ON CARRUTHERS ROAD @ STA 740.59

$$TC = 72.98$$

CHECK REQUIRED HEAD FOR DISCHARGE = 13 CFS PER INLET

$$Q = CA\sqrt{2.3H} \quad (C \text{ FACTOR FOR CONDUIT} = 0.6)$$
$$(A \text{ FOR } 18" \text{ PIPE} = 1.77 \text{ S.F.})$$

$$13 \text{ CFS} = (0.6)(1.77)\sqrt{2(32.2)H}$$

$$13 = 1.06\sqrt{64.4H}$$

$$12.26 = \sqrt{64.4H}$$

$$150.33 = 64.4H$$

$$2.33' = H \text{ REQUIRED}$$

→ INSTALL 2-TYPE A INLETS @ STA 740.5

TOTAL INPUT TO CARRUTHERS LATERAL = 26 CFS

TOTAL FLOW IN CARRUTHERS LATERAL @ BEAR TRIS

$$205 \text{ CFS} + 26 \text{ CFS} = 231 \text{ CFS}$$



PROJECT NAME ACADEMY RIDGE EAST SHEET _____ OF _____
PROJECT NO. 41442 BY KUD DATE 7/18/04
SUBJECT CARRUTHERS LATERAL DESIGN CH'D _____ DATE _____

From ACADEMY RD

150 cfs

5/8" burg

single
C

STA 5+98.83

MACAQUENA

18" RCP
13.5 cfs


18" RCP
13.5 cfs

24" RCP
27 cfs

STA 5+73.83 15' ET.
BUILD 6' DIA
TYPE 'C' MK.

177
cfs

TO ACADEMY
RIDGE RD

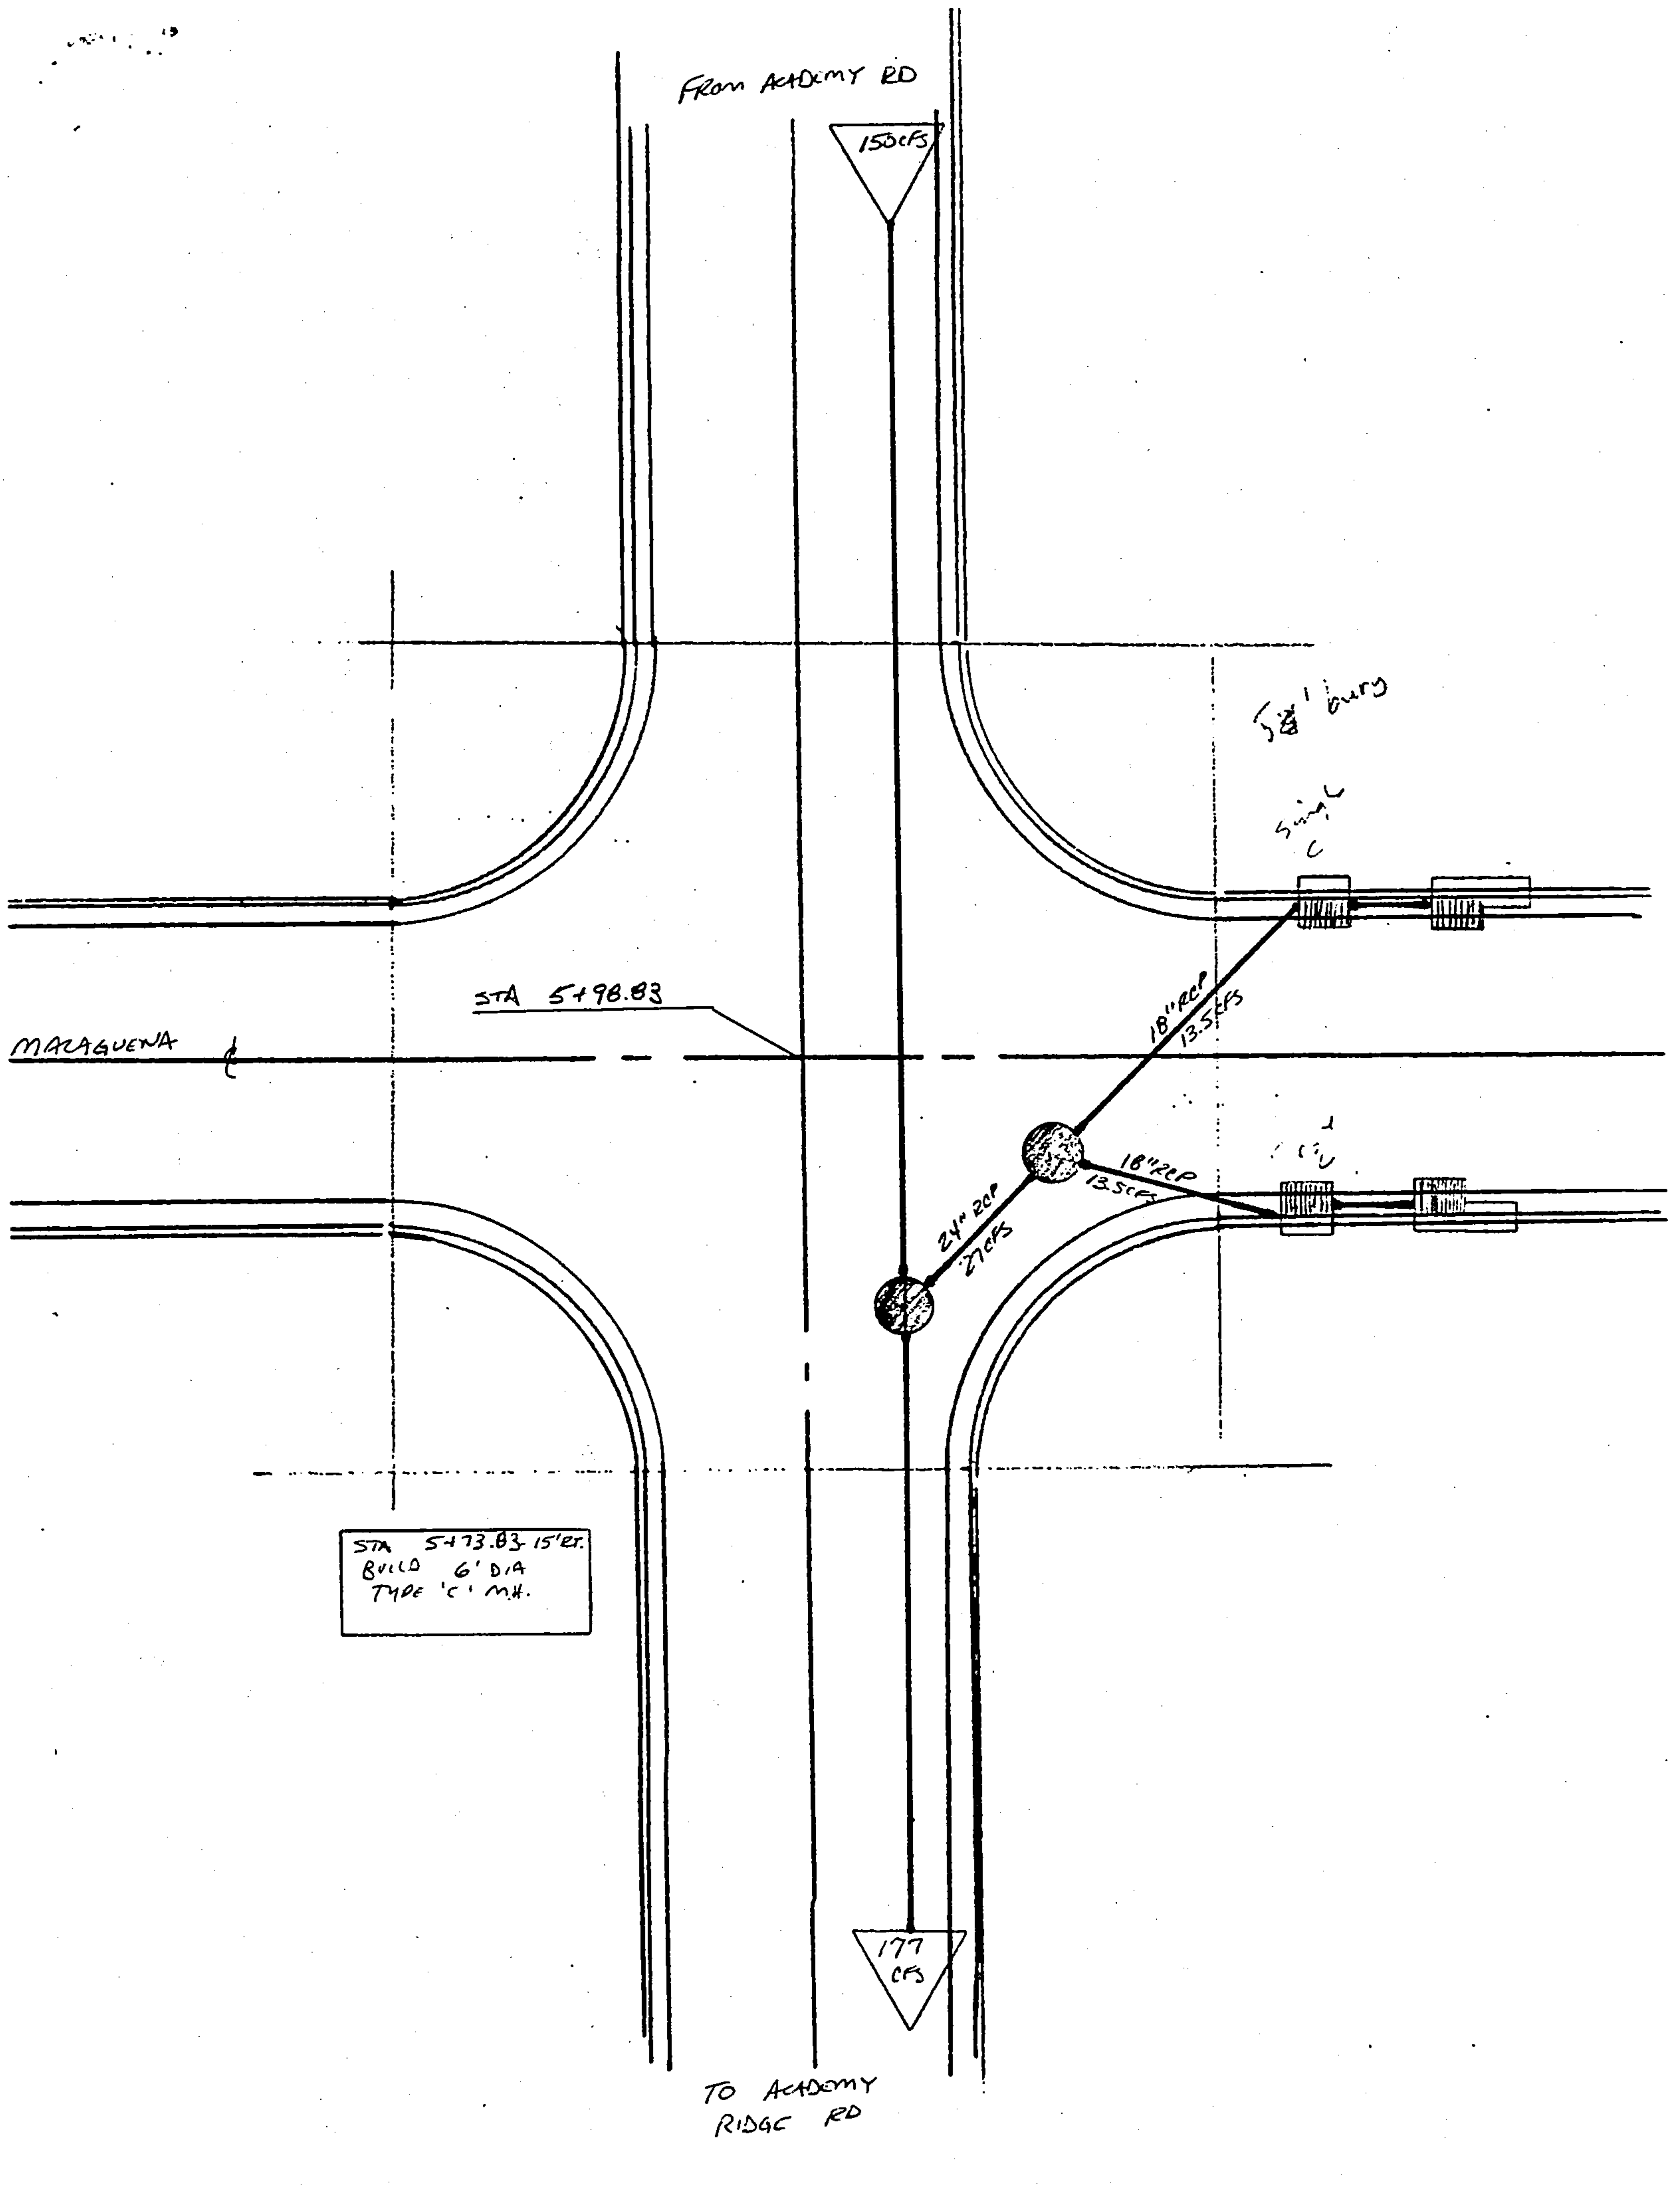

FROM MALDEN

CREIGHTON ST

177
CFS

48" RCP SD

STA

5' 8" long

SIMP
C

18" RCP
8 CFS

8'-18" RCP

STA 1495.00

ACADEMY RIDGE RD.

18" RCP
14 CFS

8'-18" RCP

SIMP
C

18" RCP
14 CFS


24" RCP
28 CFS

STA 1485-
15' R.
BUILD 4' DIA
TYPE 'E' MH.
INV

STA 1470.00
BUILD 6' DIA. TYPE
'E' MH.

54" RCP SD

205
CFS

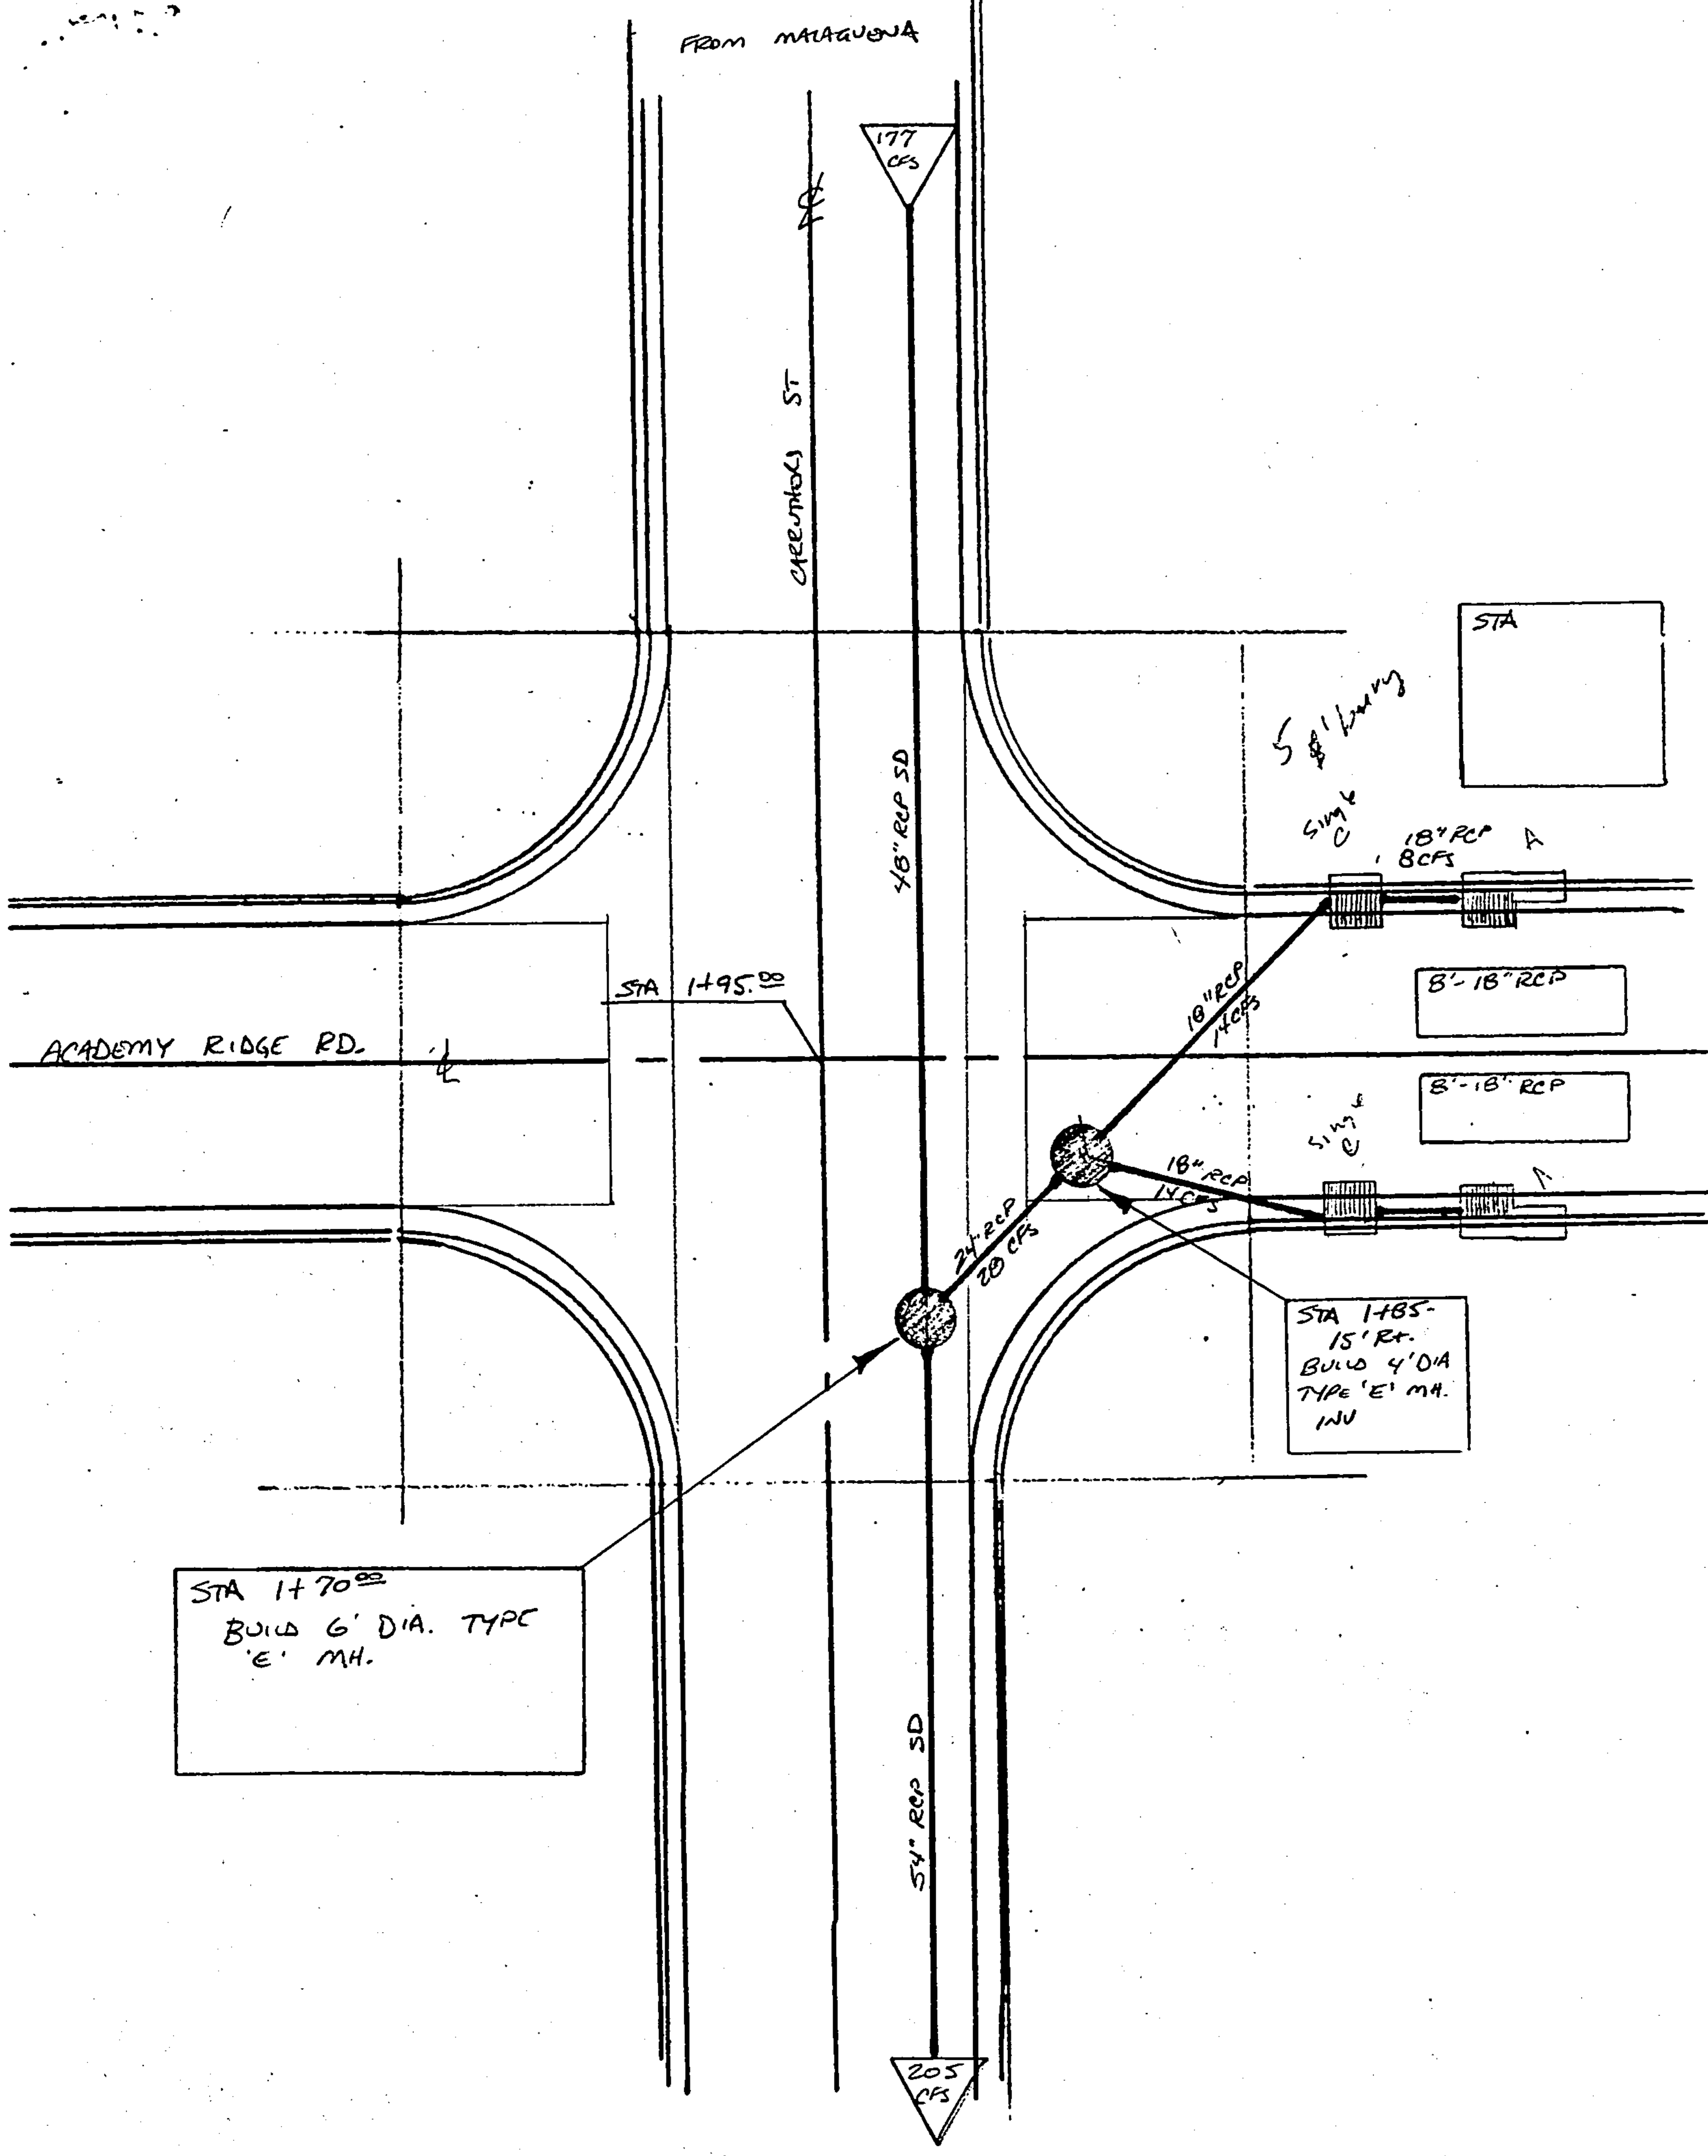

UNDEVELOPED FLOWS FROM EAST OF CARRUTHERS.

LAST INLET MIT. ON BEAR TRIS @ STA. 4B+50 - NEAR
NORTHEAST CORNER OF ACADEMY PLACE UNIT 5.

$$i = (2.6)(6.84)(10 \text{ min})^{-.51} = 5.50$$

BASIN	D.A.	C _{FACTOR}	i	Q _{UNDEVELOPED}
A-1	7.1	0.34	5.5	13.3
A-3	5.1			9.5
A-5	9.4			17.6
A-6	8.3			15.5
A-9	2.3			4.3
TOTAL	32.2			60.2 cfs

BUILD 1-TYPE DOUBLE 'D' INLET @ ALLEY INTERSECTION
EAST OF CARRUTHERS

ASSUME FLOW DEPTH = 0.5'

$$Q_{REMOVED} = 10 \text{ cfs}$$

BUILD 2-TYPE 'A' INLETS ON CARRUTHERS AT SAG
SUMP CONDITION

$$Q_{REMAINING} = 60 \text{ cfs} - 10 = 50 \text{ cfs} \text{ OR } 25 \text{ cfs PER INLET.}$$

WITH 18" CONNECTOR PIPES:

$$Q = CA \sqrt{2gh}$$

$$25 = (0.6)(1.77) \sqrt{64.4h}$$

$$23.54 = \sqrt{64.4h}$$

$$554.15 = 64.4h$$

$$8.6' = h$$



$$-0.2'$$

8.4' = MINIMUM DEPTH OF INLET BELOW TOP OF CURB.

$$TC = 5772.96$$

$$INVERT = 5764.00$$

DEPTH PROVIDED = 8.96'

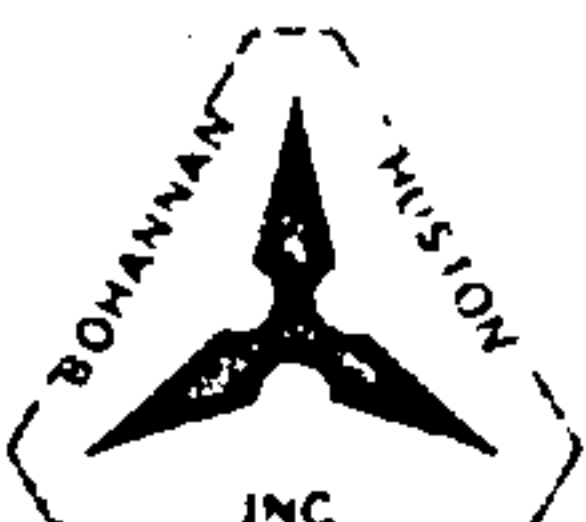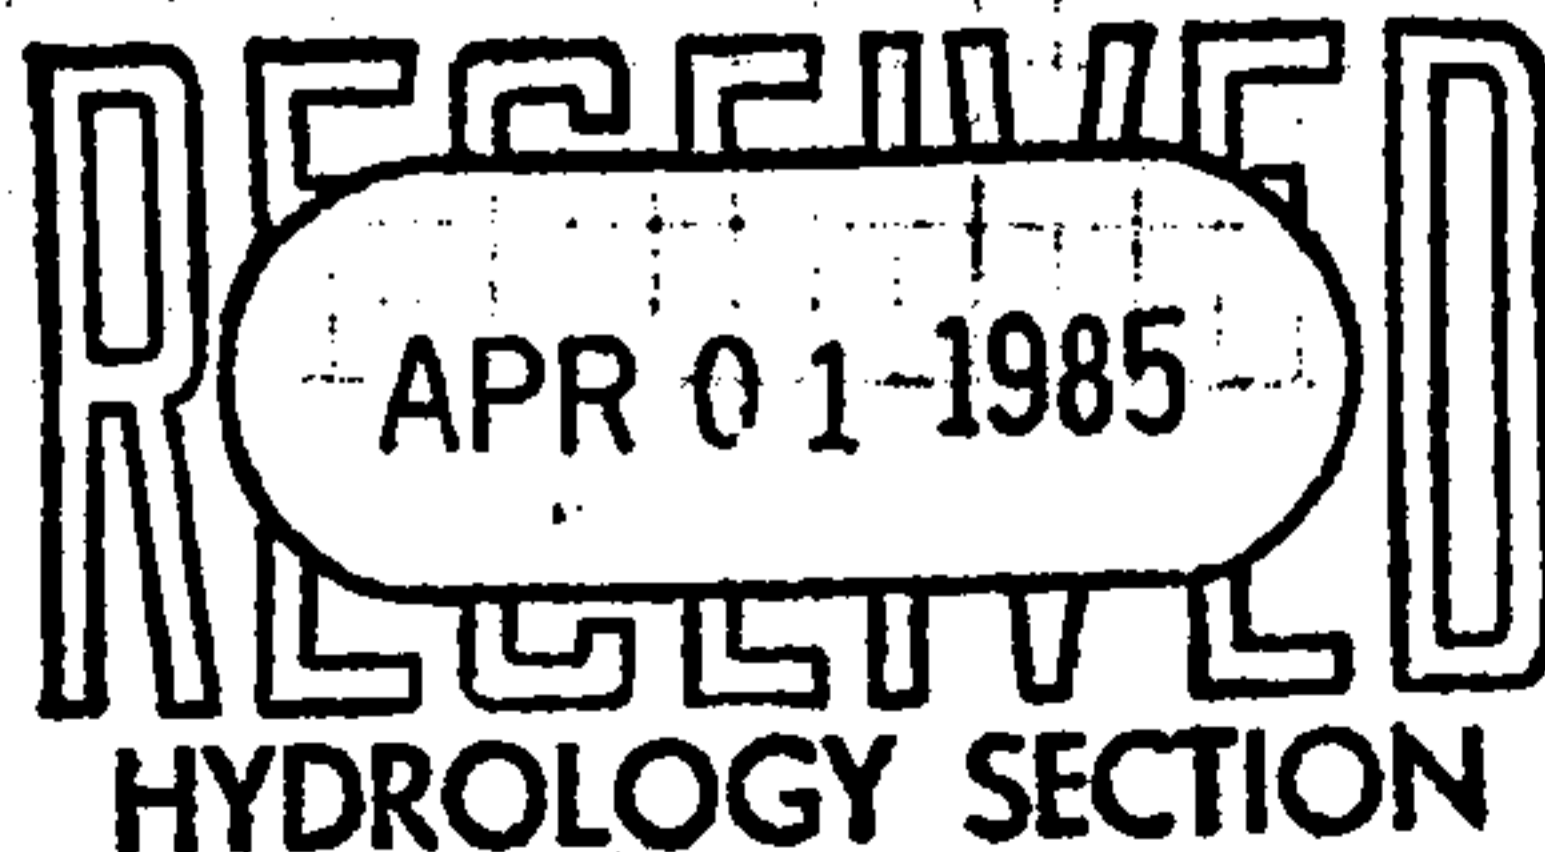

PROJECT NAME ACADEMY RIDGE EAST SHEET _____ OF _____
PROJECT NO. 41443 BY KID DATE _____
SUBJECT UNDEVELOPED FLOW ANALYSIS CH'D _____ DATE _____




UNDEVELOPED DRAINAGE AREA- BASINS A-1, A-3, A-5, A-6, & A PORTION OF A-9

75 LF 6" PVC, DIP or AC
 6" Gate Valve w/Type "A" Box & Lid
 6" 90° Bend
 6" 45° Bends
 Locking

Sta. 1+95 Carruthers St.
 Install
 50 LF 8" PVC
 1- 8" Plug
 S=0.021ft
 Inv. @ plug = 66.00

CAR

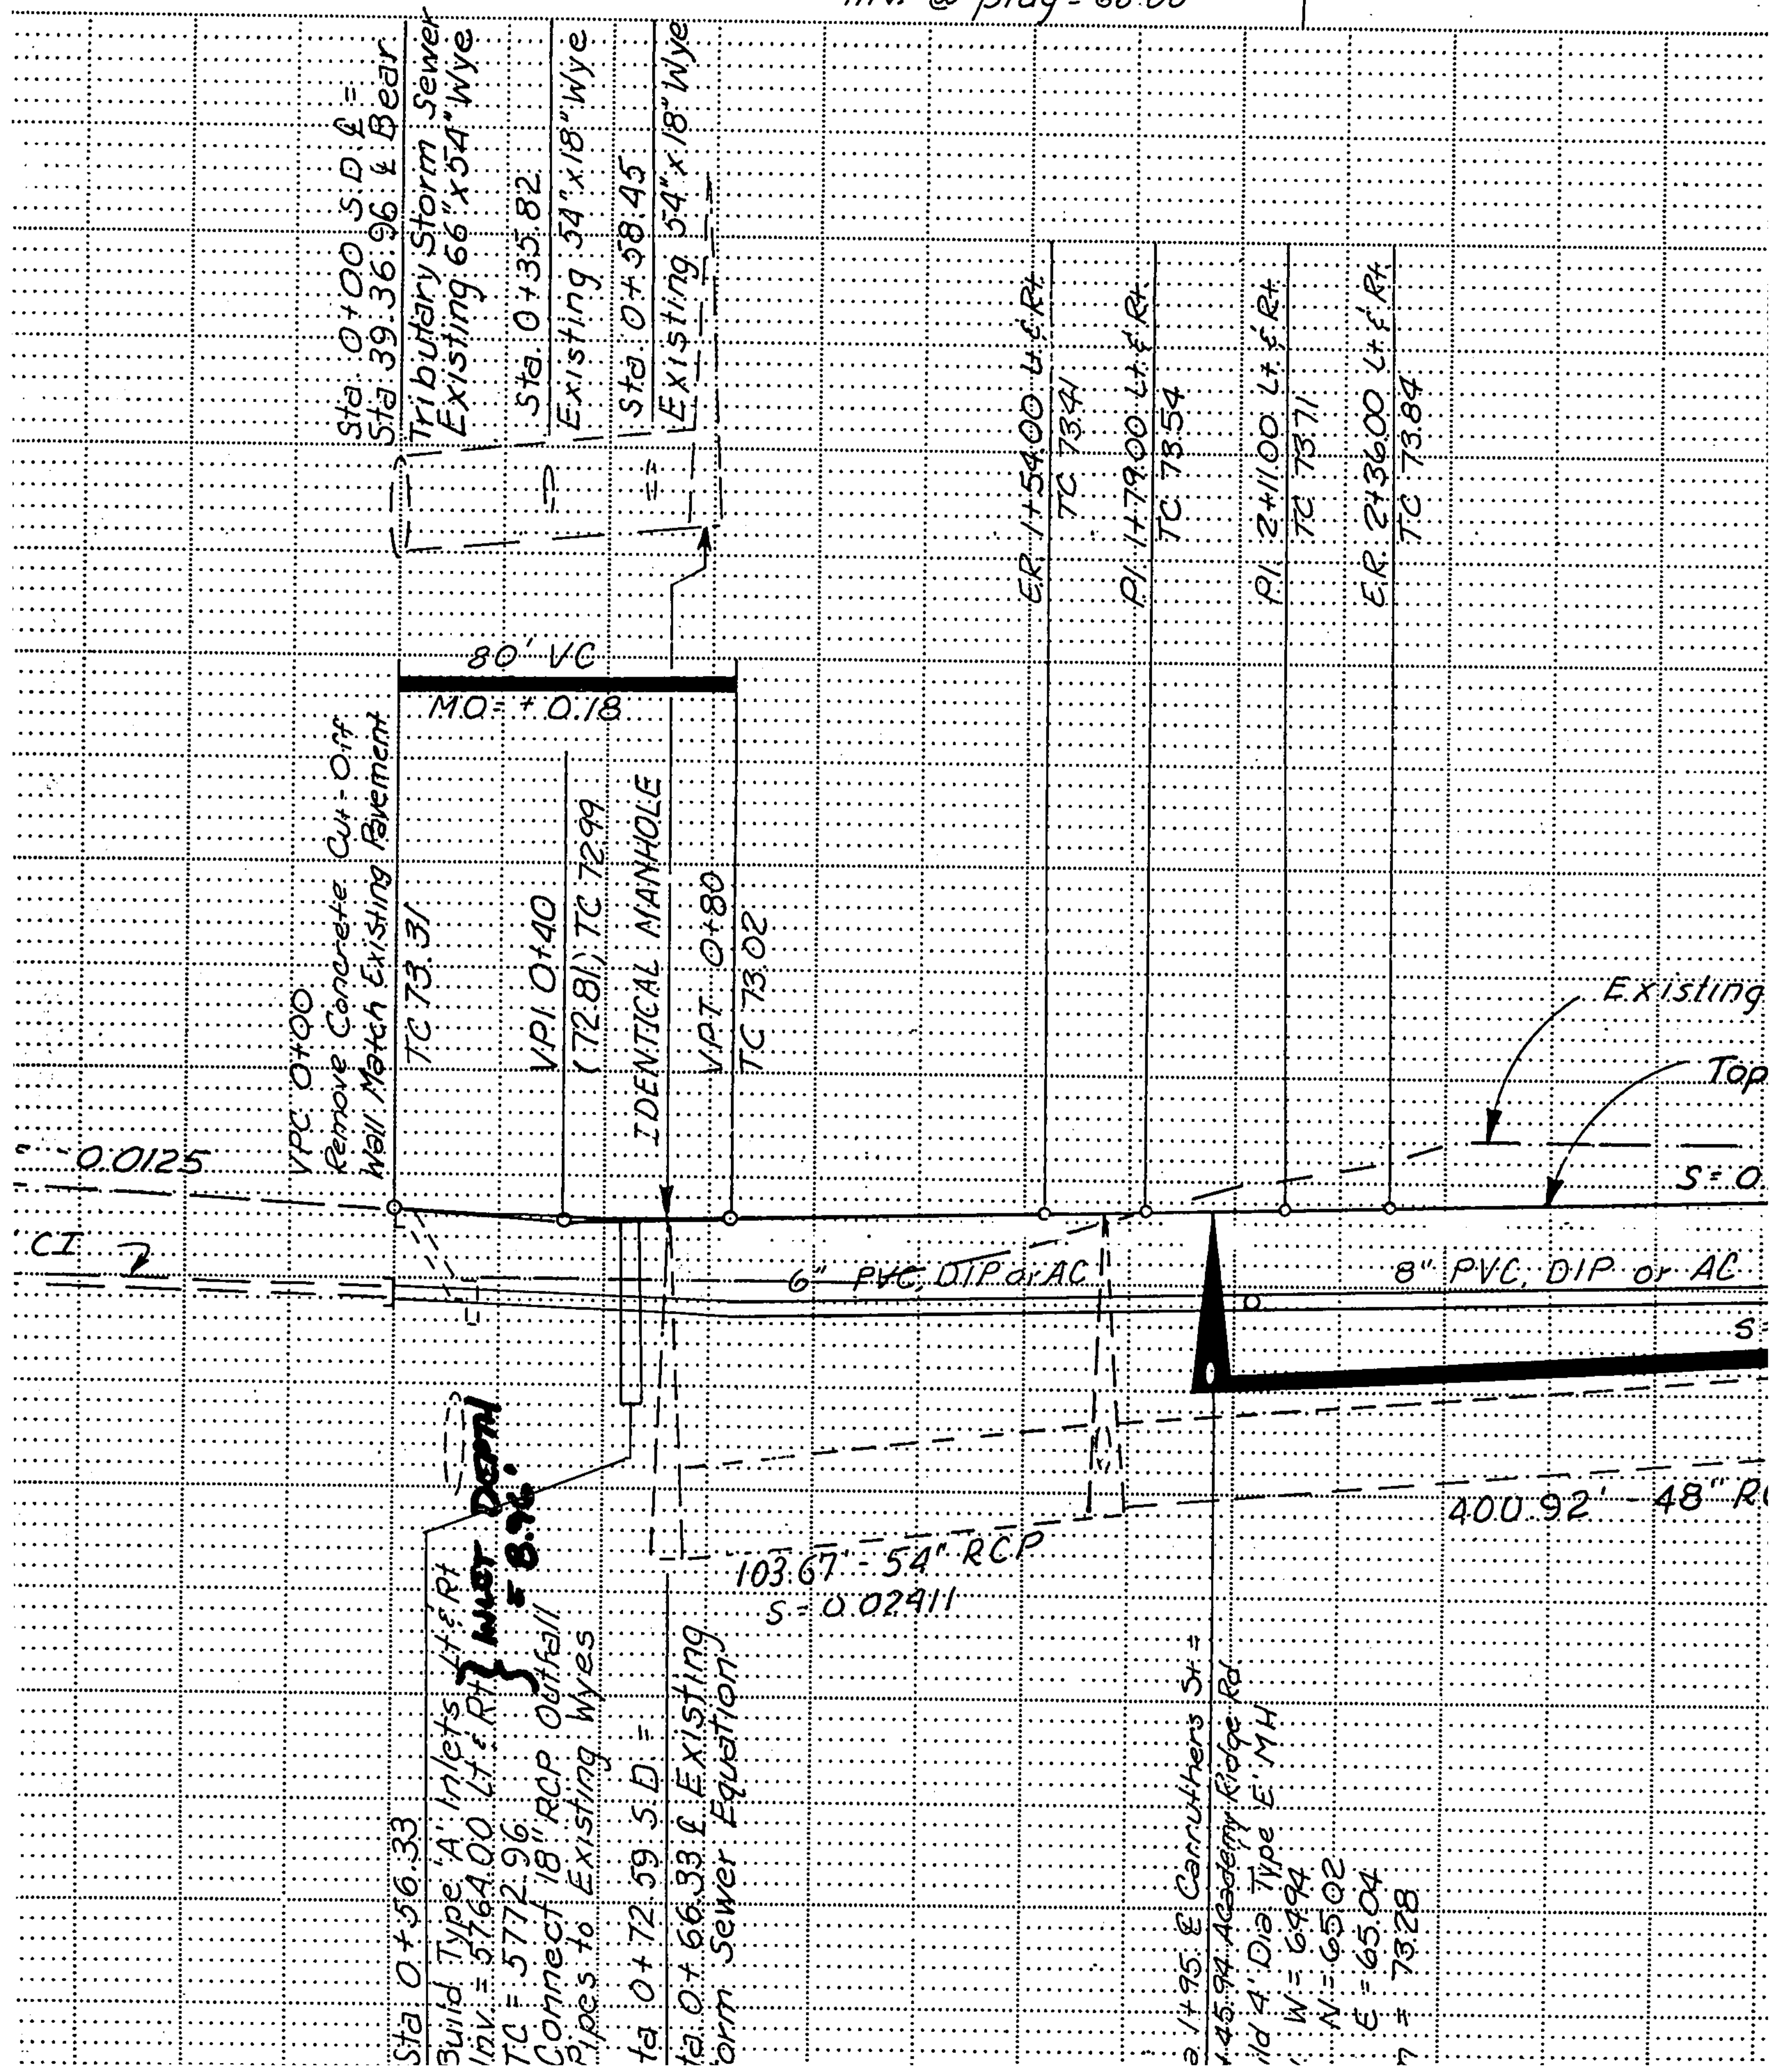

VPC 0+00
 Remove Concrete Cut-Off
 Wall Match Existing Pavement
 T.C. 73.31

80' VC
 MO = +0.18

VPI 0+40
 (72.81) T.C. 72.99

IDENTICAL MANHOLE

VPT 0+80
 T.C. 73.02

ER 1+54.00 L+R
 T.C. 73.41

PI 1+79.00 L+R
 T.C. 73.54

PI 2+11.00 L+R
 T.C. 73.71

ER 2+36.00 L+R
 T.C. 73.84

Existing
 Top
 S=0

Sta. 0+56.33
 Build Type "A" Inlets L+R
 Inv. = 57.64.00 L+R } MUST DEPTH
 TC = 57.72.96 } S=0.02
 Connect 18" RCP Outfall
 Pipes to Existing Wyes

Sta. 0+72.59 S.D. =
 Sta. 0+66.33 & Existing
 Storm Sewer Equation

103.67' = 54" RCP
 S = 0.02411

Sta. 1+95 E Carruthers St. =
 1.45.94 Academy Ridge Rd
 14' Dia Type E.M.H
 W = 64.94
 H = 65.02
 E = 65.04
 T.C. = 73.28

400.92' - 48" RCP

DRAINAGE REPORT
FOR
ACADEMY RIDGE EAST

July 1984

PREPARED FOR:

AMERIWEST CORPORATION
P.O. BOX 25625
ALBUQUERQUE, NM 87125

PREPARED BY:

BOHANNAN-HUSTON INC.
4125 CARLISLE NE
ALBUQUERQUE, NM 87107

Job No. 4 144 1

PURPOSE

The purpose of this report is to outline the drainage management plan for a 60.1 acre tract referred to as Academy Ridge East, owned by AmeriWest Corporation. The Development Process Manual (DPM) will be utilized to establish the plan.

SITE LOCATION AND DESCRIPTION

Academy Ridge East is located south of Academy Road NE, about one-half mile east of Eubank Blvd. Figure 1 identifies the project location. The development falls within the Academy/Tramway/Eubank Sector Development Plan area. The property combines portions of two tracts within the Sector Development Plan, both zoned R-D. One tract is zoned for single family residential (6 DU/acre maximum) and the other is zoned for mixed residential (15 DU/acre maximum). The entire subdivision will have no more than 6 DU/acre and will be developed for patio homes. Figure 2 shows the tracts as they appear in the Sector Development Plan.

PREVIOUS REPORTS

Two major drainage studies are currently existing that provide hydrological analyses of the property and additional information that will prove useful. These are the *Academy/Tramway/Eubank Sector Development Plan Master Conveyance Study* and the *Drainage Report for the Bear Arroyo Tributary* prepared for SAD 205.

The Master Conveyance Study recommended constructing an open concrete channel in the Bear Tributary Arroyo with structures at street crossings. This plan was abandoned in favor of a closed conduit to be constructed in SAD 205.

The Master Conveyance Study also recommended constructing special design inlets in Academy Road with a closed conduit to deliver collected flows to the Bear Tributary Channel, along the proposed alignment of Carruthers St. This pipeline will be referred to as the Carruthers lateral.

The design of the inlets in Academy included flows from north of Academy only. This area is shown as a portion of Basin C5 on Figure 3. Because of this, Academy Ridge must be designed to discharge no flows to Academy Road.

The *Drainage Report for the Bear Arroyo Tributary* was prepared to analyze runoff generated east of Tramway. That report recommends constructing diversion structures to divert Bear Tributary runoff into the Pino Arroyo, as shown in Figure 4.

These diversions are to be constructed prior to SAD 205. AMAFCA Resolution 1984-5 decrees that no development may occur within the 100-year flood plain until the diversion structures are in place and functioning.

Another analysis of the Bear Tributary Watershed was performed for SAD 205 of those basins west of Tramway. This analysis is included in Appendix 1. Information from that analysis was culled for use in the hydrology utilized in this report.

HYDROLOGIC ANALYSIS

A modified version of the computerized watershed model "HYMO" was used to compute the flow rates generated within the Bear Tributary basins. The rainfall used for this analysis was the one-hour, 100-year storm equal to 2.3". This storm was used in the previous report done for SAD 205. (p. A1-3) "The one-hour storm was used because flooding problems in this area usually result from very intense, short duration thunderstorms. Six-hour storms would add to the volume of runoff, but would not add to the peak flow rates". (p. A1-4).

All hydrologic computations and the HYMO printout are included in Appendix 2. The runoff generated within each of the basins calculated by HYMO was checked using the rational method and reasonable correlations were obtained. The basin layout for the Bear Tributary Watershed is shown on Plate 1.

A routing scheme was developed to approximate the actual drainage configuration under developed conditions, assuming no runoff retention in any basin. The schematic diagrams for basin configuration and the HYMO analysis are presented on page A2-4 and A2-5 of Appendix 2.

DRAINAGE MANAGEMENT PLAN

The scheme for managing storm water runoff in Academy Ridge will assume that the Bear Tributary pipeline will be in place, as well as the other items to be constructed as parts of SAD 205. These items include the diversions to the Pino Arroyo at Tramway, and Academy Road, complete with inlets to collect flows generated north of Academy, along with a portion of the Carruthers lateral.

Bear Tributary Pipeline

The original hydraulic analysis of the Bear Tributary pipeline is included in Appendix 3, along with reduced plans for the SAD 205 construction of the pipeline.

The original hydraulic analysis provided for flow inputs distributed along the length of the pipe. The Academy Ridge development will concentrate the majority of these inputs in three laterals: the Carruthers lateral, the Malaguena lateral and a lateral in Academy Ridge Drive. See Figure 5 for an overview of the drainage facilities to be constructed in Academy Ridge East.

The design of the Bear Tributary pipeline provided specially designed inlet manholes to deliver flow to the pipe. The Academy Ridge development will include a paved public alleyway centered over the pipe. If possible, the inlet manholes would remain in place and functioning, and small swales would deliver flow from the adjacent blocks to the inlets. If this is not possible, type 'D' inlets would be built to accept flow from the alley and connectors would deliver that flow to the manholes.

A flow schematic for the Bear Tributary pipeline showing actual inputs and mainstream flows after the Academy Ridge development is in place is shown on page A3- of Appendix 3. This compares favorably with the original design flows shown above it.

Carruthers Lateral

This pipeline has been designed for SAD 205 to convey flows from Tract J of the Tanoan Properties (see Figure 1), now Country Club Estates. Originally, a ponding area was designed to collect flows from a tract of land north of Academy (Basin D, Figure 3 and a closed basin shown on Plate 1 of the Appendix). This ponding area has been eliminated and a diversion will be constructed to convey flows from this basin to the Tanoan Country Club, and the Pino Arroyo Watershed. That construction will be a part of the County Club Estates development. } *check*

Page A4-1 of Appendix 4 shows the plan and profile for the portion of the Carruthers lateral to be built under SAD 205. The Academy Ridge development will include removing the bend where the pipe dumps into an existing arroyo, extending it to the Bear Tributary pipeline, and constructing a junction box at their confluence. The specially designed inlets in Academy Road will remain in place after Academy Ridge East is developed. Academy Ridge East will utilize the Carruthers lateral to remove some of the flow generated internally. Batteries of inlets will be installed in Malaguena Lane and Academy Ridge Road to accomplish this. Figure 5 provides an overview of the drainage facilities to be constructed in Academy Ridge.

The original hydraulic analysis of Tract J and the original design of the Carruthers lateral called for a 66" pipe to convey flows from Academy Road. The drainage report for Country Club Estates included a hydrologic analysis that reduces the discharge from Tract J from 118 cfs to 45 cfs. Hydrologic analysis of basins north of Academy Road indicates a peak flow discharge into Carruthers Road of approximately 160 cfs.

Preliminary design computations for the storm drain laterals are shown on page A4-2 of Appendix 4. These computations utilize pressure flow procedures presented in the DPM. The hydraulic grade line elevations at the Bear Tributary pipeline were taken from the hydraulic computations in Appendix 2. Since the Academy Ridge development reduces the actual flow in the Bear Tributary, these elevations are conservative. The preliminary design calculates friction head loss only, but sufficient elevation differences are provided to allow for head losses from junctions, manholes, etc. The preliminary design for the Carruthers lateral indicates that a 48" pipe will be required to convey discharge from Academy Road. Therefore, the SAD 205 construction drawings should be changed to downsize the Carruthers lateral pipeline.

In addition, to provide the most efficient use of space for platting within Academy Ridge East, the intersection of Carruthers and Academy occurs approximately 40' west of the location proposed by the SAD 205 construction drawings. It is, therefore, imperative that SAD 205 be changed to allow for a new size and configuration of the Carruthers lateral.

Off-Site Flows

Academy Road will divert any flow attempting to enter the development from the north. Therefore, the only off-site flows to be addressed are sheet flows from the tract of land immediately to the east held in trust for the Albuquerque Boys Academy, flows from the tracts southeast owned by AmeriWest Corporation, and flow entering through the Bear Tributary collection channel.

An east-west ridge enters Academy Ridge East from the Academy lands approximately 200' north of the southeast corner of the development. Sheet flow across the

Academy lands will be collected and diverted in an open earthen channel to the north and south. The flow diverted south will be collected by the Bear Tributary Collection Channel, a small open channel that delivers flow to the pipeline. The flow directed to the north will enter a rundown that will deliver it to Malaguena Lane. Inlets will be provided in Malaguena Lane at Academy Ridge Drive to convey the flow to the Academy Ridge lateral. The diversion berm will be a temporary facility that will be in place until the Academy lands are developed. At that time, adequate grading of the site could provide runoff concentration at the northwest and southwest corners of the tract without a diversion facility.

Flow from the southeast will be collected by the paved alleyway and delivered to the Bear Tributary pipeline. Some off-site grading may be required to accomplish this without ponding. Additional flow from the tract to the southeast would be conveyed to the Bear Tributary pipeline in a future storm drain lateral.

On-Site Grading

Due to the desire of the developer to allow the location of the individual dwelling pads to remain flexible, the grading plan will not provide flat pad areas. Rather, a small ridge line will be graded across the rear of the future pad envelopes, in a diagonal grading scheme shown on Plate 2. Rear lot discharges will be collected in a swale type ditch and transmitted from lot to lot through holes built into the block walls between lots. Every sixth lot (counting downstream) will provide a 5' private drainage easement and a swale to convey the collected flow to the street. The future configuration of such a scheme is presented on sheet A4-3.

PHASING PLAN

The proposed Academy Ridge development will be constructed in three phases from west to east as shown in the three figures in Appendix 5. The existing topography will allow natural arroyos to transmit undeveloped flows to stubbed streets with minimal grading off-site to each phase. The manhole inlets and collection channel on the Bear Tributary will remain in place and functioning until a development phase is constructed. At that time, the public alleyway will be paved and type 'D' inlets will replace the manhole inlets as required. In addition, storm drain laterals will be constructed as follows: the Malaguena and Carruthers laterals in Phase I and the Academy Ridge lateral in Phase II.

EROSION CONTROL

An erosion control plan will be submitted during the construction plans review *No.* process prior to obtaining grading permits. The plan will address measures required to minimize erosion in those areas graded but remaining undeveloped during implementation of the phasing plan.

SUMMARY AND CONCLUSIONS

Academy Ridge East is proposed as a townhome development with densities not to exceed 6 DU/acre. It occurs within the Bear Arroyo Tributary Watershed, bordered by Academy Road on the north and the Bear Tributary pipeline on the south. This report assumed that the diversions to the Pino Arroyo from the Bear Tributary Arroyo at Tramway would be in place as well as the improvements included in SAD 205. Among these improvements are pavement on Academy Road and the Bear Tributary pipeline.

Hydrologic analysis of the ultimate development led to the following conclusions:

- o The pipeline in Academy Road, identified as the Carruthers lateral, included in the SAD 205 improvements should be redesigned to downsize the pipe and alter the geometry to relocate the outlet in the revised intersection of Carruthers Road and Academy. *check SAD 205*
- o Concentrating the inputs into the Bear Tributary pipeline into three storm drain laterals will not adversely affect the hydraulics of the original design of the pipeline, done for SAD 205.
- o Some off-site grading will be required for the ultimate development to collect and divert sheet flow from the tract immediately east of the development and to prevent ponding in the tract southeast of the development. *erosion*
- o On-site grading will provide for lot-to-lot conveyance of backyard discharge and conveyance of six-lot collected flows to the internal streets, where those flows will be intercepted by the storm drain laterals.
- o The existing topography will allow phasing of the development with minimal grading off-site to each implemented phase.

10078
May 26, 1983

BEAR TRIBUTARY FLOW ANALYSIS

100 year, 1 hour discharges in CFS:

<u>Crossing</u>	<u>No. Diversion</u>	<u>Diversion 1-Mile East Of Tramway</u>	<u>Diversion At Tramway</u>
Tramway	1220	700	0
Lowell	1250	800	170
Eubank	1410	1280	830

BEAR TRIBUTARY FLOW ANALYSIS AT TRAMWAY BOULEVARD AND EUBANK BOULEVARD

INTRODUCTION

The purpose of this study was to determine 100-year flow rates along the Bear Arroyo Tributary at Tramway and Eubank, assuming different runoff conditions upstream of Tramway.

The first part of this analysis was to develop a rainfall-runoff model that matched the accepted flow rates developed by Leonard Rice. The second part of the analysis was to then evaluate the downstream effects of a diversion east of Tramway that reduced flow in the Bear Tributary to 700 cfs or less at Tramway.

PROCEDURES

The rainfall-runoff model HYMO was used for this analysis. The model uses the SCS curve number approach to develop runoff and also has routing capabilities. Drainage areas downstream of Tramway were defined by T. Mann Engineers. Upstream of Tramway the drainage areas were defined by Bohannon-Huston, Inc. within a study entitled "Drainage Evaluation of Albuquerque Academy Land East of Tramway," February, 1982. Curve numbers were based on standard SCS criteria assuming fully developed conditions with no on-site reduction of flow. Times of concentration for the sub-basins were based on average velocities for street flows taken from the Kent Whitman report.

The rainfall used for this analysis was the one hour, 100-year rainfall equal to 2.3 inches (K. Whitman). The rainfall distribution was based on the 10% probability, first quartile storm, typical of intense southwestern thunderstorms, from F.A. Huff, "Time Distribution of Rainfall in Heavy Storms," Water Resources Research, 3, No. 4, 1967.

The one hour storm was used because flooding problems in this area usually result from very intense, short duration thunderstorms. Six hour storms would add to the volume of runoff but would not add to the peak flow rate.

STUDY RESULTS

A schematic of the sub-basin characteristics and flow rates is shown on Figure 1. The hydrographs for the flows, at Tramway and Eubank, with and without the diversion are shown on Figure 2. A review of the attached computer runs indicates that without the diversion, the peak flow rate at Eubank is mostly dependent on the large flow from east of Tramway because the peak flows from intervening drainage basins west of Tramway occur earlier. With the diversion in place, the intervening sub-basins contribute more directly to the peak flow rate at Eubank.


The Leonard Rice peak flow rates for Bear Tributary at Tramway and Eubank are 1,206 cfs and 1,400 cfs respectively. Discharges generated by the rainfall-runoff model for those same locations, without an upstream diversion, yielded 1,220 cfs and 1,410 cfs. With the diversion in place (approximately one mile east of Tramway) flows at Tramway and Eubank were estimated to be 700 cfs and 1,280 cfs respectively.

There is only a small difference in peak flow at Eubank with and without the diversion. Again, this analysis was based on many assumptions and on fully developed conditions without on-site detention.

Additional information developed in this study are the expected flows at Lowell. The peak flow rate along Academy at Lowell is 80 cfs. The peak channel flow at Lowell is 760 cfs with the diversion and 1,240 cfs without the diversion. Total routed flow at Lowell (Academy flow and channel flow) is 800 cfs and 1,250 cfs with and without the upstream diversion.


One last computer run was made to determine the peak flow rate at Eubank assuming total diversion at Tramway. Assuming no flow at Tramway, total flow at Lowell (Academy and channel flow) would be 170 cfs and peak flow at Eubank would be 830 cfs.

FIG. 7

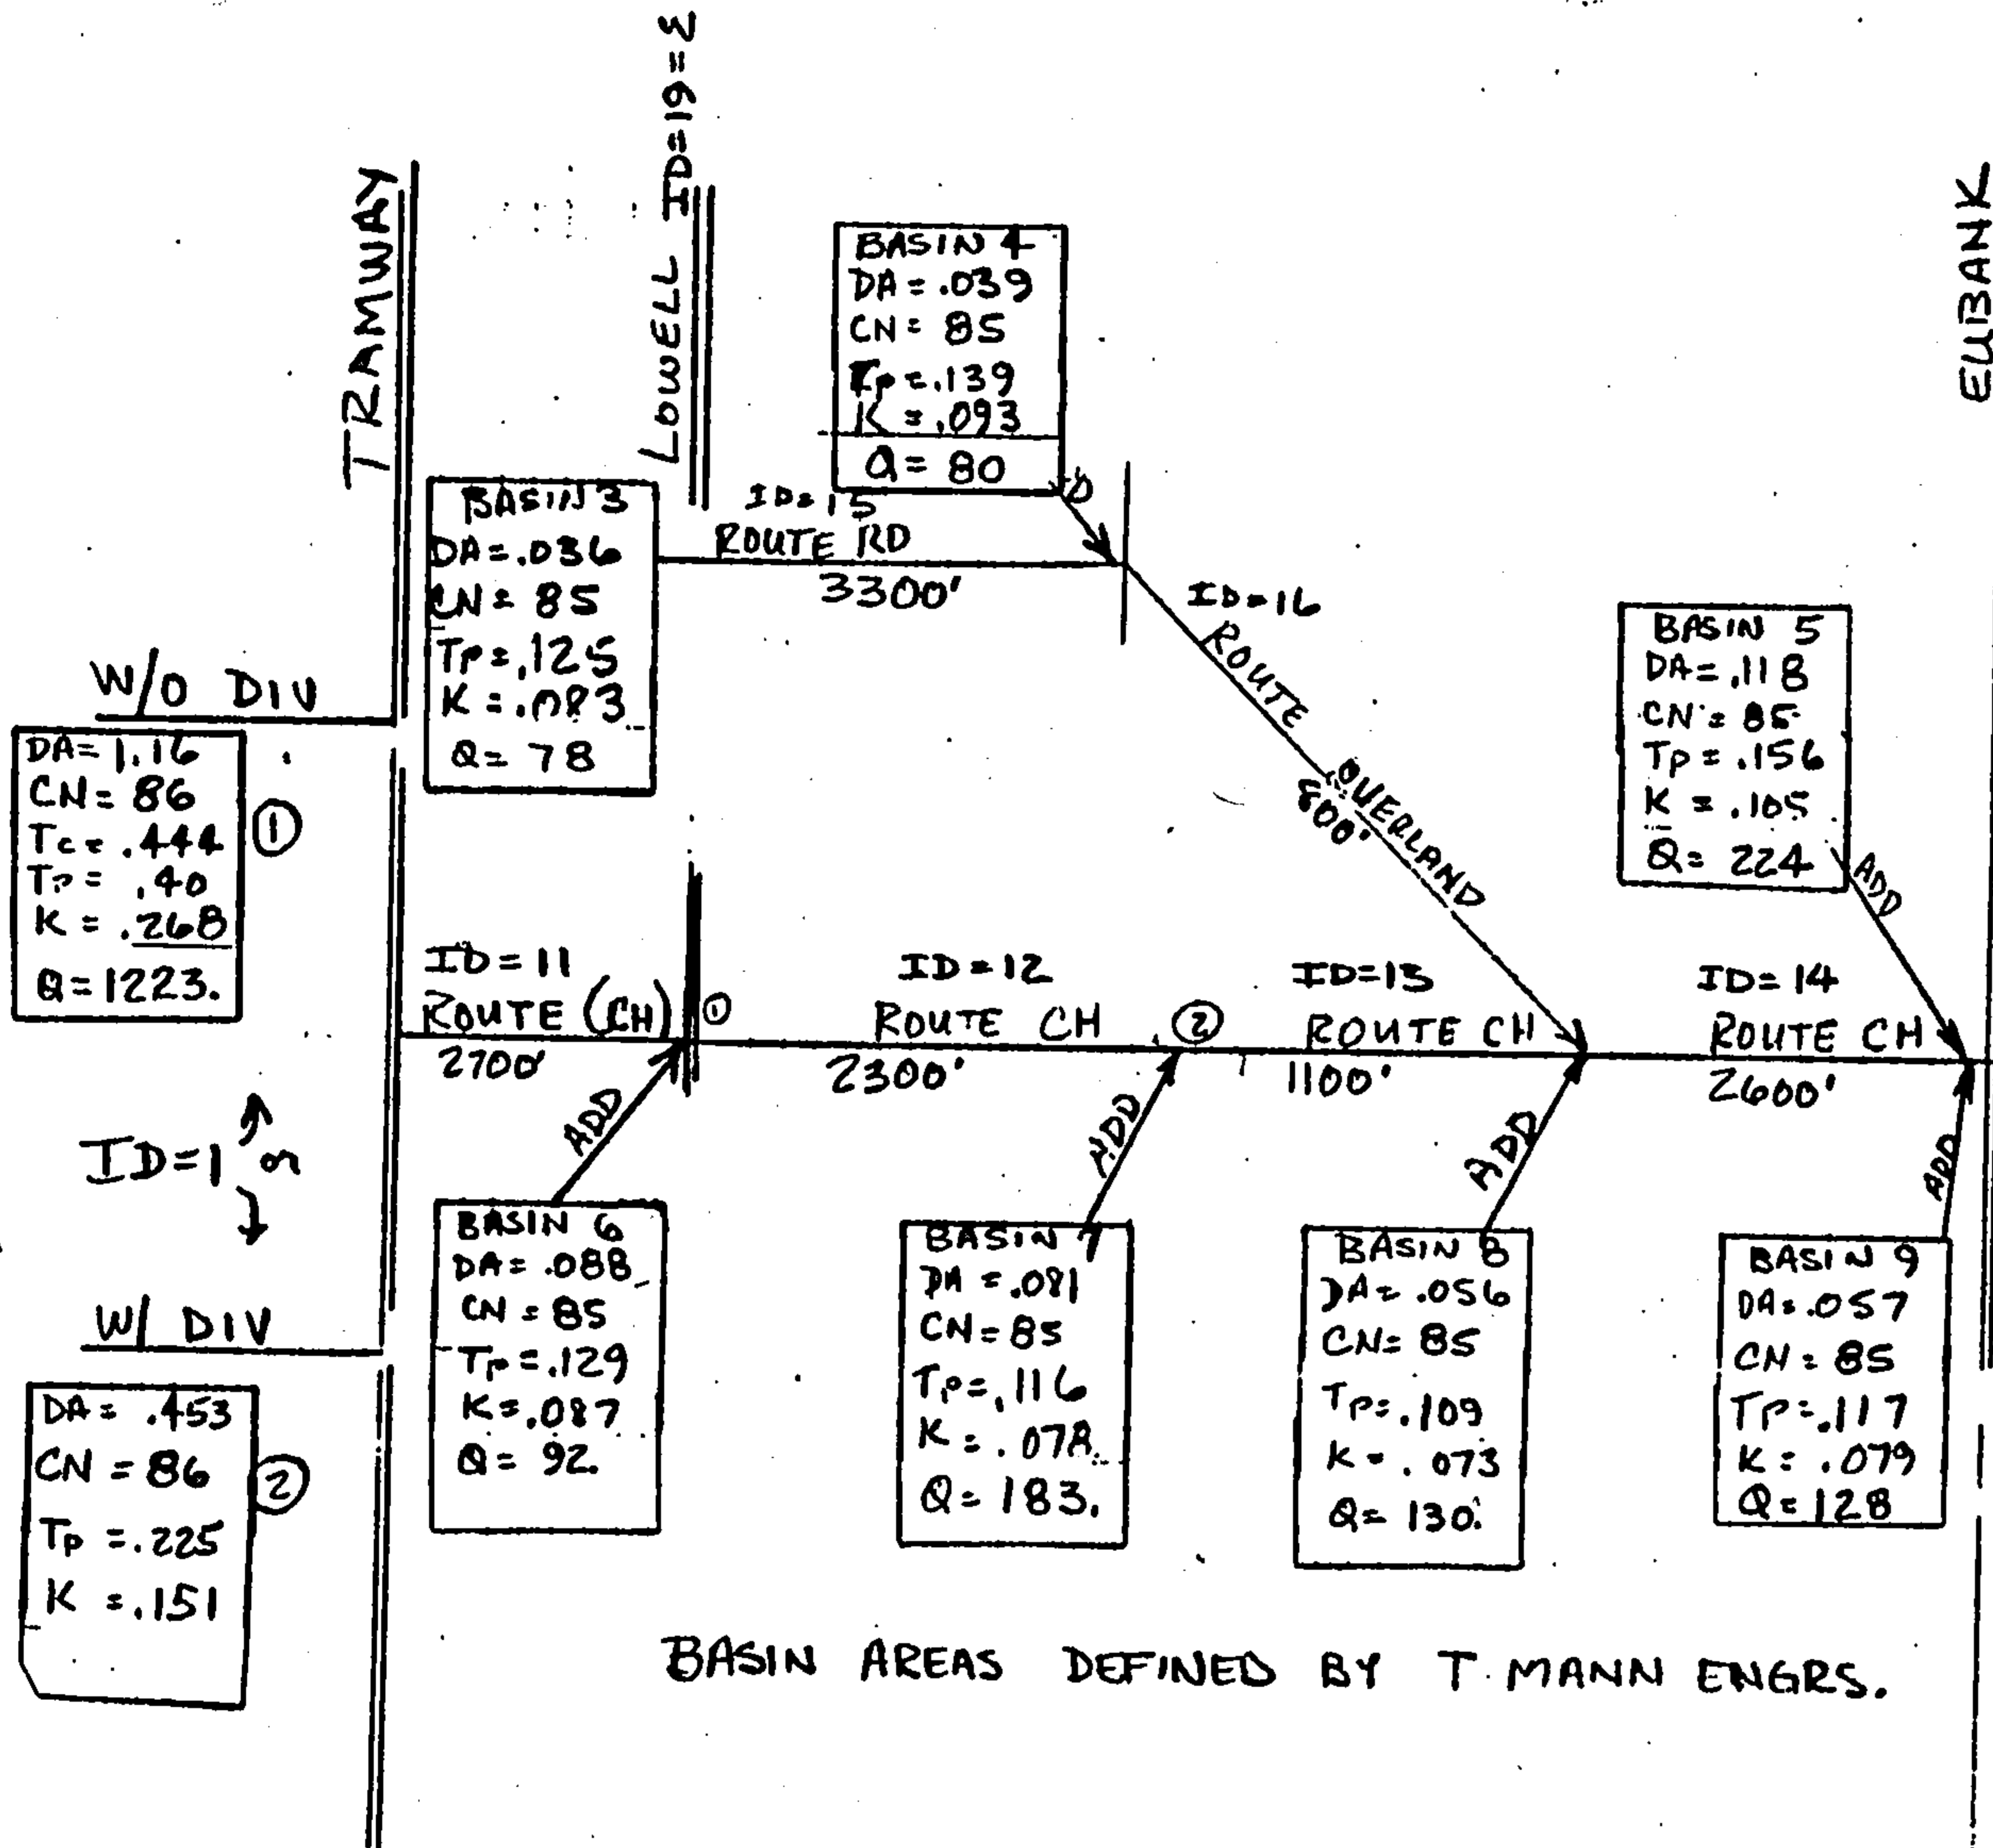


FLOW AT:	WITHOUT DIVERSION (CFS)	WITH DIVERSION 1 MI EAST OF TRAMWAY (CFS)	WITH DIVERSION AT TRAMWAY (CFS)
TRAMWAY	1220	700.	-0-
LOWELL	1250.	800.	170.
EUBANK	1410.	1280.	830.

BASIN AREAS DEFINED BY T. MANN ENGRS.

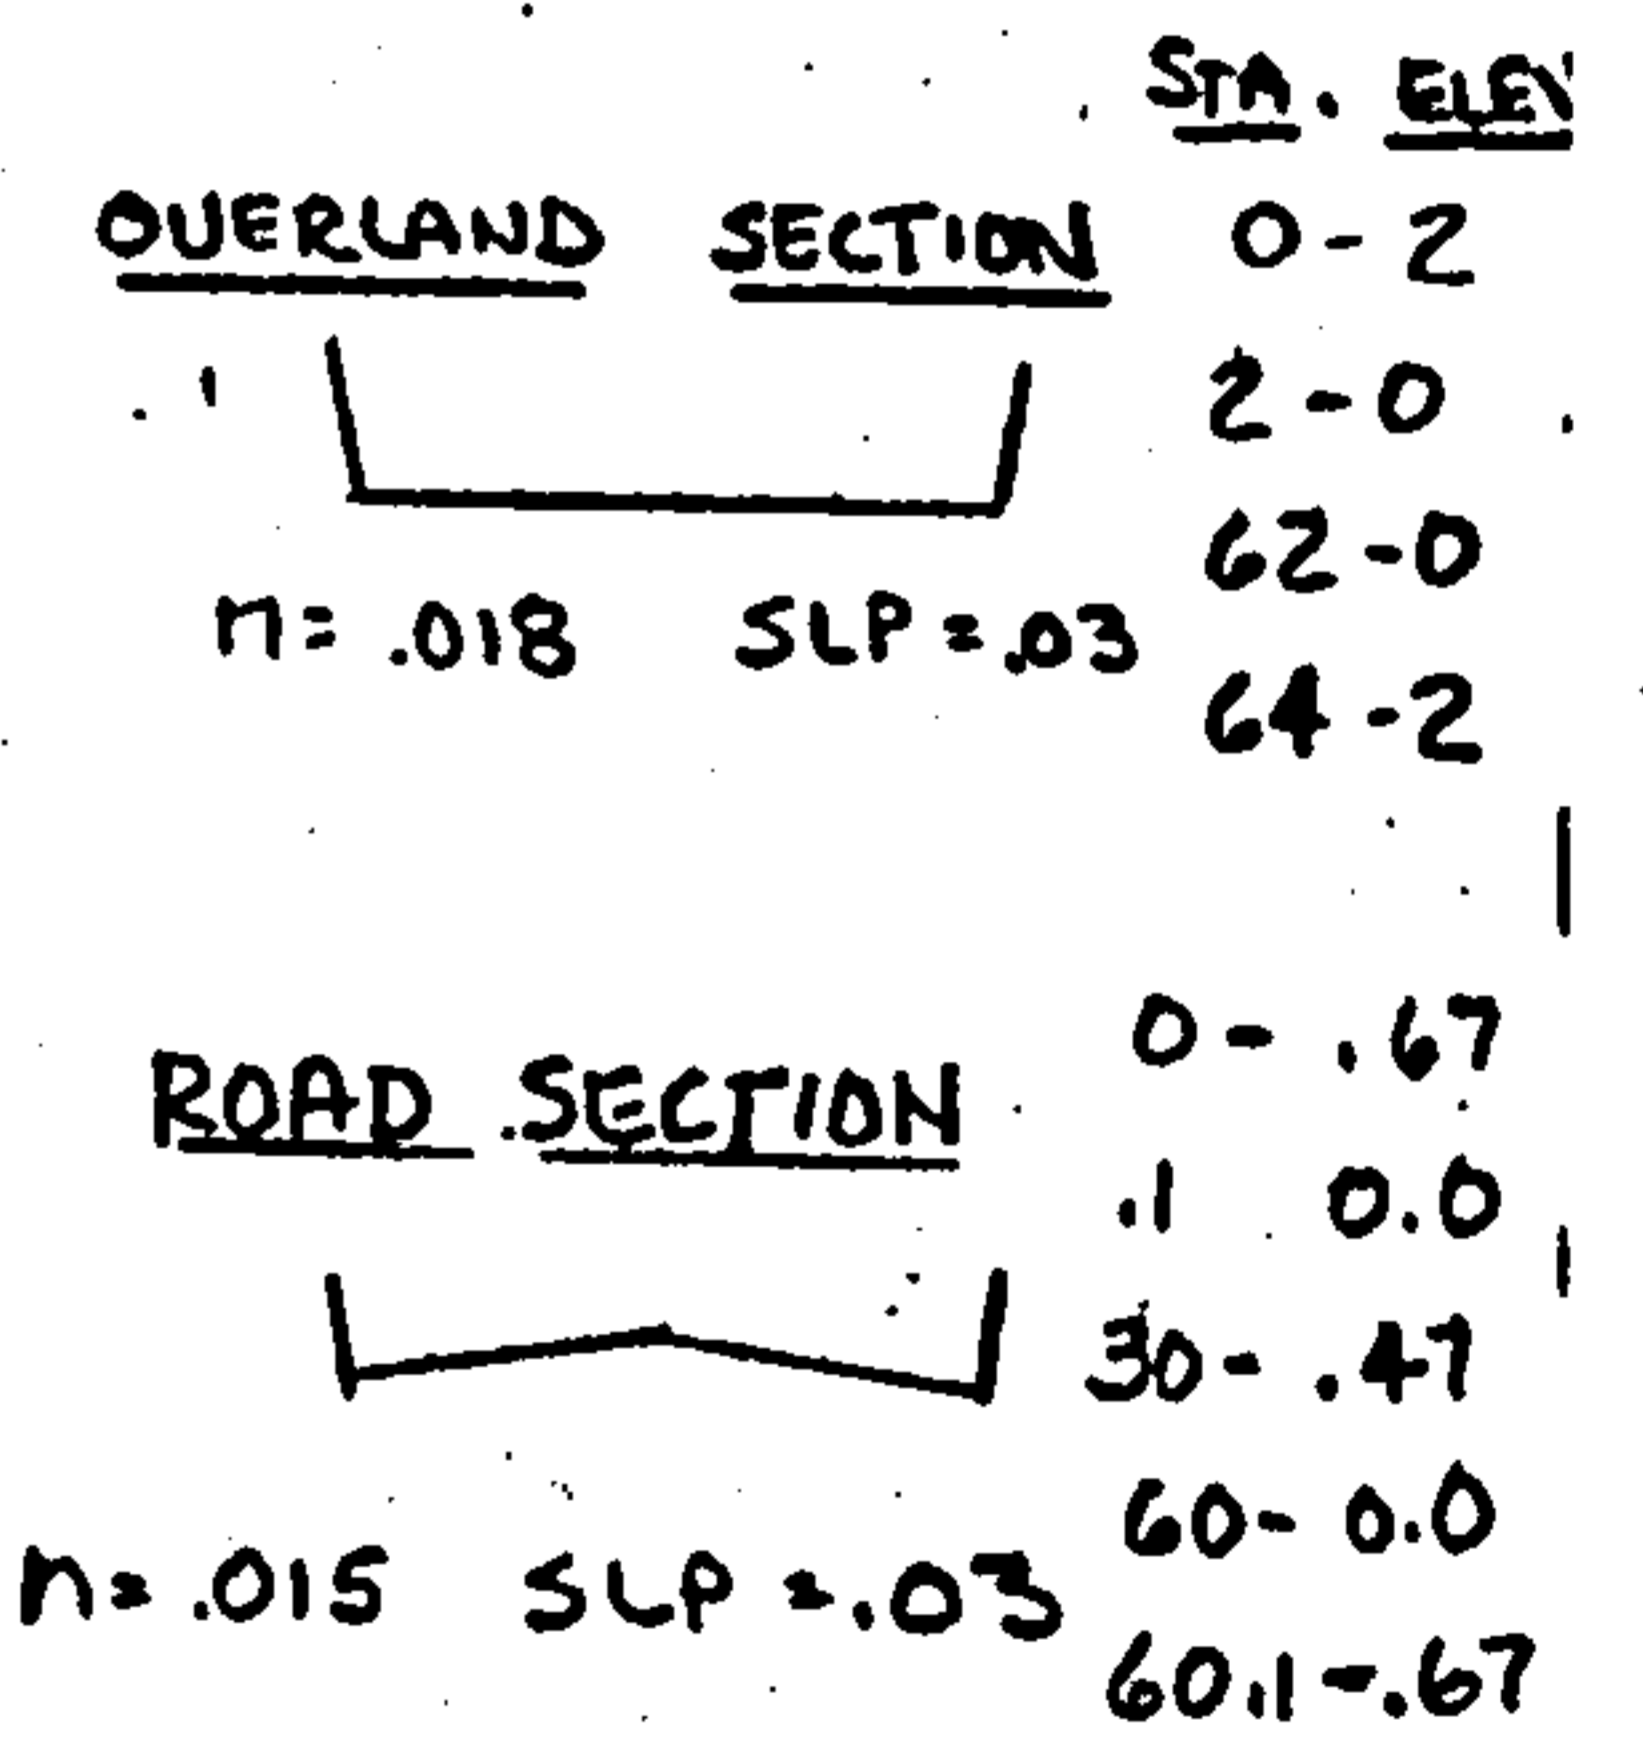

MIN RAINFALL .0333 HR: 2 MIN 1 HR = 2.3"

0	.0	10	1.78	20	2.16	12 th QUANTILE
2	.33	12	1.94	22	2.19	10% PROBABILITY
4	.79	14	2.02	24	2.22	
6	1.21	16	2.09	26	2.25	
8	1.53	18	2.13	28	2.28	
		30	2.30			

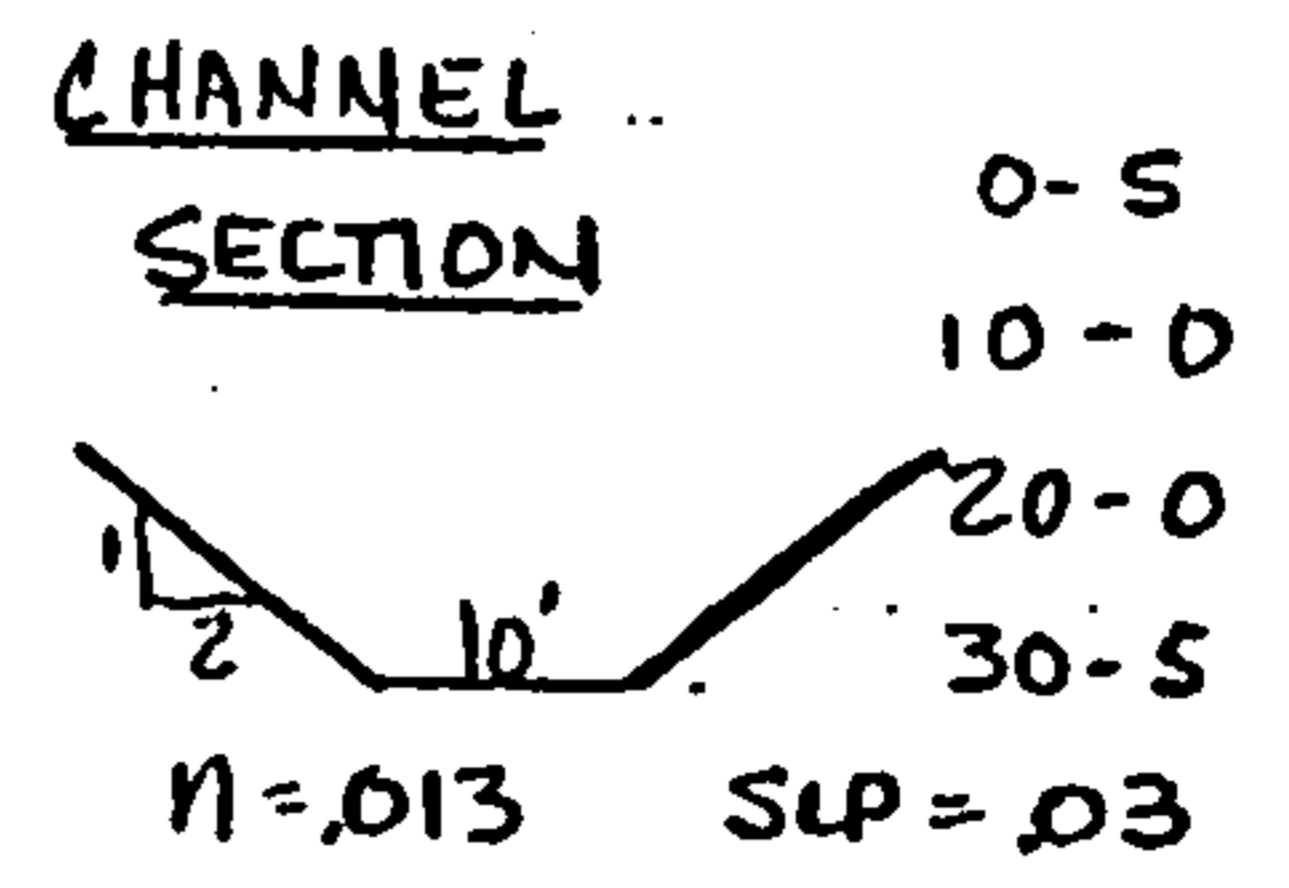

A1-5

BEAR ARROYO TRIBUTARY
 100 Year Flow Hydrographs
 At Tramway and Eubank, With
 and Without Upstream Diversion

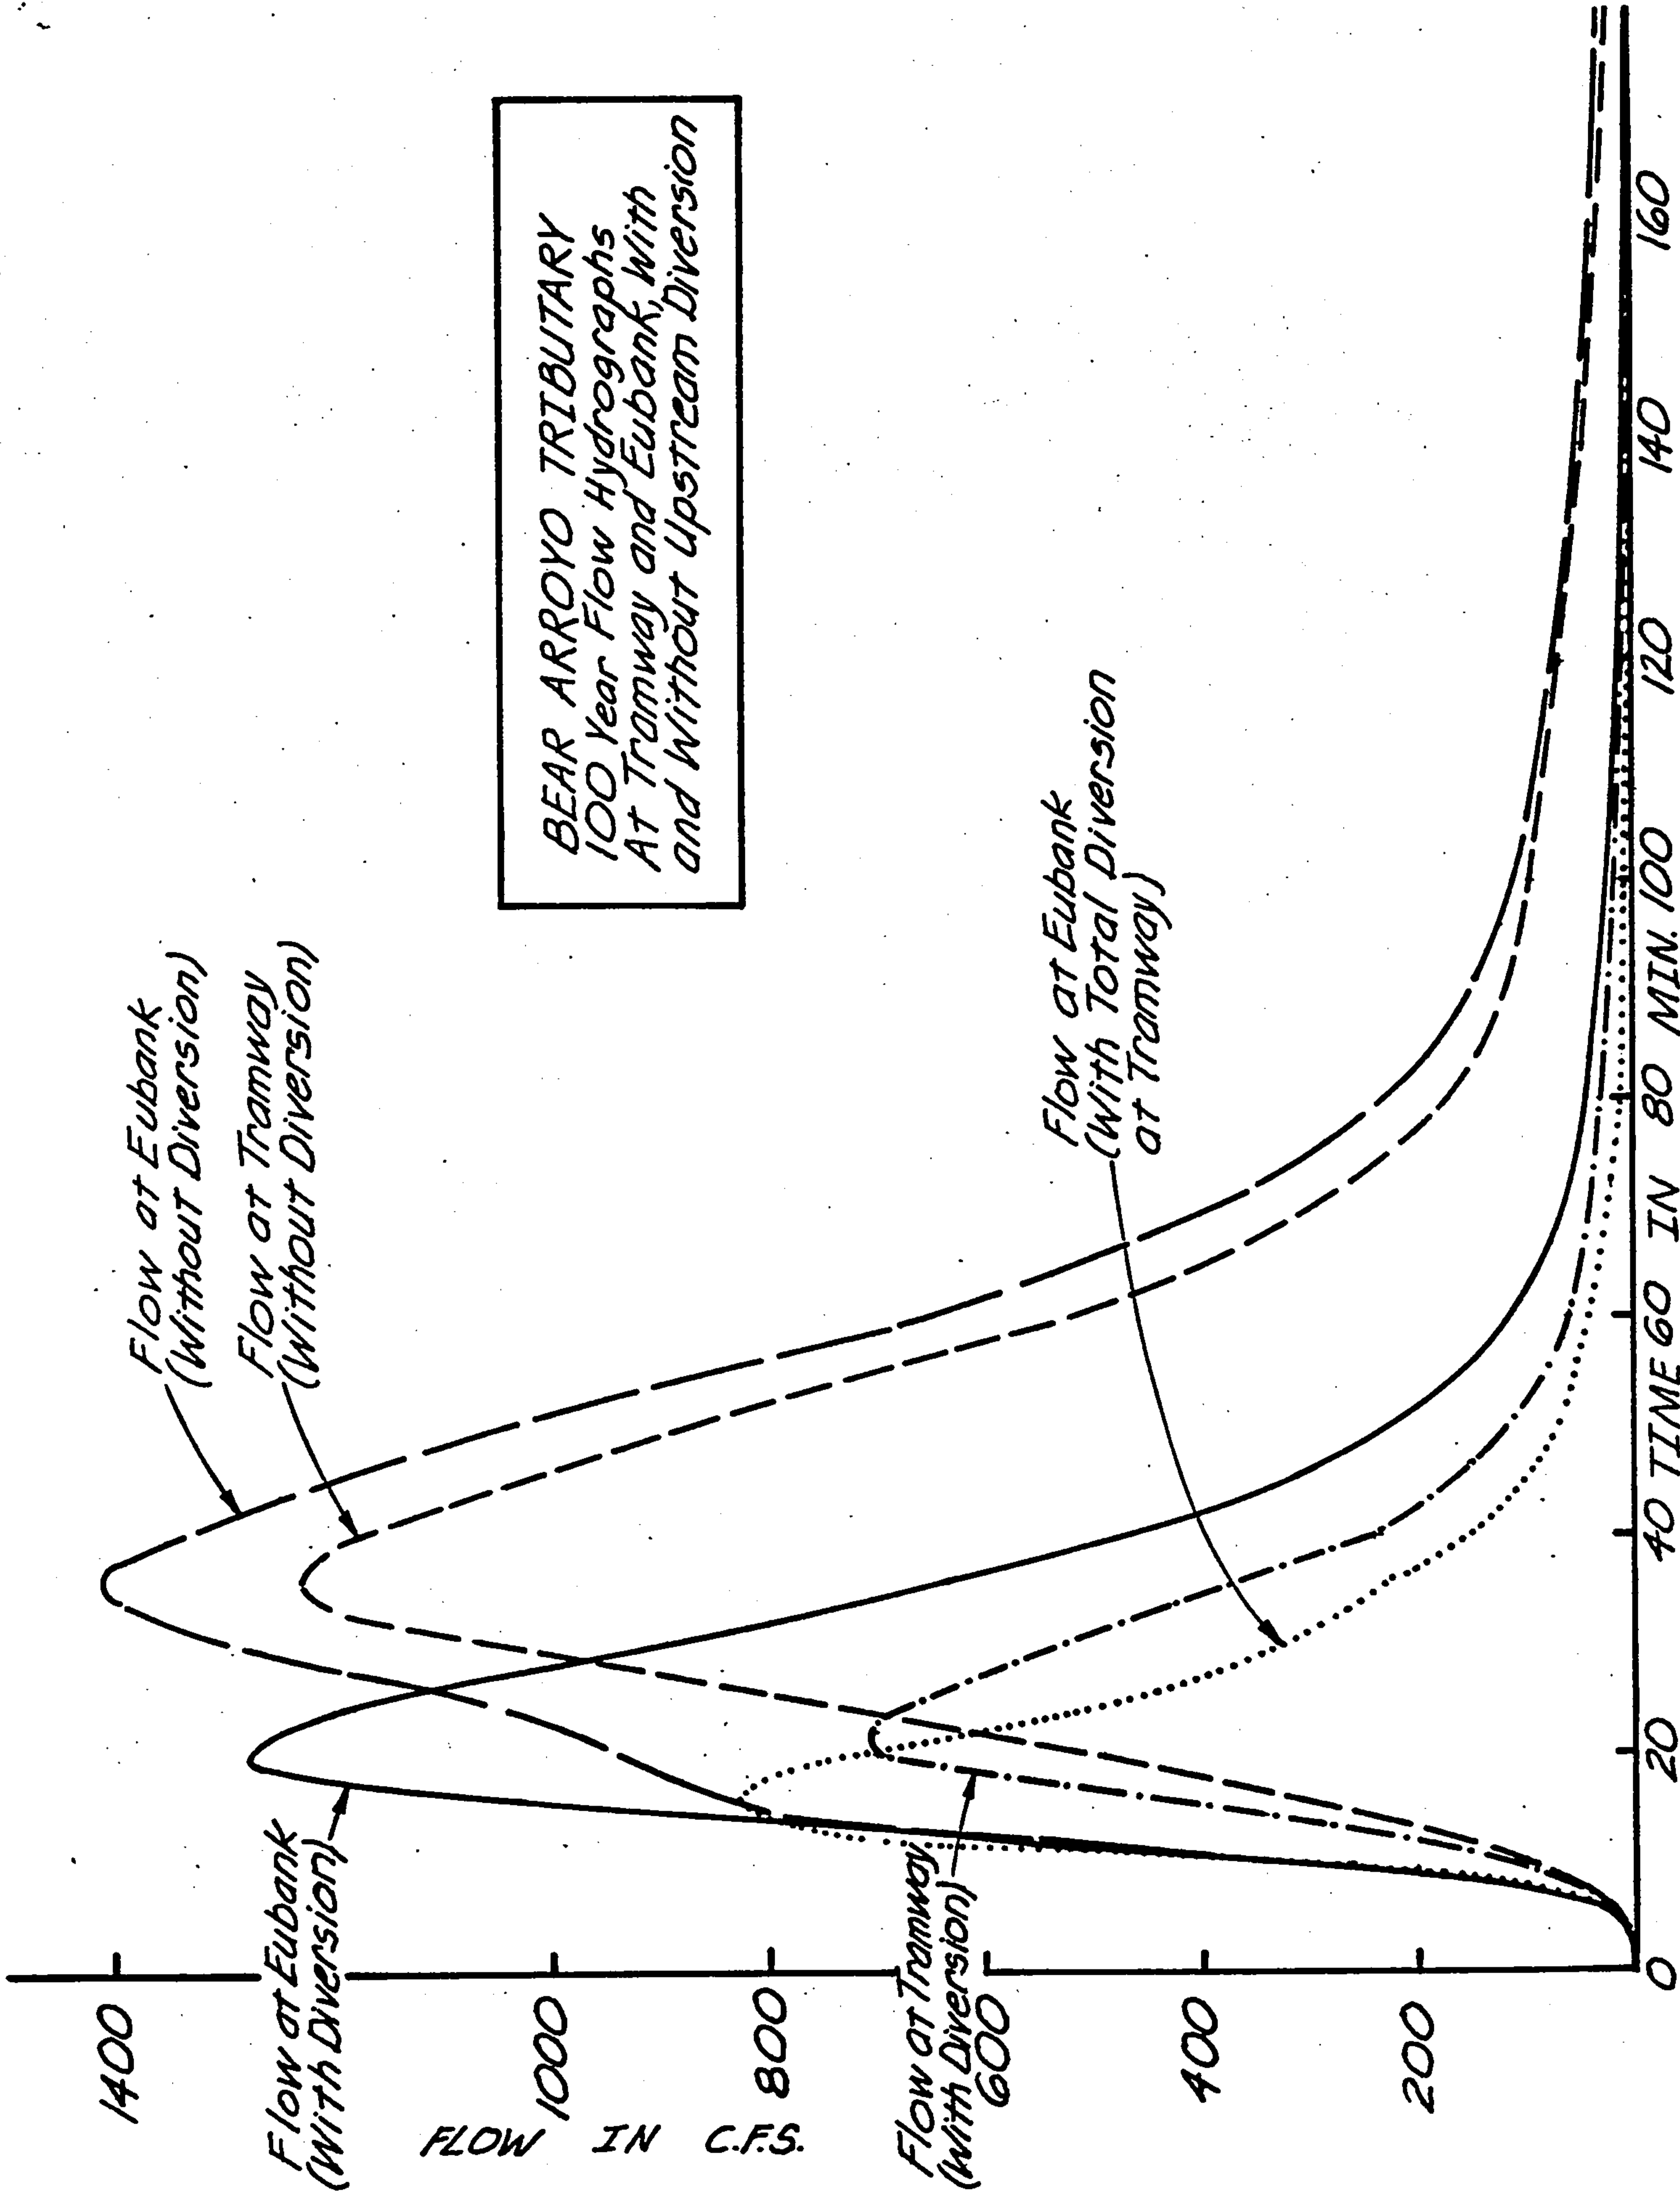


FIG 2


BASIN	LAND USE / DENSITY (SEE FIGURE 2, SHT. 1)	AVG % IMPERV.	D.A. (ACRES)	DN	CFactor	Q _W (CFS)	Q _R (CFS)
A-1	MIXED RES (12 DU/AC)	75%	7.12	85	0.72	30.2	29.5
A-2	"	75%	4.18	85	0.72	19.0	17.3
* A-3	SINGLE FAM. RES. (6 DU/AC)	70% (3)	5.12	82	0.70	22.9	20.6
* A-4	"	70%	4.28	82	0.70	19.1	17.2
A-5	"	70%	4.43	82	0.70	41.0	38.0
A-6	"	70%	8.32	82	0.70	36.2	33.5
A-7	"	70%	15.06	82	0.70	70.2	60.6
* A-8	"	70%	2.89	82	0.70	13.3	11.6
A-9	"	70%	4.47	82	0.70	19.7	18.0
A-10	"	70%	5.27	82	0.70	23.9	21.2
7	PARK, SCHOOL, RES (4 DU/AC)	60%	25.11	80	0.60	90.9	86.6
8	SINGLE FAM RES (4 DU/AC)	38%	35.8	80	0.50	119.1	103.0
* LAND USE IS ACTUAL, CHANGED FROM SECTOR DEVELOPMENT PLAN							
(2) BASED ON A RAINFALL INTENSITY OF (2.3") (2.5) = 5.75" (DPM CHART D-2)							
(3) SEE FIGURE							



BASIN	HYD. NO.	LENGTH (FT)	SLOPE (FT/FT)	AREA (SQ MI.)	TC (HOURS)	TP (HOURS)	K (HOURS)	CN
A-1	121	400	0.100	0.0111	0.0316	0.0212	0.0127	B5
A-2	122	380	0.079	0.0065	0.0335	0.0223	0.0134	B5
A-3	123	450	0.075	0.0080	0.0389	0.0259	0.0156	B2
A-4	124	470	0.083	0.0067	0.0387	0.0258	0.0155	B2
A-5	125	750	0.067	0.0147	0.0602	0.0401	0.0241	B2
A-6	126	800	0.074	0.0130	0.0609	0.0406	0.0244	B2
A-7	127	600	0.067	0.0235	0.0507	0.0338	0.0203	B2
A-8	128	580	0.080	0.0045	0.0412	0.0274	0.0165	B2
A-9	129	800	0.070	0.0070	0.0622	0.0415	0.0249	B2
A-10	130	700	0.079	0.0082	0.0536	0.0357	0.0214	B2
7	107	1050	0.071	0.0392	0.0763	0.0509	0.0305	B0
8	108	900	0.079	0.0559	0.0957	0.0638	0.0383	B0



PROJECT NAME ACADEMY RIDGE EAST SHEET A2-2 OF _____
 PROJECT NO. 41441 BY KLD DATE 5/84
 SUBJECT DRAINAGE BASIN DATA CH'D _____ DATE _____

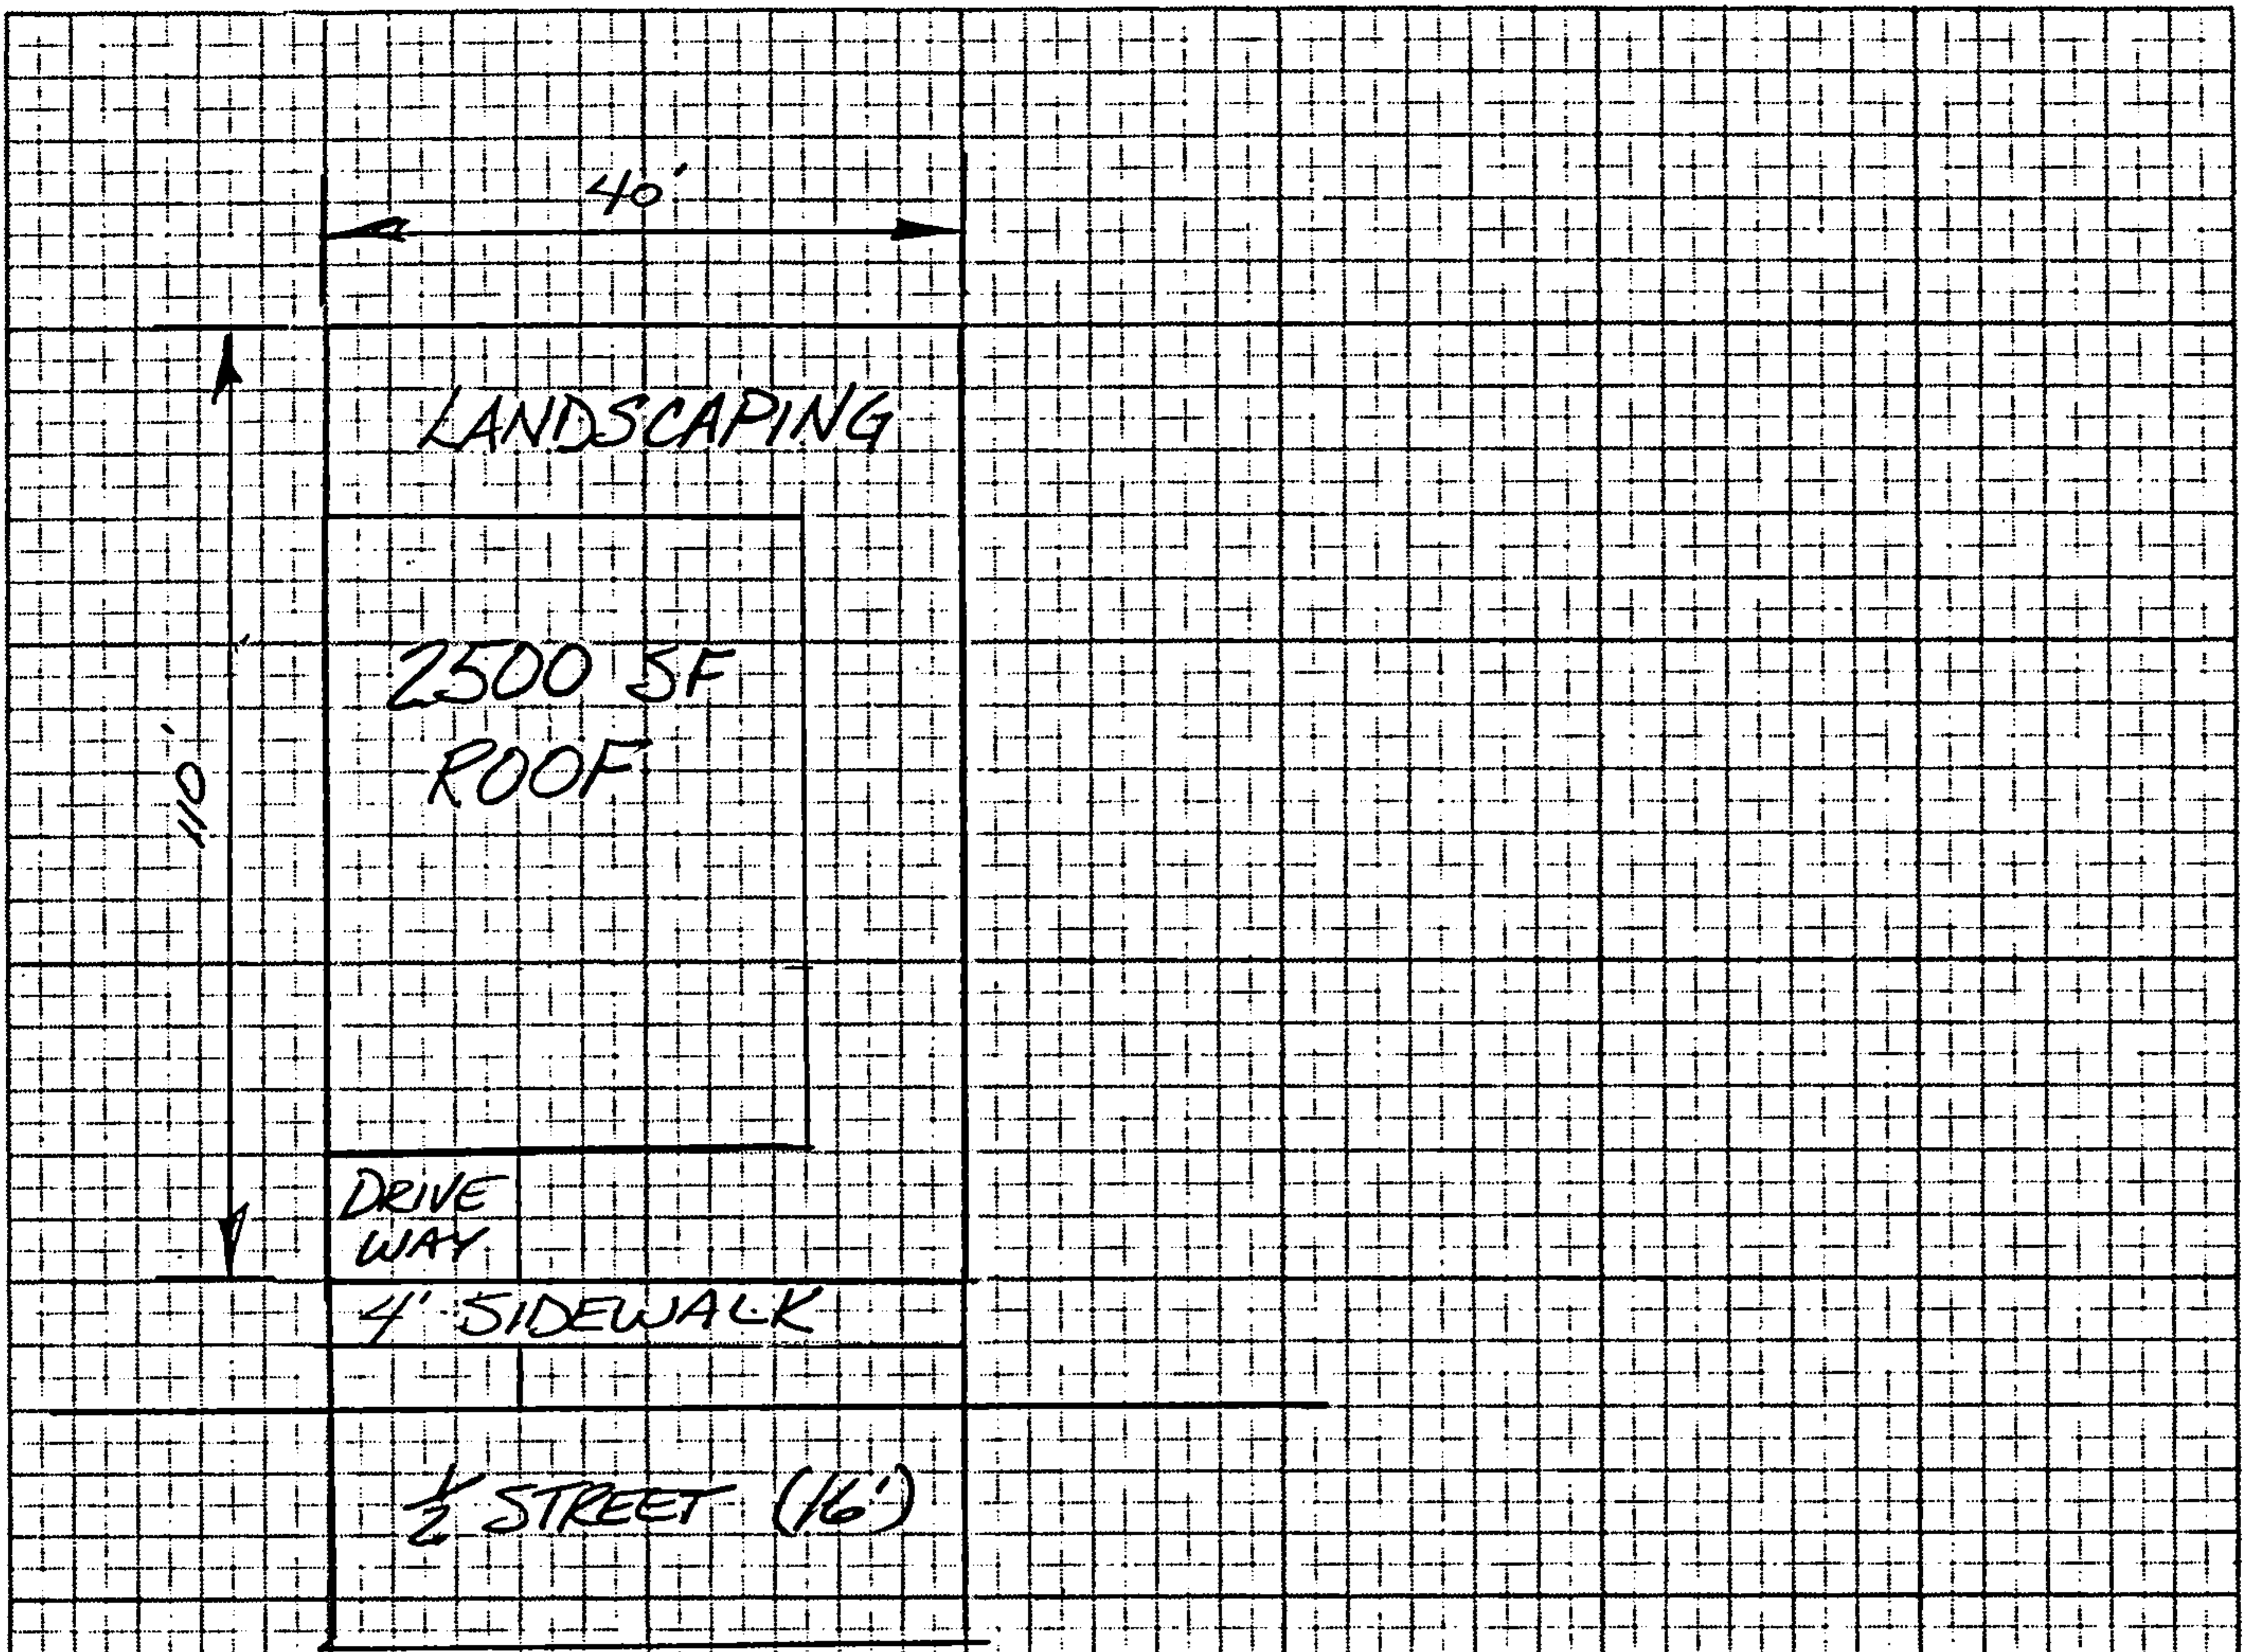

6 DU. / ACRE

TYPICAL LOT

TOTAL LOT AREA W/ 1/2 STREET

$$(110 + 25) (40) = 5400 \text{ SQ. FT.}$$

% IMPERVIOUS

$$2500 + (20)(20) + (4)(40) + (5)(20) + (40)(16) = 3800 \text{ SQ. FT.}$$

$$\frac{3800 \text{ SQ. FT.}}{5400 \text{ SQ. FT.}} = 0.70 \quad 70\% \text{ IMPERVIOUS}$$


PLATE 22.2 C-1 GIVES C FACTOR = 0.70 FOR SOIL GROUP B



PROJECT NAME _____ SHEET A2-3 OF _____

PROJECT NO. _____ BY _____ DATE _____

SUBJECT _____ CH'D _____ DATE _____

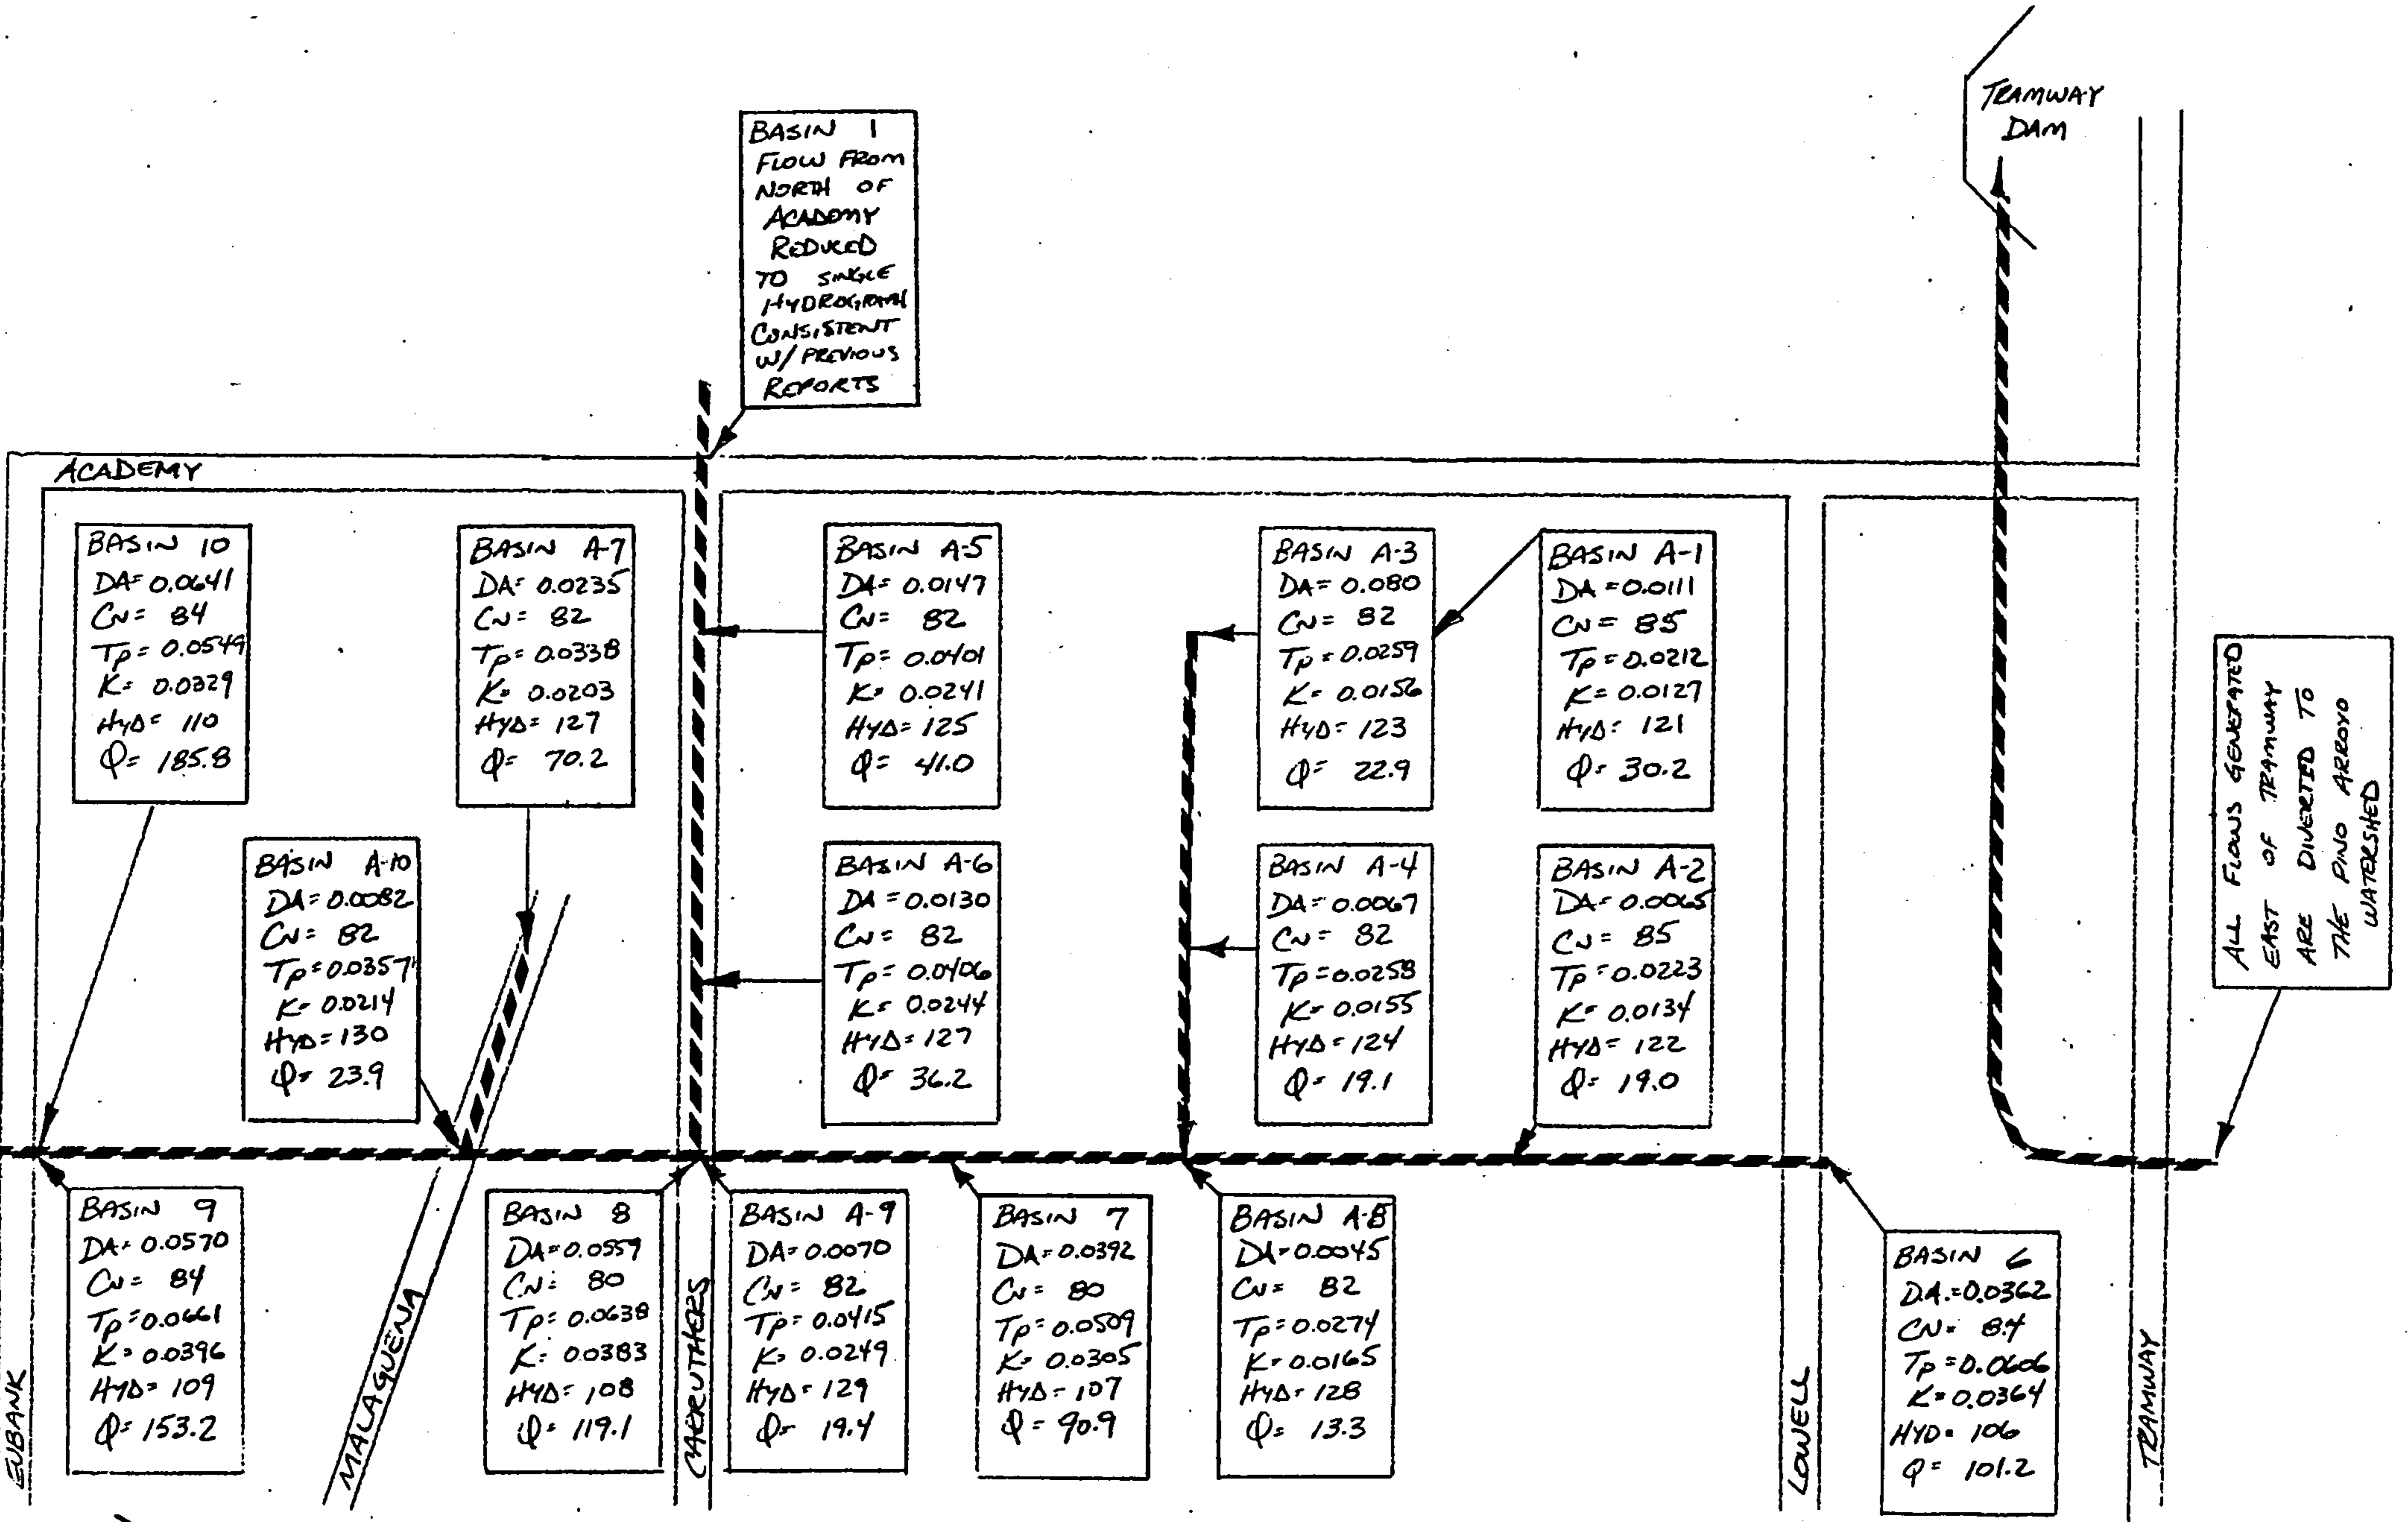

BASIN 1
FLOW FROM
NORTH OF
ACADEMY
REDUCED
TO SINGLE
HYDROGRAPH
CONSISTENT
W/ PREVIOUS
REPORTS

ACADEMY

BASIN 10
DA=0.0641
CN= 84
Tp= 0.0549
K= 0.0329
HYD= 110
Q= 185.8

BASIN A-7
DA= 0.0235
CN= 82
Tp= 0.0338
K= 0.0203
HYD= 127
Q= 70.2

BASIN A-5
DA= 0.0147
CN= 82
Tp= 0.0101
K= 0.0241
HYD= 125
Q= 41.0

BASIN A-3
DA= 0.080
CN= 82
Tp= 0.0259
K= 0.0156
HYD= 123
Q= 22.9

BASIN A-1
DA= 0.0111
CN= 85
Tp= 0.0212
K= 0.0127
HYD= 121
Q= 30.2

BASIN A-10
DA= 0.0082
CN= 82
Tp= 0.0357
K= 0.0214
HYD= 130
Q= 23.9

BASIN A-6
DA= 0.0130
CN= 82
Tp= 0.0106
K= 0.0244
HYD= 127
Q= 36.2

BASIN A-4
DA= 0.0067
CN= 82
Tp= 0.0258
K= 0.0155
HYD= 124
Q= 19.1

BASIN A-2
DA= 0.0065
CN= 85
Tp= 0.0223
K= 0.0134
HYD= 122
Q= 19.0

BASIN 9
DA= 0.0570
CN= 84
Tp= 0.0661
K= 0.0396
HYD= 109
Q= 153.2

BASIN 8
DA= 0.0557
CN= 80
Tp= 0.0638
K= 0.0383
HYD= 108
Q= 119.1

BASIN A-9
DA= 0.0070
CN= 82
Tp= 0.0415
K= 0.0249
HYD= 129
Q= 19.4

BASIN 7
DA= 0.0392
CN= 80
Tp= 0.0509
K= 0.0305
HYD= 107
Q= 90.9

BASIN A-8
DA= 0.0045
CN= 82
Tp= 0.0274
K= 0.0165
HYD= 128
Q= 13.3

BASIN 6
DA= 0.0362
CN= 84
Tp= 0.0606
K= 0.0364
HYD= 106
Q= 101.2


ALL FLOWS GENERATED
EAST OF TEAMWAY
ARE DIVERTED TO
THE PINO ARROYO
WATERSHED

BEAR TRIBUTARY WATERSHED DRAINAGE BASIN SCHEMATIC

STORM DRAIN




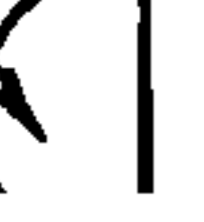


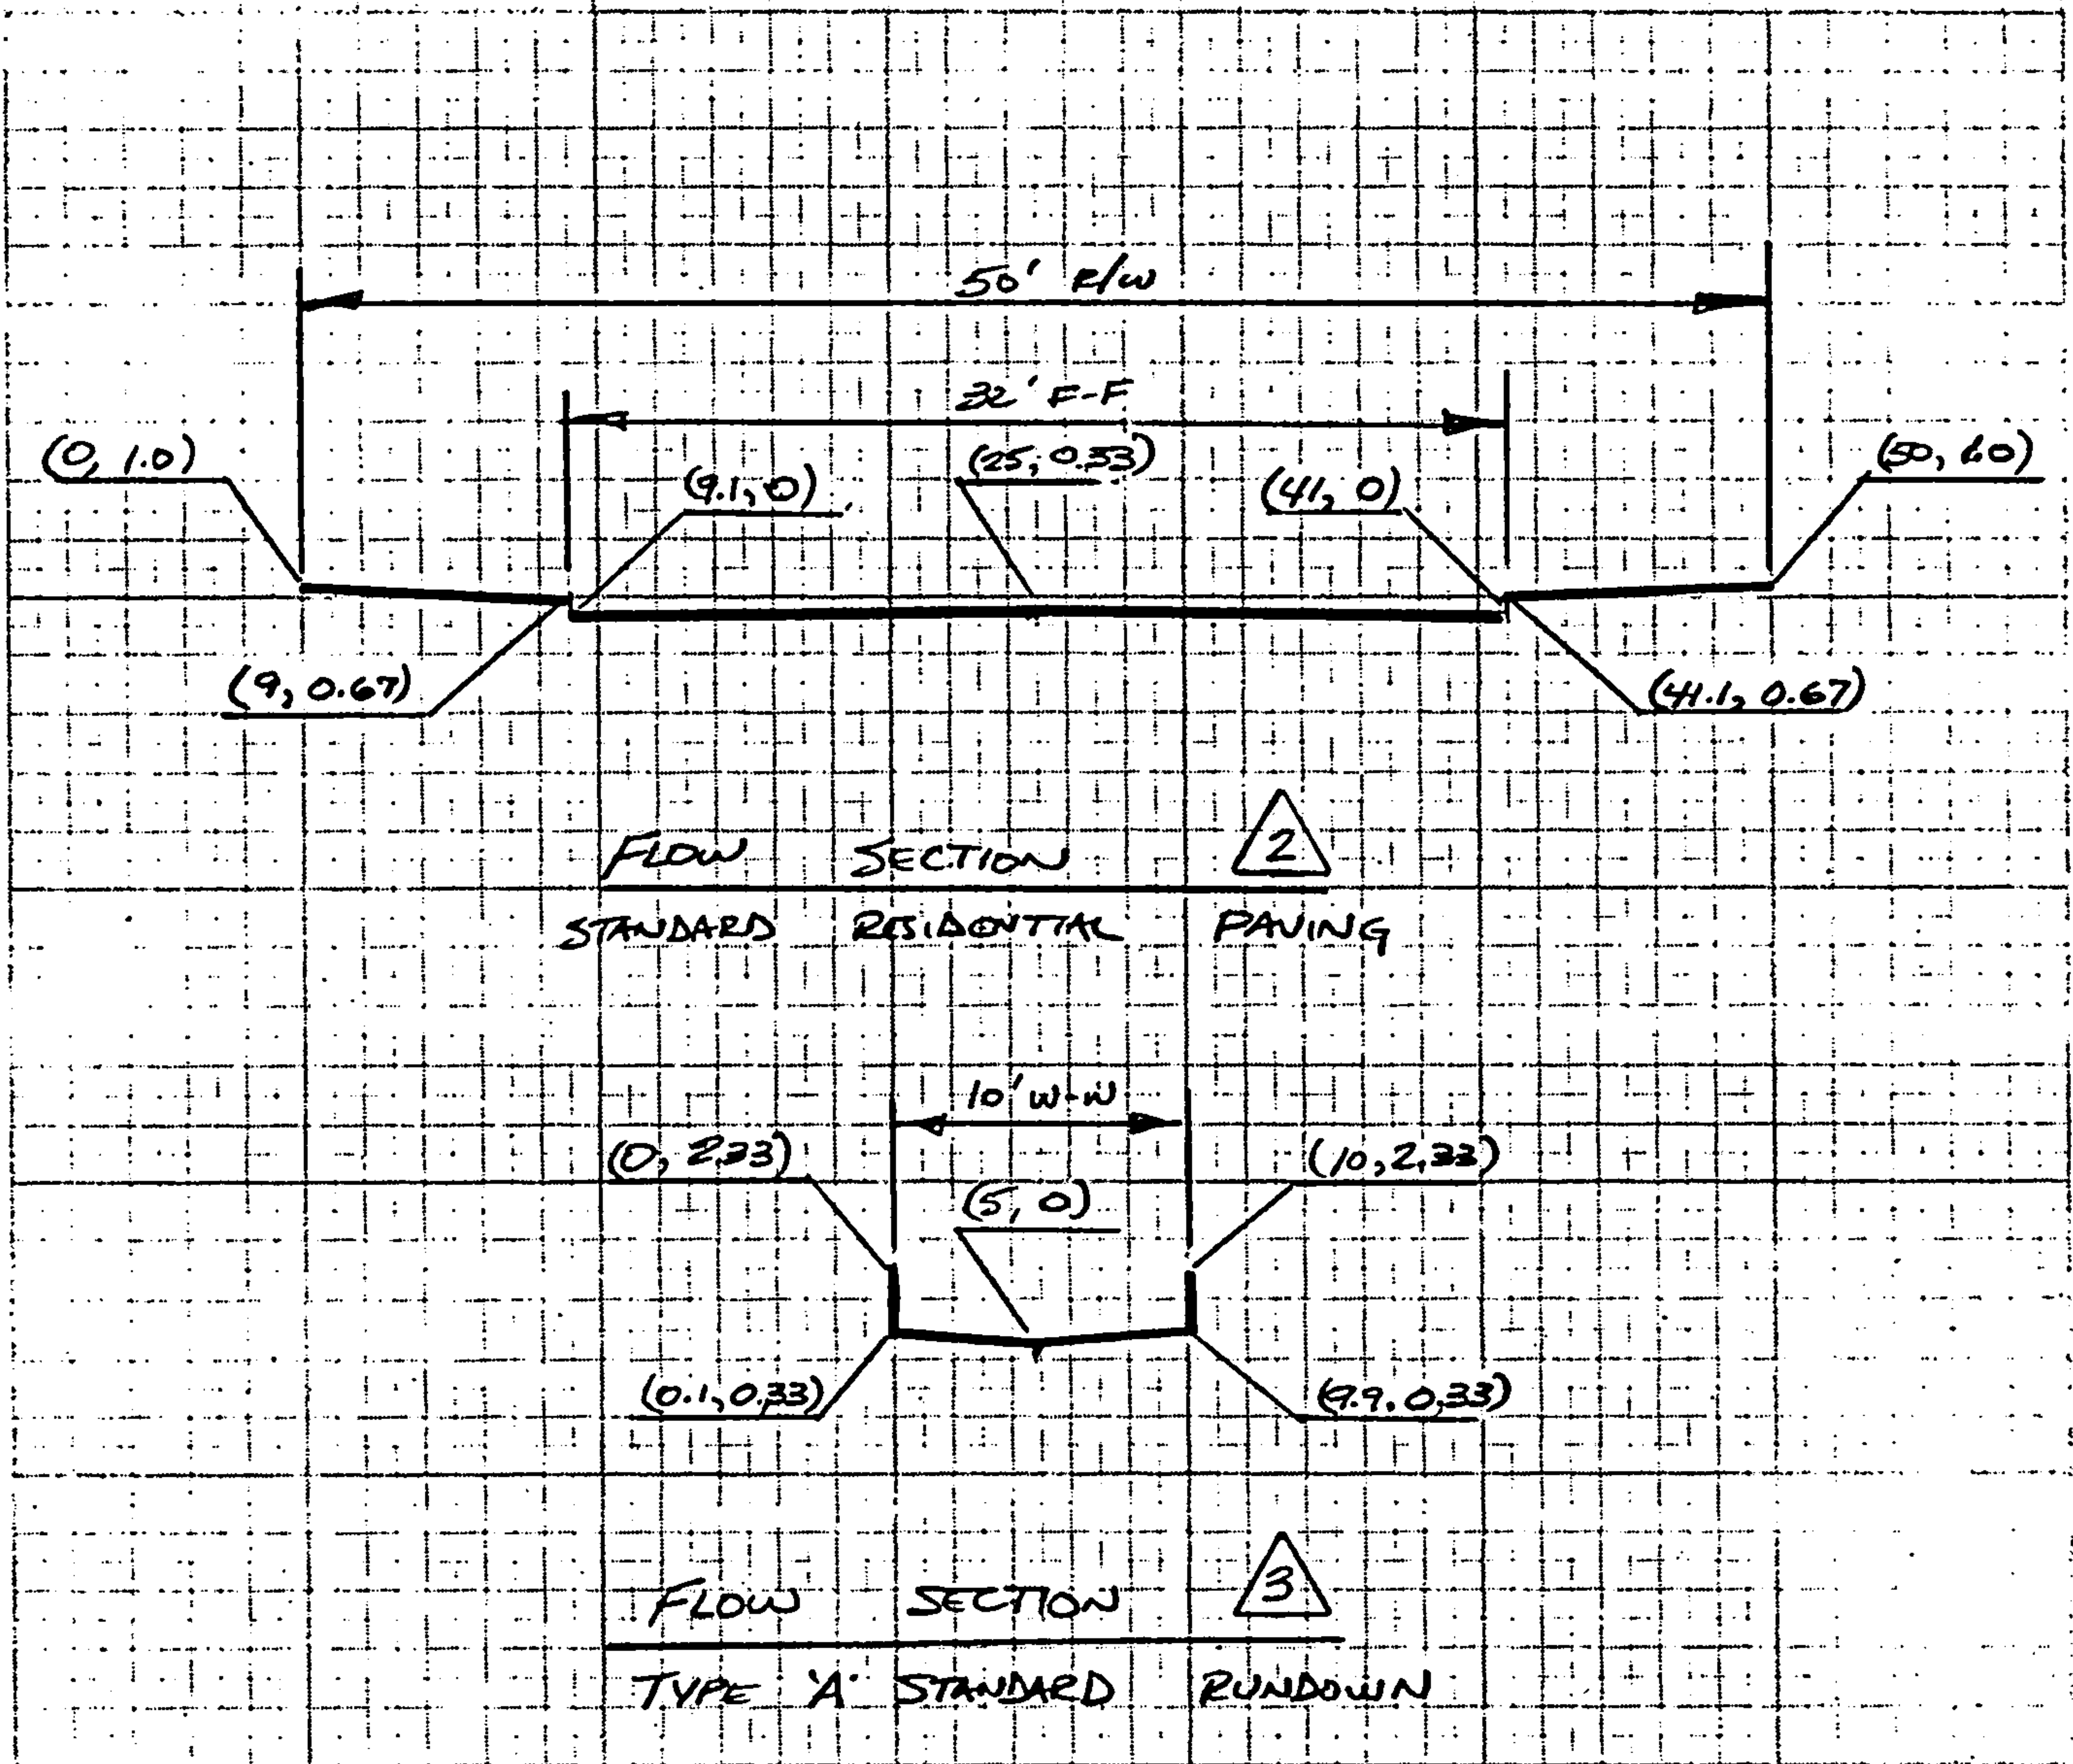
A2-4






PROJECT NAME ACADEMY RIDGE EAST SHEET A2-6 OF
 PROJECT NO. 41441 BY KUD DATE 5/84
 SUBJECT HYMO FLOW SECTIONS CH'D DATE

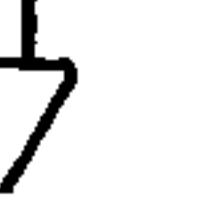

-  ANALYSIS POINT
-  BASIN ID
-  BASIN SYMBOL
-  HYD. NO.
-  FLOW SECTION
-  ROUTING SYMBOL
-  ROUTED HYD. NO.

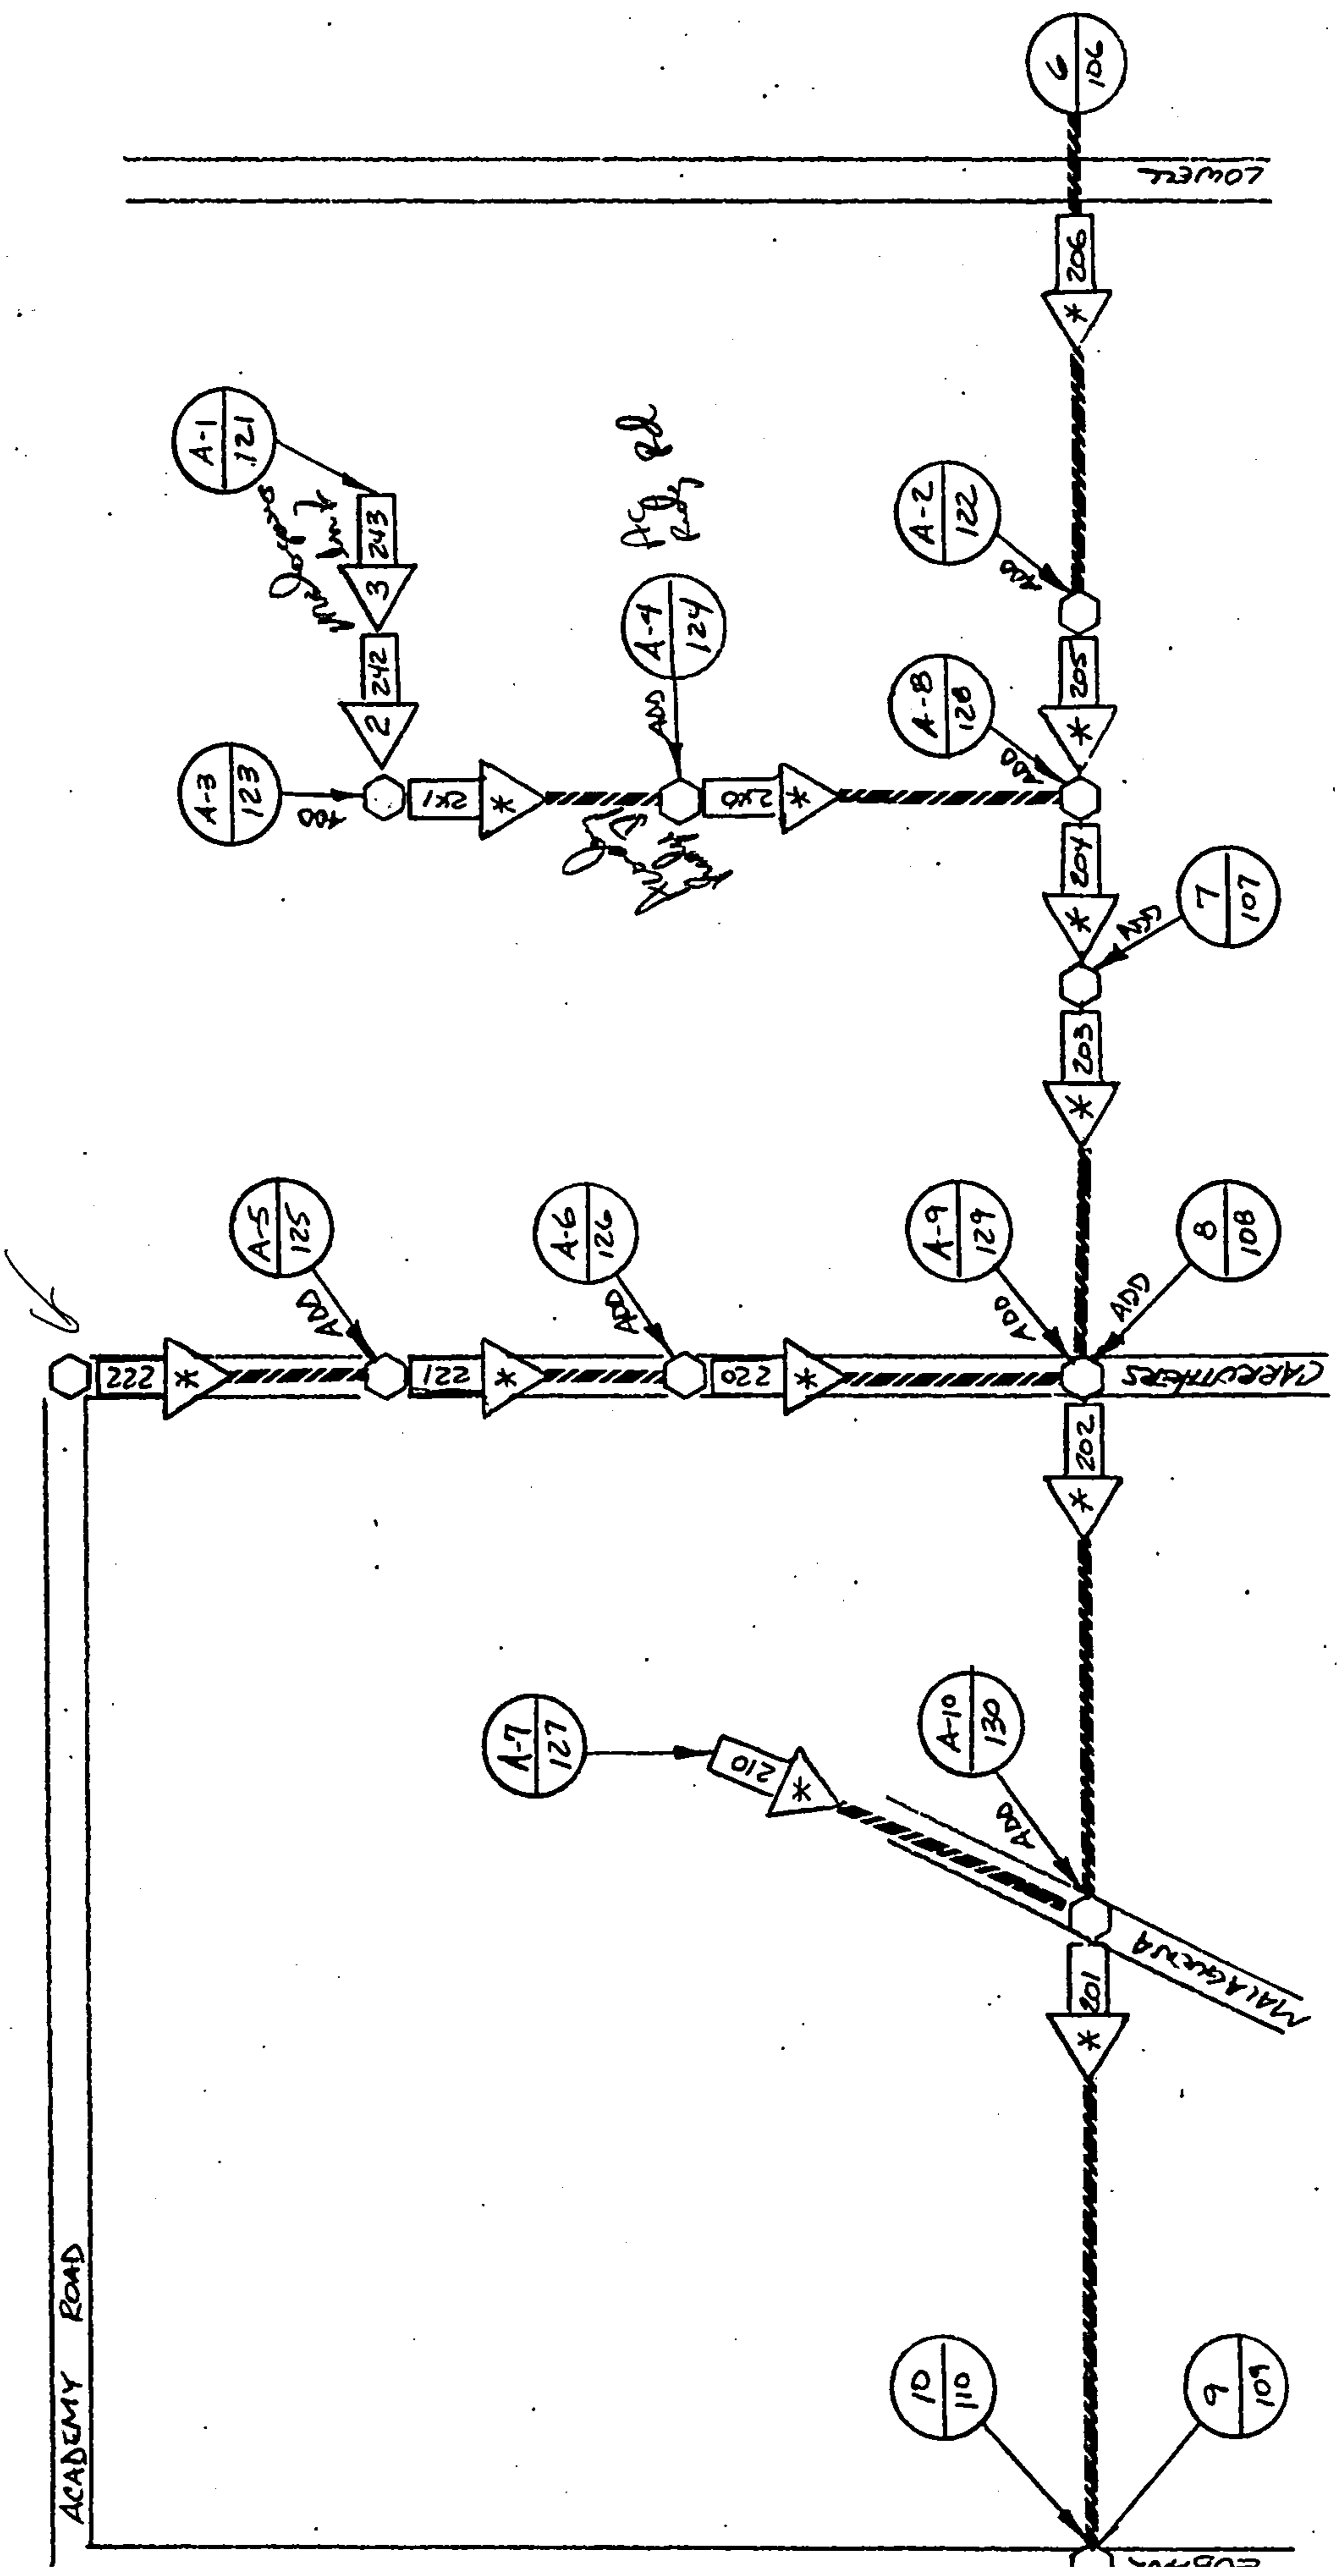

BEAR ARROYO TRIBUTARY HYMO ANALYSIS SCHEMATIC

A2-5

$$T_c = 0.0078 \frac{L^{0.77}}{S^{0.385}}$$

[DPM SECTION 22.2.B.1]

$$T_p = (2/3) T_c$$


$$K = 0.6 T_p$$

C_w DETERMINATION:


ALL SOILS IN SOIL GROUP B

CURVE NUMBER DETERMINATION

LAND USE DESCRIPTION	Hydrologic Soil Group			
	A	B	C	D
Cultivated land ^{1/} : without conservation treatment	72	81	88	91
: with conservation treatment	82	71	78	81
: poor condition	68	79	86	89
Pasture or range land: fair condition	54	70	80	85
: good condition	39	61	74	80
Meadow: good condition	30	68	71	78
Wood or Forest land: thin stand, poor cover, no mulch	45	66	77	81
good cover ^{2/}	25	55	70	77
Open Spaces, lawns, parks, golf courses, cemeteries, etc. good condition: grass cover on 75% or more of the area	39	61	74	80
fair condition: grass cover on 50% to 75% of the area	49	69	78	84
Commercial and business areas (85% impervious)	89	92	94	96
Industrial districts (72% impervious)	81	88	91	93
Residential ^{2/}				
Average lot size Average % Impervious ^{4/}				
1/8 acre or less 65	77	85	90	92
1/4 acre 38	61	76	83	87
1/3 acre 30	67	72	81	86
1/2 acre 25	64	70	80	85
1 acre 20	61	68	79	84
Paved parking lots, roofs, driveways, etc. ^{2/}	98	98	98	98
Streets and roads:				
paved with curbs and storm sewers ^{2/}	98	98	98	98
gravel	78	85	92	91
dirt	72	82	87	90

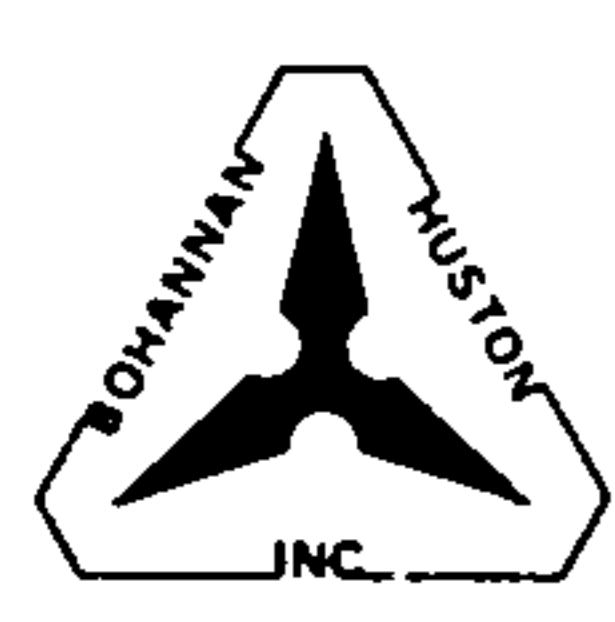

1-31

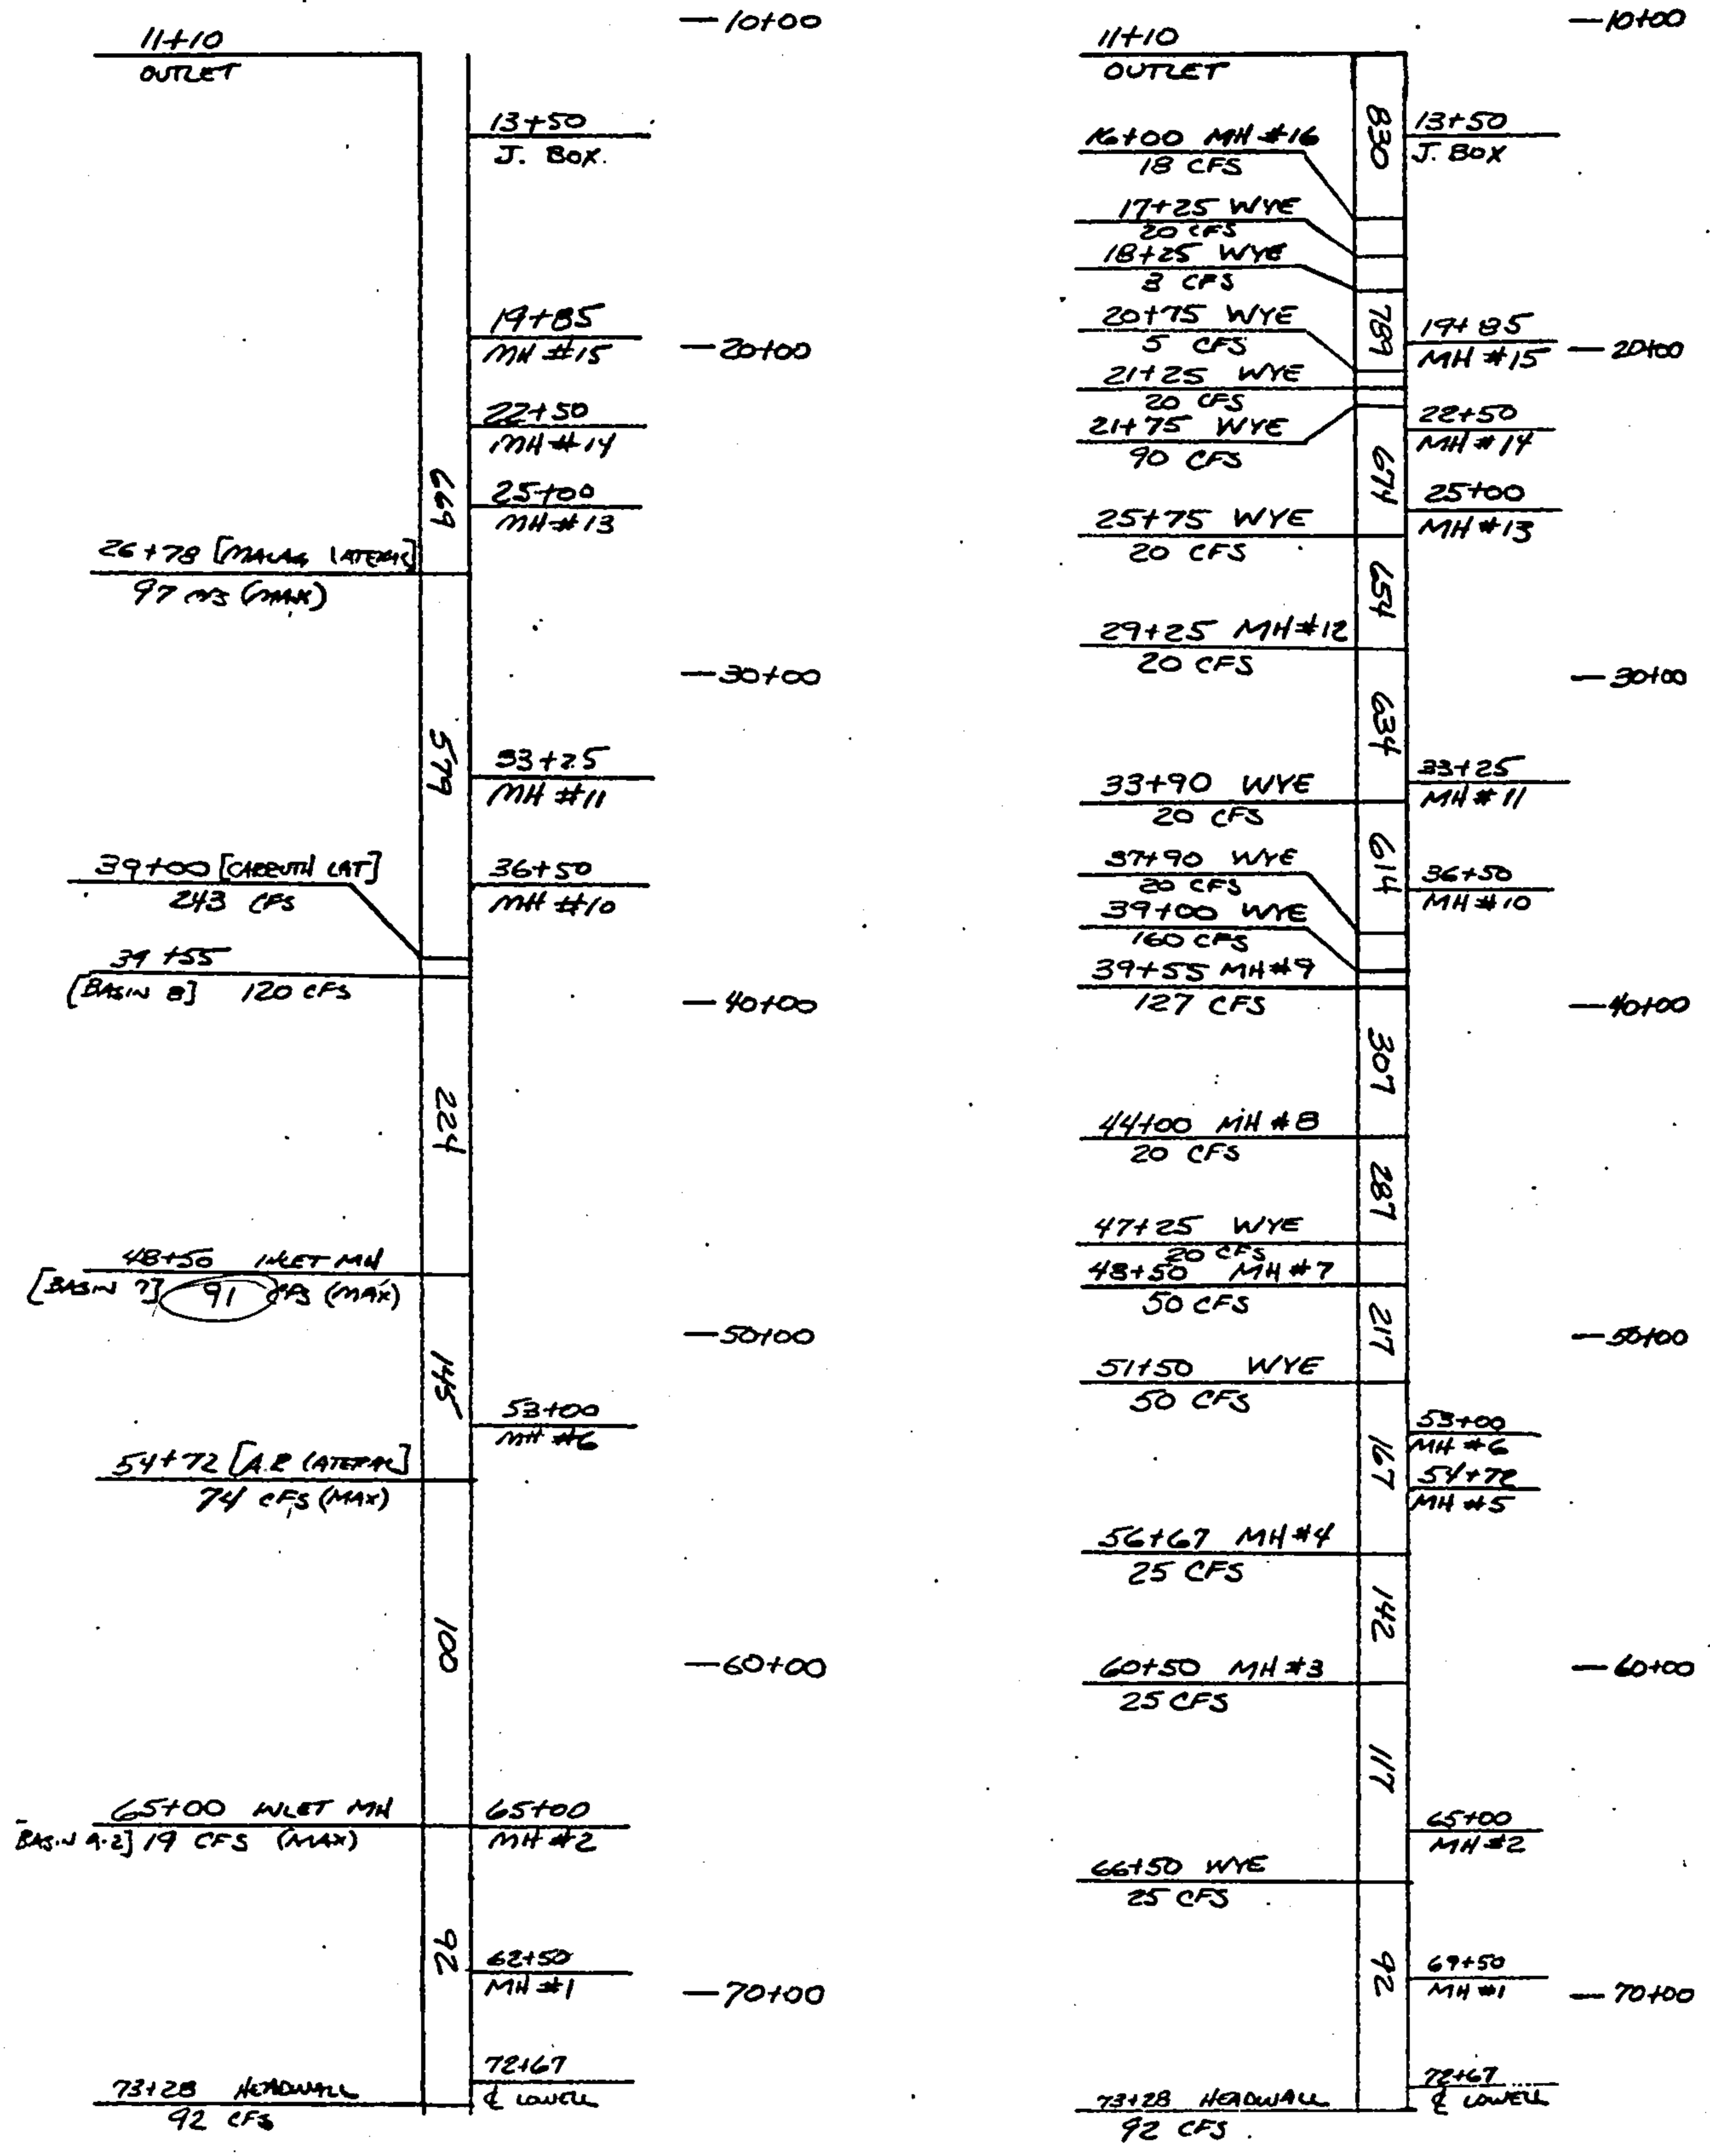

BEAR TRIBUTARY PIPELINE FLOW SCHEMATIC



PROJECT: BEAR TRIB 10079
SAD 205

SUMMARY OF HYDRAULIC CALCULATIONS

BY: SE
DATE: 12/1/83
SHEET: 1 OF 4

STATION	STRUCT.	CONDUIT					OPEN CHANNEL FLOW												PRESSURE CONDUIT						ELEVATIONS					
		Q	n	PIPE	L	S	S _F	PIPE HYDRAULICS						LOSSES		PIPE HYDRAULICS		LOSSES				E.G.	h _v	H.G.	SOFFIT	d _n	INVERT			
								Q _{ACT}	%Q _{DES}	%D _{ACT}	d _n	V _{ACT}	V _{DES}	V	H _F	H _x	A	V	H _F	H _B	H _S							H _{MH}	H _x	ΣH _L
11+10	ORLET																								85 ¹¹	1492	70 ¹⁹	71 ⁵⁴	3 ⁴⁹	66 ⁷¹
13+50	J. BOX	830	0.011	58x91	240'	0.0296	0.0253	256	0.93	0.72	348	30.1	1.03	31.00	710										92 ²¹	1492	77 ²⁹	78 ⁶⁴	3 ⁴⁹	73 ⁸¹
														0.01	0.33										94 ²⁴	1521	79 ⁰³	79 ⁸¹	522	73 ⁸¹
16+00	MH	830	0.011	72"	250'	0.0296	0.02751	861	0.96	0.83	522	30.4	1.03	31.3	740										01 ⁶⁴	1521	86 ⁴³	87 ²¹	522	81 ²¹
														0.19											01 ⁸³	1521	86 ⁶²	87 ⁵²	510	81 ⁵²
17+25	WYE	812	0.011	72"	125'	0.0296	0.02633	861	0.94	0.85	510	30.4	1.03	31.3	370										05 ⁵³	1521	90 ³²	91 ²²	510	85 ²²
																									05 ⁵³	1521	90 ³²	91 ²²	510	85 ²²
18+25	WYE	792	0.011	72"	100'	0.0296	0.02505	861	0.92	0.85	510	30.4	1.03	31.3	296										08 ⁴⁹	1521	93 ²⁸	94 ¹⁸	510	88 ¹⁸
																									08 ⁴⁹	1521	93 ²⁸	94 ¹⁸	510	88 ¹⁸
19+85	MH	789	0.011	72"	160'	0.0296	0.02486	861	0.92	0.85	510	30.4	1.03	31.3	474										13 ²³	1521	98 ⁰²	98 ⁹²	510	92 ⁷²
														0.14											13 ²³	1521	98 ⁰²	98 ⁹²	510	92 ⁷²
20+75	WYE	789	0.011	72"	90'	0.0260	0.02486	807	0.98	0.88	528	28.5	1.03	29.3	234										13 ⁵⁷	1333	00 ⁰⁴	00 ⁶⁷	528	94 ⁷⁶
																									15 ⁷¹	1333	02 ³⁸	03 ⁰¹	528	97 ¹⁰
21+25	WYE	784	0.011	72"	50'	0.0260	0.02455	807	0.97	0.93	528	28.5	1.03	29.3	130										15 ⁷¹	1333	02 ³⁸	03 ⁰¹	528	91 ¹⁰
																									17 ⁰¹	1333	03 ⁶⁸	04 ³¹	528	98 ⁴⁰
																									16 ⁹⁵	1333	03 ⁶²	04 ³¹	522	98 ⁴⁰

A3-2

SUMMARY OF HYDRAULIC CALCULATIONS

PROJECT: BEAR TRIB - SAD 205

BY: _____

DATE: _____

SHEET: 2 OF 4

STATION	STROG.	CONDUIT					OPEN CHANNEL FLOW					PRESSURE CONDUIT					ELEVATIONS										
		Q	n	PIPE	L	S	SF	PIPE HYDRAULICS			LOSSES		PIPE HYDRAULICS					E.G.	hv	H.G.	SOFFIT	dn	INVERT				
								$\frac{Q_{total}}{Q_{pipe}}$	$\frac{V_{full}}{V_{avail}}$	$\frac{d_{full}}{d_{avail}}$	$\frac{H_f}{H_x}$	H_f	H_x	A	V	H_f	H_b							H_s	H_{MH}	H_x	ΣH_L
21+75	WYE	764	0.011	72"	50	0.0260	0.02331	807	0.95	87	522	28.5	1.03	27.3	1.30							18 ²⁵	1333	04 ⁹²	05 ⁷²	522	99 ⁷²
22+50	MH	674	0.011	72"	75	0.0260	0.01814	807	0.84	0.78	468	28.5	1.0	28.5	1.95							16 ⁹⁹	12 ⁶¹	04 ³⁸		468	99 ⁷²
25+00	MH	674	0.011	66"	250	0.0280	0.02887								0.25						20 ¹⁵	12 ⁵⁸	07 ⁶⁵	07 ⁶⁵	55	02 ¹⁵	
25+75	WYE	674	0.011	66"	75	0.02430	0.02887														27 ⁹⁸	12 ⁵⁸	14 ⁸⁵	14 ⁶⁵	55	09 ¹⁵	
29+25	MH	654	0.011	66"	350	0.02430	0.02718														30 ¹⁴	12 ⁵⁸	17 ⁴³	16 ⁴⁸	55	10 ¹⁷	
33+25	MH	634	0.011	66"	400	0.02510	0.02554	635	0.91	0.84	462	29.4	1.03	30.3	2.40						23 ⁷⁶	11 ⁷¹	19 ³²	16 ⁴⁸	55	10 ⁹¹	
33+90	WYE	634	0.011	66"	65	0.02510	0.02554	635	0.91	0.84	462	29.4	1.03	30.3	2.02						23 ⁷⁶	11 ⁷¹	21 ⁹³	25 ²¹	55	03 ²⁰	
36+50	MH	614	0.011	66"	260	0.02510	0.02376	638	0.88	0.82	457	29.4	1.02	30.0	8.06						23 ⁷⁶	13 ⁹⁵	42 ³⁵		462	37 ⁷³	
																					64 ³²	13 ⁹⁵	50 ³⁴		457	45 ⁷⁹	
																					64 ³²	13 ⁹⁵	50 ³⁴		457	45 ⁷⁹	

SUMMARY OF HYDRAULIC CALCULATIONS

BY: _____
 DATE: _____
 SHEET: 3 OF 4

PROJECT: BOAZ TRIB - SAD 205

STATION	CONDUIT					OPEN CHANNEL FLOW					PRESSURE CONDUIT					ELEVATIONS						
	STRUC.	Q	n	PIPE	L	S	SF	PIPE HYDRAULICS			LOSSES		PIPE HYDRAULICS			LOSSES		E.G.	h _v	H.G. SOFFIT	d _n	INVERT
								Q _{ACT}	% _{ACT}	% _{DES}	d _n	V _{ACT}	V _{DES}	H _f	H _s	A	V					
37+90	WYE	614	0.011	66"	140	0.0310	0.02394	1.98	0.88	0.83	4.57	102	30.0	4.34				68.66	13.96	54.20	4.57	50.13
39+10	WYE	594																67.87	13.42	54.45	4.29	50.13
39+55	J. BOX	594	0.011	66"	165	0.0310	0.02242	1.98	0.85	0.78	4.29	1.00	29.4	5.12				72.96	13.42	59.54	4.29	55.55
44+00	MH	307	0.013	54"	445	0.0400	0.01744	1.65	0.66	0.67	3.02	0.92	26.9	17.80				73.19	11.23	61.96	3.02	55.94
47+25	WYE	287	0.013	48"	325	0.0481	0.03994											91.30	8.10	83.20		76.74
48+50	MH	267	0.013	48"	125	0.0481	0.03455											91.30	8.10	83.20		76.74
51+50	WYE	217	0.013	48"	300	0.0324	0.02082											10.96	4.63	06.33		09.17
53+00	MH	167	0.013	48"	150	0.0324	0.01352											18.42	2.74	15.68		13.71

A3-4

SUMMARY OF HYDRAULIC CALCULATIONS

PROJECT: BEAR TRIB - SAD 205 BY: _____ DATE: _____ SHEET: 4 OF 4

STATION	OPEN CHANNEL FLOW										PRESSURE CONDUIT					ELEVATIONS																					
	STROG.	CONDUIT			PIPE HYDRAULICS					LOSSES		PIPE HYDRAULICS					E.G.	hv	H.G.	SOFFIT	dn	INVERT															
		Q	n	PIPE	L	S	SF	Q _{full} /Q _{reqd}	8/1000	%/1000	d _n	V _{full}	V _{reqd}	V	H _f	H _b							H _s	H _{MIN}	H _x	ΣHL	A	V	H _f	H _b	H _s	H _{MIN}	H _x	ΣHL			
54+72	MH	167	0.013	42"	172	0.03450	0.02756	194	0.86	0.79	2.77	202	100	202	64							707	20.09	17.36							29.8	6.32	22.88			277	20.11
56+67	MH	167	0.013	42"	195	0.03720	0.02756	194	0.86	0.79	2.77	202	100	202	72.5							707	20.09	17.36							29.8	6.32	22.88			277	20.11
60+50	MH	142	0.013	36"	383	0.04559	0.0454														707	20.09	17.36							36.45	6.27	30.18			3.0	41.54	
65+00	MH	117	0.013	36"	450	0.03902	0.03086														707	16.55	13.85							55.82	4.25	51.57			3.0	62.12	
66+50	WYE	117	0.013	36"	150	0.02182	0.03086														707	16.55	4.62							69.56	4.25	65.31			3.0	65.37	
69+50	MH	92	0.013	36"	300	0.02182	0.01706														707	12.02	5.71							75.11	2.63	72.48			3.0	75.19	
73+28	INLET	92	0.013	36"	378			128	0.72	0.70	2.10	182	0.87	158	14.05															91.32	3.88	77.44			2.1	75.24	

GENERAL NOTE

1. All BCP shall be A.S.T.M. Class II.
2. All street fills shall be compacted to a minimum density of 98% of optimum (modified) A.S.T.M. 1557.

AS BUILT INFORMATION

NO.	DATE	BY	FIELD NOTES

BENCH MARKS

NO.	DESCRIPTION	ELEVATION

SURVEY INFORMATION

NO.	DATE	BY	FIELD NOTES



ENGINEER'S SEAL

CITY OF ALBUQUERQUE
MUNICIPAL DEVELOPMENT DEPARTMENT
ENGINEERING DIVISION

TITLE
BEAR CANYON TRIBUTARY
STORM DRAIN PLAN & PROFILE

APPROVALS	DATE	APPROVALS	DATE

PROJECT NO. 1721 SHEET 57 OF 87

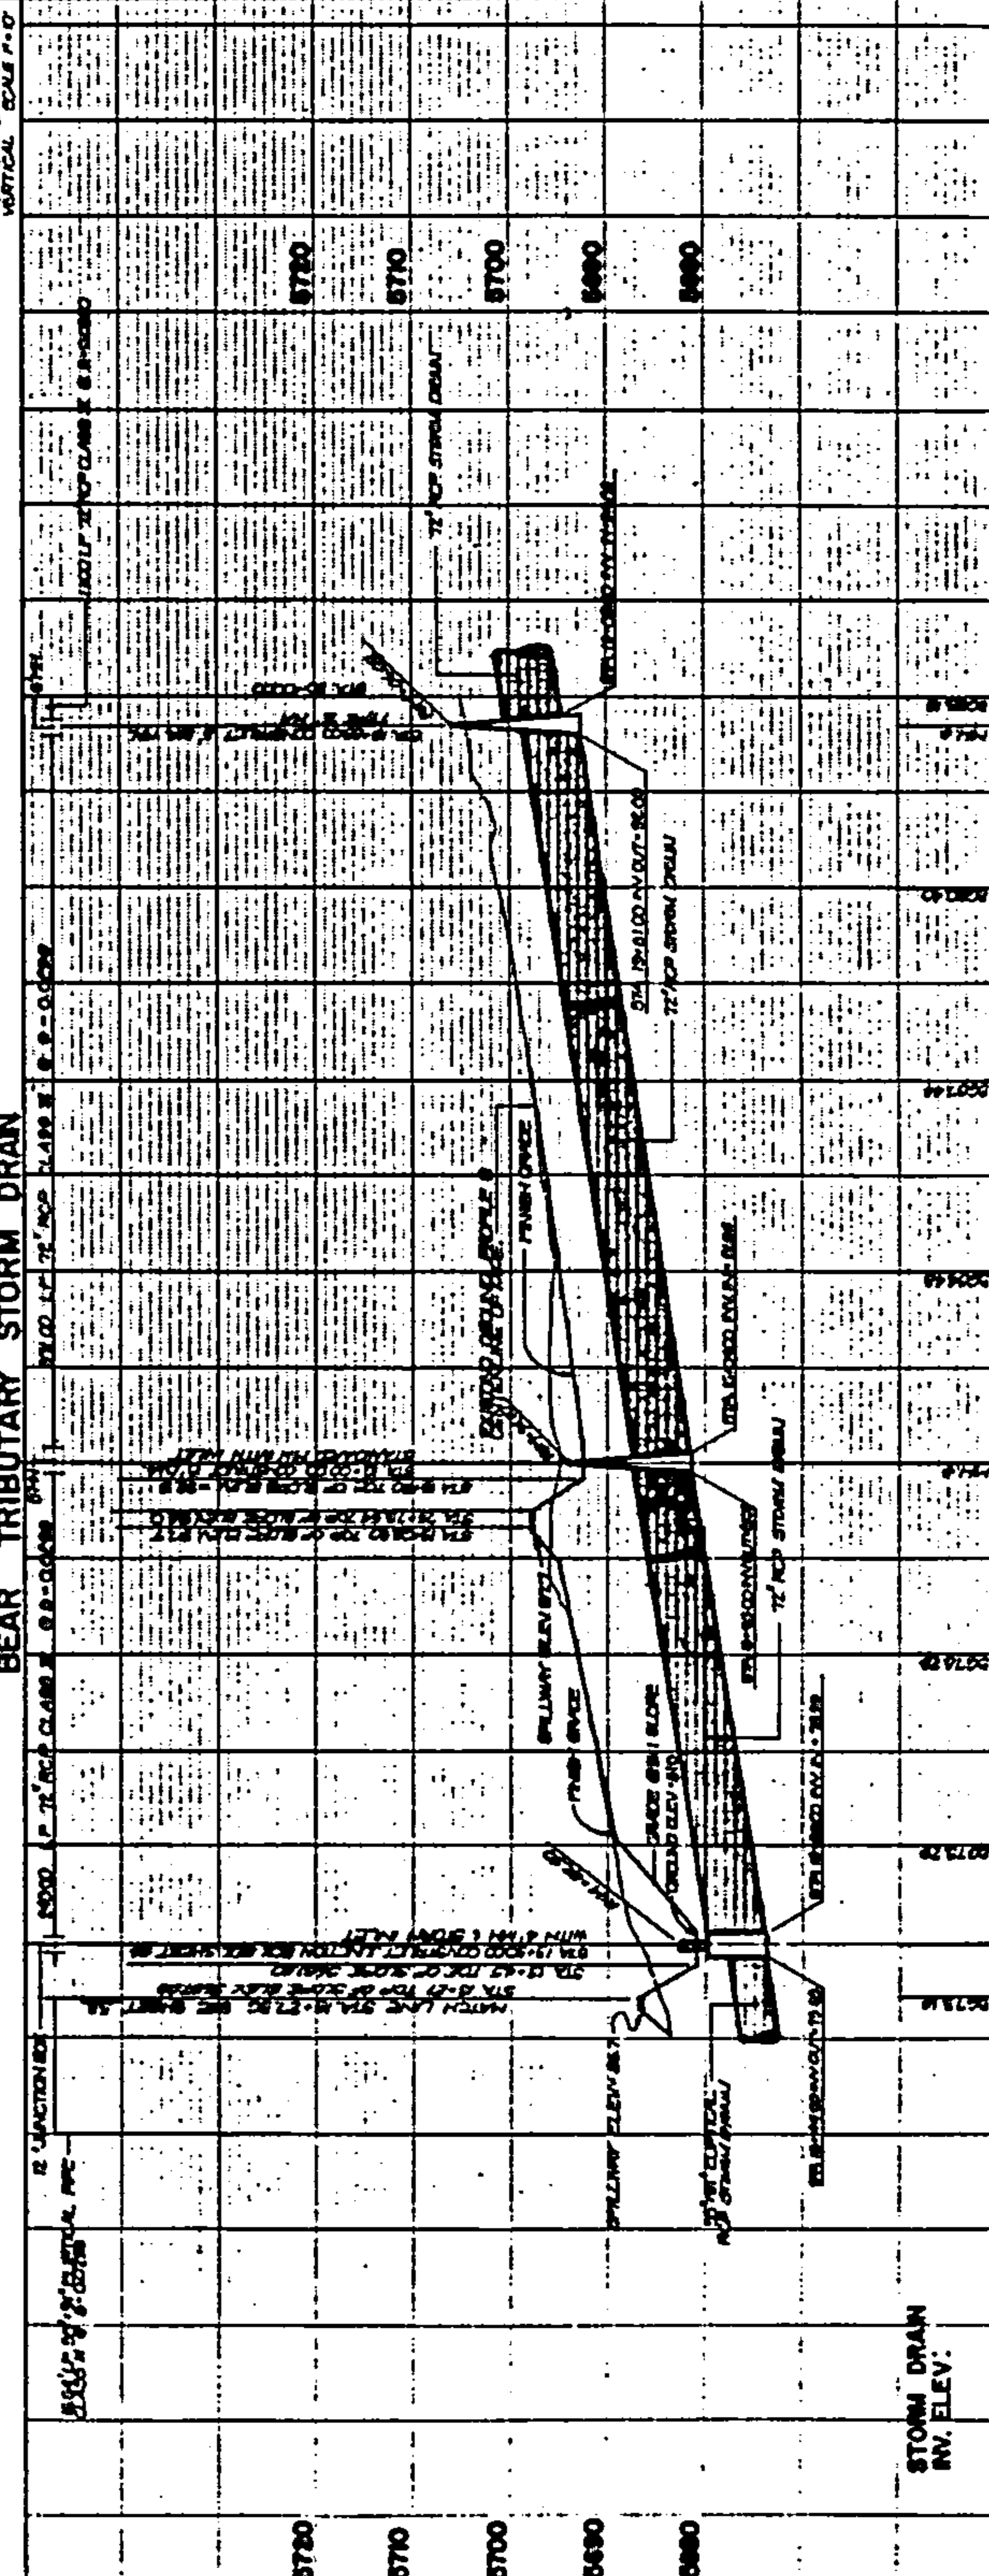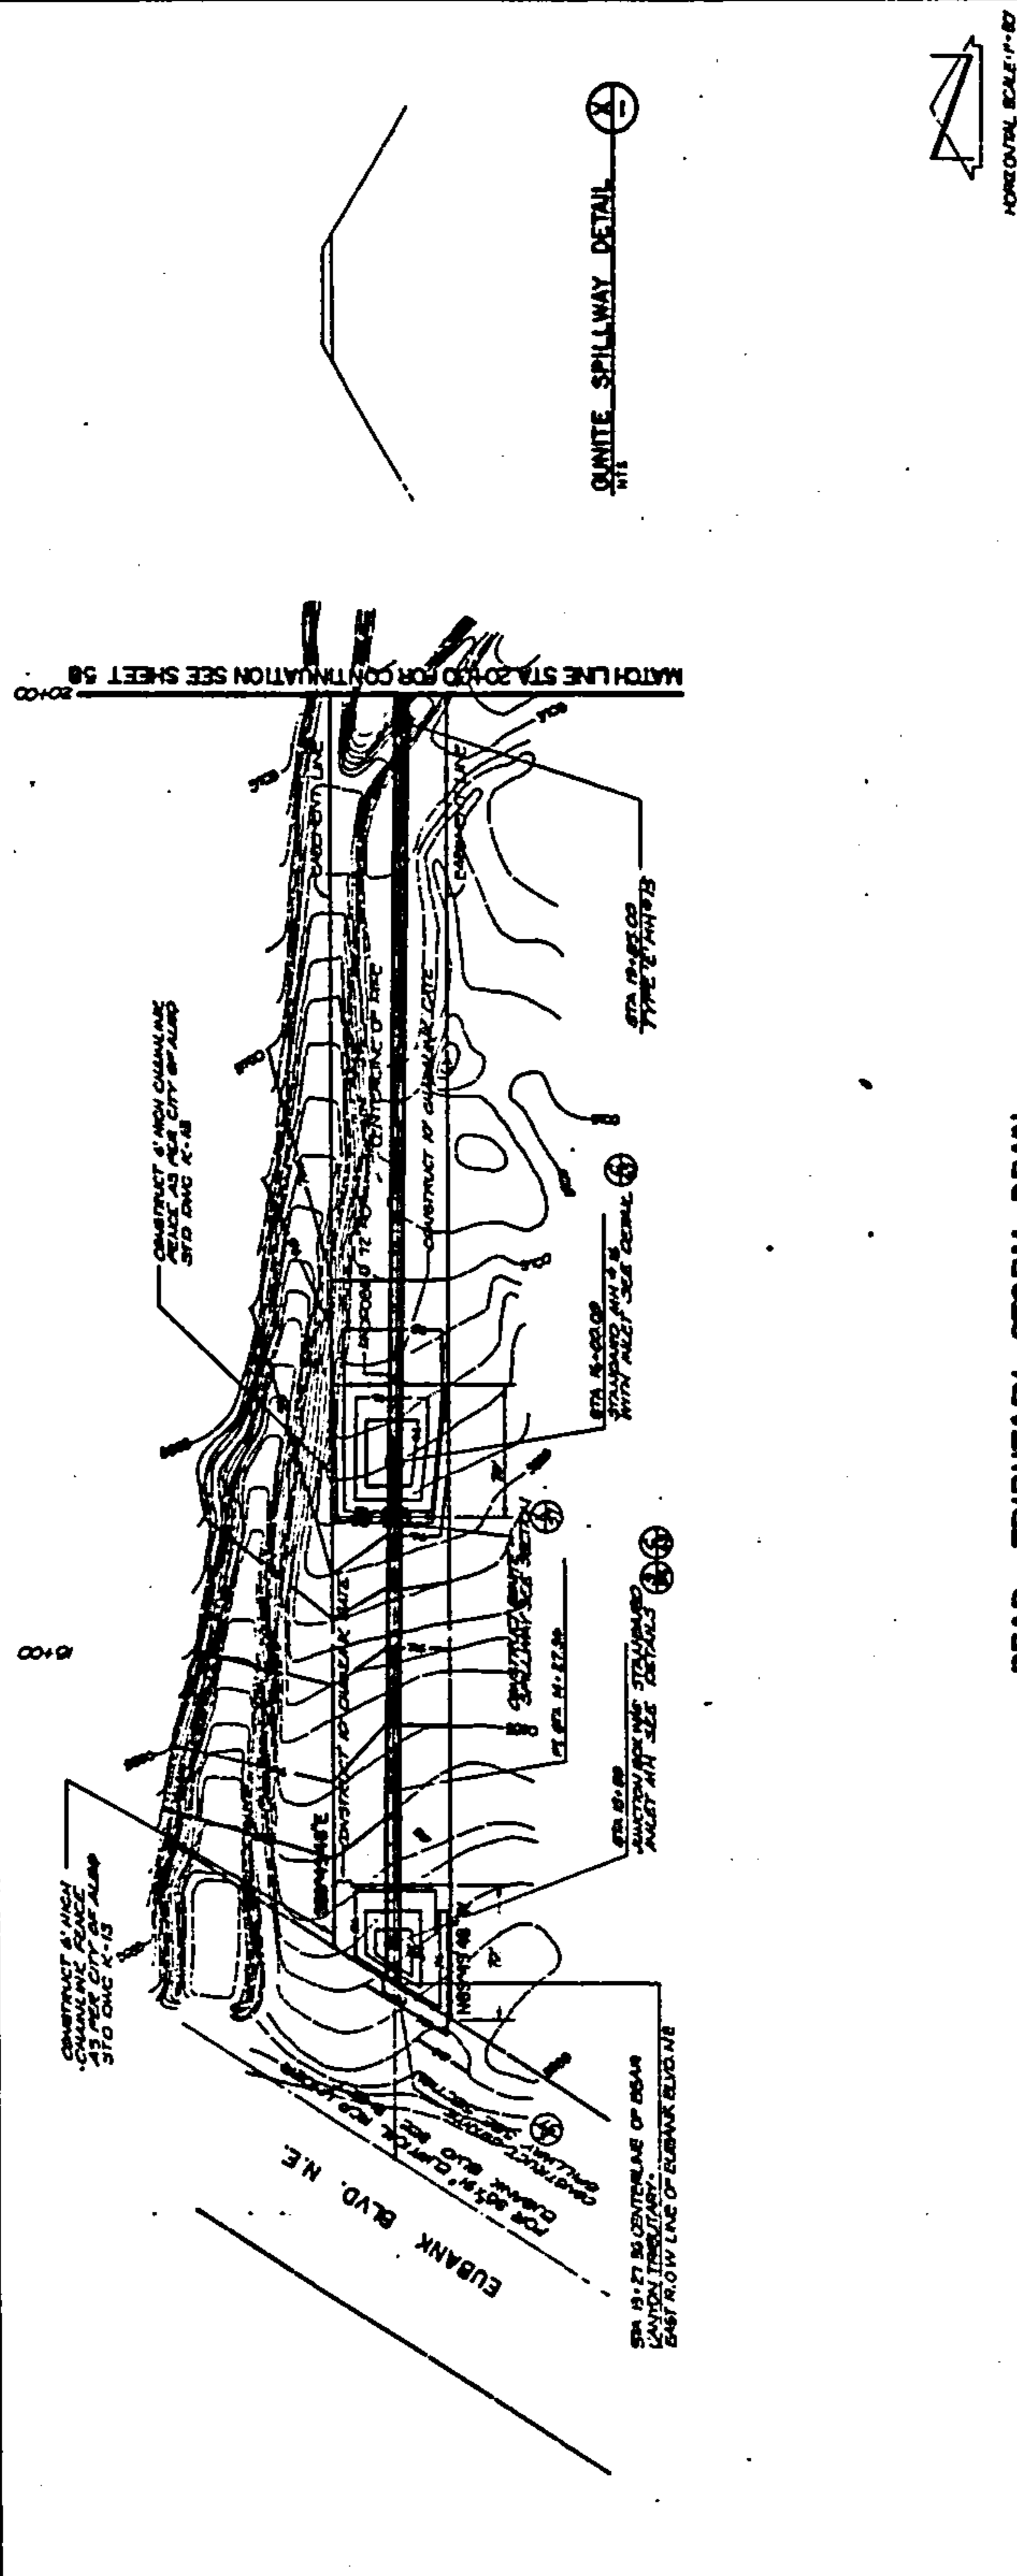

A3-7

ENGINEER'S SEAL		NO. _____		DATE _____		REMARKS	
SURVEY INFORMATION		FIELD NOTES		DATE		BY	
AS BUILT INFORMATION		A D OUT ON TOP OF THE CONCRETE CURB		THE INTERSECTION OF CARROLLERS RD.		AND DONAHOO CT IN THE NORTHEAST	
QUADRANT OF THE INTERSECTION, (A,B)		ELEVATION = 5707.30		B.M. 15 - #22		ELEVATION = 5707.30	
MICRO-FILM INFORMATION		NO. _____		DATE _____		BY _____	





CITY OF ALBUQUERQUE
MUNICIPAL DEVELOPMENT DEPARTMENT
ENGINEERING DIVISION

TITLE:
BEAR CANYON TRIBUTARY
STORM DRAIN PLAN & PROFILE

APPROVALS	DATE	APPROVALS	DATE
City Engineer		Approved	
ACE - Design		Checked	
ACE - Hydrology		Drawn	

- GENERAL NOTES**
- All S.P. shall be A.S.T.M. Class M.
 - All strength shall be computed to a minimum quality of 95% of optimum (Modified A.S.T.M. D1557).

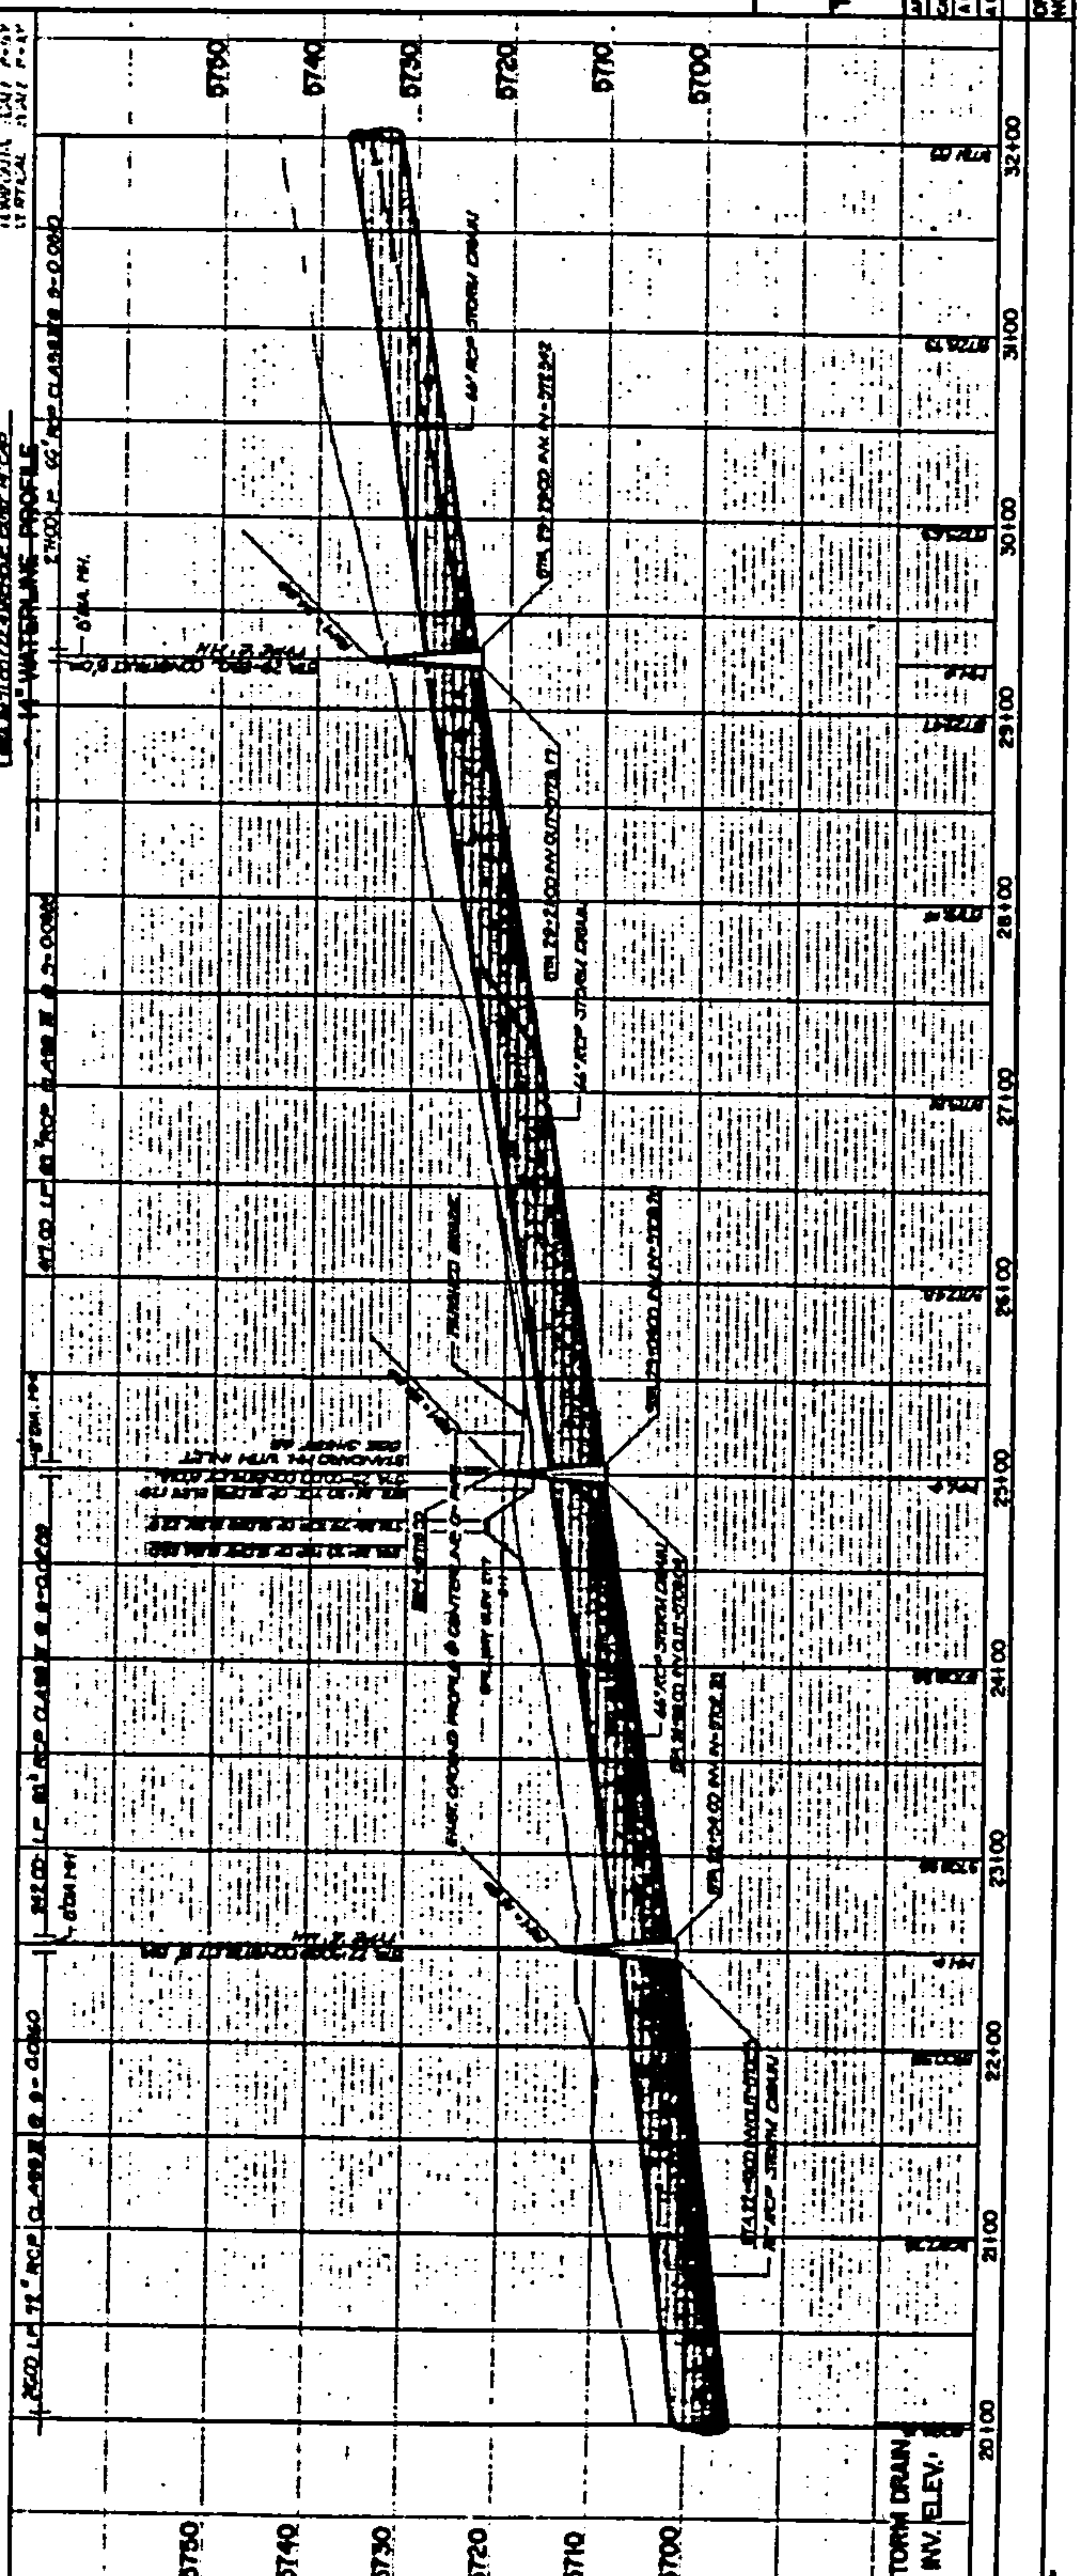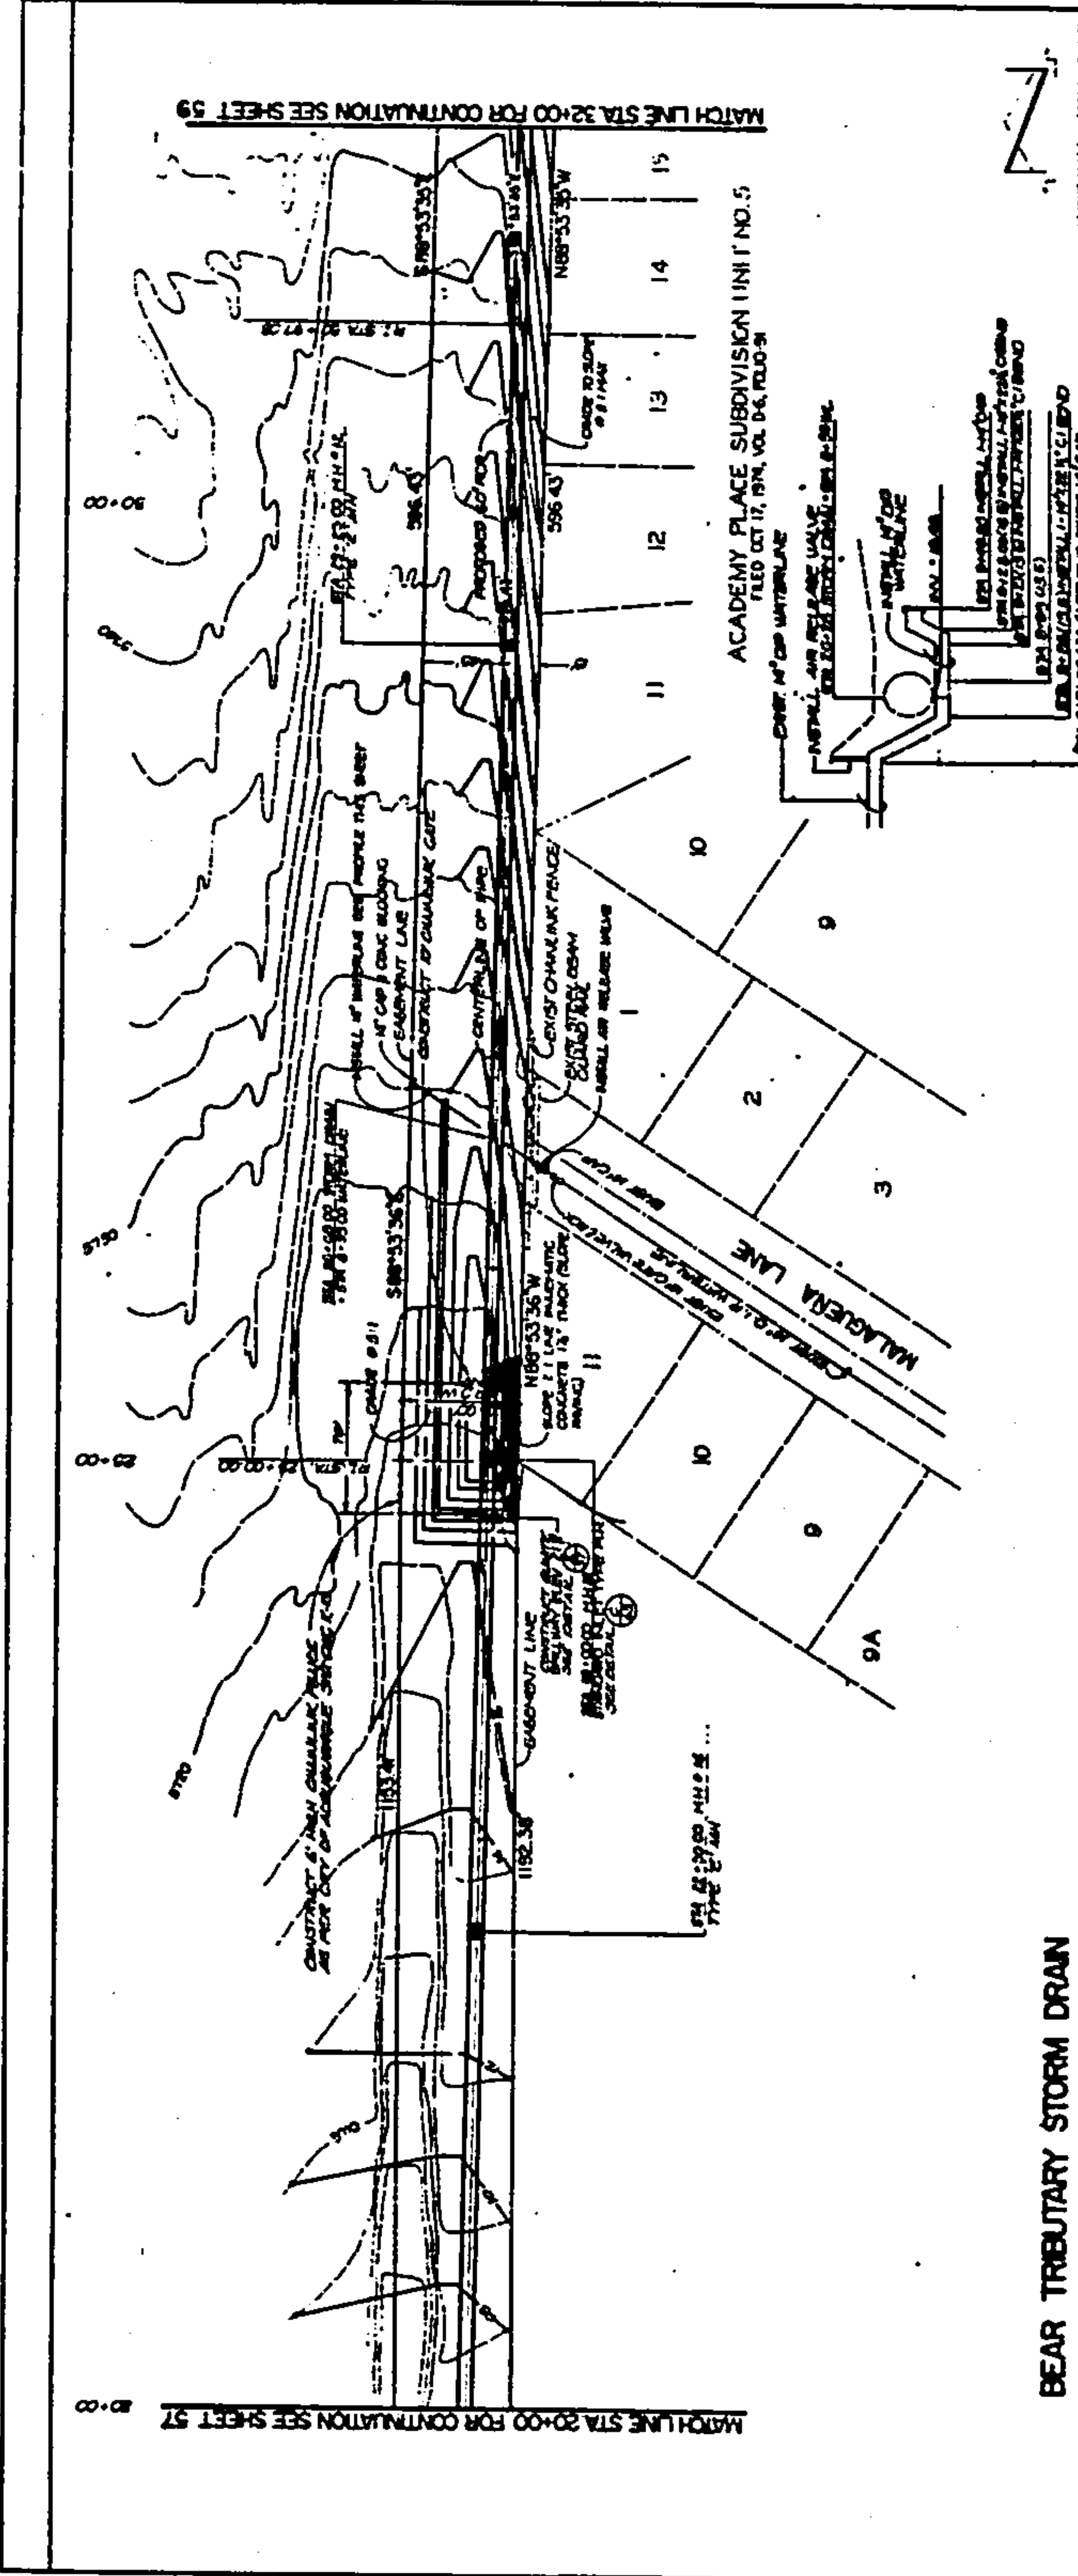

ENGINEER'S SEAL

FIELD NOTES

A D CUT ON TOP OF THE CONCRETE CURB LOCATED ON THE NMC CLASS RETURN AT THE INTERSECTION OF CANYONHEADS AND COMAHOE CT. IN THE NORTHEAST QUADRANT OF THE INTERSECTION (A.B.)

BM # 19 - 122)

ELEVATION = 9797.30

AS BUILT INFORMATION

NO. BY DATE

REMARKS


NO. DATE

CITY OF ALBUQUERQUE
MUNICIPAL DEVELOPMENT DEPARTMENT
ENGINEERING DIVISION

TITLE:
BEAR CANYON TRIBUTARY
STORM DRAIN PLAN & PROFILE

DATE: 11/10/09
ENGINEER: [Signature]
CHECKED: [Signature]
APPROVALS: [Signature]
DATE: 11/10/09
PROJECT NO.: 31100 TO STA 4110

DRAWING NO. 1721 MAP NO. SHEET 59 OF 87

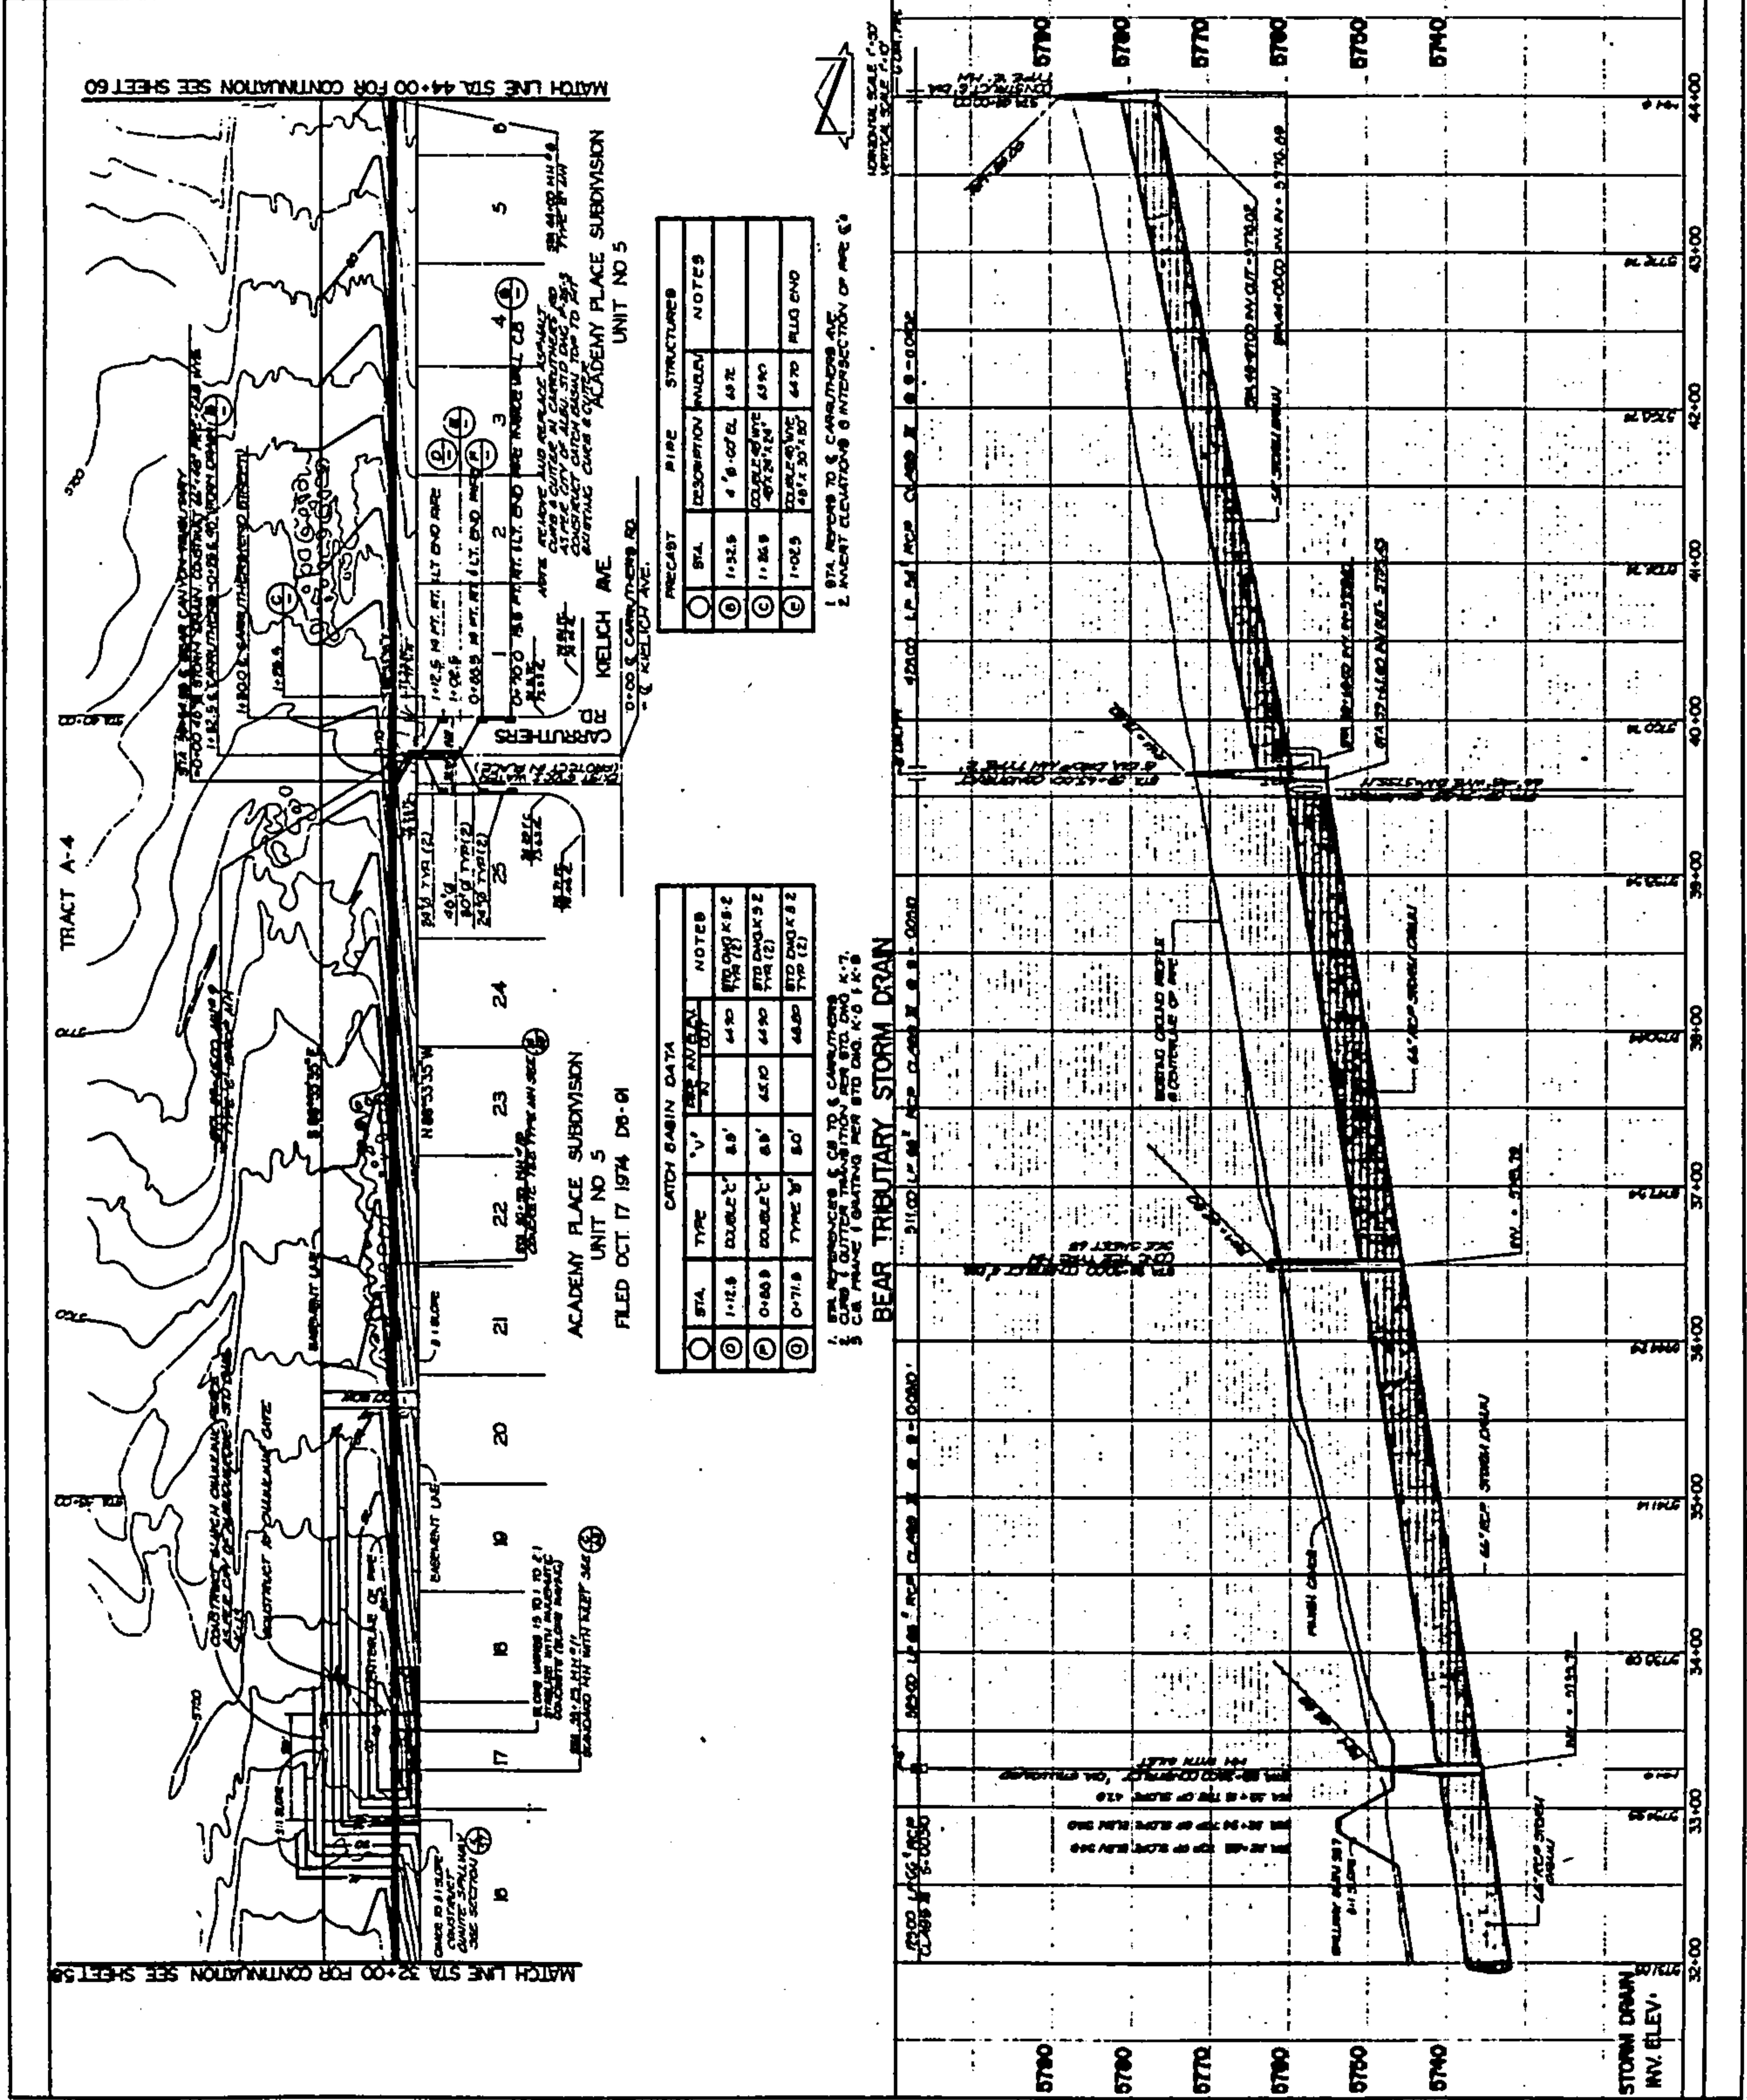

ACADEMY PLACE SUBDIVISION UNIT NO 5

BEAR TRIBUTARY STORM DRAIN

UNIT NO 5

FILED OCT 17 1974 DS-01

MELICH AVE

STORM DRAIN INV. ELEV.

32+00 33+00 34+00 35+00 36+00 37+00 38+00 39+00 40+00 41+00 42+00 43+00 44+00

5740 5750 5760 5770 5780 5790

VERTICAL SCALE 1" = 10'

HORIZONTAL SCALE 1" = 40'



1. STA. APPROX TO S. CURBLINE AS SHOWN

2. INVERT ELEVATIONS @ INTERSECTION OF MPE & MELICH AVE.



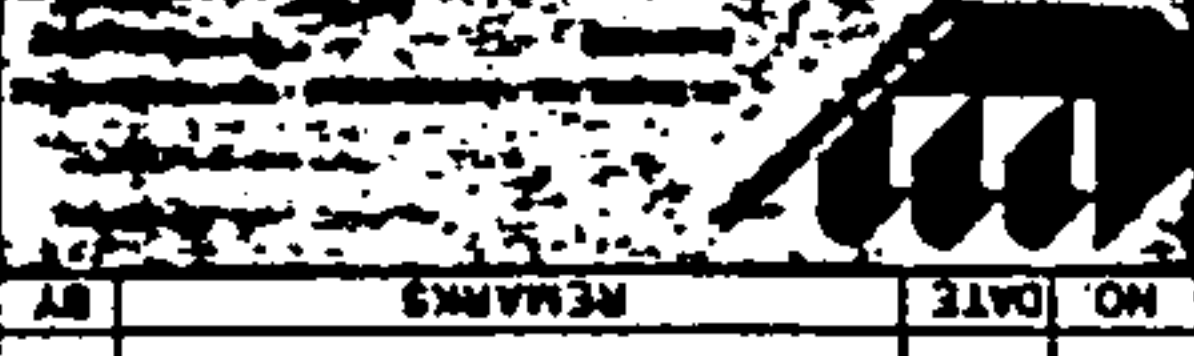








			
ENGINEER'S SEAL SURVEY INFORMATION BENCH MARKS A POINT ON TOP OF THE CONCRETE CURB LOCATED ON THE NINE CURB RETURN AT THE INTERSECTION OF CARLHERRS RD. AND DONAHOO CR. IN THE NORTHEAST QUADRANT OF THE INTERSECTION (A.B. S.N. 19-P22) ELEVATION = 5797.30 RECORDED BY DATE		NO. DATE BY REMARKS	
FIELD NOTES DATE BY		APPROVALS ENGINEER DATE CITY ENGINEER DATE P.C.E. DATE A.C.E. DATE	
AS BUILT INFORMATION SERIAL TITLE 1. All rep shall be A.S.T.M. Class M. 2. All rebar shall be placed in quantity of 5% of volume (modified A.S.T.M. 91337).		CITY OF ALBUQUERQUE MUNICIPAL DEVELOPMENT DEPARTMENT ENGINEERING DIVISION TITLE: BEAR CANYON TRIBUTARY STORM DRAIN PLAN & PROFILE STA 44+00 TO STA 54+75	
DRAWING NO. 1721		SHEET NO. 60 OF 87	

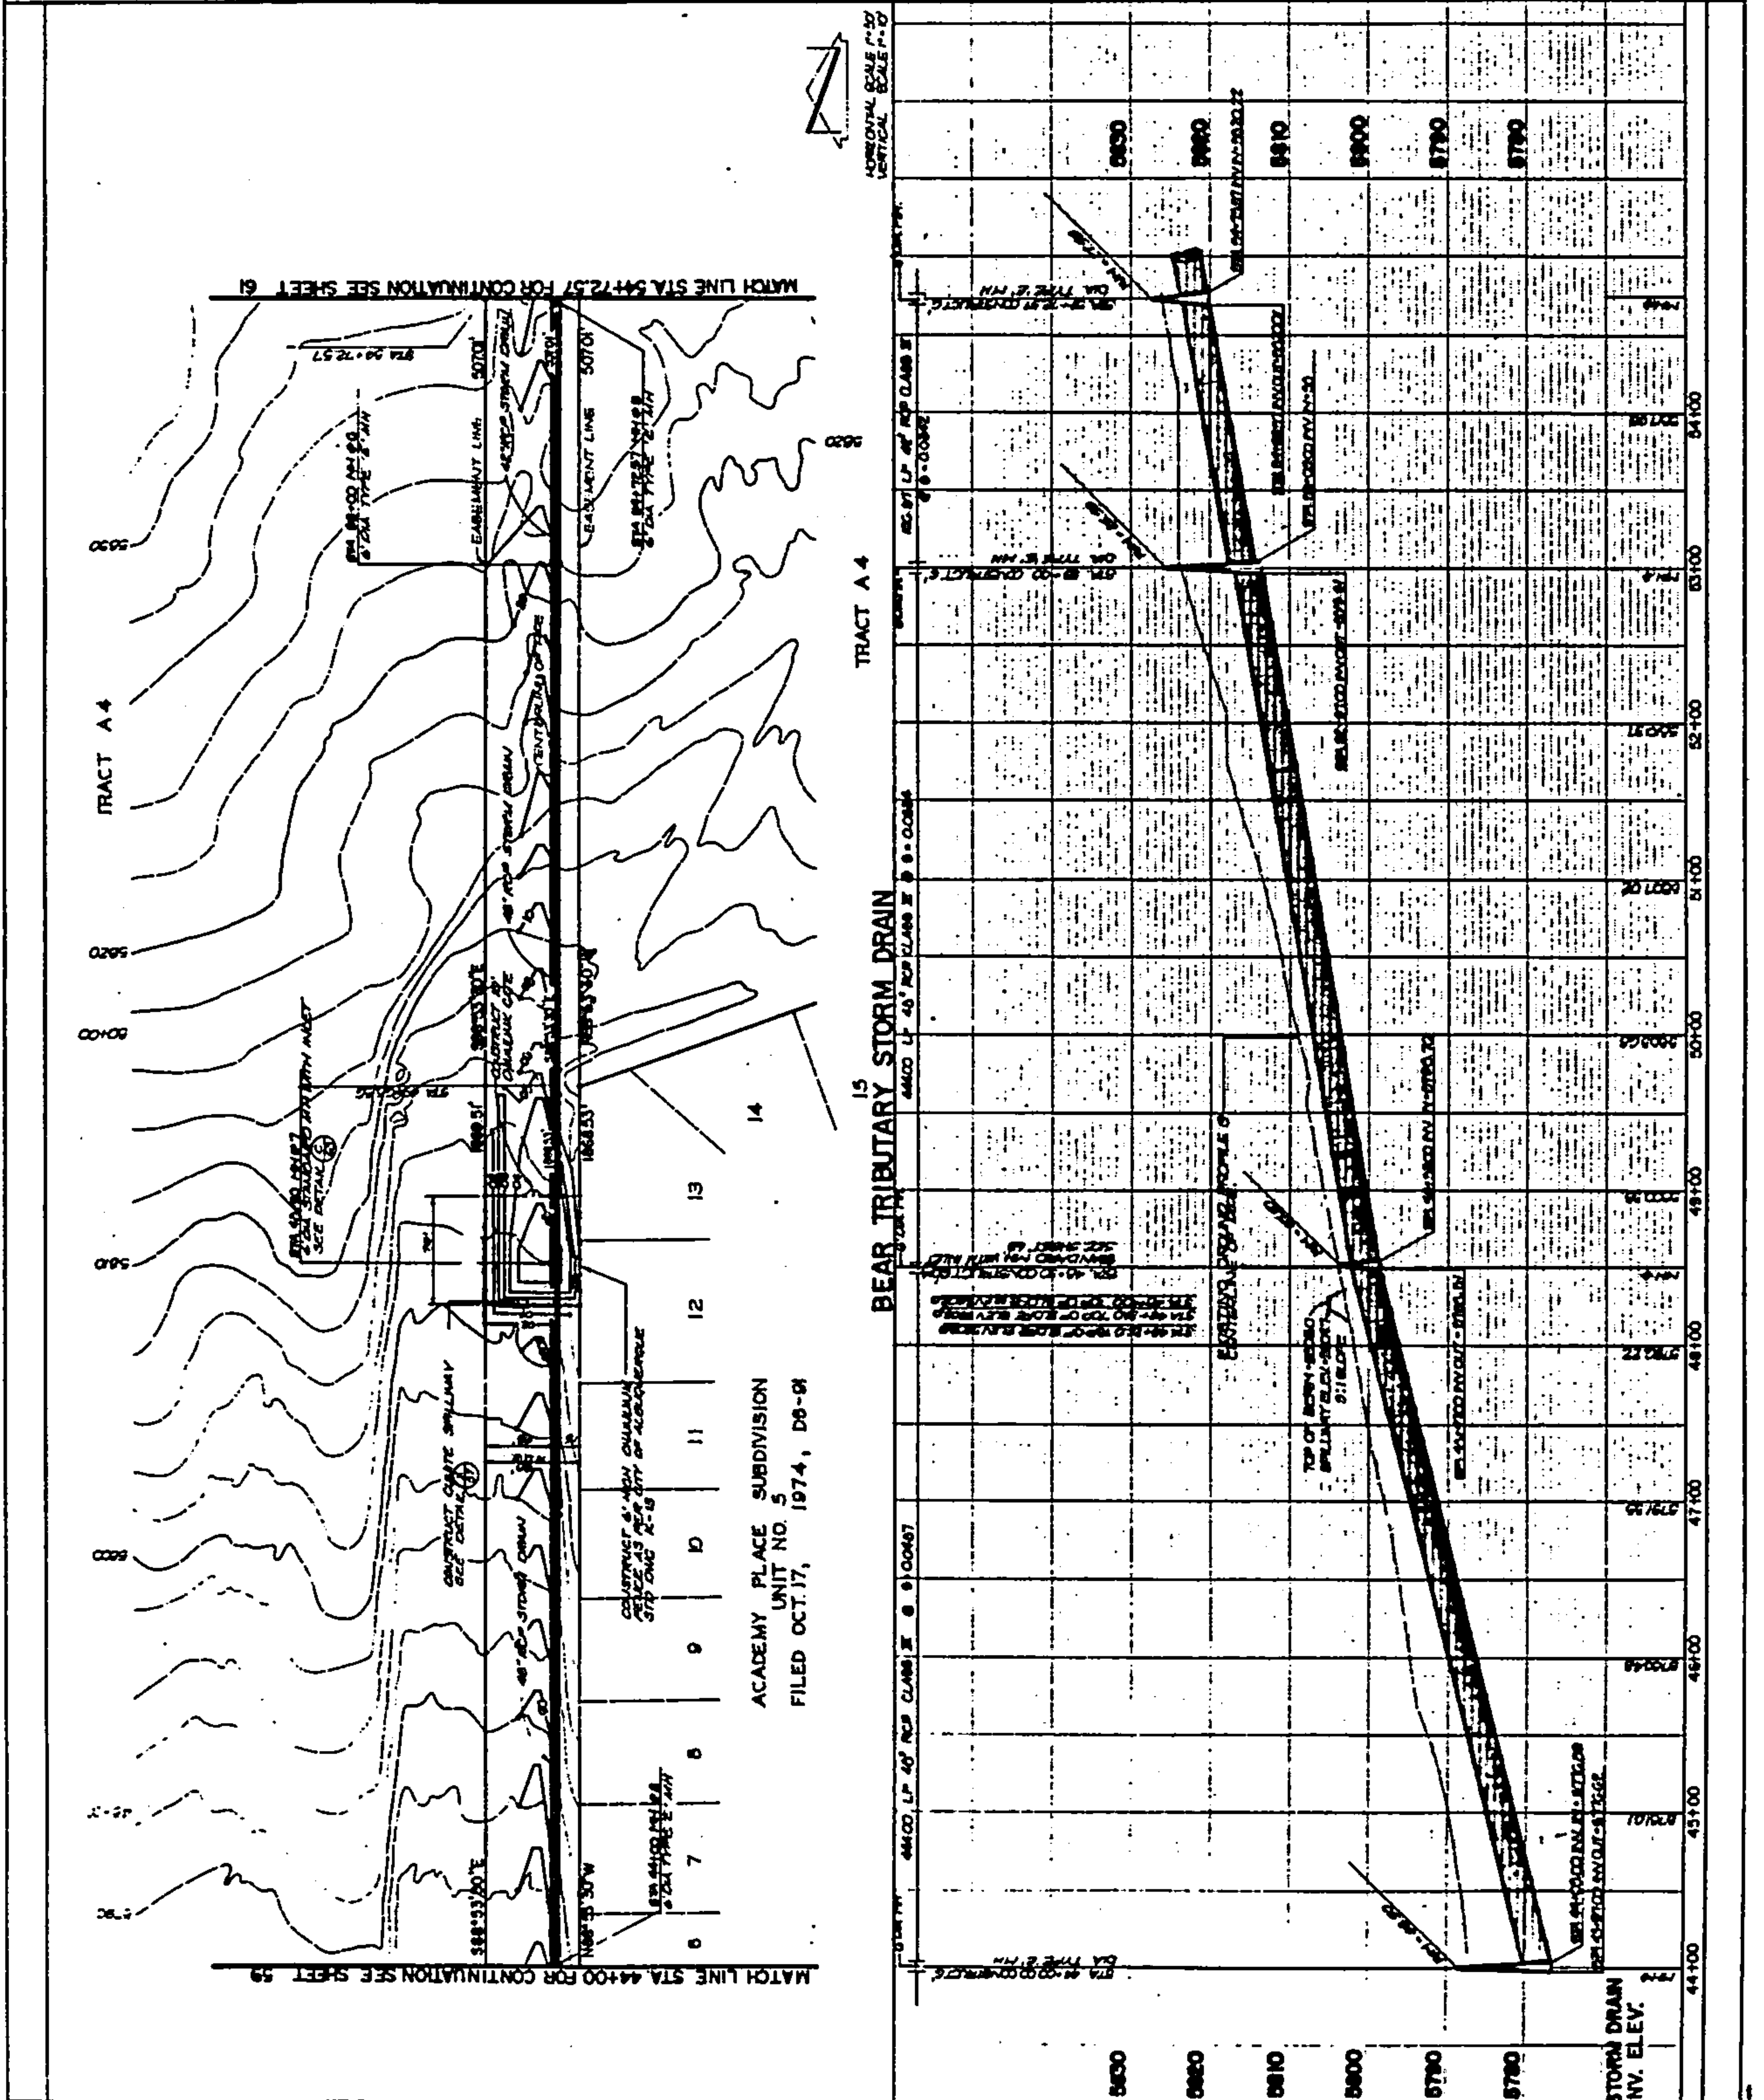



A3-10

ENGINEER'S SEAL		NO. DATE		REMARKS	
					
SWMPT INFORMATION FIELD NOTES DATE BY A 3' CUT ON TOP OF THE CONCRETE BENCH MARKS AS BUILT INFORMATION		NO. DATE BY		REMARKS	
RECEIVED BY ELEVATION - 87.7, 80 G.M. 13 - #22 QUADRANT OF THE INTERSECTION (A.B.) AND DONOR CT IN THE NORTH EAST AT THE INTERSECTION OF CARROLL RD QUADRANT OF THE INTERSECTION (A.B.) DATE BY					
SERIALS 1. All work shall be A.S.T.M. Class M. 2. All trench (fill) shall be compacted to 95% minimum density by the contractor (modified) A.S.T.M. #1557.		CITY OF ALBUQUERQUE MUNICIPAL DEVELOPMENT DEPARTMENT ENGINEERING DIVISION TITLE: BEAR CANYON TRIBUTARY STORM DRAIN PLAN & PROFILE STA 54+73 TO STA 66+00		APPROVALS ENGINEER DATE APPROVALS ENGINEER DATE City Engineer A.C.E. - Design A.C.E. - Hydrology	

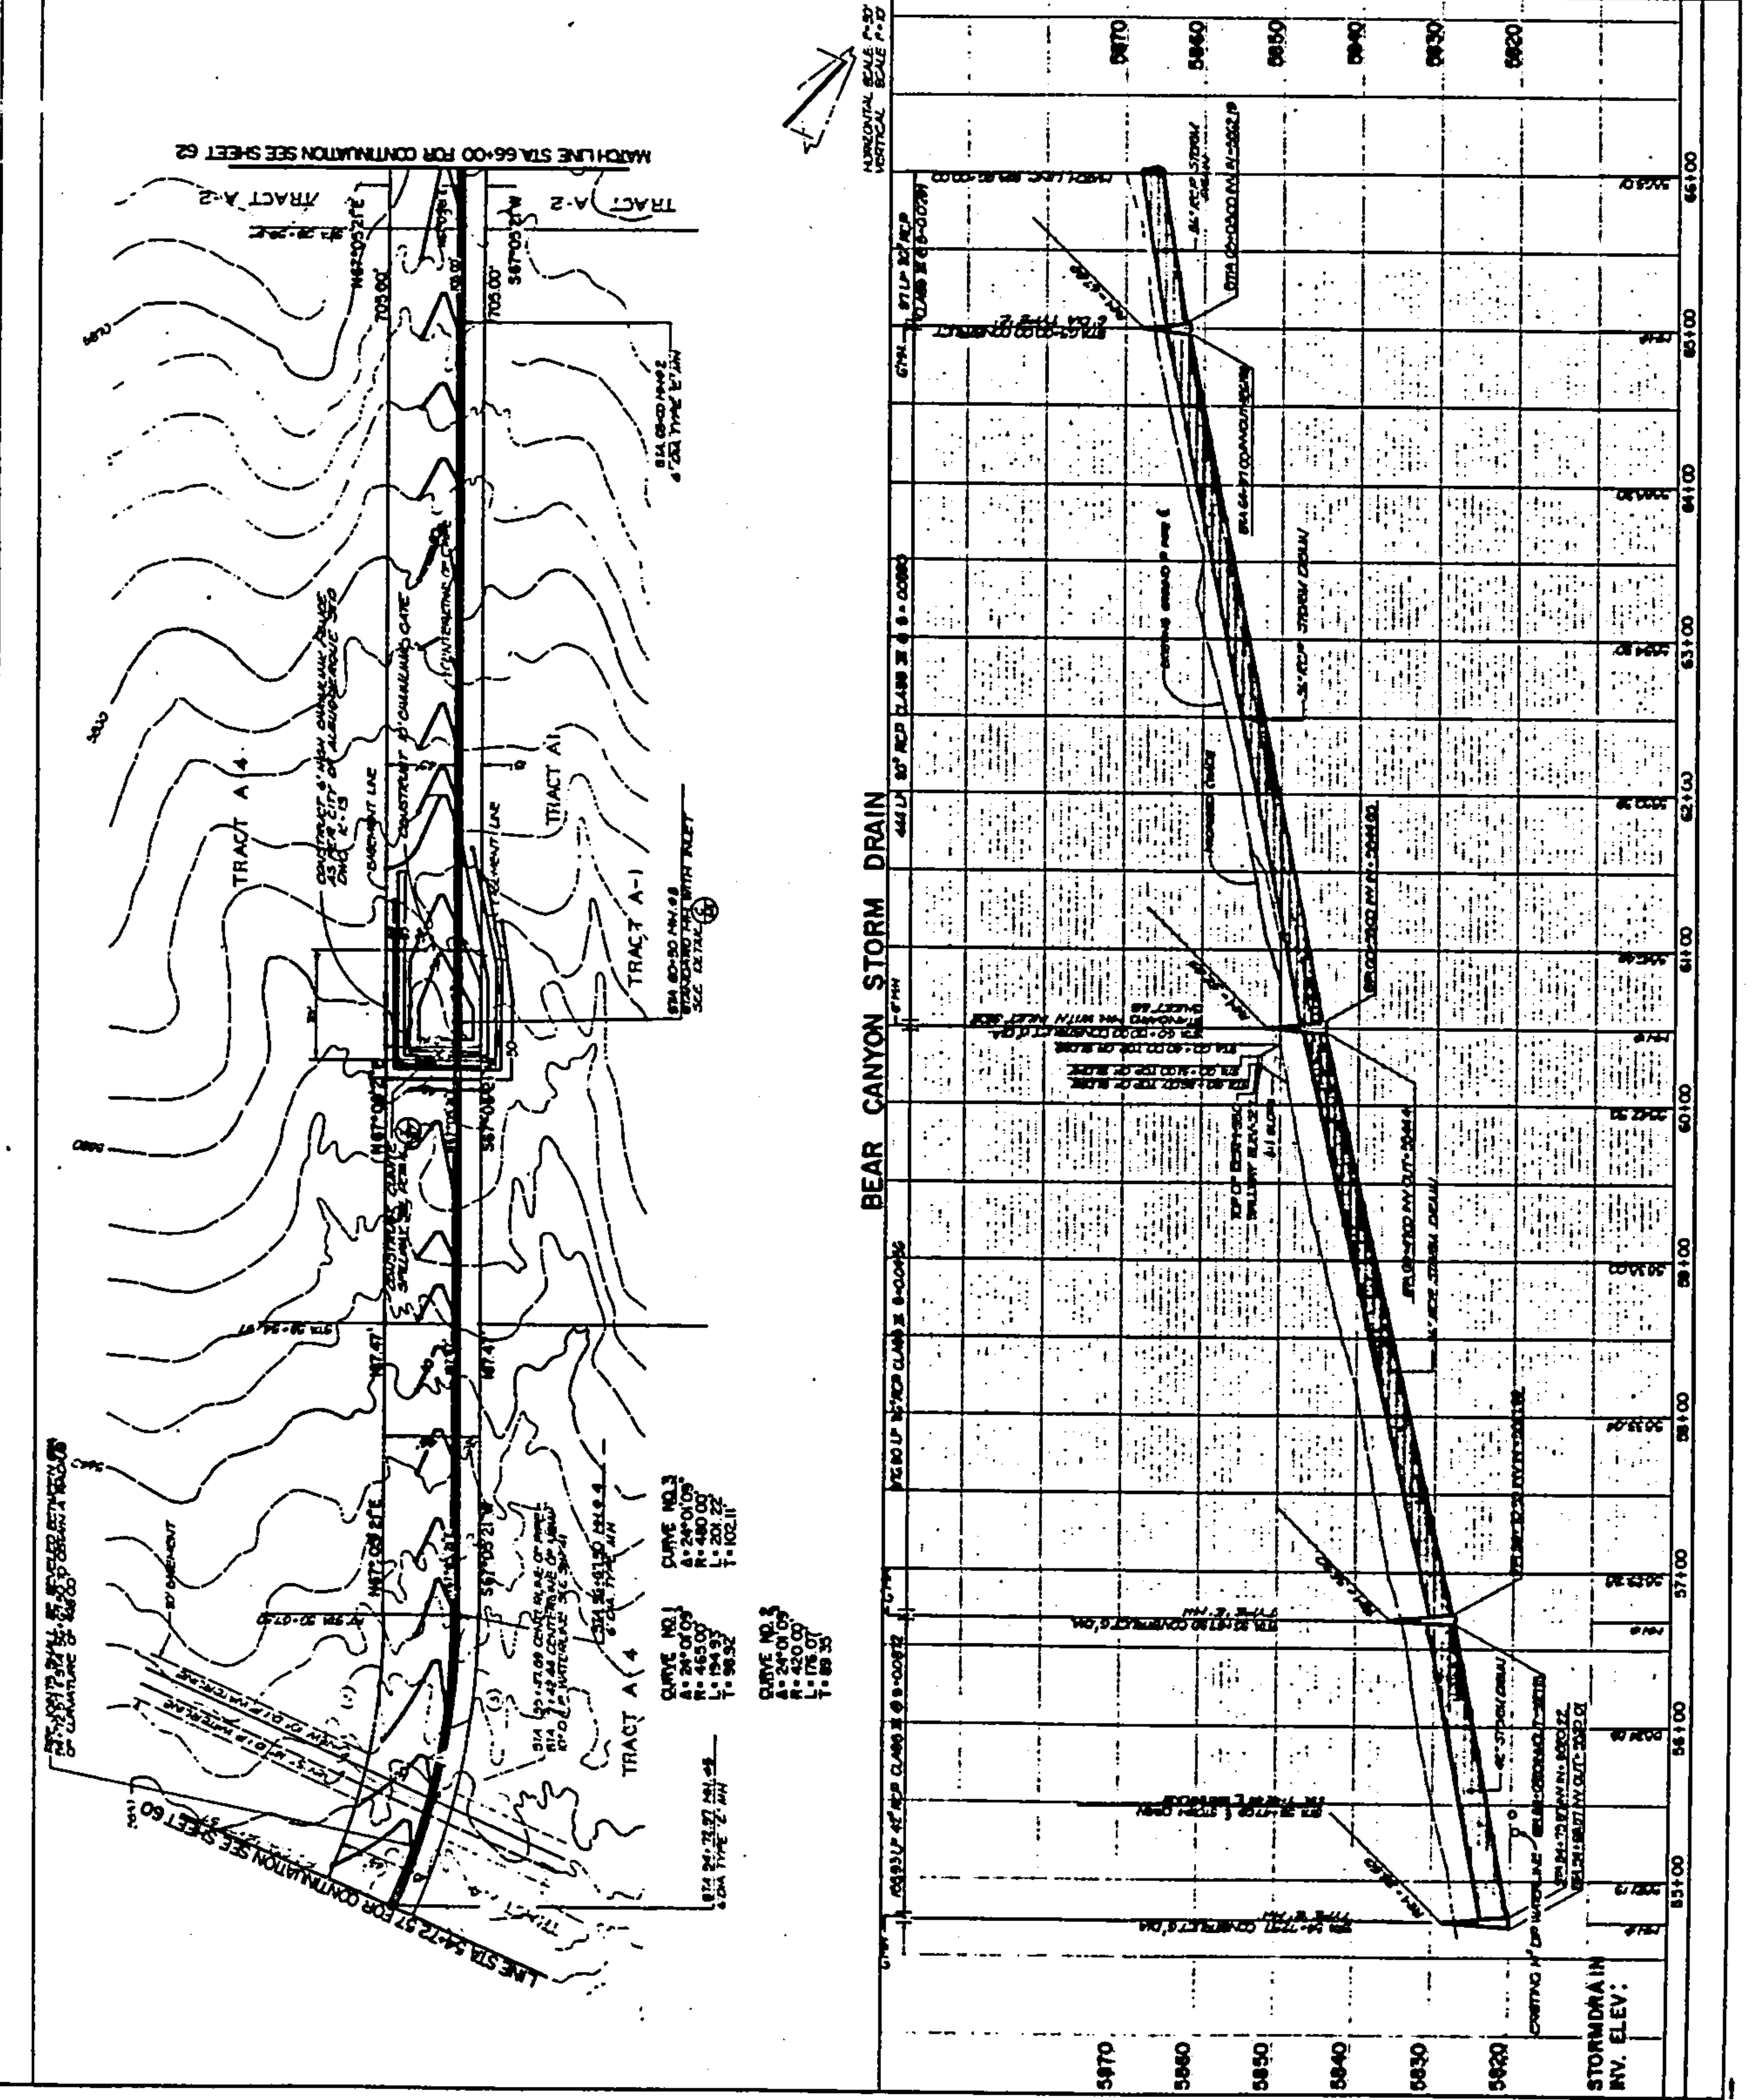DRAWING NO. 1721 MAP NO. SHEET 61 OF 87




A3-11

			
ENGINEER'S SEAL	NO.	DATE	REMARKS
DATE	BY		
FIELD NOTES			
AS BUILT INFORMATION			

SURVEY INFORMATION
 BENCH MARKS
 A CUT ON TOP OF THE CONCRETE CURB LOCATED ON THE NINE CURB RETURN AT THE INTERSECTION OF CARROLLTON EAST QUADRANT OF THE NORTH - (TAB. P.M. 13-122) ELEVATION = 5787.30

AS BUILT INFORMATION
 BENCH MARKS
 A CUT ON TOP OF THE CONCRETE CURB LOCATED ON THE NINE CURB RETURN AT THE INTERSECTION OF CARROLLTON EAST QUADRANT OF THE NORTH - (TAB. P.M. 13-122) ELEVATION = 5787.30


GENERAL RULES
 1. All S.P. shall be A.S.T.M. Class M.
 2. All rough fall shall be reported to a minimum quality of 92% of official (modified) A.S.T.M. R157.

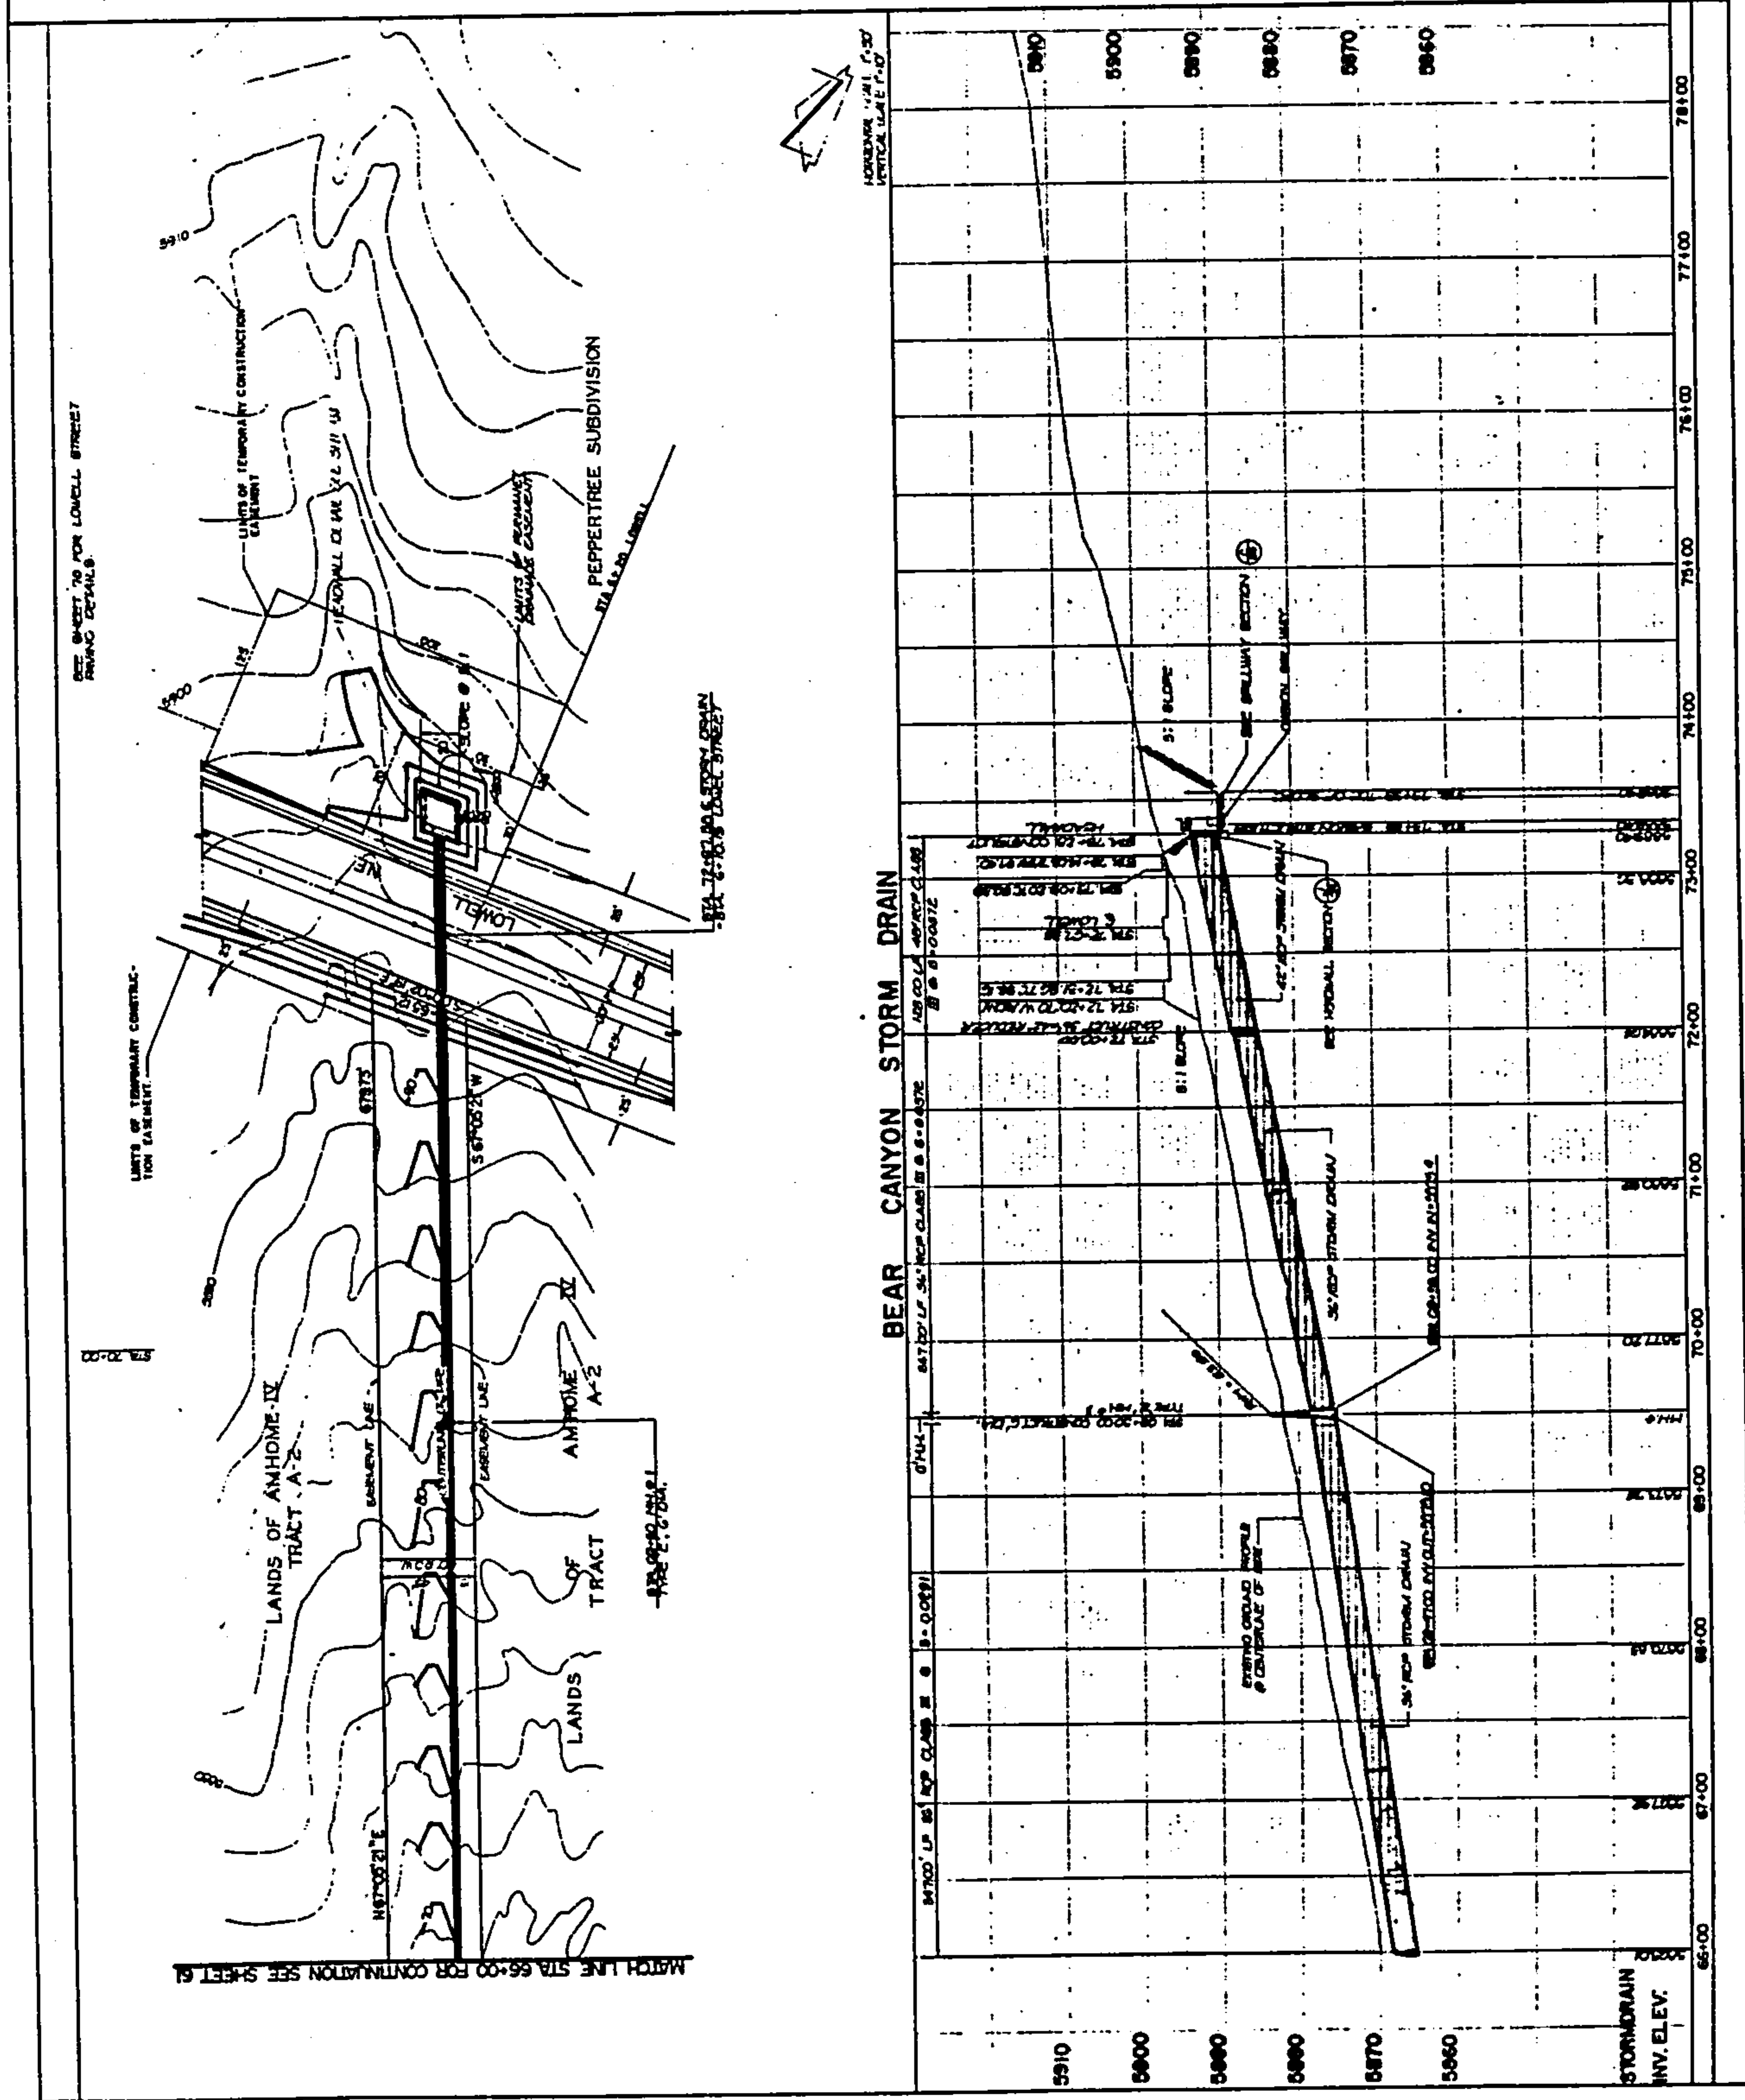


STATIONING	66+00	67+00	68+00	69+00	70+00	71+00	72+00	73+00	74+00	75+00	76+00	77+00	78+00

ACADEMY RIDGE LATERAL -


HYDRAULIC GRADE LINE ELEVATIONS AT THE BEAR TRIB PIPELINE WERE OBTAINED FROM THE PIPELINE ANALYSIS PERFORMED FOR SAD-205, AND REPRESENT THE WORST POSSIBLE CASE.

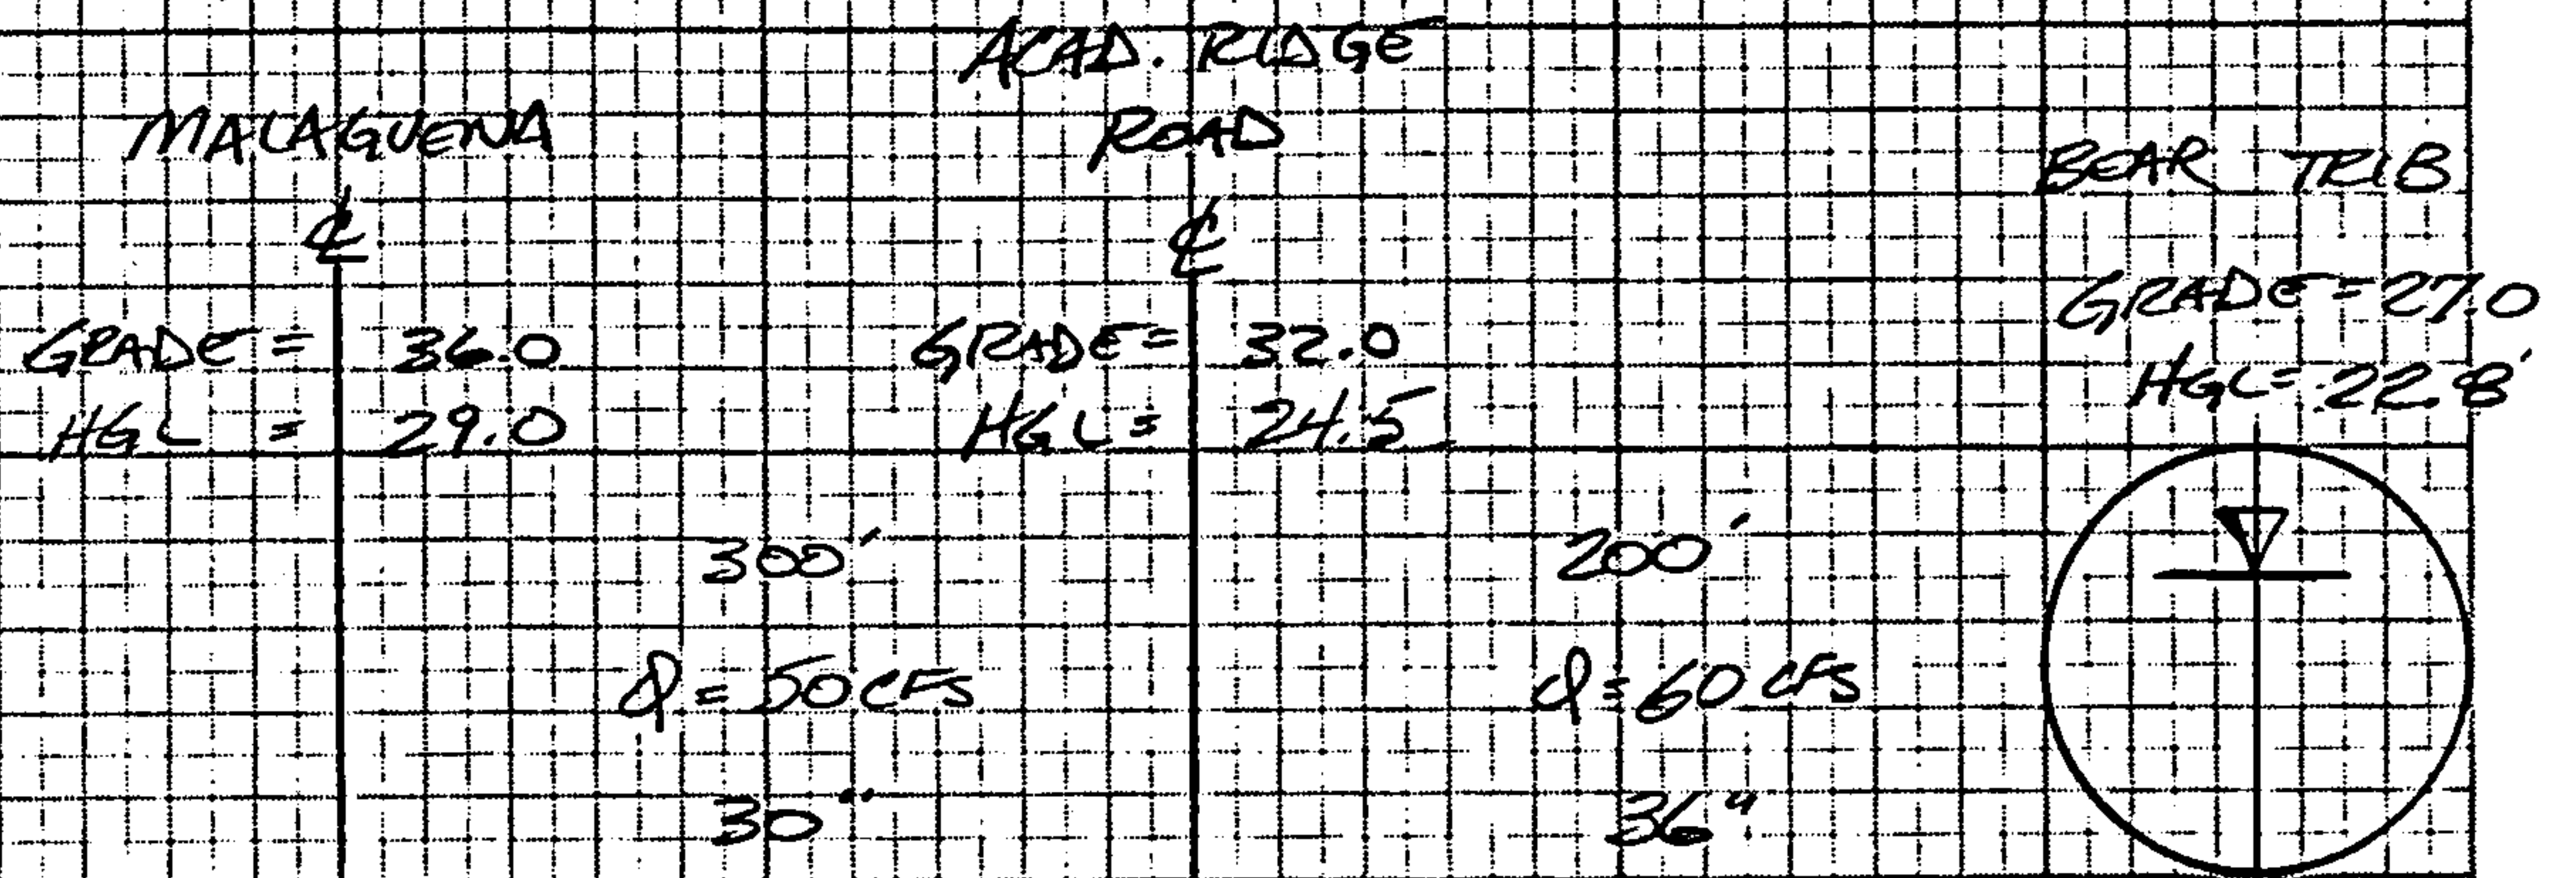



CARRUTHERS LATERAL

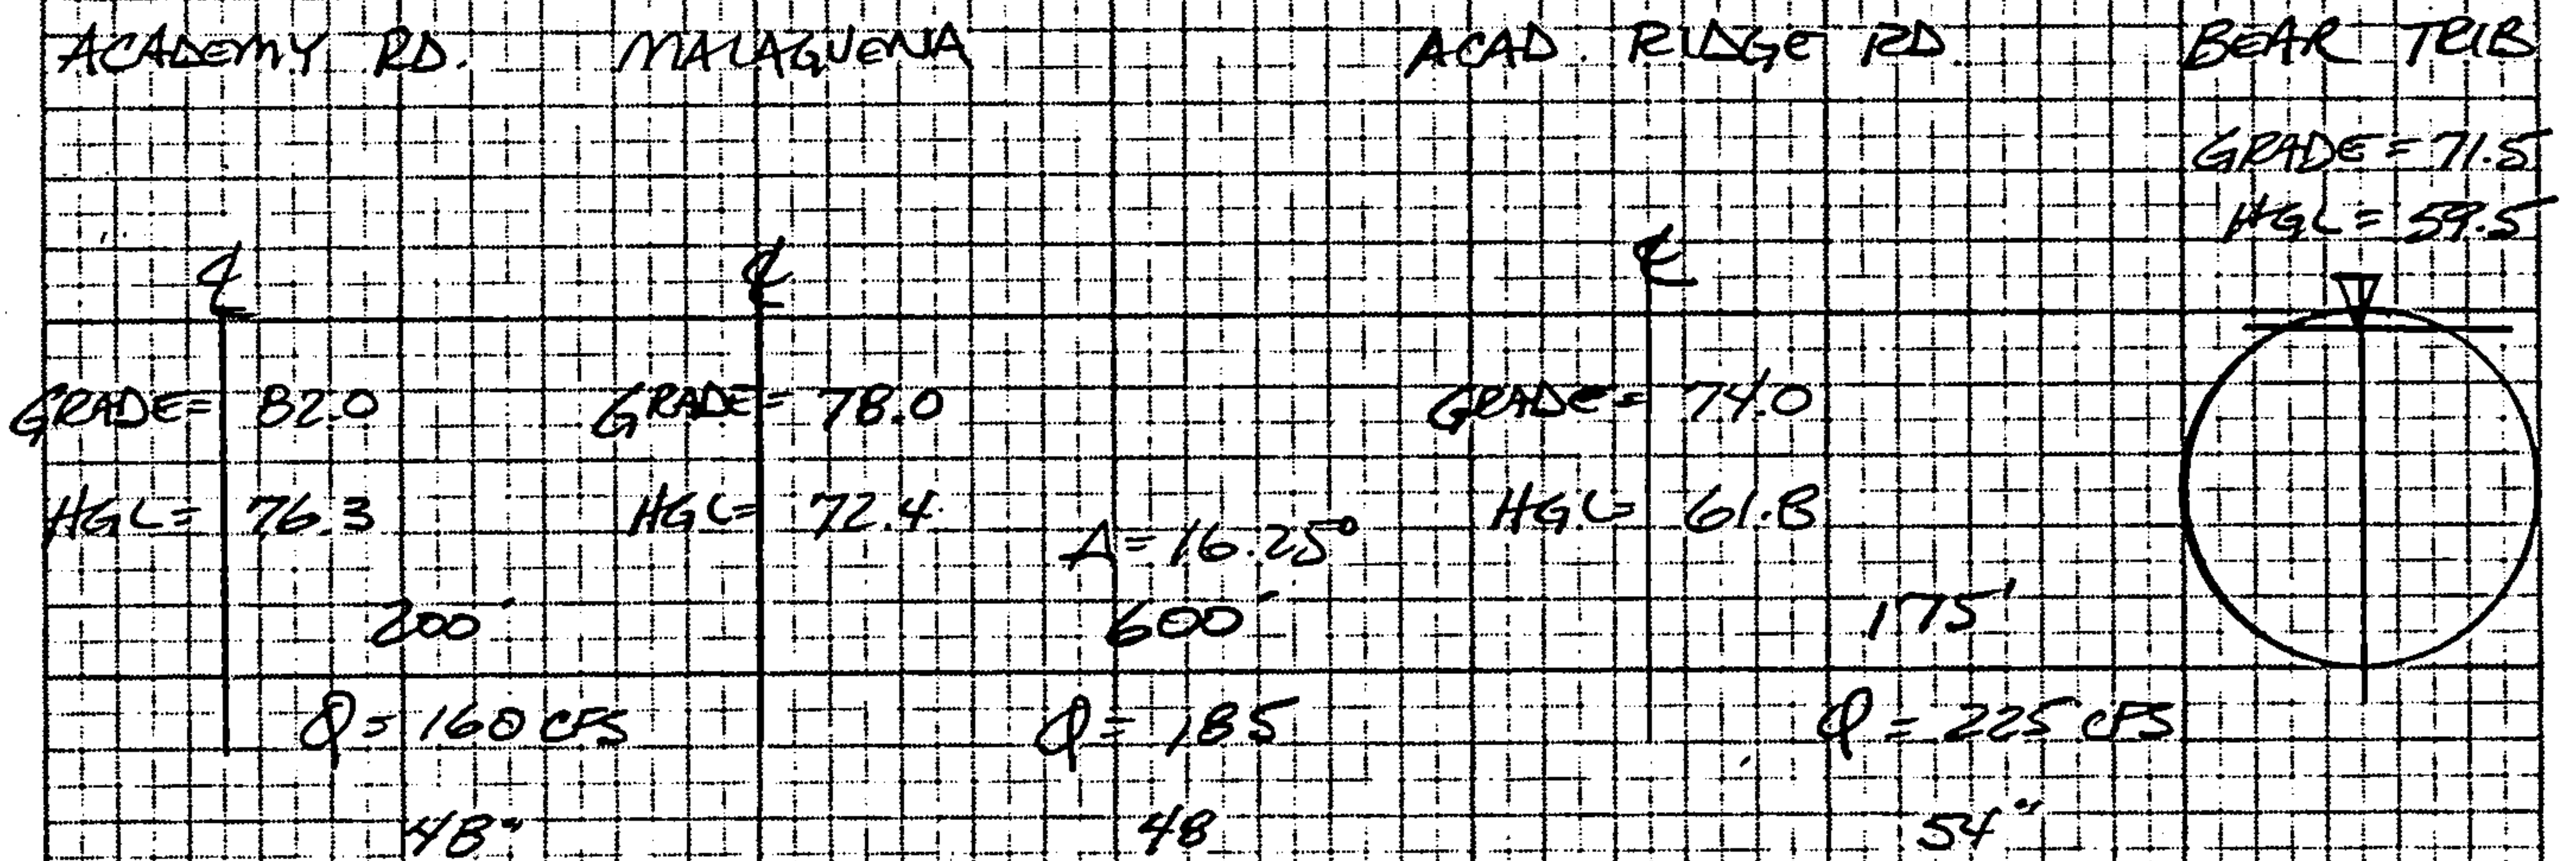

MALAGUENA LATERAL

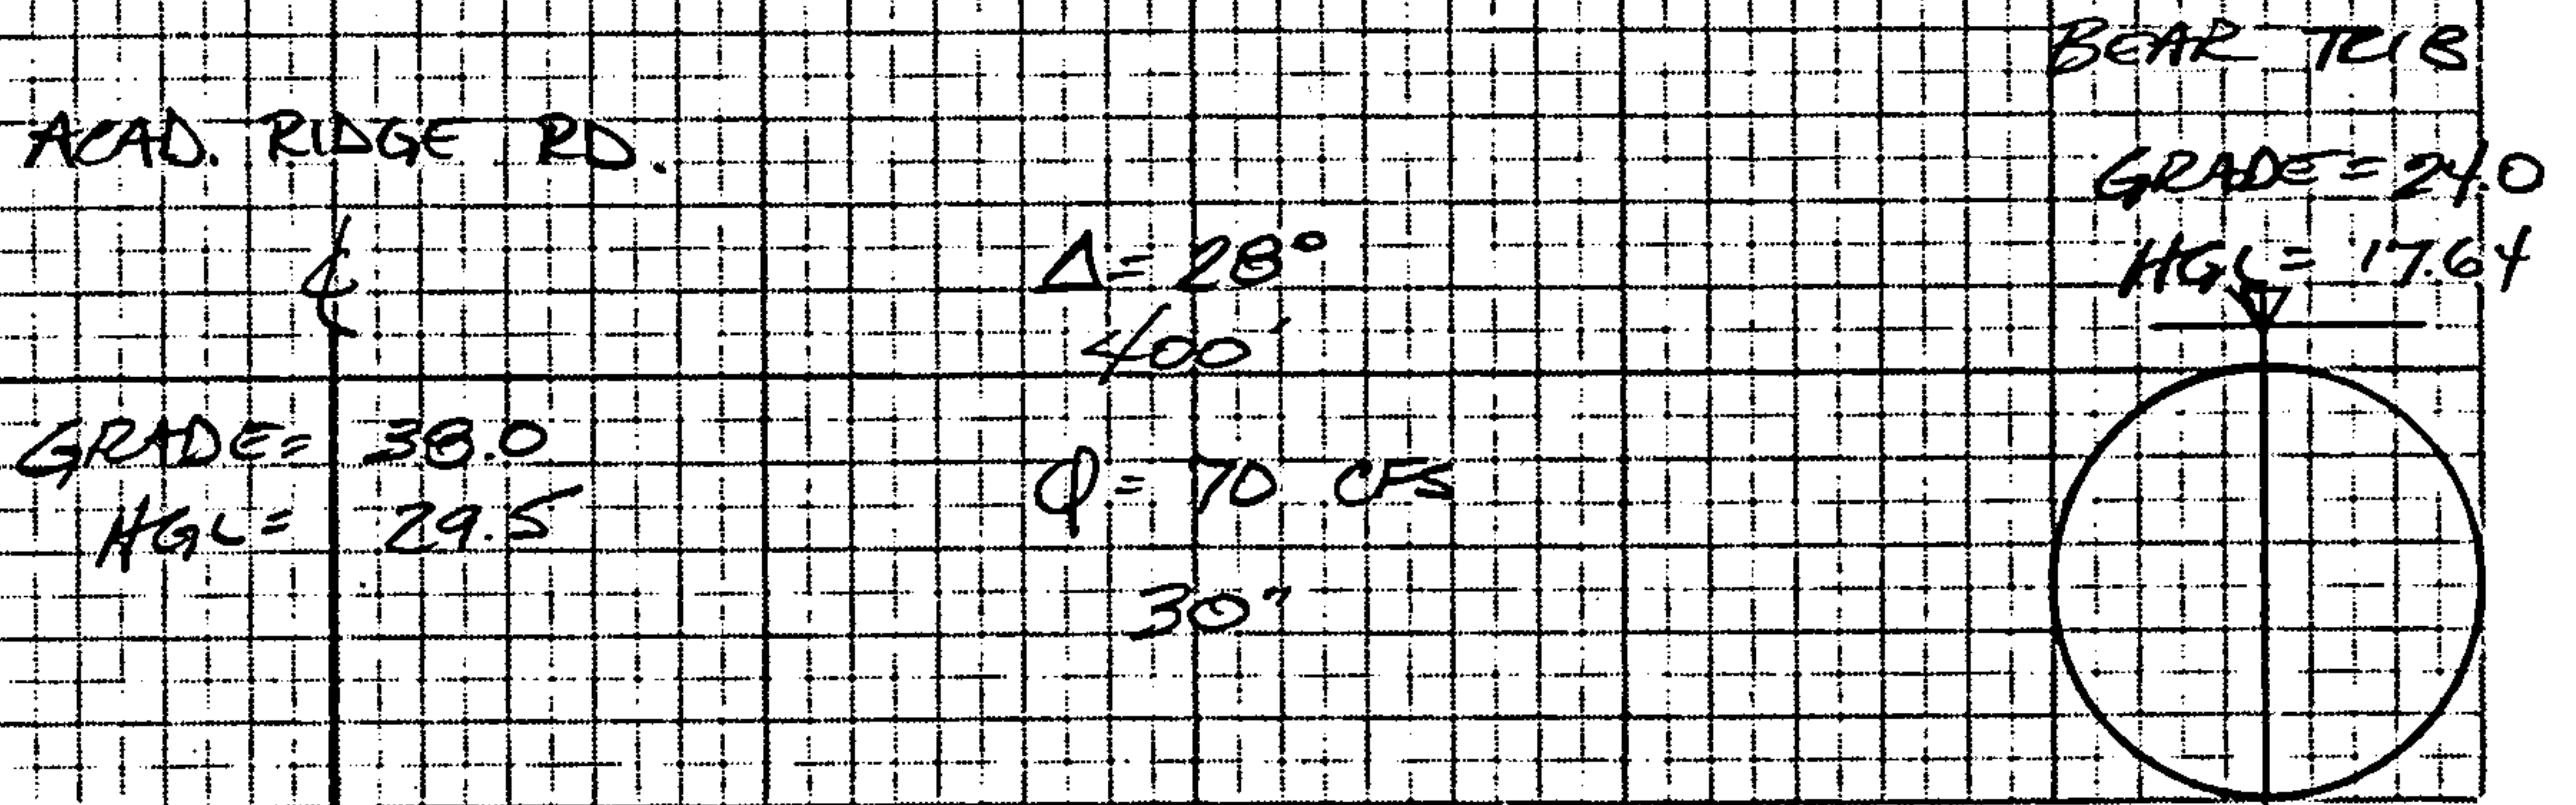

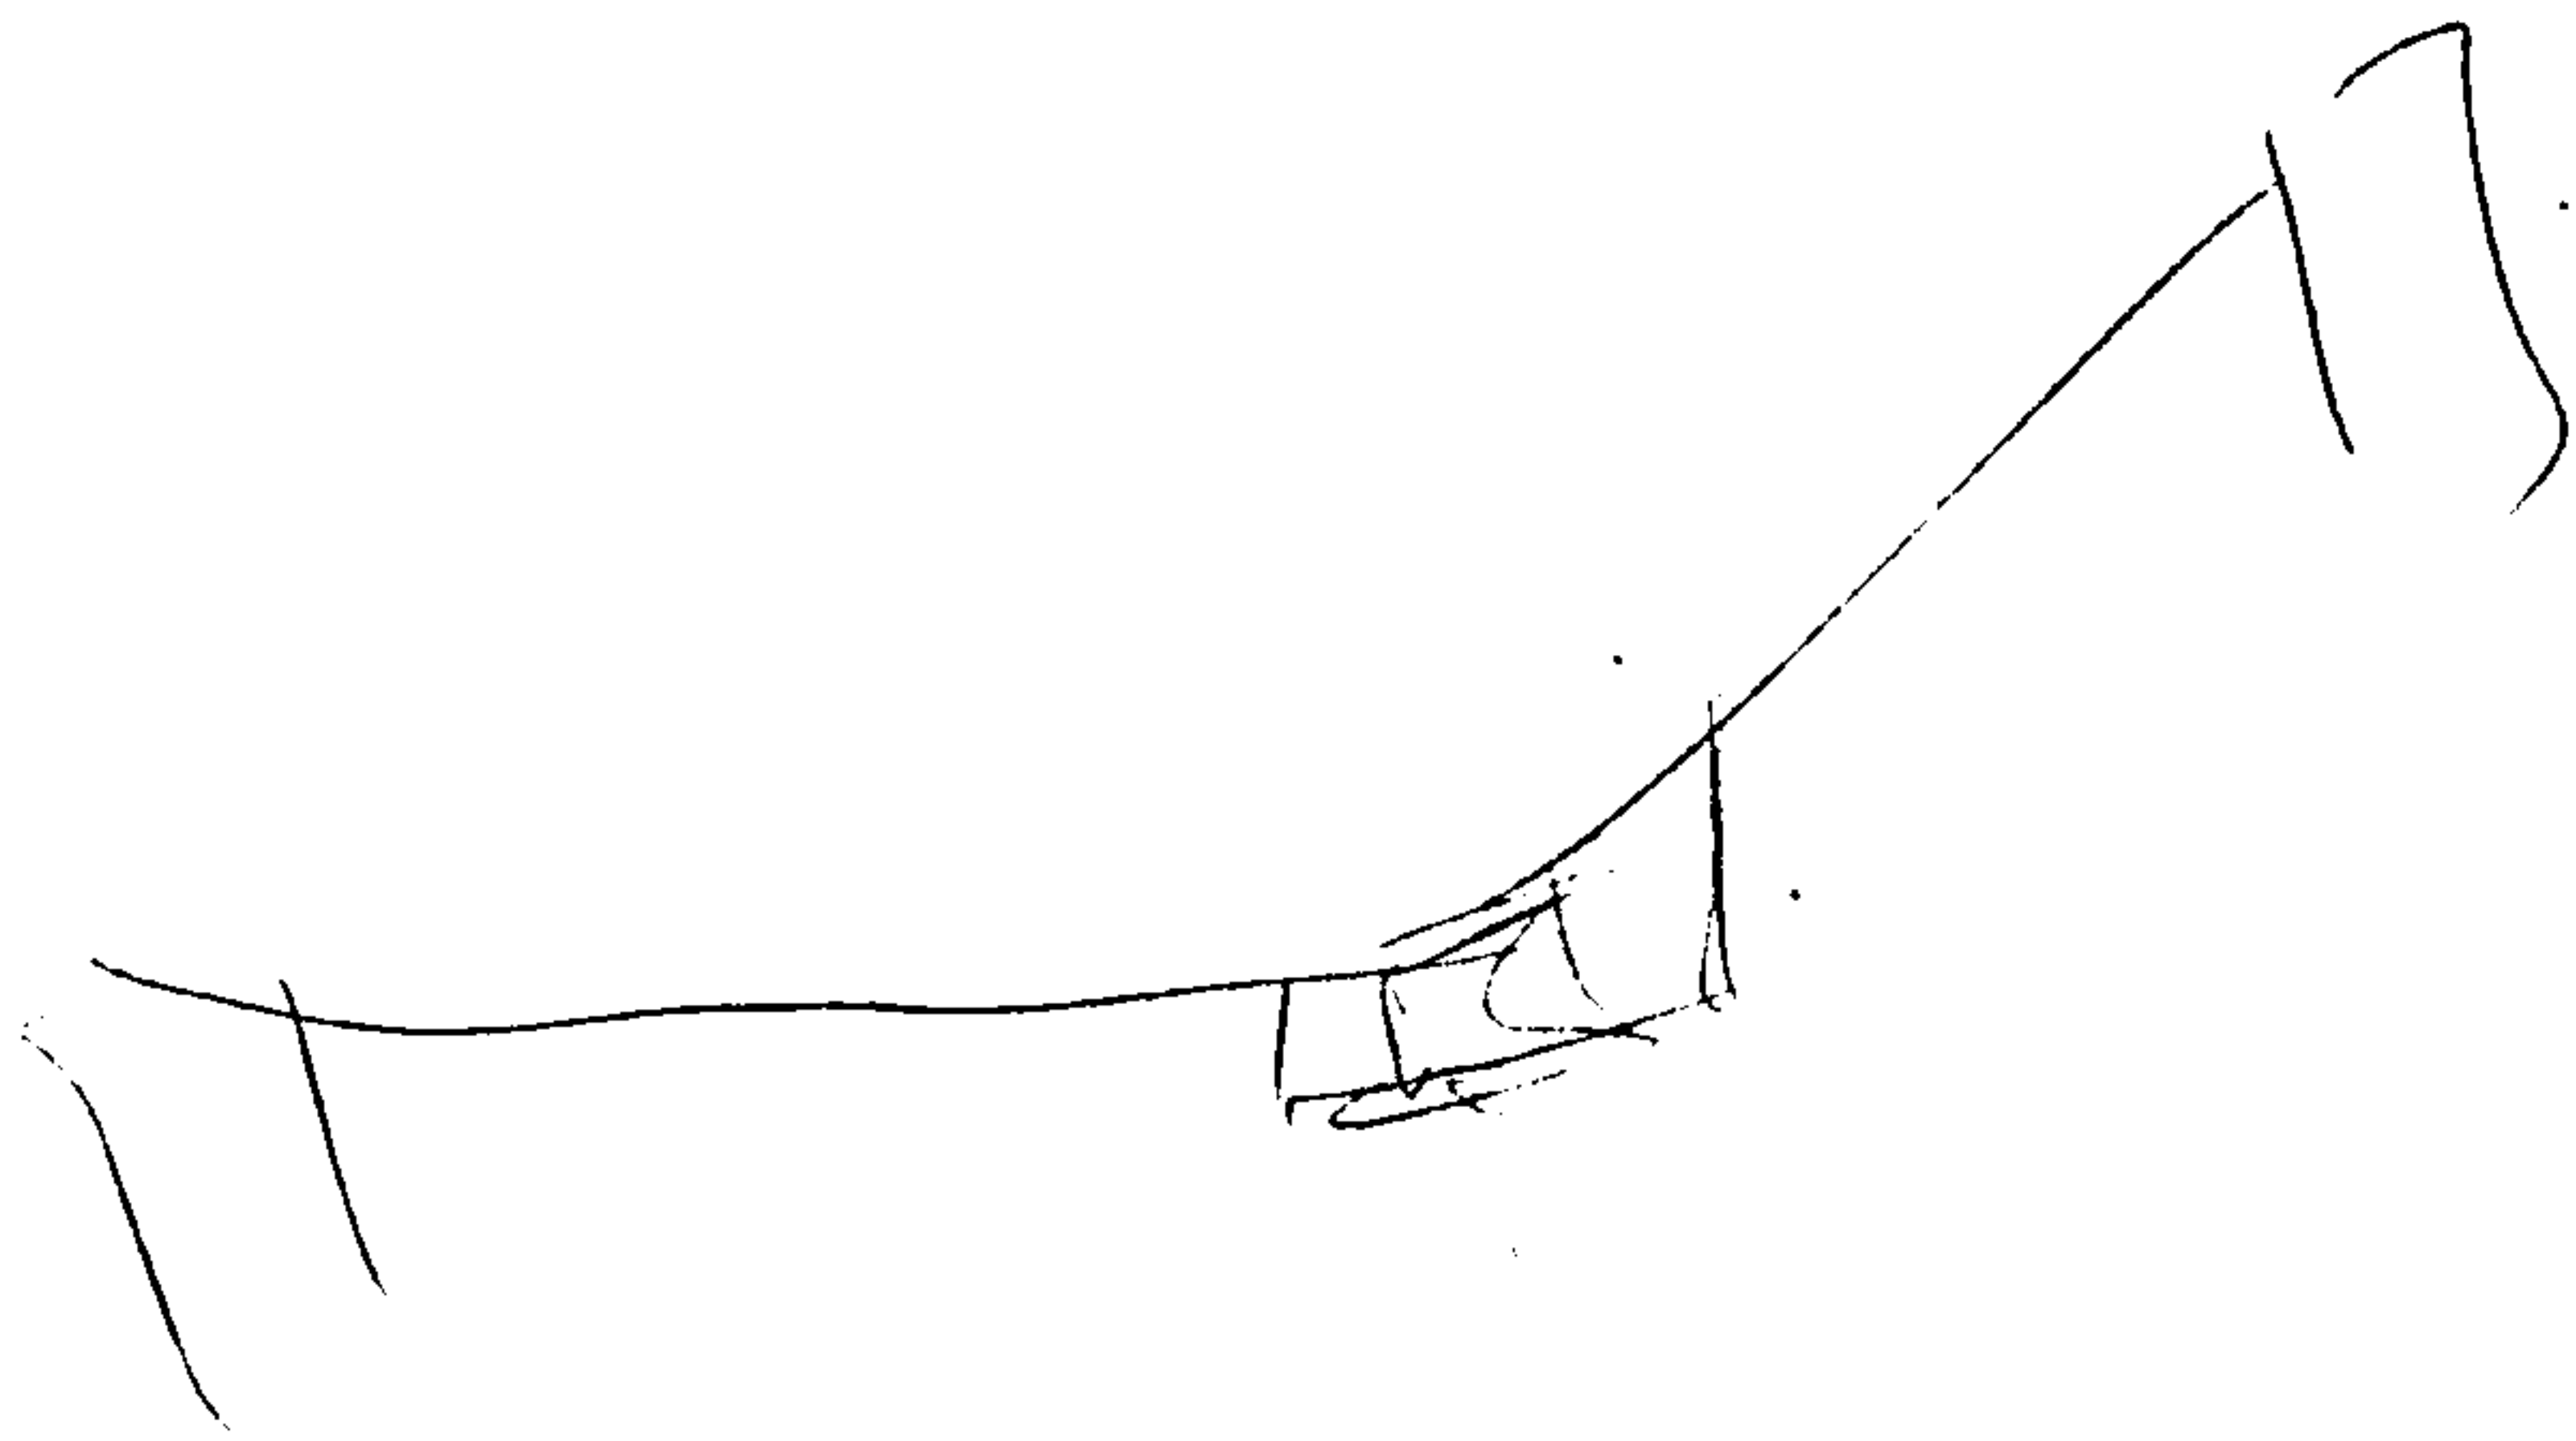

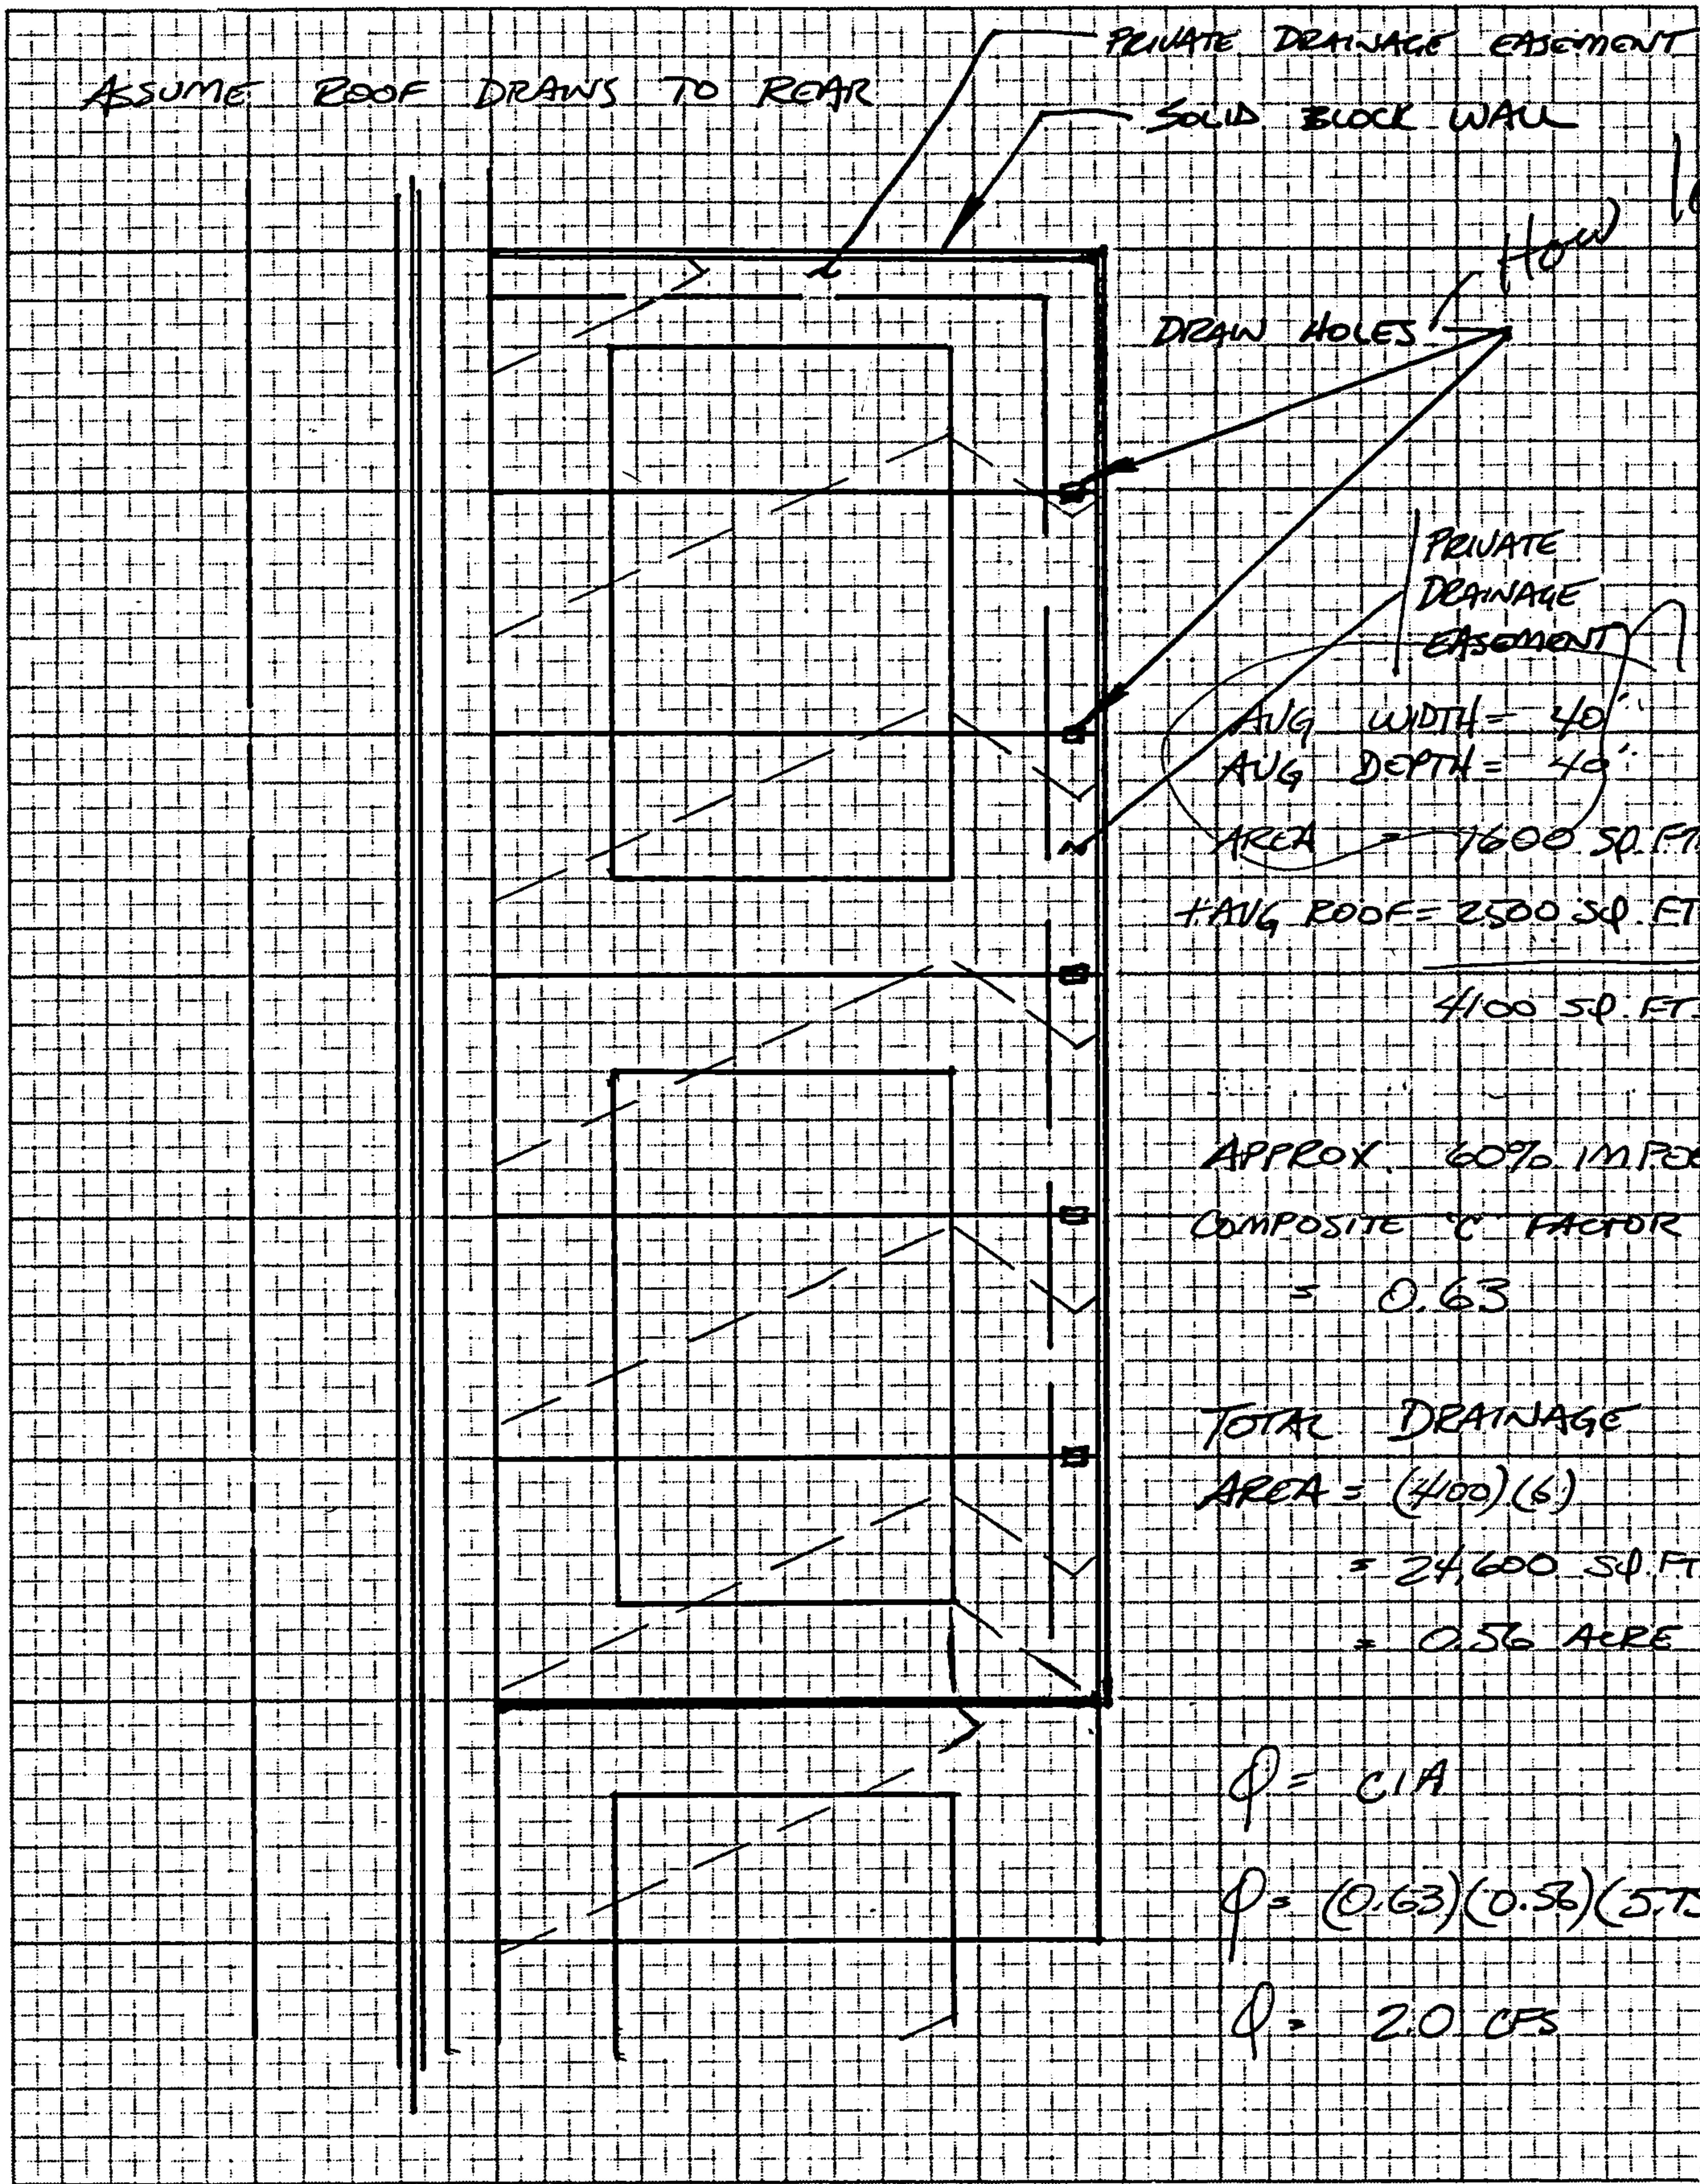

PROJECT NAME ACADEMY RIDGE EAST

SHEET _____

OF A4-3

PROJECT NO. 41441

BY KLD

DATE 7/10/84

SUBJECT TYPICAL GRADING SCHEME

CH'D _____

DATE _____

INTERSECTION - MALAGUENA GANG AND ACADEMY RIDGE ROAD

PEAK FLOW BASIN A-7

$$Q_p = 70.2 \text{ cfs}$$

ALLOW FLOWS TO DRAIN SOUTH IN ACADEMY ROAD

INTERSECTION - MALAGUENA GANG AND BEAR TRIS.

COMBINED PEAK FLOWS BASIN A-7 AND BASIN A-10

$$Q_p = 97.2 \text{ cfs}$$

→ PLACE 1-TYPE D INLET IN ALLEY GUTTER @ BEAR TRIS.

FLOW DEPTH IN ALLEY = 0.5' (SEE RATINGS CURVE)

$$Q_{\text{REMOVED}} = 8 \text{ cfs (FROM DPM PLATE 22.3 D-6)}$$

$$Q_{\text{REMAINING}} = 24 \text{ cfs} - 8 = 16 \text{ cfs WILL OUTFALL TO MALAGUENA.}$$

SUMP CONDITION @ MALAGUENA AND THE BEAR TRIS

→ PLACE TWO DOUBLE C INLETS AT STA 0+70 MALAGUENA (STA)

ASSUME INLET CONTROLS ON CONNECTOR PIPES

WITH 6' OF HEAD AVAILABLE

$$\text{AVAILABLE CONDUIT DISCHARGE} = Q = CA\sqrt{2gh}$$

TOT 24" CONNECTOR PIPES

$$Q_{\text{REMOVED}} = (0.6)(3.14)\sqrt{2(32.2)(6)} = 37 \text{ cfs EACH SIDE}$$

$$\text{TOTAL } Q_{\text{REMOVED}} = 74 \text{ cfs}$$

$$\text{REMAINING FLOW UPSTREAM} = 97.2 - 8 - 74 = 15.2 \text{ cfs}$$

→ PLACE 2-TYPE A INLETS ON MALAGUENA UPSTREAM.

$$Q_{\text{ORIGINAL}} = 70.2 \text{ cfs} \quad \frac{1}{2} \text{ STREET FLOW} = 35 \text{ cfs} \quad S = 3.87\%$$

$$\text{DEPTH OF FLOW} = 0.55' \text{ (TABLE 22.3 D-1)}$$


$$Q_{\text{REMOVED}} = 10 \text{ cfs EACH SIDE}$$

$$\text{TOTAL FLOW} = 97.2 \text{ cfs}$$

- 20 cfs REMOVED BY TYPE A INLETS - MALAGUENA

- 8 cfs REMOVED BY TYPE D INLET - BEAR TRIS

70 cfs TO BE REMOVED BY DOUBLE C INLETS.

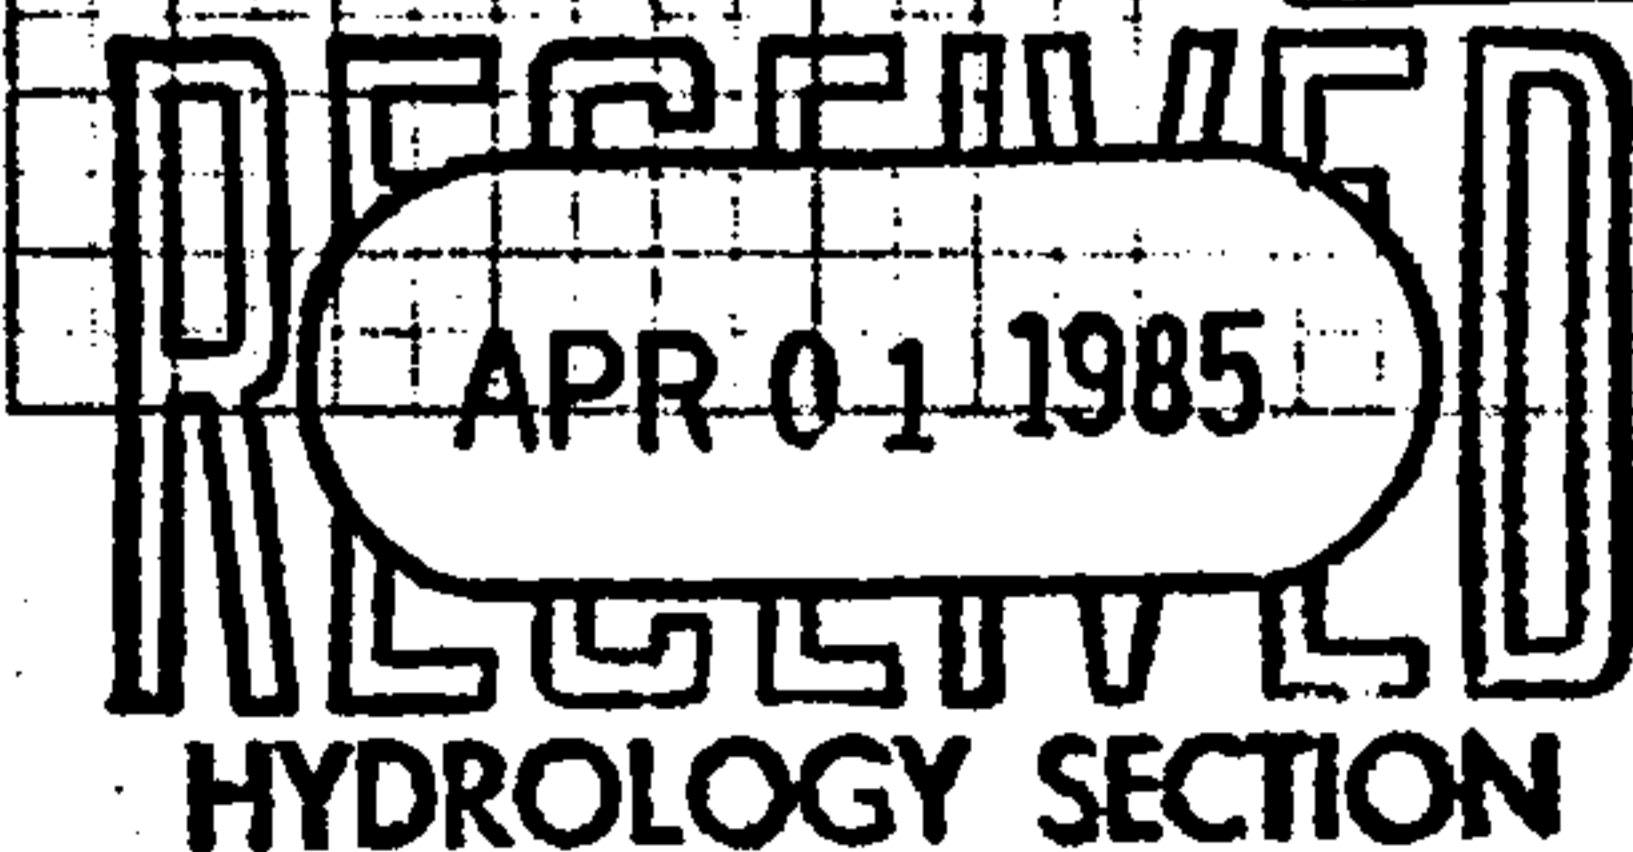

SET DEPTH OF DOUBLE C INLETS TO REMOVE 70 CFS

$$Q = CA\sqrt{2gh}$$

$$35 = (0.6)(3.14)\sqrt{64.4h}$$

$$18.58 = \sqrt{64.4h}$$

$$5.36 = h = \text{REQUIRED HEAD}$$

$$-0.2$$

5.16' BELOW TOP OF CURB

DETERMINE MINIMUM DEPTH FOR TYPE 'A' INLETS

$$d = 18''$$

$$Q = 10 \text{ CFS}$$

$$A = 1.77 \text{ FT}^2$$

$$V = 5.65 \text{ FPS}$$

$$V_{\text{MIN}} = 1.33 + 1.2 \frac{V^2}{2g} + d$$

$$= 1.33 + 1.2(0.5) + 1.5 = 3.42'$$

DETERMINE MINIMUM DEPTH FOR TYPE 'D' INLET

$$d = 18''$$

$$Q = 8 \text{ CFS}$$

$$A = 1.77 \text{ FT}^2$$

$$V = 4.52 \text{ FPS}$$

$$V_{\text{MIN}} = 1.33 + 1.2 \frac{V^2}{2g} + d$$

$$1.33 + 1.2(0.32) + 1.5 = 3.21'$$



PROJECT NAME ACADEMY RIDGE EAST SHEET _____ OF _____

PROJECT NO. _____ BY _____ DATE _____

SUBJECT _____ CH'D _____ DATE _____

SUMMARY OF HYDRAULIC CALCULATIONS

Calc. by KUD

Chk. by _____

FULL CLOSED CONDUIT DESIGN

Proj. No. 4143

Date 1/20/05

Project: Academy Ridge East - Maruona Uprdr Lines: _____ Freq.: 100 Yr.

Sheet 1 of 1

1	2	3	4	5	6	7	8	9	10	LOSSES							18	19	20			
STRUCTURE	STATION	S.D. TYPE SIZE	Q	A	V	K	S _f	L	Δ	H _f	H _b	H _j	H _r	H _{min}	H _{misc}	ΣH _L	E.G.	h _v	H.G.			
1	WYE	66" min 16" / 66"	1674/669																			A
2		48"	90	12.57	7.16	1436.43	0.00393	18.00		0.07						0.07	5720.84	0.80	5720.04		1A*	
3	WYE	24"	35									0.11				0.11	20.91	0.80	20.11		2A	
4		48"	55	12.57	4.38	1436.43	0.00147	18.00		0.03						0.03	21.01	0.30	20.72		3A	
5	WYE	24"	35														21.04	0.30	20.74		4A	
6		48"																				5A
7																						6A
8																						7A
9																						8A
10																						9A
11																						10A
12																						11A
13																						12A
14																						13A
15																						14A
16																						15A
17																						16A
18																						17A
19																						18A
20																						19A
																						20A

NOTES:

*1A ASSUME HGL @ SOFFIT OF MAIN
 HEAD REQUIRED FOR ORIFICE CONTROLLED OUTLET
 WITHIN DOUBLE 'C' INLETS = 5.16'
 TOP OF CURB = 26.18
 CENTER OF PIPE = 21.00
 ∴ HGL IS LOW ENOUGH @ 20.72 & 20.74 TO
 DRIVE THE 24" CONNECTOR PIPES.



0+00

0+17.70 @ Malaguena

26+75.20 5.0 @

Inv. = 13.83

0+35.77

Tie to Exist. 4' Dia. M.H.

Inv. N = 11.50

W = 11.30

Adjust Rim to Elev. 26.07

0+62.10

Exist. 14" Cap.

Top WL = 16.5

0+85.26, 10' Rt.

Build 6' Dia. Type "E" M.H.

Inv. = 17.87 (S)

18.56 (NE)

18.38 (NW)

S = 0.04213 1/4" Rt.
S = 0.04527 1/4" Lt.

48" RCP

S = 0.0045

S = 0.0010022 1/4"

403.2

S = 0.0

8"

8+50 Academy Place Unit 5

VPI: (27.16); 26.12 (Lt.); 26.18 (Rt.)

8+72.45 Begin Curb Lt.

TC: 26.43

8+87.70 BK = 0+00 AH.

26.54 (Rt) 26.53 (Lt)

0+15.03 Begin Curb Rt.

TC: 26.55

0+28.96 Rt.

Elev. @ back of Drivepad: 26.68

0+55.95 Rt.

Elev. @ back of Drivepad: 26.43

Sta. 0+70:

Build. Type Double "C" Inlets Lt. & Rt.

TC = 26.18

Inv. = 20.00

Sta. 1+12:

Build. Type "A" Inlets Lt. & Rt.

TC = 26.59

Inv. = 22.50

M.O. = -0.98 (Rt.), -1.04 (Lt.)

150' VC

100' VC

7+75 VPC

TC: 23.76 (Lt.)

24.00 (Rt.)

0+37.30 VPI

TC: 26.41 Lt. & Rt.

VPC: 0+50

TC: 26.28

1+00 V.P.

(25.78)

TC: 26.39

VPT: 1+50

TC: 27.71

2



**WESTERN
TECHNOLOGIES
INC.**

8305 Washington Place, N.E.
Albuquerque, New Mexico 87113
(505) 823-4488

Centex Homes
10701 Montgomery Blvd., NE
Suite 6
Albuquerque, New Mexico

April 19, 1989

Attention: Mr. Richard Mallett, V.P.

Re: Evaluation of Drainage
Academy Ridge East Phase I
Albuquerque, New Mexico

Job No. 3229J024

Our geotechnical engineering report for the Academy East Phase I drainage investigation is attached. The work was performed in accordance with our proposal of March 30, 1989, accepted by your signed agreement of April 3, 1989.

Soils at the site generally consisted of fine to coarse-grained silty sand overlying poorly-graded sand with low to moderate load bearing capabilities. Subsurface soil conditions identified during the field investigation were found to be unusually moist in areas where surface water has accumulated due primarily to collection of irrigation water. We are recommending locating four interceptors to dewater the problem areas.

We are prepared to review your plans and specifications for consistency with the recommendations, and to provide the construction observation and testing recommended.

Sincerely,

WESTERN TECHNOLOGIES, INC.
Geotechnical Engineering Services

BY:

Charles M. Miller
Charles M. Miller, P.E.

Reviewed by:


Lyle M. Tweet
Lyle M. Tweet, P.E.

Copies

6018

Address

(3)

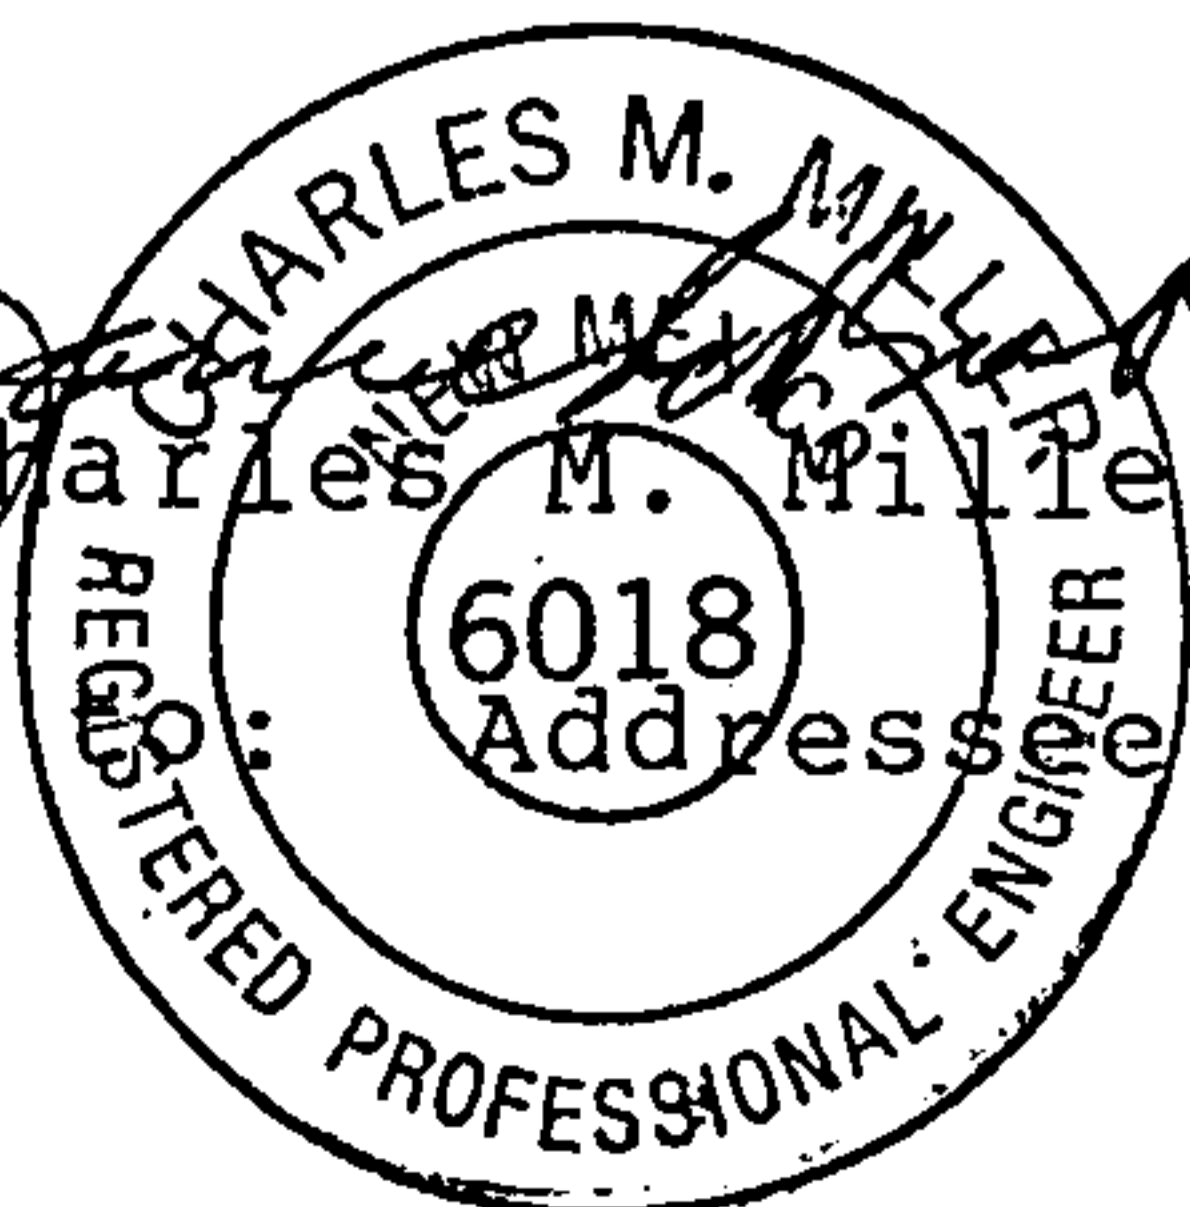

Geotechnical Engineering
Evaluation of Drainage
Academy Ridge East Phase I
Academy Ridge Road and Malaguena Lane
Albuquerque, New Mexico

INTRODUCTION

This report contains the results of our geotechnical engineering evaluation for the drainage problem located between Academy Ridge Road and Malaguena Lane in Albuquerque, New Mexico. The purpose of these services is to evaluate subsurface soil and groundwater conditions, and criteria for surface and subsurface drainage adjacent to the buildings.

PROPOSED EXISTING CONSTRUCTION

We understand the proposed and existing structures will be one/two-story slab-on-grade houses using wood construction. Shallow footings are planned or have been constructed for these houses. Ground floor level for the existing and proposed structures is at or slightly above existing site grade.

SITE CONDITIONS

At the time of our exploration, the site was occupied by homes on lots 42, 43, 46, 47, and 50. Lots 44, 45, 48, and 49 were vacant. For additional information see site plan. The ground surface was terraced and the vacant lots were free of vegetation. Site drainage was to the west, although shallow depressions existed. Other site features include a back lot drain channel extending from the back of lot 42 west to its outlets west of lot 47 and west of lot 50, both of which drain into Academy Ridge Road. The drain channel is joined along its length in two locations by tributary drain channels which drain areas to the north of the aforementioned lots.



In addition, a sump pump is located in the back of lot 46 and a gravel sump is connected to the house on lot 47.

SCOPE OF SERVICES

Our scope of service was to determine the primary causes of surface and/or subsurface drainage problems for the Academy Ridge Phase I project. The problems consisted of ponded water. To accomplish the primary goal, interviews with City personnel, home owners, subcontractors, and home builders were completed. In addition, observation of the site was continued over a two week period as well as reviewing previous reports and investigations by others.

A total of five borings were drilled to depths of approximately 15 to 20 feet and 11 test pits were excavated to depths of approximately 3 to 4 feet at the approximate locations shown on the site plan. During exploration, subsoils were visually examined and sampled at selected intervals. Moisture-density tests were performed on selected soil samples.

Western Technologies Inc. performed the services described in this report to develop engineering information for the purposes defined in the "Introduction." We did not intend to uncover nor identify any contaminated subsurface materials that may contain hazardous or flammable substances. Identification of such substances requires specialized exploration techniques and analyses which were beyond the scope of this investigation.

INTERPRETATION OF SUBSURFACE CONDITIONS

Exploration: As presented on Logs of Borings, subsoils vary with depth and are fairly uniform across the site. The backhoe test pits were generally found to be moist to slightly-moist silty sand and fill depths ranged from 1 to 4 feet. The native silty sands were noted as being lightly cemented at the fill/native soil



interface. In the borings, fill material was noted as ranging from 3 to 8 feet deep and consisted of moist to slightly-moist silty sand. Below the native silty sands, dry to slightly-moist poorly-graded sands were encountered to the full depth of exploration. In areas where water has ponded on the surface and later evaporated, calcium carbonates were encountered. A groundwater table was not encountered in any boring at the time of exploration.

Testing: Laboratory test results verify field findings in that site silty sands are slightly-moist to moist and the underlying poorly-graded sands are slightly-moist to dry. For further information on specific tests see the attached data.

CONCLUSIONS AND RECOMMENDATIONS

General: Based on previous history, observations of the area, soil borings and test pits, our conclusions are as follows:

- 1) The primary cause of excessive water is caused by irrigation by homeowners. The soil is being excessively wetted causing water migration in the upper structure of soil.

Secondary isolated drainage problems:

- 2) Excessive irrigation water requires an improvement of the drainage in selected lots. (See attached drawings.)
- 3) Inadequate sloping next to and away from houses causes water to accumulate next to house foundations and walls;
- 4) Runoff is not being channeled to the back lot drains or rundowns efficiently because the adjacent ground surface in some yards is below the lip of the concrete drains.
- 5) Impedance of surface flow by landscaping, sidewalks, retaining walls, etc., causes runoff to accumulate.

Recommendations: To control the excessive irrigation, area homeowners must be made aware of the problem and educated as to the adverse effects over-watering can cause. Also, positive



drainage should be provided on future lots to drain surface water away from structures. To help runoff water reach the rundowns or back lot drains, concrete interceptors or some modification of the existing drains could be implemented. Each lot must be specifically designed which will require a study of each specific/isolated conditions which are causing problems.

CLOSURE

Based on this investigation, our findings in the field, and reports of others, it is our conclusion that the drainage problem in the area is caused by excessive irrigation. Correction of the problem will depend primarily on the cooperation of homeowners in controlling the use of irrigation water.

If you have any questions or if we can help you further, please feel free to contact us.



BORING LOG NOTES

The number shown in "LOG OF BORING NO." refers to the approximate location of the same number indicated on the "Site Plan" as positioned in the field by measurements from property lines and/or existing features.

"TYPE/SIZE BORING" refers to the exploratory equipment used in the boring wherein HSA = hollow-stem auger.

"N" in "Blows/Foot" refers to the number of blows of a 140-pound weight, dropped 30 inches, required to advance a two-inch-outside-diameter split-barrel sampler a distance of 1 foot, Standard Penetration Test (ASTM D1586). Refusal to penetration is considered more than 100 blows per foot.

"R" in "Blows/Foot" refers to the number of blows of a 140-pound weight, dropped 30 inches, required to advance a 2.42-inch-inside-diameter ring sampler a distance of 1 foot. Refusal to penetration is considered more than 50 blows per foot.

"Sample Type" refers to the form of sample recovery wherein N = Split-barrel sample, and R = Ring sample.

"Dry Density, pcf" refers to the laboratory-determined dry density in pounds per cubic foot.

"Moisture Content, %" refers to the laboratory-determined moisture content in percent (ASTM D2216).

"Unified Class" refers to the soil type as defined by "Method of Soil Classification". The soils were visually classified in the field and, where appropriate, classifications were modified by visual examination of samples in the laboratory and/or by appropriate test.

These notes and boring logs are intended for use in conjunction with the purposes of our services defined in the text. Boring log data should not be construed as part of the construction plans or as defining construction conditions.

Boring logs depict our interpretations of subsurface conditions at the locations and on the date(s) noted. Variations in subsurface conditions and soil characteristics may occur between borings. Groundwater levels may fluctuate due to seasonal variations and other factors.

In general, terms and symbols on the boring logs conform with "Standard Definitions of Terms and Symbols Relating to Soil and Rock Mechanics" (ASTM D653).



LOG OF BORING

Test Boring No. 1

Project: Centex Homes - Academy Ridge Rd.-Drainage

Job No. 3229J024

Type/Size Boring: HSA 6 5/8" Rig Type: CME-75

Date: 04-03-89

Groundwater Conditions: No Groundwater Encountered

Depth (ft)	Blows/ Foot	ST	DD (pcf)	MC (%)	Description
—					Fill
—	32	N			SILTY SAND; fine to coarse grained, dense, trace of gravel, moist, brown, (SM)
—					Black Organic Layer, 3-5' strong sewage odor
5					
—	14	N			SILTY SAND; fine to coarse grained, dense, trace of gravel, moist, brwown, (SM)
—					
—					
10					
—	7	N			SILTY SAND; coarse grained, loose, trace of gravel, dry, brown, (SP)
—					
—					
15					
—	19	N			
—					
—					
—					
20					
—					
—					
—					
25					

STOPPED AT 16.5 FEET



LOG OF BORING

Test Boring No. 2

Project: Centex Homes - Academy Ridge Rd.-Drainage

Job No. 3229J024

Type/Size Boring: HSA 6 5/8" Rig Type: CME-75

Date: 04-03-89

Groundwater Conditions: No Groundwater Encountered

Depth (ft)	Blows/ Foot	ST	DD (pcf)	MC (%)	Description
—					FILL
—	15	N			SILTY SAND; fine to coarse grained, medium dense, moist to slightly moist, brown, (SM)
—					
<u>5</u>					
—	24	N			
—					
—					SAND; fine to coarse grained, medium dense, trace of gravel, slightly moist to dry, brown, (SP)
<u>10</u>					
—	16	N			
—					
—					
<u>15</u>					
—	6	N			
—					
—					STOPPED AT 16.5 FEET
—					
<u>20</u>					
—					
—					
—					
<u>25</u>					



LOG OF BORING

Test Boring No. 3

Project: Centex Homes - Academy Ridge Rd.-Drainage

Job No. 3229J024

Type/Size Boring: HSA 6 5/8" Rig Type: CME-75

Date: 04-03-89

Groundwater Conditions: No Groundwater Encountered

Depth (ft)	Blows/ Foot	ST	DD (pcf)	MC (%)	Description
—					FILL
—	22	N	124		SILTY SAND; fine to coarse grained, dense, light cementation, moist, brown, (SM)
—					
<u>5</u>					
—	33	N	126		
—					
—					
<u>10</u>					
—	30	N	122		SILTY SAND; fine to coarse grained, medium dense, trace of gravel, light cementation, low plasticity, moist, brown, (SM)
—					
—					
<u>15</u>					
—	10	N			SAND; coarse grained, medium dense, trace of gravel, moist, brown, (SP)
—					
—					
<u>20</u>					
—	16	N			
STOPPED AT 21.5 FEET					
—					
<u>25</u>					



LOG OF BORING

Test Boring No. 4

Project: Centex Homes - Academy Ridge Rd.-Drainage

Job No. 3229J024

Type/Size Boring: HSA 6 5/8" Rig Type: CME-75

Date: 04-03-89

Groundwater Conditions: No Groundwater Encountered

Depth (ft)	Blows/ Foot	ST	DD (pcf)	MC (%)	Description
—					FILL
—	12	N	124		SILTY SAND; fine grained, medium dense, trace of gravel, slightly moist, brown, (SM)
—					
—					
<u>5</u>					
—	24	N			
—					
—					SAND; coarse grained, medium dense, trace of gravel, slightly moist, brown, (SP)
<u>10</u>					
—	10	N			
—					
—					
<u>15</u>					
—	7	N			
—					
—					STOPPED AT 16.5 FEET
<u>20</u>					
—					
—					
—					
<u>25</u>					
—					
—					
—					
<u>30</u>					



LOG OF BORING

Test Boring No. 5

Project: Centex Homes - Academy Ridge Rd.-Drainage

Job No. 3229J024

Type/Size Boring: HSA 6 5/8" Rig Type: CME-75

Date: 04-03-89

Groundwater Conditions: No Groundwater Encountered

Depth (ft)	Blows/ Foot	ST	DD (pcf)	MC (%)	Description
—					FILL
—	21	N			SILTY SAND; fine to medium grained, medium dense, trace of coarse grained and gravel, slightly moist, brown, (SM)
<u>5</u>					
—	19	N	133		
—					
—					
<u>10</u>					
—	6	N			SILTY SAND; fine to medium grained, medium dense, trace of coarse grained and gravel, slightly moist, brown, (SM)
—					
—					
<u>15</u>					
—	8	N			
—					
—					SAND; fine to coarse grained, loose to medium dense, moist, brown, (SP)
<u>20</u>					
—	10	N			CLAYEY SILTY SAND; medium dense, low plasticity, light cementation, moist, brown, (SC-SM)
—					
—					STOPPED AT 21.5 FEET
<u>25</u>					




NOT TO SCALE

SITE PLAN

ACADEMY RIDGE DRAINAGE

JOB NUMBER 3229J024

BORING ●
 TEST PIT ⊕

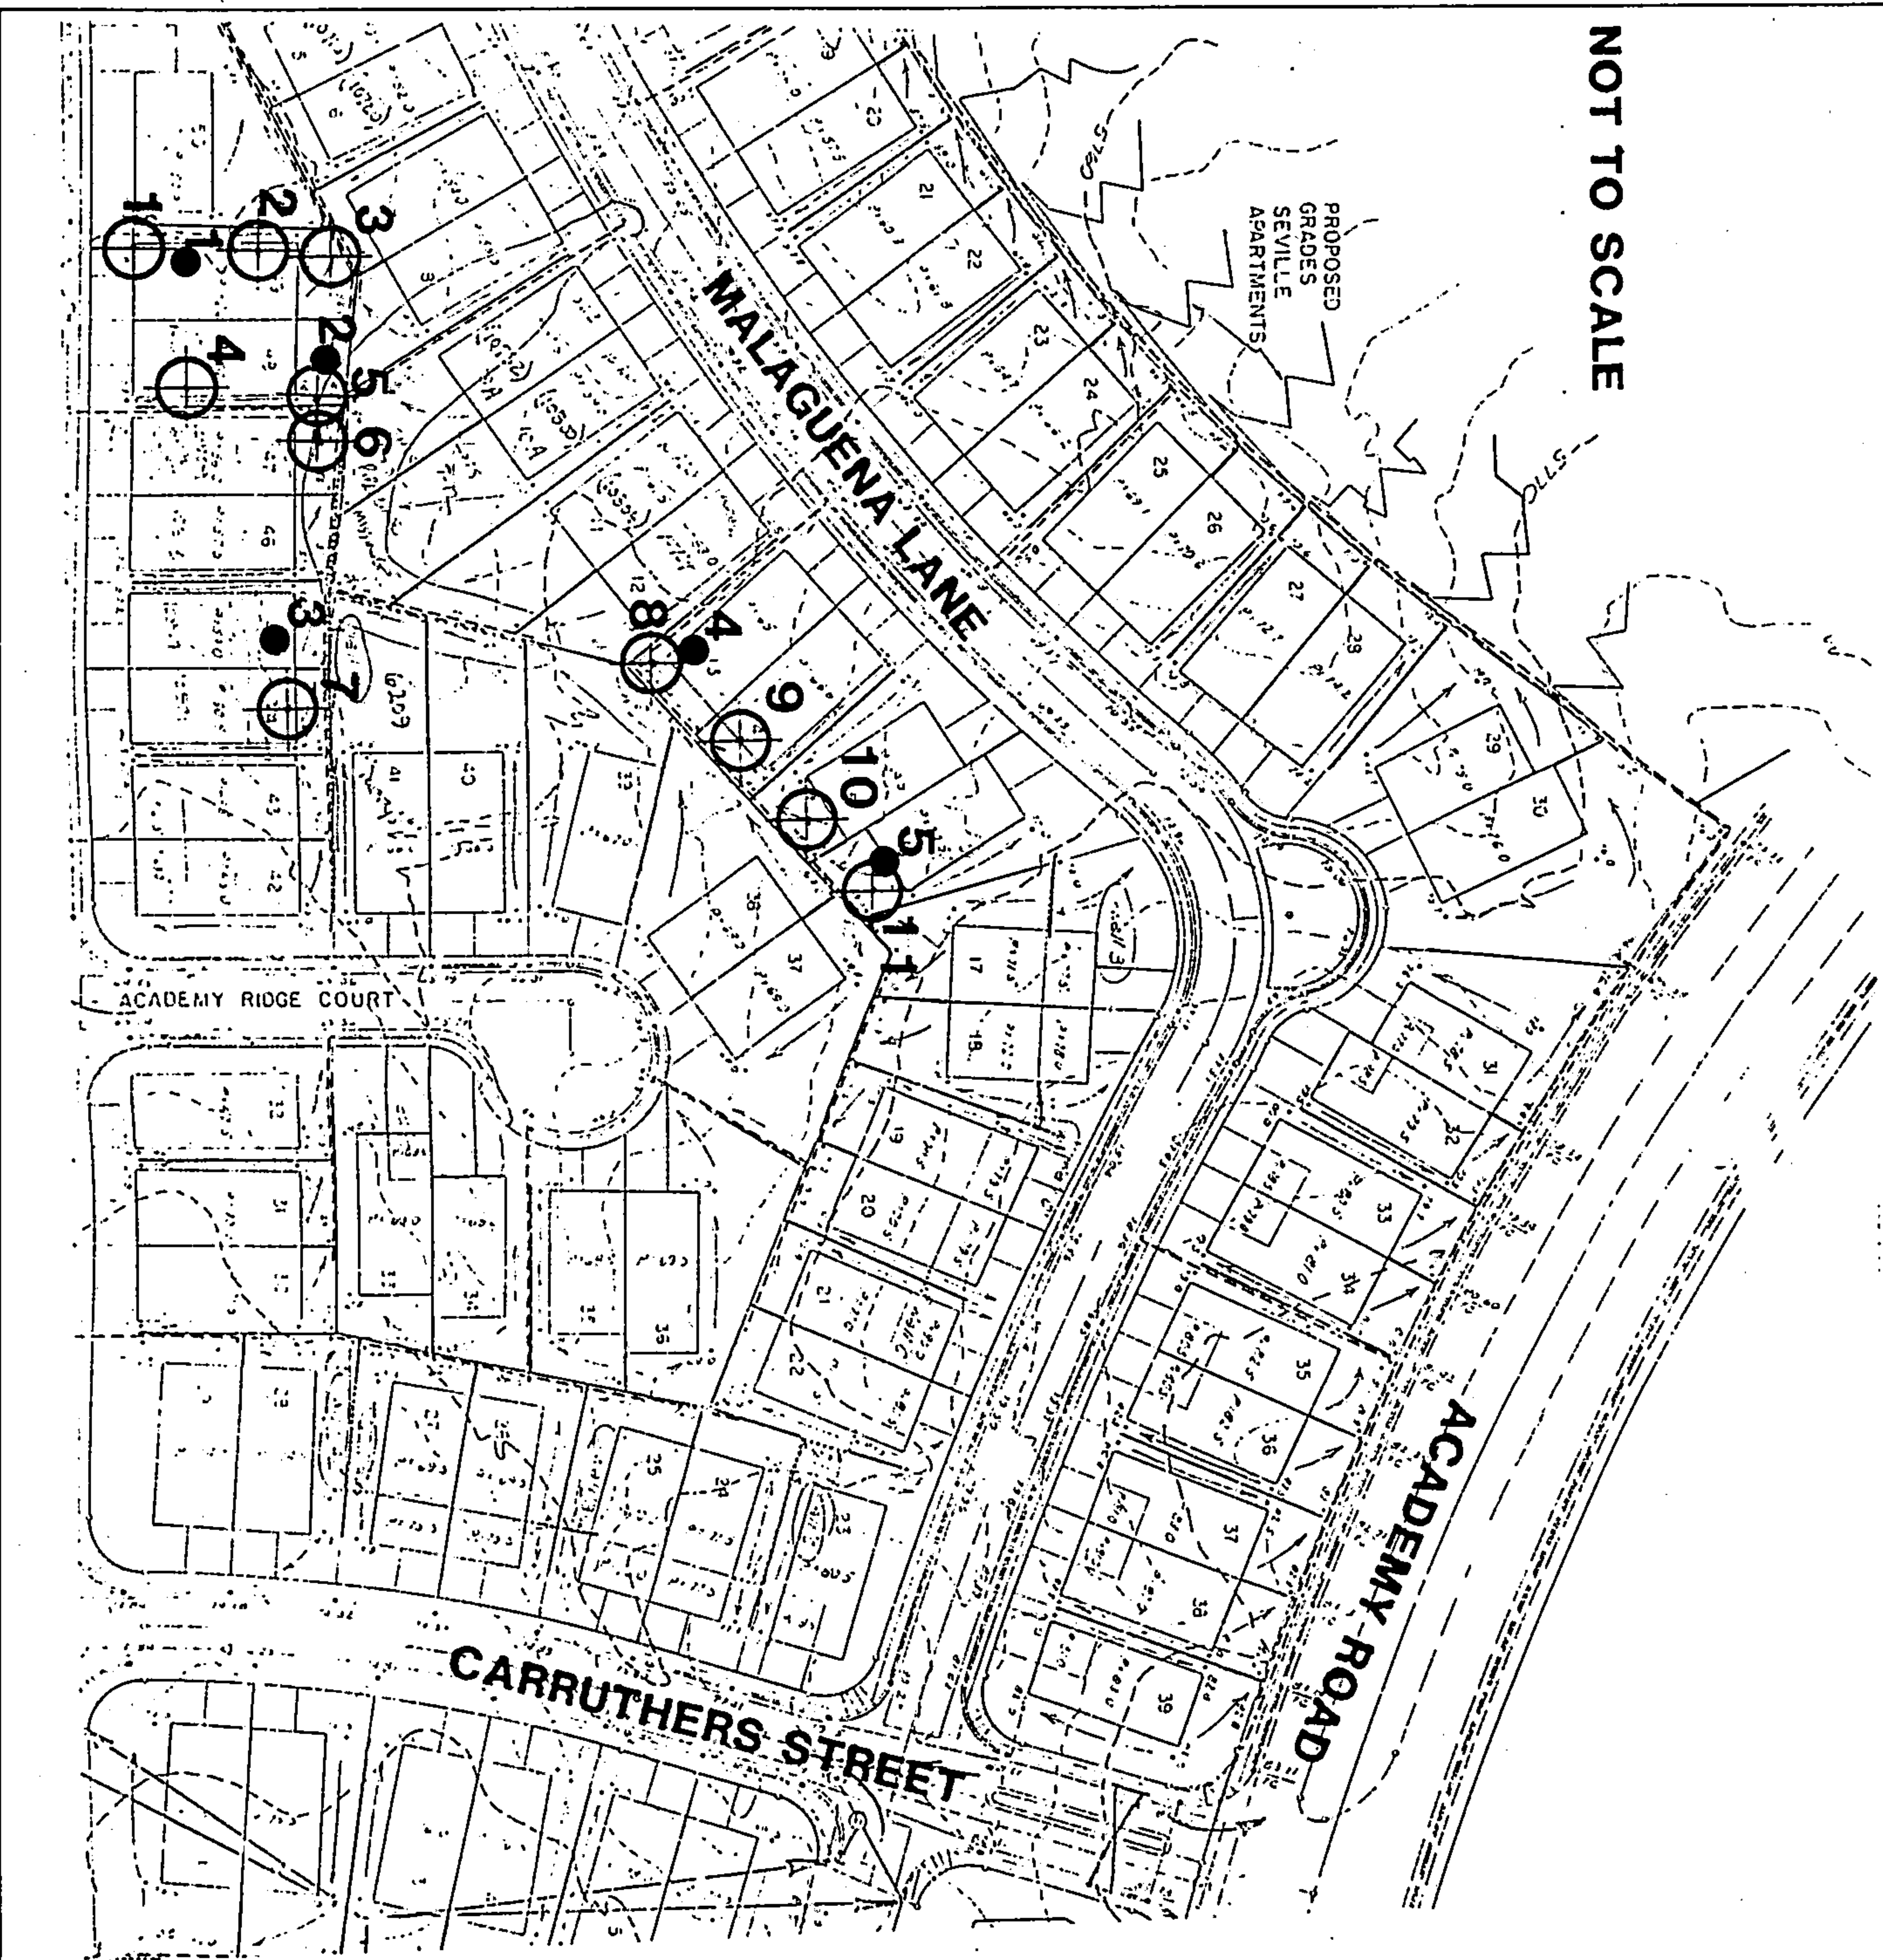

LOGS OF TEST PITS

Test Pit No.	Total Depth (feet)	Soil Type	Moisture	Fill Thickness (feet)
1	4	SM	SL. MOIST	2
2	4	SM	SL. MOIST	2
3	4	SM	SL. MOIST	3
4	4	SM	DRY	1
5	4	SM	MOIST	4
6	4	SM	MOIST	3
7	4	SM	DRY	1
8	4	SM	SL. MOIST	4
9	4	SM	SL. MOIST	2.5
10	4	SM	SL. MOIST	3
11	4	SM	SL. MOIST	4



FILE COPY



City of Albuquerque

P.O. BOX 1293 ALBUQUERQUE, NEW MEXICO 87103

MAYOR
KEN SCHULTZ

CHIEF
ADMINISTRATIVE OFFICER
GENE ROMO

DEPUTY CAO
PUBLIC SERVICES
FRANK MARTINEZ

DEPUTY CAO
PLANNING/DEVELOPMENT
BILL MUELLER

May 11, 1988

Kerry Davis, P.E.
Bohannon-Huston, Inc.
7500 Jefferson Street, NE
Albuquerque, New Mexico 87109

RE: REVISED GRADING & DRAINAGE PLAN FOR ACADEMY RIDGE EAST, UNIT III
RECEIVED MAY 6, 1988 FOR APPROVAL (E-21/D29)

Dear Mr. Davis:

The above referenced submittal, Sheet 9 of 13, revised May 3, 1988, is approved.

If you have any further questions, call me at 768-2650.

Cordially,

Roger A. Green, PE
Roger A. Green, P.E.
C.E./Hydrology Section

RAG/bsj

FILE COPY



City of Albuquerque

P.O. BOX 1293 ALBUQUERQUE, NEW MEXICO 87103

MAYOR
KEN SCHULTZ

CHIEF
ADMINISTRATIVE OFFICER
GENE ROMO

DEPUTY CAO
DEVELOPMENT & ENTERPRISE SERVICES
LARRY LARRANAGA

DEPUTY CAO
PUBLIC SERVICES
DAN WEAKS

June 29, 1988

Kerry Davis, P.E.
Bohannon-Huston, Inc.
7500 Jefferson Street, NE
Albuquerque, New Mexico 87109

RE: DRAINAGE RUNDOWN MODIFICATION FOR ACADEMY RIDGE EAST, UNIT I
RECEIVED JUNE 24, 1988 FOR BUILDING PERMIT APPROVALS (E-21/D29)
(CITY PROJECT NO. 2289)

Dear Mr. Davis:

The above referenced submittal revised June 23, 1988, is approved. The V-bottom drainage channels may be used where the minimum slope is 0.5%.

If you have any further questions, call me at 768-2650.

Cordially,

Roger A. Green, P.E.
C.E./Hydrology Section

xc: Rick Duran, Drainage Inspector
Lynn Johnson, Centex Homes

RAG/bsj