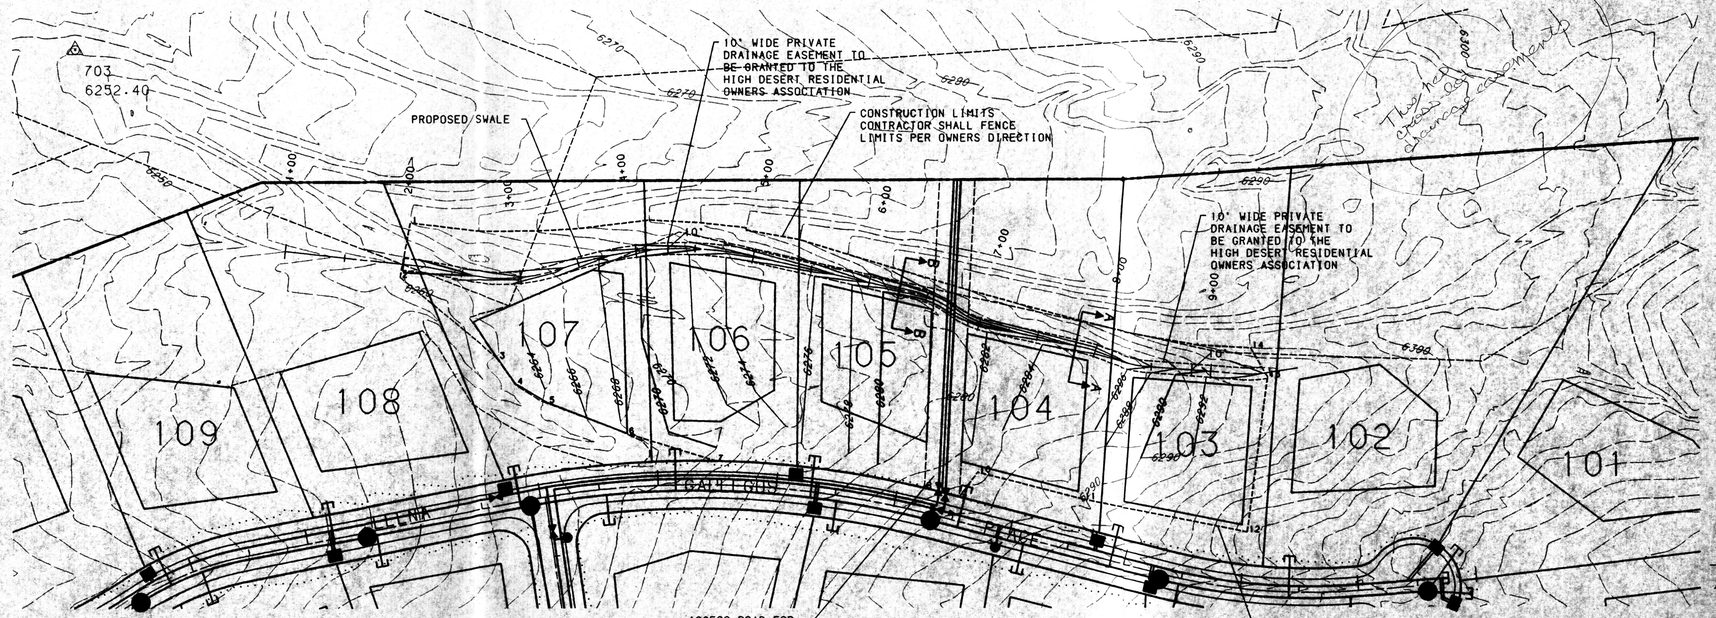

DRAINAGE SWALE

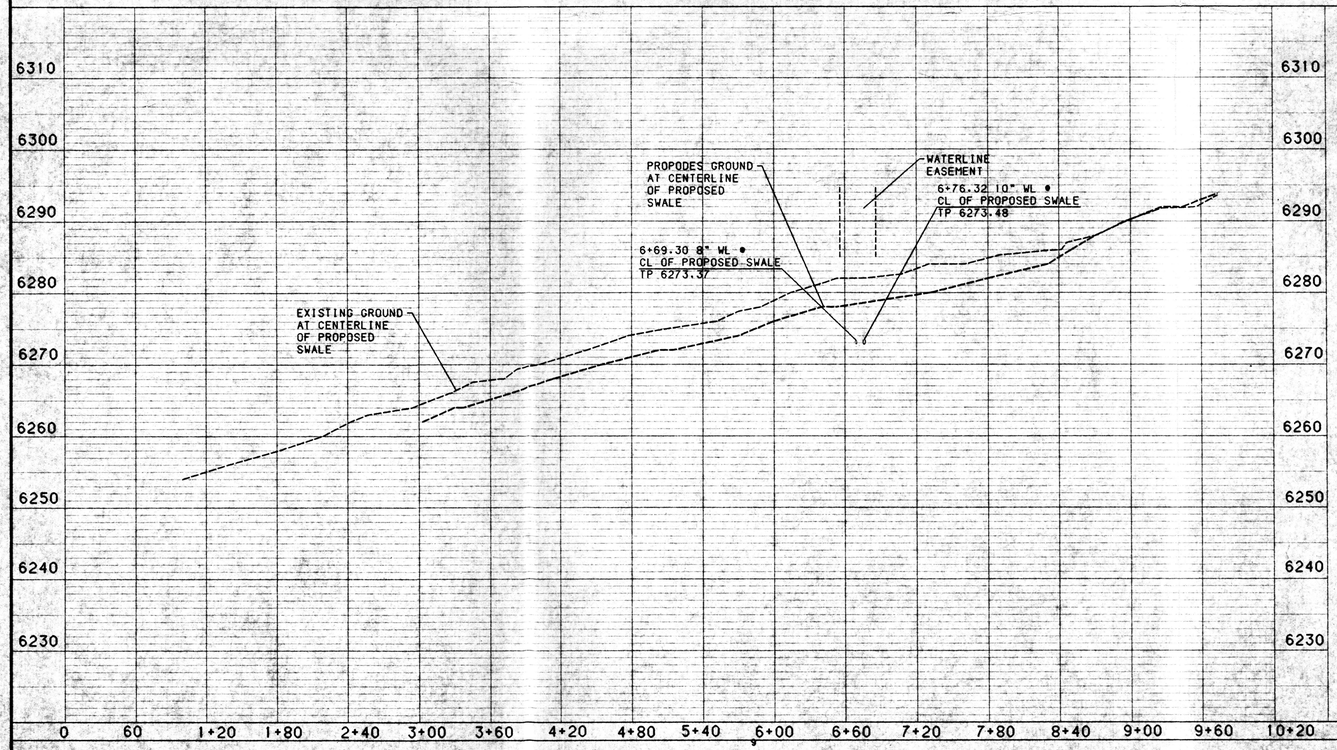

SCALE: 1" = 60' (HORIZ.)
SCALE: 1" = 10' (VERT.)

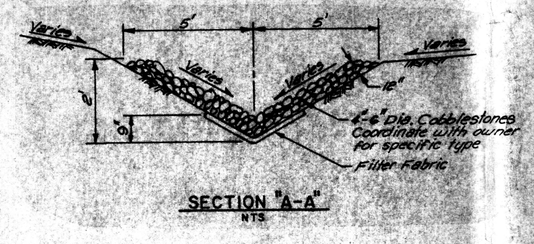

SECTION "A-A"
NTS

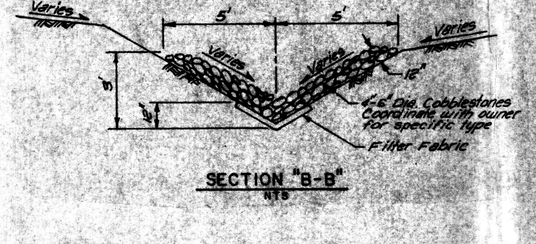

SECTION "B-B"
NTS

GENERAL NOTES

1. CONTRACTOR MUST OBTAIN A TOPSOIL DISTURBANCE PERMIT FROM THE ENVIRONMENTAL HEALTH DIVISION PRIOR TO CONSTRUCTION.
2. THE CONTRACTOR IS TO REFER TO EARTHWORK SPECIFICATION AS NOTED IN THE SOILS REPORT PREPARED BY GEO-TEST.
3. THE CONTRACTOR SHALL CONFORM TO ALL CITY, COUNTY, STATE, AND FEDERAL DUST CONTROL MEASURES AND REQUIREMENTS AND WILL BE RESPONSIBLE FOR PREPARING AND OBTAINING ALL NECESSARY APPLICATIONS AND APPROVALS.
4. THE CONTRACTOR SHALL ENSURE THAT NO SOIL ERODES FROM THE LOTS INTO PUBLIC RIGHT-OF-WAY. THIS CAN BE ACHIEVED BY CONSTRUCTING TEMPORARY BERMS AS PER DETAIL THIS SHEET AND WETTING THE SOIL TO KEEP IT FROM BLOWING.
5. ALL SPOT ELEVATIONS ARE TO FLOWLINE ELEV. UNLESS OTHERWISE NOTED.

COORDINATES FOR THE BUILDING LIMITS

PT	X	Y

AS-BUILT INFORMATION
BENCH MARKS
FIELD NOTES
BY
DATE
ENGINEER'S SEAL
NO. DATE REMARKS
REVISIONS
DESIGNED BY
DRAWN BY
CHECKED BY
DATE
PROJECT NO.
FILE NO.

BOHANNAN-HUSTON INC.
ENGINEERS • PLANNERS • SURVEYORS • LANDSCAPE ARCHITECTS
ALBUQUERQUE LAS CRUCES SANTA FE

CITY OF ALBUQUERQUE
PUBLIC WORKS DEPARTMENT
ENGINEERING DEVELOPMENT GROUP

THE HIGHLANDS AT HIGH DESERT UNIT # 3
DRAINAGE SWALE
LOTS 102-109

DESIGN REVIEW COMMITTEE	CITY ENGINEER APPROVAL	LAST DESIGN UPDATE	INITIATOR	INITIATOR
JUL 07 1997				

CITY PROJECT NO. 000000 | ZONE MAP NO. E23Z-E24Z | SHEET 1 OF 1

BHI JOB NO. C96464A06

Copyright Bohannan-Huston, Inc. 1997
DATE: JUNE, 1997

USERNAME: CDP1:[C96464A06]
FILENAME: SWALE-PNP.GRF