PUBLIC WORKS/HYDROLOGY

1 OF 2

F17/D49A

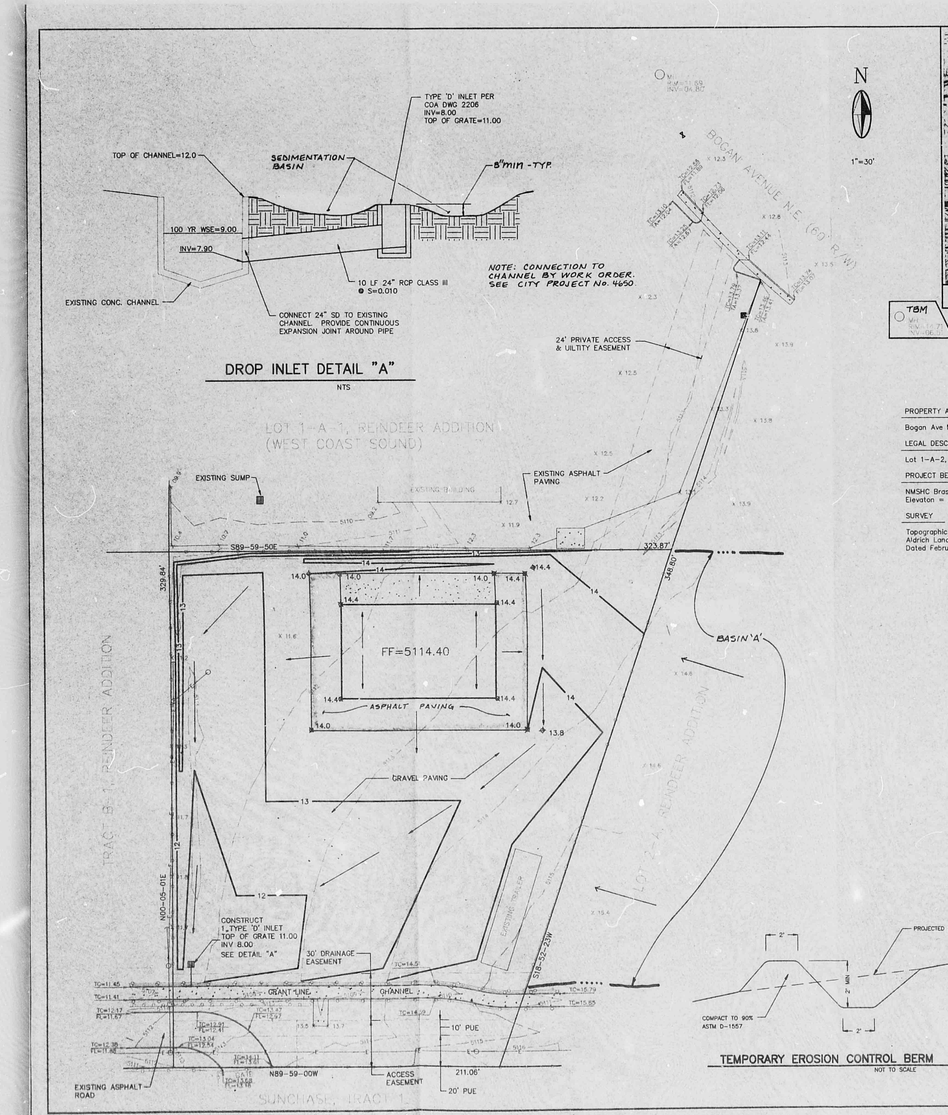

DROP INLET DETAIL "A"

NTS

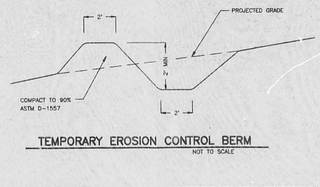

TEMPORARY EROSION CONTROL BERM

NOT TO SCALE

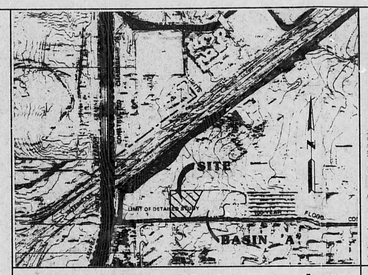

FLOODWAY & OFFSITE DRAINAGE MAP 1"=500'

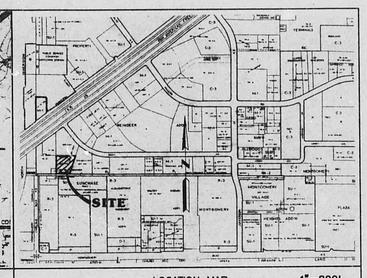

LOCATION MAP 1"=800'

PROPERTY ADDRESS	
Bogan Ave NE	
LEGAL DESCRIPTION	
Lot 1-A-2, Reindeer Addition	
PROJECT BENCHMARK	
NMSHC Brass cap "I25-18" Elevation = 5125.70 feet (MSLD 1929)	
SURVEY	
Topographic and Improvement survey by Aldrich Land Surveying Dated February, 1993	

LEGEND

- 14 — CONTOUR (PROPOSED)
- 4949 — CONTOUR (EXISTING)
- CURB AND GUTTER
- CONCRETE
- GUARDRAIL
- SANITARY SEWER MANHOLE
- WATER VALVE
- x 11.3 SPOT ELEVATION (EXISTING)
- CHAIN LINK FENCE
- OVERHEAD ELECTRIC LINE
- POLE
- ANCHOR
- LIGHT POLE
- 14.0 SPOT ELEVATION (PROPOSED)
- FLOW DIRECTION
- DRAINAGE SWALE
- DRAINAGE BASIN DIVIDE

HYMO DATA SHEET

Precipitation zone 2 P360= 2.35"

Basin	Basin Area (ac)	Land Treatment A (acres)	B	C	D	Ew (in)	Q100 (cfs)	V100 (af)
Existing conditions								
SITE	2.08	---	---	2.08	---	1.13	6.5	0.20
A	2.9	2.0	---	0.7	0.2	0.78	6.3	0.19
Developed conditions								
SITE	2.08	---	0.18	---	1.9	2.00	9.3	0.35
A	2.9	---	0.3	---	2.6	2.00	12.9	0.48

DRAINAGE PLAN

SCOPE:

Pursuant to the established Drainage Ordinance for the City of Albuquerque and the Development Process Manual, this Drainage Plan outlines the drainage management criteria for controlling developed runoff from the project site. A truck repair service facility is proposed on the property, with guards quarters (mobile home), and associated access, paving, drainage and utility improvements.

EXISTING CONDITIONS:

The project site is approximately 2.08 acres in size and is located just south of Bogan Avenue, east of the I-25 east frontage road. Presently the site is partially improved. The site has recently been graded to remove vegetation. A chain link fence has been constructed at the perimeter of the property for security purposes. Site topography is uniform, sloping from east to west at approximately one percent (1%). The site is bounded on the west and north by developed commercial properties, on the east by undeveloped property, and on the south by a developed apartment complex. The Grant Line Channel runs through the southern edge of the site. As shown by Floodway Map Panel 350002 0016, this site does not lie within a designated flood hazard zone.

The natural (pre-graded) site drained in a northwesterly direction into the West Coast Sound site located to the north. An area drain is provided on the West Coast Sound site to intercept all flows. This area drain discharges into an underground vault which is drained by a sump pump. The outfall for the vault is the Pan American Frontage Road drainage system.

The existing (graded) site drains in a westerly direction. Temporary erosion control berms have been placed at the property lines to prohibit discharge of flows onto adjacent lands. The graded site is presently ponding runoff as a result of erosion control measures.

DEVELOPED CONDITIONS:

As shown by the Plan, the site is to be developed as a service center for a trucking operation. Improvements consist of construction of a 6000 SF building, paved access and parking, perimeter fencing, guards quarters (mobile home), private utilities, and drainage improvements. Review of the existing off-site conditions at West Coast Sound, and the Drainage Report for Lot 1A (West Coast Sound), prepared by Hall Engineering, dated 1-23-85, reveals that the existing vault does not have capacity to accept developed flows from the L&H Trucking site. The vault was sized to accept only undeveloped flow from the L&H site. Inspection of the vault revealed a need for maintenance which would be increased by further discharge by the project site. The site will therefor be graded to drain to the Grant Line Channel located to the routh. An area drain will be constructed just north of the channel to intercept all on-site flow. Utilization of an area drain reduces the fill required drain the site to the south instead of its natural tendency to drain northwest.

The site accepts off-site flow from the undeveloped tract located to the east. The drainage improvements to be provided by this project will be sized to accept this runoff, however, when the adjacent tract develops it will be required to drain either to the Grant Line Channel or Bogan ave.

As shown by the Plan, the site has paved access through the West Coast Sound site. A 20' strip will be paved around the perimeter of the building, with the remainder of the site to be paved with gravel.

CALCULATIONS:

The calculations shown hereon define the 100 year/6 hour design storm falling with the project area under existing and developed conditions. The Hydrology is per "Section 22.2, Part A, DPM, Vol 2" Dated August 1991. Supplemental calculations for the sizing of the private drop inlet and connection to the Grant Line Channel are submitted separately.

RECEIVED MAR 12 1993

L & H TRUCKING
GRADING & DRAINAGE PLAN

FLOYD L. BRASHER NEW MEXICO 9681

2-25-93 3-4-93

BRASHER ENGINEERING, INC.
11930 MENAUL BLVD. N.E., SUITE 113
ALBUQUERQUE, NEW MEXICO 87112
(505)296-0422

DRAWN BY: STAFF	DATE: 02-25-93
CHECKED BY: D.A.L.	SHEET 1 OF 1

02259.3DAL

R# 25 DATE 3-17-92 OP. KR

CITY OF ALBUQUERQUE

This microimage is certified to be a complete and accurate copy of the original as it appears in the files of the Public Works Department and was created in the normal course of business.

The photographic process used meets the Basic Microfilm Standards of the National Micrographics Association (MS1A5-1977)

Brian J. Hatley 1/15/92
DIRECTOR

PLAN SHOT TWICE ONCE ON LIGHT ONCE ON DARK

CITY OF ALBUQUERQUE THIS MICROIMAGE IS THE BEST POSSIBLE REPRODUCTION DUE TO THE POOR QUALITY OF THE ORIGINAL DOCUMENT.

Roberta Duran
NOTARY PUBLIC

OFFICIAL SEAL
Roberta Duran
NOTARY PUBLIC
STATE OF NEW MEXICO
07/23/92

PLANS/PLATS ON FILE

FILE DESC: F17/D49A

PLANS/PLATS 3

E 30 D 24 C 20 B 16 A 12 CITY OF ALBUQUERQUE C D F

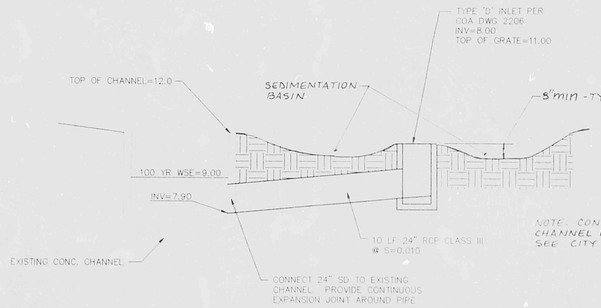

DROP INLET DETAIL "A"

NTS

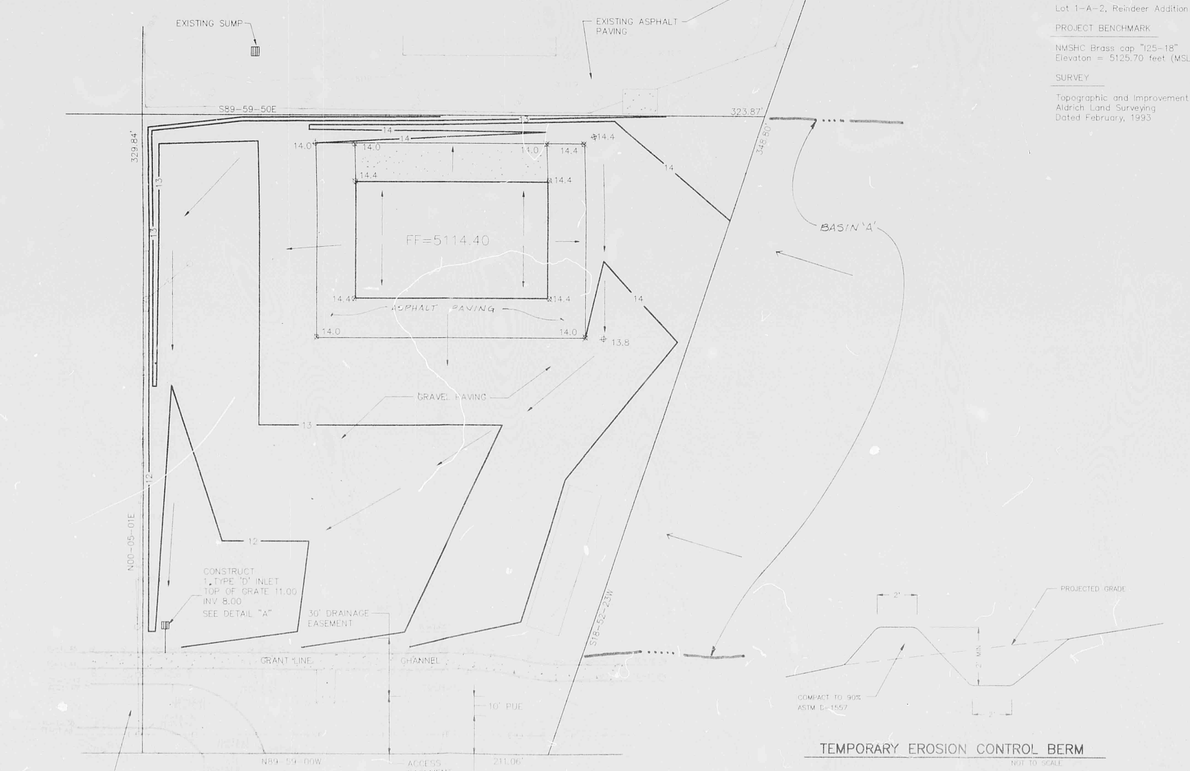

TEMPORARY EROSION CONTROL BERM

NOT TO SCALE

N

1"=60'

TBM

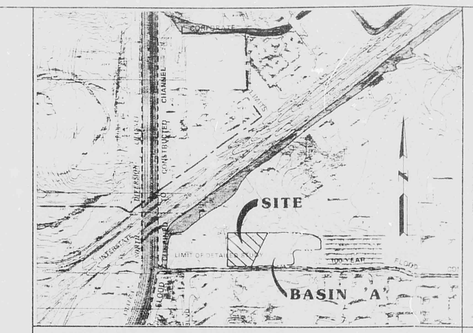

FLOODWAY & OFFSITE DRAINAGE MAP 1"=500'

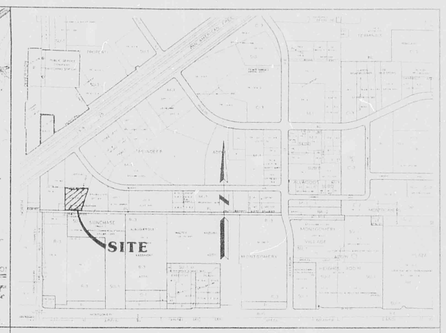

LOCATION MAP 1"=800'

PROPERTY ADDRESS

Bogan Ave NE

LEGAL DESCRIPTION

Lot 1-A-2, Reindeer Addition

PROJECT BENCHMARK

NMSHC Brass cap "125-18"
Elevaton = 5125.70 feet (MSLD 1929)

SURVEY

Topographic and Improvement survey by
Aldrich Land Surveying
Dated February, 1993

LEGEND

—14—	CONTOUR (PROPOSED)
	CONTOUR (EXISTING)
	CURB AND GUTTER
	CONCRETE
	GUARDRAIL
	SANITARY SEWER MANHOLE
	WATER VALVE
x 11.3	SPOT ELEVATION (EXISTING)
	CHAIN LINK FENCE
	OVERHEAD ELECTRIC LINE
	POLE
	ANCHOR
	LIGHT POLE
⊕ 14.0	SPOT ELEVATION (PROPOSED)
	FLOW DIRECTION
	DRAINAGE SWALE
	DRAINAGE BASIN DIVIDE

HYMO DATA SHEET

Precipitation zone 2 P360= 2.35"

Basin	Basin Area (ac)	Land Treatment A (acres)	B	C	D	EW (in)	Q100 (cfs)	V100 (af)
Existing conditions								
SITE	2.08	---	---	2.08	---	1.13	6.5	0.20
A	2.9	2.0	---	0.7	0.2	0.78	6.3	0.19
Developed conditions								
SITE	2.08	---	0.18	---	1.9	2.00	9.3	0.35
A	2.9	---	0.3	---	2.6	2.00	12.9	0.48

DRAINAGE PLAN

SCOPE:

Pursuant to the established Drainage Ordinance for the City of Albuquerque and the Development Process Manual, this Drainage Plan outlines the drainage management criteria for controlling developed runoff from the project site. A truck repair service facility is proposed on the property, with guards quarters (mobile home), and associated access, paving, drainage and utility improvements.

EXISTING CONDITIONS:

The project site is approximately 2.08 acres in size and is located just south of Bogan Avenue, east of the I-25 east frontage road. Presently, the site is partially improved. The site has recently been graded to remove vegetation. A chain link fence has been constructed at the perimeter of the property for security purposes. Site topography is uniform, sloping from east to west at approximately one percent (1%). The site is bounded on the west and north by developed commercial properties, on the east by undeveloped property, and on the south by a developed apartment complex. The Grant Line Channel runs through the southern edge of the site. As shown by Floodway Map Panel 350002 0016, this site does not lie within a designated flood hazard zone.

The natural (pre-graded) site drained in a northwesterly direction into the West Coast Sound site located to the north. An area drain is provided on the West Coast Sound site to intercept all flows. This area drain discharges into an underground vault which is drained by a sump pump. The outfall for the vault is the Pan American Frontage Road drainage system.

The existing (graded) site drains in a westerly direction. Temporary erosion control berms have been placed at the property lines to prohibit discharge of flows onto adjacent lands. The graded site is presently ponding runoff as a result of erosion control measures.

DEVELOPED CONDITIONS:

As shown by the Plan, the site is to be developed as a service center for a trucking operation. Improvements consist of construction of a 6000 SF building, paved access and parking, perimeter fencing, guards quarters (mobile home), private utilities, and drainage improvements. Review of the existing off-site conditions at West Coast Sound, and the Drainage Report for Lot 1A (West Coast Sound), prepared by Hall Engineering, dated 23-85, reveals that the existing vault does not have capacity to accept developed flows from the L&H Trucking site. The vault was sized to accept only undeveloped flow from the L&H site. Inspection of the vault revealed a need for maintenance, which would be increased by further discharge by the project site. The site will therefor be graded to drain to the Grant Line Channel located to the south. An area drain will be constructed just north of the channel to intercept all on-site flow. Utilization of an area drain reduces the fill required from the site to the south, instead of its natural tendency to drain northwest.

The site accepts off-site flow from the undeveloped tract located to the east. The drainage improvements to be provided by this project will be sized to accept this runoff, however, when the adjacent tract develops it will be required to drain either to the Grant Line Channel or Bogan Ave.

As shown by the Plan, the site has paved access through the West Coast Sound site. A 20' strip will be paved along the perimeter of the building, with the remainder of the site to be paved with gravel.

CALCULATIONS:

The calculations shown hereon define the 100 year/6 hour design storm falling with the project site under existing and developed conditions. The Hydrology is per "Section 22.2, Part A DPM, Vol 2" Dated August 1997. Supplemental calculations for the sizing of the private drop inlet and connection to the Grant Line Channel are submitted separately.

L & H TRUCKING
GRADING & DRAINAGE PLAN

BRASHER ENGINEERING, INC.
11930 MENAUL BLVD. N.E., SUITE 113
ALBUQUERQUE, NEW MEXICO 87112
(505)296-0422

2-25-92 3-27-92

DRAWN BY: STAFF	DATE: 02/25/92
CHECKED BY: RJS	DATE: 03/27/92

PLAN SHOT TWICE
ONCE ON LIGHT
ONCE ON DARK

CITY OF ALBUQUERQUE
THIS MICROIMAGE IS THE BEST POSSIBLE REPRODUCTION DUE TO THE POOR QUALITY OF THE ORIGINAL DOCUMENT.

R# 35 DATE 5/19/92 OP

CITY OF ALBUQUERQUE
This microimage is certified to be a complete and accurate copy of the original as it appears in the files of the Public Works Department and was created in the normal course of business.
The photographic process used meets the Basic Microfilm Standards of the National Micrographics Association (MS115-1977)

DIRECTOR

NOTARY PUBLIC
OFFICIAL SEAL
Rebecca Duran
07/02/92

D 24 C 20 B 16 A 12

CITY OF ALBUQERQUE C D

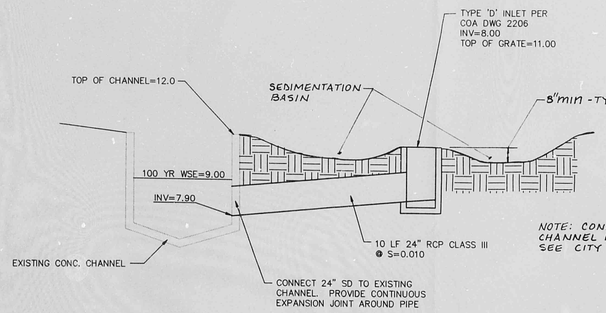

DROP INLET DETAIL "A"

NTS

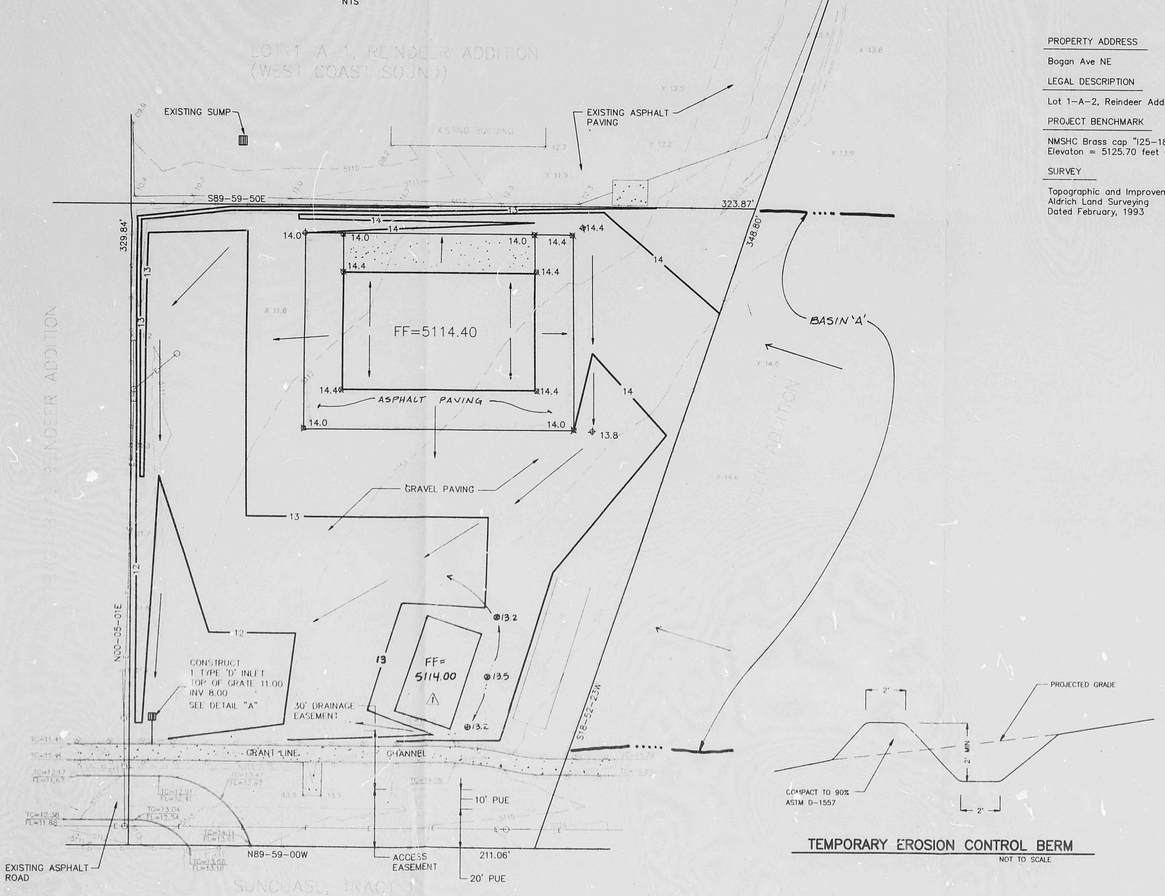

TEMPORARY EROSION CONTROL BERM

NOT TO SCALE

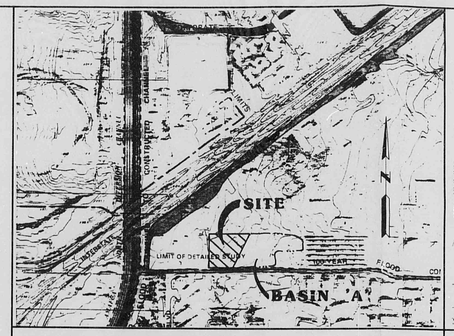

FLOODWAY & OFFSITE DRAINAGE MAP 1"=500'

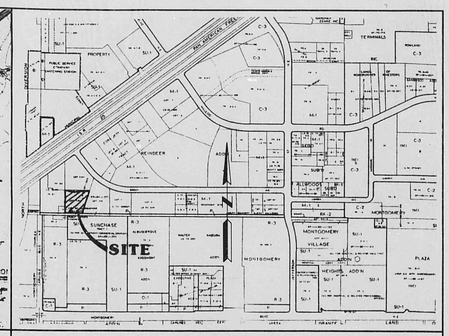

LOCATION MAP 1"=800'

TBM

PROPERTY ADDRESS

Bogan Ave NE

LEGAL DESCRIPTION

Lot 1-A-2, Reindeer Addition

PROJECT BENCHMARK

NMSHC Brass cap "125-18"
Elevaton = 5125.70 feet (MSLD 1929)

SURVEY

Topographic and Improvement survey by
Aldrich Land Surveying
Dated February, 1993

LEGEND

- —14— CONTOUR (PROPOSED)
- 5148 CONTOUR (EXISTING)
- CURB AND GUTTER
- CONCRETE
- GUARDRAIL
- SANITARY SEWER MANHOLE
- WATER VALVE
- x 11.3 SPOT ELEVATION (EXISTING)
- CHAIN LINK FENCE
- —E— OVERHEAD ELECTRIC LINE
- POLE
- ANCHOR
- LIGHT POLE
- 14.0 SPOT ELEVATION (PROPOSED)
- FLOW DIRECTION
- DRAINAGE SWALE
- DRAINAGE BASIN DIVIDE

HYMO DATA SHEET

Precipitation zone 2 P360= 2.35"

Basin	Basin Area (ac)	Land Treatment A (acres)	B	C	D	Ew (in)	Q100 (cfs)	V100 (af)
Existing conditions								
SITE	2.08	---	---	2.08	---	1.13	6.5	0.20
A	2.9	2.0	---	0.7	0.2	0.78	6.3	0.19
Developed conditions								
SITE	2.08	---	0.18	---	1.9	2.00	9.3	0.35
A	2.9	---	0.3	---	2.6	2.00	12.9	0.48

DRAINAGE PLAN

SCOPE:

Pursuant to the established Drainage Ordinance for the City of Albuquerque and the Development Process Manual, this Drainage Plan outlines the drainage management criteria for controlling developed runoff from the project site. A truck repair service facility is proposed on the property, with guards quarters (mobile home), and associated access, paving, drainage and utility improvements.

EXISTING CONDITIONS:

The project site is approximately 2.08 acres in size and is located just south of Bogan Avenue, east of the I-25 east frontage road. Presently the site is partially improved. The site has recently been graded to remove vegetation. A chain link fence has been constructed at the perimeter of the property for security purposes. Site topography is uniform, sloping from east to west at approximately one percent (1%). The site is bounded on the west and north by developed commercial properties, on the east by undeveloped property, and on the south by a developed apartment complex. The Grant Line Channel runs through the southern edge of the site. As shown by Floodway Map Panel 350002 0016, this site does not lie within a designated flood hazard zone.

The natural (pre-graded) site drained in a northwesterly direction into the West Coast Sound site located to the north. An area drain is provided on the West Coast Sound site to intercept all flows. This area drain discharges into an underground vault which is drained by a sump pump. The outfall for the vault is the Pan American Frontage Road drainage system.

The existing (graded) site drains in a westerly direction. Temporary erosion control berms have been placed at the property lines to prohibit discharge of flows onto adjacent lands. The graded site is presently ponding runoff as a result of erosion control measures.

DEVELOPED CONDITIONS:

As shown by the Plan, the site is to be developed as a service center for a trucking operation. Improvements consist of construction of a 6000 SF building, paved access and parking, perimeter fencing, guards quarters (mobile home), private utilities, and drainage improvements. Review of the existing off-site conditions at West Coast Sound, and the Drainage Report for Lot 1A (West Coast Sound), prepared by Hall Engineering, dated 1-23-8 reveals that the existing vault does not have capacity to accept developed flows from the L&H Trucking site. The vault was sized to accept only undeveloped flow from the L&H site. Inspection of the vault revealed a need for maintenance which would be increased by further discharge by the project site. The site will therefor be graded to drain to the Grant Line Channel located to the south. An area drain will be constructed just north of the channel to intercept all on-site flow. Utilization of an area drain reduces the fill required drain the site to the south instead of its natural tendency to drain northwest.

The site accepts off-site flow from the undeveloped tract located to the east. The drainage improvements to be provided by this project will be sized to accept this runoff, however, when the adjacent tract develops it will be required to drain either to the Grant Line Channel or Bogan ave.

As shown by the Plan, the site has paved access through the West Coast Sound site. A 20' strip will be paved around the perimeter of the building, with the remainder of the site to be paved with gravel.

CALCULATIONS:

The calculations shown hereon define the 100 year/6 hour design storm falling with the project area under existing and developed conditions. The Hydrology is per "Section 22.2, Part A, DPM, Vol 2" Dated August 1991. Supplemental calculations for the sizing of the private drop inlet and connection to the Grant Line Channel are submitted separately.

OCT 13 1993
HYDROLOGY DIVISION

REVISIONS			
1 10-12-93	PLAN UPDATE TO ADD 30'x52' BUILDING	DAL	

L & H TRUCKING
GRADING & DRAINAGE PLAN

BRASHER ENGINEERING, INC.
11930 MENAUL BLVD. N.E., SUITE 113
ALBUQUERQUE, NEW MEXICO 87112
(505)296-0422

10-12-93
2-25-93 9-24-93

DRAWN BY: STAFF	DATE: 02-25-93
CHECKED BY: D.A.L.	SHEET 1 OF 1

PLAN SHOT TWICE
ONCE ON LIGHT
ONCE ON DARK

CITY OF ALBUQUERQUE
THIS MICROIMAGE IS THE BEST POSSIBLE REPRODUCTION DUE TO THE POOR QUALITY OF THE ORIGINAL DOCUMENT.

R# 25 DATE 3-19-02 OP EGP

CITY OF ALBUQUERQUE

This microimage is certified to be a complete and accurate copy of the original as it appears in the files of the Public Works Department and was created in the normal course of business.

The photographic process used meets the Basic Microfilm Standards of the National Micrographics Association (MS115-1977)

3/15/02
DIRECTOR

NOTARY PUBLIC

OFFICIAL SEAL
Roberta Duran
NOTARY PUBLIC
STATE OF NEW MEXICO
07/02/02

D 24 C 20 B 16 A 12

CITY OF ALBUQUERQUE C D

DROP INLET DETAIL "A"

N.T.S.

TEMPORARY EROSION CONTROL BERM

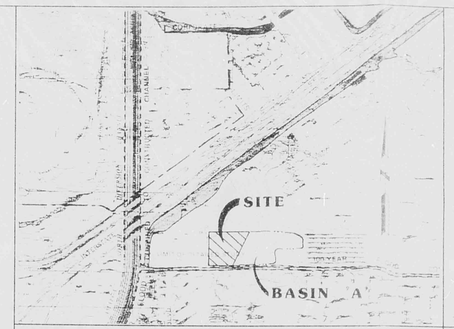

FLOODWAY & OFFSITE DRAINAGE MAP 1" =500'

LOCATION MAP 1" =800'

TBM

PROPERTY ADDRESS

Bogan Ave NE

LEGAL DESCRIPTION





Dated February, 1993

LEGEND

- CONTOUR (PROPOSED)
- CONTOUR (EXISTING)
- CURB AND GUTTER
- CONCRETE
- GUARDRAIL
- SANITARY SEWER MANHOLE
- WATER VALVE
- SPOT ELEVATION (EXISTING)
- CHAIN LINK FENCE
- OVERHEAD ELECTRIC LINE
- ANCHOR
- LIGHT POLE
- SPOT ELEVATION (PROPOSED)
- FLOW DIRECTION














DEVELOPED CONDITIONS







DRAINAGE PLAN

REVISIONS

2/5/92	REVISED ASPHALT & GRADING		

L & H TRUCKING
GRADING & DRAINAGE PLAN

BRASHER ENGINEERING, INC.
11000 MENAUL BLVD. N.E., Suite 115
ALBUQUERQUE, NEW MEXICO 87112
(505) 296-0942

PLAN SHOT TWICE
ONCE ON LIGHT
ONCE ON DARK

CITY OF ALBUQUERQUE
THIS MICROIMAGE IS THE BEST POSSIBLE REPRODUCTION DUE TO THE POOR QUALITY OF THE ORIGINAL DOCUMENT.

R# 35 DATE 5/17/92 OP

CITY OF ALBUQUERQUE
This microimage is certified to be a complete and accurate copy of the original as it appears in the files of the Public Works Department and was created in the normal course of business.
The photographic process used meets the Basic Microfilm Standards of the National Micrographics Association (MS115-1977)

DIRECTOR

NOTARY PUBLIC
OFFICIAL SEAL
Roberta Duran
07/07/92

D 24 C 20 B 16 A 12 CITY OF ALBUQERQUE C D

PUBLIC WORKS/HYDROLOGY

2 OF 2

F17/D49A

DROP INLET DETAIL "A"

NTS

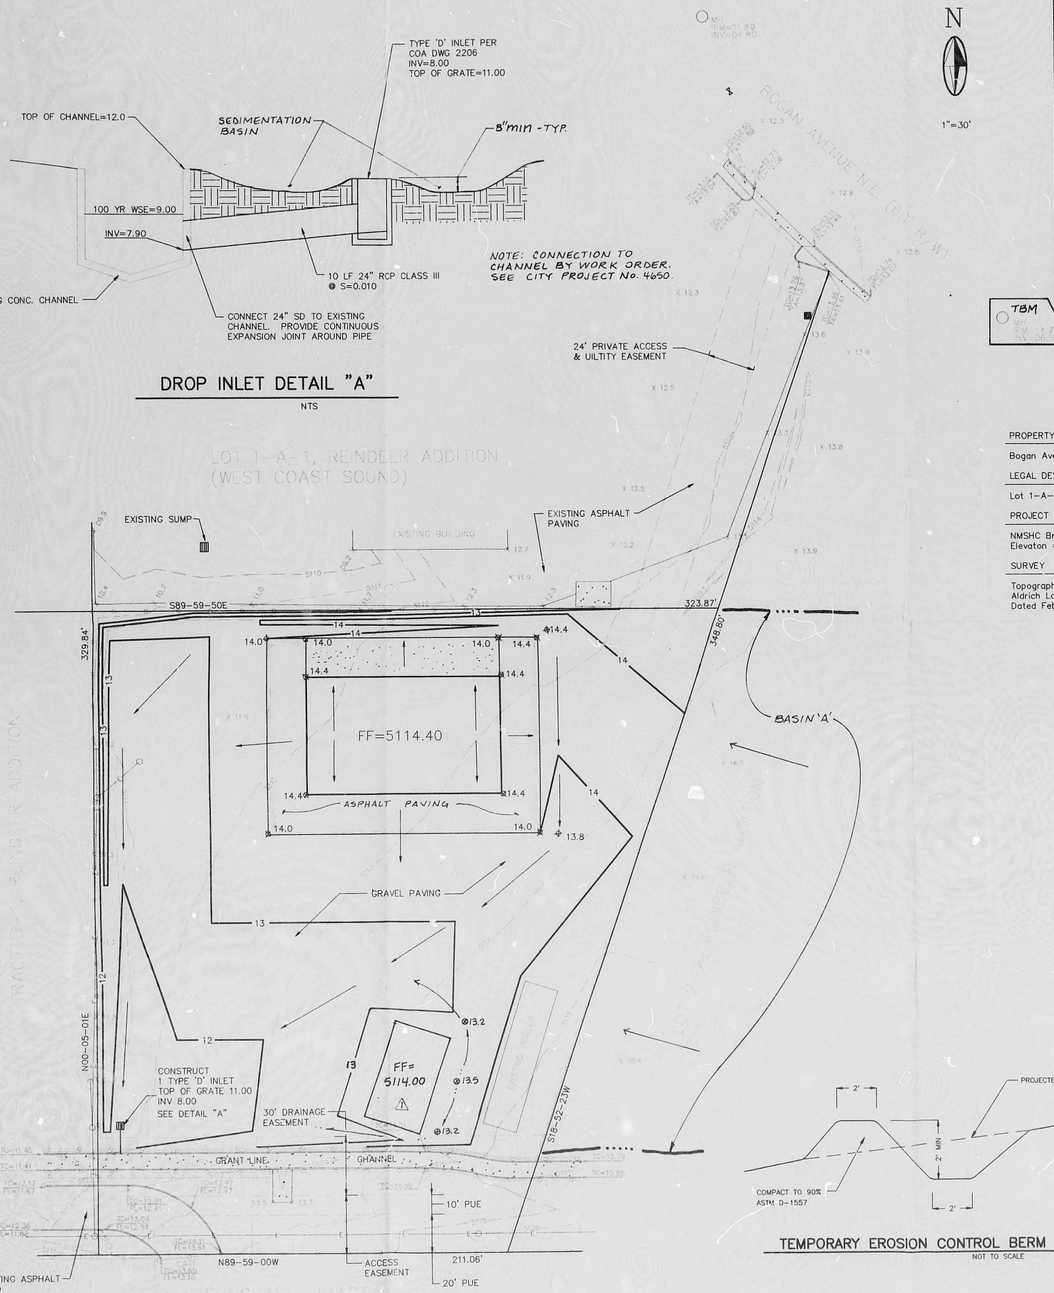

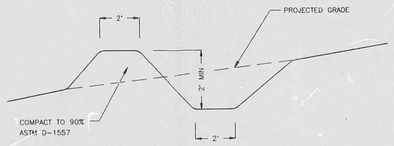

TEMPORARY EROSION CONTROL BERM

NOT TO SCALE

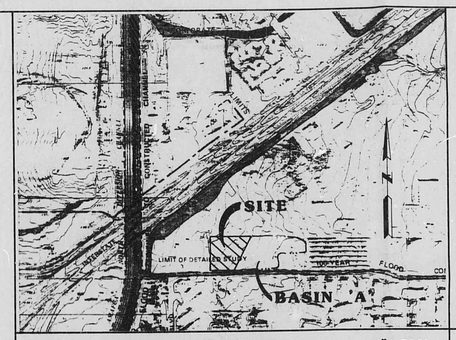

FLOODWAY & OFFSITE DRAINAGE MAP 1"=500'

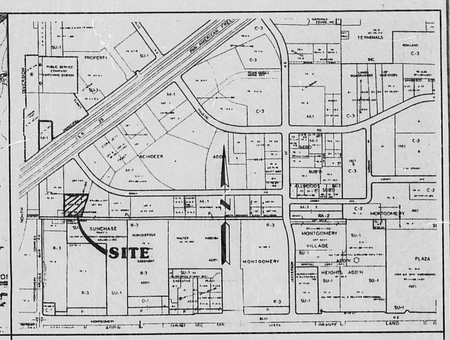

LOCATION MAP 1"=800'

TBM

PROPERTY ADDRESS

Bogan Ave NE

LEGAL DESCRIPTION

Lot 1-A-2, Reindeer Addition

PROJECT BENCHMARK

NMSHC Brass cap "125-18"
Elevaton = 5125.70 feet (MSLD 1929)

SURVEY

Topographic and Improvement survey by
Aldrich Land Surveying
Dated February, 1993

LEGEND

—14—	CONTOUR (PROPOSED)
4949	CONTOUR (EXISTING)
	CURB AND GUTTER
	CONCRETE
	GUARDRAIL
	SANITARY SEWER MANHOLE
	WATER VALVE
x 11.3	SPOT ELEVATION (EXISTING)
	CHAIN LINK FENCE
—E—	OVERHEAD ELECTRIC LINE
	POLE
	ANCHOR
	LIGHT POLE
14.0	SPOT ELEVATION (PROPOSED)
	FLOW DIRECTION
	DRAINAGE SWALE
	DRAINAGE BASIN DIVIDE

HYMO DATA SHEET

Precipitation zone 2 P360= 2.35"

Basin	Basin Area (ac)	Land Treatment A (acres)	B	C	D	EW (in)	Q100 (cfs)	V100 (af)
Existing conditions								
SITE	2.08	---	---	2.08	---	1.13	6.5	0.20
A	2.9	2.0	---	0.7	0.2	0.78	6.3	0.19
Developed conditions								
SITE	2.08	---	0.18	---	1.9	2.00	9.3	0.35
A	2.9	---	0.3	---	2.6	2.00	12.9	0.48

2.08
2.9
4.98

DRAINAGE PLAN

SCOPE:

Pursuant to the established Drainage Ordinance for the City of Albuquerque and the Development Process Manual, this Drainage Plan outlines the drainage management criteria for controlling developed runoff from the project site. A truck repair service facility is proposed on the property, with guards quarters (mobile home), and associated access, paving, drainage and utility improvements.

EXISTING CONDITIONS:

The project site is approximately 2.08 acres in size and is located just south of Bogan Avenue, east of the I-25 east frontage road. Presently the site is partially improved. The site has recently been graded to remove vegetation. A chain link fence has been constructed at the perimeter of the property for security purposes. Site topography is uniform, sloping from east to west at approximately one percent (1%). The site is bounded on the west and north by developed commercial properties, on the east by undeveloped property, and on the south by a developed apartment complex. The Grant Line Channel runs through the southern edge of the site. As shown by Floodway Map Panel 350002 0016, this site does not lie within a designated flood hazard zone.

The natural (pre-graded) site drained in a northwesterly direction into the West Coast Sound site located to the north. An area drain is provided on the West Coast Sound site to intercept all flows. This area drain discharges into an underground vault which is drained by a sump pump. The outfall for the vault is the Pan American Frontage Road drainage system.

The existing (graded) site drains in a westerly direction. Temporary erosion control berms have been placed at the property lines to prohibit discharge of flows onto adjacent lands. The graded site is presently ponding runoff as a result of erosion control measures.

DEVELOPED CONDITIONS:

As shown by the Plan, the site is to be developed as a service center for a trucking operation. Improvements consist of construction of a 6000 SF building, paved access and parking, perimeter fencing, guards quarters (mobile home), private utilities, and drainage improvements. Review of the existing off-site conditions at West Coast Sound, and the Drainage Report for Lot 1A (West Coast Sound), prepared by Hall Engineering, dated 1-23-85, reveals that the existing vault does not have capacity to accept developed flows from the L&H Trucking site. The vault was sized to accept only undeveloped flow from the L&H site. Inspection of the vault revealed a need for maintenance which would be increased by further discharge by the project site. The site will therefor be graded to drain to the Grant Line Channel located to the south. An area drain will be constructed just north of the channel to intercept all on-site flow. Utilization of an area drain reduces the fill required drain the site to the south instead of its natural tendency to drain northwest.

The site accepts off-site flow from the undeveloped tract located to the east. The drainage improvements to be provided by this project will be sized to accept this runoff, however, when the adjacent tract develops it will be required to drain either to the Grant Line Channel or Bogan ave.

As shown by the Plan, the site has paved access through the West Coast Sound site. A 20' strip will be paved around the perimeter of the building, with the remainder of the site to be paved with gravel.

CALCULATIONS:

The calculations shown hereon define the 100 year/6 hour design storm falling with the project area under existing and developed conditions. The Hydrology is per "Section 22.2, Part A, DPM, Vol 2" Dated August 1991. Supplemental calculations for the sizing of the private drop inlet and connection to the Grant Line Channel are submitted separately.

OCT 13 1993 HYDROLOGY DIVISION

REVISIONS		
1 10-12-93	PLAN UPDATE TO ADD 50'x52' BUILDING	DAL

022593DAL

L & H TRUCKING
GRADING & DRAINAGE PLAN

10-12-93
2-25-93 3-24-93

BRASHER ENGINEERING, INC.
11930 MENAUL BLVD. N.E., SUITE 113
ALBUQUERQUE, NEW MEXICO 87112
(505)296-0422

DRAWN BY: STAFF	DATE: 02-25-93
CHECKED BY: D.A.L.	SHEET 1 OF 1

PLAN SHOT TWICE
ONCE ON LIGHT
ONCE ON DARK

CITY OF ALBUQUERQUE
THIS MICROIMAGE IS THE BEST POSSIBLE REPRODUCTION DUE TO THE POOR QUALITY OF THE ORIGINAL DOCUMENT.

R# 25 DATE 3-17-02 OP LRP

CITY OF ALBUQUERQUE
This microimage is certified to be a complete and accurate copy of the original as it appears in the files of the Public Works Department and was created in the normal course of business.
The photographic process used meets the Basic Microfilm Standards of the National Micrographics Association (MS115-1977)

DIRECTOR

NOTARY PUBLIC

OFFICIAL SEAL
Roberta Duran
NOTARY PUBLIC
STATE OF NEW MEXICO
07/07/02

D 24 C 20 B 16 A 12

CITY OF ALBUQUERQUE C D

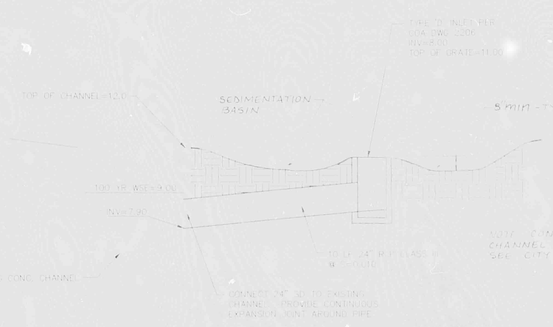

DROP INLET DETAIL "A"

N

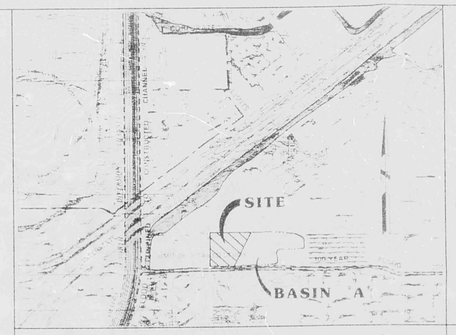

FLOODWAY & OFFSITE DRAINAGE MAP 1" =500'

LOCATION MAP 1" =800'

TBM

PROPERTY ADDRESS

Bogan Ave NE

LEGAL DESCRIPTION

Lot 1-A-2, Pendaw Addition

PROJECT BENCHMARK

NGS(N) Brass cap "B 34 18"
Elevation = 5324.70 feet (MSL 1929)

SURVEY

Topographic and Improvement survey by Aldrich Land Surveyors dated February, 1993

LEGEND

—14—	CONTOUR (PROPOSED)
	CONTOUR (EXISTING)
	CURB AND GUTTER
	CONCRETE
	GUARDRAIL
	SANITARY SEWER MANHOLE
WV	WATER VALVE
x 15.3	SPOT ELEVATION (EXISTING)
	CHAIN LINK FENCE
	OVERHEAD ELECTRIC LINE
	POLE
	ANCHOR
	LIGHT POLE
5114.0	SPOT ELEVATION (PROPOSED)
	FLOW DIRECTION
	DRAINAGE SWALE
	DRAINAGE BASIN DIVIDE

HYMO DATA SHEET

Precipitation zone 2 P360= 2.1"

Basin	Basin Area (ac)	Land Treatment A (acres)	B (acres)	C (acres)	D (acres)	Tc (hr)	Q100 (cfs)	V100 (ac/ft)
Existing conditions								
SITE	2.08	---	---	2.08	---	1.23	0.35	0.20
A	2.3	2.0	---	0.3	0.2	0.79	6.1	0.10
Developed Conditions								
SITE	2.08	---	0.18	0.6	1.3	2.06	9.3	0.38
A	2.3	---	0.1	---	2.2	2.00	12.4	0.28

DRAINAGE PLAN

SCOPE:

Pursuant to the established Drainage Ordinance for the City of Albuquerque and the Developer's Process Manual, this Drainage Plan outlines the drainage management criteria for controlling developed runoff from the project site. A truck repair service facility is proposed on the property, with guards quarters (mobile home) and associated access, paving, drainage and utility improvements.

EXISTING CONDITIONS:

The project site is approximately 2.08 acres in size and is located just south of Bogan Avenue, east of the I-25 east frontage road. Presently the site is partially improved. The site has recently been graded to remove vegetation. A chain link fence has been constructed at the perimeter of the property for security purposes. Site topography is uniform, sloping from east to west at approximately one percent (1%). The site is bounded on the west and north by developed commercial properties, on the east by undeveloped property, and on the south by a developed apartment complex. The Corrit Line Channel runs through the southern edge of the site. As shown by Floodway Map Panel 350002 0016, this site does not lie within a designated flood hazard zone.



DEVELOPED CONDITIONS:







L & H TRUCKING
GRADING & DRAINAGE PLAN

REVISIONS

12-12-93	DRAIN DRAWING 3-1-1993	10-4-93	

BRASHER ENGINEERING, INC.
11930 MENAUL BLVD. N.E., SUITE 113
ALBUQUERQUE, NEW MEXICO 87112
(505)296-0422

PLAN SHOT TWICE
ONCE ON LIGHT
ONCE ON DARK

CITY OF ALBUQUERQUE
THIS MICROIMAGE IS THE BEST POSSIBLE REPRODUCTION DUE TO THE POOR QUALITY OF THE ORIGINAL DOCUMENT.

R# 15 DATE 3-17-92 OP 67

CITY OF ALBUQUERQUE

This microimage is certified to be a complete and accurate copy of the original as it appears in the files of the **Public Works Department** and was created in the normal course of business.

The photographic process used meets the Basic Microfilm Standards of the National Micrographics Association (MS115-1977).

1/5/92
DIRECTOR

NOTARY PUBLIC
OFFICIAL SEAL
Roberta Duran
NOTARY PUBLIC
07/02/92

D 24 C 20 B 16 A 12

CITY OF ALBUQUERQUE C D