HYDROLOGY

F18/D14B
ONE PLAN

F18-D14B

1 PLAN

VICINITY MAP F-18-Z

SECTION A-A
CONC. CHANNEL AND CONC. RUNDOWN

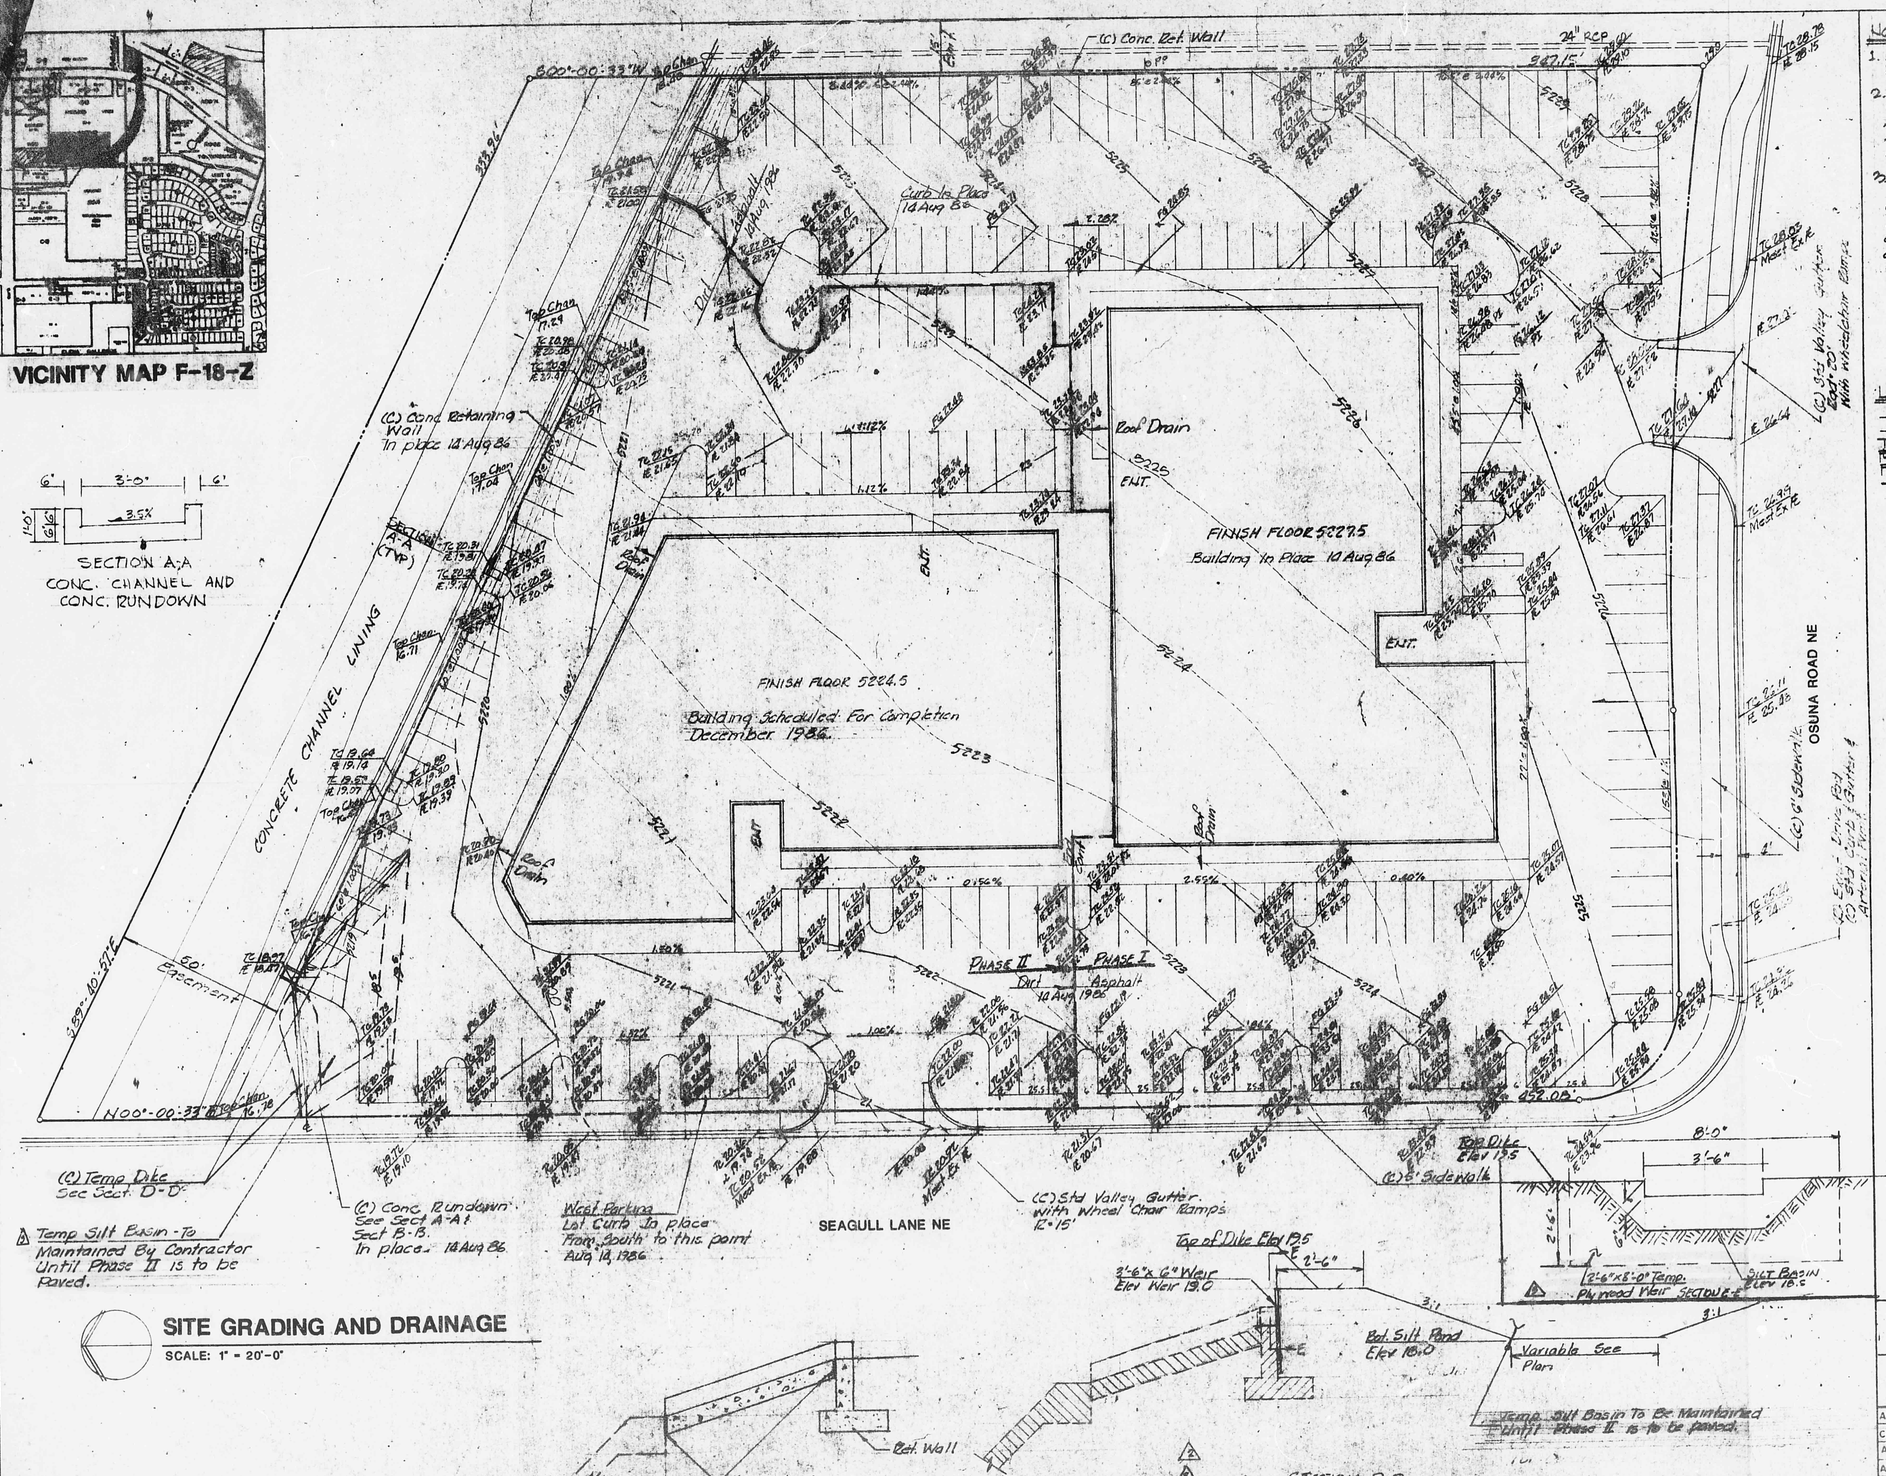

SITE GRADING AND DRAINAGE

SCALE: 1" = 20'-0"

NOTES

1. ALL ELEVATIONS ARE MEAN SEA LEVEL.
2. ALL CONSTRUCTION WITHIN PUBLIC RIGHT-OF-WAY TO BE IN ACCORDANCE WITH CITY OF ALBUQUERQUE STD DRAWINGS & SPECIFICATIONS.
3. DURING CONSTRUCTION, THE CONTRACTOR SHALL TAKE SUCH MEASURES AS NECESSARY SO SEDIMENT FROM ANY SOIL EROSION WILL REMAIN ON SITE.

LEGEND

5225	EXISTING CONTOUR
5220	PROPOSED CONTOUR
TC	TOP OF CURB
FL	FLOW LINE
FG	FINISH GRADE
	DIRECTION OF FLOW

RECEIVED
SEP 02 1986
HYDROLOGY SECTION

AS BUILT INFORMATION

CONTRACTOR | DATE
WORK STAKED BY | DATE
INSPECTOR'S ACCEPTANCE BY | DATE
FIELD VERIFICATION BY | DATE
DRAWINGS CORRECTED BY | DATE

MICRO-FILM INFORMATION

RECORDED BY | DATE
NO.

BENCH MARKS

A standard ACS brass tablet stamped "B-F18 1981" set in top of north curb 0.3 miles east of intersection of Osuna Rd. NE & San Mateo Blvd. NE
El. = 5233.12

SURVEY INFORMATION

FIELD NOTES
NO. | BY | DATE

ENGINEER'S SEAL

ROBERT F. SYLVA
NEW MEXICO
REGISTERED PROFESSIONAL ENGINEER
(1981)

NO.	DATE	REMARKS	BY
1	Feb 86	Rev due to ft discrepancy	RFS
2	Aug 86	Show limit of imp As of Aug 86	
3		Added section for Erosion Control	RFS
4		Revised Temp Silt Basin	

REVISIONS

DESIGNED BY | DATE
DRAWN BY | DATE
CHECKED BY | DATE

CITY OF ALBUQUERQUE

TOPOGRAPHIC SURVEY

TRACT A-1

LIMITED PARTNERSHIP TRACT

APPROVALS	ENGINEER	DATE	APPROVALS	ENGINEER	DATE
City Engineer			Liquid Waste		
A.C.E.-Design			Traffic		
A.C.E.-Hydrology			Water		

DRAWING NO. | MAP NO. F-18-Z | SHEET

WILSON & COMPANY
ENGINEERS & ARCHITECTS
ALBUQUERQUE, NEW MEXICO