HYDROLOGY

F18/D26
ONE PLAN

F 18 - D 26

1 PLAN

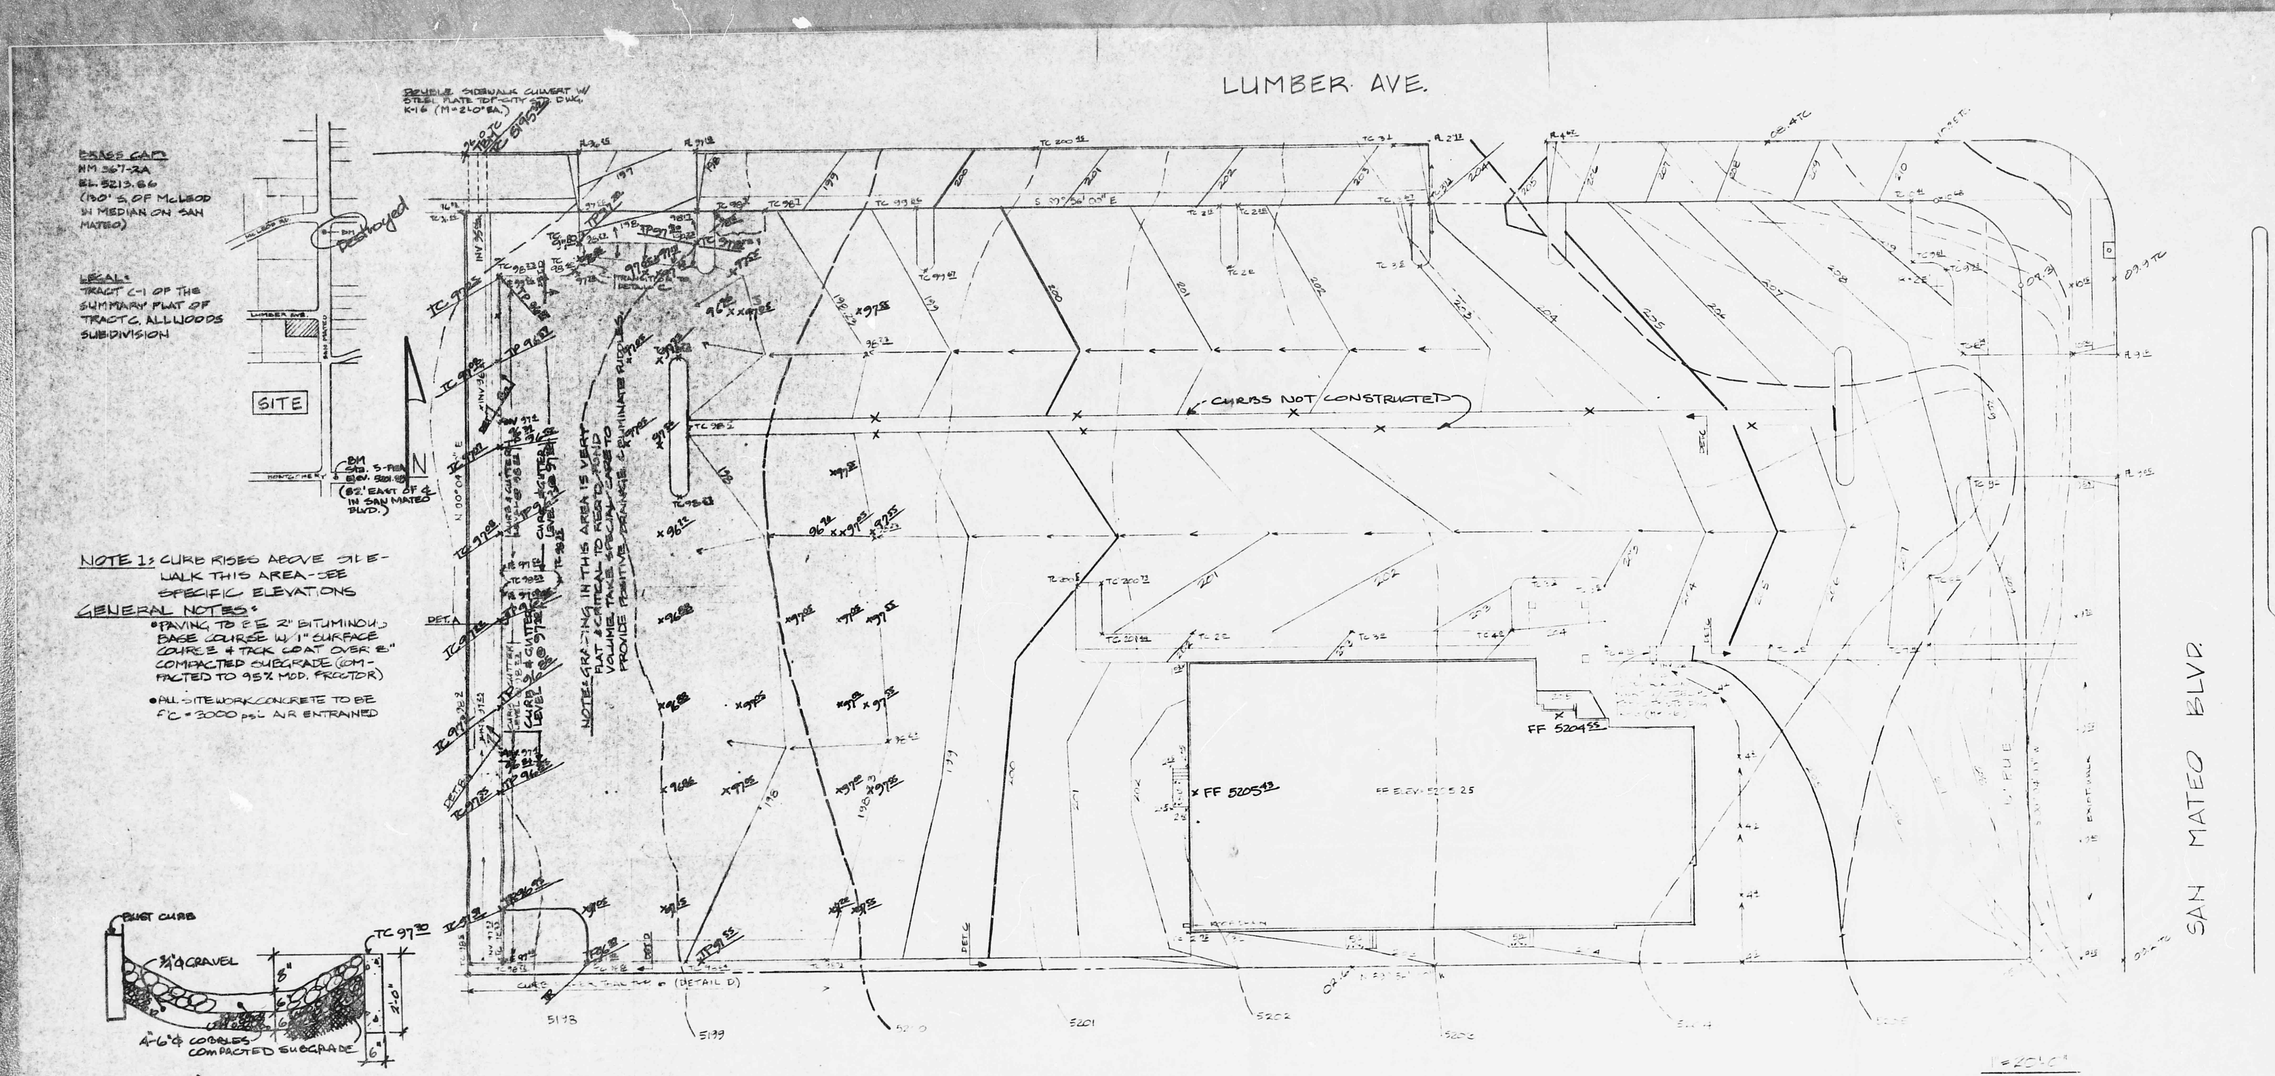

Sheet Title: GRADING & DRAINAGE AS-BUILT

CHI - CHI'S RESTAURANT

Job no:
Date: 10/27/81
Drawn:
Check:
Rev: 11/2/81

NORTON & ASSOCIATES ARCHITECTS
1717 Louisiana Blvd NE Albuquerque New Mexico 87110 Tel (505) 265-8333

Sheet 2 of 13

F18/D26