HYDROLOGY

F18/D34
ONE PLAN

F18/D34

1 Plan

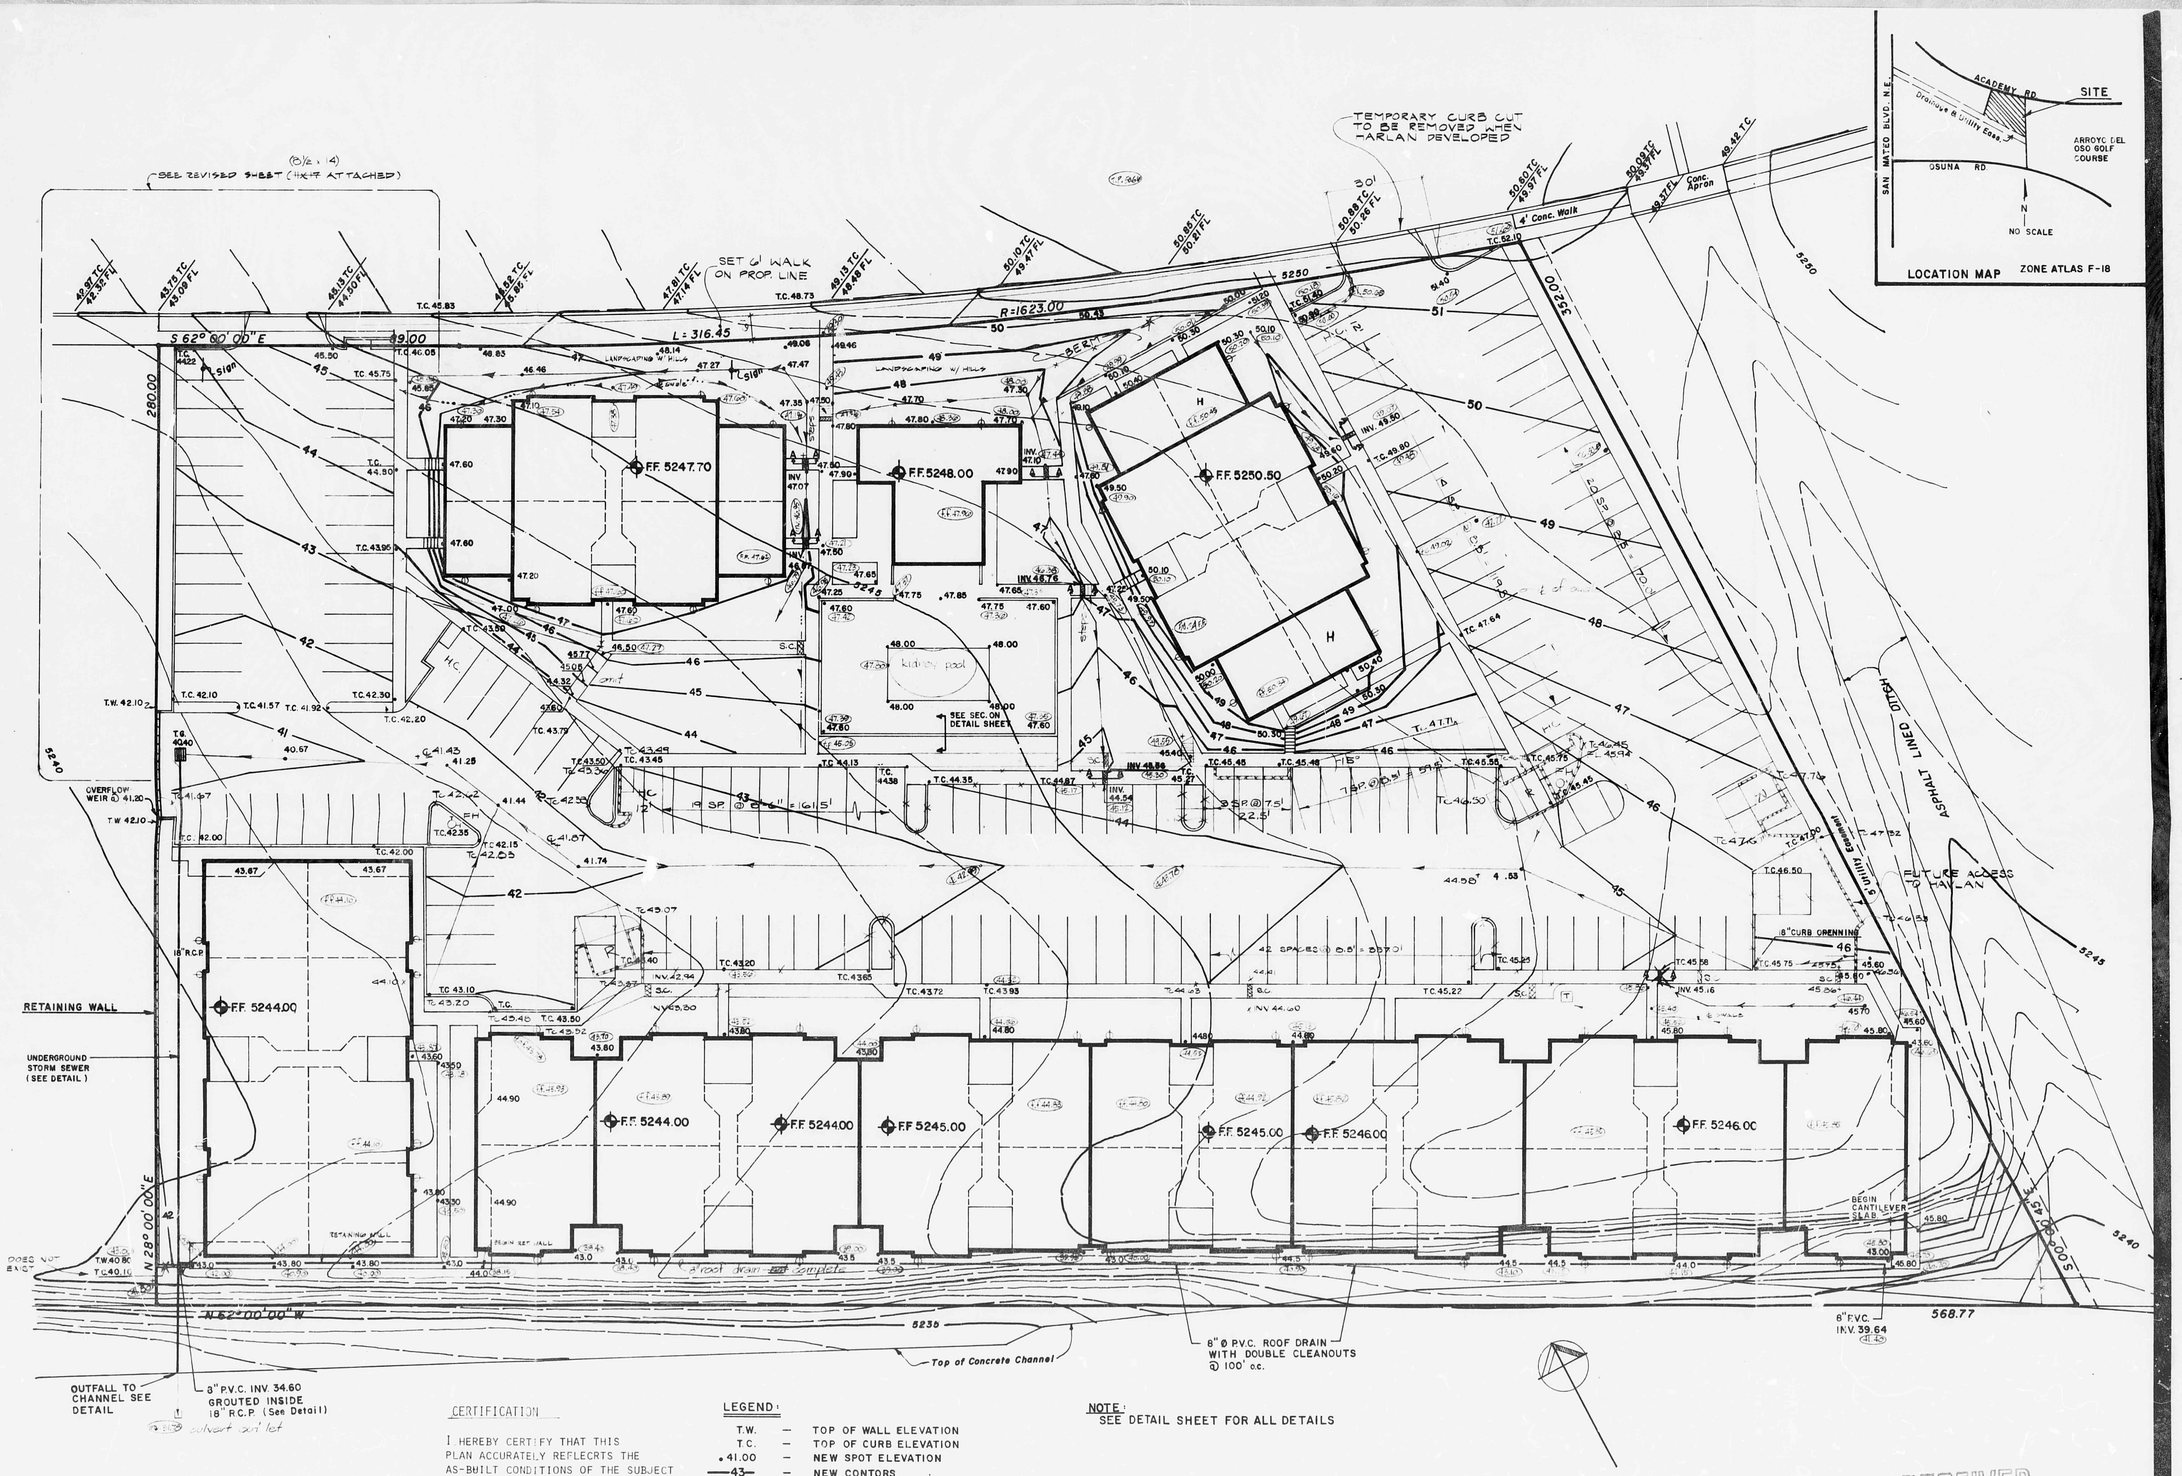

CERTIFICATION

I HEREBY CERTIFY THAT THIS PLAN ACCURATELY REFLECRTS THE AS-BUILT CONDITIONS OF THE SUBJECT SITE AND IS IN COMPLIANCE WITH THE ORIGINAL APPROVED DRAINAGE PLAN.

Fred C. Arfman, P.E. — 10-11-89 Date

LEGEND:

T.W.	—	TOP OF WALL ELEVATION
T.C.	—	TOP OF CURB ELEVATION
• 41.00	—	NEW SPOT ELEVATION
43	—	NEW CONTORS
	—	EXISTING CONTORS
	—	NEW SIDEWALK CULVERT (See Detail)
	—	NEW SINGLE "D" CATCH BASIN
	—	NEW HEARDER CURB (See Detail)

AS-BUILT LEGEND

Ø	ROOF DRAIN
	AS-BUILT SPOT ELEVATION
	DRAINAGE SWALE
	AS-BUILT CURBING

NOTE:
SEE DETAIL SHEET FOR ALL DETAILS

DRAINAGE PLAN

RECEIVED
OCT 19 1989
HYDROLOGY SECTION

rickschalk
eric miller
architects,
p.a. /// aia
3908 Carlisle Blvd. NE
Albuquerque, NM 87107
505-884-5656

STATE OF NEW MEXICO
RICK SCHALK No. 1393
ERIC MILLER No. 1517
REGISTERED ARCHITECT

REVISED
DATE
DRAWN BY

SHEET NO 2
OF