HYDROLOGY

F21/D31B

ONE PLAN

1 PLAN FOR

SUNCREEK APTS.

F21 – D31B

SECTION

EXISTING CONCRETE LINED CHANNEL
BEAR ARROYO

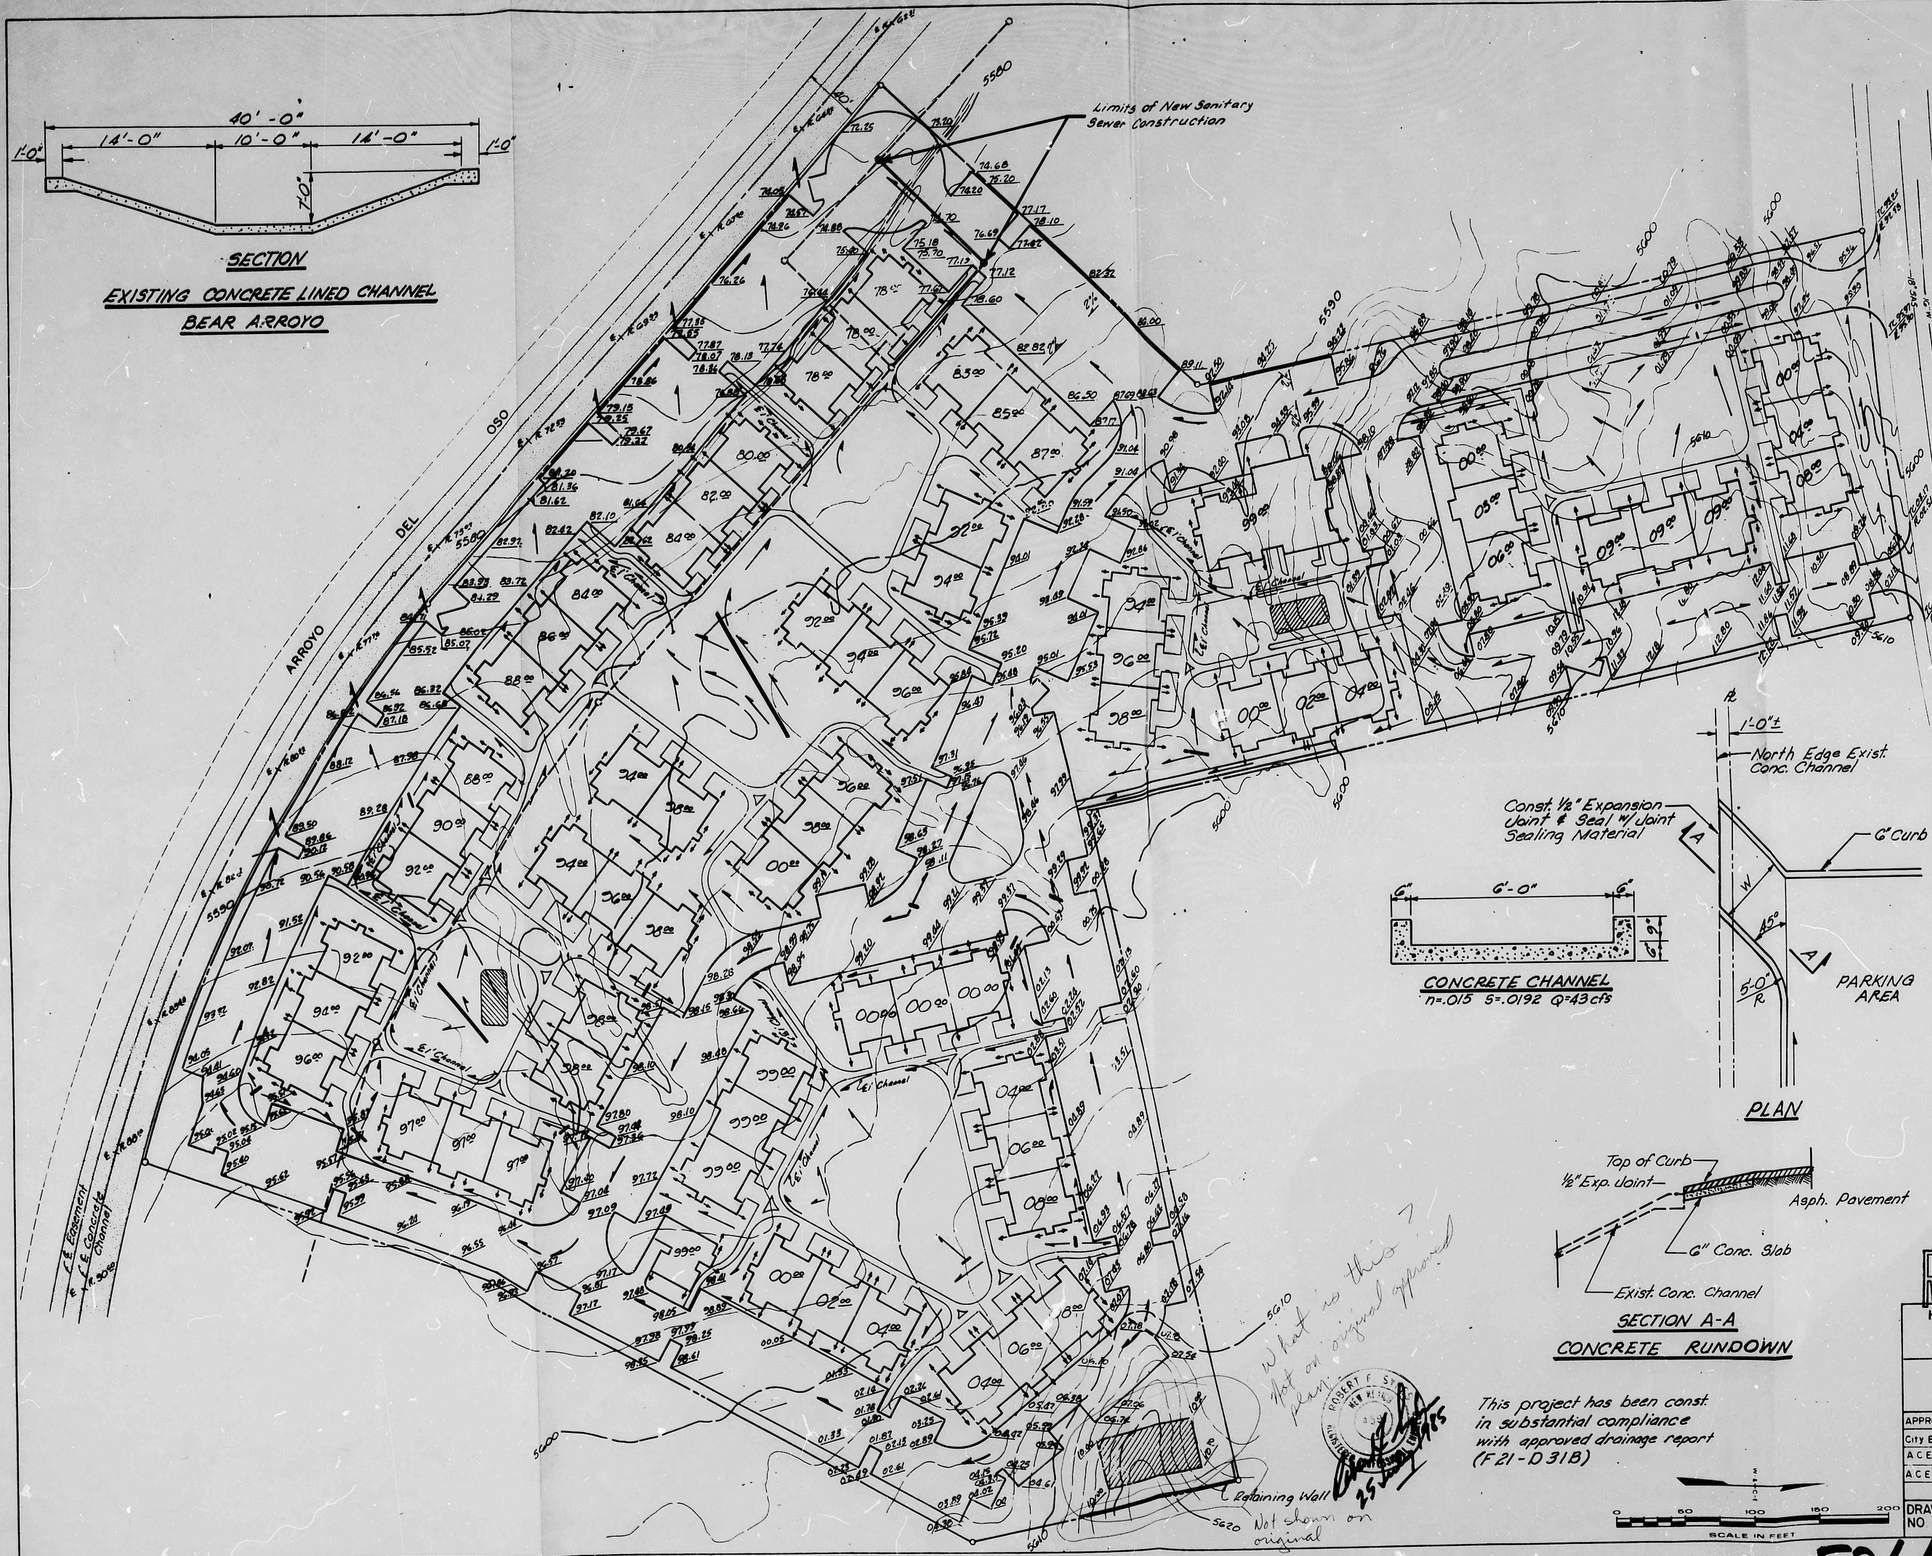

PLAN

CONCRETE CHANNEL
n=.015 S=.0192 Q=43 cfs

SECTION A-A
CONCRETE RUNDOWN

This project has been const. in substantial compliance with approved drainage report (F21-D31B)

0 50 100 150 200
SCALE IN FEET

AS BUILT INFORMATION
CONTRACTOR
WORK DONE BY — DATE
INSPECTORS — DATE
AS-BUILT BY — DATE
FIELD VERIFICATION BY — DATE
DRAWING CORRECTED BY — DATE

MICRO-FILM INFORMATION
RECORDED BY — DATE
NO

BENCH MARKS

SURVEY INFORMATION
FIELD NOTES
NO. | BY | DATE

ENGINEER'S SEAL

NO.	DATE	REVISIONS	DESIGNED BY	DRAWN BY	CHECKED BY
1	11/29/84	Revised Grade West Rd.	RFS		
		REMARKS	DESIGN		
			DATE OCT. '83	DATE OCT. '83	DATE

RECEIVED
JUL 25 1985
HYDROLOGY SECTION
CITY OF ALBUQUERQUE

SUNCREEK APARTMENTS
GRADING PLAN

APPROVALS	ENGINEER	DATE	APPROVALS	ENGINEER	DATE
City Engineer			Liquid Waste	N.A. Rubio	6/28/84
A.C.E. - Design			Traffic	W.A. Duffy	6/27/84
A.C.E. - Hydrology	N.A. Rubio	6/27/84	Water	N.A. Rubio	6/27/84

DRAWING NO 2188 | MAP NO. F-21-Z | SHEET 3 OF 4

WILSON & COMPANY ENGINEERS ALBUQUERQUE | ARCHITECTS NEW MEXICO

WCEA 83-517

F21/D31B